

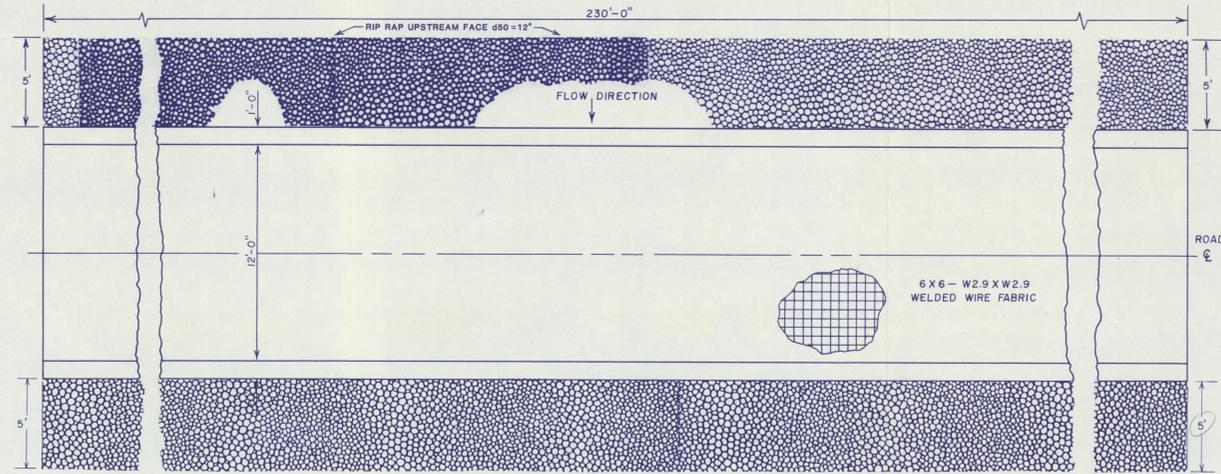



PLAN VIEW
SCALE: 1" = 50'
PHOTO DATE: 10-25-88

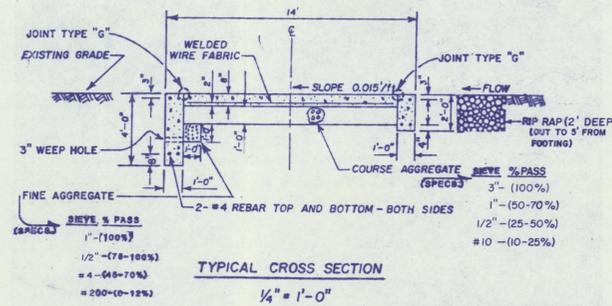

PLAN
1/4" = 1'-0"

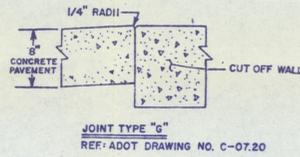

TYPICAL CROSS SECTION
1/4" = 1'-0"
REF. - "ARIZONA DEPARTMENT OF TRANSPORTATION STANDARD DRAWING C-19.10 FORD CONCRETE WALL," 1983

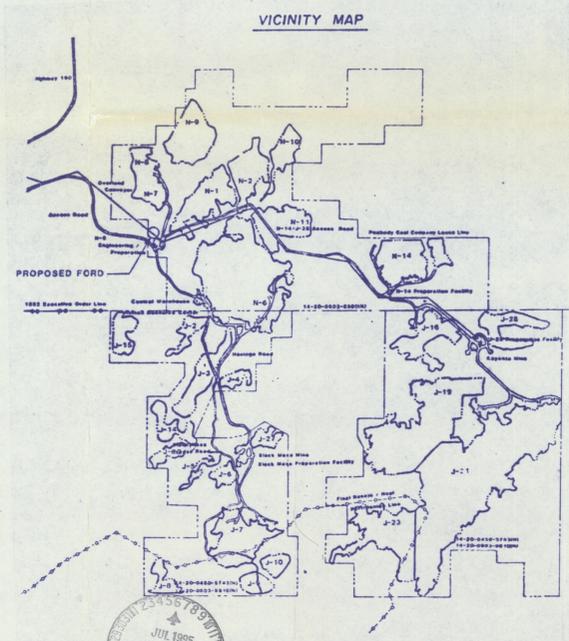

I certify this structure was constructed as designed and as approved in the mining permit, and that the information contained herein is accurate to the best of my knowledge and belief.

James G. Schlotterbeck
Professional Engineer
No. 17007
State of Arizona

JUN 20 1989
Date


PEABODY COAL COMPANY
BLACK MESA - KAYENTA MINE

CONCRETE FORD OF
YELLOW WATER CANYON WASH
"AS-BUILT"

SCALE: AS SHOWN DRAWN BY: J.H.J.

DATE: 4-11-89 DRAWING NO: 65490A

REVISION: APPROVED BY: J.G.S.

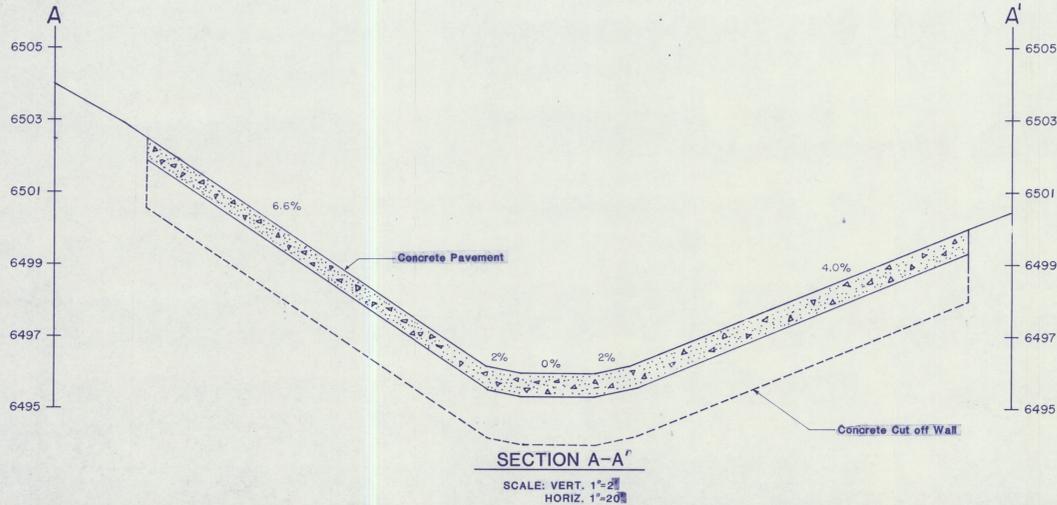

SECTION A-A'
SCALE: VERT. 1" = 2'
HORIZ. 1" = 20'