
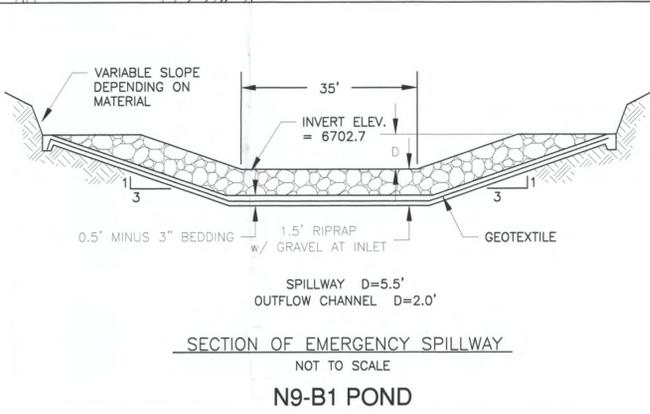
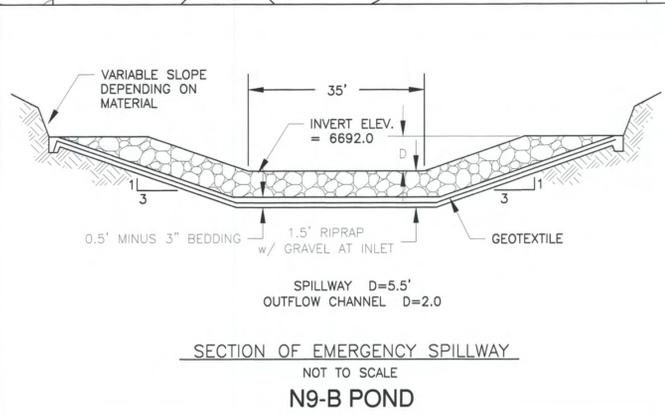


N9-B POND STAGE CAPACITY TABLE

ELEVATION (ft-msl)	STAGE (ft)	AREA (acres)	TOTAL CAPACITY (ac-ft)	DESCRIPTION
6677.2	0.0	0.00	0.00	BOTTOM OF POND
6680.0	2.8	0.63	0.71	
6685.0	7.8	1.52	6.98	INCISED ELEV.
6690.0	12.8	1.94	15.62	
6692.0	14.8	2.13	19.69	EMERGENCY SPILLWAY
6695.0	17.8	2.45	26.55	
6697.5	20.3	2.74	33.01	TOP OF EMBANKMENT

N9-B1 POND STAGE CAPACITY TABLE

ELEVATION (ft-msl)	STAGE (ft)	AREA (acres)	TOTAL CAPACITY (ac-ft)	DESCRIPTION
6684.6	0.0	0.32	0.00	BOTTOM OF POND
6690.0	5.4	0.83	3.52	
6695.0	10.4	1.10	8.34	INCISED ELEV.
6700.0	15.4	1.39	14.54	
6702.7	18.1	1.59	18.50	EMERGENCY SPILLWAY
6705.0	20.4	1.75	22.43	
6708.2	23.6	2.16	28.64	TOP OF EMBANKMENT

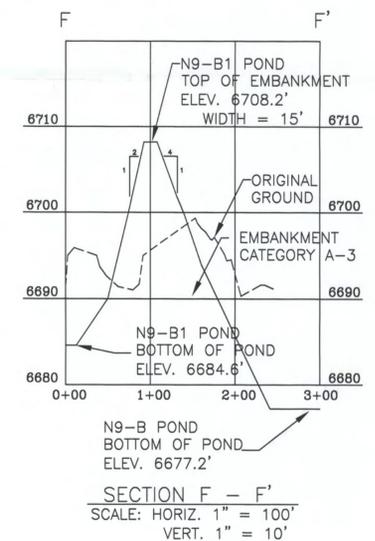

I CERTIFY IN ACCORDANCE WITH THE REQUIREMENTS OF 30 CFR 750.16 AND 816.46(b)(3) THAT THE SILTATION CONTROL STRUCTURE WAS CONSTRUCTED AS DESIGNED BY PEABODY WESTERN COAL CO. AND AS APPROVED BY THE OFFICE OF SURFACE MINING, WITH THE EXCEPTIONS OF CERTAIN DIFFERENCES THAT ARE LISTED BELOW:

1. POND STAGE CAPACITY TABLE
2. PONDING AREA SHAPE
3. ELEVATIONS & DIMENSIONS REFLECTED ON THE DRAWING

ENGINEER'S CERTIFICATION



EXPIRES: 09/30/2014

GARY ALTSISI ARIZONA P.E. #37842  
RECLAMATION SUPERVISOR  
PEABODY WESTERN COAL COMPANY






CHK'D	DATE	DESCRIPTION
GA	10/27/11	N9-B1 Ponding Area



**N9-B & N9-B1 (2011)  
SEDIMENTATION POND  
AS-BUILT**

KAYENTA MINE  
PEABODY WESTERN COAL COMPANY  
P. O. BOX 650 KAYENTA, ARIZONA 86033

DESIGNED BY: GA	SCALE: AS NOTED
DRAWN BY: M.Becenti/G.A.	DRAWING DATE: 10-27-11
CHECKED BY: GA	PHOTO DATE: 03-25-11
CONTOUR INTERVAL: 5 FT.	SURVEY DATE: 10-25-11

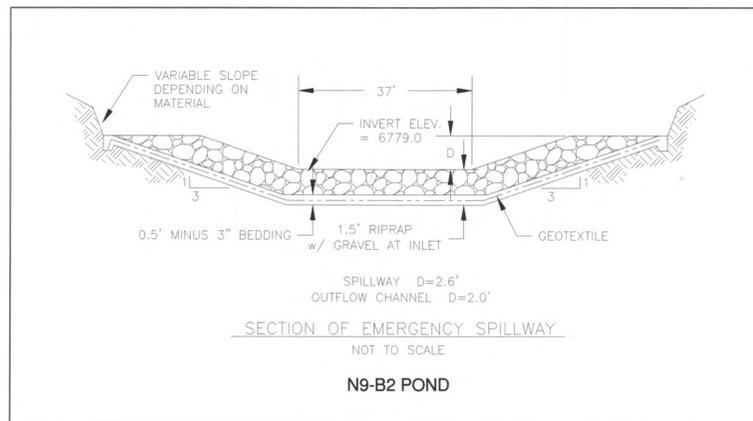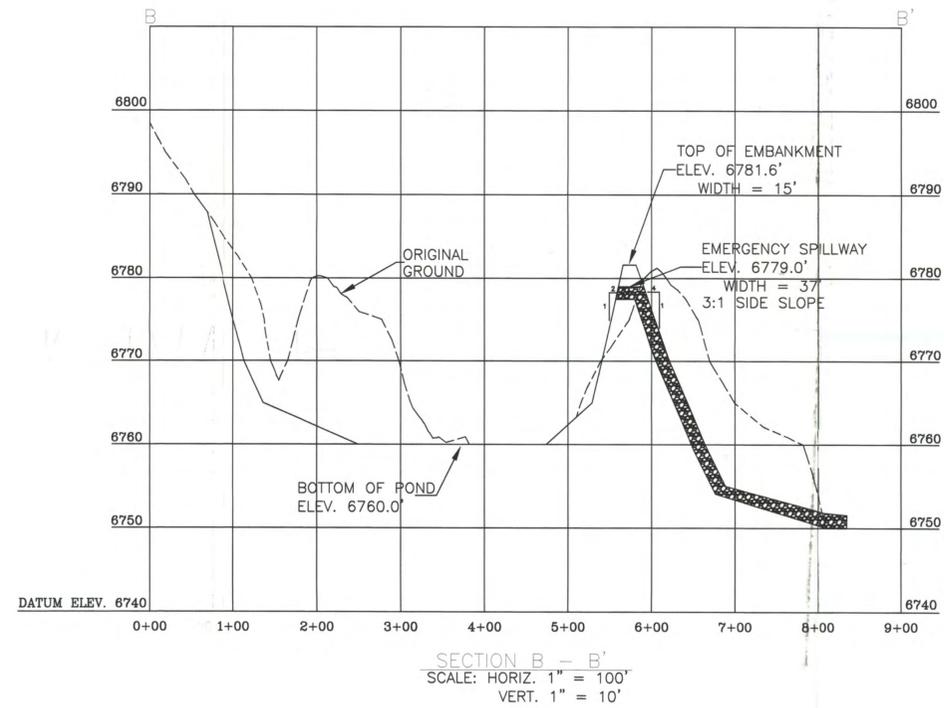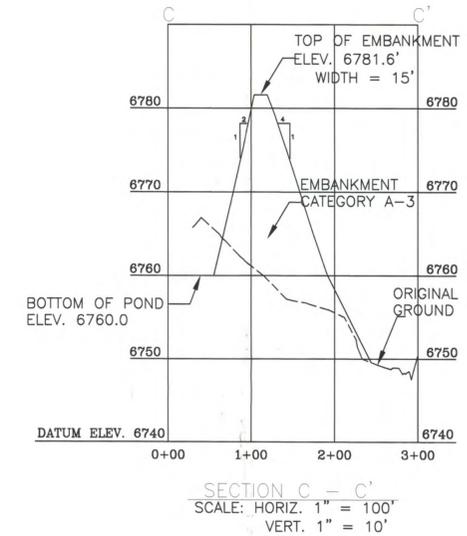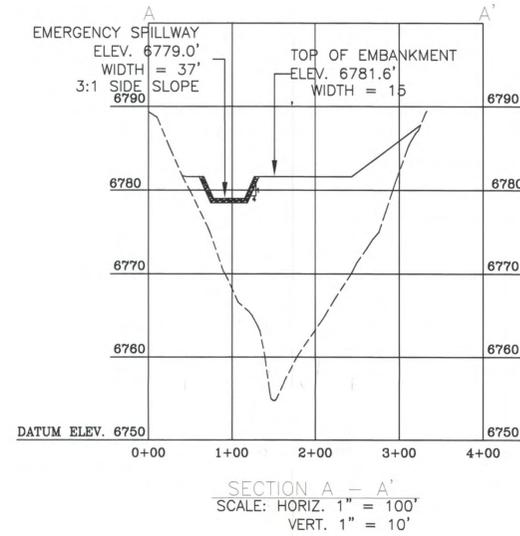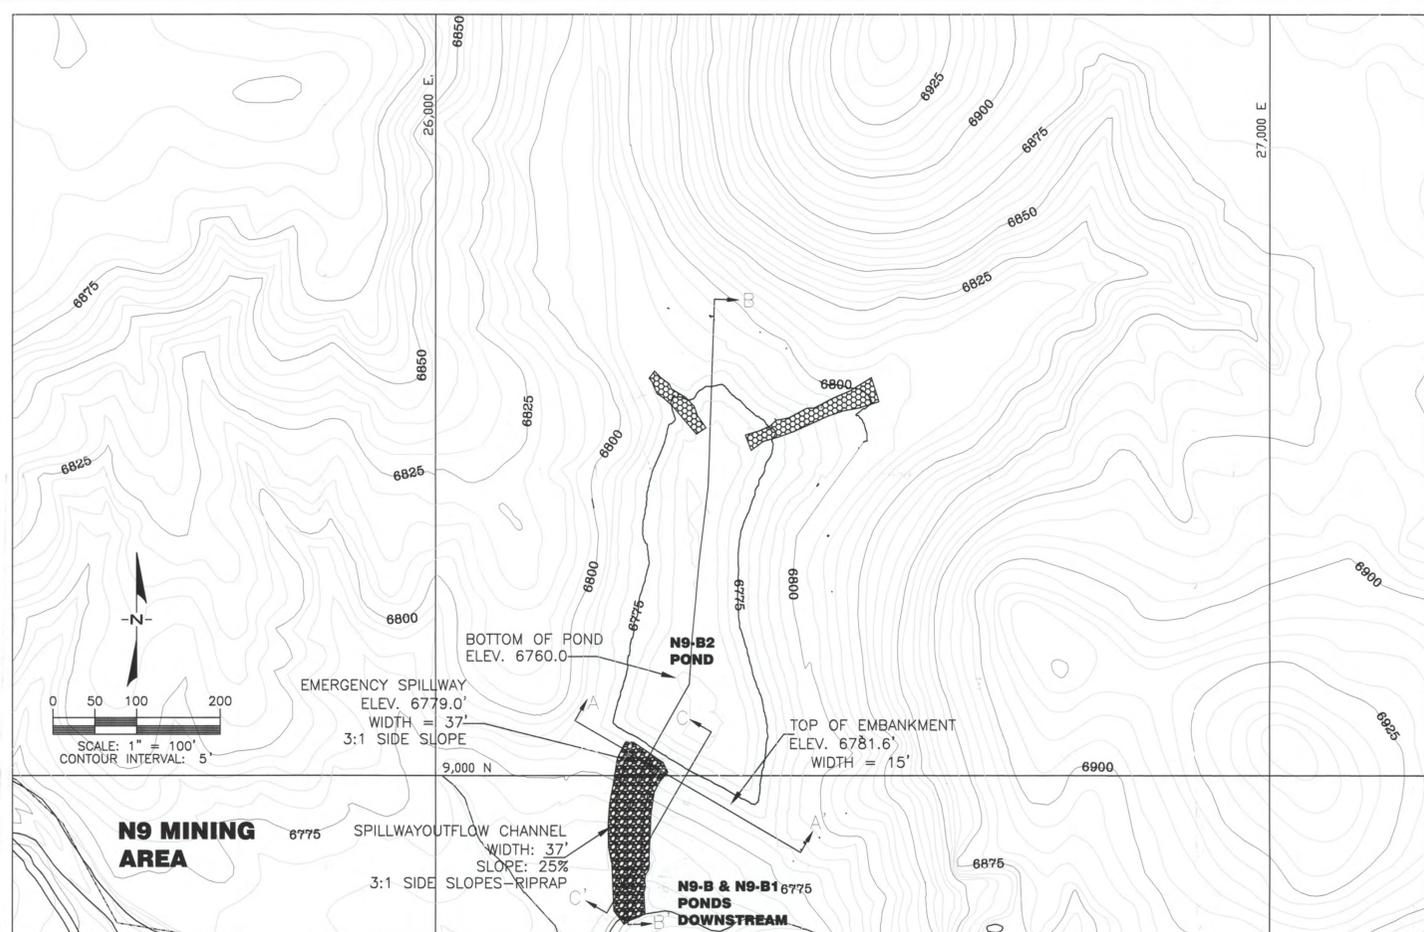

**N9-B2 POND STAGE CAPACITY TABLE**

ELEVATION (ft-msl)	STAGE (ft)	AREA (acres)	TOTAL CAPACITY (ac-ft)	DESCRIPTION
6760.0	0.0	0.16	0.00	BOTTOM OF POND
6765.0	5.0	0.72	2.37	INCISED ELEV.
6770.0	10.0	1.06	6.88	
6775.0	15.0	1.45	13.17	
6779.0	19.0	1.76	19.58	EMERGENCY SPILLWAY
6780.0	20.0	1.85	21.38	
6781.6	21.6	1.99	24.45	TOP OF EMBANKMENT

I CERTIFY IN ACCORDANCE WITH THE REQUIREMENTS OF 30 CFR 750.16 AND 816.46(b)(3) THAT THE SILTATION CONTROL STRUCTURE WAS CONSTRUCTED AS DESIGNED BY PEABODY WESTERN COAL CO. AND AS APPROVED BY THE OFFICE OF SURFACE MINING, WITH THE EXCEPTIONS OF CERTAIN DIFFERENCES THAT ARE LISTED BELOW:



1. POND STAGE CAPACITY TABLE
2. PONDING AREA SHAPE
3. ELEVATIONS & DIMENSIONS REFLECTED ON THE DRAWING
4. SPILLWAY WIDTH IS WIDER THAN DESIGN

**ENGINEER'S CERTIFICATION**  
18782  
JAMES GARY SCHENVOGT  
ENGINEERING SUPERVISOR  
PEABODY WESTERN COAL COMPANY


ARIZONA P.E. #18782  
DATE: JUN 01 2007




<b>N9-B2 (2007) SEDIMENTATION POND AS-BUILT</b>	
KAYENTA MINE PEABODY WESTERN COAL COMPANY P. O. BOX 650 KAYENTA, ARIZONA 86033	
DESIGNED BY: GA	SCALE: AS NOTED
DRAWN BY: M. Becenti	DRAWING DATE: 06/01/07
CHECKED BY: JGS	PHOTO DATE: 05-83
CONTOUR INTERVAL: 5 FT.	
DWG FILE: 011006_POND N9-B2_As-Built.dwg	

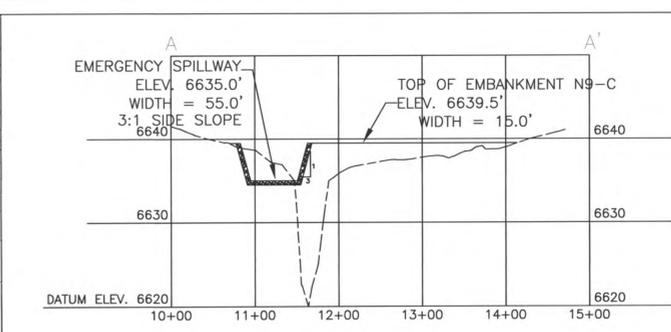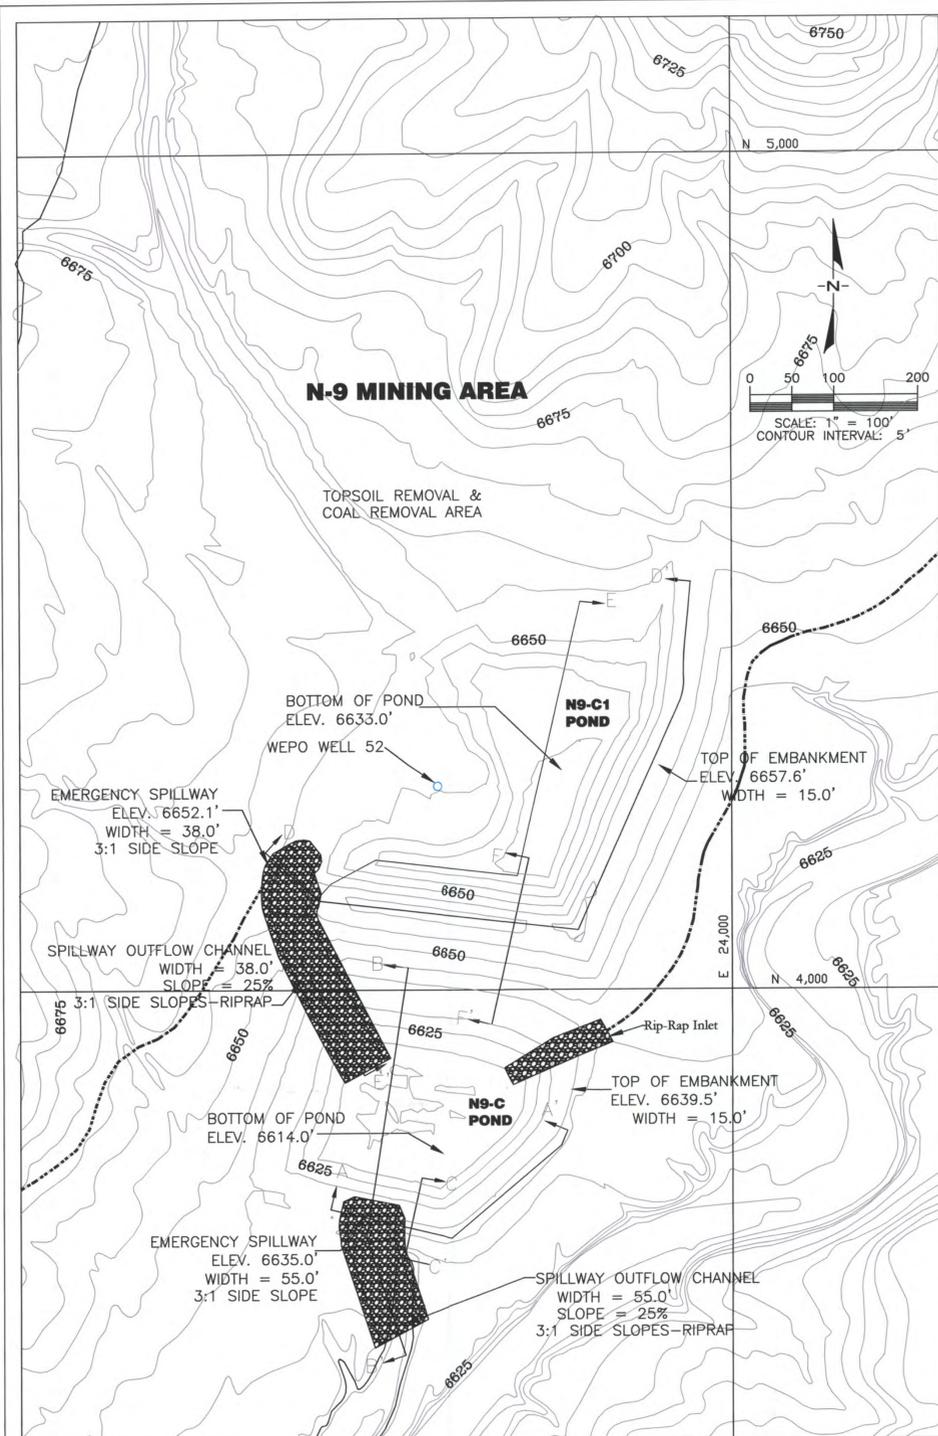


SECTION A - A'  
SCALE: HORIZ. 1" = 100'  
VERT. 1" = 10'

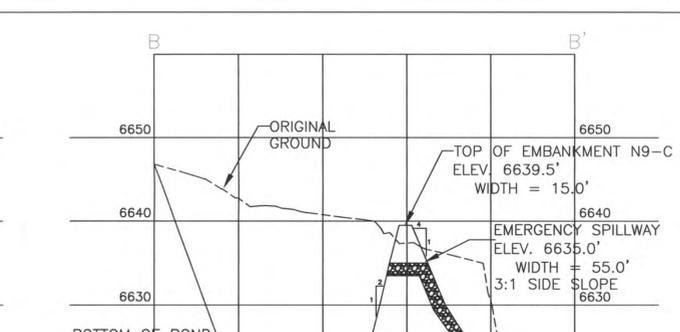


SECTION B - B'  
SCALE: HORIZ. 1" = 100'  
VERT. 1" = 10'

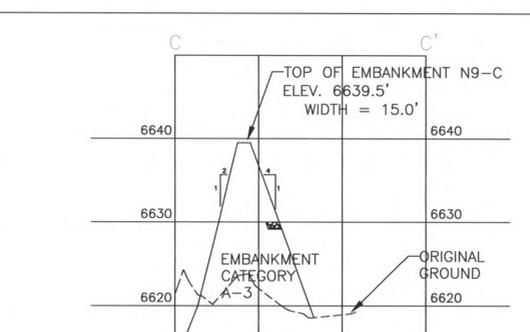


SECTION C - C'  
SCALE: HORIZ. 1" = 100'  
VERT. 1" = 10'

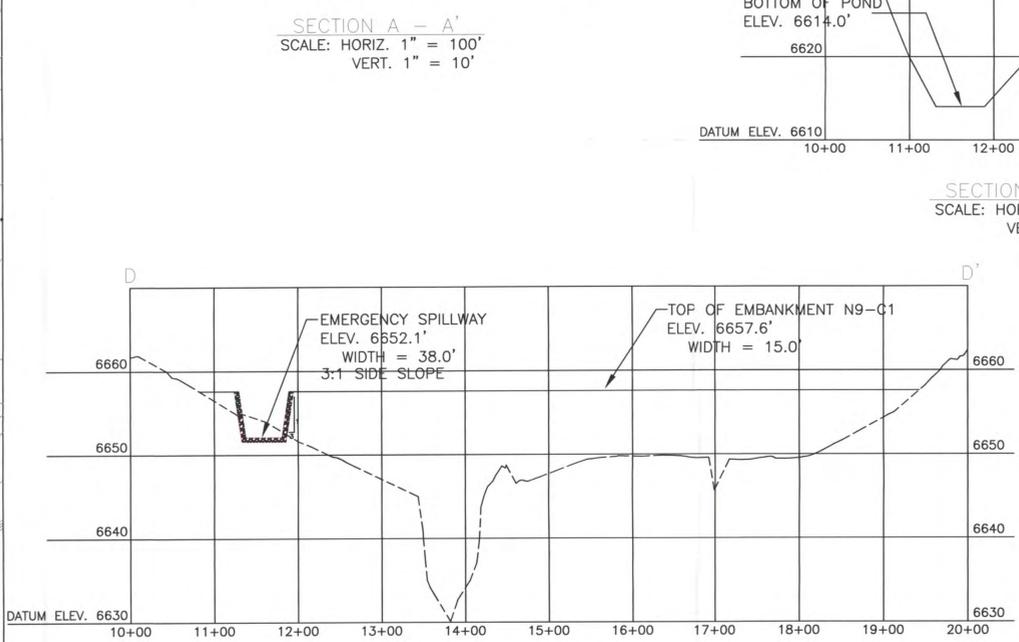

SECTION D - D'  
SCALE: HORIZ. 1" = 100'  
VERT. 1" = 10'

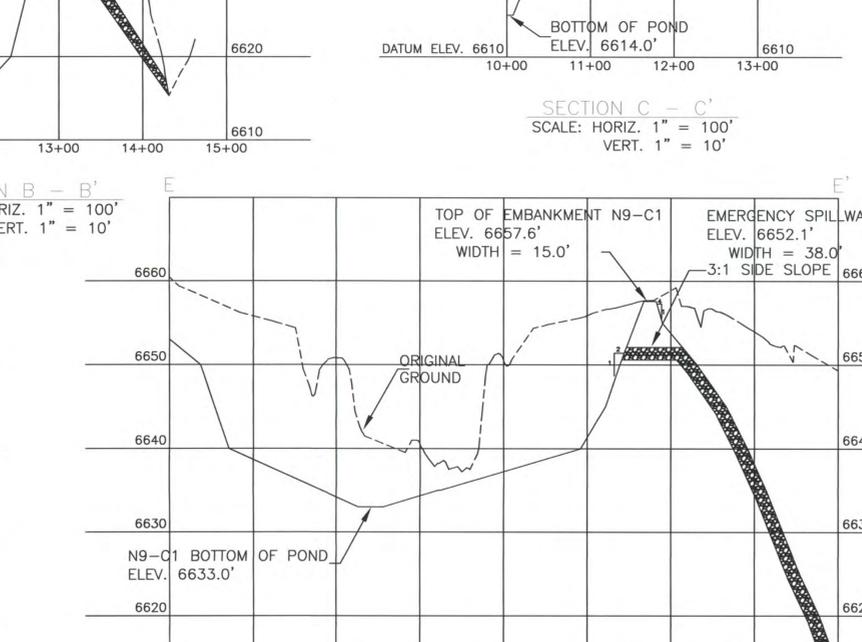

SECTION E - E'  
SCALE: HORIZ. 1" = 100'  
VERT. 1" = 10'

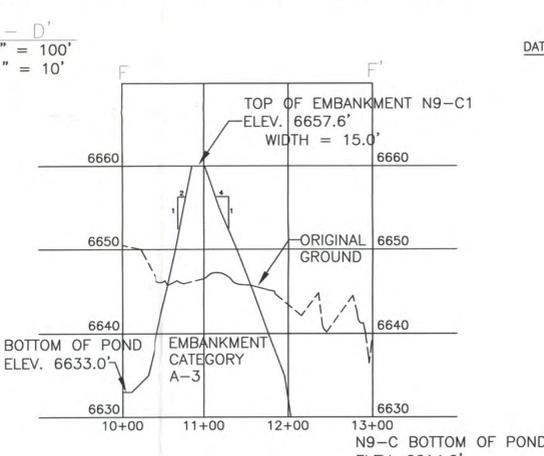

SECTION F - F'  
SCALE: HORIZ. 1" = 100'  
VERT. 1" = 10'

**LEGEND**



- Rip-Rap
- Temporary Diversion

I CERTIFY IN ACCORDANCE WITH THE REQUIREMENTS OF 30 CFR 750.16 AND 816.46(b)(3) THAT THE SILTATION CONTROL STRUCTURE WAS CONSTRUCTED AS DESIGNED BY PEABODY WESTERN COAL CO. AND AS APPROVED BY THE OFFICE OF SURFACE MINING, WITH THE EXCEPTIONS OF CERTAIN DIFFERENCES THAT ARE LISTED BELOW:

- POND STAGE CAPACITY TABLE
- PONDING AREA SHAPE
- ELEVATIONS & DIMENSIONS REFLECTED ON THE DRAWING
- SPILLWAY WIDTH IS WIDER THAN DESIGN

**ENGINEER'S CERTIFICATION**  
 JAMES G. SCHLENOVOT  
 ENGINEERING SUPERVISOR  
 PEABODY WESTERN COAL COMPANY

ARIZONA P.E. #18782  
 DATE: NOV 03 2006

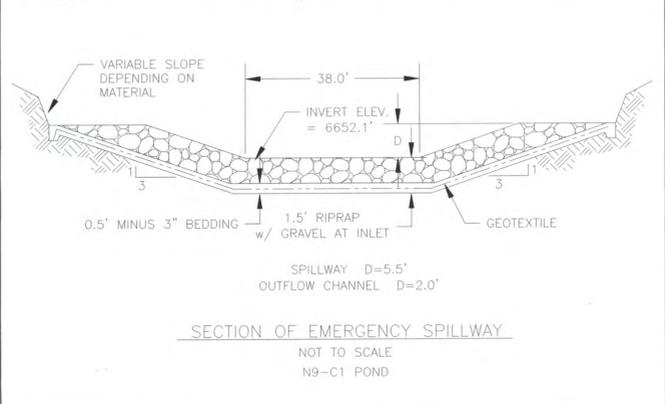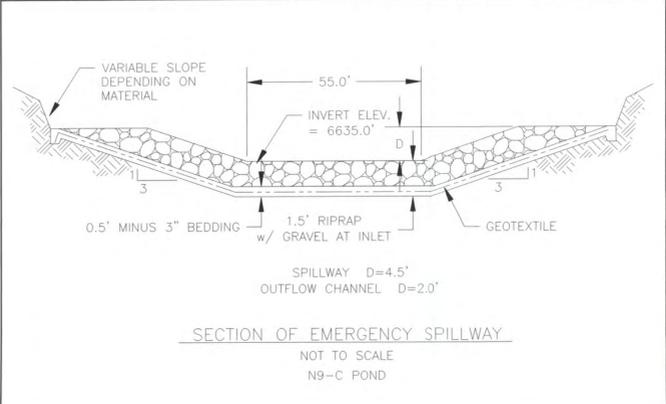

**N9-C1 POND STAGE CAPACITY TABLE**

ELEVATION (ft-msl)	STAGE (ft)	AREA (acres)	TOTAL CAPACITY (ac-ft)	DESCRIPTION
6633.0	0.0	0.00	0.00	BOTTOM OF POND
6640.0	7.0	0.80	2.75	
6645.0	12.0	1.24	7.85	INCISED ELEV.
6650.0	17.0	1.80	15.26	
6652.1	19.1	2.27	19.50	EMERGENCY SPILLWAY
6655.0	22.0	2.99	27.05	
6657.6	24.6	3.74	35.76	TOP OF EMBANKMENT



**N9-C POND STAGE CAPACITY TABLE**

ELEVATION (ft-msl)	STAGE (ft)	AREA (acres)	TOTAL CAPACITY (ac-ft)	DESCRIPTION
6614.0	0.0	0.00	0.00	BOTTOM OF POND
6615.0	1.0	0.24	0.15	
6620.0	6.0	0.66	2.68	
6625.0	11.0	0.95	6.68	INCISED ELEV.
6630.0	16.0	1.31	12.34	
6635.0	21.0	1.66	19.73	EMERGENCY SPILLWAY
6639.5	25.5	2.02	28.0	TOP OF EMBANKMENT

**REVISIONS**

CHECKED BY	DATE	DESCRIPTION
J. Schlenovot	10-24-2006	OSM Response - Rip-Rap Inlet

**N9-C & N9-C1 (2005) TEMPORARY SEDIMENTATION POND AS-BUILT**  
 KAYENTA MINE  
 PEABODY WESTERN COAL COMPANY  
 P. O. BOX 650 KAYENTA, ARIZONA 86033  
 DESIGNED BY: GA SCALE: AS NOTED  
 DRAWN BY: M. Becenti (PWCC) DRAWING DATE: 12-01-05  
 CHECKED BY: JGS (PWCC) PHOTO DATE: 05-83  
 CONTOUR INTERVAL: 5 FT. PLOT DATE: 10-31-06  
 DWG FILE: 120605\_POND-C\_C1\_As-Built.dwg

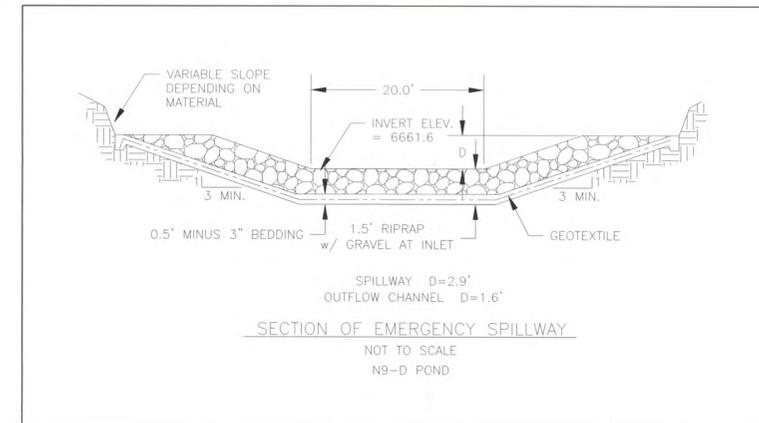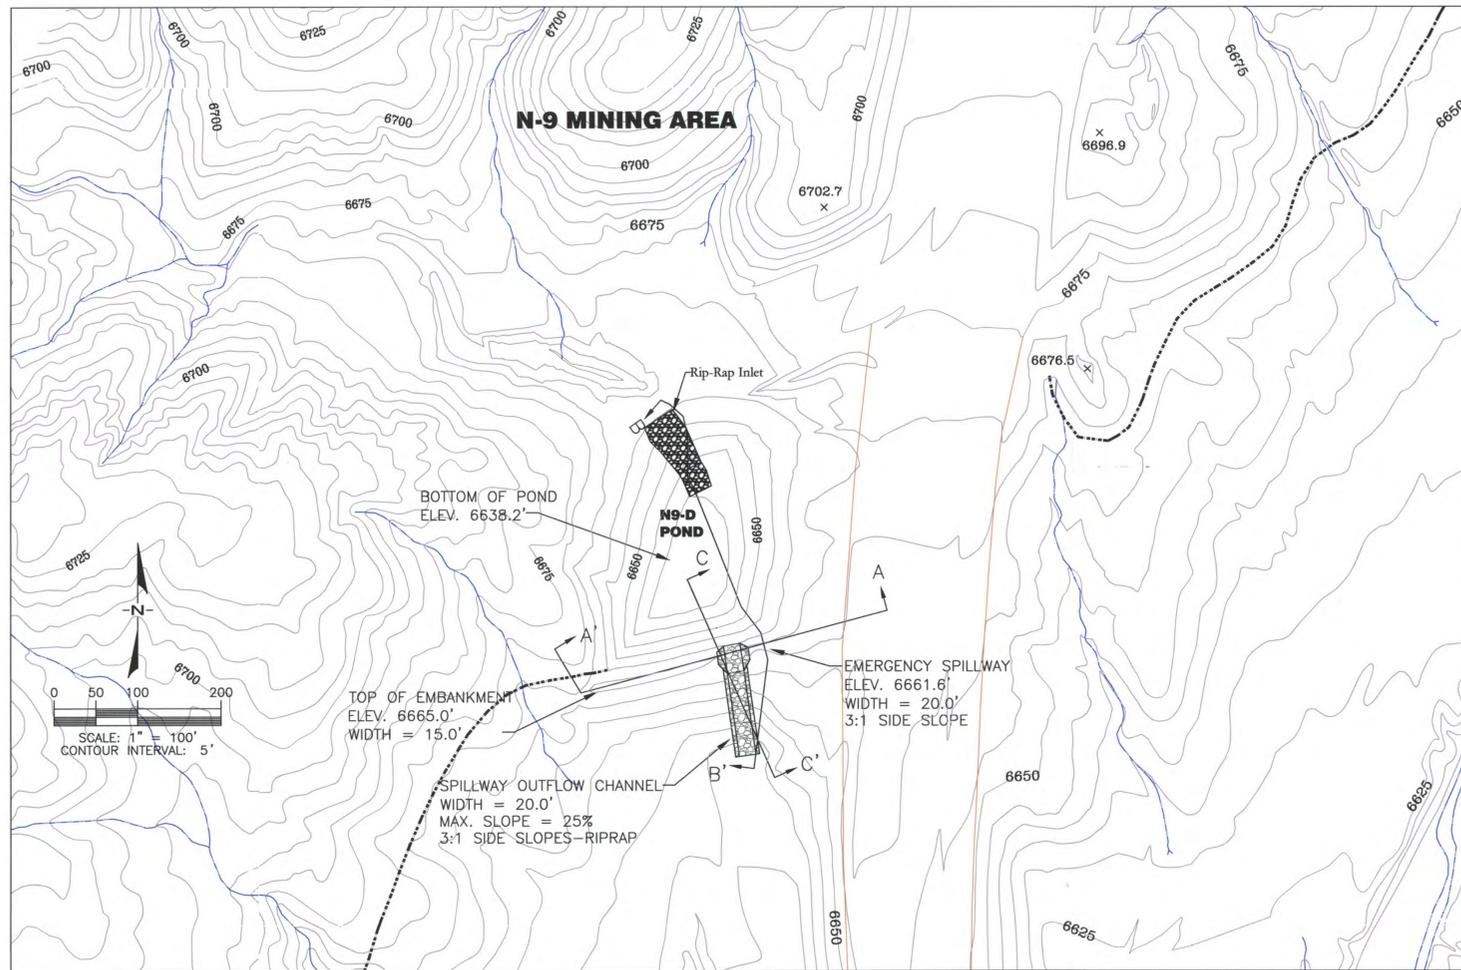

I CERTIFY IN ACCORDANCE WITH THE REQUIREMENTS OF 30 CFR 750.16 AND 816.46(b)(3) THAT THE SILTATION CONTROL STRUCTURE WAS CONSTRUCTED AS DESIGNED BY PEABODY WESTERN COAL CO. AND AS APPROVED BY THE OFFICE OF SURFACE MINING, WITH THE EXCEPTIONS OF CERTAIN DIFFERENCES THAT ARE LISTED BELOW:

1. POND STAGE CAPACITY TABLE
2. PONDING AREA SHAPE
3. ELEVATIONS & DIMENSIONS REFLECTED ON THE DRAWING




**ENGINEER'S CERTIFICATION**

*J. Schlenvogt*  
  
**JAMES G. SCHLENOVGT**  
 ENGINEERING SUPERVISOR

ARIZONA P.E. #18782

PEABODY WESTERN COAL COMPANY

DATE: NOV 03 2006

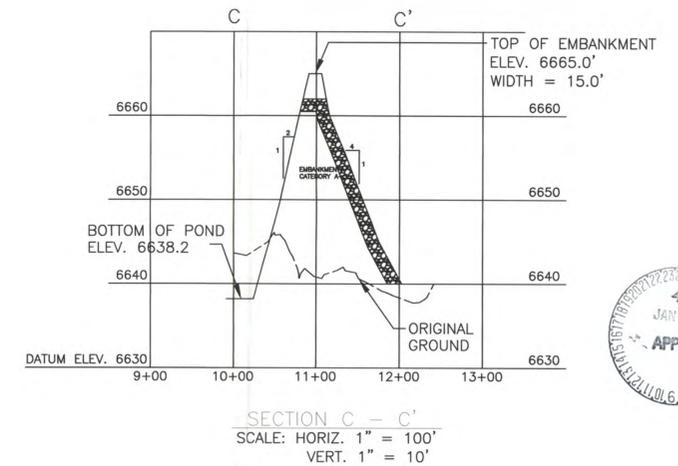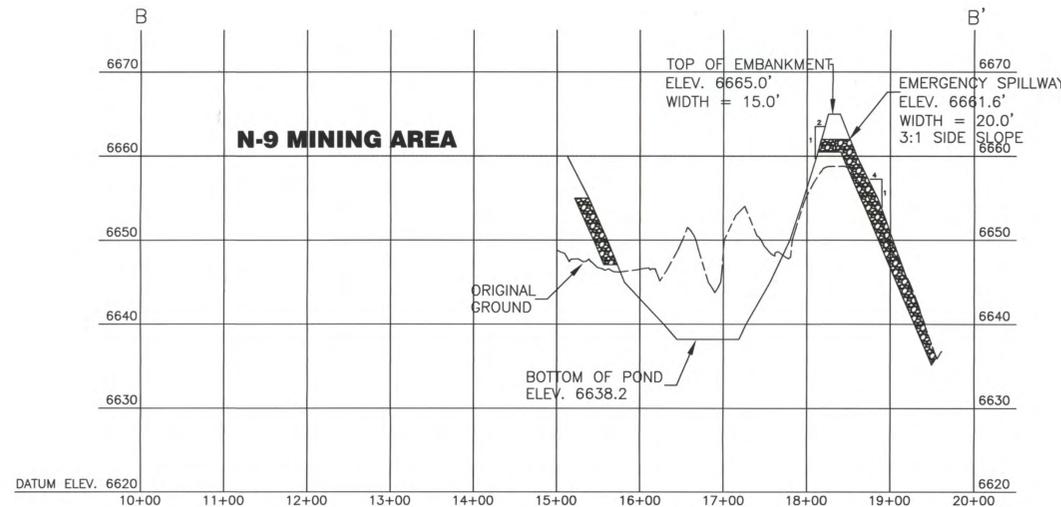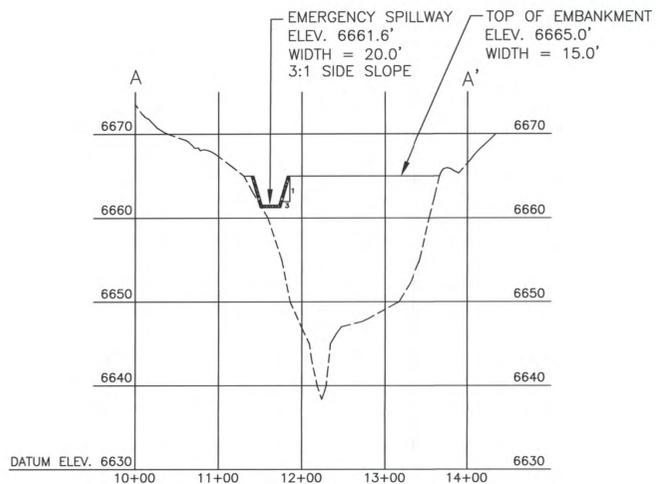

**N9-D POND STAGE CAPACITY TABLE**

ELEVATION (ft-msl)	STAGE (ft)	AREA (acres)	TOTAL CAPACITY (ac-ft)	DESCRIPTION
6638.2	0.0	0.00	0.00	BOTTOM OF POND
6645.0	6.8	0.43	1.77	INCISED ELEV.
6650.0	11.8	0.68	4.54	
6655.0	16.8	0.98	8.65	
6660.0	21.8	1.52	14.81	
6661.6	23.4	1.73	17.35	EMERGENCY SPILLWAY
6665.0	26.8	2.26	24.51	TOP OF EMBANKMENT

**REVISIONS**

CHECKED	DATE	DESCRIPTION
J. Schlenvogt	10-24-2006	OSM Response - Rip-Rap Inlet



**N9-D (2005) SEDIMENTATION POND AS-BUILT**

**KAYENTA MINE**  
 PEABODY WESTERN COAL COMPANY  
 P. O. BOX 650 KAYENTA, ARIZONA 86033

DESIGNED BY: GA SCALE: AS NOTED  
 DRAWN BY: M. Becenti DRAWING DATE: 11-16-05  
 CHECKED BY: JGS PHOTO DATE: 05-83  
 CONTOUR INTERVAL: 5 FT. PLOT DATE: 10-31-2006  
 DWG FILE: 111605\_POND N9-D\_AsBuilt.DWG

**LEGEND**


- Rip-Rap
- Temporary Diversion
- Drainage Channel
- N9-Primary Road


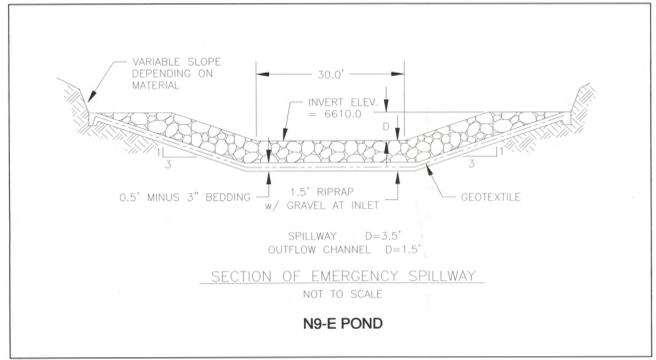
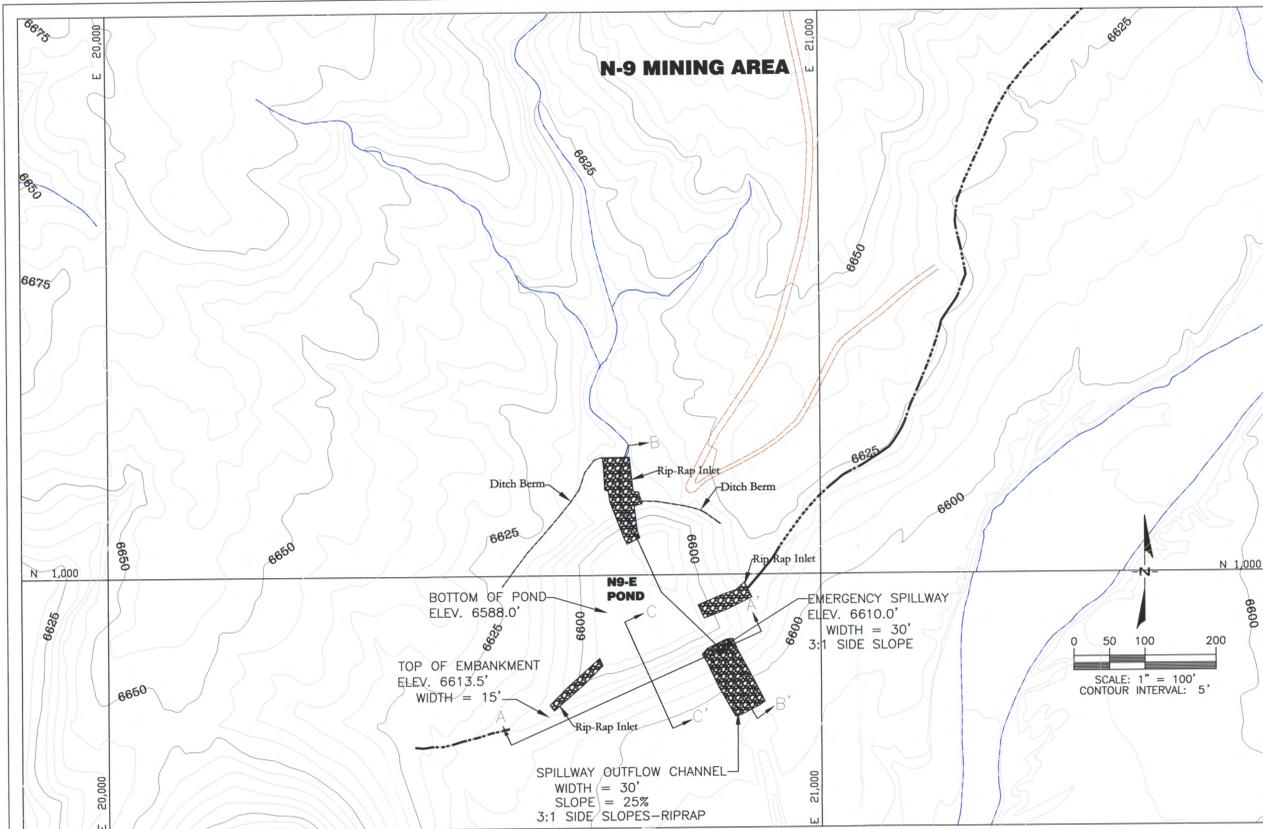


I CERTIFY IN ACCORDANCE WITH THE REQUIREMENTS OF 30 CFR 750.16 AND 816.46(b)(3) THAT THE SILTATION CONTROL STRUCTURE WAS CONSTRUCTED AS DESIGNED BY PEABODY WESTERN COAL CO. AND AS APPROVED BY THE OFFICE OF SURFACE MINING, WITH THE EXCEPTIONS OF CERTAIN DIFFERENCES THAT ARE LISTED BELOW:

1. POND STAGE CAPACITY TABLE
2. PONDING AREA SHAPE
3. ELEVATIONS & DIMENSIONS REFLECTED ON THE DRAWING
4. SPILLWAY WIDTH IS WIDER THAN DESIGN

**ENGINEER'S CERTIFICATION**

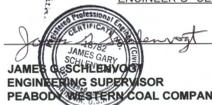
 ARIZONA P.E. #18782  
 DATE: **NOV 03 2006**

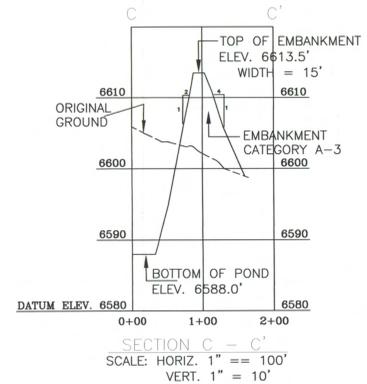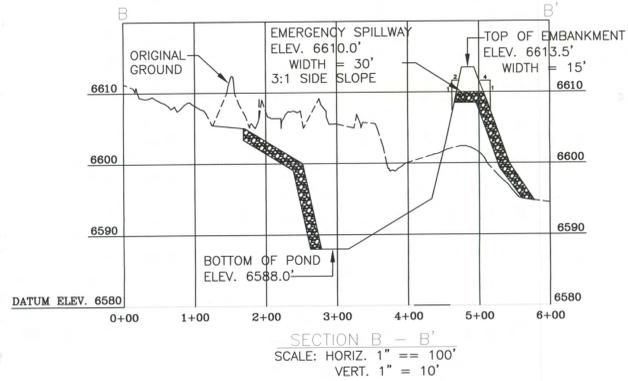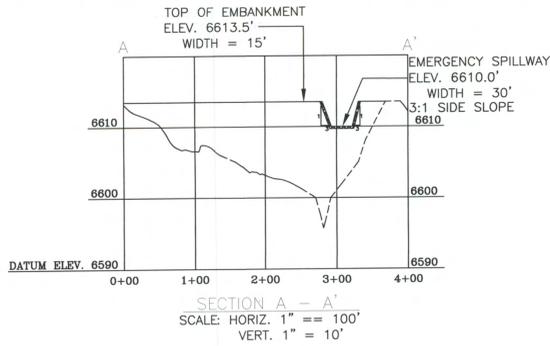

**N9-E POND STAGE CAPACITY TABLE**

ELEVATION (ft-msl)	STAGE (ft)	AREA (acres)	TOTAL CAPACITY (ac-ft)	DESCRIPTION
6588.0	0.0	0.00	0.00	BOTTOM OF POND
6590.0	2.0	0.09	0.07	
6595.0	7.0	0.52	1.74	
6600.0	12.0	0.75	4.89	INCISED ELEV.
6605.0	17.0	1.02	9.28	
6610.0	22.0	1.52	15.58	EMERGENCY SPILLWAY
6613.5	25.5	1.97	21.66	TOP OF EMBANKMENT

**LEGEND**

-  Rip-Rap
-  Temporary Diversion
-  Drainage Channel
-  1D Ancillary Road


**REVISIONS**

CHECKED	DATE	DESCRIPTION
J. Schluers	10-24-2006	OSM Response - Rip-Rap Inlet

**N9-E (2006)  
SEDIMENTATION POND  
AS-BUILT**



KAYENTA MINE  
PEABODY WESTERN COAL COMPANY  
P. O. BOX 650 KAYENTA, ARIZONA 86033

DESIGNED BY: GA SCALE: AS NOTED  
 DRAWN BY: M. Becenti (PWCC) DRAWING DATE: 1-12-06  
 CHECKED BY: JGS PHOTO DATE: 05-83  
 CONTOUR INTERVAL: 5 FT. PLOT DATE: 10-31-2006  
 DWG FILE: 011306\_N9E\_Pond\_As\_Built.dwg

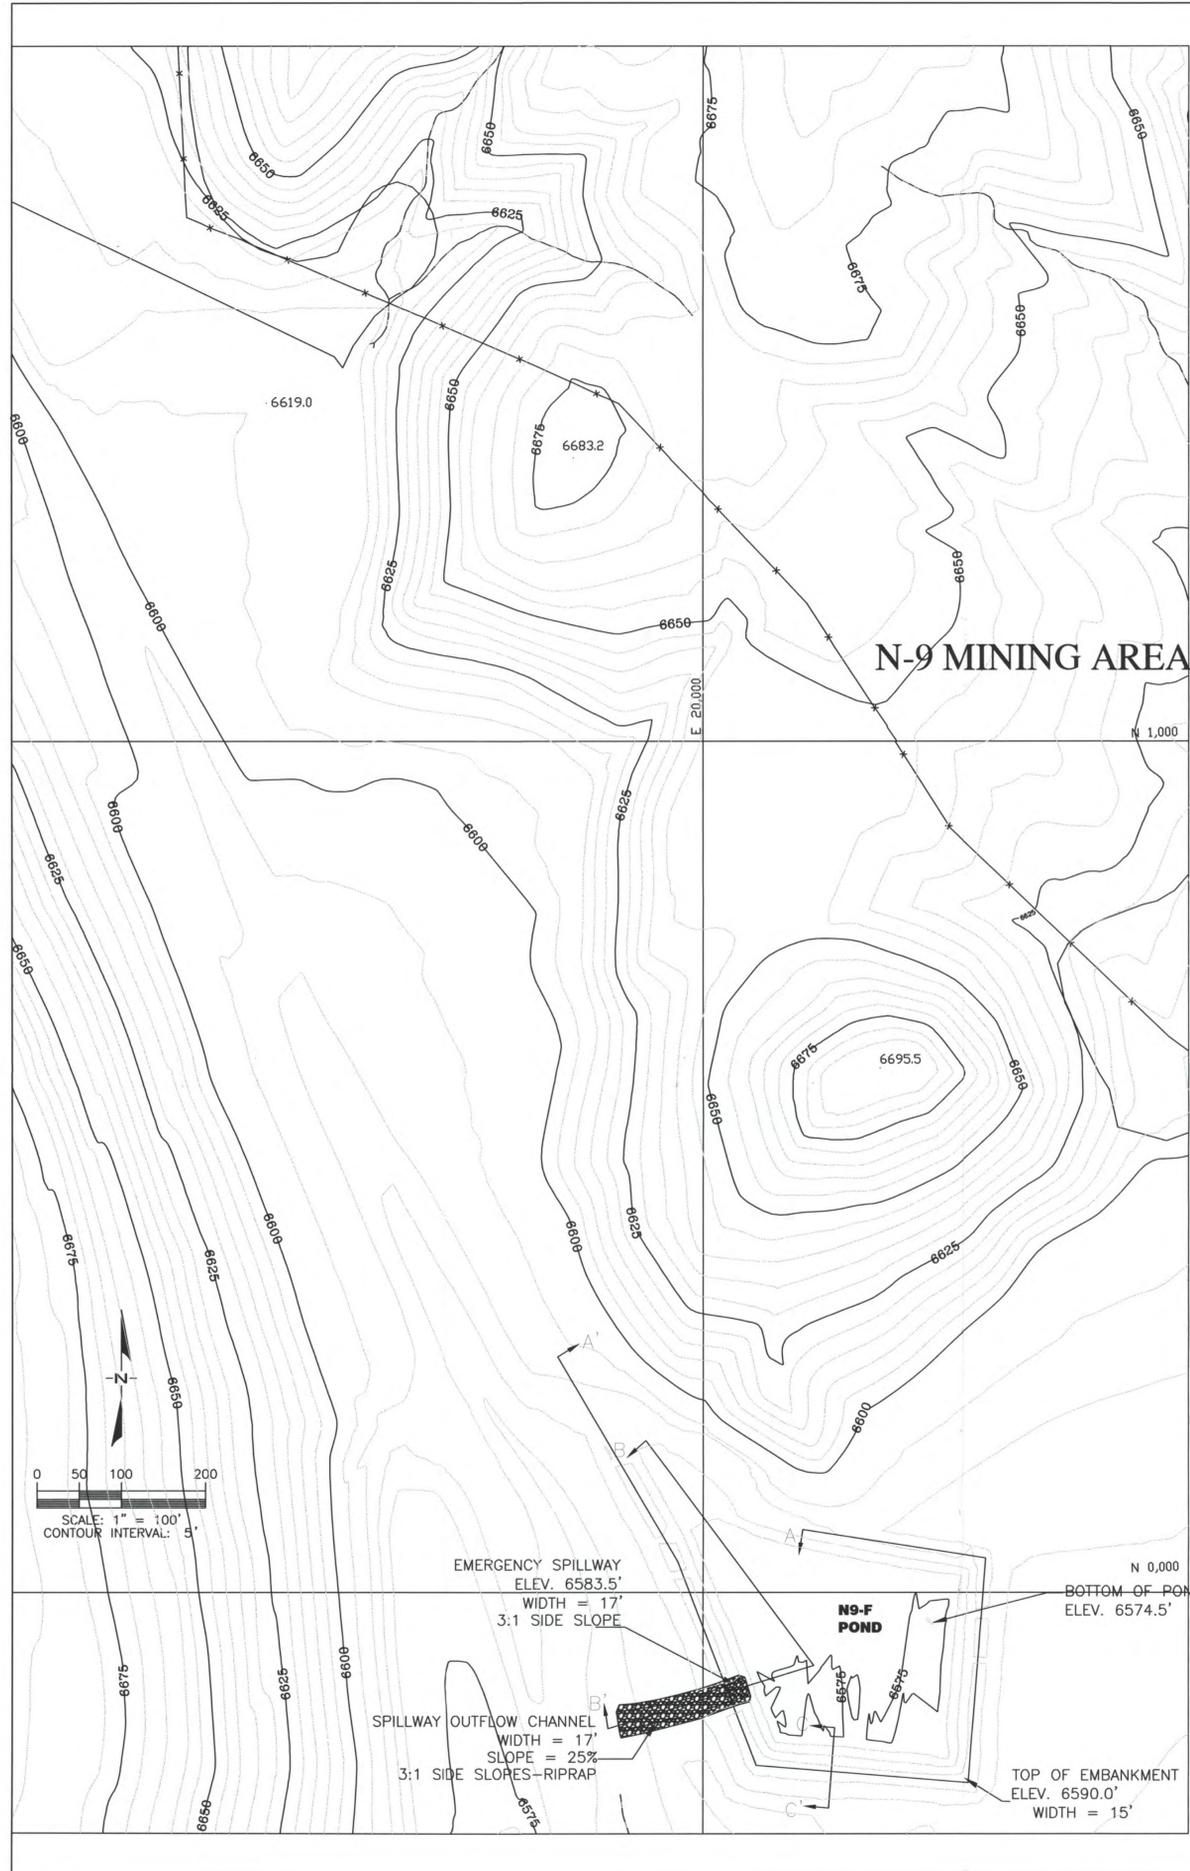


N9-F POND STAGE CAPACITY TABLE


ELEVATION (ft-msl)	STAGE (ft)	AREA (acres)	TOTAL CAPACITY (ac-ft)	DESCRIPTION
6574.5	0.0	0.00	0.00	BOTTOM OF POND
6575.0	0.5	0.33	0.06	
6580.0	5.5	1.37	5.53	
6583.5	9.0	1.64	10.78	EMERGENCY SPILLWAY
6585.0	10.5	1.78	13.35	INCISED ELEV.
6590.0	15.5	2.36	23.57	TOP OF EMBANKMENT

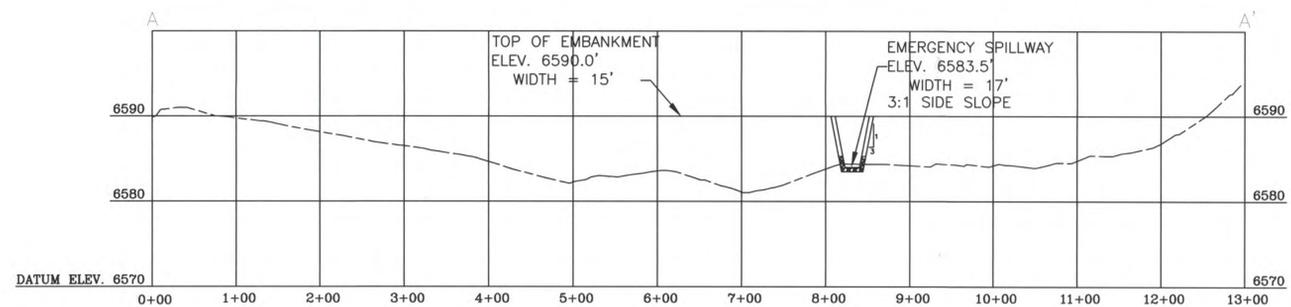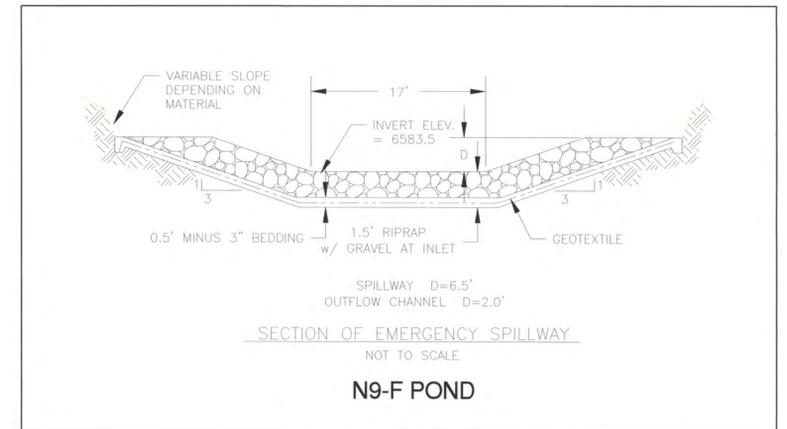

SECTION A - A'  
SCALE: HORIZ. 1" = 100'  
VERT. 1" = 10'

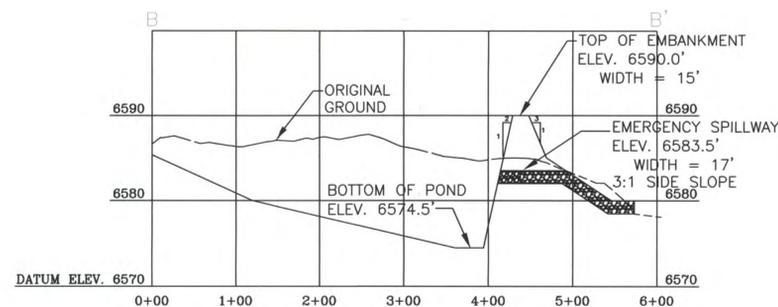

SECTION B - B'  
SCALE: HORIZ. 1" = 100'  
VERT. 1" = 10'

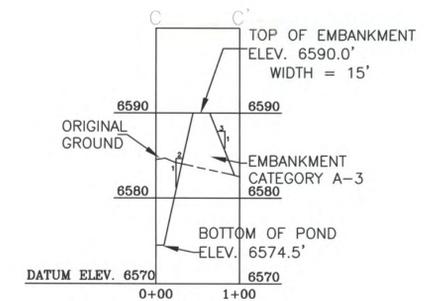

SECTION C - C'  
SCALE: HORIZ. 1" = 100'  
VERT. 1" = 10'



I CERTIFY IN ACCORDANCE WITH THE REQUIREMENTS OF 30 CFR 750.16 AND 816.46(b)(3) THAT THE SILTATION CONTROL STRUCTURE WAS CONSTRUCTED AS DESIGNED BY PEABODY WESTERN COAL CO. AND AS APPROVED BY THE OFFICE OF SURFACE MINING, WITH THE EXCEPTIONS OF CERTAIN DIFFERENCES THAT ARE LISTED BELOW:

1. POND STAGE CAPACITY TABLE
2. PONDING AREA SHAPE
3. ELEVATIONS & DIMENSIONS REFLECTED ON THE DRAWING
4. SPILLWAY WIDTH IS WIDER THAN DESIGN


ENGINEER'S CERTIFICATION  
 18782  
 JAMES GARY SCHWARTZ  
 JAMES G. SCHWARTZ  
 ENGINEERING SUPERVISOR  
 PEABODY WESTERN COAL COMPANY  
 ARIZONA P.E. #18782  
 DATE: DEC 29 2005




N9-F (2005) SEDIMENTATION POND AS-BUILT	
KAYENTA MINE PEABODY WESTERN COAL COMPANY P. O. BOX 650 KAYENTA, ARIZONA 86033	
DESIGNED BY: CA	SCALE: AS NOTED
DRAWN BY: M.Beconti (PWCC)	DRAWING DATE: 12-20-05
CHECKED BY: JGS	PHOTO DATE: 05-83
CONTOUR INTERVAL: 5 FT.	

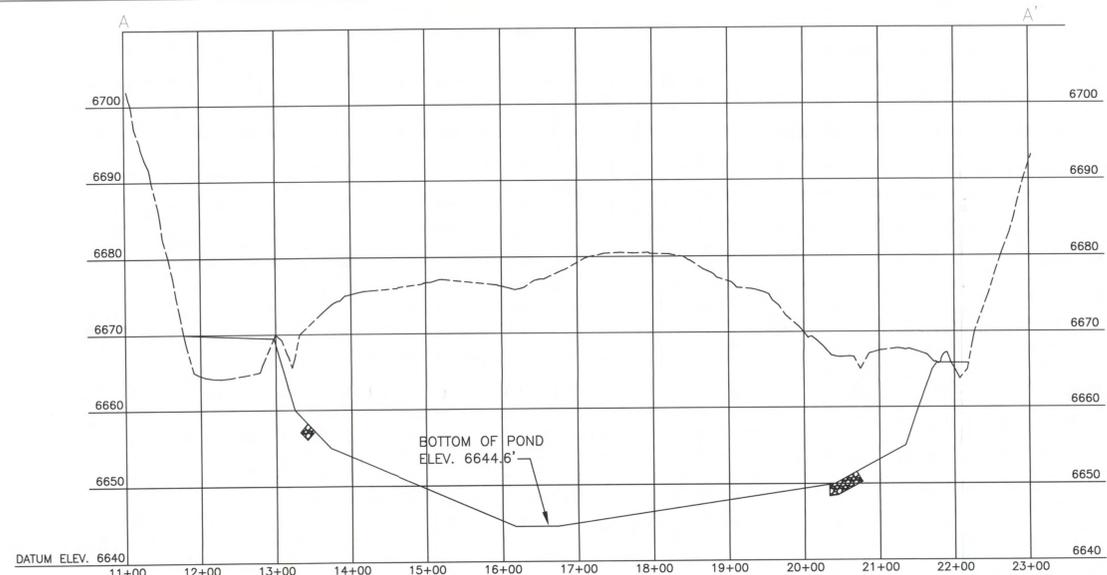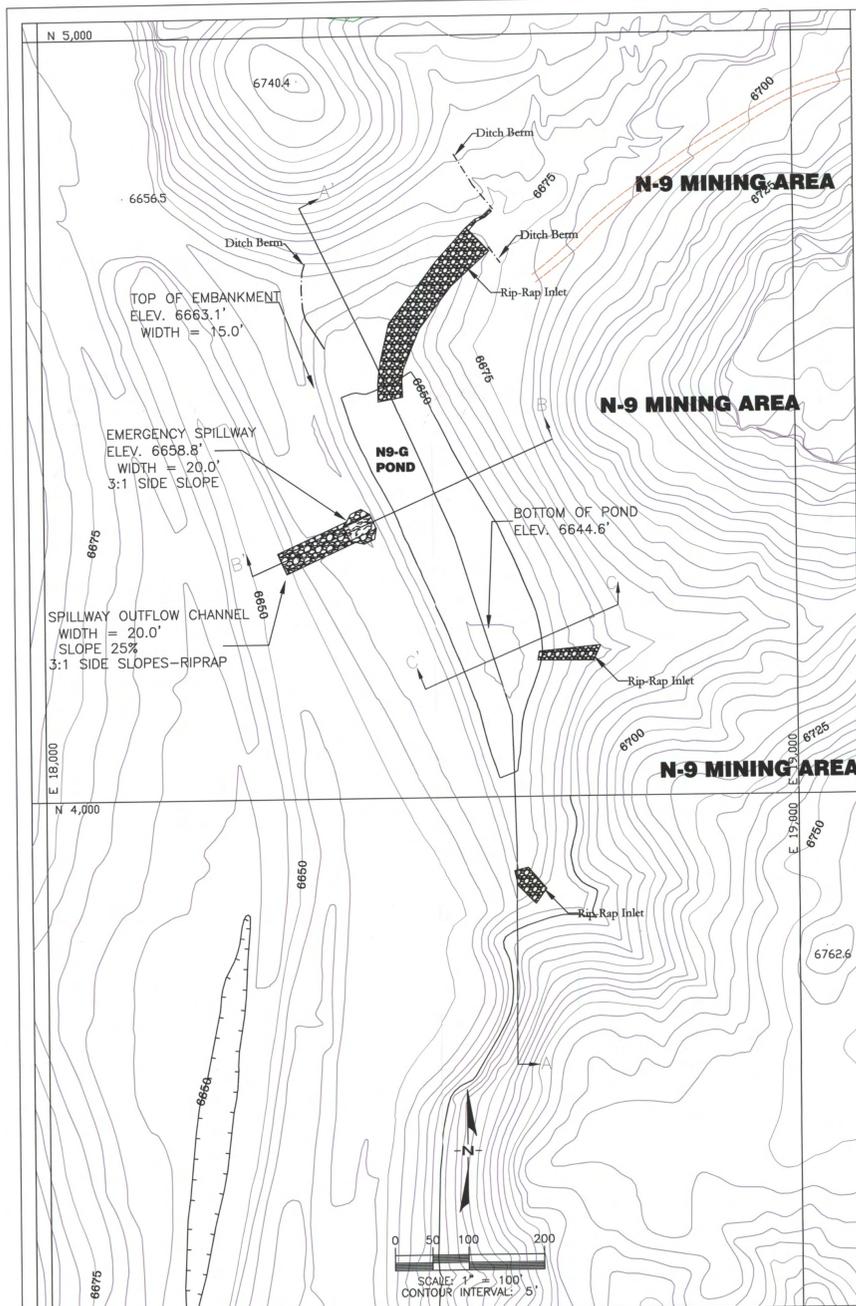

SECTION A - A'  
SCALE: HORIZ. 1" = 100'  
VERT. 1" = 10'

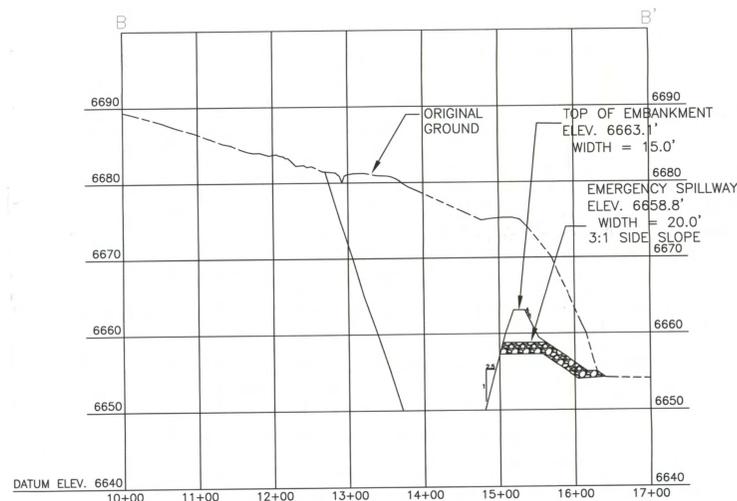

SECTION B - B'  
SCALE: HORIZ. 1" = 100'  
VERT. 1" = 10'

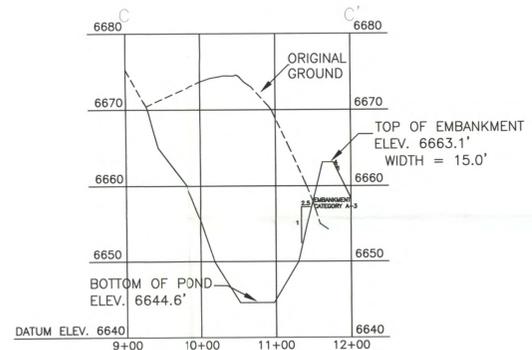

SECTION C - C'  
SCALE: HORIZ. 1" = 100'  
VERT. 1" = 10'



**LEGEND**

- Rip-Rap
- Ditch Berm
- 1D Ancillary Road

**REVISIONS**

CHECKED	DATE	DESCRIPTION
J. Schlenvogt	10/24/2006	OSM Response - Rip-Rap Inlet

**N9-G (2005)  
SEDIMENTATION POND  
AS-BUILT**

KAYENTA MINE  
PEABODY WESTERN COAL COMPANY  
P. O. BOX 650 KAYENTA, ARIZONA 86033

DESIGNED BY: GA	SCALE: AS NOTED
DRAWN BY: M. Becenti	DRAWING DATE: 11-17-05
CHECKED BY: JGS	PHOTO DATE: 05-83
CONTOUR INTERVAL: 5 FT.	PLOT DATE: 10-31-2006
DWG FILE: 111605_POND N9-G_AsBuilt_revised	

N9-G POND STAGE CAPACITY TABLE


ELEVATION (ft-msl)	STAGE (ft)	AREA (acres)	TOTAL CAPACITY (ac-ft)	DESCRIPTION
6644.6	0.0	0.00	0.00	BOTTOM OF POND
6645.0	0.4	0.12	0.02	INCISED ELEV.
6650.0	5.4	1.15	3.49	
6655.0	10.4	1.80	10.79	
6658.8	14.2	2.60	19.45	EMERGENCY SPILLWAY
6660.0	15.4	2.72	22.65	
6663.1	18.5	3.47	32.05	TOP OF EMBANKMENT



I CERTIFY IN ACCORDANCE WITH THE REQUIREMENTS OF 30 CFR 750.16 AND 816.46(b)(3) THAT THE SILTATION CONTROL STRUCTURE WAS CONSTRUCTED AS DESIGNED BY PEABODY WESTERN COAL CO. AND AS APPROVED BY THE OFFICE OF SURFACE MINING, WITH THE EXCEPTIONS OF CERTAIN DIFFERENCES THAT ARE LISTED BELOW:

1. POND STAGE CAPACITY TABLE
2. PONDING AREA SHAPE
3. ELEVATIONS & DIMENSIONS REFLECTED ON THE DRAWING
4. SPILLWAY LOCATION

**JAMES G. SCHLENOVOT**  
 ENGINEERING SUPERVISOR  
 PEABODY WESTERN COAL COMPANY

ARIZONA P.E. #18782  
 DATE: **NOV 03 2006**

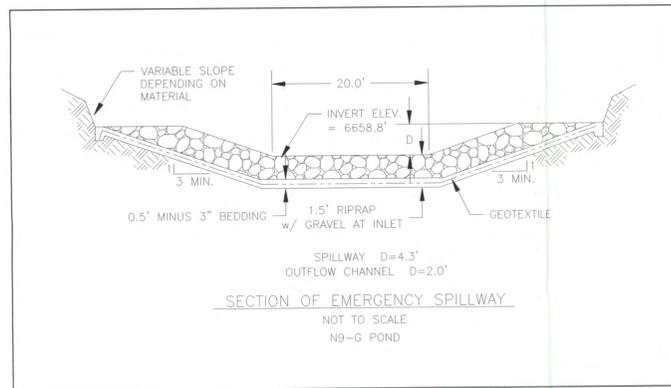


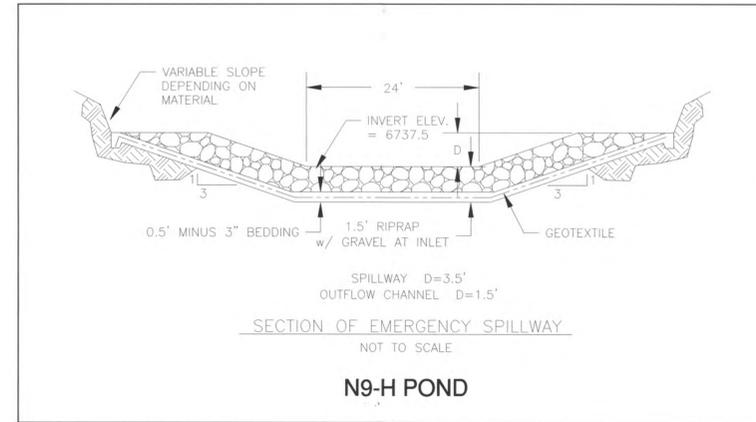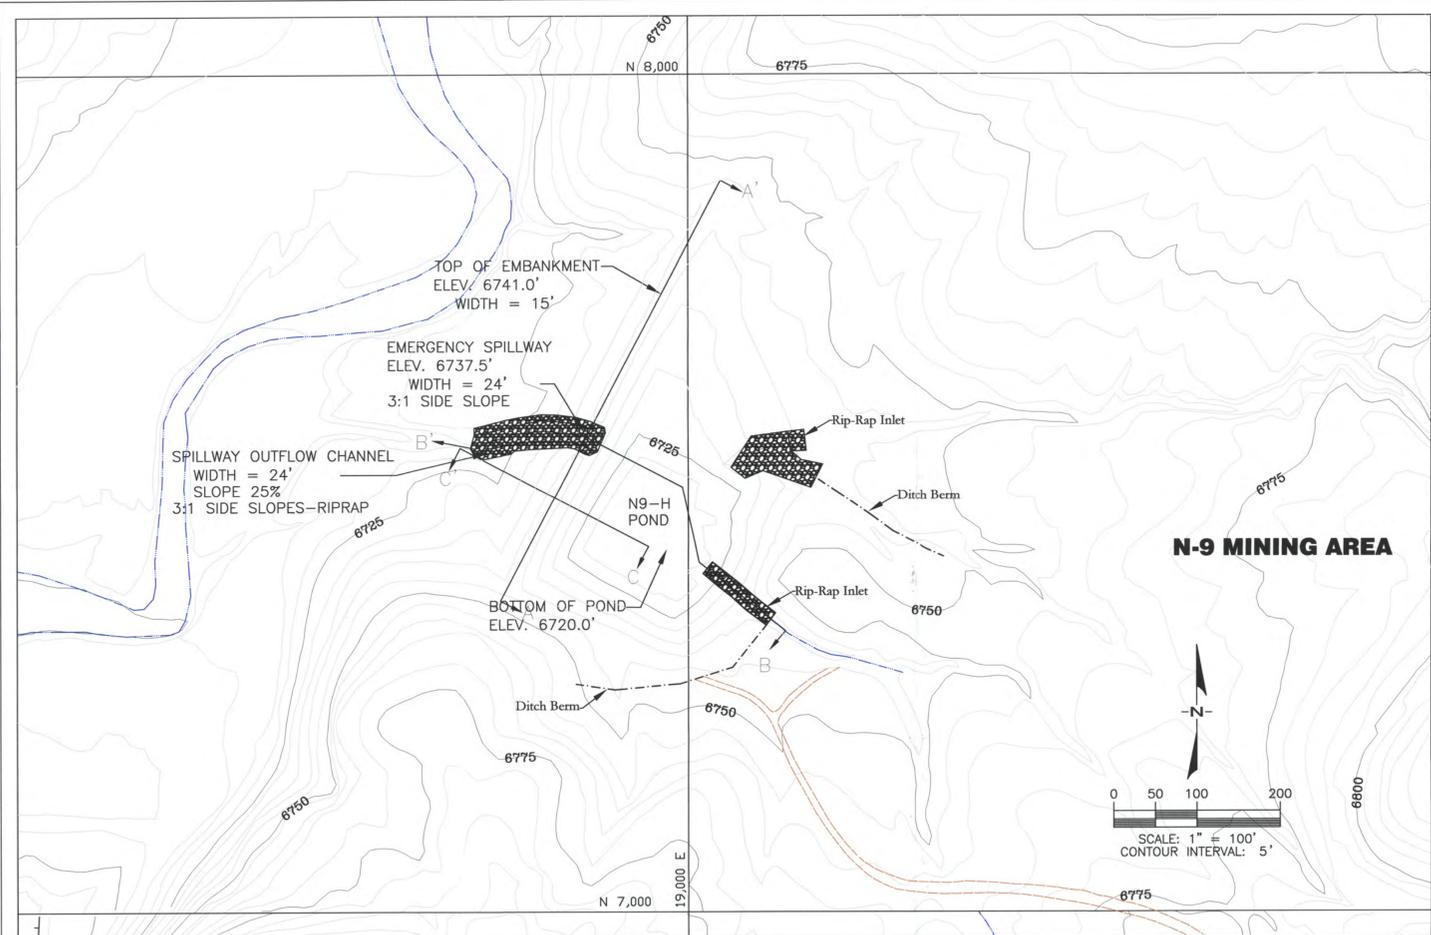


I CERTIFY IN ACCORDANCE WITH THE REQUIREMENTS OF 30 CFR 750.16 AND 816.46(b)(3) THAT THE SILTATION CONTROL STRUCTURE WAS CONSTRUCTED AS DESIGNED BY PEABODY WESTERN COAL CO. AND AS APPROVED BY THE OFFICE OF SURFACE MINING, WITH THE EXCEPTIONS OF CERTAIN DIFFERENCES THAT ARE LISTED BELOW:

1. POND STAGE CAPACITY TABLE
2. PONDING AREA SHAPE
3. ELEVATIONS & DIMENSIONS REFLECTED ON THE DRAWING
4. SPILLWAY WIDTH IS WIDER THAN DESIGN


ENGINEER'S CERTIFICATION  
  
**JAMES SCHLENOVGT**  
 ENGINEERING SUPERVISOR  
 PEABODY WESTERN COAL COMPANY  
 ARIZONA P.E. #18782  
 DATE: NOV 03 2006

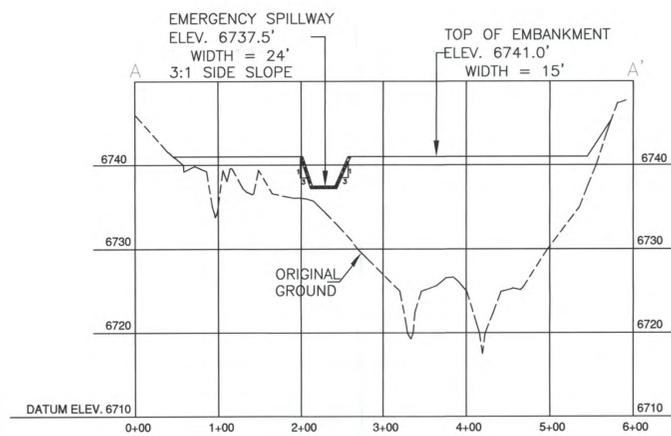

SECTION A - A'  
 SCALE: HORIZ. 1" = 100'  
 VERT. 1" = 10'

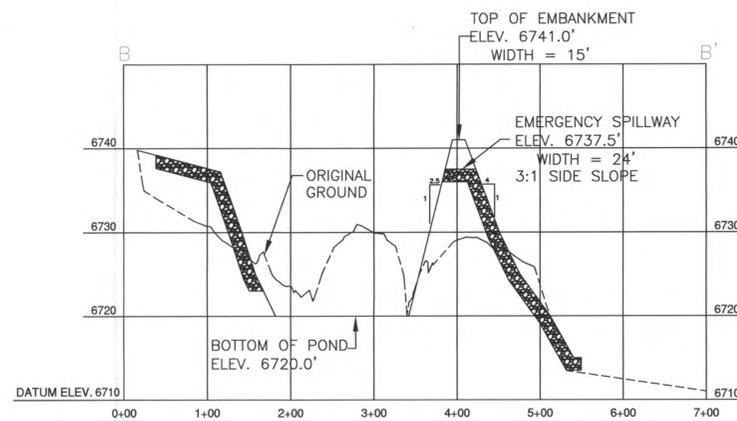

SECTION B - B'  
 SCALE: HORIZ. 1" = 100'  
 VERT. 1" = 10'

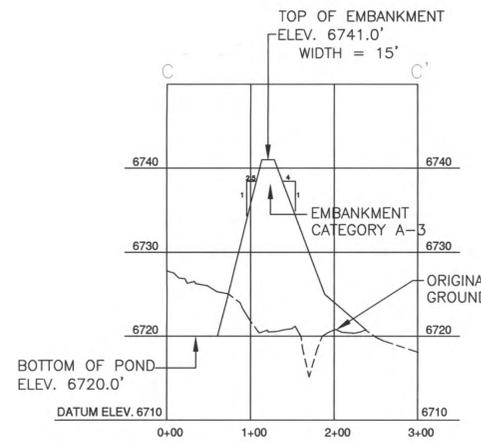

SECTION C - C'  
 SCALE: HORIZ. 1" = 100'  
 VERT. 1" = 10'

N9-H POND STAGE CAPACITY TABLE

ELEVATION (ft-msl)	STAGE (ft)	AREA (acres)	TOTAL CAPACITY (ac-ft)	DESCRIPTION
6720.0	0.0	0.40	0.00	BOTTOM OF POND
6725.0	5.0	0.64	2.61	INCISED ELEV.
6730.0	10.0	1.06	6.75	
6735.0	15.0	1.56	13.24	
6737.5	17.5	1.87	17.50	EMERGENCY SPILLWAY
6740.0	20.0	2.29	22.66	
6741.0	21.0	2.49	25.05	TOP OF EMBANKMENT

**LEGEND**

	Rip-Rap
	Ditch Berm
	Drainage Channel
	1D Ancillary Road






**REVISIONS**

CHECKED	DATE	DESCRIPTION
J. Schlenvogt	10-24-2006	OSM Response - Rip-Rap Inlet

**N9-H (2006)  
 SEDIMENTATION POND  
 AS-BUILT**

KAYENTA MINE  
 PEABODY WESTERN COAL COMPANY  
 P. O. BOX 650 KAYENTA, ARIZONA 86033  
 DESIGNED BY: GA SCALE: AS NOTED  
 DRAWN BY: M. Becenti (PWCC) DRAWING DATE: 1-16-06  
 CHECKED BY: JGS PHOTO DATE: 05-83  
 CONTOUR INTERVAL: 5 FT. PLOT DATE: 10-31-2006  
 DWG FILE: 012006\_N9-H-Pond\_As-Built.dwg



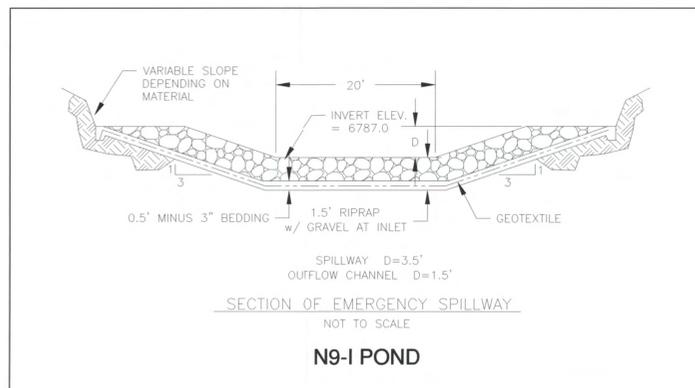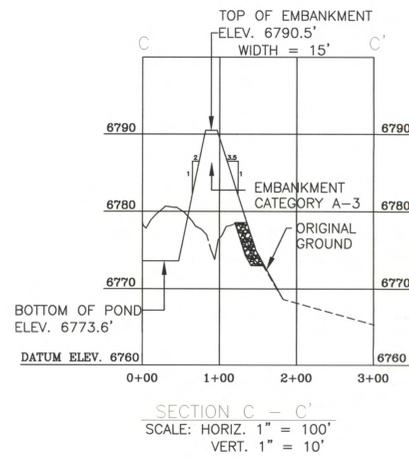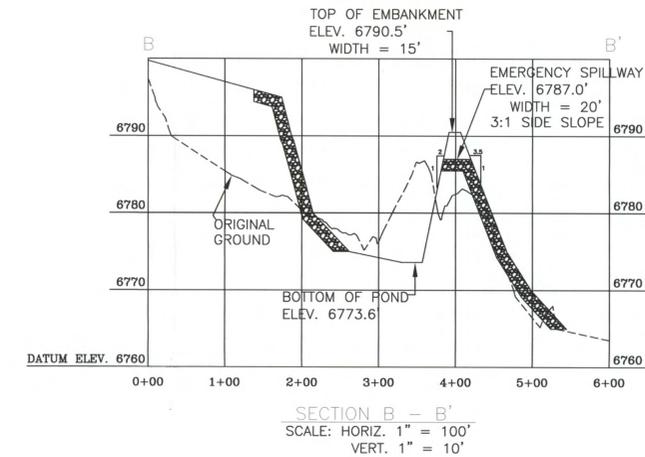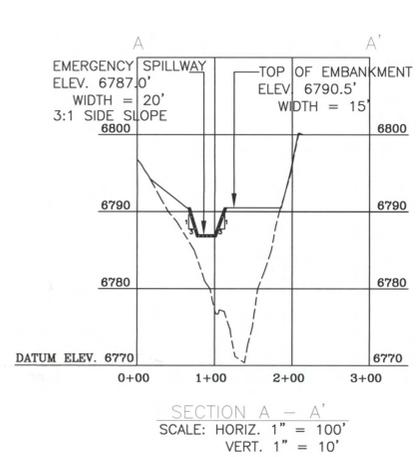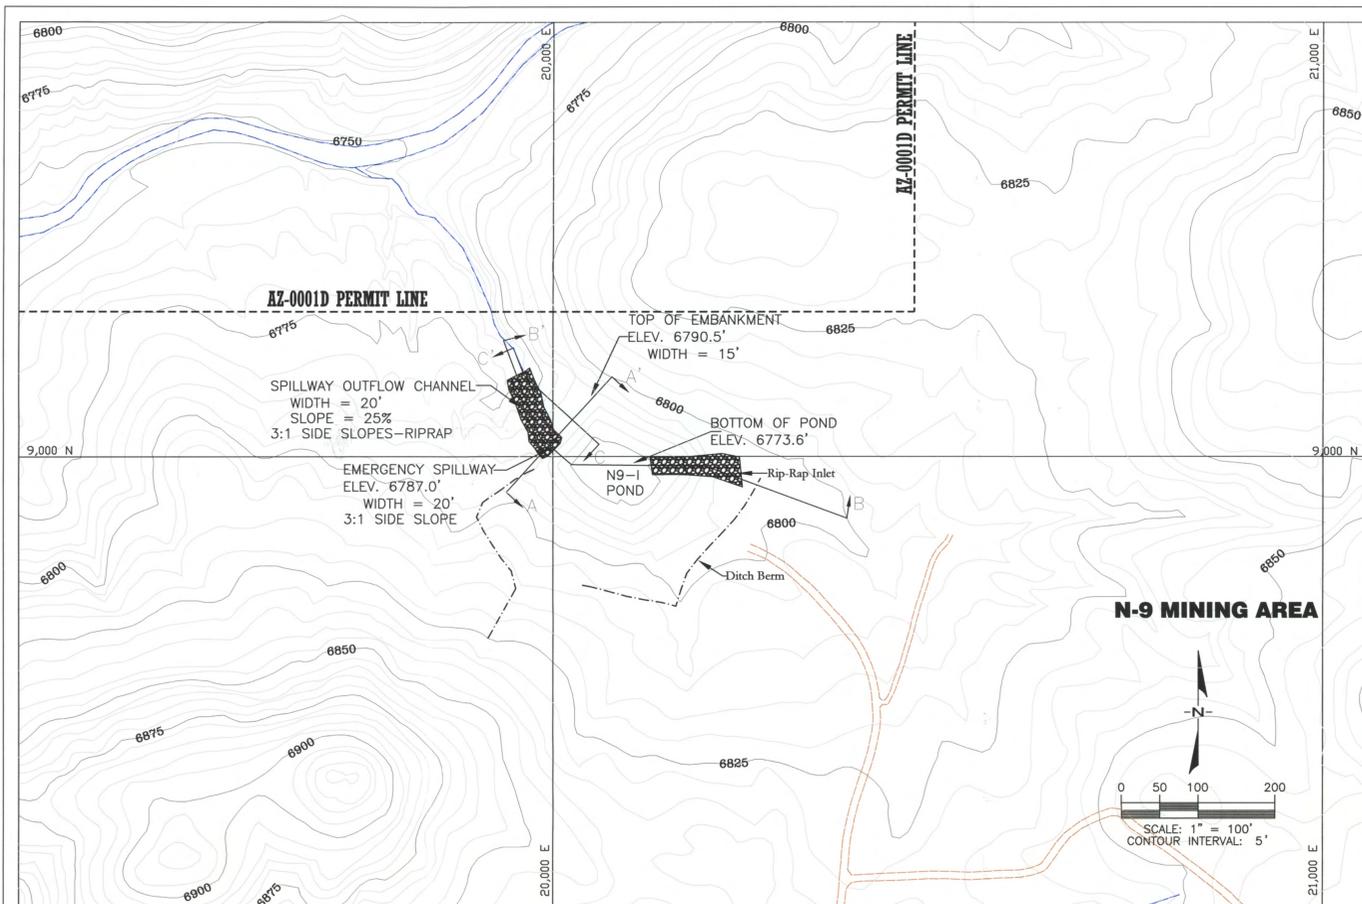

N9-I POND STAGE CAPACITY TABLE

ELEVATION (ft-msl)	STAGE (ft)	AREA (acres)	TOTAL CAPACITY (ac-ft)	DESCRIPTION
6773.6	0.0	0.00	0.00	BOTTOM OF POND
6775.0	1.4	0.15	0.08	
6780.0	6.4	0.29	1.19	INCISED ELEV.
6785.0	11.4	0.44	3.03	
6787.0	13.4	0.51	3.98	EMERGENCY SPILLWAY
6790.0	16.4	0.63	5.68	
6790.5	16.9	0.66	6.00	TOP OF EMBANKMENT

I CERTIFY IN ACCORDANCE WITH THE REQUIREMENTS OF 30 CFR 750.16 AND 816.46(b)(3) THAT THE SILTATION CONTROL STRUCTURE WAS CONSTRUCTED AS DESIGNED BY PEABODY WESTERN COAL CO. AND AS APPROVED BY THE OFFICE OF SURFACE MINING, WITH THE EXCEPTIONS OF CERTAIN DIFFERENCES THAT ARE LISTED BELOW:

1. POND STAGE CAPACITY TABLE
2. PONDING AREA SHAPE
3. ELEVATIONS & DIMENSIONS REFLECTED ON THE DRAWING
4. SPILLWAY WIDTH IS WIDER THAN DESIGN

ENGINEER'S CERTIFICATION  
 JAMES SCHLEINVOGT  
 ENGINEERING SUPERVISOR  
 PEABODY WESTERN COAL COMPANY

ARIZONA P.E. #18782  
 DATE: NOV 03 2006



**LEGEND**

	Rip-Rap
	Ditch Berm
	AZ0001D-Permit Line
	1D Ancillary Road
	Drainage Channel

**REVISIONS**

CHECKED	DATE	DESCRIPTION
J. Schleinvogt	10-24-2006	OSM Response - Rip-Rap Inlet

**PROPOSED N9-I (2006) SEDIMENTATION POND DESIGN AS-BUILT**

KAYENTA MINE  
 PEABODY WESTERN COAL COMPANY  
 P. O. BOX 650 KAYENTA, ARIZONA 86033

DESIGNED BY: GA	SCALE: AS NOTED
DRAWN BY: M.Becenti (PWCC)	DRAWING DATE: 1-17-06
CHECKED BY: JGS	PHOTO DATE: 05-83
CONTOUR INTERVAL: 5 FT.	PLOT DATE: 10-31-2006

DWG FILE: 012006\_N9-I-Pond\_As-Built.dwg