

**SECTION 26**

**DRAINAGE CONTROL PLAN**

**TABLE OF CONTENTS**

<b>SECTION</b>	<b>SECTION TITLE</b>	<b>PAGE NUMBER</b>
26	DRAINAGE CONTROL PLAN .....	26-1
26.1	Existing Drainage Control Structures .....	26-1
26.1.1	Primary Roads – Water and Sediment Control .....	26-1
26.1.2	Ancillary Roads Control of Siltation.....	26-1
26.1.3	Surface Water Control .....	26-1
26.1.4	Primary Road Static Stability.....	26-2
26.1.5	Railroad Drainage and Erosion Control .....	26-2
26.1.5.1	Railroad Static Stability .....	26-5
26.2	Ponds, Impoundments, Berms and Embankments.....	26-6
26.2.1	Sediment Ponds.....	26-7
26.2.2	Modification to Operations of Pond 5 and North Cells.....	26-8
26.2.3	Ponds with a Single Closed Spillway.....	26-9
26.2.4	Highwall Impoundments.....	26-10
26.2.5	Berms.....	26-10
26.2.5.1	Topdressing Stockpile Berms .....	26-10
26.2.5.2	Immediate Mining Area and Active Grading Area Berms.....	26-11
26.2.5.3	Coal Stockpile Berms.....	26-11
26.2.6	Embankments.....	26-11
26.2.7	Hazard Classification .....	26-11
26.2.8	Miscellaneous Hydrologic Structures .....	26-12
26.3	Land Use/Condition, Hydrologic Groups and Curve Numbers .....	26-12
26.3.1	Reclaimed Areas .....	26-12
26.3.2	Undisturbed and Cultivated Areas .....	26-13
26.3.3	Spoil Material.....	26-13
26.4	Diversions.....	26-13
26.4.1	Lowe/Dixon Diversion Channel Extension – Removed with Update 1307.....	26-14
26.4.2	North Fork Diversion Channel.....	26-14

26.4.2.1 Drainage/Sediment Control for Excess Material Dump..... 26-16

26.5 Discharges Into an Underground Mine..... 26-17

**SECTION 26**

**DRAINAGE CONTROL PLAN**

**LIST OF TABLES**

<b>TABLE NUMBER</b>	<b>TABLE TITLE</b>
<a href="#"><u>26-1</u></a>	Primary Culverts
<a href="#"><u>26-2</u></a>	Downdrains
<a href="#"><u>26-3</u></a>	Ancillary Road Culverts
<a href="#"><u>26-4</u></a>	Railroad Culverts
<a href="#"><u>26-5</u></a>	Pond Cross Reference
<a href="#"><u>26-5.1</u></a>	Area 3 Lowe Hole 3 Pond 2
<a href="#"><u>26-5.2</u></a>	Area 3 Lowe Impoundment 1
<a href="#"><u>26-5.3</u></a>	Area 2 Barber Stockpile Pond 2
<a href="#"><u>26-5.4</u></a>	Area 2 Barber Stockpile Pond 3
<a href="#"><u>26-5.5</u></a>	Area 2 South Barber Pond
<a href="#"><u>26-5.6</u></a>	Area 3 Collyer Road Pond 4
<a href="#"><u>26-5.7</u></a>	Area 1 Emmas Pond
<a href="#"><u>26-5.8</u></a>	Area 2 Hosteen Stockpile Pond 1
<a href="#"><u>26-5.9</u></a>	Area 2 Hosteen Stockpile Pond 2
<a href="#"><u>26-5.10</u></a>	Area 2 Hosteen Stockpile Pond 3
<a href="#"><u>26-5.11</u></a>	Area 3 Lowe Railroad Impoundment 1
<a href="#"><u>26-5.12</u></a>	Area 3 Lowe Railroad Impoundment 2
<a href="#"><u>26-5.13</u></a>	Area 3 Lowe Stockpile Pond
<a href="#"><u>26-5.14</u></a>	North Pinto Pond
<a href="#"><u>26-5.15</u></a>	Area 1 North Pond Cell A_B_C combined
<a href="#"><u>26-5.16</u></a>	Area 1 North Pond 1 Cell A
<a href="#"><u>26-5.17</u></a>	Area 1 North Pond 1 Cell A2
<a href="#"><u>26-5.18</u></a>	Area 1 North Pond 1 Cell B
<a href="#"><u>26-5.19</u></a>	Area 1 North Pond 1 Cell C
<a href="#"><u>26-5.20</u></a>	Area 1 Pond 5
<a href="#"><u>26-5.21</u></a>	Area 3 Northwest Dixon
<a href="#"><u>26-5.22</u></a>	Area 3 South Dixon Pond 1
<a href="#"><u>26-5.23</u></a>	Area 3 South Dixon Pond 2

<a href="#"><u>26-5.24</u></a>	Area 3 South Dixon Pond 3
<a href="#"><u>26-5.25</u></a>	Area 3 Southwest Dixon Pond
<a href="#"><u>26-5.26</u></a>	Area 1 Vinnel Pond
<a href="#"><u>26-5.27</u></a>	Area 2 Block C Pond 1
<a href="#"><u>26-5.28</u></a>	Area 2 Block C Pond 2
<a href="#"><u>26-5.29</u></a>	Area 2 Block C Pond 3
<a href="#"><u>26-5.30</u></a>	Area 3 Lowe Hole 3 Pond 3
<a href="#"><u>26-5.31</u></a>	Area 2 Mason Pond
<a href="#"><u>26-5.32</u></a>	Area 2 Employee Coal Dump
<a href="#"><u>26-5.33</u></a>	Area 4 North Pond 401
<a href="#"><u>26-5.34</u></a>	Area 4 North Pond 412
<a href="#"><u>26-5.35</u></a>	Area 4 North Pond 3
<a href="#"><u>26-5.36</u></a>	Area 4 North Pond 4
<a href="#"><u>26-5.37</u></a>	OPEN
<a href="#"><u>26-5.38</u></a>	Area 4 North Pond 411
<a href="#"><u>26-5.39</u></a>	Area 4 North Pond 413
<a href="#"><u>26-5.40</u></a>	Area 4 North Pond 402
<a href="#"><u>26-5.41</u></a>	OPEN
<a href="#"><u>26-5.42</u></a>	Area 4 North Pond 408
<a href="#"><u>26-5.43</u></a>	Area 4 North Pond 409
<a href="#"><u>26-5.44</u></a>	Area 4 North Pond 410
<a href="#"><u>26-5.45</u></a>	Area 3 Pond 301
<a href="#"><u>26-5.46</u></a>	Area 3 Pond 302
<a href="#"><u>26-5.47</u></a>	Area 2 Block C Pond 4
<a href="#"><u>26-5.48</u></a>	Area 3 Pond 309A
<a href="#"><u>26-5.49</u></a>	Area 3 Pond 309B
<a href="#"><u>26-5.50</u></a>	Area 4 North Pond 414
<a href="#"><u>26-5.51</u></a>	OPEN
<a href="#"><u>26-5.52</u></a>	Area 3 Pond 306
<a href="#"><u>26-5.53</u></a>	Area 2 Pond 201
<a href="#"><u>26-5.54</u></a>	Area 2 Pond 202
<a href="#"><u>26-5.55</u></a>	Area 3 Pond 310
<a href="#"><u>26-5.56</u></a>	Area 3 Pond 311
<a href="#"><u>26-6</u></a>	Ponds with Single Closed Spillway Asbuilt Capacity vs Storm Runoff Volume
<a href="#"><u>26-7</u></a>	Block B Pond 3 Stage Storage
<a href="#"><u>26-8</u></a>	Highwall Impoundments and Impoundments Hazard Classification
<a href="#"><u>26-9</u></a>	Land Types and Curve Numbers

<a href="#"><u>26-10</u></a>	Topdressing Types and Quantities
<a href="#"><u>26-11</u></a>	Flow Depths and Velocities for Portion to be Constructed
<a href="#"><u>26-12</u></a>	Flow Depths and Velocities for the Portion in the Existing Drainage
<a href="#"><u>26-13</u></a>	Variation of Dimensions of Incised Channels
<a href="#"><u>26-14</u></a>	Excess Material Dump Slope Length Measurements
<a href="#"><u>26-15</u></a>	Undisturbed Surface Slope Length Measurements
<a href="#"><u>26-16</u></a>	Estimated Soil Loss Excess Material Dump
<a href="#"><u>26-17</u></a>	Estimated Soil Loss Undisturbed Surface

**SECTION 26**

**DRAINAGE CONTROL PLAN**

**LIST OF FIGURES**

<b>FIGURE NUMBER</b>	<b>FIGURE TITLE</b>
<a href="#"><u>26-1</u></a>	Railroad Culverts CP 14 and CP 13 Cross Section
<a href="#"><u>26-2</u></a>	Railroad Culverts CP 8 and CP 9 Cross Section
<a href="#"><u>26-3</u></a>	North Fork Diversion Channel Drainage Control
<a href="#"><u>26-4</u></a>	Drill Pad Typical Sections

**SECTION 26**

**DRAINAGE CONTROL PLAN**

**LIST OF EXHIBITS**

<b>EXHIBIT NUMBER</b>	<b>EXHIBIT TITLE</b>
<a href="#"><u>26-1</u></a>	Area 1 Culvert Dropbox Structure Locations Watershed Areas
<a href="#"><u>26-2</u></a>	Area 2 Culvert Down Drain Locations Watershed Areas
<a href="#"><u>26-3</u></a>	Area 2 Culvert Down Drain Locations Watershed Areas
<a href="#"><u>26-4</u></a>	Watershed Area Yazzie Y Culverts
<a href="#"><u>26-5</u></a>	Area 2 Culvert Down Drainage Structure Locations and Watershed Areas
<a href="#"><u>26-6</u></a>	Area 3 and 4 North Culvert Down Drainage Locations and Watershed Areas
<a href="#"><u>26-7</u></a>	Area 4N Culvert Down Drainage Watershed Areas
<a href="#"><u>26-8</u></a>	Asbuilt Barber Coal Stockpile Sedimentation Pond No 2
<a href="#"><u>26-9</u></a>	Area 1 Impoundment Ponds Watershed
<a href="#"><u>26-10</u></a>	Area 2 Impoundment Ponds Watershed
<a href="#"><u>26-11</u></a>	Area 2 Impoundment and Pond Locations/Watershed Areas
<a href="#"><u>26-12</u></a>	Area 3 Impoundment and Pond Locations/Watershed Areas
<a href="#"><u>26-13</u></a>	North Cell Modification
<a href="#"><u>26-14</u></a>	Area 3 Lowe Railroad Impoundment No 1 Modified Pond Design
<a href="#"><u>26-14</u></a>	Area 3 Lowe Railroad Impoundment No 1 Modified Pond AsBuilt (in Table 26-5.11)
<a href="#"><u>26-15</u></a>	Area 3 Lowe Railroad Impoundment No 2
<a href="#"><u>26-15</u></a>	Area 3 Lowe Railroad Impoundment No 2 AsBuilt (in Table 26-5.12)
<a href="#"><u>26-16</u></a>	North Fork Diversion Channel and Pit Location
<a href="#"><u>26-17</u></a>	North Fork Diversion Channel – Sheet 1
<a href="#"><u>26-17</u></a>	North Fork Diversion Channel – Sheet 2
<a href="#"><u>26-18</u></a>	North Fork Diversion Channel SEDCAD Watershed
<a href="#"><u>26-19</u></a>	Area 4 North Pond 401 Design (in Table 26-5.33)
<a href="#"><u>26-20</u></a>	Area 4 North Pond 402 Design (in Table 26-5.40)
<a href="#"><u>26-21</u></a>	OPEN
<a href="#"><u>26-22</u></a>	OPEN
<a href="#"><u>26-23</u></a>	Area 4 North Pond 413 Design (in Table 26-5.39)
<a href="#"><u>26-24</u></a>	Area 3 Impoundment Ponds Watershed (in Table 26-5.1)
<a href="#"><u>26-25</u></a>	Area 4 North Impoundment Ponds Watershed (in Table 26-5.33)

<a href="#"><u>26-26</u></a>	Mason Pond Modification Design (in Table 26-5.39)
<a href="#"><u>26-27</u></a>	Emmas Pond AsBuilt (in Table 26-5.7)
<a href="#"><u>26-28</u></a>	Emmas Pond Hydrology and Pond Design (in Table 26-5.7)
<a href="#"><u>26-29</u></a>	North Pinto Pond AsBuilt (in Table 26-5.14)
<a href="#"><u>26-30</u></a>	Hosteen Pond Number 1 AsBuilt (in Table 26-5.8)
<a href="#"><u>26-31</u></a>	Hosteen Pond Number 2 AsBuilt (in Table 26-5.9)
<a href="#"><u>26-32</u></a>	Hosteen Pond Number 3 AsBuilt (in Table 26-5.10)
<a href="#"><u>26-33</u></a>	Barber Coal Stockpile Detention Pond Number 3 AsBuilt (in Table 26-5.4)
<a href="#"><u>26-34</u></a>	Lowe Stockpile Pond AsBuilt (in Table 26-5.13)
<a href="#"><u>26-35</u></a>	Vinnel Hydrology Plan (in Table 26-5.26)
<a href="#"><u>26-36</u></a>	Vinnel Pond AsBuilt (in Table 26-5.26)
<a href="#"><u>26-37</u></a>	Northwest Dixon Pond AsBuilt (in Table 26-5.21)
<a href="#"><u>26-38</u></a>	Southwest Dixon Pond AsBuilt (in Table 26-5.25)
<a href="#"><u>26-39</u></a>	South Barber Pond Design Plan Profile Section (in Table 26-5.5)
<a href="#"><u>26-40</u></a>	South Barber Pond AsBuilt Plan Profile Section (in Table 26-5.5)
<a href="#"><u>26-41</u></a>	Area 3 South Dixon Pond 1 AsBuilt (in Table 26-5.22)
<a href="#"><u>26-42</u></a>	Area 3 South Dixon Pond 3 AsBuilt (in Table 26-5.24)
<a href="#"><u>26-43</u></a>	CR Pond 4 AsBuilt_in Table 26-5.6 - Sheet 1
<a href="#"><u>26-43</u></a>	CR Pond 4 AsBuilt_in Table 26-5.6 - Sheet 2
<a href="#"><u>26-44</u></a>	Area 4 North Pond 412 AsBuilt (in Table 26-5.34)
<a href="#"><u>26-45</u></a>	Area 4 North Pond 412 Design (in Table 26-5.34)
<a href="#"><u>26-46</u></a>	Area 4 North Pond 3 AsBuilt (in Table 26-5.35)
<a href="#"><u>26-47</u></a>	Area 4 North Pond 3 Desig (in Table 26-5.35)
<a href="#"><u>26-48</u></a>	South Dixon Pond 2 Modification Design (in Table 26-5.23)
<a href="#"><u>26-49</u></a>	South Dixon Pond 2 Modification AsBuilt (in Table 26-5.23)
<a href="#"><u>26-50</u></a>	Area 4 North Pond 4 AsBuilt (in Table 26-5.36)
<a href="#"><u>26-51</u></a>	Area 4 North Pond 4 Design (in Table 26-5.36)
<a href="#"><u>26-52</u></a>	Area 3 Design Lowe Hole 3 Pond 2 (in Table 26-5.1)
<a href="#"><u>26-53</u></a>	Area 3 Design Lowe Hole 3 Pond 3 (in Table 26-5.30)
<a href="#"><u>26-54</u></a>	Lowe Hole 3 Pond 3 AsBuilt (in Table 26-5.30)
<a href="#"><u>26-55</u></a>	Lowe Hole 3 Pond 2 AsBuilt (in Table 26-5.1)
<a href="#"><u>26-56</u></a>	Employee Coal Dump Modification AsBuilt (in Table 26-5.32)
<a href="#"><u>26-56</u></a>	Employee Coal Dump Modification Design (in Table 26-5.32)
<a href="#"><u>26-57</u></a>	Block C Pond 1 Design (in Table 26-5.27)
<a href="#"><u>26-58</u></a>	Block C Pond 1 AsBuilt (in Table 26-5.27)
<a href="#"><u>26-59</u></a>	Block C Pond 2 Design (in Table 26-5.28)
<a href="#"><u>26-60</u></a>	Block C Pond 2 AsBuilt (in Table 26-5.28)

<a href="#">26-61</a>	Block C Pond 3 Design (in Table 26-5.29)
<a href="#">26-62</a>	Block C Pond 3 AsBuilt (in Table 26-5.29)
<a href="#">26-63</a>	Block C Pond 3 Typical Section Profile Modified AsBuilt (Table 26-5.2)
<a href="#">26-64</a>	Area 4 North Pond 406 AsBuilt (in Table 26-7)
<a href="#">26-64</a>	Area 4 North Pond 406 Design
<a href="#">26-65</a>	Area 4 North Pond 407 AsBuilt (in Table 26-7)
<a href="#">26-65</a>	Area 4 North Pond 407 Design
<a href="#">26-66</a>	Area 4 North Pond 408 AsBuilt (in Table 26-5.42)
<a href="#">26-67</a>	Area 4 North Pond 408 Design (in Table 26-5.42)
<a href="#">26-68</a>	Area 4 North Pond 409 410 AsBuilt (in Table 26-5.43)
<a href="#">26-69</a>	Area 4 North Pond 409 410 Design (in Table 26-5.43)
<a href="#">26-70</a>	Area 4 North Pond 411 AsBuilt (in Table 26-5.38)
<a href="#">26-71</a>	Area 4 North Pond 411 Design (in Table 26-5.38)
<a href="#">26-72</a>	South Dixon Ponds 301 AsBuilt (in Table 26-5.45)
<a href="#">26-73</a>	South Dixon Ponds 302 AsBuilt (in Table 26-5.45)
<a href="#">26-75</a>	Railroad Side Ditch Channel at CP2 Culvert
<a href="#">26-76</a>	Area 4 North Pond 1 Design Plan Profile Section
<a href="#">26-77</a>	Area 3 Shop Temporary Diversion Plan Profile Cross Sections
<a href="#">26-78</a>	Culverts CP-103 & CP-104 Plans, Sections & Details
<a href="#">26-79</a>	Area 4 North Pond 7
<a href="#">26-80</a>	Block C Pond 4 Design
<a href="#">26-81</a>	Mason Pond AsBuilt (in Table 26-5.31)
<a href="#">26-82</a>	North Fork Pond Design
<a href="#">26-83</a>	Spur D Watersheds
<a href="#">26-84</a>	Area 3 Facilities Culvert Locations Watershed Areas
<a href="#">26-85</a>	Dixon Pond 306 Design
<a href="#">26-86</a>	Pond 414 Design – Sheet 1
<a href="#">26-86</a>	Pond 414 Diversion Channel – Sheet 2
<a href="#">26-87</a>	Area 2 Pond 201 Design
<a href="#">26-88</a>	Area 2 Pond 202 Design
<a href="#">26-89</a>	Corridor Roads Designs
<a href="#">26-90</a>	Dixon By-pass Road Design - Sheet 1
<a href="#">26-90</a>	Dixon By-pass Road Design - Sheet 2
<a href="#">26-91</a>	Dixon Ramp 2 Haulroad Design
<a href="#">26-92</a>	Corridor Ready-Line Design
<a href="#">26-93</a>	Pond 310 Design
<a href="#">26-94</a>	Pond 311 Plan, Profile and Section

**SECTION 26**

**DRAINAGE CONTROL PLAN**

**LIST OF APPENDICES**

**APPENDIX**

**NUMBER      APPENDIX TITLE**

---

<a href="#">26.A</a>	Lowe Railroad Embankments #2 Modification
<a href="#">26.B</a>	Navajo Mine Railroad Sediment and Drainage Control Structures Design Data
<a href="#">26.C</a>	Sediment Ponds Impoundments Hydrology Calculations Backup
<a href="#">26.D</a>	Highwall Impoundment Design and As-Built Information
<a href="#">26.E</a>	North Fork Diversion Channel
<a href="#">26.F</a>	Emma's Pond Design and As-Built
26.G	OPEN
<a href="#">26.H</a>	North Pinto Modification Design and As-Built
<a href="#">26.I</a>	North Pond Expansion Cell A2
<a href="#">26.J</a>	South Dixon Ponds 1 2 and 3 Hydrology
<a href="#">26.K</a>	Spur D Drainage Sediment Control
<a href="#">26.L</a>	Lowe Dixon Temporary Diversion SEDCAD

**SECTION 26**

**DRAINAGE CONTROL PLAN**

**LIST OF REVISIONS DURING PERMIT TERM**

<b>REV. NUMBER</b>	<b>REVISION DESCRIPTION</b>	<b>DATE APPROVED</b>
1301	Ponds 201 and 202	

## **26 DRAINAGE CONTROL PLAN**

### **26.1 Existing Drainage Control Structures**

#### *26.1.1 Primary Roads – Water and Sediment Control*

Primary Roads will be designed and maintained in such a manner to minimize the contribution of additional suspended solids to surface runoff leaving the Permit Area. If the results from the hydraulic analysis indicate the potential for erosion to occur, rip-rap rock or other forms of protective lining will be installed. Primary Road drainage controls will be designed for a 10 year-6 hour storm event. The design and construction of Primary Roads will both be certified by a Professional Engineer. The construction will not commence until the designs are approved by the Regulatory Authority.

#### *26.1.2 Ancillary Roads Control of Siltation*

For existing and future Ancillary Roads, the runoff is usually drained into internal depression, or routed through existing nearby channels to impoundments or open mining pits. These roads are located so as to: 1) minimize construction efforts and disturbance, 2) keep road gradients minimal to deter erosion, and 3) minimize impact on existing drainage channels. Ancillary road drainage control structures will be designed for a 2 year-6 hour storm event. Measures will be taken to prevent contributions of additional suspended solids to stream flow or runoff outside the Permit Area, such as locating roads to prevent runoff from leaving the Permit Area, installing culverts, installing filter fences, or vegetating or otherwise stabilizing exposed surfaces such as sideslopes and roadcuts.

#### *26.1.3 Surface Water Control*

The Primary Roads are located with minimal impact upon existing drainage channels. At topographical lows or where roads intersect drainage channels, surface flows are routed through the road embankments with culverts.

All culverts are designed to safely pass the peak discharge from a 10 year-6 hour event for Primary Roads and 2 year-6 hour storm event for Ancillary Roads. Exhibit 23-1 shows the existing haulroad and access road culvert typical cross sections.

The utility routine for sizing culverts in SEDCAD+ was used to design the culverts. The design peak flows were determined with the SEDCAD+ computer program. All culvert watersheds were delineated, soil curve numbers determined and precipitation values for the event obtained from NOAA Atlas IV-New Mexico.

Hydrologic and channel information pertinent to the Primary Road culverts, and downdrains are located in [Table 26-1](#) and [Table 26-2](#). Hydrologic and channel information pertinent to the Ancillary Road culverts

are located on [Table 26-3](#). All culvert and downdrain locations and corresponding watershed are shown on [Exhibit 26-1](#), [Exhibit 26-2](#), [Exhibit 26-3](#), [Exhibit 26-4](#), [Exhibit 26-5](#), [Exhibit 26-6](#), and [Exhibit 26-7](#). Reference Appendix 23.A and 23.B for additional culvert information.

#### *26.1.4 Primary Road Static Stability*

Primary Road embankment heights vary from 0 to 36 feet. The majority of the road embankment heights average less than 10 feet. Embankment height is defined as the difference in elevation from toe to grade.

Historically, Navajo Mine has not had problems with road embankments stability based upon the following reasons:

1. The mine's geologic setting is in an area with an abundance of clay and shaley material with the majority of road embankments being constructed of this material, The cohesive values of the two types of soils vary from 1,000 to 10,000 pounds per square foot,
2. The majority of the roads are on level ground, which requires minimum fill,
3. There is no evidence of the presence of shallow ground water where embankments are located, and
4. In the immediate natural hillsides and roads, there is no evidence of failures such as:
  - a. creep
  - b. landslides
  - c. flows-wet & dry

Other embankments which consist of the same materials and construction methods as the existing roads have been tested for stability (See Appendix 23.E, "Slope Stability", for more information). As a worst case scenario, refer to page 11-Q-29 in [Appendix 26.A](#), "Lowe Railroad Embankment #1 Stability Analysis" as all Primary Road embankment heights are less than the embankment height used in the stability analysis.

#### *26.1.5 Railroad Drainage and Erosion Control*

The railroad is designed and constructed to control contribution of additional sediment to the downstream flows leaving the Permit Area. Side ditches are provided in the cut section to collect the surface runoff from the cut slopes, track bed, service road and adjacent undisturbed areas. The grades of the side ditches/channels coincide with the railroad gradient, which in most cases are 1.0 percent or less. The watersheds for the side ditches are generally small. The flow velocity in the side ditches will seldom exceed the erosive velocity of the soil. The use of low gradient side ditches is a "best management practice" (BMP) in controlling the flow velocity and thereby minimizing the contribution of additional sediment to the downstream flows. At fill sections, relief ditches are utilized to route surface runoff to a

natural drainage channel. The relief ditches are located along the toe of the railroad embankment. The grade of the relief ditches varies from moderate to steep depending on the topography. The flow velocity in the relief ditches will in some cases exceed the erosive velocity of the soil. In cases where the erosive velocity are exceeded and there is visible erosion, other types of BMP will be considered to control the sediment or erosion. The procedure and design criteria outlined below will be used to determine the type BMP that will be applied to control the sediment or erosion, if any is required.

- Field survey each concentrated flow or ditch created due to the construction of the railroad. From the field surveys and topographic maps determine the ditch slopes, sizes, flow lengths, soil types, approximate watersheds, and note any visible erosion.
- Using the data obtained above perform hydrological analysis for each ditch. Since the watersheds are small and numerous, several worse case hydrology analysis will be done at appropriate watershed size increments. The criteria below will be used for the worse case hydrology analysis.
  - a) Minimum Design Storm Event – the 10 year – 6 hour storm
    - ◇ Storm Distribution Type – SCS Type II-65
    - ◇ Time of Concentration – Assumed to be equal to zero or instantaneous. This would be a conservative analysis giving higher peak discharges for design purposes.
    - ◇ Curve Number – Assumed to be equal to 89 for all watersheds. The recommended curve number for a graveled road on a Class C soil is 89. The assumption is conservative since the adjacent undisturbed areas that will be contributing surface runoff to the design structures have lower curve numbers.
    - ◇ The Sedcad+ computer software will be used to model the hydrology.
    - ◇ For worse case analysis use watershed increments of 0.5, 1.0, 2.0, 4.0, 6.0, and 8.0 acres. The watersheds greater than 8.0 acres will be modeled separately.
    - ◇ For watersheds greater than 8.0 acres the criteria above will also apply except for the curve number and time of concentration. The curve number will be determined using the procedure outlined in this Section. The time of concentration will be determined based on actual watershed configuration.
    - ◇ Perform the hydraulic analysis using the results from the hydrology analysis above. The Sedcad+ channel design utility will be utilized for the hydraulic analysis of the ditches/channels. The ditches/channels will be verified to safely pass the peak discharge from the 10 year – 6 hour storm event. The maximum flow velocity will be determined for each ditch/channel and compared to the erosive velocity of the soil.
- If the flow velocity is less than the erosive velocity, the existing ditch/channel configuration is sufficient in controlling the contribution of additional sediment to the downstream flow and no additional BMP is warranted.

- If the flow velocity in a ditch/channel exceeds the erosive velocity an appropriate type of BMP will be considered for controlling sediment and erosion.
- For watersheds  $\leq 8.0$  acres and the flow velocity  $>$  erosive velocity.
  - ◊ If there is no erosion visible a silt fence or straw bale barrier will be installed.
  - ◊ If erosion is visible a protective channel lining, i.e. rip-rap or straw bale check dams will be installed.
- For watersheds  $> 8.0$  acres and the flow velocity  $>$  erosive velocity a protective channel lining, i.e. rip-rap will be placed.

Refer to [Appendix 26.B](#) for supporting design data. For locations of side ditches, relief ditches, drop structures, culverts, downdrain pipes, silt fences, straw bale barriers, straw bale check dams, and livestock crossings, see Exhibit 11-14A through 11-14G. For typical sections of ditches, drop structures, downdrain pipes, silt fences, straw bale barriers, straw bale check dams, and railroad cut/fill sections, see Exhibit 11-14H and 11-14J.

The railroad embankment slopes generally are hydrologically stable, very little rilling or erosion occurs on the slopes. Overland sheet flow is the primary type of flow that occurs on the embankment slopes. The stability is partly due to the infiltration of ballast material (1.5 inch crushed rock) into the embankment slopes. On large embankments with long slopes, berms/ditches and downdrain pipes are used to prevent concentrated flows from running down the slopes. Berms and ditches are located at the crest of railroad embankments to divert surface runoff to the downdrain pipes. The downdrain pipes extend from the crest of the embankment to the toe. Energy dissipater will be installed at the outlet of the downdrain pipes to prevent scouring. Overall a very minimal amount of sediment has been transported to the toe of the embankments during the period the rail system has been in service, approximately 25 years. Deposition occurs immediately adjacent to the toe of the embankment inside the ROW or Permit Area.

The railroad culverts were checked for capacity and adequacy for a peak discharge from a 10-yr, 6-hr event. Peak flows were determined with the SEDCAD+ computer program. Culvert watersheds were delineated, soil curve numbers were determined, and precipitation values for events were obtained from NOAA Atlas IV-New Mexico. The railroad culverts and pertinent information are shown in [Table 26-2](#) and [Table 26-4](#). Their locations and corresponding watersheds are shown in [Exhibit 26-1](#), [Exhibit 26-2](#), [Exhibit 26-3](#), [Exhibit 26-4](#), [Exhibit 26-5](#), [Exhibit 26-6](#), and [Exhibit 26-7](#). Refer to Appendix 23.A and [Appendix 26.B](#) for hydrological analysis and SEDCAD+ runs.

All necessary field data obtained to evaluate the existing culverts were obtained from cross sectional surveys. The cross sectional survey determined the following culvert data:

1. Pipe size type and length
2. Pipe invert slope, and
3. Headwater depths of road embankments over pipe.

With the above information, the railroad culverts were checked for the design discharge using SEDCAD+. The field surveyed “Available Maximum Headwater Depth” was compared with calculated headwater to check pipe adequacy.

The majority of the railroad culverts are of single barrel arrangements except for the culverts CP-23 & 24. Culverts CP-23 & 24 consist of two 57 inch by 38 inch corrugated steel pipe-arches with 4 feet diameter CMP drop inlets and serve as emergency spillways for Barber Stockpile Pond #2. The spillway was checked using an equivalent round pipe for the arch pipe, the equivalent round pipe is a 48 inch diameter pipe. See SEDCAD+ run in [Appendix 26.C](#) and [Exhibit 26-8](#) for more details.

Culvert numbers 8, 9, 13, and 14 are arranged in the field in series. Culvert CP-8 is immediately upstream of culvert CP-9, and culvert CP-14 is upstream of CP-13 (CP-8/9 are not in series with CP-14/13). Analysis of these culverts commenced with the downstream pipe. This way, the controlling headwater depth of the downstream pipe is the tailwater depth for the upstream pipe’s outlet HW depth calculations. In both cases (CP-8/9 and CP-14/13) the upstream pipe outlet and downstream pipe inlet are submerged at peak design discharge.

The controlling headwater depths for CP-8/9 and CP-14/13 are inlet/inlet and outlet/inlet, respectively. See [Figure 26-1](#) and [Figure 26-2](#) for the drawings of pipes in a series.

All drainage and erosion control structures along the railroad will be maintained to ensure that no adverse condition that maybe harmful to the environment will arise. Structures will be inspected after each major storm event, any adverse conditions identified will be corrected.

#### 26.1.5.1 Railroad Static Stability

The majority of the alignments are located on original ground with the exception of four embankments. The railroad has two major embankments with culverts: the Chinde Wash and the Up-Dip Barber Railroad embankments.

The Chinde Wash embankment (Big Fill) has a static safety factor of 1.5. See Permit NM-0003C, Chapter 34, Appendix 34-D for a copy of the report on this certification. Figures 5 and 6 of this report were done

by two different consulting firms with several years time between each drawing. Figure 5 was drawn by Terratech in 1973 and referenced by Steffen, Robertson and Kristen (SRK) in their 1985 report. SRK drew Figure 6 for their report and the minor differences between figures 5 and 6 reflect only the different approach each author utilized. Both drawings and the analyses performed by the two consultants resulted in nearly identical factors of safety for the structure (see Appendix 34-D, page 34-D-15). A Seismic Stability Analysis for the Big-Fill was performed by SRK in 1987. The summary concluded based on a design horizontal acceleration of 0.08g, the safety factor of the fill, against failure under earthquake loading, generally exceeds 1.2. This is considered adequate for the stability of the fill. The findings report can be found in Permit NM-0003C, Chapter 29, Appendix 29-E.

The drop structure at the Chinde Wash embankment (Big Fill) will receive periodic maintenance following major precipitation events. Riprap, sized to pass a 10 year-6 hour flow, has been placed on filter fabric so as to prevent erosion. The riprap is comprised of an appropriate gradation of particle sizes. All remedial measures recommended by SRK were completed in 1985 (see Permit NM-0003C, Chapter, Appendix 34-D).

The Up-Dip Barber Railroad embankment has a minimum safety factor of 4.4. See Permit NM-0003C, Chapter 34, Appendix 34-F for the safety factor determination and the laboratory test results for the embankment.

Two additional embankments impound water along the railroad. These embankments are Lowe Embankments No. 1 and No. 2 and are located along the railroad just north of the Lowe Pit Coal Stockpile in Area 3. Both embankments contain small surface water runoff from the Lowe haulroad and spoil storage areas. A stability analysis was conducted in 1987 by Western Technologies Inc. Results on the largest of these embankments reported a static safety factor of 3.4. A copy of the analysis is found in Permit NM-0003C, Chapter 29, Appendix 29-C.

## **26.2 Ponds, Impoundments, Berms and Embankments**

Ponds, impoundments, berms or embankments are used within the Permit Area to: 1) capture and/or treat surface water runoff from unreclaimed spoil, coal handling, shop, office or maintenance facilities, or other disturbed areas where runoff could leave the Permit Area, 2) prevent surface water runoff from undisturbed upstream areas from entering into active mine pits, and 3) reduce the amount of topdressing loss from topdressing stockpiles due to wind and surface water erosion. Upon disturbance/removal of sediment ponds due to mining advancement, the pit will provide drainage and sediment control during mining operations. The remaining sediment ponds will provide drainage and sediment control during regrade and reclamation. Other appropriate water and sediment control structures may be constructed as needed.

All temporary drainage control structures such as sedimentation ponds, impoundments, berms and embankments will be reclaimed according to the procedures outlined in Part 5 – Reclamation plan.

#### 26.2.1 Sediment Ponds

The pond tables (see [Table 26-5](#) for index listing of the pond tables) identify each sediment pond and specify the criteria used for the design of each pond. The pond tables also provide references for locating the supporting design data, design drawing, and the as-built drawing for each pond. The pond tables and the referenced data for each respective pond provide the information required for demonstrating that the ponds comply with CFR 30 Parts 816.46, 816.47 and 816.49. The hazard classification for each pond is also specified on the pond tables. The locations of the ponds are shown on [Exhibit 26-9](#), [Exhibit 26-10](#), [Exhibit 26-11](#), and [Exhibit 26-12](#).

The sediment ponds are designed to retain either the 10 year-24 hour or the 100 year-6 hour precipitation event. Riprap material is placed at the pond inlets and spillways if the hydraulic analysis indicates that a protective lining is required to minimize and control erosion. The spillways are designed to safely pass the peak discharge from the 25 year-6 hour precipitation event.

To ensure that the design capacity is maintained, the maximum permissible gauge reading for the water/sediment level will be provided. The volume above the maximum permissible water/sediment level is equal to the design volume and the volume below it, the excess volume. If the water or sediment level should exceed the maximum permissible gauge reading then the impoundment will be either pumped or cleaned out down to an acceptable level. This will insure that the design volume is maintained at all times. The maximum permissible gauge reading for water/sediment level to maintain the design volume will be provided for each impoundment, except for the sewer ponds, storage ponds for dust suppressant water, highwall impoundments, and North Cells. The permissible water/sediment level in the North Cells will be referenced from the top of overflow between Cell B and C. The maximum gauge reading for the permissible water/sediment level are on the pond tables, see [Table 26-5](#) for index listing of the pond tables.

The watershed sizes and curve numbers change due to areas being mined and reclaimed. This results in changes in the volume of surface runoff that need to be retained by the impoundments. The hydrology and the maximum permissible gauge reading will be updated annually to account for these changes.

After a runoff event, 90 percent of the design capacity will be restored within 10 days, provided the pond is accessible. Weather and ground conditions may limit access to some ponds particularly those in the reclaimed areas. Accessing these ponds during muddy conditions with dewatering equipment will cause

excessive damage to the adjacent reclaimed lands. In such a case, the dewatering will occur as soon as conditions improve.

Inspection and maintenance will be done on a periodic basis to ensure the ponds are kept in good condition and functional. Inspections will be performed on a quarterly basis; the fourth quarter inspection will be an annual inspection that will be submitted to the regulatory agency. The quarterly inspections will be kept on file at the mine site. Any maintenance items identified from the inspections will be promptly repaired or corrected.

Approval for additional sediment ponds will be obtained from the regulatory agency prior to construction. The detail engineering drawings and the supporting design data will be submitted for review and approval. After completion of construction an as-built drawing of the pond will be submitted for review. A registered professional engineer will certify both the design and the as-built drawings.

General Notes:

- All references unless otherwise noted are from the current approved PAP.
- 25 year – 6 hour Peak Discharge is the design flow for all spillway design.
- All ponds without spillways are designed to handle runoff volume with 1 ft. of freeboard except where noted.

*26.2.2 Modification to Operations of Pond 5 and North Cells*

The operations of Pond 5 and the North Cells were modified to reduce the frequent clean-out of Cell A (lined) and to increase the flow path in Cell A2. In order for Pond 5 to maintain sufficient capacity the stormwater and plant washdown water is being pumped to Cell A2. Cell A2 was divided into three additional cells to increase the flow path, which will allow coal fines to settle and to facilitate cleaning. The pump from Pond 5 has a maximum flow of 3.5 cfs so the outlet pipe from Cell A2 is sufficient to handle the flow into Cell A.

Cell A, Cell B and Cell C will collect the stormwater from the North Facility and equipment washdown water from the North Shop. Cell A has a liner; all the flows are diverted into this cell except for the runoff from the side slope into the other two cells. The overflow from Cell A to Cell B is equipped with a skimmer to retain any hydrocarbons within the lined cell. This will be the main hydrocarbon treatment for the North Facilities.

The water collected in Cells B and C will be periodically pumped to either the Lowe Loadout Pond or Barber Loadout Pond via the existing mainline to be used as dust suppressant water on the haulroads. If the water truck loadout ponds are full or for some reason cannot receive the water from Cell A2 then the water will be pumped to other sediment ponds having sufficient capacity. The permissible gauge reading or elevation will not be exceeded when pumping to other ponds.

This is a temporary solution for managing the effluent collected in Pond 5. The plant washdown system has been automated to comply with MSHA standards and the amount of effluent generated has increased significantly. For the long term solution an engineer study will be done to determine the best way to manage the plant washdown water.

The hydrology data and design exhibits have been revised to reflect the operational modification. The revised or updated hydrology data for Pond 5 and the North Cells are presented in [Appendix 26.C](#). The embankment placed over the spillway between Cell A and Cell A2 is presented on [Exhibit 26-13](#). The cells were surveyed after completion of recent clean-out. This survey data has been incorporated into the revised exhibit.

#### *26.2.3 Ponds with a Single Closed Spillway*

Five sediment ponds at Navajo Mine have been constructed, each with a single closed spillway. The ponds constructed as such are: Hosteen #3, Barber #2, and Block C Ponds 1, 2, and 3. All are located along the railroad embankment in Area 2. The ponds were designed to retain the runoff from the 10-year 24-hour storm event, and to discharge the 25-year 6-hour peak flow through the spillway. To facilitate the construction of several of the ponds the existing culverts beneath the railroad were converted to spillways.

The surface mine regulations at 30 CFR 816.49(a)(9) allow for the use of a single closed spillway only when it is combined with an emergency spillway. To demonstrate compliance with regulations, the ponds described above were re-evaluated as containment structures that rely primarily on storage capacity to control the runoff from the 100-year 6-hour storm event as specified in section 816.49(c)(2) of the regulations.

With the exception of the Block C Pond 3, each of the other ponds are capable of retaining the runoff from the 100-year 6-hour storm event without discharging at the spillway. The as-built pond capacities and the runoff volumes from the 100-year 6-hour storm are summarized in [Table 26-6](#). The hydrologic analyses were revised by adjusting the curve numbers for the watersheds to account for reclaimed areas. This resulted in reductions of the runoff volumes. Refer to [Appendix 26.C](#) for the hydrologic analyses. The

watershed areas are shown on [Exhibit 26-10](#) and [Exhibit 26-11](#). For Block B Pond 3-Stage Storage refer to [Table 26-7](#).

These analyses support the conclusion to retain the single closed spillways in all five ponds. Four of the ponds (Hosteen #3, Barber #2, and Block C Ponds 1, and 2) will be maintained and operated to retain the 100-year 6-hour runoff volume. Block C Pond 3 will continue to be maintained and operated in compliance with the requirements for a 10-year 24-hour capacity sediment pond. If the spillway should become plugged during a storm event larger than the design storm, there is more than sufficient capacity to retain the runoff without overtopping and breaching the pond embankment.

#### *26.2.4 Highwall Impoundments*

[Table 26-8](#) identifies the impoundments and classification, whereas, [Exhibit 26-9](#), [Exhibit 26-10](#), [Exhibit 26-11](#) and [Exhibit 26-12](#) provides locations. Highwall impoundments are constructed according to a typical design shown on the Highwall Impoundments Standard Design drawing ([Appendix 26.D](#)). Detailed design information also can be found in [Appendix 26.D](#), Highwall Impoundment Design and As-Built Information. The standard design package for highwall impoundments serves as a pre-approved design for these structures, therefore structures constructed according to the typical design standard do not require approval prior to construction. As-built information for highwall structures are shown on the Highwall Impoundment As-Built drawing in [Appendix 26.D](#). Under normal circumstances, as-built information for highwall structures is submitted to OSM within sixty days following construction.

A brief description of each highwall impoundment at the Navajo Mine is included in [Table 26-8](#). The locations are shown on [Exhibit 26-9](#), [Exhibit 26-10](#), [Exhibit 26-11](#) and [Exhibit 26-12](#). The impoundments are designed and built to prevent water from entering active mining pits. In no case will discharge from any of the impoundments leave the Permit Area as the pits would intercept the flows.

#### *26.2.5 Berms*

Berms are inspected regularly to ensure their stability and ability to perform as designed. When degradation of the berms is observed they will be reestablished using a blade or other appropriate equipment.

##### 26.2.5.1 Topdressing Stockpile Berms

Exhibit 22-1 through Exhibit 22-3 provide the location of all current topdressing stockpiles as discussed in Section 22 – Support Facilities. In an effort to reduce topdressing loss resulting from wind and water erosion, berms and/or ditches are constructed around the perimeters of each topdressing stockpile or ponds

are built. In addition, stockpiles that have a slope at angle of repose, a berm will be placed on the top to eliminate runoff erosion along the slopes.

Figure 25-1 provides a typical design and cross section of the berm surrounding the topdressing stockpiles. See Section 25 – Sediment Control Plan, for application of the typical design.

During periods when the topdressing stockpiles are active, breaches in the berms will be created to allow for equipment access. These berms will be reconstructed after the topdressing stockpiles become inactive.

#### 26.2.5.2 Immediate Mining Area and Active Grading Area Berms

See Section 25 – Sediment Control Plan, Operation 2: “Immediate Mining Area and Active Grading Areas”, for text discussion.

#### 26.2.5.3 Coal Stockpile Berms

Berms are installed adjacent to the coal stockpiles to help divert the surface runoff into a sediment pond or other drainage control structures. The berms convey surface runoff either directly into a sediment pond or into a ditch or channel that leads to a sediment pond. They are examined after storm events, and kept in good condition to ensure that they function properly and as intended. A typical section of the berm is shown on Figure 22-1 and the design for the worst case scenario is in Appendix 23.B.

#### *26.2.6 Embankments*

Embankments are constructed in areas where the transportation facilities (haulroads, roads, railroad, etc) traverse across topographic lows. The embankments have culverts to prevent surface runoff from impounding on the upstream side, except for the section of railroad embankment just north of the Lowe Coal Stockpile. This section of railroad embankment impounds the surface runoff from two watersheds, which have been designated as Lowe Impoundment #1 and #2. The detail designs, plans and sections of these impoundments are shown on [Exhibit 26-14](#) and [Exhibit 26-15](#). Whereas, the location of the embankments and the culverts are shown on Exhibits 10-1 through 10-2 and Exhibits 10-4 through 10-7.

When segments of the transportation facilities are no longer needed they will be regraded and reclaimed in accordance with Section 22 – Support Facilities of the mine permit.

#### *26.2.7 Hazard Classification*

All impoundment’s have been classified using the Soil Conservation Service (SCS) criteria for Class B and C dams (TR-60), and MSHA’s criteria for impoundment’s (30 CFR 77.216 (a) (1)). Tables 22-2 through 22-6, [Table 26-5.1](#), [Table 26-5.2](#), [Table 26-5.3](#), [Table 26-5.4](#), [Table 26-5.5](#), [Table 26-5.6](#), [Table 26-5.7](#),

[Table 26-5.8](#), [Table 26-5.9](#), [Table 26-5.10](#), [Table 26-5.11](#), [Table 26-5.12](#), [Table 26-5.13](#), [Table 26-5.14](#), [Table 26-5.15](#), [Table 26-5.16](#), [Table 26-5.17](#), [Table 26-5.18](#), [Table 26-5.19](#), [Table 26-5.20](#), [Table 26-5.21](#), [Table 26-5.22](#), [Table 26-5.23](#), [Table 26-5.24](#), [Table 26-5.25](#), [Table 26-5.26](#), [Table 26-5.27](#), [Table 26-5.28](#), [Table 26-5.29](#) and [Table 26.8](#) identify the impoundment's and classification, whereas [Exhibit 26-9](#), [Exhibit 26-10](#), [Exhibit 26-11](#), and [Exhibit 26-12](#) provide the locations.

All impoundments have been determined to be low hazard potential. In the event of a failure there is no potential hazard to homes, utilities, roads, or other structures downstream. Lowe Railroad Embankment #1 meets the MSHA impoundment criteria (embankment height higher than 20 feet and capacity greater than 20 acre-feet).

#### *26.2.8 Miscellaneous Hydrologic Structures*

Design proposals submitted to OSM will contain the appropriate engineering design analysis. Design analysis data (e.g. SEDCAD) for miscellaneous hydrologic structures is contained in Appendix 23.B.

### **26.3 Land Use/Condition, Hydrologic Groups and Curve Numbers**

The NRCS has classified soil types into four hydrologic group ratings; A, B, C or D. To establish uniformity in the curve numbers used for reclaimed, undisturbed and cultivated (NAPI fields) lands. The curve numbers that will be used for the soils in the respective hydrologic groups and land types, are shown on [Table 26-9](#). The land use/conditions and curve numbers were taken from SCS Engineering Division Technical Release 55, June 1986, "Urban Hydrology for Small Watersheds", Table 2-2d, page 2-8.

#### *26.3.1 Reclaimed Areas*

From the referenced table the type of land use/conditions for the reclaimed lands at Navajo Mine is between "Herbaceous" and "Desert Shrub", each with poor hydrologic condition. The curve numbers for the reclaimed lands were determined by interpolating between the curve numbers associated with the two land use/conditions. These curve numbers are conservative for the reclaimed lands. For the land use/condition "Herbaceous" and "Desert Shrub" the reference table does not take into account the mechanical treatments applied to the reclaimed lands such as, contouring, terracing, mulching, and small depressions. These land treatments are incorporated into the final reclamation to reduce the potential surface runoff and soil loss, but were not accounted for in establishing the curve numbers.

For the land use/conditions listed under "Arid and Semiarid Rangelands" the reference table does not give curve numbers for hydrologic soil group A, except for "Desert Shrub". A curve number of 63 is given for "Desert Shrub", hydrologic soil group A with poor hydrologic condition. A slightly higher curve number of 65 will be used for hydrologic soil group A in reclaimed lands.

The runoff curve number for the reclaimed lands in each mine area (Area 1, 2, 3, and 4) was estimated from the type and quantity of topdressing material to be salvaged from each area. Refer to [Table 26-10](#) for the topdressing soil types and quantities for each mine area. The hydrologic group classification or rating for each soil mapping unit was obtained from the NRCS soil surveys. The curve numbers associated with each hydrologic group rating was obtained from [Table 26-9](#). The weighted curve number values were calculated using the volume of material from each mapping unit and its contribution to the total volume of topdressing available in each mine area. The weighted values for each mine area were summed to arrive at a mean curve number. Refer to Table 18-5 through 18-8 for the weighted runoff curve numbers for each mine area.

### *26.3.2 Undisturbed and Cultivated Areas*

The land use/condition for undisturbed areas will be identical to the reclaimed lands (same curve numbers). The curve numbers for undisturbed areas will be determined on a case by case basis. The soil types and hydrologic group classification for all the soil types will be obtained from NRCS soil surveys. The curve number associated with the hydrologic group classification will be taken from [Table 26-9](#). In large watersheds with several sub-watersheds, a mean curve number will be calculated for each sub-watershed.

The type of land use and condition selected for the NAPI cultivated fields from the referenced table is “Row crops, Straight row” with good hydrologic conditions. This is conservative since the crop residue cover was not taken into account.

### *26.3.3 Spoil Material*

Spoil material at Navajo Mine typically exhibits hydrologic properties found in hydrologic grouping D. Therefore, a curve number of 89 will be used to model surface discharge for all watersheds composed of disturbed spoil material

## **26.4 Diversions**

All planned permanent diversions will be designed in accordance with Navajo Mine's Reclamation Surface Stabilization Handbook (NTEC formerly known as BHP-Navajo Mine, 1992) (OSM approval date July 22, 1992). Designs and as-builts for diversion structures will be completed and submitted for OSM approval.

Should an existing diversion require additional maintenance (erosion control, improved vegetation establishment, etc.) the channel will be manipulated with either appropriate machinery or by the use of cattle impaction, whichever is deemed most effective by the operator. Machinery may be used to control erosion, and/or prepare for reclamation activities. Where appropriate and feasible, cattle will be used to

impact inslopes. Cattle impactation will reduce erosion, incorporate mulch and seed into the soil and increase water infiltration by creating increased surface roughness.

#### *26.4.1 Lowe/Dixon Diversion Channel Extension*

Removed with Update 1307

#### *26.4.2 North Fork Diversion Channel*

The primary function of the North Fork Diversion Channel will be to prevent or minimize the inflow of surface water into the Dixon Pit Extension, enhancing the efficiency and safety of the mining operations. The upstream end of the diversion starts near the northern permit boundary where the North Fork enters the Permit Area. The diversion routes the North Fork drainage towards the south into a natural drainage, which is a tributary of the Middle Fork of the Cottonwood Arroyo. The location and alignment of the diversion are shown on [Exhibit 26-16](#).

The total length of the diversion is approximately 6,340 feet. The portion to be constructed is approximately 3,980 feet in length and the portion in the natural drainage is approximately 2,360 feet in length. The constructed portion will have a grade of 0.263 percent and the portion in the natural drainage has an average grade of 0.988 percent. The alignment, profile and typical sections for the portion that will be constructed are presented on Exhibit 26-17 ([Sheet 1](#) and [Sheet 2](#)). The constructed portion of the diversion passes through a ridge between Station 26+50 and 31+30. The side slopes through this reach were steepened to minimize excavation and surface disturbance.

The diversion is design to meet the criteria for a temporary diversion as outlined in CFR Part 816.43. A temporary diversion must safely pass the peak discharge from the 10 year–6 hour precipitation event. The hydrology for the North Fork of the Cottonwood was model in SEDCAD to simulate the 2, 5 and 10 year–6 hour storm events. The watershed subdivisions used in the model is presented in [Exhibit 26-18](#). The results from the SEDCAD runs are presented in [Appendix 26.E](#). The peak discharge from the 2, 5 and 10 year-6 hour precipitation events are 244, 472 and 647 cfs, respectively.

The channel design utility in SEDCAD was used to proportion the diversion channel. The diversion channel is designed to 1) remain stable during the peak flow from the 2 and 5 year-6 hour storm events and 2) safely pass the peak flow from the 10 year-6 hour storm event with a minimum freeboard of one foot. The entire length of the diversion is located in the badlands. The soil composition in the badlands is predominately shale and clays. The limiting velocity used in the design for stability is the erosive velocity of the soil, which is estimated to be 5.0 fps. The Manning's roughness coefficient was estimated to be 0.031 in the portion to be constructed. The SEDCAD output for the channel design is presented in

[Appendix 26.E](#). The flow depths and velocities from the SEDCAD channel design utility are summarized in the [Table 26-11](#).

The flow velocities during the peak flows from the 2 and 5 year-6 hour storm events are all less than 5 fps, which indicates that the channel will remain stable with minimal amount of erosion. Some erosion can be expected occur from flows that are greater than the peak flow from the 5 year-6 hour storm. The maximum flow depth during the peak flow from 10 year-6 hour storm event is approximately 4 feet. The minimum design depth is 6 feet thus the channel will safely pass the peak flow form the 10 year-6 hour storm event with a minimum freeboard of 2 feet.

The portion of the diversion in the natural drainage was hydraulically evaluated using Manning's Equation. The flow depths and velocities were determined for the peak flows from the 2, 5 and 10 year-6 hour storm events at five cross sections. The Manning's roughness coefficient (n-value) for the natural drainage was estimated to be: 0.042 for the over bank flow, 0.035 for the channel banks, and 0.030 for the channel bottom. The n-value for the over bank flow is estimated to range from 0.032 to 0.047. In isolated short reaches the n-value is as low as 0.032 and as high as 0.047 but is predominately between 0.040 and 0.045. For this evaluation an n-value of 0.042 was used for the over bank flow. A composite n-value was calculated for each flow depth at each section. The cross section and stage flow data are presented in [Appendix 26.E](#). The flow depths and velocities are summarized in [Table 26-12](#).

The flow velocities during the peak flow from the 2 and 5 year-6 hour storm events are all less than 5 fps at each section except at Station 21+88. Station 21+88 is approximately 170 feet upstream from the point where the drainage enters the Middle Fork of the Cottonwood Arroyo. The channel in the vicinity of Station 21+88 is deeply incised. The channel bed has eroded downward to match the elevation of the channel bed in the Middle Fork. The higher flow velocities in this reach are due to the incised channel confining the flow. The average velocity during the peak flow from the 10 year-6 hour storm for this reach is 4.49 fps, but the velocity in the incised portion of the channel is probably in the range of 6 to 7 fps. Some erosion is expected to occur through this reach particularly in the lateral direction thus widening the channel. The extent of widening will depend on the magnitude of the flows that occur while the diversion is in service.

The typical configuration of the natural drainage is a swale with an incised channel. The dimension of the incised channel varies as shown in [Table 26-13](#).

With the increased flows through the natural drainage some erosion is expected to occur. Additional down cutting of the channel bed is expected to occur particularly during storms that are greater than the 10 year-6

hour events. The major channels in the surrounding area have stabilized at grades between 0.7 and 0.9 percent. The reach of the diversion that is in the natural channel has an average grade of 1.0 percent. From field observations there is indications of bedrock outcropping at Station 0+50 and about midway at Station 10+10. These may develop into natural grade control structures. The rock outcrop at the upstream end does not appear to be as competent as the one downstream. In the worst-case scenario, maximum head cutting will occur if the channel stabilizes to a 0.7 percent grade. If this occurs the head cutting at Station 0+50 and 10+10 is expected to be approximately 3.0 and 4.0 feet, respectively. Assuming the outcropping rock is competent to withstand the flow velocities.

To minimize surface disturbance the channel in the natural drainage will be allowed to stabilize through natural processes. However if head cutting should exceed 5 feet in any reach, then corrective measures will be taken to prevent further head cutting upstream. The depth of head cutting will be measured from the current flow line. Riprapped drop structures will be considered as a mitigation measure. If the channel were not allowed to develop and stabilize through natural processes the alternative would be to construct a channel at a uniform grade on the current alignment. This will require m10/99; 6/01 ore surface disturbance and excavation.

Riprapped downdrains will be installed to control erosion in locations where existing side drainages enter the diversion channel. The riprap rock is sized for the 10 year-6 hour peak flow. For the locations and details of the riprapped downdrains see Exhibit 26-17 ([Sheet 1](#) and [Sheet 2](#)). The hydrology and design data for the downdrains are presented in [Appendix 26.E](#).

The design criteria for the riprapped downdrains was revised, the flows to the downdrains are from ephemeral streams such flows are classified as miscellaneous flows. Temporary diversions for miscellaneous flows are designed to safely pass the peak flow from the 2 year-6 hour storm event (CFR 816.43(c)(3)). The revised design data for the riprapped downdrains are presented in [Appendix 26.E](#) (as-built data) of the PAP.

When the diversion is no longer needed it will be re-graded and reclaimed in accordance with the guidelines and procedures outlined in Section 35 – Hydrologic Reclamation Plan.

#### 26.4.2.1 Drainage/Sediment Control for Excess Material Dump

During construction the excess excavation or waste was dumped along the west side of the diversion channel. To control drainage and sediment from the dump a berm will be constructed adjacent to the toe of west slope that will direct the drainage to the low points. At the natural low points or existing drainages there will be a break in the berm with a silt fence to release the drainage and retain the sediment. In some

cases where the natural topography is favorable, a berm may not be required to direct the drainage to the low point where the silt fence will be placed. Refer to the typical section and profile on [Figure 26-3](#) for location of berm and silt fences.

On the east side of the dump the slope for the most part is constructed flush with the cut slope of the channel. A short segment at the north end has a 15-foot bench at the crest of the cut. There is essentially no room to construct a berm or ditch to collect the runoff from the dump slope without moving the dump towards the west. In lieu of moving the dump to create room for placing drainage control structures an evaluation comparing the soil loss from the undisturbed surface with the dump slope was done to determine the potential degree of impact.

Slope/length measurements were taken on the east slope and on the undisturbed area adjacent to the west side of the dump. The data was used as input parameters in RUSLE Version 1.06 to determine the soil loss. The input parameters along the length of the dump were averaged based on similarity of conditions. The weighted average soil loss is based on the lengths of similar conditions along the dump and not on area. Refer to the [Table 26-14](#), [Table 26-15](#), [Table 26-16](#), and [Table 26-17](#) for the field measurements taken and the results from RUSLE Version 1.06. The estimated weighted average soil loss from the east dump slope is 2.0 ton/acre and from the undisturbed surface it is 1.9 ton/acre. The soil loss from the east dump slope is 5 percent more than the adjacent undisturbed surface. The additional sediment from the dump slope is very minimal, thus the potential impact to the downstream flow would be insignificant. Also the area in question (east dump slope) is very small compared to the total surface disturbance for the South Dixon Pit extension.

### **26.5 Discharges Into an Underground Mine**

No underground mining is anticipated within the proposed Permit Area, and therefore, the potential for discharges to an underground mine do not exist.

#### *References*

BHP Navajo Coal Company (BNCC). 1992. Reclamation Surface Stabilization Handbook. Unpublished report, available for review at the Navajo Mine Environmental Quality Department

United States Department of Agriculture, Soil Conservation Service. 1980. Soil Survey of San Juan County, New Mexico, Eastern Part.

Table 26-1 Primary Culverts

Culvert Label	Watershed Area (ac)	Culvert Diameter (inches)	Installed Slope (%)	Culvert Length (feet)	Tailwater Depth (ft)	Design Q (cfs)	Required HW (ft)	Available HW (ft)	Hydrology Appendix
CP-18	460.6	90.0	3.0	305	0	142.90	4.7	36.6	23.A
CP-20	42.2	24.0	2.5	262	2.6	27.18	12.0	27	23.A
CP-22	80.6	48.0	1.0	282	0	32.15	2.6	10	23.A
CP-31	23611.2	48.0	3.1	150	3.5	325.70	8.5	9.5	23.A
CP-32		48.0	3.1	150	3.5	325.70	8.5	9.5	23.A
CP-33		48.0	3.1	150	3.5	325.70	8.5	9.5	23.A
CP-34		48.0	3.1	150	3.5	325.70	8.5	9.5	23.A
CP-35A		662.4	24.0	2.4	147	0	18.22	2.9	4.3
CP-35B	24.0		2.4	147	0	18.22	2.9	4.3	23.A
CP-36	19.1	48.0	0.6	70	0	15.97	1.8	6.5	23.A
CP-37	21.3	24.0	1.5	160	0.9	12.29	2.3	5.5	23.A
CP-49	2.6	12.0	2.0	140	0	3.01	1.4	8	23.A
CP-50	72.2	30.0	2.1	140	0	49.00	5.9	7	23.A
CP-51	122.1	36.0	1.1	134	0	71.06	6.3	6.7	23.A
CP-52	510.6	42.0	0.7	137	0	112.00	8.4	8.6	23.A
CP-53		42.0	0.7	141	0	112.00	8.4	8.6	23.A
CP-53a		Removed culvert CP-53a, not install							
CP-54	18.5	18.0	1.1	178	0	13.47	5.0	12.5	23.A
CP-55	319.1	42.0	1.6	204	0	139.63	11.3	11.5	23.A
CP-55a		Removed culvert CP-55a, not install							
CP-56	195.1	48.0	1.7	170	0	109.90	12.3	16.5	23.A
CP-57	3.7	18.0	3.0	174	0	4.28	1.3	10.4	23.A

Table 26-1 (Continued)

Culvert Label	Watershed Area (ac)	Culvert Diameter (inches)	Installed Slope (%)	Culvert Length (feet)	Tailwater Depth (ft)	Design Q (cfs)	Required HW (ft)	Available HW (ft)	Hydrology Appendix
CP-58	4.7	18.0	3.3	140	0	5.44	1.5	9.8	23.A
CP-59	4.5	18.0	3.4	142	0	5.24	1.5	9.6	23.A
CP-60	13.8	18.0	2.5	230	0	15.95	5.2	7	23.A
CP-61	53.9	30.0	2.9	140	0	39.23	4.4	6.5	23.A
CP-62	8.7	18.0	3.6	128	0	10.07	2.4	3.7	23.A
CP-63A	4.36	16.0	1.0	40	0	10.13	3.5	3	23.A
CP-63B		15.0	2.8	133	0	10.13	4.5	4.5	23.A
CP-66				RESERVED					
CP-67				CULVERT REMOVED					
CP-68				Plugged and made inactive, surface run off diverted into pit					
CP-69	7.1	72.0	1.1	83	0	5.05	1.0	7.00	23.A
CP-74	15.7	76.0	1.1	110	0	16.93	0.5	7.00	23.A
CP-77	46.5	36.0	1.0	231	0	14.22	1.8	6.00	23.A
CP-83	64.7	24.0	14.0	155	0	7.99	1.6	10.54	23.A
CP-84	5.5	15.6	0.9	48	0	3.90	1.5	2.50	23.A
CP-85	5.2	15.6	2.7	65	0	3.85	1.5	2.50	23.A
CP-91	17.8	18.0	1.0	70	0	10.95	1.8	2.80	23.A
CP-93	51.2	48.0	1.0	230	0	23.08	2.0	4.00	23.A
CP-103	29.2	30.0	1.0	124	0	22.75	2.9	4.00	23.A
CP-104	64.2	36.0	1.0	161	0	28.78	2.8	4.00	23.A
CP-106	1.8	10.0	6.5	75	0	1.16	1.0	1.60	23.A

Navajo Mine Permit Application Package

Culvert Label	Watershed Area (ac)	Culvert Diameter (inches)	Installed Slope (%)	Culvert Length (feet)	Tailwater Depth (ft)	Design Q (cfs)	Required HW (ft)	Available HW (ft)	Hydrology Information Appendix
CP-107	4.6	10.0	9.0	75	0	2.12	1.5	1.50	23.A
CP-109									
CP-119	31.9	18.0	2.2	95	0	4.15	1.2	3.83	23.A
CP-120	8.9	18.0	1.9	79	0	2.87	1.2	3.80	23.A
CP-122	13.0	24.0	1.0	54	0	2.26	0.8	6.00	23.B
CP-123	187.4	24.0	1.0	50	0	6.32	1.3	3.30	23.B
CP-124	372.0	24.0	1.0	50	0	7.74	1.5	3.30	23.B
CP-126	24.6	24.0	1.5	144	0	13.21	2.8	3.60	23.A
CP-128	58.6	24.0	1.5	116	0	14.23	3.3	8.00	23.A
CP-129	1.7	24.0	3.7	148	0	1.97	1.0	4.00	23.A
CP-130	0.9	24.0	5.2	142	0	1.04	0.7	15.40	23.A
CP-131	19.0	24.0	1.9	146	0	12.47	3.5	19.20	23.A
CP-132	12.0	24.0	2.6	132	0	7.51	1.6	12.40	23.A
CP-133	4.6	24.0	2.2	124	0	5.32	2.0	13.90	23.A
CP-134	137.0	42.0	1.7	132	0	81.00	5.4	13.50	23.A
CP-136	74.4	24.0	1.8	112	0	38.62	3.7	5.60	23.A
CP-137	25.8	24.0	1.9	226	0	17.23	4.2	29.30	23.A
CP-138	2.2	24.0	1.3	168	0	2.55	1.0	26.00	23.A
CP-139	16.5	24.0	2.2	154	0	16.52	3.7	3.90	23.A
CP-140	19.5	24	1.5	100	0	2.6	2.5	4.00	23.A

Table 26-1-3

Navajo Mine Permit Application Package

Culvert Label	Watershed Area (ac)	Culvert Diameter (inches)	Installed Slope (%)	Culvert Length (feet)	Tailwater Depth (ft)	Design Q (cfs)	Required HW (ft)	Available HW (ft)	Hydrology Information Appendix
CP-141	6.0	24.0	2.0	122	0	6.95	1.6	8.30	23.A
CP-142	4.0	24.0	2.6	192	0	4.63	1.3	18.80	23.A
CP-143	4.2	24.0	4.6	226	0	4.86	1.3	3.50	23.A
CP-144	105.7	42.0	2.0	168	0	58.82	4.7	20.80	23.A
CP-145	23.0	24.0	1.5	188	0	15.46	3.4	12.90	23.A
CP-150	12.8	24.0	1.9	190	0	13.91	2.2	4.00	23.A
CP-151	Plugged and made inactive, surface run off diverted into pit								
CP-157	28.7	24.0	2.3	86	0	20.90	3.3	4.10	23.A
CP-158	38.9	24.0	2.0	94	0	28.33	5.7	6.10	23.A
CP-159	11.4	24.0	4.8	94	0	13.20	2.0	4.70	23.A
CP-160	23.7	24.0	0.9	90	0	16.66	2.9	4.90	23.A
CP-161	102.1	42.0	3.0	100	0	59.76	4.1	4.40	23.A
CP-162	40.2	24.0	2.1	86	0	28.88	5.8	8.00	23.A
CP-163	17,258.7	96.0	0.9	150	0	647.00	12.5	13.60	23.A
CP-164	45.5	30.0	1.5	94	0	27.11	3.1	4.50	23.A
CP-165	14.7	18.0	1.4	86	0	10.54	3.2	3.60	23.A
CP-166	13.0	24.0	2.0	100	0	15.05	2.4	5.00	23.A
CP-167	1.3	18.0	8.8	136	0	1.50	0.5	5.00	23.A
CP-168	0.7	12.0	9.7	110	0	0.81	0.5	2.50	23.A
CP-171	246.3	24.0	2.7	60	0	22.28	4.0	4	23.A
CP-173	6.8	24.0	3.5	74	0	8.21	1.5	4.3	23.A
CP-182	34.1	24	1.9	140	0	24.1	4.0	5	23.A
CP-183	6.5	24	2.0	130	0	6.61	1.4	3.85	23.A

Table 26-1-4

---

Culvert Label	Watershed Area (ac)	Culvert Diameter (inches)	Installed Slope (%)	Culvert Length (feet)	Tailwater Depth (ft)	Design Q (cfs)	Required HW (ft)	Available HW (ft)	Hydrology Information Appendix
CP-185	24.38	24	9.0	130	0	9.94	1.8	3.2	23.A
CP-186	108.5	24	2.9	206	0	13.02	2.0	5.3	23.A
CP-187	54.5	24	1.5	206	0	4.95	1.3	3.95	23.A
CP-189	90.6	30	5.2	330	0	65.69	10	23	23.A
CP-323	106.8	18	1.0	124	0	7.03	1.8	3	23.A
CP-324	41.7	24.0	0.6	110	0	10.41	2.1	3.25	23.A

---

Table 26-1-5

Table 26-2 Downdrains

Culvert Label	Watershed Area (ac)	Culvert Diameter (inches)	Installed Slope (%)	Culvert Length (feet)	Tailwater Depth (ft)	Design Q (cfs)	Required HW (ft)	Available HW (ft)	Hydrology Information Appendix
CP-86	23.9	15	10.99	14	0	5.02	1.6	2.25	23.A
CP-87	6.0	15.6	10.2	19	0.00	4.65	1.5	3.80	23.A
DD-01	19.5	30.0	34.0	36	0.00	2.04	0.6	4.00	23.A
DD-02	19.5	30.0	34.9	53	0.00	2.04	0.6	4.00	23.A
DD-03	19.5	30.0	37.6	53	0.00	2.04	0.6	4.00	23.A
DD-04	1.7	16.0	66.3	65	0.00	1.12	0.5	2.00	23.A
DD-05	10.4	42.0	28.6	29	0.00	3.22	0.8	4.00	23.A
DD-06	15.2	15.0	19.7	44	0.00	5.08	0.5	4.00	23.A
DD-07	56.2	15.0	20.4	325	0.00	5.18	2.2	2.25	23.A
DD-08	56.2	15.0	67.4	90	0.00	5.18	2.2	2.25	23.A
DD-09	56.2	15.0	66.3	87	0.00	5.18	2.2	2.25	23.A
DD-10	4.6	15.0	50.3	105	0.00	0.33	0.5	1.25	23.A
DD-11	4.6	15.0	12.1	408	0.00	0.33	0.5	1.25	23.A
DD-12	4.6	15.0	58.8	68	0.00	0.33	0.5	1.25	23.A
DD-13	15.0	15.0	27.9	206	0.00	0.97	0.6	1.25	23.A
DD-14	15.0	15.0	34.4	153	0.00	0.97	0.6	1.25	23.A
DD-15	15.0	15.0	32.4	154	0.00	0.97	0.6	1.25	23.A
DD-16	61.6	15.0	28.9	160	0.00	7.79	2.7	2.75	23.A
DD-17	61.6	15.0	29.4	126	0.00	7.79	2.7	2.75	23.A
DD-18	61.6	15.0	23.8	170	0.00	7.79	2.7	2.75	23.A
DD-19	4.3	15.0	36.0	55	0.00	5.00	1.5	5.00	23.A
DD-20	1.4	15.0	36.0	55	0.00	1.60	0.8	4.50	23.A

Table 26-2 (Continued)

Culvert Label	Watershed Area (ac)	Culvert Diameter (inches)	Installed Slope (%)	Culvert Length (feet)	Tailwater Depth (ft)	Design Q (cfs)	Required HW (ft)	Available HW (ft)	Hydrology Information Appendix
DD-21	5.3	15.0	45.0	68	0.00	3.90	1.0	4.90	23.A
DD-22	0.2	15.0	50.0	250	0.00	0.22	0.3	1.50	23.A
DD-23	0.1	16.0	68.0	52	0.00	1.08	0.9	1.80	23.A
DD-24	0.1	10.0	50.0	45	0.00	0.54	1.0	1.40	23.A
DD-25	0.9	9.0	25.0	68	0.00	1.08	0.9	1.80	26.B
DD-27	0.4	12.0	65.0	25	0.00	0.54	0.4	1.00	26.B
DD-29	1.81	16.0	60.0	73	0.00	1.84	0.8	5.00	23.A
DD-30	6.3	4.0	50.0	334	0.00	1.09	1.6	5.11	23.A

Table 26-3 Ancillary Road Culverts

Culvert Label	Watershed Area (ac)	Culvert Diameter (inches)	Installed Slope (%)	Culvert Length (feet)	Tailwater Depth (ft)	Design Q (cfs)	Required HW (ft)	Available HW (ft)	Hydrology Information Appendix
CP-64									REMOVED CULVERT
CP-65									REMOVED CULVERT
CP-75A	37.4	7.2	0.6	106	0	10.44	25	2.3	23.A
CP-75B		7.2	0.6	106	0	10.44	25	2.3	23.A
CP-76	4.1	24.0	1.3	89	0	3.18	1.0	3.00	23.A
CP-79	5.3	15	23.43	37	0	5.71	2	1.3	23.A
CP-80A	17.1	15.0	4.4	31	0	6.49	3.0	3.50	23.A
CP-80B		15.0	2.3	31	0	6.49	3.0	3.50	23.A
CP-81A	24.5	15.0	3.1	34	0	7.75	2.8	2.80	23.A
CP-81B		15.0	3.2	24	0	7.75	2.8	2.80	23.A
CP-88	3.9	14.5	1.8	39	0	1.60	1.0	2.70	23.A
CP-89	0.6	15.0	5.5	22	0	0.65	0.5	2.00	23.A
CP-90	1.21	15.0	9.16	24	0	1.3	0.62	1.5	23.A
CP-92	138.7	30.0	3.5	50	0	18.90	2.9	4.00	23.A
CP-94	1.7	12.0	0.9	31	0	2.22	1.5	2	23.A
CP-95	9.6	24.0	1.0	26	0	9.94	1.8	3.5	23.A
CP-96	2.3	18.0	0.5	144	0	1.8	0.2	2	23.A
CP-108	332.3	30.0	0.1	28	0	29.09	3.7	5.40	23.A
CP-110	0.4	117x79 arch	1.7	110	0	0.45	5.0	10.00	23.A
CP-125	4.2	16.0	1.3	28	0	1.12	0.6	1.80	23.A
CP-169	0.5	18.0	10.6	40	0	0.26	0.4	2.50	23.A
CP-170	1.0	18.0	6.4	48	0	0.52	0.4	4.8	23.A
CP-174	13.4	18	4.4	35	0	5.47	1.5	2.00	23.A
CP-175	14.4	16	1.5	40	0	5.88	1.7	2.20	23.A
CP-176	2.6	16	4.5	35	0	1.06	0.4	1.90	23.A
CP-177	58.6	30	3.0	40	0	16.58	2.0	3.50	23.A
CP-178	0.6	16	3.0	36	0	0.25	0.2	1.60	23.A
CP-179	0.7	16	4.0	40	0	0.29	0.2	1.90	23.A
CP-180	5.1	16	2.0	40	0	2.1	0.4	2.10	23.A
CP-181A	23	16	2.4	33	0	4.7	1.4	2.70	23.A
CP-181B		16	2.4	33	0	4.7	1.4	2.70	23.A

Table 26-3 (Continued)

Culvert Label	Watershed Area (ac)	Culvert Diameter (inches)	Installed Slope (%)	Culvert Length (feet)	Tailwater Depth (ft)	Design Q (cfs)	Required HW (ft)	Available HW (ft)	Hydrology Information Appendix
CP-184	11.43	16.0	0.20	191	0	4.04	1.3	2.0	23.A
CP-189	0.6	16	3.1	40	0	0.31	2.3	3.5	23.A
CP-190	1.1	16	1.3	40	0	0.56	1.1	4.85	23.A
CP-202	2.9	18.0	3.8	30	0	1.18	0.6	3.5	23.A
CP-203	4.2	18.0	4.9	30	0	1.72	0.7	2.5	23.A
CP-204	3.5	18.0	2.6	61	0	1.43	0.6	6	23.A
CP-205	10.76	24.0	1.5	60	0	14.64	2.4	3.4	23.A
CP-206	12.67	24.0	2	60	0	17.24	2.7	3.5	23.A
CP-207	5.12	16.0	1.5	44	0	6.97	2.3	3.2	23.A
CP-300	8.9	24	8.2	110	0	4.59	1.0	3.2	23.A
CP-301	1.3	24.0	6.3	122	0	1.24	0.5	8.90	23.A
CP-302	8.4	18.0	5.6	80	0	8.31	1.3	3.50	23.A
CP-303	2.4	18.0	4.1	86	0	2.85	0.8	3.3	23.A
CP-304	2.3	18.0	5.0	80	0	2.23	0.7	2.8	23.A
CP-305A&B	14.6	18 (2)	6.3	120	0	8.23	1.5	2.6	23.A
CP-306	2.7	18	3.3	80	0	2.67	0.7	5.5	23.A
CP-307	20.6	18	5.4	80	0	11.5	1.3	6.8	23.A
CP-308A&B	22.2	18	2.7	80	0	12.01	1.8	2.3	23.A
CP-309	9.2	18	2.3	80	0	9.08	1.3	5	23.A
CP-320A&B	10.0	18 (2)	1.3	80	0	12.01	1.5	4.9	23.A
CP-321	28.4	24	1.4	100	0	33.95	2.0	7.1	23.A

Table 26-4 Railroad Culverts

Culvert locations can be found on Exhibits 26-1 through 26-6 and Exhibits 10-4 through 10-7

Culvert Label	Watershed Area (ac)	Culvert Diameter (inches)	Installed Slope (%)	Culvert Length (feet)	Tailwater Depth (ft)	Design Q (cfs)	Required HW (ft)	Available HW (ft)	Hydrology Information Appendix
CP-01	92.1	48	2.5	76	2.7	40.02	2.8	13.7	23.A
CP-02	133.5	48	3.2	183	3.3	76.61	4.8	35.6	23.B
CP-03	87.6	48	2.6	100	2.1	44.35	3.5	18.6	23.A
CP-04	40.9	48	1.8	68	2	25.50	2.0	13.8	23.A
CP-05	27209.8	84	0.7	311	0	585.50	15.0	70.3	23.A
CP-06	195.1	60	2.1	218	1	68.54	3.8	36	23.A
CP-07 <sup>1</sup>	103.9	42	1.1	158	0	23.58	0.8	2	26.C
CP-08 <sup>2</sup>	76.2	30	0.4	81	0	21.70	1.0	2.5	26.C
CP-09 <sup>2</sup>	76.2	30	4.3	48	0	21.70	2.6	6.5	26.C
CP-10 <sup>3</sup>	55.8	24	4.2	120	0	13.00	2.2	2.7	26.C
CP-11	12.2	24	0.6	107	1	13.15	2.5	8.6	23.A
CP-12	26.5	24	2.2	101	1.2	18.52	2.9	6.3	23.A
CP-13	79.3	30	3.5	73	1.7	37.13	5.0	13.4	23.A
CP-14	79.3	30	3.7	129	4	37.13	5.0	8.5	23.A
CP-15	28.0	24	2.6	108	0.5	20.88	4.0	11.9	23.A
CP-16	196.4	60	1.1	153	0	15.18	2.7	42.5	23.A
CP-17	492.60	108	0.3	187	0	145.80	5.5	8.6	23.A
CP-19	72.3	30	0.6	203	0	49.45	9.6	23.4	23.A
CP-23 <sup>4</sup>	122.7	58 x 36 Arch	1.5	146	3.8	41.59	1	10	26.C
CP-24 <sup>4</sup>		58 x 36 Arch	1.5	146	3.8	41.59	1	10	26.C
CP-97 <sup>5</sup>	89.1	24	0.93	140	0	10.99	1.87	7.2	26.C
CP-98	2.0	16	1	80	0	2.16	1.6	2.5	26.B
CP-99	2.0	16	1	80	0	2.16	1.6	2.5	26.B
CP-100	0.2	24	2	60	0	0.54	1.6	3	26.B
CP-101	2.0	12	1	40	0	2.16	1.6	3	26.B
CP-102	1.0	24	1	50	0	1.08	2.4	3	26.B

Notes: <sup>1</sup> Spillway for Block C Pond 3      <sup>2</sup> Spillway for Block C Pond 2      <sup>3</sup> Spillway for Block C Pond 1

<sup>4</sup> Spillway for Barber Stockpile Pond #2      <sup>5</sup> Spillway for Hosteen Stockpile Pond #3

*Navajo Mine Permit Application Package*

---

Table 26-5 Pond Cross Reference

Pond Name	Pond Information
Area 3 Lowe Hole 3 Pond 2	Table 26-5.1 & Table 26.8
Area 3 Lowe Permanent Impoundment 1	Table 26-5.2
Area 2 Barber Stockpile Pond 2	Table 26-5.3
Area 2 Barber Stockpile Pond 3	Table 26-5.4
Area 2 South Barber Pond	Table 26-5.5
Area 3 Collyer Road Pond #4	Table 26-5.6
Area 1 Emma's Pond	Table 26-5.7
Area 2 Hosteen Stockpile Pond 1	Table 26-5.8
Area 2 Hosteen Stockpile Pond 2	Table 26-5.9
Area 2 Hosteen Stockpile Pond 3	Table 26-5.10
Area 3 Lowe Railroad Impoundment #1	Table 26-5.11
Area 3 Lowe Railroad Impoundment #2	Table 26-5.12
Area 3 Lowe Stockpile Pond	Table 26-5.13
Area 1 North Pinto Pond	Table 26-5.14
Area 1 North Pond All Cells	Table 26-5.15
Area 1 North Pond 1 Cell A	Table 26-5.16
Area 1 North Pond 1 Cell A2	Table 26-5.17
Area 1 North Pond 1 Cell B	Table 26-5.18
Area 1 North Pond 1 Cell C	Table 26-5.19
Area 1 Pond 5	Table 26-5.20
Area 3 Northwest Dixon	Table 26-5.21
Area 3 South Dixon Pond 1	Table 26-5.22
Area 3 South Dixon Pond 2	Table 26-5.23
Area 3 South Dixon Pond 3	Table 26-5.24
Area 3 Southwest Dixon Pond	Table 26-5.25
Area 1 Vinnel Pond	Table 26-5.26
Area 2 Block C Pond 1	Table 26-5.27
Area 2 Block C Pond 2	Table 26-5.28
Area 2 Block C Pond 3	Table 26-5.29
Area 3 Lowe Hole 3 Pond 3	Table 26-5.30 & Table 26.8
Area 2 Mason Pond	Table 26-5.31
Area 2 Employee Coal Dump Pond	Table 26-5.32
Area 4 Pond 401	Table 26-5.33

Table 26-5 (Continued)

Pond Name	Pond Information
Area 4 North Pond 412	Table 26-5.34
Area 4 North Pond 3	Table 26-5.35
Area 4 North Pond 4	Table 26-5.36
Open	Table 26-5.37
Area 4 North Pond 411	Table 26-5.38
Area 4 North Pond 413	Table 26-5.39
Area 4 North Pond 402	Table 26-5.40
Open	Table 26-5.41
Area 4 North Pond 408	Table 26-5.42
Area 4 North Pond 409	Table 26-5.43
Area 4 North Pond 410	Table 26-5.44
Area 3 North Pond 301	Table 26-5.45
Area 3 North Pond 302	Table 26-5.46
Area 2 Block C Pond 4	Table 26-5.47
Area 3 Pond 309A	Table 26-5.48
Area 3 Pond 309B	Table 26-5.49
Area 4 North Pond 414	Table 26-5.50
Open	Table 26-5.51
Area 3 Pond 306	Table 26-5.52
Area 3 North Fork Pond	Table 26.8
Area 4 North Pond 406	Table 26.8
Area 4 North Pond 407	Table 26.8
Area 2 Pond 201	Table 26-5.53
Area 2 Pond 202	Table 26-5.54
Area 3 Pond 310	Table 26-5.55
Area 3 Pond 311	Table 26-5.56

Table 26-5.1 Area 3 Lowe Hole 3 Pond 2

Type of Pond	Impoundment
Location	Exhibit 26-24
Purpose	Minimizes inflow into Lowe Pit, thus enhancing the safety of the mining operations. Not classified as a sediment pond.
Design Information	Appendix 26.C, Exhibit 26-52
As-Built Information	Exhibit 26-55
Intended Life Span	Will be removed in 2025.
Watershed Area (ac)	628.7
As-Built Capacity (ac-ft)	9.82
Curve Number (SCS)	88
Design Storm Event	2 year-6 hour
Peak Discharge (cfs)	23.8
Runoff Volume (ac-ft)	7.7
Max. Permissible Gauge Reading for Water/Sediment (ft)	N/A
Depth at Upstream Toe (ft)	10
NRCS Hazard Classification	Low
Spillway Type	Emergency
25 yr - 6 hr Peak Discharge (cfs)	109.1 (spillway)
Foundation Soil Type	Spoils (shale and sandstone cobbles)
Comments	Pond minimizes the inflow of runoff into Lowe Pit during the more frequent low intensity storms. Overflow will be retained in the pit; off lease discharge is very unlikely.

Table 26-5.2 Area 3 Lowe Impoundment 1

Type of Pond	Impoundment
Location	Exhibit 26-12
Purpose	Minimize inflow into Lowe Pit, thus enhancing the safety of the mining operations. Not classified as a sediment pond.
Design Information	Appendix 26.C and Exhibit 11-127
As-Built Information	Pending
Intended Life Span	Will be removed in 2025
Watershed Area (ac)	1642 ac.
As-Built Capacity (ac-ft)	Pending As-built
Curve Number (SCS)	Refer to Appendix 26.C
Design Storm Event	25 year 6 hour for spillway
Peak Discharge (cfs)	241.9
Runoff Volume (ac-ft)	50.04
Max. Permissible Gauge Reading for Water/Sediment (ft)	N/A
Depth at Upstream Toe (ft)	7
NRCS Hazard Classification	Low Potential
Spillway Type	Emergency
25 yr - 6 hr Peak Discharge (cfs)	241.9
Foundation Soil Type	Clay
Comments	Spoil

---

Table 26-5.3 Area 2 Barber Stockpile Pond 2

Type of Pond	I
Location	Exhibit 26-10 and 26-11
Purpose	Contain surface runoff water runoff from the Barber Stockpile area.
Design Information	Appendix 26.C
As-Built Information	Exhibit 26-8
Intended Life Span	Will be removed in 2025.
Watershed Area (ac)	106.6
As-Built Capacity (ac-ft)	8.02
Curve Number (SCS)	81.9
Design Storm Event	100 year – 6 hour
Peak Discharge (cfs)	82.12
Runoff Volume (ac-ft)	5.72
Max. Permissible Gauge Reading for Water/Sediment (ft)	5.1, Elev.5280.0
Depth at Upstream Toe (ft)	4
NRCS Hazard Classification	Low
Spillway Type	N/A
25 yr - 6 hr Peak Discharge (cfs)	N/A
Foundation Soil Type	Sandy Clay
Comments	Incised ponds with mild slopes.

Table 26-5.4 Area 2 Barber Stockpile Pond 3

Type of Pond	Detention
Location	Exhibit 26-10 and 26-11
Purpose	Contain surface runoff water runoff from the Barber Stockpile area.
Design Information	Appendix 26.C
As-Built Information	Exhibit 26-33
Intended Life Span	Will be removed in 2025.
Watershed Area (ac)	59.8
As-Built Capacity (ac-ft)	3.74
Curve Number (SCS)	76
Design Storm Event	10 year – 24 hour
Peak Discharge (cfs)	4.28
Runoff Volume (ac-ft)	1.13
Max. Permissible Gauge Reading for Water/Sediment (ft)	5.6, Elev. 5347.6
Depth at Upstream Toe (ft)	4
NRCS Hazard Classification	Low
Spillway Type	Trickle Tube & Emergency Spillway
25 yr - 6 hr Peak Discharge (cfs)	0.63 at spillway
Foundation Soil Type	Sandy Clay
Comments	Incised ponds with mild slopes.

Table 26-5.5 Area 2 South Barber Pond

Type of Pond	Sediment
Location	Exhibit 26-11
Purpose	Contain runoff from South Barber Ramp 5 reclaim area.
Design Information	Exhibit 26-39, Appendix 26.C
As-Built Information	Exhibit 26-40
Intended Life Span	2016
Watershed Area (ac)	157.4
As-Built Capacity (ac-ft)	6.17
Curve Number (SCS)	Refer to Appendix 26.C
Design Storm Event	100 year 6 hour
Peak Discharge (cfs)	70.0
Runoff Volume (ac-ft)	5.43
Max. Permissible Gauge Reading for Water/Sediment (ft)	2.2 (elev. 5384.2)
Depth at Upstream Toe (ft)	8.0
NRCS Hazard Classification	Low
Spillway Type	N/A
25 yr - 6 hr Peak Discharge (cfs)	N/A
Foundation Soil Type	Clay spoils
Comments	

Table 26-5.6 Area 3 Collyer Road Pond #4

Type of Pond	Sediment
Location	Exhibit 26-12
Purpose	Surface water and Sediment control for South Dixon Pit.
Design Information	Appendix 26.C
As-Built Information	Exhibit 26-43
Intended Life Span	Will be removed in 2025
Watershed Area (ac)	142.1 – Worst case using AOC topo./ (45.8 Ac.– Current topo).
As-Built Capacity (ac-ft)	11.8
Curve Number (SCS)	86/(78 and 86)
Design Storm Event	100 year - 6 hour
Peak Discharge (cfs)	81.9/(40.1)
Runoff Volume (ac-ft)	10.0/(2.4)
Max. Permissible Gauge Reading for Water/Sediment (ft)	2.4, Elev. 5263.4/(7.0, Elev. 5268.0)
Depth at Upstream Toe (ft)	8.0
NRCS Hazard Classification	Low
Spillway Type	N/A
25 yr - 6 hr Peak Discharge (cfs)	N/A
Foundation Soil Type	Sandy clay
Comments	Meets the applicable mass stability criteria of 30 CFR § 816.49 based on evidence from NM-0003C Chapter 29.

---

Table 26-5.7 Area 1 Emma's Pond

Type of Pond	Sediment
Location	Exhibit 26-9
Purpose	Prevents undisturbed surface water runoff from entering the north industrial area.
Design Information	Appendix 26.F, Exhibit 11-31 & Exhibit 26-28
As-Built Information	Exhibit 26-27
Intended Life Span	Will be removed in 2025.
Watershed Area (ac)	91.5
As-Built Capacity (ac-ft)	9.66
Curve Number (SCS)	80
Design Storm Event	100 year-6 hour
Peak Discharge (cfs)	76.22
Runoff Volume (ac-ft)	3.34
Max. Permissible Gauge Reading for Water/Sediment (ft)	5.8, Elev. 5358.6
NRCS Hazard Classification	Low
Spillway Type	Emergency Spillway
25 yr - 6 hr Peak Discharge (cfs)	7.14 (discharge at spillway)
Foundation Soil Type	Sand with some clay.
Comments	Static factor of safety of 1.5 and seismic factor of safety of 1.2.

---

Table 26-5.8 Area 2 Hosteen Stockpile Pond 1

Type of Pond	Sediment
Location	Exhibit 26-10
Purpose	Contain surface water runoff from the Hosteen Stockpile area.
Design Information	Appendix 26.C.
As-Built Information	Exhibit 26-30
Intended Life Span	Will be removed in 2025.
Watershed Area (ac)	155.54
As-Built Capacity (ac-ft)	10.71
Curve Number (SCS)	79.1
Design Storm Event	10 year – 24 hour
Peak Discharge (cfs)	22.17
Runoff Volume (ac-ft)	4.01
Max. Permissible Gauge Reading for Water/Sediment (ft)	11.3, Elev. 5269.2
Depth at Upstream Toe (ft)	15
NRCS Hazard Classification	Low
Spillway Type	Emergency Spillway
25 yr - 6 hr Peak Discharge (cfs)	16.06 at spillway
Foundation Soil Type	Sandstone and shale
Comments	

---

Table 26-5.9 Area 2 Hosteen Stockpile Pond 2

Type of Pond	Sediment
Location	Exhibit 26-10
Purpose	Contain surface water runoff from the Hosteen Stockpile area.
Design Information	Appendix 26.C.
As-Built Information	Exhibit 26-31
Intended Life Span	Will be removed in 2025.
Watershed Area (ac)	122.8
As-Built Capacity (ac-ft)	12.98
Curve Number (SCS)	83
Design Storm Event	10 year – 24 hour
Peak Discharge (cfs)	26.55
Runoff Volume (ac-ft)	4.36
Max. Permissible Gauge Reading for Water/Sediment (ft)	7.7, Elev.5300.5
Depth at Upstream Toe (ft)	15
NRCS Hazard Classification	Low
Spillway Type	Trickle Tube & Emergency Spillway
25 yr - 6 hr Peak Discharge (cfs)	37.71
Foundation Soil Type	Spoils (sandstone and shale)
Comments	

---

Table 26-5.10 Area 2 Hosteen Stockpile Pond 3

Type of Pond	Sediment
Location	Exhibit 26-10
Purpose	Contain surface water runoff from the Hosteen Stockpile area.
Design Information	Appendix 26.C.
As-Built Information	Exhibit 26-32.
Intended Life Span	Will be removed in 2025.
Watershed Area (ac)	135.2
As-Built Capacity (ac-ft)	7.36
Curve Number (SCS)	80.9
Design Storm Event	100 year – 6 hour
Peak Discharge (cfs)	68.03
Runoff Volume (ac-ft)	6.76
Max. Permissible Gauge Reading for Water/Sediment (ft)	1.5, Elev. 5266.1
Depth at Upstream Toe (ft)	8
NRCS Hazard Classification	Low
Spillway Type	N/A
25 yr - 6 hr Peak Discharge (cfs)	N/A
Foundation Soil Type	Shale
Comments	

---

Table 26-5.11 Area 3 Lowe Railroad Impoundment #1

Type of Pond	Sediment
Location	Exhibit 26-12
Purpose	To contain sediment and runoff on lease.
Design Information	Appendix 26.G
As-Built Information	Exhibit 11-67
Intended Life Span	This pond will be reclaimed in 2015.
Watershed Area (ac)	105.73
As-Built Capacity (ac-ft)	19.2
Curve Number (SCS)	87.4 (Weighted Average, see design information for actual subwatershed Curve Numbers)
Design Storm Event	100 year – 6 hour
Peak Discharge (cfs)	89.73
Runoff Volume (ac-ft)	6.84
Max. Permissible Gauge Reading for Water/Sediment (ft)	13.5 Elev. 5303.5
Depth at Upstream Toe (ft)	13
NRCS Hazard Classification	Low
Spillway Type	N/A
25 yr - 6 hr Peak Discharge (cfs)	N/A
Foundation Soil Type	Sandy Clay
Comments	The western boundary of this pond is the railroad embankment. The railroad embankment has the potential to hold 99.26 ac-ft of water.

Table 26-5.12 Area 3 Lowe Railroad Impoundment #2

Type of Pond	Sediment
Location	Exhibit 26-12
Purpose	To contain sediment and runoff on lease.
Design Information	Appendix 26.G
As-Built Information	Exhibit 11-67B
Intended Life Span	Will be removed in 2025.
Watershed Area (ac)	133.27
As-Built Capacity (ac-ft)	18.37
Curve Number (SCS)	81.7 (Weighted Average, see design information for actual subwatershed Curve Numbers)
Design Storm Event	10-yr., 24-hr.
Peak Discharge (cfs)	103.69
Runoff Volume (ac-ft)	6.65
Max. Permissible Gauge Reading for Water/Sediment (ft)	6.3 Elev. 5324.3
Depth at Upstream Toe (ft)	8
NRCS Hazard Classification	Low
Spillway Type	N/A
25 yr - 6 hr Peak Discharge (cfs)	N/A
Foundation Soil Type	Sandy Clay with Limestone
Comments	Large embankment with small drainage area and no culvert. Partially incised.

---

Table 26-5.13 Area 3 Lowe Stockpile Pond

Type of Pond	Sediment
Location	Exhibit 26-12
Purpose	Contain runoff from the Lowe stockpile area.
Design Information	Appendix 26.C
As-Built Information	Exhibit 26-34
Intended Life Span	Will be removed in 2025.
Watershed Area (ac)	51.8
As-Built Capacity (ac-ft)	5.60
Curve Number (SCS)	89
Design Storm Event	10-yr., 24-hr.
Peak Discharge (cfs)	13.35
Runoff Volume (ac-ft)	2.99
Max. Permissible Gauge Reading for Water/Sediment (ft)	7.8, Elev. 5308.6
Depth at Upstream Toe (ft)	11
NRCS Hazard Classification	Low
Spillway Type	Emergency Spillway
25 yr - 6 hr Peak Discharge (cfs)	17.52
Foundation Soil Type	Badlands
Comments	Partially incised with maximum height of 6 ft. and slopes not excessively steep.

---

Table 26-5.14 Area 1 North Pinto Pond

Type of Pond	Sediment
Location	Exhibit 26-9
Purpose	Sediment control for Pinto Pit and prevents runoff from entering the North Area support facility.
Design Information	Appendix 26.H
As-Built Information	Exhibit 26-29.
Intended Life Span	Will be removed in 2025
Watershed Area (ac)	76.9
As-Built Capacity (ac-ft)	5.36
Curve Number (SCS)	80
Design Storm Event	100-yr., 6-hr.
Peak Discharge (cfs)	42.4
Runoff Volume (ac-ft)	3.6
Max. Permissible Gauge Reading for Water/Sediment (ft)	3.1, Elev. 5373.3
Depth at Upstream Toe (ft)	N/A
NRCS Hazard Classification	Low
Spillway Type	N/A
25 yr - 6 hr Peak Discharge (cfs)	N/A
Foundation Soil Type	Sandy clay
Comments	

Table 26-5.15 Area 1 North Pond Cell A, B & C (combined)

Type of Pond	Sediment
Location	Exhibit 26-9
Purpose	Retains surface runoff from the North Facility excluding the coal handling facilities.
Design Information	Appendix 26.C and Exhibit 22-13, Exhibit 22-14 and Exhibit 26-13.
As-Built Information	Exhibit 26-13
Intended Life Span	Will be removed in 2025.
Watershed Area (ac)	214.9
As-Built Capacity (ac-ft)	31.8
Curve Number (SCS)	See Appendix 26.C
Design Storm Event	100-yr., 6-hr.
Peak Discharge (cfs)	138.4
Runoff Volume (ac-ft)	11.39
Max. Permissible Gauge Reading for Water/Sediment (ft)	Cells A, B and C function together. The max. permissible water level is at elevation 5330.3 in all cells.
Depth at Upstream Toe (ft)	N/A
NRCS Hazard Classification	Low
Spillway Type	N/A
25 yr - 6 hr Peak Discharge (cfs)	N/A
Foundation Soil Type	Sandy clay.
Comments	Consists of 3 cells: A, B & C. A & B are lined.

---

Table 26-5.16 Area 1 North Pond 1 Cell A

Type of Pond	Sediment
Location	Exhibit 26-9
Purpose	Retains surface runoff from the North Facility excluding the coal handling facilities.
Design Information	Appendix 26.C, Exhibit 22-13, 22-14 & 26-13.
As-Built Information	Exhibit 26-13
Intended Life Span	Will be removed in 2025.
Watershed Area (ac)	See Table 26-5.15 North Pond 1 Cells A, B & C
As-Built Capacity (ac-ft)	4.8
Curve Number (SCS)	See Appendix 26.C
Design Storm Event	100-yr., 6-hr.
Peak Discharge (cfs)	See Table 26-5.15 North Pond 1 Cells A, B & C
Runoff Volume (ac-ft)	See Table 26-5.15 North Pond 1 Cells A, B & C
Max. Permissible Gauge Reading for Water/Sediment (ft)	Elev. 5330.3
Depth at Upstream Toe (ft)	N/A
NRCS Hazard Classification	Low
Spillway Type	N/A
25 yr - 6 hr Peak Discharge (cfs)	N/A
Foundation Soil Type	Sandy clay.
Comments	Lined, incised pond.

Table 26-5.17 Area 1 North Pond 1 Cell A2

Type of Pond	Sediment
Location	Exhibit 26-9
Purpose	In conjunction with Pond 5 retains surface runoff from the coal handling facilities and the coal plant washdown water. Cell A2 tied to N. Loadout, Barber Loadout, and Lowe Loadout for dust suppression needs and de-watering. Water collected in Pond 5 is pumped to Cell A2.
Design Information	Appendix 26.I, Appendix 26.C & Exhibit 26-13
As-Built Information	Exhibits 22-7 through 22-12 & 26-13
Intended Life Span	Will be removed in 2025.
Watershed Area (ac)	51.9
As-Built Capacity (ac-ft)	5.4
Curve Number (SCS)	See Appendix 26.C
Design Storm Event	100-yr., 6-hr.
Peak Discharge (cfs)	16.3
Runoff Volume (ac-ft)	2.67
Max. Permissible Gauge Reading for Water/Sediment (ft)	Elev. 5328.8
Depth at Upstream Toe (ft)	N/A
NRCS Hazard Classification	Low
Spillway Type	N/A
25 yr - 6 hr Peak Discharge (cfs)	N/A
Foundation Soil Type	Sandy clay.
Comments	Incised pond. Sump with pump/motor.

Table 26-5.18 Area 1 North Pond 1 Cell B

Type of Pond	Sediment
Location	Exhibit 26-9
Purpose	Retains surface runoff from the North Facility excluding the coal handling facilities.
Design Information	Appendix 26.C, Exhibit 22-13, 22-14 & 26-13.
As-Built Information	Exhibit 26-13.
Intended Life Span	Will be removed in 2025.
Watershed Area (ac)	See Table 26-5.15 North Pond 1 Cells A, B & C
As-Built Capacity (ac-ft)	14.3
Curve Number (SCS)	See Appendix 26.C
Design Storm Event	100-yr., 6-hr.
Peak Discharge (cfs)	See Table 26-5.15 North Pond 1 All Cells A, B & C
Runoff Volume (ac-ft)	See Table 26-5.15 North Pond 1 All Cells A, B & C
Max. Permissible Gauge Reading for Water/Sediment (ft)	Elev. 5330.3
Depth at Upstream Toe (ft)	N/A
NRCS Hazard Classification	Low
Spillway Type	N/A
25 yr - 6 hr Peak Discharge (cfs)	N/A
Foundation Soil Type	Sandy clay.
Comments	Incised Pond.

---

Table 26-5.19 North Pond 1 Cell C

Type of Pond	Sediment
Location	Exhibit 26-9
Purpose	Retains surface runoff from the North Facility excluding the coal handling facilities.
Design Information	Appendix 26.C, Exhibit 22-13, 22-14 & 26-13.
As-Built Information	Exhibit 26-13.
Intended Life Span	Will be removed in 2025.
Watershed Area (ac)	See Table 26-5.15 North Pond 1 Cells A, B & C
As-Built Capacity (ac-ft)	12.68
Curve Number (SCS)	See Appendix 26.C
Design Storm Event	100-yr., 6-hr.
Peak Discharge (cfs)	See Table 26-5.15 North Pond 1 Cells A, B & C
Runoff Volume (ac-ft)	See Table 26-5.15 North Pond 1 Cells A, B & C
Max. Permissible Gauge Reading for Water/Sediment (ft)	Elev. 5330.3
Depth at Upstream Toe (ft)	N/A
NRCS Hazard Classification	Low
Spillway Type	N/A
25 yr - 6 hr Peak Discharge (cfs)	N/A
Foundation Soil Type	Sandy clay.
Comments	Incised Pond.

Table 26-5.20 Area 1 Pond 5

Type of Pond	Sediment
Location	Exhibit 26-9
Purpose	In conjunction with Pond 1 Cell A2 retains the surface runoff from the coal handling facilities and the coal plant washdown water. Water collected in Pond 5 is pumped to Cell A2.
Design Information	Appendix 26.C & Exhibit 11-105A.
As-Built Information	Exhibits 22-7 through 22-12 & 11-105A
Intended Life Span	Will be removed in 2025.
Watershed Area (ac)	41.9
As-Built Capacity (ac-ft)	2.29
Curve Number (SCS)	See Appendix 26.C
Design Storm Event	100-yr., 6-hr.
Peak Discharge (cfs)	36.53
Runoff Volume (ac-ft)	1.92
Max. Permissible Gauge Reading for Water/Sediment (ft)	Elev. 5329.6
Depth at Upstream Toe (ft)	N/A
NRCS Hazard Classification	Low
Spillway Type	N/A
25 yr - 6 hr Peak Discharge (cfs)	N/A
Foundation Soil Type	Sandy clay
Comments	Incised, lined pond. Pond contains 25 HP pump that discharges at 1400 gpm.

---

Note: The excess runoff is pumped into Cell A.

Table 26-5.21 Area 3 Northwest Dixon

Type of Pond	Sediment
Location	Exhibit 26-12
Purpose	Contain runoff from the outslope of the northwest portion of the Dixon boxcut spoils and adjacent off-lease area.
Design Information	Appendix 26.C.
As-Built Information	Exhibit 26-37.
Intended Life Span	Will be removed in 2025.
Watershed Area (ac)	62.2
As-Built Capacity (ac-ft)	5.9
Curve Number (SCS)	83
Design Storm Event	100-yr., 6-hr.
Peak Discharge (cfs)	47.84
Runoff Volume (ac-ft)	4.42
Max. Permissible Gauge Reading for Water/Sediment (ft)	4.3, Elev. 5348.4
Depth at Upstream Toe (ft)	N/A
NRCS Hazard Classification	Low
Spillway Type	N/A
25 yr - 6 hr Peak Discharge (cfs)	N/A
Foundation Soil Type	Sandy clay
Comments	Incised Pond.

Table 26-5.22 Area 3 South Dixon Pond 1

Type of Pond	Sediment
Location	Exhibit 26-12
Purpose	Sediment Control for South Dixon (Block D).
Design Information	Appendix 26.J
As-Built Information	Exhibit 26-41
Intended Life Span	Will be removed in 2009.
Watershed Area (ac)	296.46
As-Built Capacity (ac-ft)	11.89
Curve Number (SCS)	80
Design Storm Event	10-yr., 24-hr.
Peak Discharge (cfs)	73.11
Runoff Volume (ac-ft)	6.63
Max. Permissible Gauge Reading for Water/Sediment (ft)	3.5, Elev. 5240.5
Depth at Upstream Toe (ft)	5
NRCS Hazard Classification	Low
Spillway Type	Emergency Spillway
25 yr - 6 hr Peak Discharge (cfs)	61.11 (at peak stage)
Foundation Soil Type	Sandy clay
Comments	Partially incised.

---

Table 26-5.23 Area 3 South Dixon Pond 2

Type of Pond	Sediment
Location	Exhibit 26-12
Purpose	Sediment Control for South Dixon (Block D).
Design Information	Appendix 26.J, Exhibit 26-48 (modification)
As-Built Information	Exhibit 26-49
Intended Life Span	Will be removed in 2009.
Watershed Area (ac)	28.4
As-Built Capacity (ac-ft)	4.62
Curve Number (SCS)	80
Design Storm Event	100-yr., 6-hr.
Peak Discharge (cfs)	23.15
Runoff Volume (ac-ft)	1.33
Max. Permissible Gauge Reading for Water/Sediment (ft)	7.1, Elev. 5248.6
Depth at Upstream Toe (ft)	7
NRCS Hazard Classification	Low
Spillway Type	N/A
25 yr - 6 hr Peak Discharge (cfs)	N/A
Foundation Soil Type	Sandy clay.
Comments:	Partially incised with medium embankments providing freeboard.

---

Table 26-5.24 Area 3 South Dixon Pond 3

Type of Pond	Sediment
Location	Exhibit 26-12
Purpose	Sediment Control for South Dixon (Block D).
Design Information	Appendix 26.J
As-Built Information	Exhibit 26-42
Intended Life Span	Will be removed in 2009.
Watershed Area (ac)	28.18
As-Built Capacity (ac-ft)	4.6
Curve Number (SCS)	80
Design Storm Event	100-yr., 6-hr.
Peak Discharge (cfs)	22.60
Runoff Volume (ac-ft)	1.05
Max. Permissible Gauge Reading for Water/Sediment (ft)	3.0, Elev. 5246.25
Depth at Upstream Toe (ft)	6
NRCS Hazard Classification	Low
Spillway Type	N/A
25 yr - 6 hr Peak Discharge (cfs)	N/A
Foundation Soil Type	Sandy clay.
Comments	Partially incised with medium embankments providing freeboard.

Table 26-5.25 Area 3 Southwest Dixon Pond

Type of Pond	Sediment
Location	Exhibit 26-12
Purpose	Contain runoff from the outslope of the Southwest portion of the Dixon boxcut spoils and adjacent off-lease areas.
Design Information	Appendix 26.C, Pg. 105-114.
As-Built Information	Exhibit 26-38.
Intended Life Span	Will be removed in 2009.
Watershed Area (ac)	37.80
As-Built Capacity (ac-ft)	2.71
Curve Number (SCS)	80
Design Storm Event	100-yr., 6-hr.
Peak Discharge (cfs)	33.33
Runoff Volume (ac-ft)	2.01
Max. Permissible Gauge Reading for Water/Sediment (ft)	4.8, Elev. 5371.1
Depth at Upstream Toe (ft)	6
NRCS Hazard Classification	Low
Spillway Type	N/A
25 yr - 6 hr Peak Discharge (cfs)	N/A
Foundation Soil Type	Sandy clay
Comments	Partially incised with medium embankments providing freeboard.

Table 26-5.26 Area 1 Vinnel Pond

Type of Pond	Sediment
Location	Exhibit 26-9
Purpose	Contain runoff from the disturbed Vinnel area.
Design Information	Exhibit 26-35. Appendix 26.C.
As-Built Information	Exhibit 26-36
Intended Life Span	Will be removed in 2006.
Watershed Area (ac)	276.5
As-Built Capacity (ac-ft)	9.76
Curve Number (SCS)	76
Design Storm Event	10-yr., 24-hr.
Peak Discharge (cfs)	11.06
Runoff Volume (ac-ft)	4.78
Max. Permissible Gauge Reading for Water/Sediment (ft)	6.2, Elev. 5364.1
Depth at Upstream Toe (ft)	6
NRCS Hazard Classification	Low
Spillway Type	Emergency Spillway
25 yr - 6 hr Peak Discharge (cfs)	19.60
Foundation Soil Type	Clayey sand
Comments	Partially incised with medium embankments providing freeboard.

Table 26-5.27 Area 2 Block C Pond 1

Type of Pond	Sediment
Location	Exhibit 26-11
Purpose	Retain surface runoff from the outslope of the Western portion of the Block C mining area and adjacent railroad.
Design Information	Exhibit 26-57, Appendix 26.C.
As-Built Information	Exhibit 26-58
Intended Life Span	Will Be Removed In 2015.
Watershed Area (Ac)	49.48
As-Built Capacity (Ac-Ft)	5.1
Curve Number (Scs)	81
Design Storm Event	100 Year-6 Hour
Peak Discharge (Cfs)	38.54
Runoff Volume (Ac-Ft)	2.49
Max. Permissible Gauge Reading For Water/Sediment (Ft)	10.3, Elev. 5306.7
Depth At Upstream Toe (Ft)	N/A – Incised
Nrcs Hazard Classification	Low
Spillway Type	N/A
25 Yr - 6 Hr Peak Discharge (Cfs)	N/A
Foundation Soil Type	Clayey Sand
Comments	Incised

---

Table 26-5.28 Area 2 Block C Pond 2

Type of Pond	Sediment
Location	Exhibit 26-11
Purpose	Retain surface runoff from the outslope of the central portion of the Block C mining area and adjacent railroad.
Design Information	Exhibit 26-59, Appendix 26.C
As-Built Information	Exhibit 26-60
Intended Life Span	Will be removed in 2015.
Watershed Area (ac)	66.64
As-Built Capacity (ac-ft)	6.0
Curve Number (SCS)	85
Design Storm Event	100 year-6 hour
Peak Discharge (cfs)	62.1
Runoff Volume (ac-ft)	4.42
Max. Permissible Gauge Reading for Water/Sediment (ft)	4.5, Elev. 5303.1
Depth at Upstream Toe (ft)	11
NRCS Hazard Classification	Low
Spillway Type	N/A
25 yr - 6 hr Peak Discharge (cfs)	N/A
Foundation Soil Type	Clayey Sand
Comments	Partially incised with medium roadway embankment providing capacity and 1 ft. freeboard.

Table 26-5.29 Area 2 Block C Pond 3

Type of Pond	Sediment
Location	Exhibit 26-10, 26-11
Purpose	Retain surface runoff from the Block C mining area, adjacent railroad and Barber Coal Stockpile area.
Design Information	Exhibit 26-61, Appendix 26.C
As-Built Information	Exhibit 26-62
Intended Life Span	Will be removed in 2015.
Watershed Area (ac)	174.42
As-Built Capacity (ac-ft)	17.28
Curve Number (SCS)	Refer to Appendix 26.C
Design Storm Event	100 year-6 hour
Peak Discharge (cfs)	94.7
Runoff Volume (ac-ft)	8.97
Max. Permissible Gauge Reading for Water/Sediment (ft)	4.1, Elev. 5268.6
Depth at Upstream Toe (ft)	9
NRCS Hazard Classification	Low
Spillway Type	N/A
25 yr - 6 hr Peak Discharge (cfs)	N/A
Foundation Soil Type	Clayey Sand
Comments	Medium roadway embankment providing capacity and 1 ft. freeboard.

Table 26-5.30 Area 3 Lowe Hole 3 Pond 3

Type of Pond	Impoundment
Location	Exhibit 26-12
Purpose	Minimize surface runoff into the pit.
Design Information	Exhibit 11-127, Exhibit 26-52, Exhibit 26-53, Appendix 26.C
As-Built Information	Exhibit 26-54
Intended Life Span	Will be removed in 2009.
Watershed Area (ac)	39.61
As-Built Capacity (ac-ft)	4.75
Curve Number (SCS)	79.67
Design Storm Event	100-yr., 6-hr.
Peak Discharge (cfs)	32.45
Runoff Volume (ac-ft)	2.01
Max. Permissible Gauge Reading for Water/Sediment (ft)	N/A
Depth at Upstream Toe (ft)	0' Incised
NRCS Hazard Classification	Low
Spillway Type	N/A
25 yr - 6 hr Peak Discharge (cfs)	N/A
Foundation Soil Type	Spoils
Comments	Incised pond with mild slopes

Table 26-5.31 Area 2 Mason Pond

Type of Pond	Sediment
Location	Exhibit 26-11
Purpose	Retain surface runoff from a portion of regrade between Barber Ramps 5 and 6, and the adjacent Barber haulroad.
Design Information	Exhibit 26-26, Appendix 26.C
As-Built Information	Exhibit 26-81
Intended Life Span	Will be removed in 2015.
Watershed Area (ac)	133.2
As-Built Capacity (ac-ft)	10.09 design capacity, will be updated after construction.
Curve Number (SCS)	Refer to Appendix 26.C
Design Storm Event	100-yr., 6-hr.
Peak Discharge (cfs)	96.4
Runoff Volume (ac-ft)	7.2
Max. Permissible Gauge Reading for Water/Sediment (ft)	4.4, Elev. 5383.9
Depth at Upstream Toe (ft)	9
NRCS Hazard Classification	Low
Spillway Type	N/A
25 yr - 6 hr Peak Discharge (cfs)	N/A
Foundation Soil Type	Clayey Sand
Comments	Partially incised with medium embankments providing freeboard.

Table 26-5.32 Area 2 Employee Coal Dump

Type of Pond	Sediment
Location	Exhibit 26-11
Purpose	Retain surface runoff from the Employee Coal Dump area
Design Information	Exhibit 26-56, Appendix 26.C
As-Built Information	Exhibit 26-56
Intended Life Span	2015
Watershed Area (ac)	6.73
As-Built Capacity (ac-ft)	3.33
Curve Number (SCS)	89
Design Storm Event	100-yr., 6-hr.
Peak Discharge (cfs)	11.42
Runoff Volume (ac-ft)	0.55
Max. Permissible Gauge Reading for Water/Sediment (ft)	4.6, Elev. 5457.6
Depth at Upstream Toe (ft)	N/A
NRCS Hazard Classification	Low
Spillway Type	N/A
25 yr - 6 hr Peak Discharge (cfs)	N/A
Foundation Soil Type	Sandy clay
Comments	

---

Table 26-5.33 Area 4 North Pond 401

Type of Pond	Sediment
Location	Exhibit 26-25
Purpose	Retains the runoff from box cut spoils
Design Information	Appendix 26.C and Exhibit 26-19
As-Built Information	Exhibit 11-01 As-built
Intended Life Span	Until Completion of Final Reclamation
Watershed Area (ac)	20.8
As-Built Capacity (ac-ft)	3.9 plus 1-foot freeboard (as-built)
Curve Number (SCS)	Refer to Appendix 26.C
Design Storm Event	100 year 6 hour
Peak Discharge (cfs)	Refer to Appendix 26.C
Runoff Volume (ac-ft)	1.4
Max. Permissible Gauge Reading for Water/Sediment (ft)	7.4 (as-built)
Depth at Upstream Toe (ft)	9
NRCS Hazard Classification	Low
Spillway Type	N/A
25 yr - 6 hr Peak Discharge (cfs)	N/A
Foundation Soil Type	Sandy Clay
Comments	

---

Table 26-5.34 Area 4 North Pond 412

Type of Pond	Sediment
Location	Exhibit 26-25
Purpose	Retains the runoff from box cut spoils
Design Information	Appendix 26.C and Exhibit 26-45
As-Built Information	Exhibit 26-44 As-built
Intended Life Span	Until completion of final reclamation
Watershed Area (ac)	30.6
As-Built Capacity (ac-ft)	3.2 plus 1-foot freeboard
Curve Number (SCS)	Refer to Appendix 26.C
Design Storm Event	100 year – 6 hour
Peak Discharge (cfs)	Refer to Appendix 26.C
Runoff Volume (ac-ft)	3.0
Max. Permissible Gauge Reading for Water/Sediment (ft)	1.7 (as-built)
Depth at Upstream Toe (ft)	9.8
NRCS Hazard Classification	Low
Spillway Type	Not required
25 yr - 6 hr Peak Discharge (cfs)	N/A
Foundation Soil Type	Sandy Clay
Comments	

---

Table 26-5.35 Area 4 North Pond 3

Type of Pond	Sediment
Location	Exhibit 26-25
Purpose	Retains the runoff from box cut spoils
Design Information	Appendix 26.C and Exhibit 26-47
As-Built Information	Exhibit 26-46 As Built
Intended Life Span	Until completion of final reclamation
Watershed Area (ac)	8.6
As-Built Capacity (ac-ft)	1.2 plus 1-foot freeboard
Curve Number (SCS)	Refer to Appendix 26.C
Design Storm Event	100 year 6 hour
Peak Discharge (cfs)	Refer to Appendix 26.C
Runoff Volume (ac-ft)	0.8
Max. Permissible Gauge Reading for Water/Sediment (ft)	2.4
Depth at Upstream Toe (ft)	7
NRCS Hazard Classification	Low
Spillway Type	N/A
25 yr - 6 hr Peak Discharge (cfs)	N/A
Foundation Soil Type	Sandy Clay
Comments	

---

Table 26-5.36 Area 4 North Pond 4

Type of Pond	Sediment
Location	Exhibit 26-25
Purpose	Retains the runoff from box cut spoils
Design Information	Appendix 26.C and Exhibit 26-51
As-Built Information	Exhibit 26-50 As-built
Intended Life Span	Until completion of final reclamation
Watershed Area (ac)	46.3
As-Built Capacity (ac-ft)	5.6 plus 1-foot freeboard
Curve Number (SCS)	Refer to Appendix 26.C
Design Storm Event	100 year – 6 hour
Peak Discharge (cfs)	Refer to Appendix 26.C
Runoff Volume (ac-ft)	4.5
Max. Permissible Gauge Reading for Water/Sediment (ft)	3.2
Depth at Upstream Toe (ft)	8.7
NRCS Hazard Classification	Low
Spillway Type	Not required
25 yr - 6 hr Peak Discharge (cfs)	N/A
Foundation Soil Type	Sandy Clay
Comments	

---

This page is intentionally left blank due to removal of Exhibit 26-22

Area 4 North Pond 405

Update 13-06.

Table 26-5.38 Area 4 North Pond 411

Type of Pond	Sediment
Location	Exhibit 26-25
Purpose	Retains the runoff from mining area
Design Information	Appendix 26.C and Exhibit 26-71
As-Built Information	Exhibit 26-70 As-built
Intended Life Span	Until completion of final reclamation
Watershed Area (ac)	12.5
As-Built Capacity (ac-ft)	1.7 plus 1-foot freeboard
Curve Number (SCS)	Refer to Appendix 26.C
Design Storm Event	100 year – 6 hour
Peak Discharge (cfs)	Refer to Appendix 26.C
Runoff Volume (ac-ft)	1.2
Max. Permissible Gauge Reading for Water/Sediment (ft)	3.2
Depth at Upstream Toe (ft)	8.3
NRCS Hazard Classification	Low
Spillway Type	Not required
25 yr - 6 hr Peak Discharge (cfs)	N/A
Foundation Soil Type	Sandy Clay
Comments	

---

Table 26-5.39 Area 4 North Pond 413

Type of Pond	Sediment
Location	Exhibit 26-25
Purpose	Retains the runoff from mining area
Design Information	Appendix 26.C and Exhibit 26-23
As-Built Information	Exhibit 11-6 As-built
Intended Life Span	Until completion of final reclamation
Watershed Area (ac)	6.8
As-Built Capacity (ac-ft)	2.6 plus 1-foot freeboard
Curve Number (SCS)	Refer to Appendix 26.C
Design Storm Event	100 year 6 hour
Peak Discharge (cfs)	Refer to Appendix 26.C
Runoff Volume (ac-ft)	0.6
Max. Permissible Gauge Reading for Water/Sediment (ft)	7.7
Depth at Upstream Toe (ft)	10
NRCS Hazard Classification	Low
Spillway Type	N/A
25 yr - 6 hr Peak Discharge (cfs)	N/A
Foundation Soil Type	Sandy Loam
Comments	

---

Table 26-5.40 Area 4 North Pond 402

Type of Pond	Sediment
Location	Exhibit 26-25
Purpose	Retains the runoff from box cut spoils
Design Information	Appendix 26.C and Exhibit 26-20
As-Built Information	Exhibit 11-04 As-built
Intended Life Span	Until completion of final reclamation
Watershed Area (ac)	96.8
As-Built Capacity (ac-ft)	7.9
Curve Number (SCS)	Refer to Appendix 26.C
Design Storm Event	100 year 6 hour
Peak Discharge (cfs)	Refer to Appendix 26.C
Runoff Volume (ac-ft)	6.8
Max. Permissible Gauge Reading for Water/Sediment (ft)	6.0
Depth at Upstream Toe (ft)	15.4
NRCS Hazard Classification	Low
Spillway Type	N/A
25 yr - 6 hr Peak Discharge (cfs)	N/A
Foundation Soil Type	Sandy Loam
Comments	

---

This page is intentionally left blank due to removal of Exhibit 26-21

Area 4 North Pond 404

Update 13-06.

Table 26-5.42 Area 4 North Pond 408

Type of Pond	Sediment
Location	EXHIBIT 26-25
Purpose	Retains the runoff from topsoil stockpile TS-401
Design Information	Appendix 26.C and Exhibit 26-67
As-Built Information	Exhibit 26-66 As-built
Intended Life Span	Until completion of final reclamation
Watershed Area (ac)	6.18
As-Built Capacity (ac-ft)	1.5
Curve Number (SCS)	Refer to Appendix 26.C
Design Storm Event	100 year 6 hour
Peak Discharge (cfs)	Refer to Appendix 26.C
Runoff Volume (ac-ft)	0.4
Max. Permissible Gauge Reading for Water/Sediment (ft)	4.5
Depth at Upstream Toe (ft)	5.2
NRCS Hazard Classification	Low
Spillway Type	N/A
25 yr - 6 hr Peak Discharge (cfs)	N/A
Foundation Soil Type	Sandy Loam
Comments	

---

Table 26-5.43 Area 4 North Pond 409

Type of Pond	Sediment
Location	Exhibit 26.25
Purpose	Retains the runoff from topsoil stockpile TS-402
Design Information	Appendix 26.C and Exhibit 26-69
As-Built Information	Exhibit 26-68 As-built
Intended Life Span	Until completion of final reclamation
Watershed Area (ac)	2.83
As-Built Capacity (ac-ft)	0.26
Curve Number (SCS)	Refer to Appendix 26.C
Design Storm Event	100 year 6 hour
Peak Discharge (cfs)	Refer to Appendix 26.C
Runoff Volume (ac-ft)	0.2
Max. Permissible Gauge Reading for Water/Sediment (ft)	1.6
Depth at Upstream Toe (ft)	3.5
NRCS Hazard Classification	Low
Spillway Type	N/A
25 yr - 6 hr Peak Discharge (cfs)	N/A
Foundation Soil Type	Sandy Loam
Comments	

---

Table 26-5.44 Area 4 North Pond 410

Type of Pond	Sediment
Location	Exhibit 26-25
Purpose	Retains the runoff from topsoil stockpile TS-402
Design Information	Appendix 26.C and Exhibit 26-69
As-Built Information	Exhibit 26-68 As-built
Intended Life Span	Until completion of final reclamation
Watershed Area (ac)	2.37
As-Built Capacity (ac-ft)	0.93
Curve Number (SCS)	Refer to Appendix 26.C
Design Storm Event	100 year 6 hour
Peak Discharge (cfs)	Refer to Appendix 26.C
Runoff Volume (ac-ft)	0.17
Max. Permissible Gauge Reading for Water/Sediment (ft)	2.7
Depth at Upstream Toe (ft)	3.0
NRCS Hazard Classification	Low
Spillway Type	N/A
25 yr - 6 hr Peak Discharge (cfs)	N/A
Foundation Soil Type	Sandy Loam
Comments	

---

Table 26-5.45 Area 3 Pond 301

Type of Pond	Sediment
Location	Exhibit 26-12
Purpose	Retains the runoff from South Dixon pit area
Design Information	Appendix 26.C and Exhibit 26-72
As-Built Information	Exhibit 26-72
Intended Life Span	2016
Watershed Area (ac)	32.9
As-Built Capacity (ac-ft)	7.5 plus 1-foot freeboard
Curve Number (SCS)	Refer to Appendix 26.C
Design Storm Event	100 year 6 hour
Peak Discharge (cfs)	Refer to Appendix 26.C
Runoff Volume (ac-ft)	2.4
Max. Permissible Gauge Reading for Water/Sediment (ft)	5.1, Elev. 5297.2
Depth at Upstream Toe (ft)	8.0
NRCS Hazard Classification	Low
Spillway Type	N/A
25 yr - 6 hr Peak Discharge (cfs)	N/A
Foundation Soil Type	Sandy Clay
Comments	

---

Table 26-5.46 Area 3 Pond 302

Type of Pond	Sediment
Location	Exhibit 26-12
Purpose	Retains the runoff from South Dixon pit area
Design Information	Appendix 26.C and Exhibit 26-73
As-Built Information	Exhibit 26-73
Intended Life Span	2016
Watershed Area (ac)	53.62
As-Built Capacity (ac-ft)	7.4 plus 1 foot freeboard
Curve Number (SCS)	Refer to Appendix 26.C
Design Storm Event	100 year 6 hour
Peak Discharge (cfs)	Refer to Appendix 26.C
Runoff Volume (ac-ft)	4.02
Max. Permissible Gauge Reading for Water/Sediment (ft)	3.1, Elev. 5292.6
Depth at Upstream Toe (ft)	N/A (incised pond)
NRCS Hazard Classification	Low
Spillway Type	N/A
25 yr - 6 hr Peak Discharge (cfs)	N/A
Foundation Soil Type	Sandy Clay
Comments	

---

Table 26-5.47 Area 2 Block C Pond 4

Type of Pond	Sediment
Location	Exhibit 26-10 & Exhibit 26-11
Purpose	Retain surface runoff from the Block C mining area, adjacent railroad and Barber Coal Stockpile area.
Design Information	Exhibit 26-80, Appendix 26.C.
As-Built Information	Exhibit 26-80 As-built
Intended Life Span	Will be removed in 2015.
Watershed Area (ac)	262.64
As-Built Capacity (ac-ft)	15.93
Curve Number (SCS)	Refer to Appendix 26.C
Design Storm Event	100 year – 6 hour
Peak Discharge (cfs)	128.27
Runoff Volume (ac-ft)	13.19
Max. Permissible Gauge Reading for Water/Sediment (ft)	2.4, Elev. 5270.4
Depth at Upstream Toe (ft)	10.5
NRCS Hazard Classification	Low
Spillway Type	N/A
25 yr - 6 hr Peak Discharge (cfs)	N/A
Foundation Soil Type	Sandy Clay
Comments	

---

Table 26-5.48 Area 3 Pond 309A

Type of Pond	Sediment
Location	Exhibit 26-12
Purpose	Retains the runoff from explosive agents storage area (Gilmore Silos).
Design Information	Appendix 26.C and Exhibit 22-18
As-Built Information	Exhibit 22-18
Intended Life Span	2016
Watershed Area (ac)	2.8
As-Built Capacity (ac-ft)	0.47 plus 1-foot freeboard (based on design data will be updated after construction)
Curve Number (SCS)	Refer to Appendix 26.C
Design Storm Event	100 year 6 hour
Peak Discharge (cfs)	Refer to Appendix 26.C
Runoff Volume (ac-ft)	0.30
Max. Permissible Gauge Reading for Water/Sediment (ft)	1.45, Elev. 5267.95 (based on design data will be updated after construction)
Depth at Upstream Toe (ft)	N/A
NRCS Hazard Classification	Low
Spillway Type	N/A
25 yr - 6 hr Peak Discharge (cfs)	N/A
Foundation Soil Type	Sandy Clay
Comments	

---

Table 26-5.49 Area 3 Pond 309B

Type of Pond	Sediment
Location	Exhibit 26-12
Purpose	Retains the runoff from explosive agents storage area (Gilmore Silos).
Design Information	Appendix 26.C and Exhibit 22-18
As-Built Information	Exhibit 22-18
Intended Life Span	2016
Watershed Area (ac)	3.1
As-Built Capacity (ac-ft)	0.38 plus 1 foot freeboard (based on design data will be updated after construction)
Curve Number (SCS)	Refer to Appendix 26.C
Design Storm Event	100 year 6 hour
Peak Discharge (cfs)	Refer to Appendix 26.C
Runoff Volume (ac-ft)	0.33
Max. Permissible Gauge Reading for Water/Sediment (ft)	0.81, Elev. 5266.91 (based on design data will be update after construction)
Depth at Upstream Toe (ft)	N/A (incised pond)
NRCS Hazard Classification	Low
Spillway Type	N/A
25 yr - 6 hr Peak Discharge (cfs)	N/A
Foundation Soil Type	Sandy Clay
Comments	

Table 26-5.50 Area 4 North Pond 414

Type of Pond	Sediment
Location	Exhibit 26-25
Purpose	Retains the runoff from Gilmore Pit
Design Information	Appendix 26.C and Exhibit 26-86
As-Built Information	Exhibit 26-86
Intended Life Span	2016
Watershed Area (ac)	476.8
As-Built Capacity (ac-ft)	34.5 plus 1-foot freeboard per design; will be updated after construction
Curve Number (SCS)	Refer to Appendix 26.C
Design Storm Event	100 year 6 hour
Peak Discharge (cfs)	Refer to Appendix 26.C
Runoff Volume (ac-ft)	30.3
Max. Permissible Gauge Reading for Water/Sediment (ft)	2.89, Elev. 5265.1; will be updated after construction per the as-built
Depth at Upstream Toe (ft)	4.9
NRCS Hazard Classification	Low
Spillway Type	N/A
25 yr - 6 hr Peak Discharge (cfs)	N/A
Foundation Soil Type	Sandy Clay
Comments	Volume above upstream toe 19.33 ac-ft

Table 26-5.51 Removed with REV 1221

Type of Pond	Highwall
Location	
Purpose	
Design Information	
As-Built Information	
Intended Life Span	
Watershed Area (ac)	
As-Built Capacity (ac-ft)	
Curve Number (SCS)	
Design Storm Event	
Peak Discharge (cfs)	
Runoff Volume (ac-ft)	
Max. Permissible Gauge Reading for Water/Sediment (ft)	
Depth at Upstream Toe (ft)	
NRCS Hazard Classification	
Spillway Type	
25 yr - 6 hr Peak Discharge (cfs)	
Foundation Soil Type	
Comments	

---

Table 26-5.52 Area 3 Pond 306

Type of Pond	Sediment
Location	Exhibit 26-12
Purpose	Retains the runoff from South Dixon pit area
Design Information	Appendix 26.C and Exhibit 26-85
As-Built Information	Exhibit 26-85
Intended Life Span	2016
Watershed Area (ac)	61.67
As-Built Capacity (ac-ft)	4.2 plus 1-foot freeboard
Curve Number (SCS)	Refer to Appendix 26.C
Design Storm Event	100 year 6 hour
Peak Discharge (cfs)	Refer to Appendix 26.C
Runoff Volume (ac-ft)	3.6
Max. Permissible Gauge Reading for Water/Sediment (ft)	1.3, Elev. 5307.5
Depth at Upstream Toe (ft)	8.5
NRCS Hazard Classification	Low
Spillway Type	N/A
25 yr - 6 hr Peak Discharge (cfs)	N/A
Foundation Soil Type	Sandy Clay
Comments	

---

Table 26-5.53 Area 2 Pond 201

Type of Pond	Sediment
Location	Exhibit 26-87
Purpose	Surface and sediment runoff control from upstream construction disturbance.
Design Information	Exhibit 26-11, Appendix 26.C & Exhibit 26-87.
As-Built Information	To develop after construction.
Intended Life Span	Life of mine.
Watershed Area (ac)	26.6
As-Built Capacity (ac-ft)	2.98 ac-ft plus 1-foot freeboard per design will be updated on the as-built after construction.
Curve Number (SCS)	Refer to Appendix 26.C
Design Storm Event	100-yr., 6-hr.
Peak Discharge (cfs)	11.8
Runoff Volume (ac-ft)	1.95
Max. Permissible Gauge Reading for Water/Sediment (ft)	4.41 ft; Elev. 5,345.91 - to be updated per the as-built.
Depth at Upstream Toe (ft)	N/A
NRCS Hazard Classification	Low
Spillway Type	N/A
25 yr - 6 hr Peak Discharge (cfs)	N/A
Foundation Soil Type	Sandy clay
Comments	The channels and inlets to the pond are designed to be stable for a 10 yr-6 hr storm event.

Table 26-5.54 Area 2 Pond 202

Type of Pond	Sediment
Location	Exhibit 26-88
Purpose	Surface and sediment runoff control from upstream construction disturbance.
Design Information	Appendix 26.C. Exhibit 22-20 & Exhibit 26-88.
As-Built Information	To develop after construction.
Intended Life Span	Life of mine.
Watershed Area (ac)	404.58
As-Built Capacity (ac-ft)	13.53 ac-ft plus 1-foot freeboard per design will be updated on the as-built after construction.
Curve Number (SCS)	See SEDCAD information in Appendix 26.C
Design Storm Event	100-yr., 6-hr.
Peak Discharge (cfs)	157.94
Runoff Volume (ac-ft)	10.89
Max. Permissible Gauge Reading for Water/Sediment (ft)	3.10 ft; Elev. 5,348.10 – to be updated per the as-built.
Depth at Upstream Toe (ft)	N/A
NRCS Hazard Classification	Low
Spillway Type	N/A
25 yr - 6 hr Peak Discharge (cfs)	N/A
Foundation Soil Type	Sandy clay
Comments	The channels and inlets to the pond are designed to be stable for a 10 yr-6 hr storm event.

Table 26-5.55 Area 3 Pond 310

Type of Pond	Sediment
Location	Exhibit 26-12
Purpose	Surface and sediment runoff control
Design Information	Appendix 26.C. Exhibit 26-93.
As-Built Information	To develop after construction.
Intended Life Span	Till final reclamation
Watershed Area (ac)	331.97
As-Built Capacity (ac-ft)	15.02 ac-ft plus 1-foot freeboard per design will be updated on the as-built after construction.
Curve Number (SCS)	See SEDCAD information in Appendix 26.C
Design Storm Event	100-yr., 6-hr.
Peak Discharge (cfs)	141.08
Runoff Volume (ac-ft)	13.38
Max. Permissible Gauge Reading for Water/Sediment (ft)	1.07 ft; Elev. 5321.07 - to be updated per the as-built.
Depth at Upstream Toe (ft)	N/A
NRCS Hazard Classification	Low
Spillway Type	N/A
25 yr - 6 hr Peak Discharge (cfs)	N/A
Foundation Soil Type	Sandy clay
Comments	The channels and inlets to the pond are designed to be stable for a 10 yr-6 hr storm event.

Table 26-5.56 Area 3 Pond 311

Type of Pond	Sediment
Location	Exhibit 26-93
Purpose	Surface and sediment runoff control from upstream construction disturbance.
Design Information	Exhibit 26-12, Appendix 26.C. & and Exhibit 26-93.
As-Built Information	To be develop after construction.
Intended Life Span	Life of mine.
Watershed Area (ac)	259.8
As-Built Capacity (ac-ft)	8.30 ac-ft plus 1-foot freeboard per design, will be updated on the as-built after construction.
Curve Number (SCS)	See SEDCAD information in Appendix 26.C
Design Storm Event	10-yr., 24-hr.
Peak Discharge (cfs)	42.71
Runoff Volume (ac-ft)	6.90
Max. Permissible Gauge Reading for Water/Sediment (ft)	1.45 ft; Elev. 5,326.95 - to be updated per the as-built.
Depth at Upstream Toe (ft)	N/A (Incised Pond)
NRCS Hazard Classification	Low
Spillway Type	Emergency Spillway
25 yr - 6 hr Peak Discharge (cfs)	47.60
Foundation Soil Type	Sandy clay
Comments	The channels and inlets to the pond are designed to be stable for a 10 yr-6 hr storm event.

Table 26-6 Ponds With Single Closed Spillway As-built Capacity vs. Storm Runoff Volume

Pond	As-built Capacity (ac-ft)	100 yr-6 hr Runoff Volume (ac-ft)	Comments:
Block C Pond 1	5.10	2.49	Sufficient capacity to retain the 100 hr-6 hr runoff
Block C Pond 2	6.00	4.42	Sufficient capacity to retain the 100 hr-6 hr runoff
Barber #2	8.02	5.72	Sufficient capacity to retain the 100 hr-6 hr runoff
Hosteen #3	7.36	6.76	Sufficient capacity to retain the 100 hr-6 hr runoff

Table 26-7 Block B Pond 3 Stage Storage

Elevation (ft)	Area (ac)	Inc. Volume (ac-ft)	Cum. Volume (ac-ft)	Comments
5261.0	0.00	0.00	0.00	
5262.0	0.00	0.00	0.00	
5263.0	0.01	0.01	0.01	
5264.0	0.03	0.02	0.02	
5265.0	0.09	0.06	0.08	
5266.0	0.25	0.17	0.25	
5267.0	0.40	0.33	0.57	
5268.0	0.71	0.56	1.13	
5269.0	1.11	0.91	2.04	
5270.0	1.75	1.43	3.46	
5271.0	2.57	2.16	5.62	
5272.0	3.51	3.04	8.66	
5272.6	4.05	2.27	10.93	Spillway elevation
5273.0	4.40	1.69	12.62	
5273.8			16.41	Peak stage for 100 yr-6 hr runoff
5274.0	5.45	4.93	17.54	
5275.0	6.59	6.02	23.56	
5276.0	8.66	7.63	31.19	
5277.0	10.15	9.40	40.59	
5278.0	11.80	10.97	51.57	
5279.0	14.27	13.03	64.60	Pond basin crest elevation

Table 26-8 Highwall Impoundments and Impoundments Hazard Classification

IMPOUNDMENT ID.	LOCATION	CURRENT STATUS	WATERSHED AREA (ACRES)	CAPACITY (AC-FT)	DEPTH AT UPSTREAM TOE (FT)	HAZARD POTENTIAL	COMMENTS <sup>1</sup> :
Lowe Hole 3 Pond 2	Lowe	active	688.0	11.6	see comment	Low	Impoundment (incised), see Appendix 26.C, Exhibit 26-52 & 26-55
Lowe Hole 3 Pond 3	Lowe	active	41.8	4.6	12.0	Low	Impoundment, see Appendix 26.C and Exhibit 26-53
North Fork Pond	Dixon	active	198.7	19.5	12.3	Low	Impoundment
Area 4-North Pond 406	A4N	active	238.1	14.2	9.0	Low	Impoundment, see Appendix 26.C and Exhibit 26-64.
Area 4-North Pond 407	A4N	active	124.8	15.4	15.0	Low	Impoundment, see Appendix 26.C and Exhibit 26-65

<sup>1</sup>The standard design and as-built information for the highwall impoundments are in Appendix 26.D.

Table 26-9 Land Types and Curve Numbers

Land Use/Condition (1)	Curve Numbers for Hydrologic Groups (5)			
	A	B	C	D
Reclaimed Lands (2)	65	78	86	91
Undisturbed Lands (3)	65	78	86	91
NAPI Cultivated lands (4)	67	78	85	89

1. Land use/conditions and the associated curve numbers were taken from Ms. Pamela J. Schwab and Dr. Richard Warner (1987), "SEDCAD+ User's Manual", Civil Software Design, Table 5.3, pages 110-112.
2. From reference (1) the land use/condition for reclaimed lands is between "Herbaceous" and "Desert Shrub", each with poor hydrologic condition. The curve numbers were determined by interpolating between the curve numbers associated with the two land use/conditions.
3. The type of land use/condition for undisturbed areas will be identical to reclaimed lands (same curve numbers).
4. The type of land use/conditions selected from reference (1) is "Row crops, Straight row" with good hydrologic conditions.
5. The hydrologic group classification for the soil types will be obtained from the NRCS soil surveys.

Table 26-10 Topdressing Types and Quantities<sup>1</sup>

Soil Mapping Unit Symbol	Soil Mapping Units	Percent of Map Unit <sup>3</sup>	Soil volume (cubic yards)					Title of SCS Soil Survey <sup>4</sup>	Hydrologic Group
			Area 1	Area 2	Area 2	Area 4 North	Total		
Ba	Badland	-	0	0	0	0	0		
Bb <sup>2</sup>	Bacobi and	39	37,061	20,523	201,579	342,305	601,468	1	C
	Monierco soils	61	57,967	32,101	315,290	535,401	940,759	2	D
Bc	Blancot	-	0	0	664,484	0	664,484	2	B
Bh	Blancot, very hard	-	0	0	307,680	0	307,680	2	B
Fa	Faro and Persayo Soils	-	8,024	83,158	0	161,922	253,104	2	D/D
Gr	Grieta	-	0	0	0	69,104	69,104	3	B
Jc	Jocity -Gilco	-	503,634	183,596	481,270	1,525,313	2,693,813	3	B/B
Jh	Jocity, very hard	-	0	0	103,722	46,339	150,061	3	B
Ma	Mack	-	0	0	1,433,038	176,992	1,610,030	5	C
Mn	Mayqueen	-	295,981	55,176	0	23,851	375,008	2	B
Ms	Mayqueen -Shiprock	-	421,971	341,951	614,672	333,565	1,712,159	2	B
Mv	Mayqueen -Shiprock, very hard	-	85,805	0	61,024	0	146,829	2	B
Na	Nakai	-	0	0	0	53,010	53,010	4	B
Nt	Natrargids	-	0	6,628	0	0	6,628	2	D
Nv	Natrargids, overblown	-	2,159	82,861	97,028	218,490	400,538	2	D
Ra	Razito	-	599,753	521,804	458,595	311,260	1,891,412	5	A
Rh	Razito, very hard	-	73,893	0	21,089	196,707	291,689	5	A

*Navajo Mine Permit Application Package*

Table 26-10 (Continued)

Soil Mapping Unit Symbol	Soil Mapping Units	Percent of Map Unit <sup>3</sup>	Soil volume (cubic yards)					Title of SCS Soil Survey <sup>4</sup>	Hydrologic Group
Rl	Redlands Variant	-	19,683	33,505	945,193	331,678	1,330,059	5	B
Rv	Redlands Variant, very hard	-	0	0	105,452	61,901	167,353	5	B
Sc	Shiprock	-	192,636	540,865	868,130	160,006	1,761,637	2	B
Sh	Shiprock, very hard	-	22,430	21,812	67,523	143,239	255,004	2	B
Sl	Shiprock -Blancot	-	278,724	0	23,813	0	302,537	2	B/B
Sv	Shiprock Variant	-	0	0	416,510	70,420	486,930	2	B
Sz	Stumble	-	0	0	15,596	105,082	120,678	2	A
Ta	Trail	-	0	23,210	0	0	23,210	5	A
Th	Trail, very hard	-	0	16,144	0	4,538	20,682	5	A
<b>TOTAL:</b>			2,599,721	1,963,334	7,201,688	4,871,123	16,635,866		

<sup>1</sup>This information was generated from Part 2, Section 14 Soil, approved PAP for Navajo Mine.

<sup>2</sup>Undifferentiated groups and complex soil mapping units were delineated if the major components had contrasting hydrologic groups.

<sup>3</sup>Percentages of each major mapping unit component were derived from Part 2, Section 14.2 Soil Map Unit Descriptions, approved PAP for Navajo Mine.

<sup>4</sup>1 = Soil Survey Coconino County, Arizona; 2= Soil Survey San Juan County, New Mexico, Eastern Part; 3= Soil Survey Sandoval County, New Mexico; 4= Soil Survey San Juan County, Utah; 5= Soil Survey Shiprock Area, Parts of San Juan County, New Mexico and Apache County, Arizona.

Table 26-11 Flow Depths and Velocities for the Portion to be Constructed

Channel Reach	2 year-6 hour		5 year-6 hour		10 year-6 hour	
	Flow	Average	Flow	Average	Flow	Average
	Depth	Velocity	Depth	Velocity	Depth	Velocity
	(ft)	(fps)	(ft)	(fps)	(ft)	(fps)
Station 0+00 to 26+37	2.17	3.58	3.13	4.39	3.71	4.83
Station 26+37 to 26+88	2.21	3.69	3.21	4.56	3.83	5.02
Station 26+88 to 27+85	2.24	3.77	3.28	4.68	3.93	5.17
Station 27+85 to 29+30	2.26	3.81	3.32	4.74	3.98	5.25
Station 29+30 to 31+30	2.19	3.65	3.18	4.50	3.79	4.96
Station 31+30 to 39+80	2.17	3.58	3.13	4.39	3.71	4.83

---

Table 26-12 Flow Depths and Velocities for the Portion in the Existing Drainage

Location	2 year-6 hour		5 year-6 hour		10 year-6 hour	
	Flow	Average	Flow	Average	Flow	Average
	Depth	Velocity	Depth	Velocity	Depth	Velocity
	(ft)	(fps)	(ft)	(fps)	(ft)	(fps)
Station 6+02.75 (Section A-A')	1.74	3.42	2.22	4.37	2.52	4.98
Station 10+61.75 (Section B-B')	2.02	3.27	2.52	4.09	2.83	4.51
Station 13+85 (Section C-C')	2.08	3.76	2.59	4.82	2.89	5.41
Station 17+80 (Section D-D')	3.50	4.10	4.20	4.05	4.50	4.56
Station 21+88.34 (Section E-E')	4.51	6.14	5.89	6.60	7.08	4.49

Table 26-13 Variation of Dimensions of Incised Channel

Location	Depth (ft)	Width (ft)
Station 0+00 to 14+00	0.5 to 1.0	1.0 to 2.0
Station 14+00 to 17+60	1.0 to 2.5	1.5 to 3.0
Station 17+60 to 23+60	2.5 to 7.0	2.5 to 5.0

Table 26-14 Excess Material Dump – Slope/Length Measurements

Location/Station	Slope Dist. (ft)	Elev. Diff. (ft)	Horiz. Dist. (ft)	Slope (%)	Rock Cover (%)
Sta. 4 to 11 (700 ft)	27	15.3	22.2	68.8%	
	25	13.4	21.1	63.5%	
Average	26	14.4	21.7	66.1%	75
Sta. 11 to 19 (800 ft)	45	13.7	42.9	32.0%	50
Sta. 19 to 24 (500 ft)	31	4.8	30.6	15.7%	50
Sta. 24 to 27 (300 ft)	70	19.0	67.4	28.2%	40
Sta. 31 to 39.8 (880 ft)	20	9.3	17.7	52.5%	
	20	9.6	17.5	54.7%	
Average	20	9.5	17.6	53.6%	75

Table 26-15 Undisturbed Surface – Slope/Length Measurements

	Slope (ft)	Dist. (ft)	Elev. Diff. (ft)	Horiz. Dist. (ft)	Slope (%)	Rock Cover (%)
Sta. 4 to 16 (1200 ft)	48		9.8	47.0	20.9%	
	35		5.9	34.5	17.1%	
	26		3.7	25.7	14.4%	
	33		6.9	32.3	21.5%	
	37		9.0	35.9	25.1%	
	26		5.3	25.5	20.8%	
	17		7.2	15.4	46.8%	
	33		10.2	31.4	32.5%	
Average	32			31.0	24.9%	15
Sta. 16 to 23 & Sta. 31 to 39.8 (1580 ft)	47		5.3	46.7	11.3%	
	45		3.2	44.9	7.1%	
	36		2.8	35.9	7.8%	
Average	43			42.5	8.8%	40
Sta. 23 to 27 (400 ft)	67		3.8	66.9	5.7%	
	70		3.7	69.9	5.3%	
	60		2.9	59.9	4.8%	
	48		2.7	47.9	5.6%	
	17		0.9	17.0	5.3%	
Average	52			52.3	5.3%	50

\*Measurements were taken on the undisturbed surface along the west side of the waste material dump.


Table 26-16 Estimated Soil Loss – Excess Material Dump (RUSLE Version 1.06)

Filename	R	K	LS	C	P	A	Location/ Station	Length (ft)	% of Total Length	Weighted Soil Loss (tn/ac)
NFD1A	20	0.21	6.25	0.06	1.0	1.8	4 to 11	700.0	22.0%	0.40
NFD1B	20	0.21	3.40	0.20	1.0	2.8	11 to 19	800.0	25.2%	0.70
NFD1C	20	0.21	1.38	0.22	1.0	1.3	19 to 24	500.0	15.7%	0.20
NFD1D	20	0.21	3.88	0.24	1.0	4.0	24 to 27	300.0	9.4%	0.38
NFD1E	20	0.21	3.09	0.08	1.0	1.1	31 to 39.8	880.0	27.7%	0.30
									Weighted Average	2.0

Table 26-17 Estimated Soil Loss – Undisturbed Surface (RUSLE Version 1.06)

Filename	R	K	LS	C	P	A	Location/ Station	Length (ft)	% of Total Length	Weighted Soil Loss (tn/ac)
NFD2A	20	0.21	3.03	0.31	1.0	4.00	4 To 16	1200.0	37.7%	1.51
NFD2B	20	0.21	0.92	0.17	1.0	0.65	16 to 23	700.0	22.0%	0.14
NFD2C	20	0.21	0.60	0.13	1.0	0.33	23 to 27	400.0	12.6%	0.04
NFD2D	20	0.21	0.92	0.17	1.0	0.65	31 to 39.8	880.0	27.7%	0.18
Weighted Average										1.9

**RAILROAD CULVERTS**  
 SCALES: HORIZONTAL 1" = 20 FT.  
 VERTICAL 1" = 5 FT.

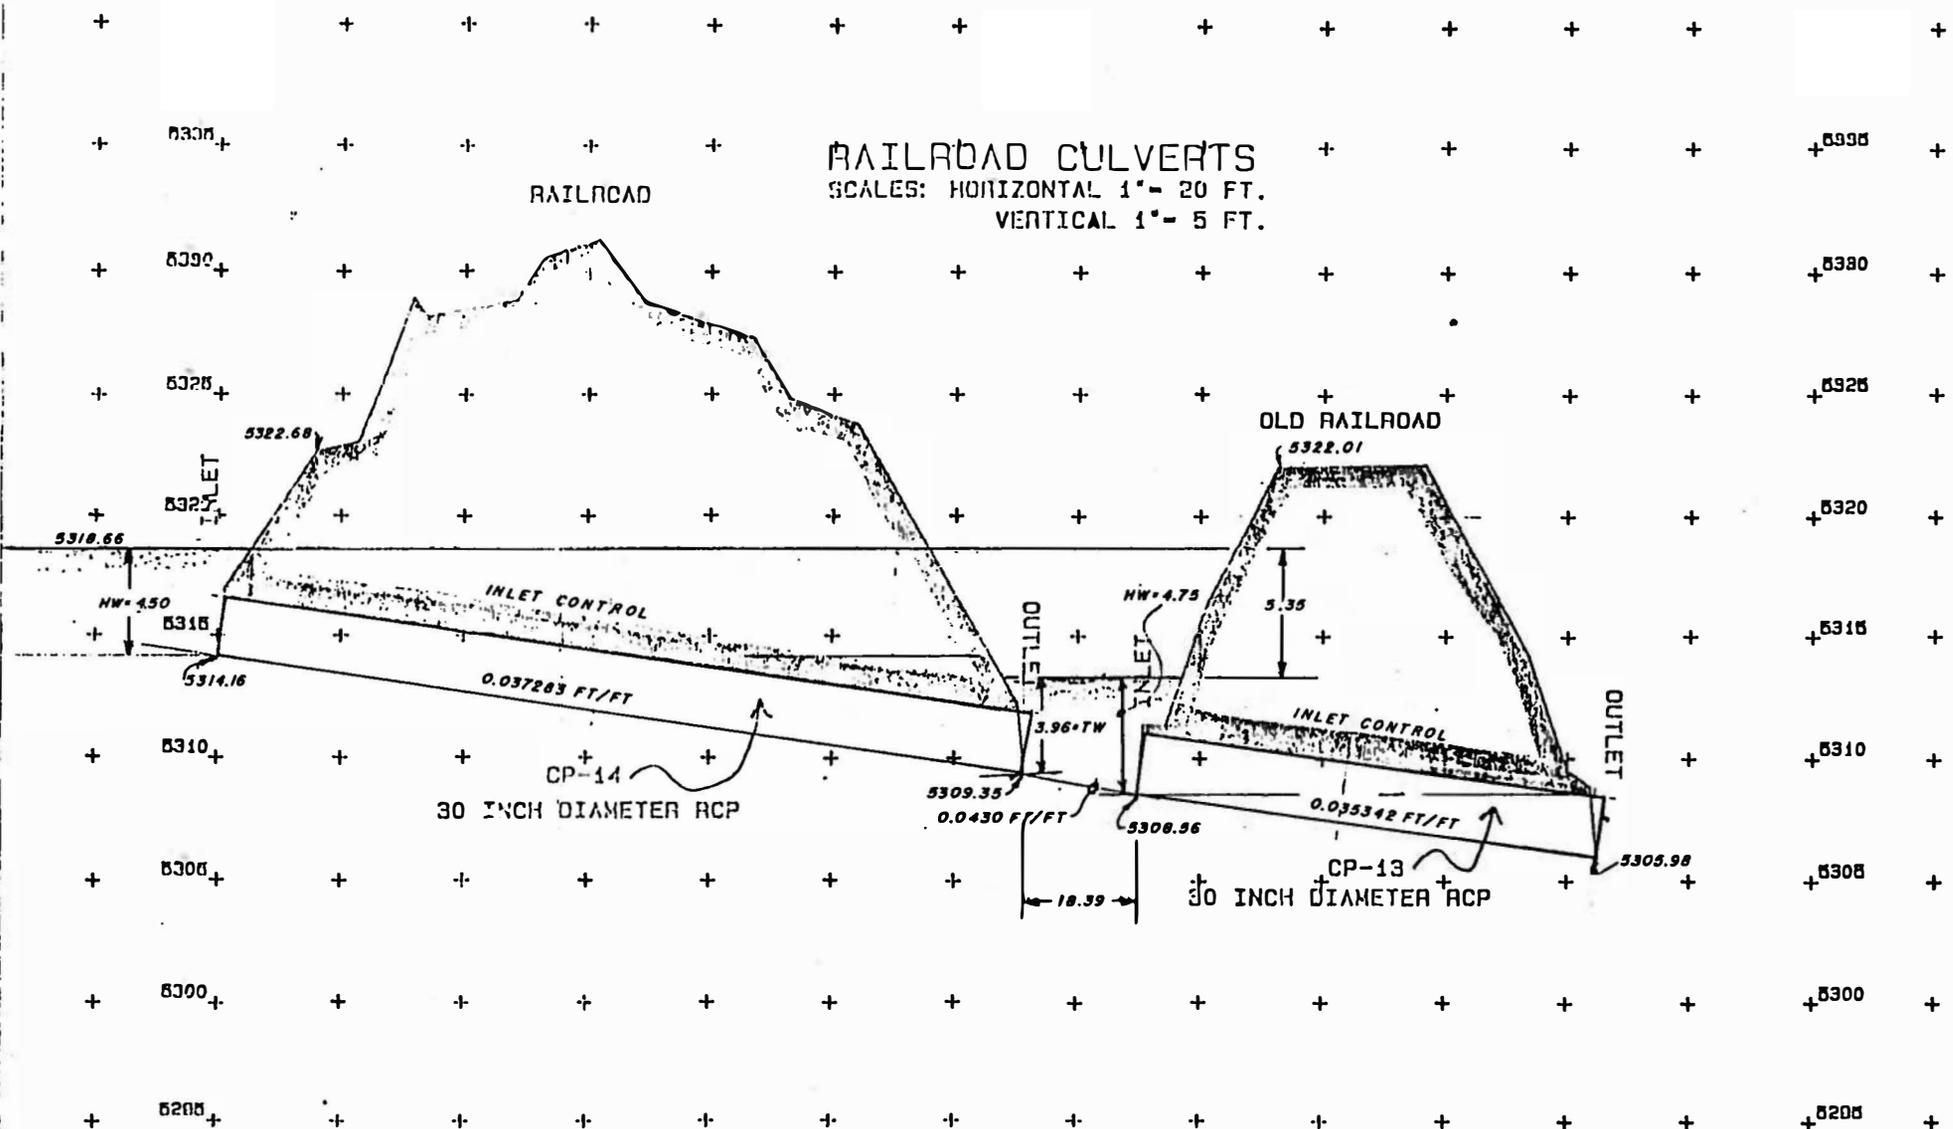

**FIGURE 26-1**  
**BHP MINERALS INTERNATIONAL INC.**




**RAILROAD CULVERTS**  
**CP-14 AND CP-13**  
**CROSS-SECTION**

REV. NO.	DATE	REVISIONS	APPROVALS			
			DRAFT	ENGR.	CMTY. SUPV.	PROJECT MGR.
1	10/92	Midterm Permit Review	PF	JAG	GAP	RCV

DRAWN BY PF	SCALE AS SHOWN
APPROVED BY	DATE NOV. 10, 1992 FIG.
DRAWING NO.	LOCATION NO.

RAILROAD CULVERTS  
 SCALE: HORIZONTAL 1" = 20 FT.  
 VERTICAL 1" = 5 FT.

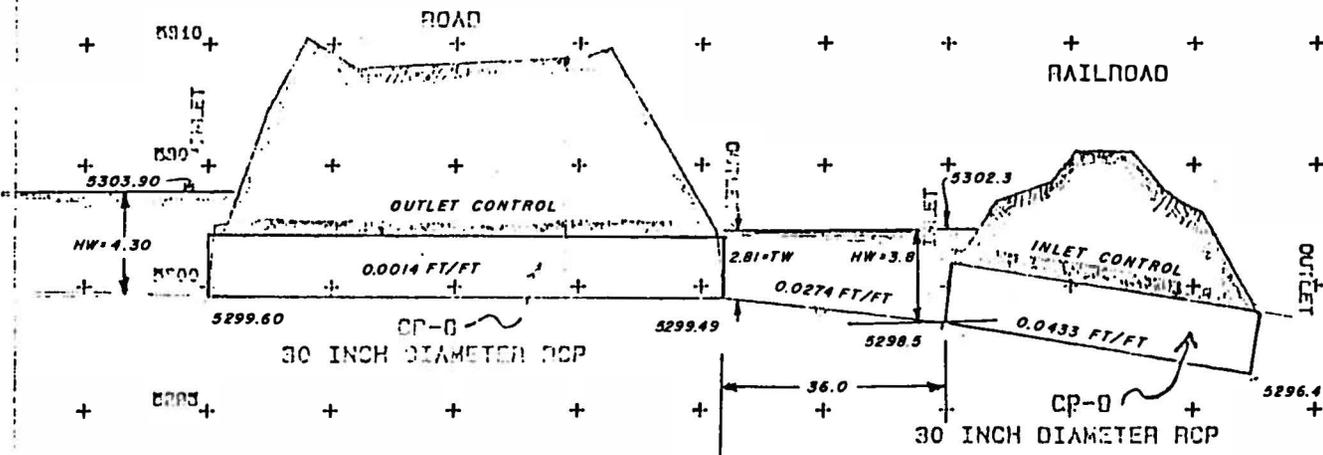

**FIGURE 26-2**  
 INTERNATIONAL  
 BHP MINERALS INC.  
 P.O. BOX 153, FRUITLAND, NEW MEXICO, 87416

**RAILROAD CULVERTS  
 CP-8 AND CP-9  
 CROSS-SECTION**

REV. NO.	DATE	REVISIONS	APPROVALS			
			DRAFT	ENGR.	INSP.	PROJECT
1	10/92	Midterm Permit Reviv	PF	REV	GAP	REV


DRAWN BY PF	SCALE AS SHOWN
APPROVED BY	DATE NOV. 10, 1932 FIG.
DRAWING NO.	LOCATION NO.

SLOPE TOP OF BERM AWAY FROM CHANNEL OR CONSTRUCT BERM AT CREST TO PREVENT FLOW TOWARDS CHANNEL

EXCESS MATERIAL

BERM  
2-3 FT HIGH

ORIGINAL GROUND

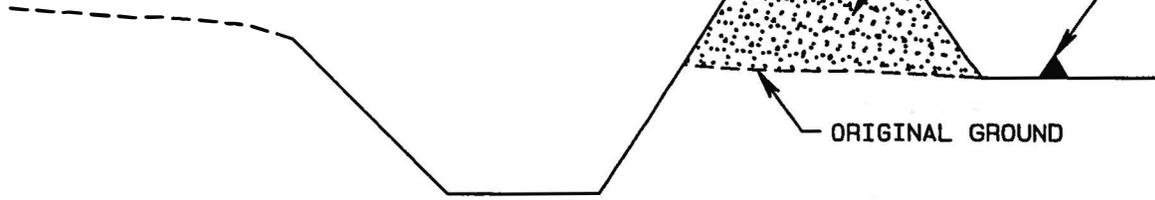

**TYPICAL SECTION**  
NTS

SILT FENCE

TOP OF BERM

GROUND PROFILE



**TYPICAL PROFILE**  
NTS

A	3-07-02	PJF	SUBMITTED TO DSH FOR REVIEW AND APPROVED.	MC	LR		
REV. No.	DATE	DRAFT. BY	REVISION DESCRIPTION	PLN	E.O.	P.E.	FILE

**FIGURE 26-3**


BHP BILLITON NAVAJO COAL COMPANY




P.O. BOX 155 FRUITLAND, NEW MEXICO 87416

**NORTH FORK DIVISION CHANNEL  
DRAINAGE CONTROL FOR  
EXCESS MATERIAL DUMP**

PREPARED BY LR	DRAWN BY PJF	SCALE 1" = NTS
APPROVED BY LR	DATE Mar. 7, 2002	

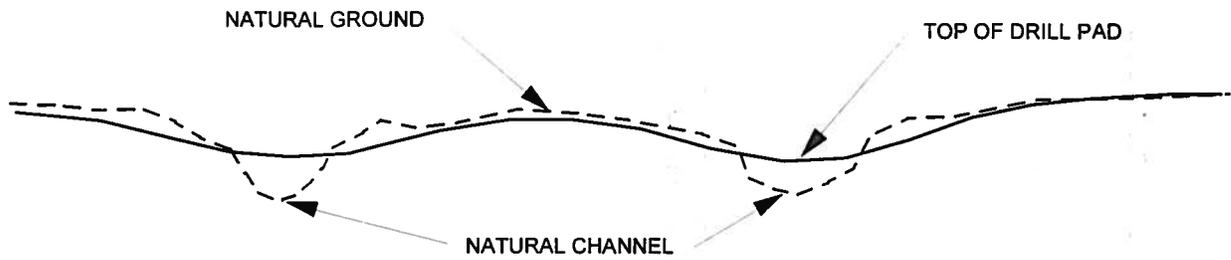


**TYPICAL DRILL PAD SECTION**  
**LONGITUDINAL DIRECTION**  
 NTS

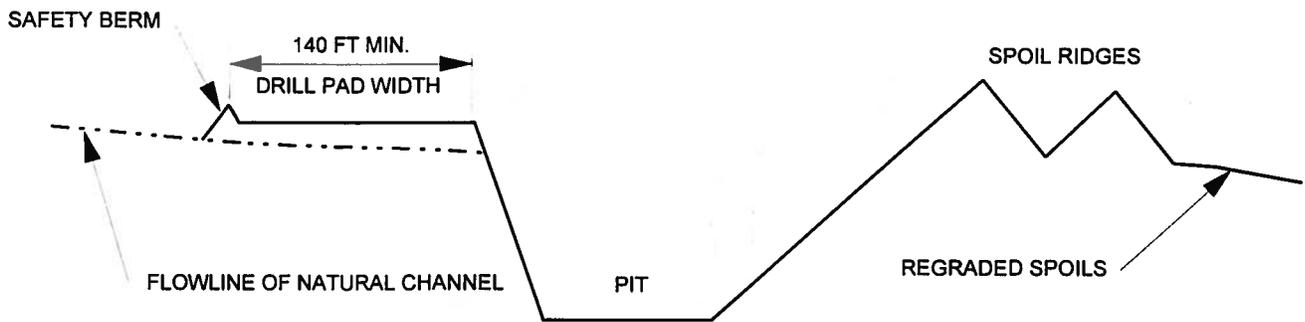

**TYPICAL DRILL PAD SECTION**  
**PERPENDICULAR TO HIGHWALL AND AT CHANNEL**  
 NTS

<b>BHP NAVAJO COAL COMPANY</b>		
		
P.O. BOX FRUITLAND, NM 87416		
<b>DRILL PAD</b>		
<b>TYPICAL SECTIONS</b>		
PREPARED BY: LR	DRAWN BY: LR	SCALE: NTS
APPROVED BY:	DATE: 3-28-97	DWG. LOC.
DWG. NO.	REF. DWG.	

**Figure 26-4**

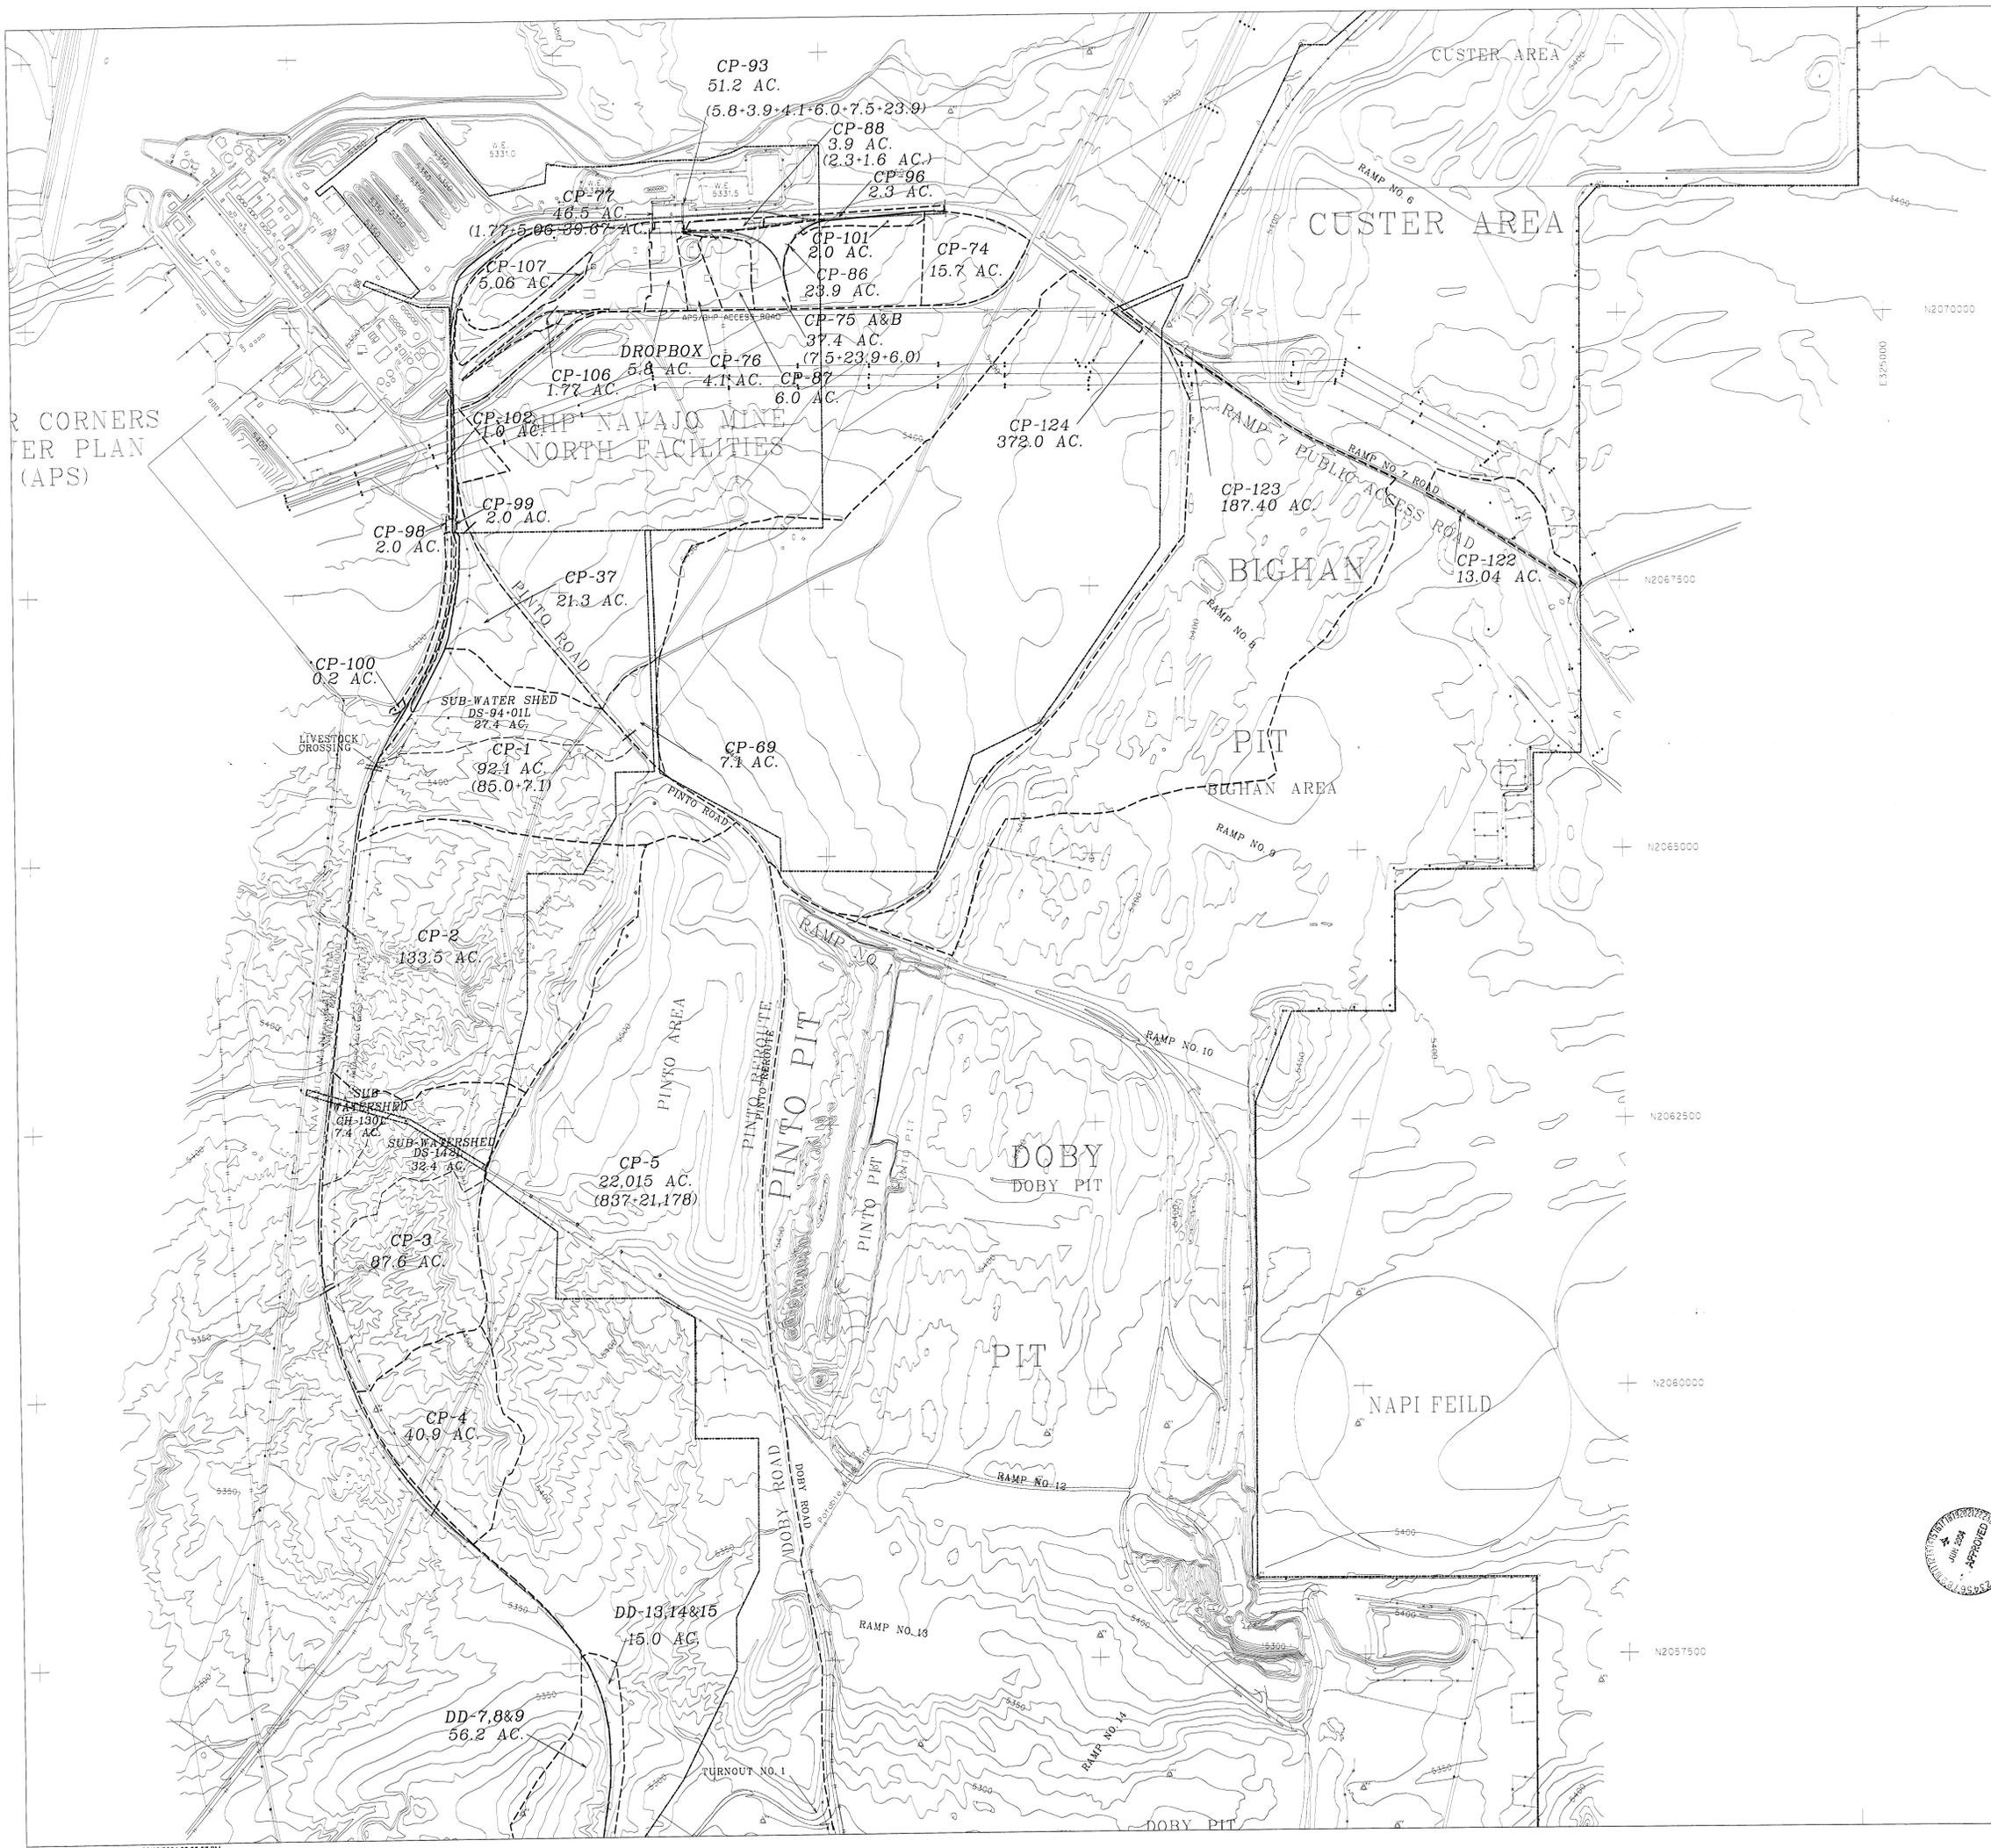

R CORNERS  
ER PLAN  
(APS)

**LEGEND**

- PAVED ROAD
- DIRT ROAD
- HAUL ROAD
- TRAIL
- BUILDING
- FENCE
- IRRIG. DN. LINE
- CULVERT
- DAM
- DRAINAGE
- RAILROAD
- TREES
- POWERLINE
- SPOT ELEVATION
- INDEX CONTOUR
- INTERMEDIATE CONTOUR
- HORIZ. & VERT. CONTROL
- LEASE CORNER
- PERMIT/LEASE BOUNDARY
- CULVERT/DROPBOX STRUCTURE LOCATIONS AND WATERSHED AREAS

500 0 500 1000  
CONTOUR INTERVAL: 10'

**CERTIFICATION STATEMENT**  
I, Leonard Raymond hereby certify that this drawing was reviewed by me and that the information shown is accurate and complete to the best of my knowledge.


LEONARD RAYMOND  
REGISTERED PROFESSIONAL ENGINEER  
NO. 8600  
3-22-04

DATE	BY	REVISION DESCRIPTION	ENG. E.S.T. P.E. P.S. P.E.

**EXHIBIT UHNR/B 26-1**  
BHP NAVAJO COAL COMPANY  
NAVAJO COAL COMPANY  
P.O. BOX 155 FREDLAND, NEW MEXICO 87418

**AREA-I  
CULVERT/DROPBOX  
STRUCTURE LOCATIONS  
AND WATERSHED AREAS**

PREPARED BY: [Signature] DRAWN BY: R.J.F. SCALE: 1" = 500'  
APPROVED BY: [Signature] DATE: DEC. 03, 1995 DWG. LOC. MF D-1  
DWG. NO. REF. DWG.

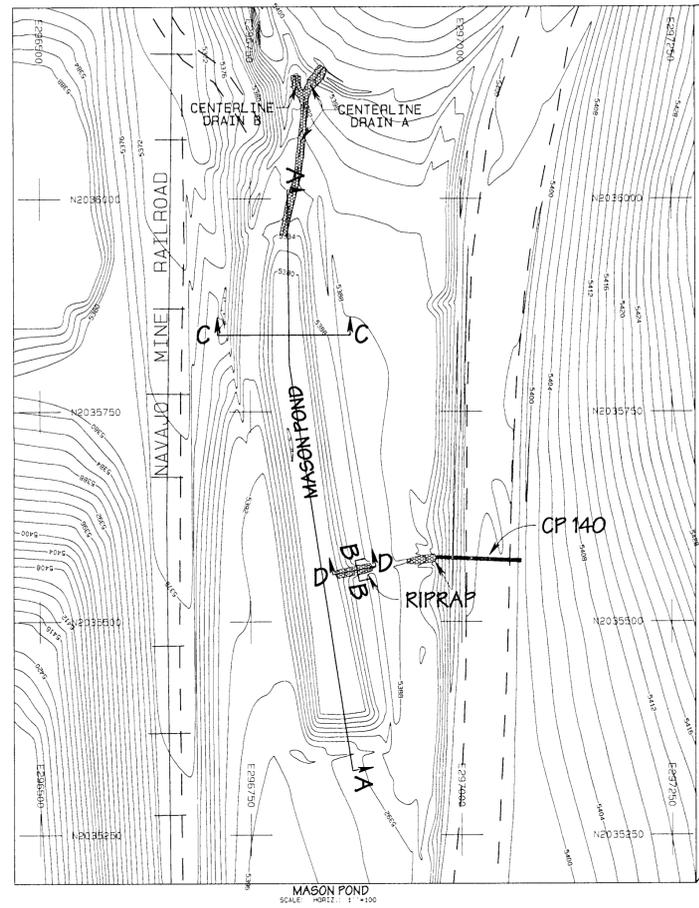


**LEGEND**

- ROAD
- WATERSHED
- BUILDING
- FENCE
- IRRIGATION LINE
- CULVERT
- DAM
- DRAINAGE
- RAILROAD
- TREES
- POWERLINE
- SPOT ELEVATION
- INDEX CONTOUR
- INTERMEDIATE CONTOUR
- LEASE LINE








**NOTES**

- For hydrology and design information refer to Appendix 11-AA in the approved PAP.
- Blue line Elevations can be found in Table 11-5
- Gauge post base elevation: 5379.54 (GPS).

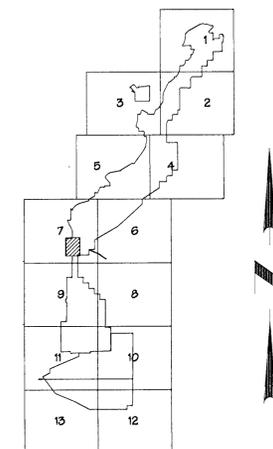

**STAGE STORAGE DATA**

ELEV feet	AREA acres	VOLUME ac-ft	CUM. VOLUME ac-ft
5378	.01	0.00	0.00
5379	0.27	0.14	0.14
5380	0.48	0.38	0.52
5381	0.55	0.51	1.03
5382	0.61	0.58	1.61
5383	0.69	0.65	2.26
5384	0.76	0.72	2.99
5385	0.83	0.80	3.78
5386	0.91	0.87	4.65
5387	1.1	1.01	5.66

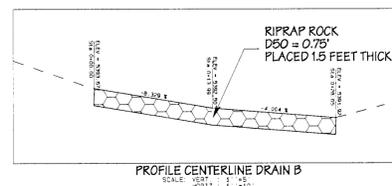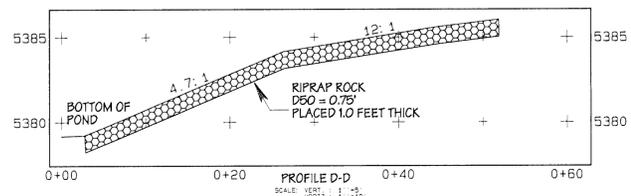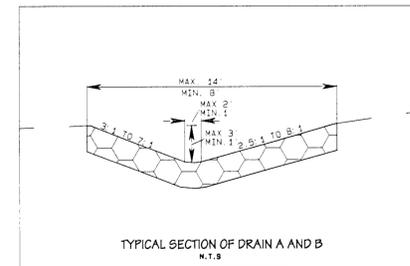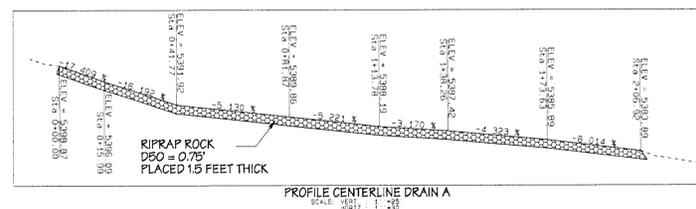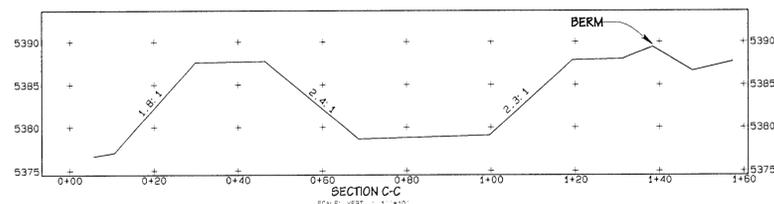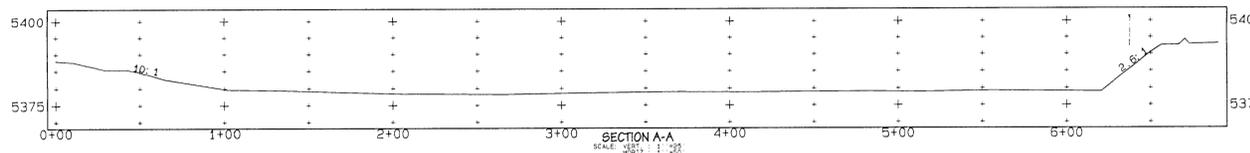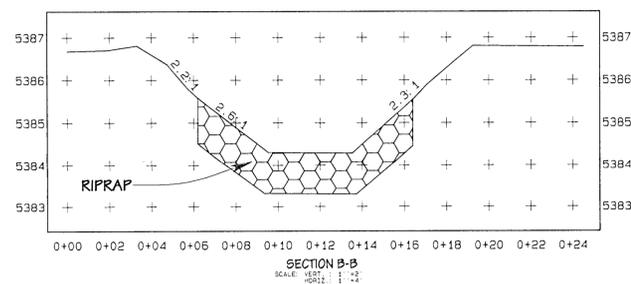

**CERTIFICATION STATEMENT**

I, Leonard Raymond, hereby certify that this impoundment has been constructed in accordance with the approved design plans and that this information shown is complete and accurate to the best of my knowledge, except as noted below.

- The D50 riprap size placed in the inlet is less than the design due to decreases in the peak flow and the inlet slope.

LEONARD RAYMOND  
NEW MEXICO  
REGISTERED PROFESSIONAL ENGINEER  
11-29-06

APPROVED  
DEC 2006

4-17-00

**BHP-NAVAJO COAL CO.**  
**NAVAJO MINE**  
PO BOX 1717, ERIKLAND, N.M. MEXICO, 87416

PROJECT DATE: APRIL 17, 2000  
DESIGNED BY: AT  
DRAWN BY: AT  
CHECKED BY: LR  
APPROVED BY: LR

**PLAN, PROFILE AND SECTIONS**

**EXHIBIT 11-139A**  
**MASON POND AS-BUILT**

DRAWING SHEET 1 OF 1

**LEGEND**

- PAVED ROAD
- DIRT ROAD
- HAIL ROAD
- TRAIL
- BUILDING
- FENCE
- IRRIGATION LINE
- CULVERT
- DAM
- DRAINAGE
- RAILROAD
- TREES
- POWER LINE
- SPOT ELEVATION
- INDEX CONTOUR
- INTERMEDIATE CONTOUR
- HORIZ. & VERT. CONTROL
- LEASE CORNER
- PERMIT/LEASE BOUNDARY
- CULVERT AND DOWN DRAINAGE STRUCTURE LOCATIONS AND WATERSHED BOUNDARY

NOTE:  
 1. The watershed for CP-111 is current topo.  
 2. Hydrology data for culverts are in Appendix 11-1.



NO.	DATE	BY	REVISION DESCRIPTION	CHK.	APP.
1	11-13-00	RUF	ISSUED FOR PERMITTING	ML	LR
2	11-13-00	RUF	REVISED TO REFLECT COMMENTS FROM BUREAU OF LAND MANAGEMENT	ML	LR
3	11-13-00	RUF	REVISED TO REFLECT COMMENTS FROM BUREAU OF LAND MANAGEMENT	ML	LR
**CERTIFICATION STATEMENT**  
 I, Leonard Raymond, hereby certify that this drawing was prepared by me and that the information contained herein is complete and accurate to the best of my knowledge.

**LEONARD RAYMOND**  
 LICENSED PROFESSIONAL ENGINEER  
 STATE OF ARIZONA  
 LICENSE NO. 6600


**Exhibit 26-2**

**bhpbilliton**

**BHP Navajo Coal Company**  
 P.O. Box 1717 Phone: 505-938-4200  
 P.O. Box 1000, New Mexico, 87416 Fax: 505-938-3333

**AREA-II CULVERT/DOWN DRAINAGE STRUCTURE LOCATIONS AND WATERSHED AREAS**

PREPARED BY: RUF/ML DRAWN BY: RUF SCALE: 1" = 500'  
 APPROVED BY: DATE: DEC. 02, 1995  
 MAP LOCATION: (See Lower Left Corner)

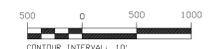





**LEGEND**


	PAVED ROAD
	DIRT ROAD
	HAUL ROAD
	TRAIL
	BUILDING
	FENCE
	IRRIGATION LINE
	CULVERT
	DAM
	DRAINAGE
	RAILROAD
	TREES
	POWERLINE
	SPOT ELEVATION
	INDEX CONTOUR
	INTERMEDIATE CONTOUR
	HORIZ. & VERT. CONTROL
	LEASE CORNER
	PERMIT/LEASE BOUNDARY
	DRAINAGE DROPBOX
	CULVERT LOCATION
	WATERSHED AND SUBWATERSHED BOUNDARY

**NOTE:**

- REFER TO APPENDIX 11-V FOR HYDROLOGY DATA.
- THE HYDROLOGY MODEL IS PRESENTED ON EXHIBIT 11-75.

**CERTIFICATION STATEMENT**

I, Ron C. Van Valkenburg, hereby certify that this drawing was reviewed by me and that the information shown is complete and accurate to the best of my knowledge.

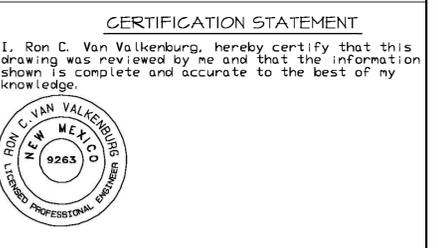

REV. NO.	DATE	DRAWN BY	REVISION DESCRIPTION	ENG.	C.D.	P.E.	P.S.	CHEF. ENGR.
A	11-05-95	PJF	SUBMITTED TO OSM FOR APPROVAL.					
B	5-27-96	PJF	MO TERM SUBMITTAL TO OSM FOR RENEW AND APPROVAL.	BTS	PVS	LR		
C	8-31-96	PJF	REFERENCE UPDATE ON CP-111, REMOVED REFERENCE TO CP-111 AND SUBMITTED TO OSM FOR RENEW AND APPROVAL.	BH	MC	LR		
D	3-04-04	PJF	UPDATED WATERSHED FOR 'YAZZIE' "Y" CULVERT AND SUBMITTED TO OSM FOR APPROVAL.	LR	MC	LR		
D	3-04-04	PJF	UPDATED WATERSHED FOR 'YAZZIE' "Y" CULVERT AND SUBMITTED TO OSM FOR APPROVAL.	LR	MC	LR		
D	3-04-04	PJF	UPDATED WATERSHED FOR 'YAZZIE' "Y" CULVERT AND SUBMITTED TO OSM FOR APPROVAL.	LR	MC	LR		
A-04	5-12-08	PJF	Revised CP-172 to add CP-31, 32, 33, 34 and CP-172 will be the same as "YAZZIE" Y, Check District and submit to OSM for review.	Shen	YB	RVV		

**EXHIBIT 26-4**

**BHP NAVAJO COAL COMPANY**

P.O. BOX 1717    FRUITLAND, NEW MEXICO    87416

**WATERSHED AREA**

**YAZZIE "Y" CULVERTS**

**(CP-172)**

PREPARED BY: BTS/PJF    DRAWN BY: PJF    SCALE: 1" = 2000'

APPROVED BY: \_\_\_\_\_    DATE: Dec. 20, 1995

MAP LOCATION: (See Lower Left Corner)












2 - 48" CMP - 145 ft Long  
Inlet Elevation = 5287.1 ft

Top of Dam  
Elev. 5288.8 ft

**Design Summary**

Storm Event	25 YR-6 HR	5275.0	0.41	0.15
Drainage Area	102.8 ac	5277.0	0.41	0.17
Runoff Volume	4.5 ac-ft	5275.0	0.50	0.17
25 Yr. Sediment Volume	143 ac-ft	5280.0	0.75	2.28
Spillway Elevation	5287.1	5281.0	0.67	2.02
Top of Dam	5288.8	5285.0	0.75	4.14
Peak Slope	5287.7	5284.0	0.44	4.19
Head Volume @ Peak Slope	8.67 ac-ft	5285.0	0.89	5.93
		5286.0	0.94	6.95
		5287.1	1.0	8.02
		5288.0	1.06	8.94
		5288.8	1.14	9.82

TOP OF EMBANKMENT ELEVATION 5288.8  
BOTTOM OF POND ELEVATION 5273.0  
TOP WIDTH OF EMBANKMENT 30 FT.  
MAXIMUM SEDIMENT ELEVATION 5279.2  
MAXIMUM SIDE SLOPE (H:V) 2.2:1

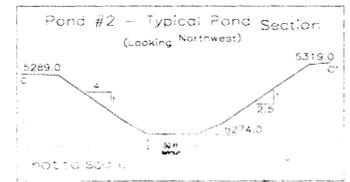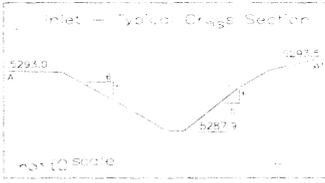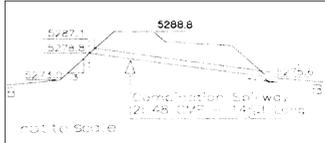

# Legend

-  Area of Detail
-  Gauge Post
-  48" CMP Culvert


**NOTE:**

- GAUGE POST BASE ELEVATION 5274.9.
- FOR BLUELINE ELEVATION REFER TO TABLE 11-5D IN THE PAP.

**CERTIFICATION STATEMENT**  
I, Leonard Raymond, hereby certify that this drawing was reviewed by me and that the information shown is complete and accurate to the best of my knowledge.



I, RON VANVALKENBURG, HEREBY CERTIFY THAT THE INFORMATION DISPLAYED ON THIS EXHIBIT IS COMPLETE AND ACCURATE TO THE BEST OF MY KNOWLEDGE.

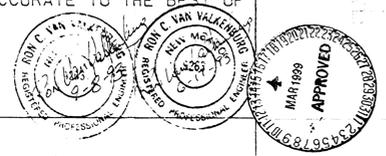

## EXHIBIT 26-8



BARBER COAL STOCKPILE SEDIMENTATION POND # 2  
MAY 1993  
APPROVED

REV. NO.	DATE	DRAWN BY	DESCRIPTION	ENC. E.G.	APPROVALS
5	9-14-98	RV	Added Notes 1 and 2.		
4	7-28-94	PJF	UPDATED DESIGN SUMMARY AND STAGE-AREA DATA.		
3	8/24/93	JG	CHANGE EXHIBIT NO. TO 11-43		
2	6-11-93	PJF	ADDED CONTRACTED APPROVED DRAINAGE SWAGE, DESIGN SUMMARY & CROSS-SECTIONS.		
1	03/29/91		AS-BUILT SUBMITTAL		

DRAWN BY JER SCALE 1" = 200' H. 1.0" V.  
APPROVED BY DATE 06/11/93  
DRAWING NO LOCATION NO MF-D2



- LEGEND**
- PAVED ROAD
  - DIRT ROAD
  - HAUL ROAD
  - TRAIL
  - BUILDING
  - FENCE
  - IRRIGATION LINE
  - CULVERT
  - DAM
  - DRAINAGE
  - RAILROAD
  - TREES
  - POWER LINE
  - SPOT ELEVATION
  - INDEX CONTOUR
  - INTERMEDIATE CONTOUR
  - HORIZ. & VERT. CONTROL
  - LEASE CORNER
  - PERMIT/LEASE BOUNDARY
  - WATERSHED BOUNDARY
  - PONDS
- NOTES:**  
 1. FOR HYDROLOGY INFORMATION REFER TO APPENDIX 11-AA IN THE APPROVED PAP.

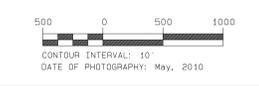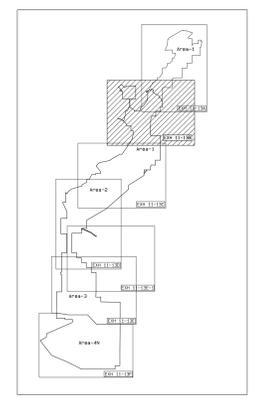

Revised by  
 Aero - Graphics Inc.  
 40 West Oakland Avenue  
 Salt Lake City, Utah 84115

NO.	DATE	BY	DESCRIPTION	CHKD.	APP'D.
1	11-11-95	JLF	DESIGNED NORTH CELL & REFINISHED AND SUBMITTED TO STATE FOR REVIEW	LR	LR
2	11-12-95	JLF	REVISED THE DESIGN AND SUBMITTED FOR STATE REVIEW	LR	LR
3	12-01-95	JLF	REVISED DESIGN TO COMPLY WITH STATE REQUIREMENTS	LR	LR
4	12-01-95	JLF	REVISED DESIGN TO COMPLY WITH STATE REQUIREMENTS	LR	LR
**CERTIFICATION STATEMENT**  
 I, Leonard Raymond, hereby certify that this drawing was reviewed by me and that the information shown is complete and accurate to the best of my knowledge.



**EXHIBIT 26-9**





**BHP Navajo Coal Company**  
 P.O. Box 1717  
 Fruita, New Mexico, 87415  
 Phone: 505-599-4200  
 Fax: 505-569-3361

**AREA-1  
 IMPOUNDMENT AND  
 POND LOCATIONS/  
 WATERSHED AREAS**

PREPARED BY BS/P. BRANN BY JLF SCALE 1" = 500'  
 APPROVED BY DATE Nov. 5, 1995  
 MAP LOCATION: (See Lower Left Corner)

C:\Users\jlf\Documents\11-013-Drawings\BIA\Approved\26-9-2010\Area-1-138.dwg  
 11/05/2010 10:56:15 AM  
 11/05/2010 10:56:15 AM

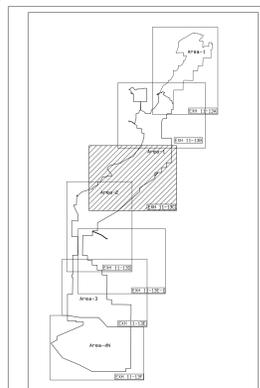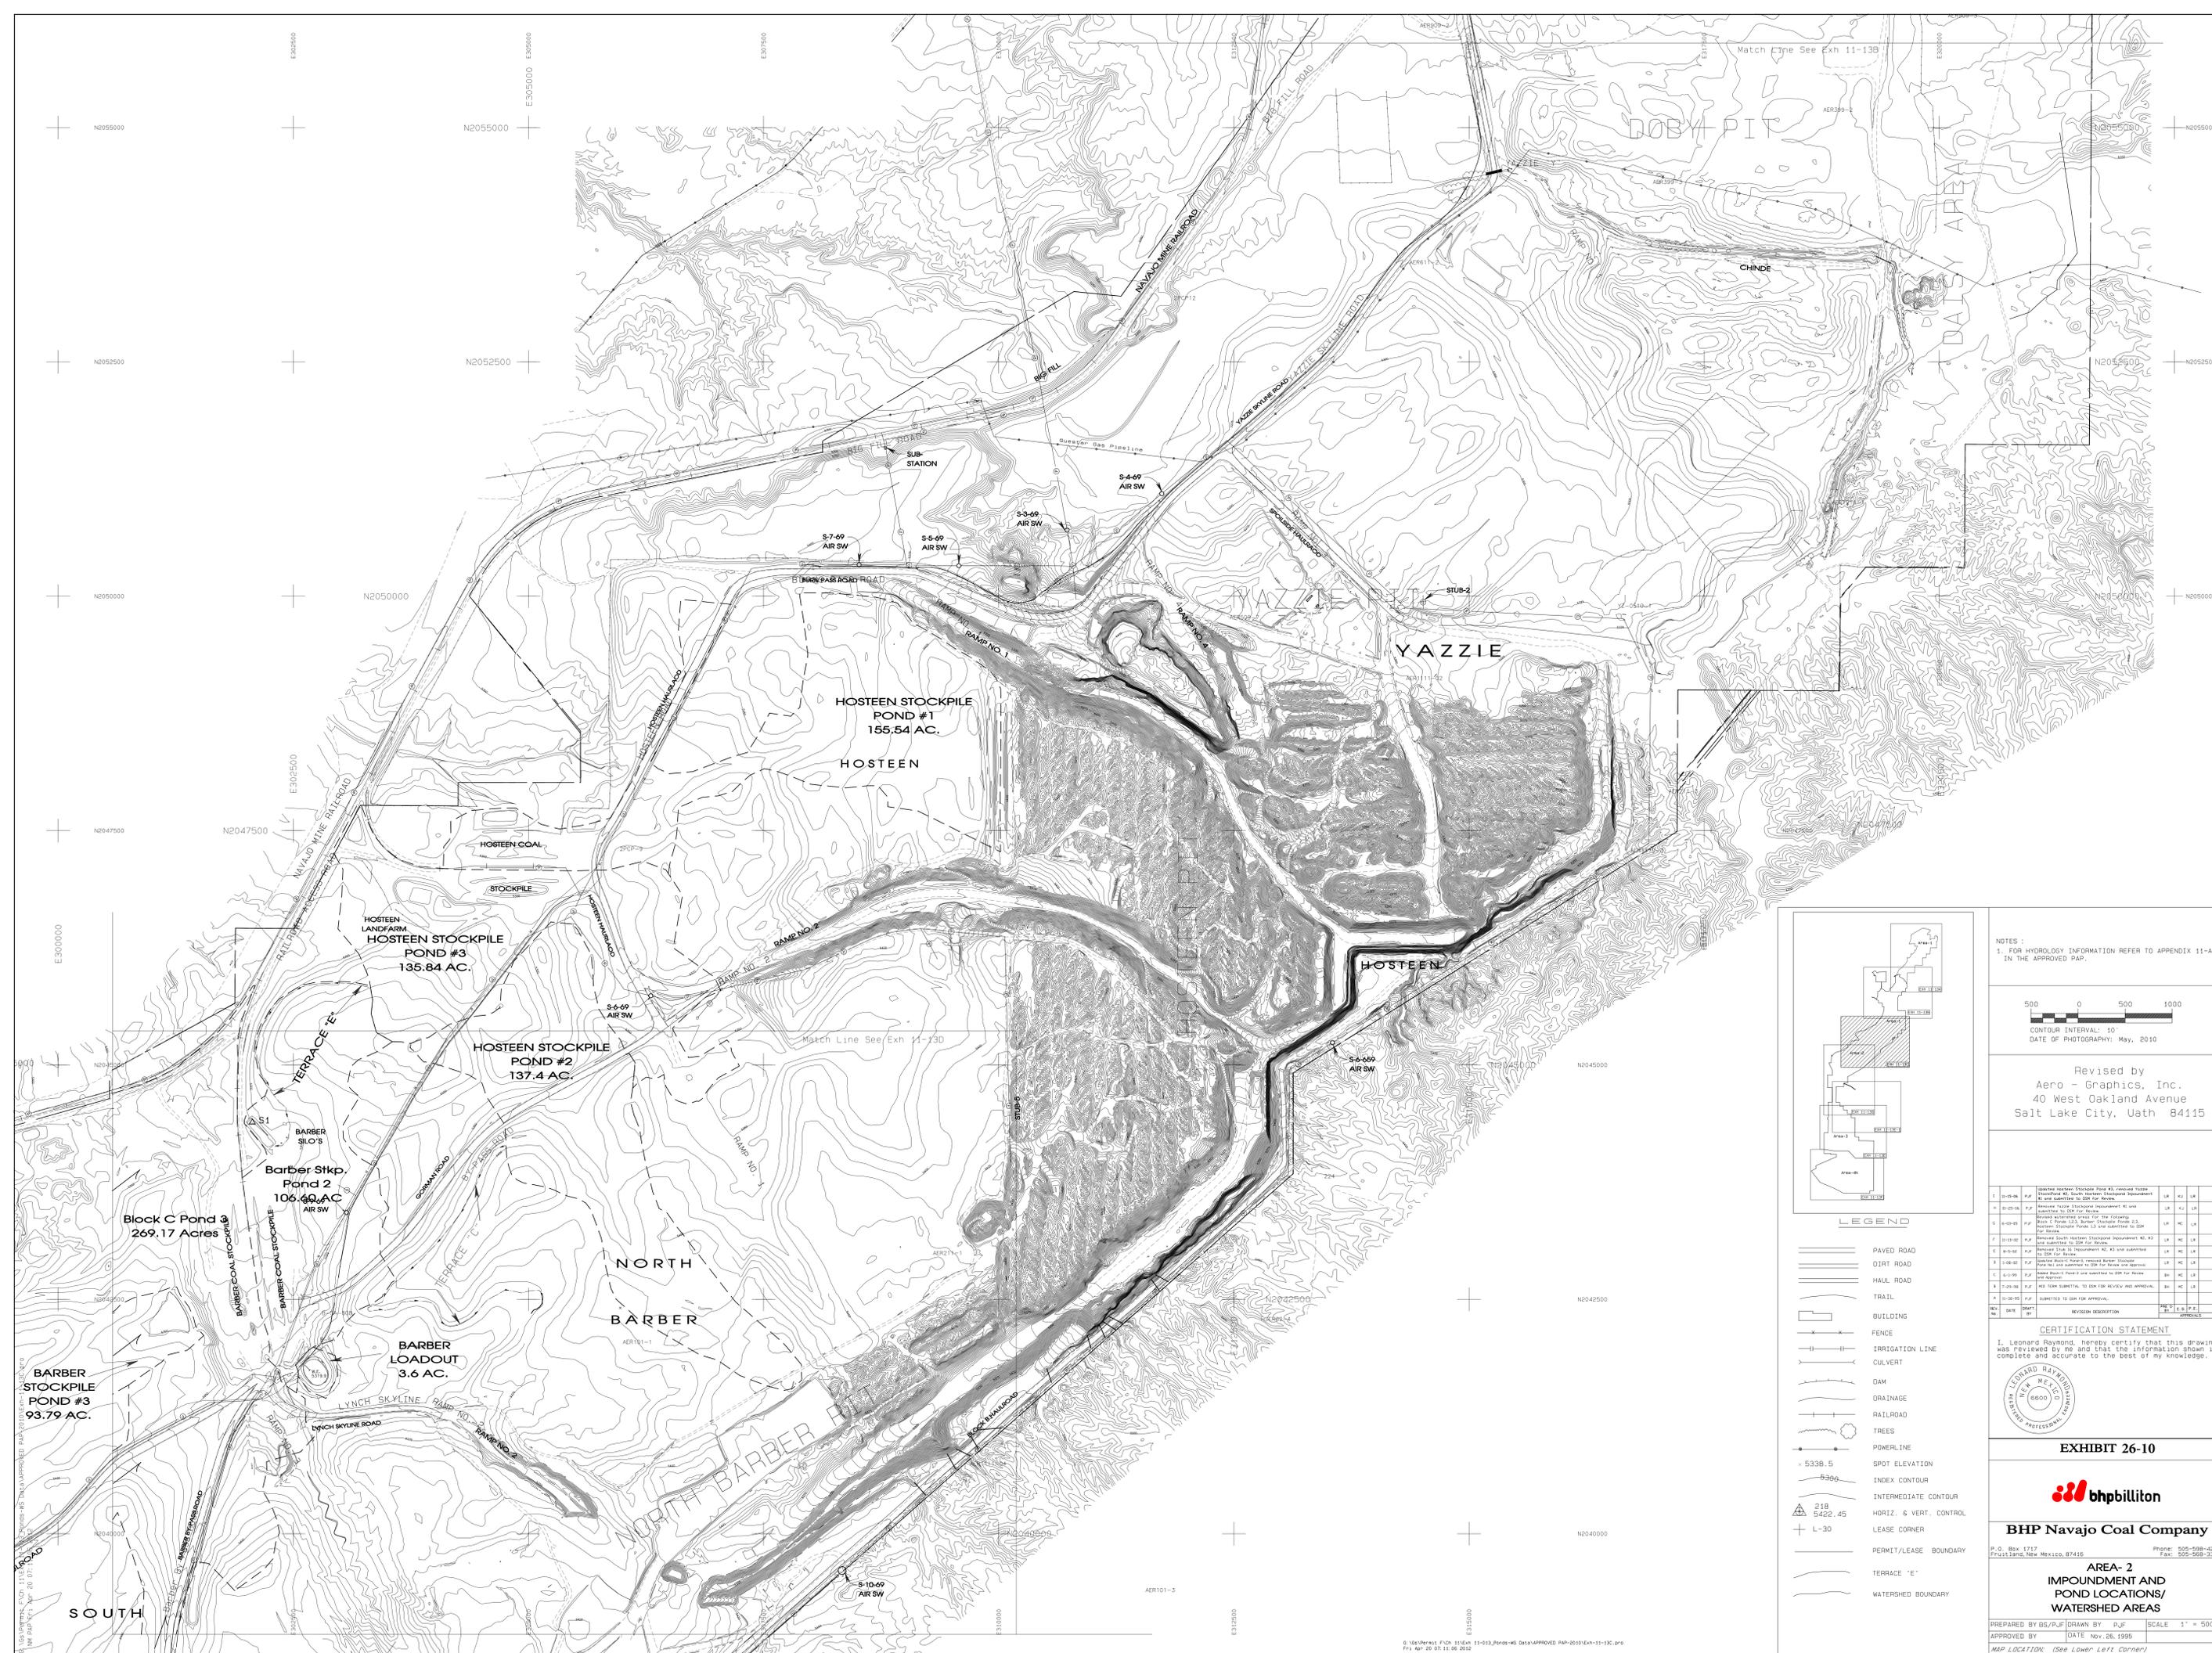

NOTES:  
 1. FOR HYDROLOGY INFORMATION REFER TO APPENDIX 11-AA IN THE APPROVED PAP.

500 0 500 1000  
 CONTOUR INTERVAL: 10'  
 DATE OF PHOTOGRAPHY: May, 2010

Revised by  
 Aero - Graphics, Inc.  
 40 West Oakland Avenue  
 Salt Lake City, Utah 84115

**LEGEND**

	PAVED ROAD
	DIRT ROAD
	HAUL ROAD
	TRAIL
	BUILDING
	FENCE
	IRRIGATION LINE
	CULVERT
	DAM
	DRAINAGE
	RAILROAD
	TREES
	POWERLINE
	SPOT ELEVATION
	INDEX CONTOUR
	INTERMEDIATE CONTOUR
	HORIZ. & VERT. CONTROL
	LEASE CORNER
	PERMIT/LEASE BOUNDARY
	TERRACE 'E'
	WATERSHED BOUNDARY

NO.	DATE	BY	DESCRIPTION	REVISED	BY	DATE
1	10-08-08	P.J.	Update Hosteen Stockpile Pond #3, remove Hosteen Stockpile Pond #1, South Barber Stockpile Pond #1 and submit to DMR for Review.	LR	LR	LR
2	10-07-08	P.J.	Remove Hosteen Stockpile Pond #1 and submit to DMR for Review.	LR	LR	LR
3	10-07-08	P.J.	Remove Barber Stockpile Pond #1 and submit to DMR for Review.	LR	LR	LR
4	10-07-08	P.J.	Remove Barber Stockpile Pond #2 and submit to DMR for Review.	LR	LR	LR
5	10-07-08	P.J.	Remove Barber Stockpile Pond #3 and submit to DMR for Review.	LR	LR	LR
102	10-07-08	P.J.	Remove Barber Stockpile Pond #100 and submit to DMR for Review.	LR	LR	LR

**CERTIFICATION STATEMENT**  
 I, Leonard Raymond, hereby certify that this drawing was reviewed by me and that the information shown is complete and accurate to the best of my knowledge.

**EXHIBIT 26-10**

**BHP Navajo Coal Company**

P.O. Box 1717 Phone: 505-598-4300  
 Puyallup, WA 98148 Fax: 505-568-3361


**AREA- 2  
 IMPOUNDMENT AND  
 POND LOCATIONS/  
 WATERSHED AREAS**

PREPARED BY BS/PJF DRAWN BY DJF SCALE 1" = 500'  
 APPROVED BY DATE Nov. 28, 1995  
 MAP LOCATION: (See Lower Left Corner)







- LEGEND**
- PAVED ROAD
  - DIRT ROAD
  - HAUL ROAD
  - TRAIL
  - BUILDING
  - FENCE
  - IRRIGATION LINE
  - CULVERT
  - DAM
  - DRAINAGE
  - RAILROAD
  - TREES
  - POWERLINE
  - SPOT ELEVATION
  - INDEX CONTOUR
  - INTERMEDIATE CONTOUR
  - HORIZ. & VERT. CONTROL
  - LEASE CORNER
  - PERMIT/LEASE BOUNDARY
  - WATERSHED BOUNDARY
  - PONDS

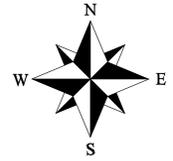

NOTES:  
1. FOR HYDROLOGY INFORMATION REFER TO APPENDIX 11-AA IN THE APPROVED PAP.

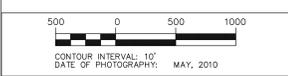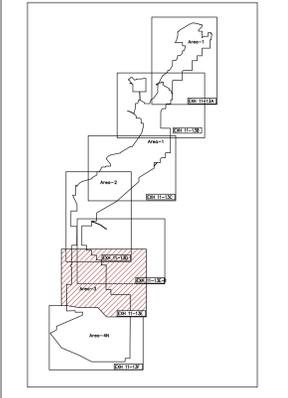

Revised by  
Aero - Graphics, Inc.  
40 West Oakland Avenue  
Salt Lake City, Utah 84115

REV	DATE	DESCRIPTION	BY	CHKD	APP'D
1-1	06-27-13	ISSUE FOR PERMIT	LR	LR	LR
1-2	07-10-13	REVISED TO ADD POND 301	LR	LR	LR
1-3	07-10-13	REVISED TO ADD POND 302	LR	LR	LR
1-4	07-10-13	REVISED TO ADD POND 303	LR	LR	LR
1-101	07-10-13	REVISED TO ADD POND 400	LR	LR	LR

**CERTIFICATION STATEMENT**  
I, Leonard Raymond, hereby certify that this drawing was reviewed by me and that the information shown is complete and accurate to the best of my knowledge.




**EXHIBIT 26-12**




BHP Navajo Coal Company  
P.O. Box 1717  
Fruitland, New Mexico 87416  
Phone: 505-598-4200  
Fax: 505-568-3361

**AREA-III  
IMPOUNDMENT AND  
POND LOCATIONS/  
WATERSHED AREAS**


PREPARED BY RRY DRAWN BY RRY SCALE 1" = 500'  
APPROVED BY LR DATE JUNE 27, 2013 (Post Area 35547)  
MAP LOCATION: (See Lower Left Corner)

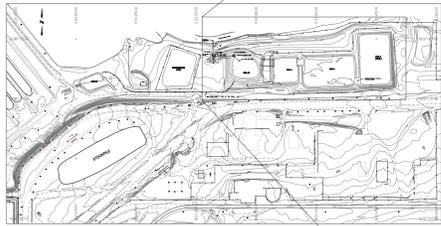


PLAN - NORTH FACILITY  
1" = 500'

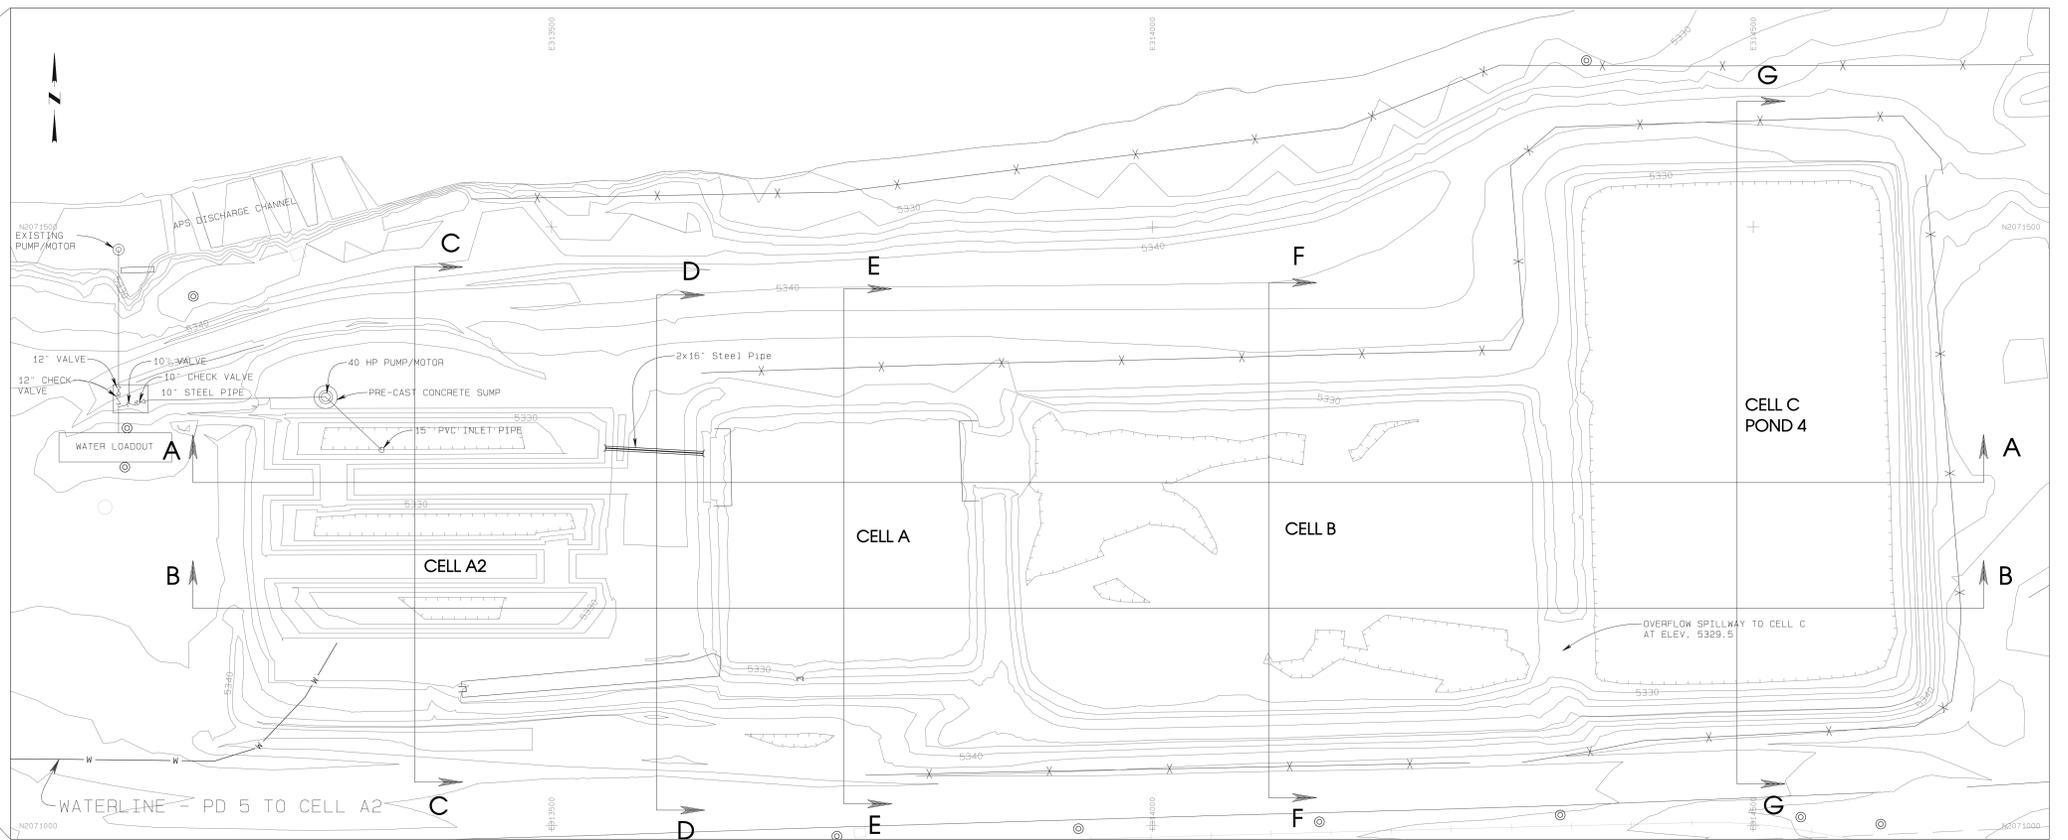


PLAN - NORTH CELLS  
1" = 50'

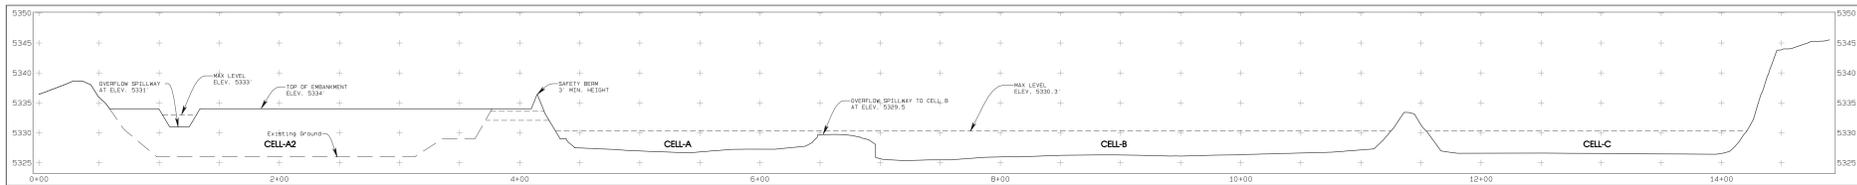


SECTION A

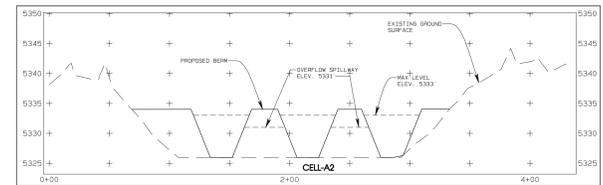


SECTION C

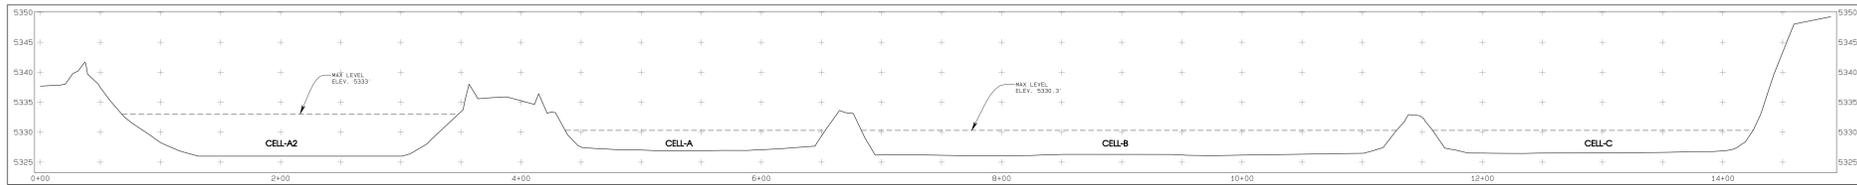


SECTION B

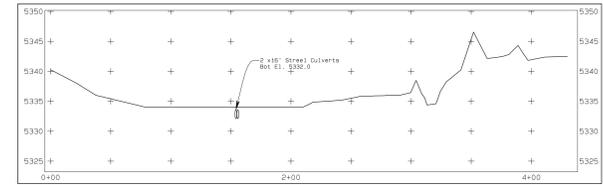


SECTION D

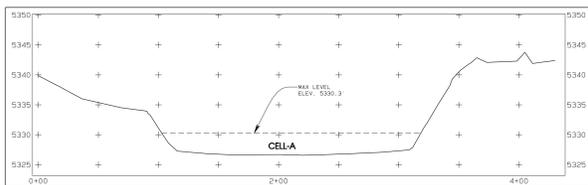

SECTION E

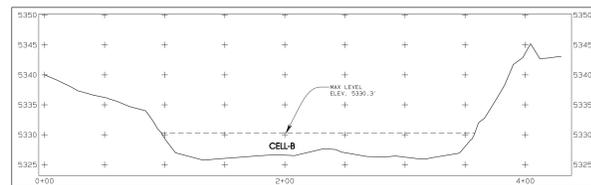

SECTION F

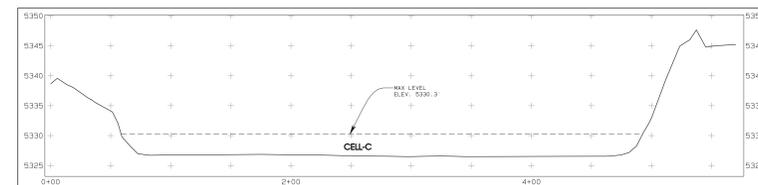

SECTION G

SECTION SCALE:  
HORIZ. - 1" = 50'  
VERT. - 1" = 10'

**CELL A  
STAGE STORAGE**

ELEV.	AREA (AC)	INC. VOL. (AC-FT)	ACCUM. VOL. (AC-FT)
5327.0	0.26	0.00	0.00
5328.0	0.91	0.59	0.59
5329.0	0.99	0.95	1.53
5329.6	1.02	0.60	2.14
5330.0	1.07	0.42	2.55
5331.0	1.13	1.10	3.65
5332.0	1.18	1.15	4.80

**CELL B  
STAGE STORAGE**

ELEV.	AREA (AC)	INC. VOL. (AC-FT)	ACCUM. VOL. (AC-FT)
5325.0	0.00	0.00	0.00
5326.0	0.54	0.27	0.27
5327.0	2.13	1.33	1.61
5328.0	2.38	2.25	3.86
5329.0	2.50	2.44	6.30
5329.5	2.56	1.26	7.56
5330.0	2.63	1.30	8.86
5331.0	2.72	2.68	11.54
5332.0	2.80	2.76	14.30

**CELL C  
STAGE STORAGE**

ELEV.	AREA (AC)	INC. VOL. (AC-FT)	ACCUM. VOL. (AC-FT)
5327.0	2.07	0.00	0.00
5328.0	2.37	2.22	2.22
5329.0	2.51	2.44	4.66
5329.5	2.58	1.27	5.93
5330.0	2.80	1.35	7.28
5331.0	2.64	2.72	10.00
5332.0	2.72	2.68	12.68

**CELL A, B & C COMBINE  
STAGE STORAGE**

ELEV.	AREA (AC)	INC. VOL. (AC-FT)	ACCUM. VOL. (AC-FT)
5325.0	0.01	0.00	0.00
5326.0	0.54	0.27	0.27
5327.0	4.46	1.33	1.61
5328.0	5.66	5.06	6.67
5329.0	5.99	5.82	12.49
5329.5	6.16	3.14	15.63
5330.0	6.50	3.06	18.69
5331.0	6.49	6.49	25.18
5332.0	6.71	6.60	31.78

HIGH WATER LEVEL ELEVATION 5332.0  
MAX. PERMISSIBLE SEDIMENT/WATER LEVEL - ELEV. 5330.30

**CELL A2  
STAGE STORAGE**

ELEV.	AREA (AC)	INC. VOL. (AC-FT)	ACCUM. VOL. (AC-FT)
5326.0	0.19	0.00	0.00
5327.0	0.30	0.24	0.24
5328.0	0.39	0.35	0.59
5329.0	0.49	0.44	1.03
5330.0	0.59	0.54	1.57
5331.0	0.71	0.65	2.21
5332.0	0.81	0.76	2.98
5333.0	0.92	0.87	3.85
5334.0	1.03	0.98	4.82

HIGH WATER LEVEL ELEVATION 5333.0

- NOTES:
1. THE HYDROLOGY DATA IS PRESENTED IN APPENDIX 11-AA.
  2. THE LOCATION AND WATERSHED AREAS ARE PRESENTED ON EXHIBIT 11-13B.

**CERTIFICATION STATEMENT**  
I, Ron C. Van Valkenburg, hereby certify that this drawing was reviewed by me and that the information shown is complete and accurate to the best of my knowledge.





REV.	DATE	BY	REVISION DESCRIPTION	ENG.	C.D.	P.E.	DATE
1	7-27-10	DJR	PRE-DESIGN CELL A2 AND SUBMITTED TO DWR FOR REVIEW	REV	18	REV	
2	7-27-10	DJR	BLOCKED THE OVERFLOW TO CELL A2 AND UPDATED AFTER CLEAN OUT	LR	18	LR	
3	7-27-10	DJR	ADDED STARTERING PUMP AND ASSOCIATED PIPELINE TO CELL A2				
4	11-28-05	DJR	SUBMITTED TO DWR FOR APPROVAL				

**EXHIBIT 26-13**  
**BHP NAVAJO COAL COMPANY**  
NAVAJO MINE  
P.O. BOX 155 FRUITLAND, NEW MEXICO 87416

**NORTH CELLS  
MODIFICATION**

PREPARED BY DJR DRAWN BY DJR SCALE AS NOTED  
APPROVED BY LR DATE 11-28-05 REF DWG EXH 11-106

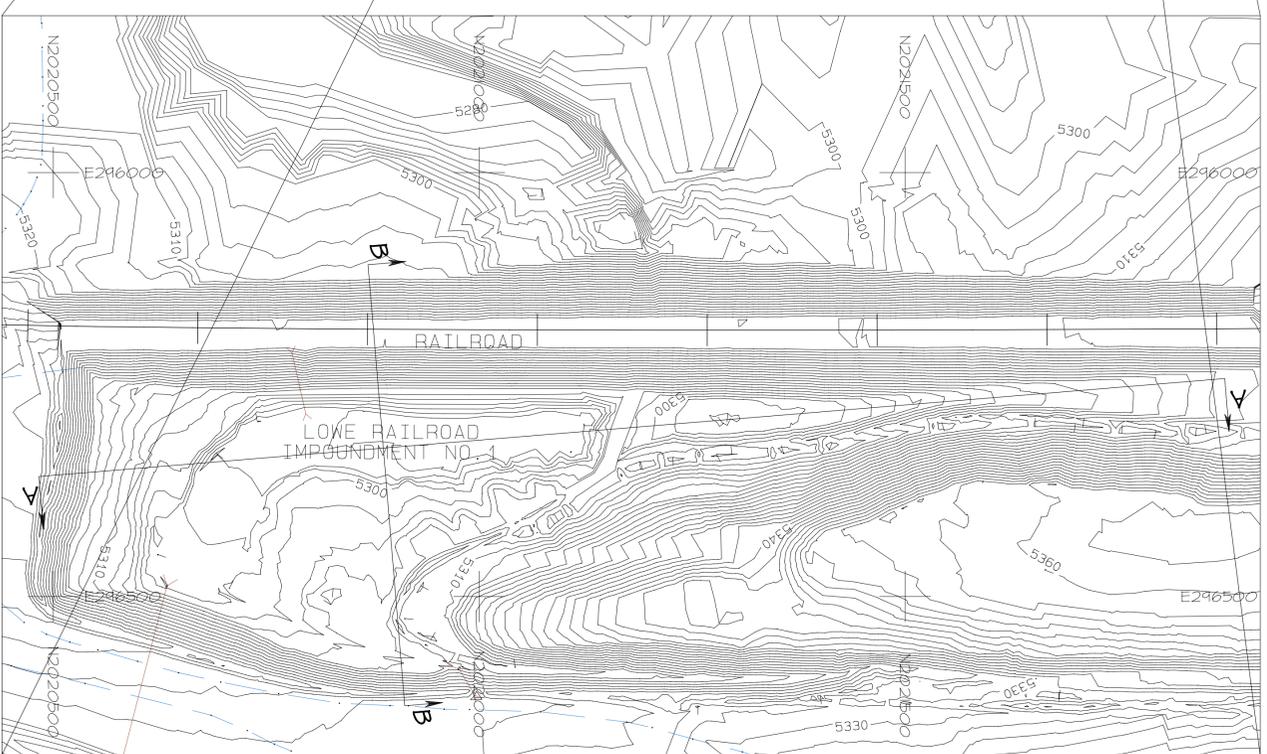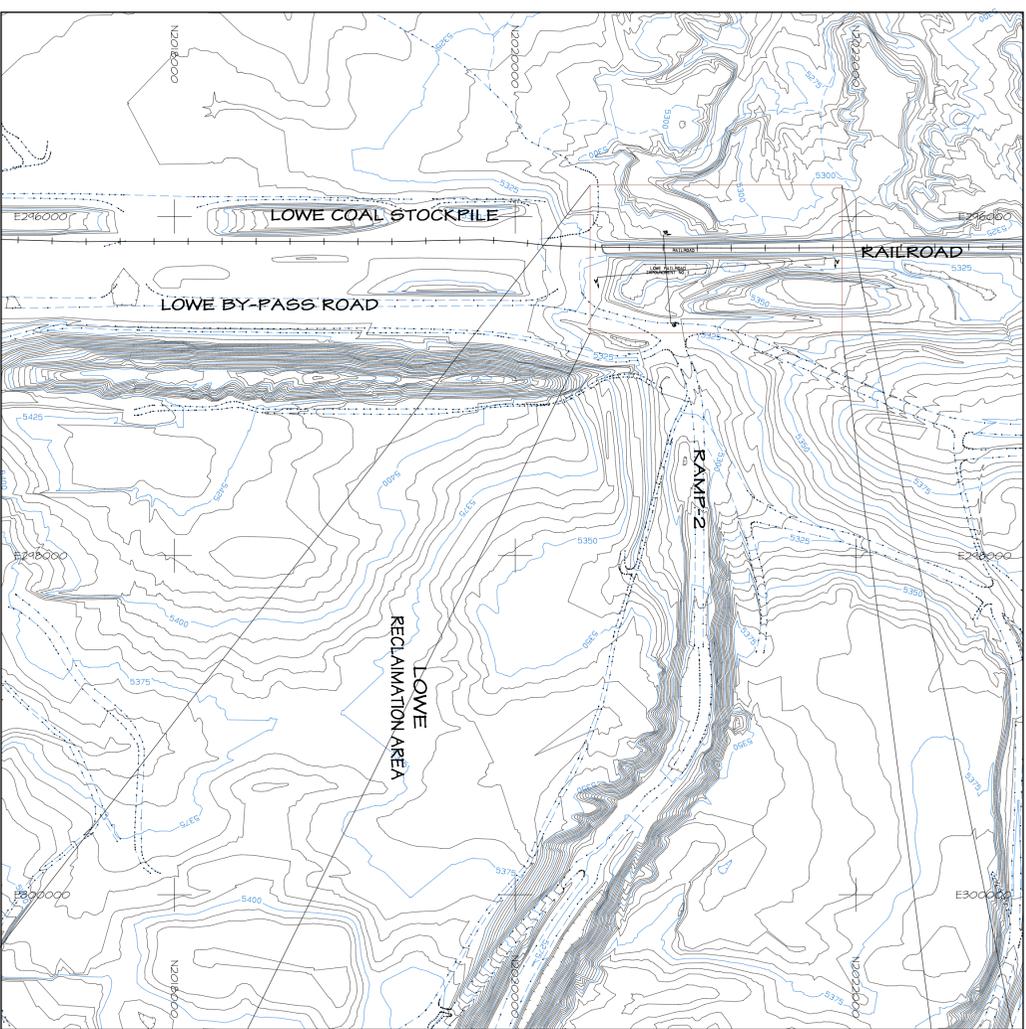

**STAGE STORAGE DATA**




ELEV feet	AREA acres	VOL. LIME ac-ft	CUM. VOL. LIME ac-ft
5293	0.00	0.00	0.00
5294	0.33	0.17	0.17
5295	0.95	0.44	0.60
5296	0.68	0.51	1.22
5297	0.86	0.77	1.96
5298	1.06	0.96	2.95
5299	1.28	1.17	4.12
5300	1.51	1.39	5.52
5301	1.75	1.63	7.15
5302	1.99	1.87	9.01
5303	2.23	2.11	11.22
5304	2.49	2.36	13.48
5305	2.89	2.69	16.16
5306	3.19	3.04	19.20 (a)
5307	3.51	3.35	22.76
5308	3.77	3.64	26.19
5310	4.27	8.04	34.23
5312	4.69	8.95	43.19
5314	5.05	9.74	52.93
5316	5.43	10.48	63.41
5318	5.80	11.22	74.62
5320	6.16	11.84	86.57 (a)
5322	6.55	12.69	99.26 (a)

(a) STAGE STAGE FROM STATION ABOVE (ELEV. 100' TO 6' IN 10').  
(b) MAXIMUM IMPOUNDMENT CAPACITY.

**LEGEND**

- ROAD
- WATERSHED
- BUILDING
- FENCE
- IRRIGATION LINE
- CULVERT
- DAW
- DRAINAGE
- RAILROAD
- TREES
- POWERLINE
- SPOT ELEVATION
- INDEX CONTOUR
- INTERMEDIATE CONTOUR
- LEASE CORNER
- PERMIT/LEASE BOUNDARY

- NOTES**
- For hydrology and design information refer to Appendix 11-A in the approved plan.
  - The watershed areas for Impoundment and pond locations are shown on Exhibit 11-13E, Table 11-50.
  - For Impoundment information refer to Table 11-50.

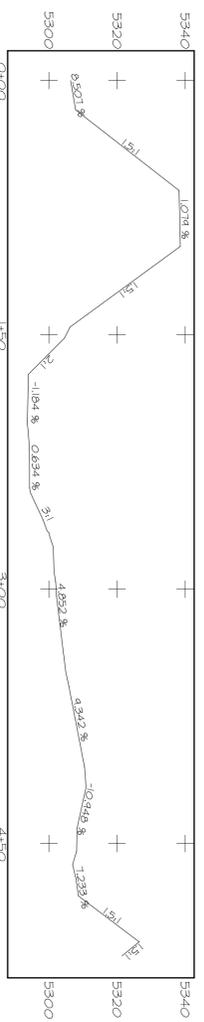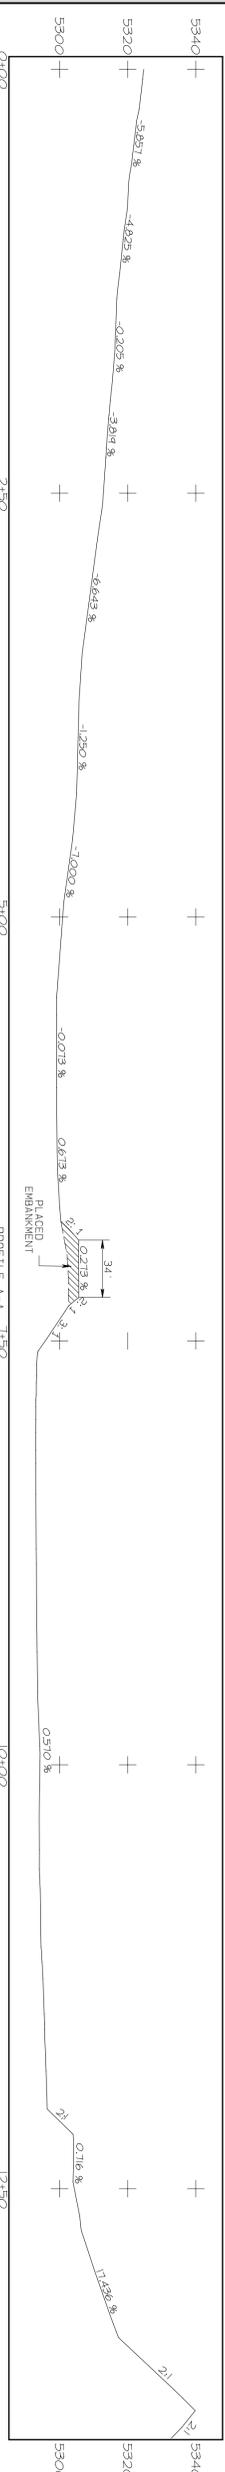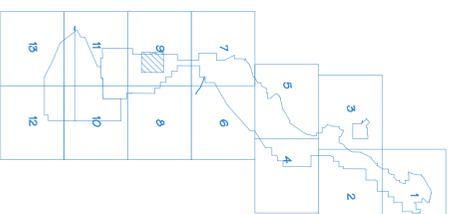

**CERTIFICATION STATEMENT**

I, Ron C. VAN VALKENBURG, hereby certify that this drawing was reviewed by me and that the information shown is complete and accurate to the best of my knowledge.



**PLAN, PROFILE AND SECTION**

ACCOUNT: \_\_\_\_\_  
 DATE: 6-18-08  
 DESIGNED BY: SS  
 DRAWN BY: AS  
 CHECKED BY: RCV  
 APPROVED BY: RCV


**BHP NAVAJO COAL CO.**  
**NAVAJO MINE**  
 PO BOX 1717, FRUITLAND, NEW MEXICO, 87416

REV	DATE	DESCRIPTION
1	7-9-08	REV BY
2		APPROVED FOR CONSTRUCTION
3		SUBMITTED TO NEW MEXICO FOR REVIEW
4		
5		


**EXHIBIT 26-14**  
**LOWE RAILROAD**  
**IMPOUNDMENT NO. 1**  
**AS-BUILT**

SHEET 1  
 OF 1




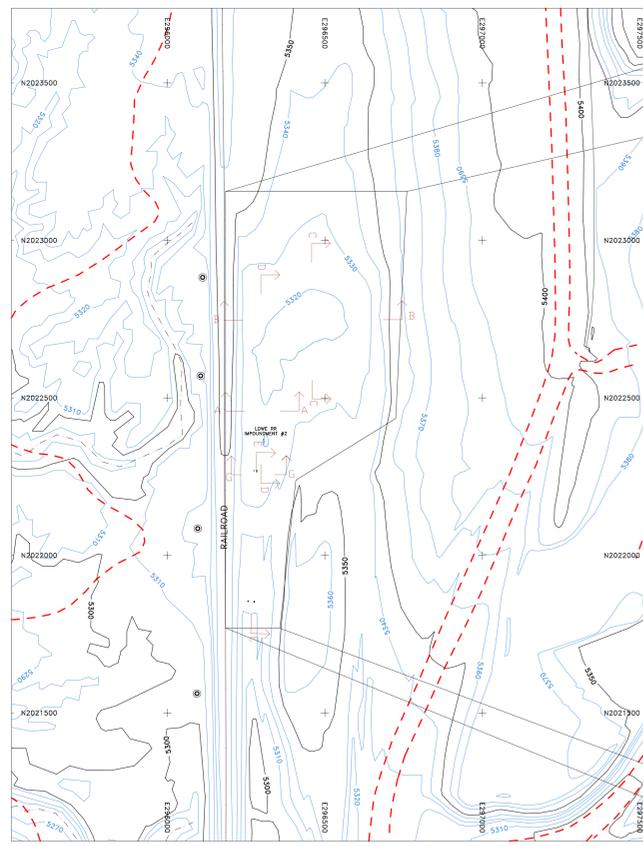


LOCATION MAP  
Scale: 1" = 200'

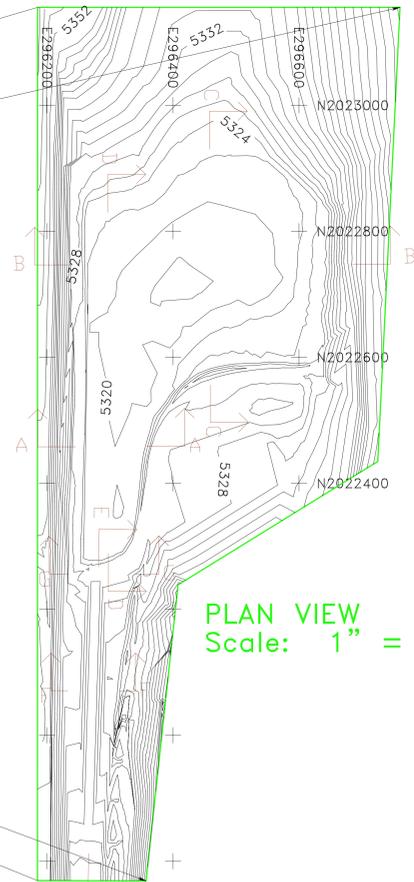


PLAN VIEW  
Scale: 1" = 100'

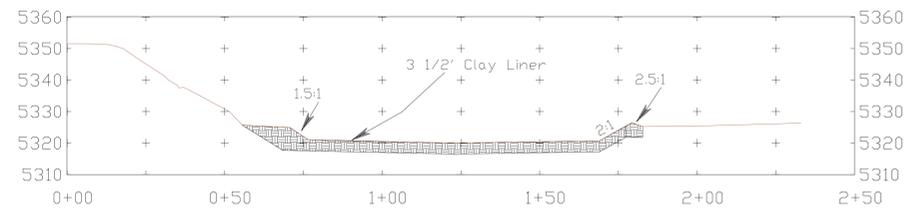


Section A

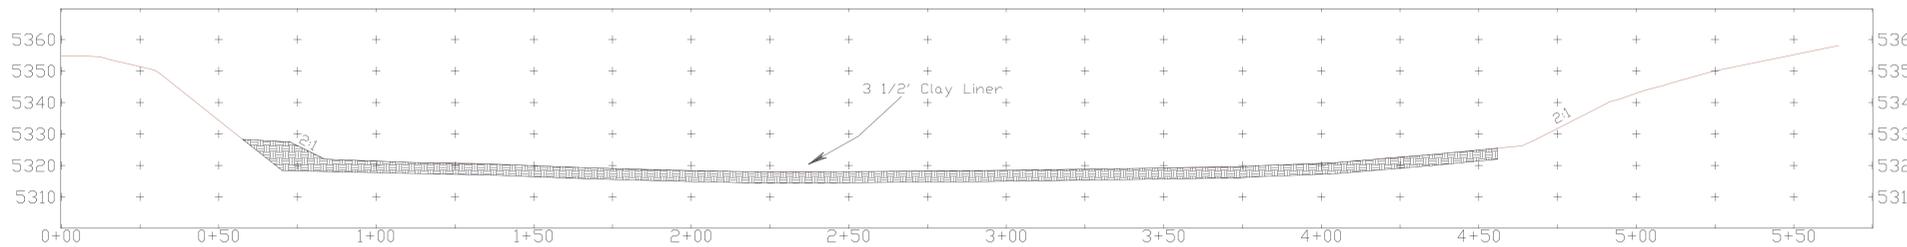

Section B

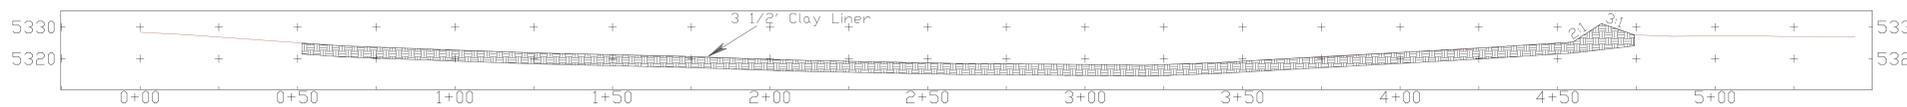

Section C

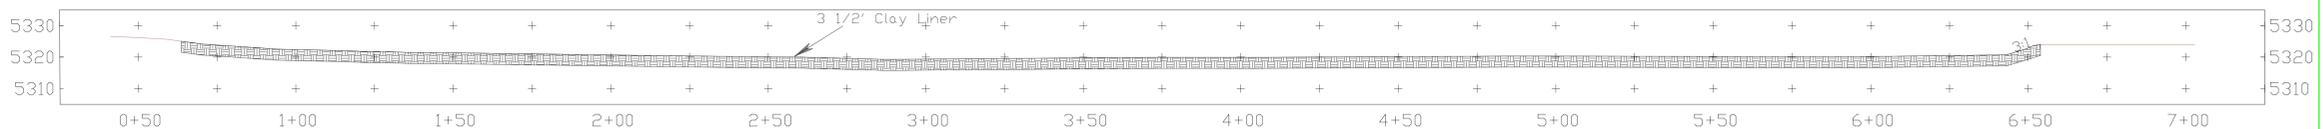


Section D



Section E



Section F

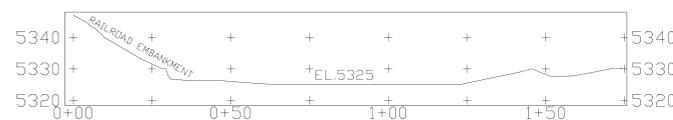

Section G

CROSS SECTIONS  
Horiz. Scale: 1" = 20'  
Vert. Scale: 1" = 20'

LEGEND


- HAUL ROAD
- - - - - TRAIL
- FENCE
- IRRIGATION LINE
- CULVERT
- DAM
- DRAINAGE
- RAILROAD
- POWERLINE
- INDEX CONTOUR
- INTERMEDIATE CONTOUR

NOTES

1. For hydrology information refer to Appendix 11-4 in the approved PAP.
2. For watershed information refer to Exhibit 11-13E in the approved PAP.
3. TOPOGRAPHY BASED ON SURVEY DATED JANUARY 26, 1998.
4. THIS IMPOUNDMENT IS DESIGNED TO CONTAIN 100 YEAR HR STORM EVENT THEREFORE NO SPILLWAY REQUIRED.

STAGE STORAGE DATA

ELEV. FEET	AREA ACRES	VOLUME ac-ft	CUM. VOLUME ac-ft
5318	0.095	0.000	0.000
5319	0.423	0.261	0.261
5320	1.143	0.769	1.049
5321	2.115	1.639	2.689
5322	2.625	2.386	5.075
5323	3.000	2.833	7.908
5324	3.358	3.202	11.110
5325	3.650	3.504	14.614

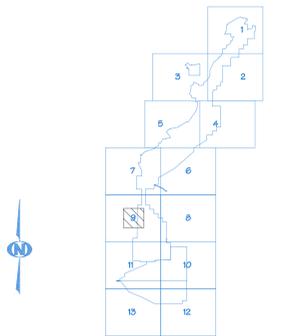

CERTIFICATION STATEMENT

I, Ron C. VAN VALKENBURG, hereby certify that this drawing was reviewed by me and that the information shown is complete and accurate to the best of my knowledge.



REV. NO.	DATE	BY	REVISION DESCRIPTION	ENG. E.S. P.E. P.S. APPROPRIATE
00A	02/08/08	SMITH	REVISED SPILLWAY OF ROAD, REVISIONS TO CROSS SECTION E, NOTES TO BE ADDED AND REVISIONS TO BE SUBMITTED TO DSM FOR APPROVAL.	
B	01/26/08	FTJ	CHANGED EXH. 11-67B TO 11-67A.	
A	05/27/97	VAH	SUBMITTED TO DSM FOR APPROVAL.	

EXHIBIT 26-15

NAVAJO COAL COMPANY




AREA 3

LOWE RAILROAD IMPOUNDMENT #2

PREPARED BY VAH DRAWN BY VAH SCALE AS NOTED  
APPROVED BY LR DATE 05/27/97 REF DWG EX. 11-67  
DWG LOC J:\05M\_SUBM\PER\_PROG\CH\_11\11-67\EXHIBITS\11-67A.PRO



LOCATION MAP  
Scale: 1" = 200'

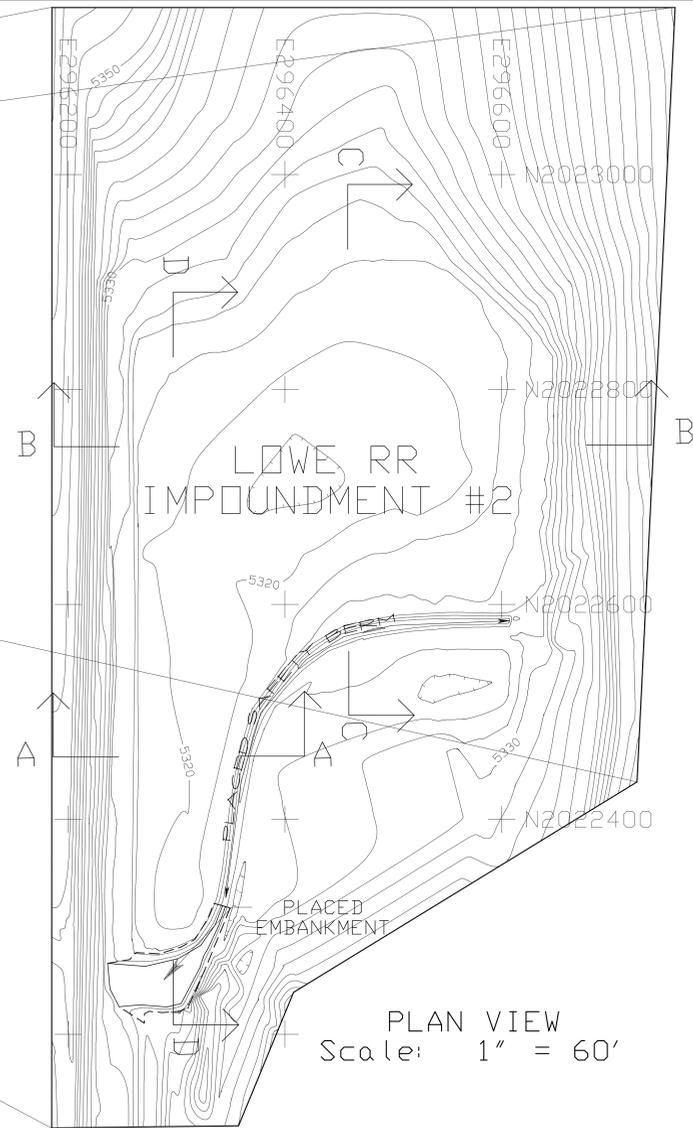

PLAN VIEW  
Scale: 1" = 60'


**LEGEND**

- HAUL ROAD
- - - TRAIL
- XXX FENCE
- IRRIGATION LINE
- CULVERT
- DAM
- DRAINAGE
- RAILROAD
- POWERLINE
- 5300 INDEX CONTOUR
- 5298 INTERMEDIATE CONTOUR


- NOTES**
- For hydrology information refer to Appendix 11-AA in the approved PAP.
  - For watershed information refer to Exhibit 11-13E in the approved PAP.
  - For impoundment and dike/elevation information refer to Table 11-5R.
  - Gauge Post base elevation 5318.0 (GPS)

**STAGE STORAGE DATA**


ELEV. feet	AREA acres	VOLUME ac-ft	CUM. VOLUME ac-ft
5318	0.092	0.000	0.000
5319	0.405	0.248	0.248
5320	1.299	0.852	1.100
5321	2.092	1.695	2.796
5322	2.598	2.345	5.141
5323	2.977	2.788	7.929
5324	3.338	3.155	11.083
5325	3.651	3.488	14.571
5326	3.958	3.797	18.368

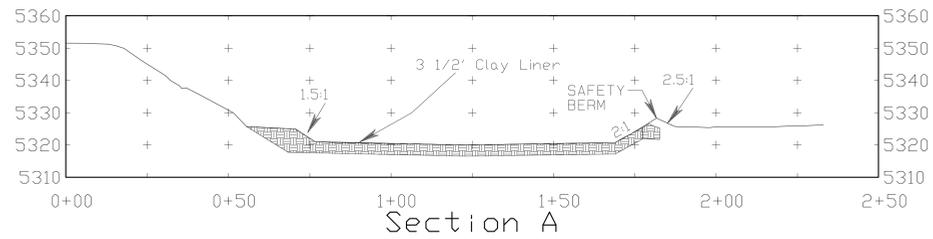


Section A

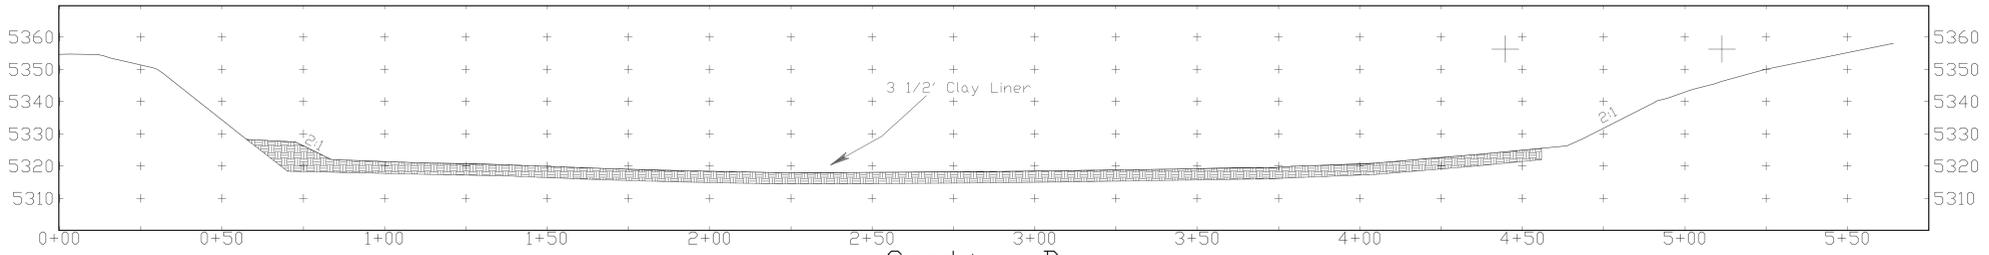

Section B

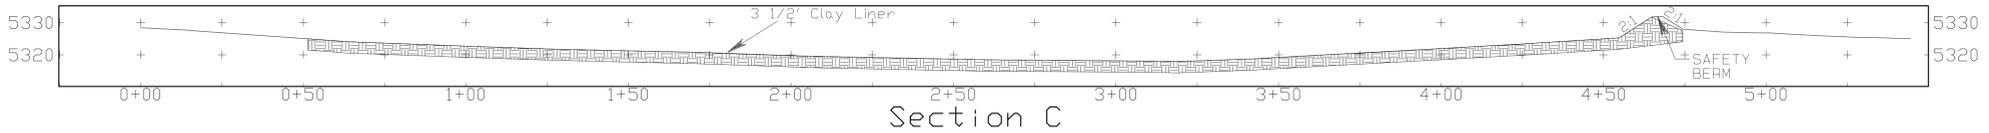


Section C

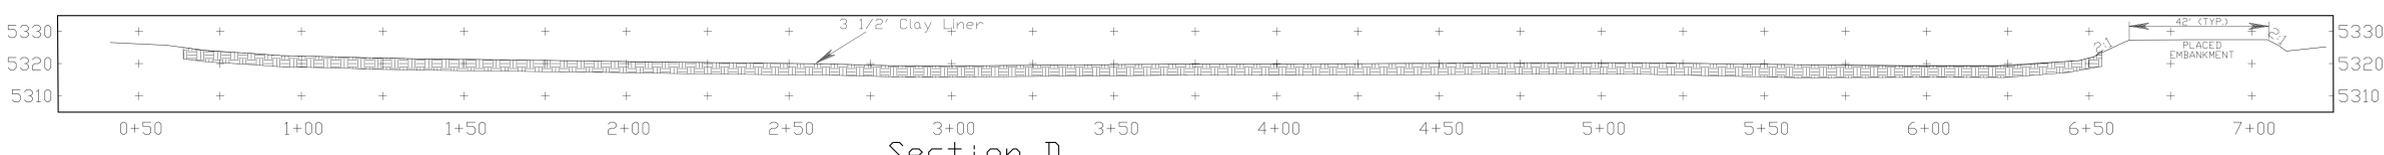

Section D

CROSS SECTIONS  
Horiz. Scale: 1" = 20'  
Vert. Scale: 1" = 20'

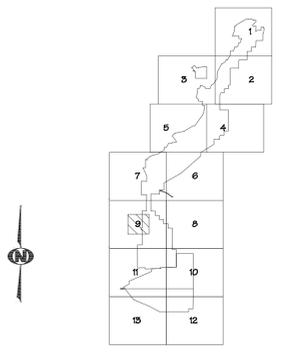

**CERTIFICATION STATEMENT**  
I, Ron C. VAN VALKENBURG, hereby certify that this drawing was reviewed by me and that the information shown is complete and accurate to the best of my knowledge.




08/06/2/08	RY	UPDATED AS-BUILT TO CURRENT	SS	YB	RCV	BN	RF
05/27/97	VAH	SUBMITTED TO OSM FOR REVIEW					
REV	DATE	DRAWN BY	REVISION DESCRIPTION	ENG.	E.G.	R.C.	J.P.S.

EXHIBIT 26-15  
**NAVAJO COAL COMPANY**  
NAVAJO MINE  
P.O. BOX 155 FRUITLAND, NEW MEXICO 87415  
**AREA 3**  
**LOWE RAILROAD IMPOUNDMENT #2**  
**AS - BUILT**  
PREPARED BY FTJ DRAWN BY FTJ SCALE AS NOTED  
APPROVED BY RCV DATE Thu Mar 24 2011 REF Dwg EXH. 11-67A  
DNG LOC G:\GS\Permit\F\Ch 11\Exh 11-067\_Lowe-Railroad Imp 1-2\A



- LEGEND**
- ROAD
  - WATERSHED
  - BUILDING
  - FENCE
  - IRRIGATION LINE
  - CULVERT
  - DAM
  - DRAINAGE
  - RAILROAD
  - TREES
  - POWERLINE
  - SPOT ELEVATION
  - INDEX CONTOUR
  - INTERMEDIATE CONTOUR
  - LEASE CORNER
  - PERMIT/LEASE BOUNDARY

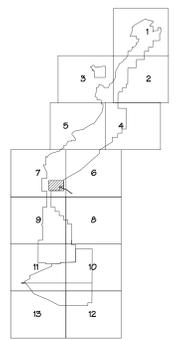

**CERTIFICATION STATEMENT**  
 I, Leonard Raymond, hereby certify that this drawing was reviewed by me and that the information shown is accurate and complete to the best of my knowledge.



REV.	DATE	BY	REVISION DESCRIPTION	PREP.	CHECK.	DATE
B	6-01-01	PJF	SUBMITTED TO DSM FOR REVIEW AND APPROVAL.	LR	MC	LR
A	2-9-01	PJF	SUBMITTED TO DSM FOR REVIEW AND APPROVAL. DRAFT	LR	MC	LR

**EXHIBIT 26-16**  
**BHP NAVAJO COAL COMPANY**  
  
 P. O. BOX 155 FRUITLAND, NEW MEXICO 87416

**NORTH FORK DIVERSION CHANNEL  
 LOCATION AND PIT LAYOUT MAP**

PREPARED BY PJF DRAWN BY PJFOSTER SCALE : 1" = 500'  
 APPROVED BY LR DATE 11-10-00




STA. 29+30 TO 29+50 TRANSITION  
FROM 1.5:1 SIDE SLOPE TO  
3:1 SIDE SLOPE

STA. 29+85 CONSTRUCT RIPRAP  
DOWNDRAIN FOR SIDE DRAINAGE

STA. 29+30 TO 29+50 TRANSITION  
FROM 1.5:1 SIDE SLOPE TO  
2:1 SIDE SLOPE

STA. 21+30 TO 31+50 TRANSITION  
FROM 2:1 SIDE SLOPE TO  
3:1 SIDE SLOPE

PLAN VIEW  
Horz. Scale: 1" = 100'

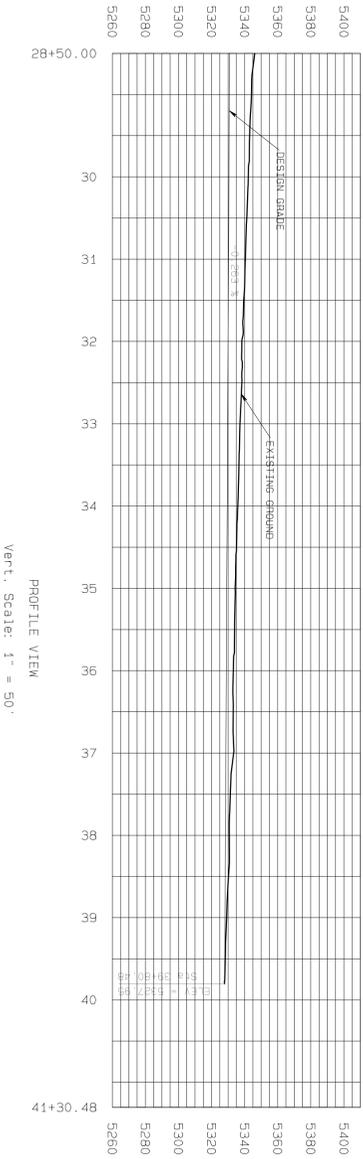

PROFILE VIEW  
Vert. Scale: 1" = 50'

NOTE:










- FOR SUPPORTING DESIGN DATA REFER TO APPENDIX 11-QQ IN THE P&P.
- THE PLACEMENT OF THE EXCESS CUT MATERIAL OR WASTE IS NOT SHOWN IN THE PLAN VIEW. IT WILL BE PLACED ALONG THE WEST BANK OF THE DIVERSION CHANNEL DURING THE REMOVAL AND RECLAMATION OF THE DIVERSION CHANNEL. EXCESS CUT MATERIAL WILL BE USED TO BACKFILL THE DIVERSION CHANNEL TO THE ORIGINAL GRADE. REFER TO THE TYPICAL SECTIONS FOR PLACEMENT OF THE EXCESS CUT MATERIAL.

RIPPAPPED DOWNDRAIN SCHEDULE

LOCATION	L (ft)	S (%)	W (ft)	H (ft)	T (ft)	Down ROCK SIZE (IN)
1+55	55	15.0	4.0	1.5	1.0	9
3+50	50	15.0	6.0	1.5	1.0	9
3+80	40	20.0	4.0	1.5	1.0	9
7+30	60	15.0	5.0	1.5	1.0	9
9+82	85	20.0	4.0	1.5	1.0	9
20+80	40	15.0	5.0	1.5	1.0	9
29+95	55	15.0	2.0	1.5	1.0	9
29+95	75	15.0	5.0	1.5	1.0	9

CERTIFICATION STATEMENT

I, Leonard Raymond, hereby certify that this drawing was reviewed by me and that the information shown is accurate and complete to the best of my knowledge.

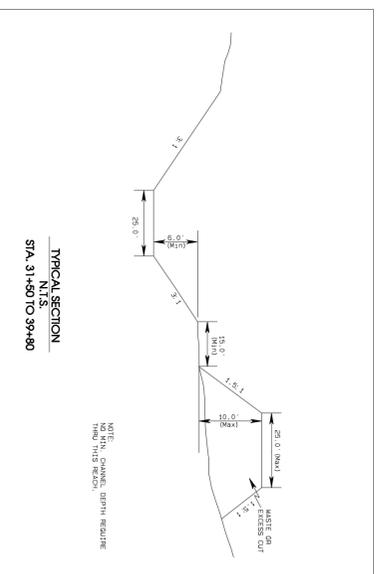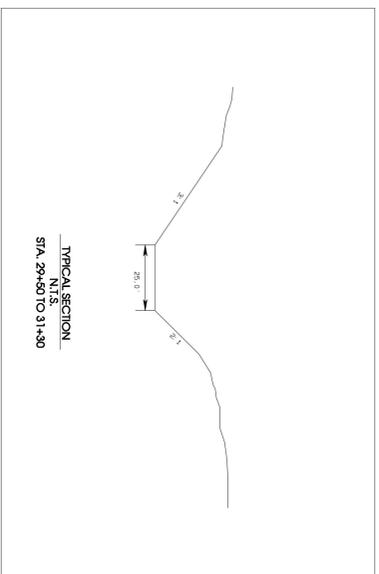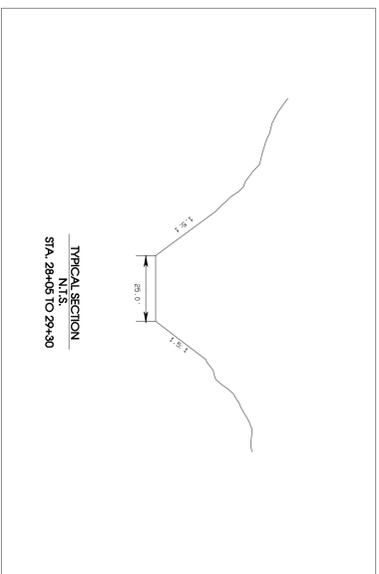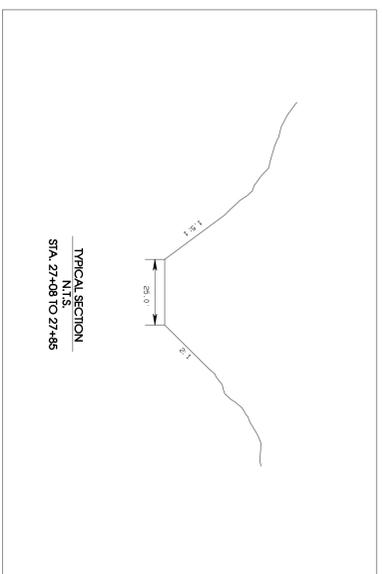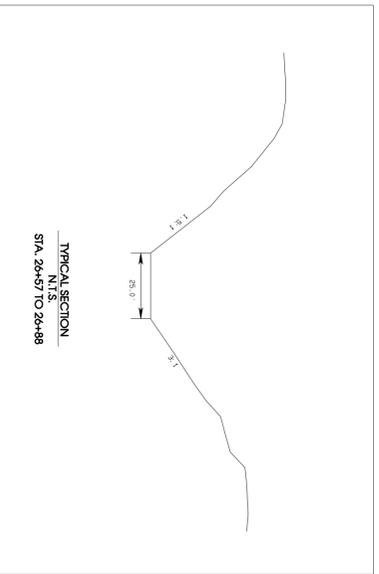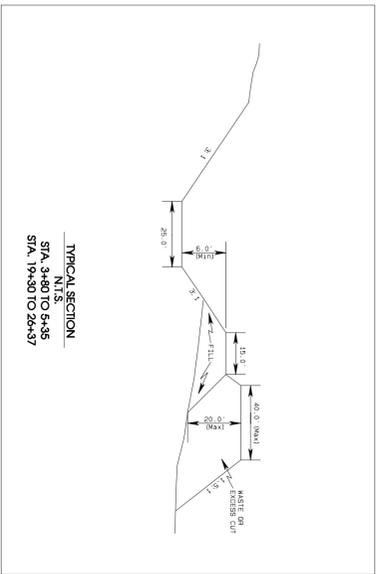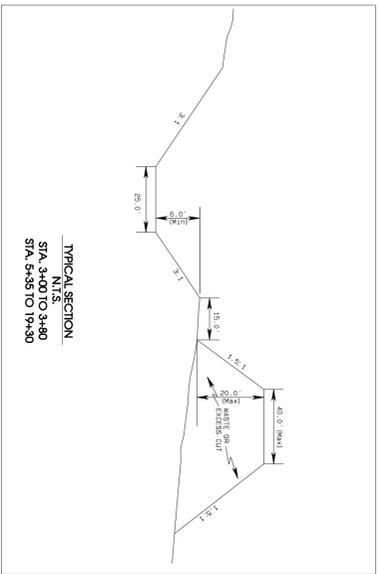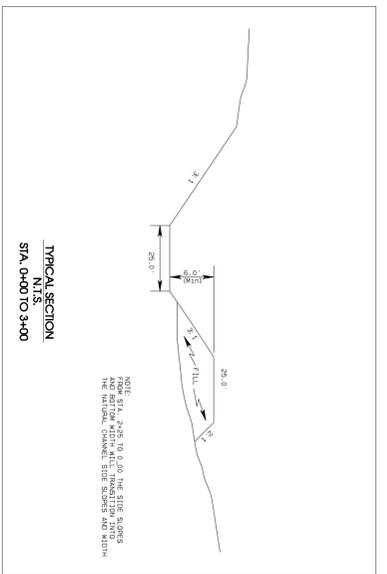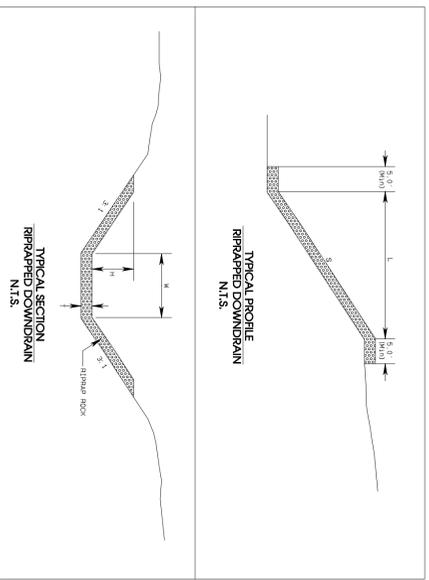

REV	NO.	DESCRIPTION	REV	DATE
1	1	SUBMITTED TO O&M FOR REVIEW AND APPROVAL (DMF1)	PJF	2-09-01
2	2	SUBMITTED TO O&M FOR REVIEW AND APPROVAL	PJF	6-01-01
3	3			
4	4			
5	5			

**BHP NAVAJO COAL CO.**  
**NAVAJO MINE**


PO BOX 1717, FRUITLAND, NEW MEXICO, 87416

ACCOUNT: N1675  
DATE: Nov. 10, 2000  
DESIGNED BY: PUFOSTER  
DRAWN BY: PUFOSTER  
CHECKED BY: LRAYMOND  
APPROVED BY: LRAYMOND


**PLAN, PROFILE  
AND SECTIONS**

**EXHIBIT 26-17  
NORTH FORK  
DIVERSION CHANNEL**

DRAWING: P/P-2  
SHEET: 02 OF 2

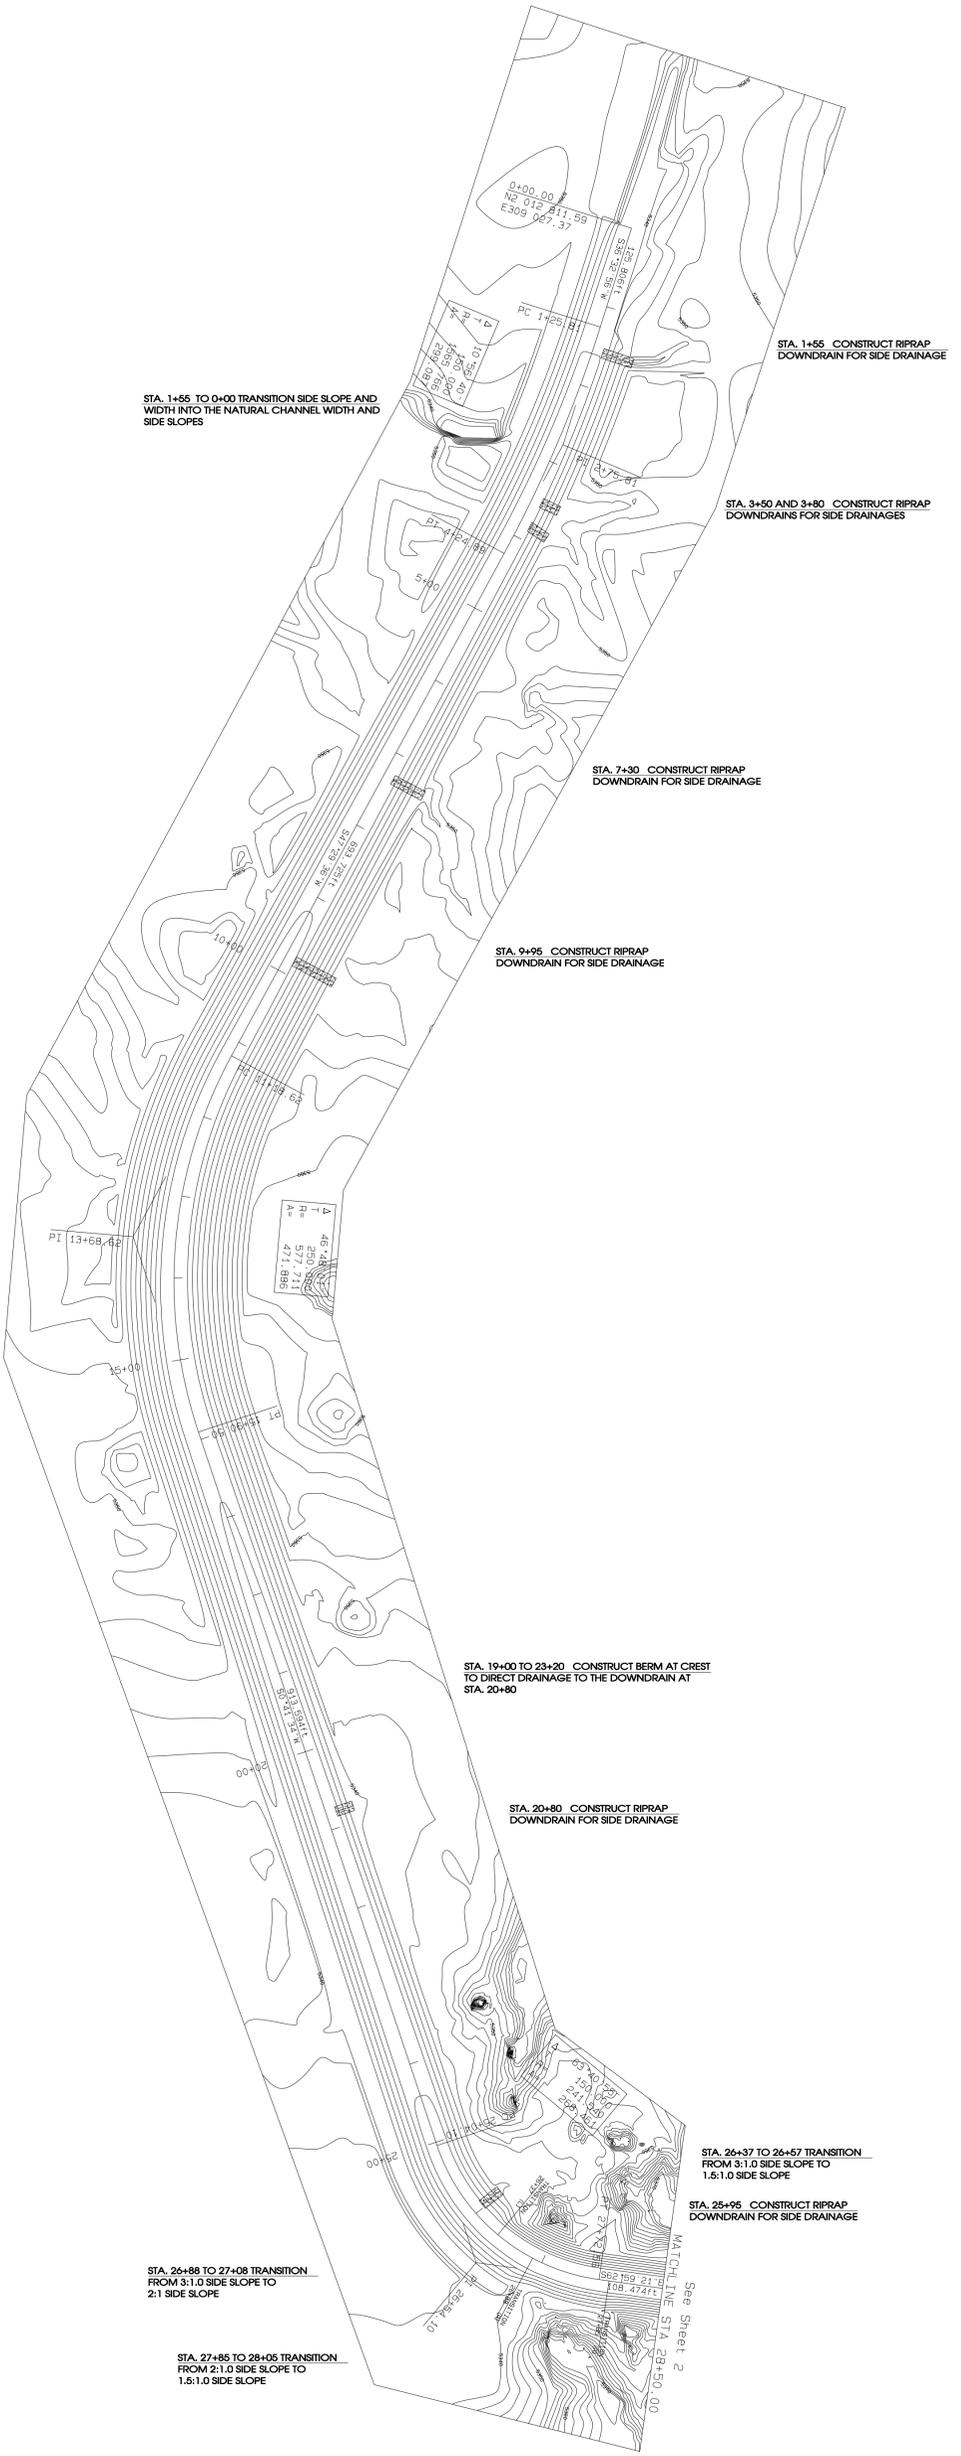

PLAN VIEW  
 Horiz. Scale: 1" = 100'

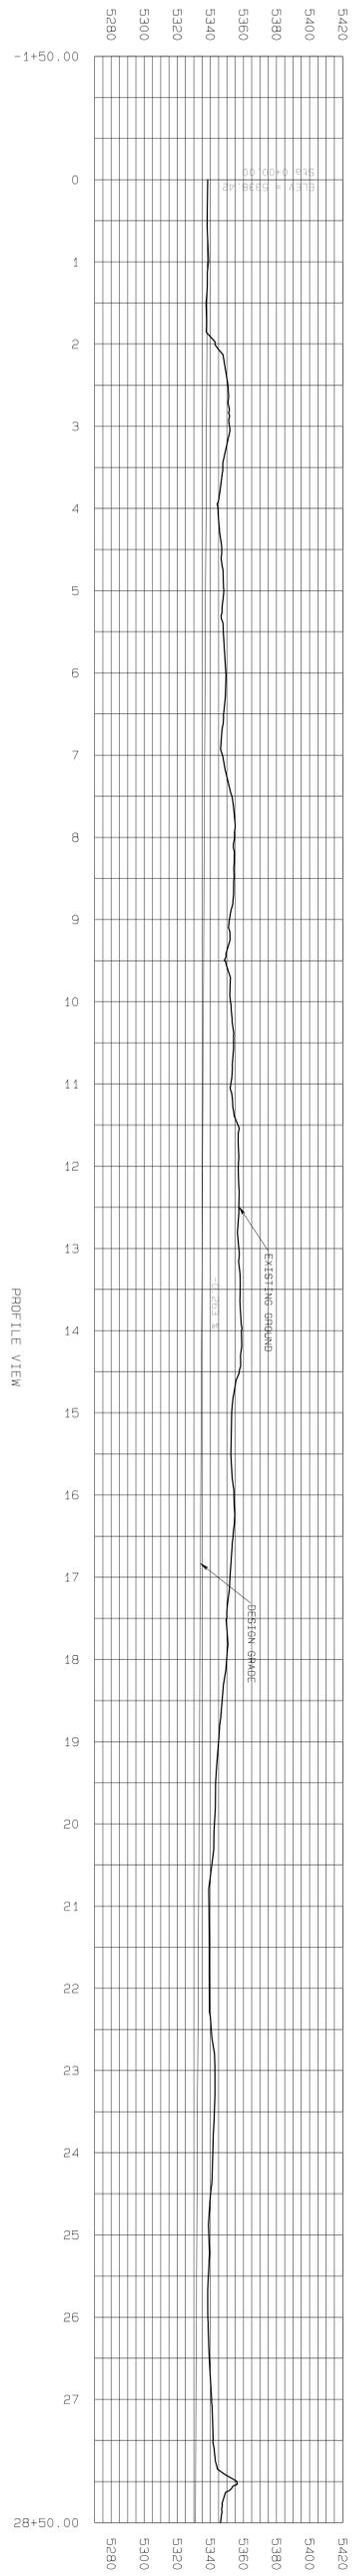

PROFILE VIEW  
 Vert. Scale: 1" = 50'

- NOTE:
1. FOR SUPPLEMENTING DESIGN DATA REFER TO APPENDIX 11-100 IN THE PMP
  2. FOR TYPICAL CHANNEL SECTIONS REFER TO EXHIBIT 11-142C.
  3. THE PLACEMENT OF THE EXCESS CUT MATERIAL OR WASTE IS NOT SHOWN IN THE PLAN VIEW. IT WILL BE PLACED ALONG THE WEST BANK OF THE DIVERSION CHANNEL. DURING THE REMOVAL USED TO BACKFILL DIVERSION REFER TO EXCESS CUT MATERIAL ON EXHIBIT 11-142C FOR PLACEMENT OF THE EXCESS CUT MATERIAL.
  4. THE RIPRAPPED DOWNDRAIN SCHEDULE IS ON EXHIBIT 11-142C.

**CERTIFICATION STATEMENT**

I, Leonard Raymond, hereby certify that this drawing was reviewed by me and that the information shown is accurate and complete to the best of my knowledge.



ACCOUNT: N1675  
 DATE: Nov. 10, 2000  
 DESIGNED BY: P.J.FOSTER  
 DRAWN BY: P.J.FOSTER  
 CHECKED BY: LRAYMOND  
 APPROVED BY: LRAYMOND


**BHP NAVAJO COAL CO.**  
**NAVAJO MINE**  
 PO BOX 1717, FRUITLAND, NEW MEXICO, 87416

REV	DESCRIPTION	REV	DATE
1	SUBMITTED TO OSM FOR REVIEW AND APPROVAL (DRAFT)	1	2-09-01
2	SUBMITTED TO OSM FOR REVIEW AND APPROVAL	2	6-01-01
3			
4			
5			

**EXHIBIT 26-17**  
**NORTH FORK**  
**DIVERSION CHANNEL**

**PLAN, PROFILE**  
**AND SECTIONS**

DRAWING:  
 P/P-1  
 SHEET 2  
 OF 1

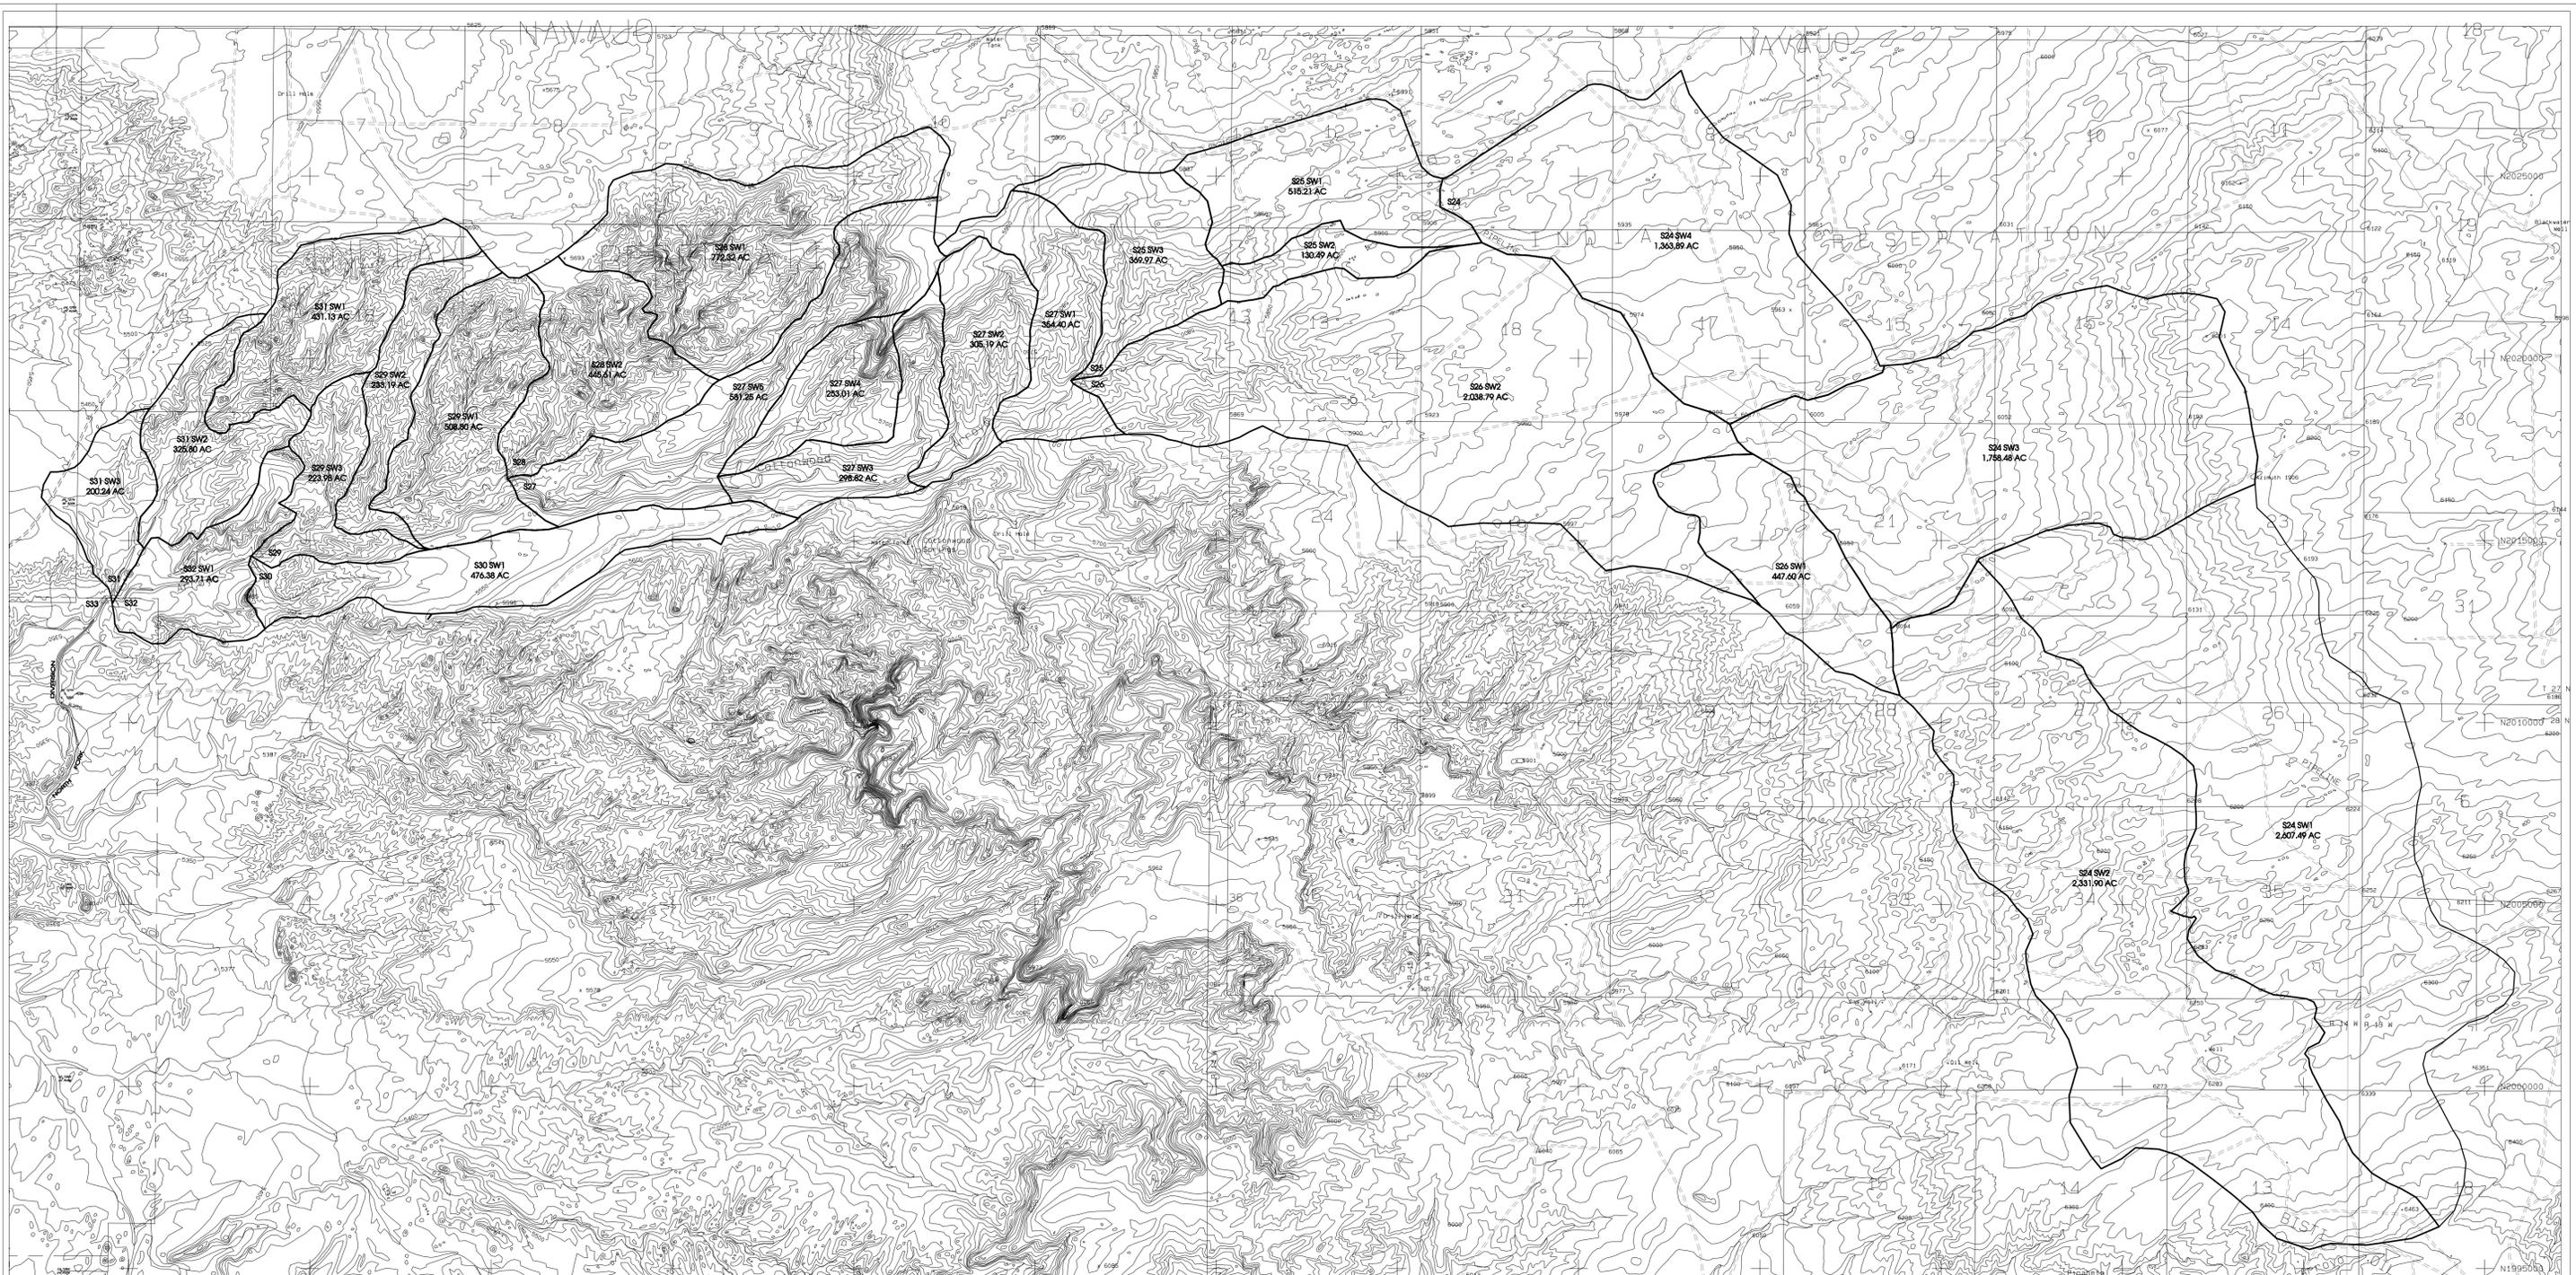


**NOTES**

1. For hydrology and design information refer to Appendix 11-00 in the approved PAP.

**LEGEND**

- ROAD
- WATERSHED
- BUILDING
- FENCE
- IRRIGATION LINE
- CULVERT
- DAM
- DRAINAGE
- RAILROAD
- TREES
- POWERLINE
- SPOT ELEVATION
- INDEX CONTOUR
- INTERMEDIATE CONTOUR
- LEASE CORNER
- LEASE/PERMIT BOUNDARY

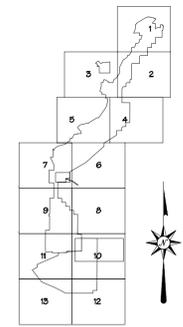

**CERTIFICATION STATEMENT**





I, Leonard Raymond, hereby certify that this drawing was reviewed by me and that the information shown is accurate and complete to the best of my knowledge.



B	6-01-01	PJF	SUBMITTED TO OSM FOR REVIEW AND APPROVAL.	LR	MC	LR
A	2-09-01	PJF	SUBMITTED TO OSM FOR REVIEW AND APPROVAL. (DRAFT)	LR	MC	LR
REV. NO.	DATE	DRAWN BY	REVISION DESCRIPTION	SCALE	D.T.S.	APPROVED BY

**EXHIBIT 26-18**  
**BHP NAVAJO COAL COMPANY**  
 NAVAJO MINE  
 P.O. BOX 155 FRUITLAND, NEW MEXICO 87416  
**NORTH FORK DIVERSION CHANNEL**  
**SEDCAD WATERSHED SUBDIVISIONS**

PREPARED BY PJF	DRAWN BY PJF	SCALE 1"= 2000'
APPROVED BY LR	DATE 11/08/00	

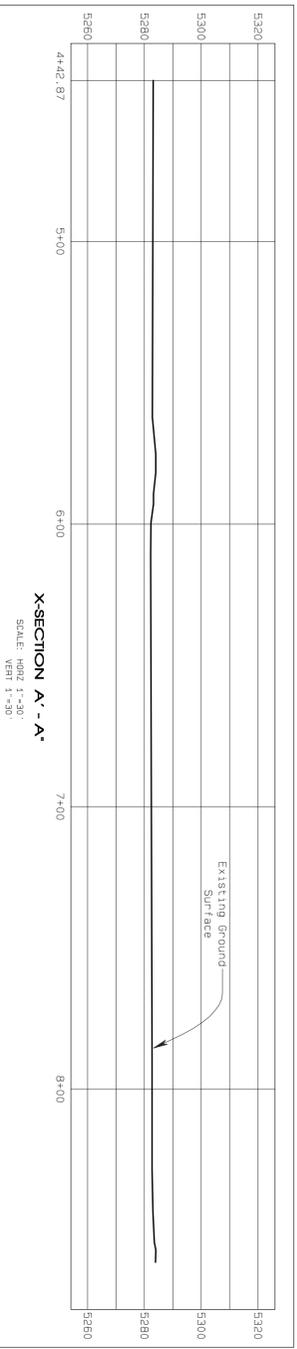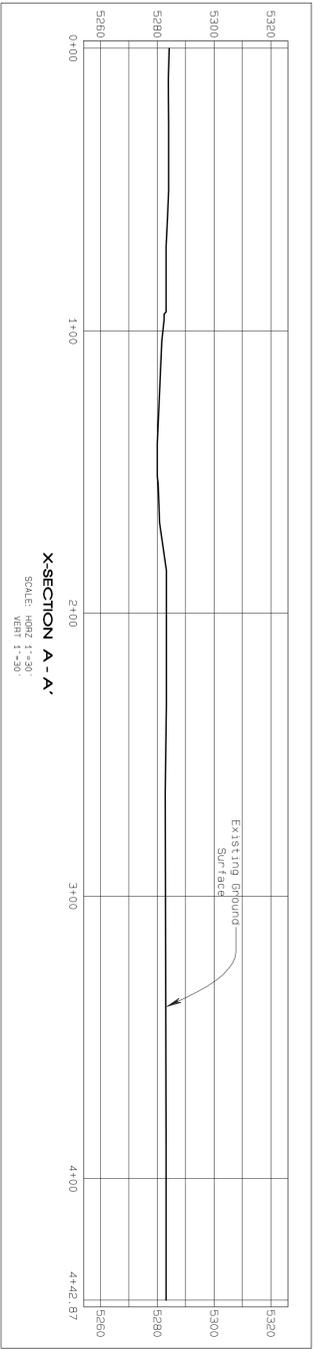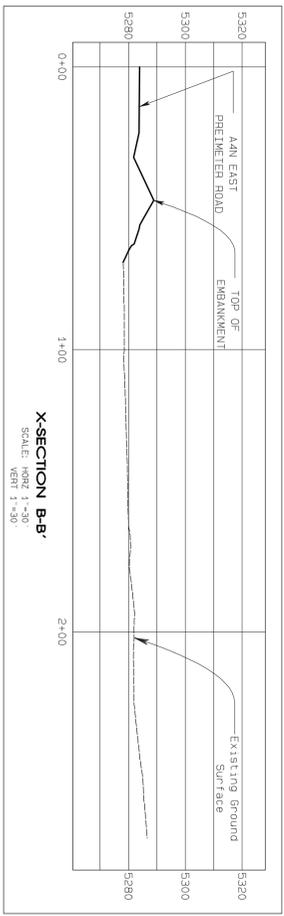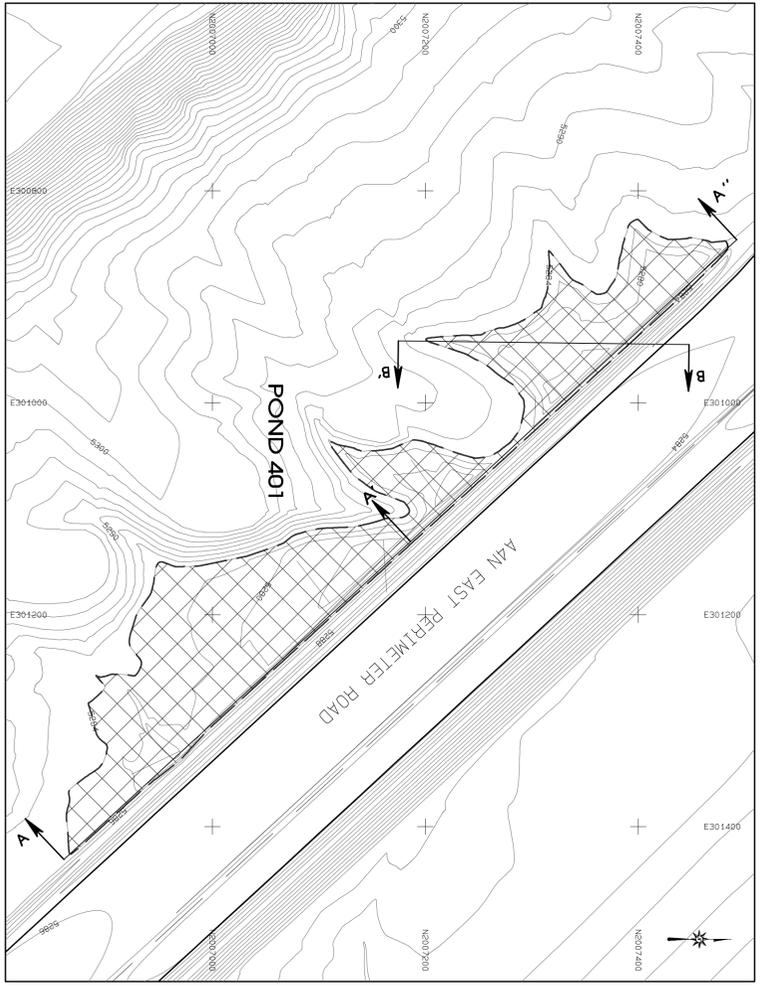

**LEGEND**


[Symbol]	ROAD
[Symbol]	BUILDING
[Symbol]	FENCE
[Symbol]	CULVERT
[Symbol]	DRAINAGE
[Symbol]	POWER LINE
[Symbol]	INDEX CONTOUR
[Symbol]	INTERMEDIATE CONTOUR
[Symbol]	PERMIT/LEASE BOUNDARY

**NOTES**

- For location of drainage control structures and waterheads, refer to Exhibit 11-13F.
- The hydrology and supporting design data for the Pond 401 are referenced on Page 4-5 of the NW map.

**STAGE STORAGE DATA**

ELEV feet	AREA acres	VOLUME bc-ft	CUM. VOLUME bc-ft
5274	0.046	0.00	0.00
5276	0.199	0.20	0.20
5278	0.471	0.70	0.90
5280	0.949	1.40	2.30
5282	1.237	2.20	4.50

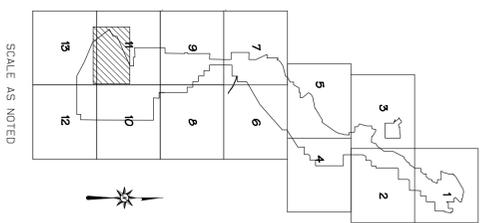

**CERTIFICATION STATEMENT**

I, Ron C. Van Valkenburg, hereby certify that this drawing was reviewed by me and that the information shown is complete and accurate to the best of my knowledge.



**bhpbilliton**  
**NAVAJO COAL COMPANY**  
**NAVAJO MINE**

PROJECT MANAGER: F. GORMAN  
ENGR. of RECORD: RON C. VAN VALKENBURG  
REG. NO: NM 9263  
DRAWN BY: PJFOSTER  
CHECKED BY: RCY  
APPROVED BY: RCY



REVISION	DATE
09-41 UPDATED WITH DEVELOPMENT AND SUBMITTED TO COM FOR REVIEW	8/28/09
11-41 PERMITS AND APPROVALS	FEB-2011

**EXHIBIT 26-19**  
**AREA 4 NORTH**  
**POND 401**  
**Design**


**PLAN, PROFILE AND SECTION**

PROJECT: A4N  
DATE: AUG. 8, 2009  
DESIGNED BY: RCY  
DRAWN BY: PJFOSTER  
CHECKED BY: RCY  
APPROVED BY: RCY

DRAWING  
SHEET  
OF 0

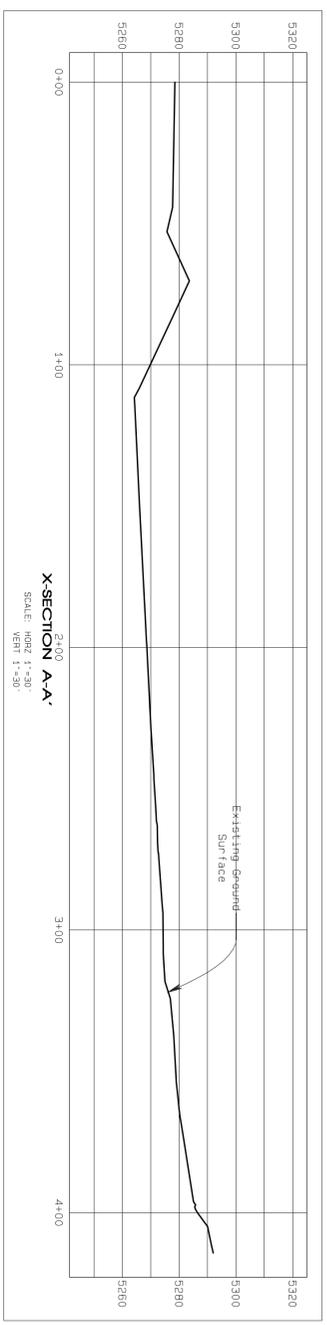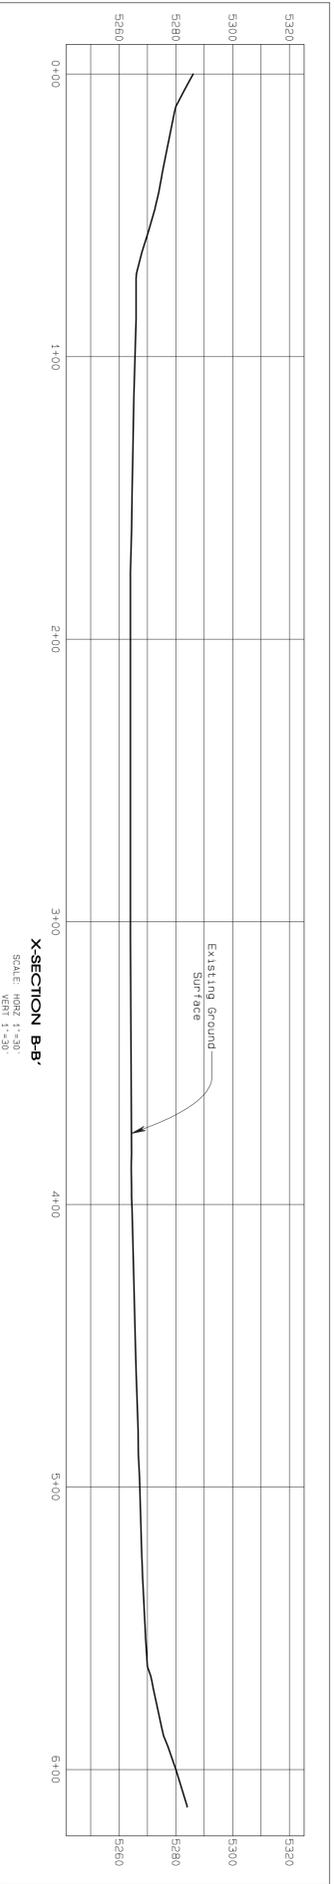

**PLAN VIEW**  
SCALE: 1"=80'

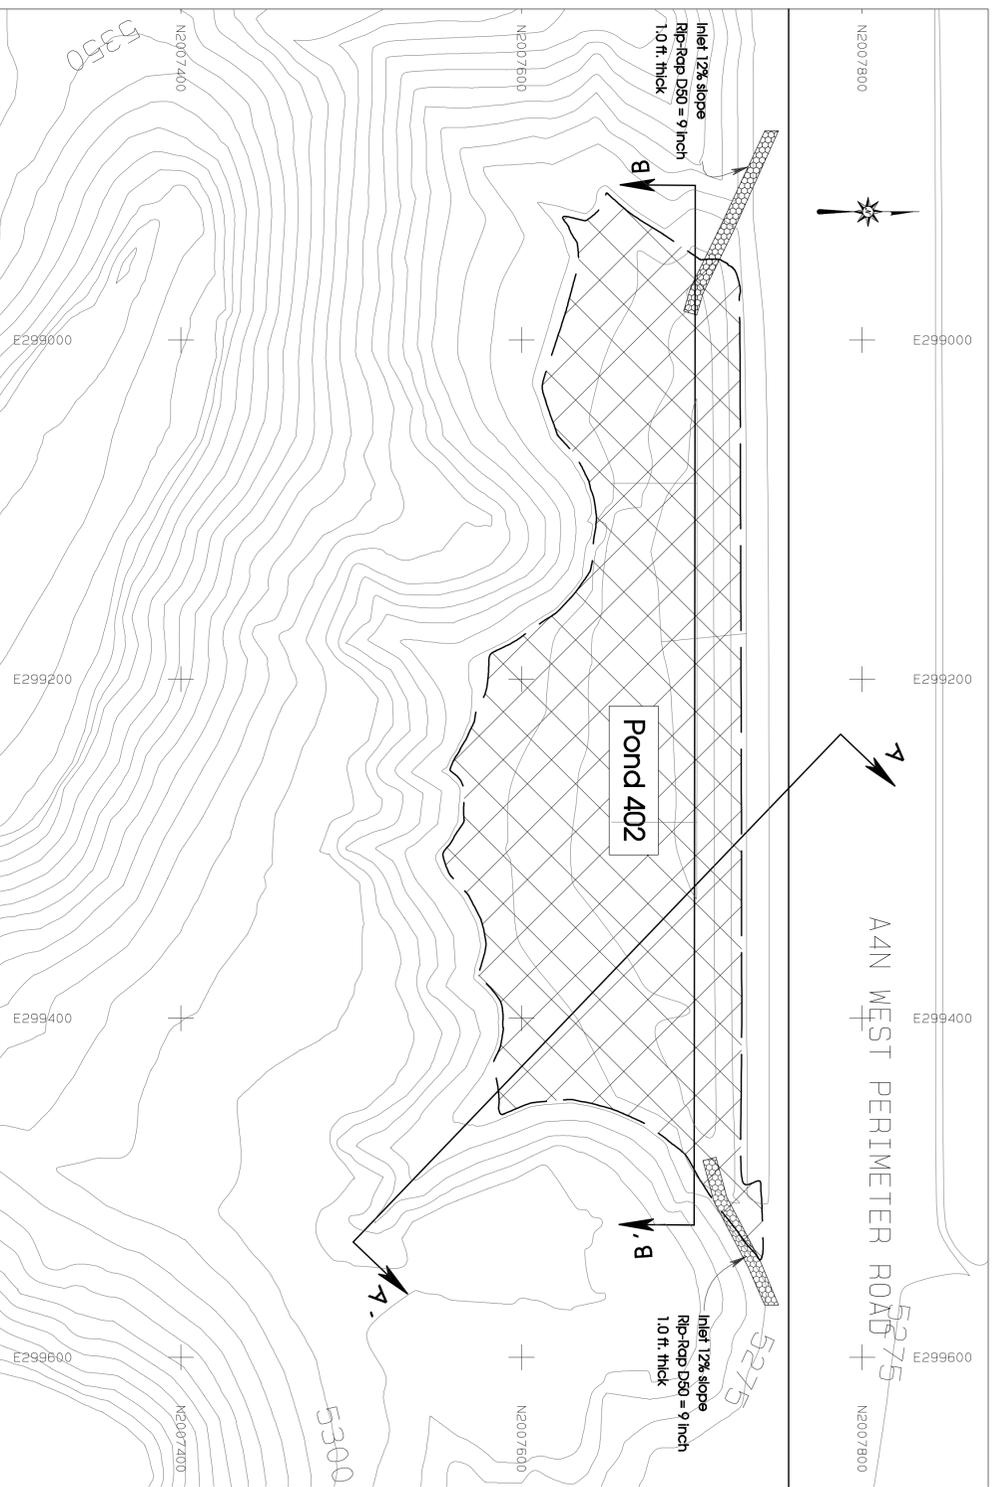

**LEGEND**


- ROAD
- BUILDING
- FENCE
- CULVERT
- DRAINAGE
- POWERLINE
- INDEX CONTOUR
- INTERMEDIATE CONTOUR
- PERMIT/LEASE BOUNDARY

**NOTES**

- For location of drainage control structures and waterheads, refer to Exhibit 11-13F.
- The hydrology and supporting design data for the Pond 402 are referenced on Table 11-5 of the NW PMP.

**STAGE STORAGE DATA**

ELEV feet	AREA acres	VOLUME ac-ft	CUM. VOLUME ac-ft
5280	0.09	0.00	0.00
5282	0.31	0.40	0.40
5284	0.49	0.80	1.20
5286	0.66	1.10	2.30
5288	0.84	1.50	3.80
5290	1.06	1.90	5.70
5292	1.31	2.40	8.10
5294	1.54	2.90	11.00
5296	1.75	3.30	14.30

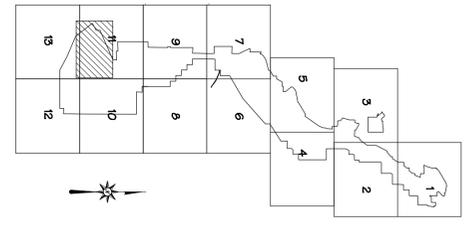

**CERTIFICATION STATEMENT**

I, Ron C. Van Valkenburg, hereby certify that this drawing was reviewed by me and that the information shown is complete and accurate to the best of my knowledge.



**EXHIBIT 26-20**  
**AREA 4 NORTH**  
**POND 402**  
**Design**

**PLAN, PROFILE AND SECTION**

PROJECT: A4N  
DATE: AUG. 8, 2009  
DESIGNED BY: RCV  
DRAWN BY: PJFOSTER  
CHECKED BY: RCV  
APPROVED BY: RCV

**bhpbilliton**  
**NAVAJO COAL COMPANY**  
**NAVAJO MINE**

REVISION	DATE
09-4 UPDATED AND DEVELOPMENT AND SUBMITTED TO COM FOR REVIEW	8/28/09
11-4 PERMITS AND REVISION REQUIREMENTS TO COM FOR REVIEW AND APPROVAL	FEB-2011

PROJECT MANAGER: F. GORMAN  
ENGR. of RECORD: RON C. VAN VALKENBURG  
REG. NO: NM 9263  
SHRVA of RECORD:  
REG. NO:

This page is intentionally left blank due to removal of Exhibit 26-21




Area 4 North Pond 404

Update 13-06.

This page is intentionally left blank due to removal of Exhibit 26-22




































































































































































































































































Area 4 North Pond 405


Update 13-06.

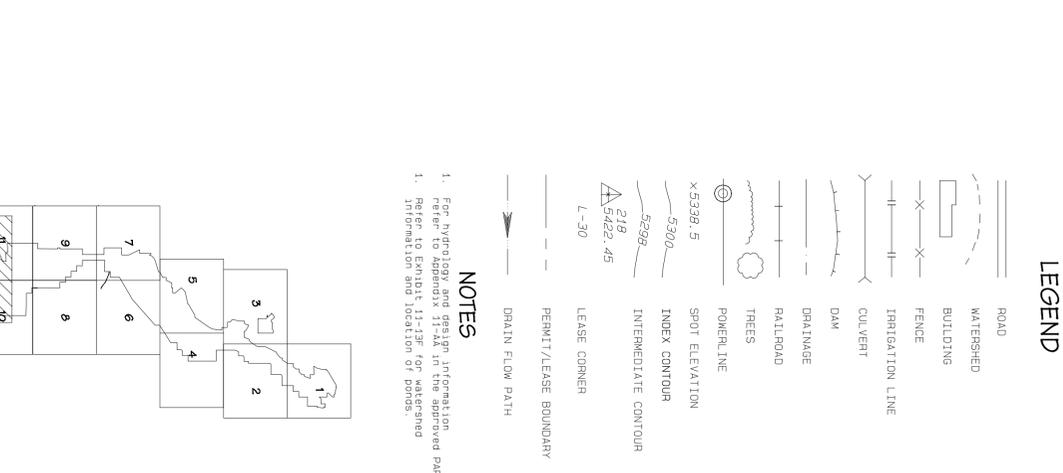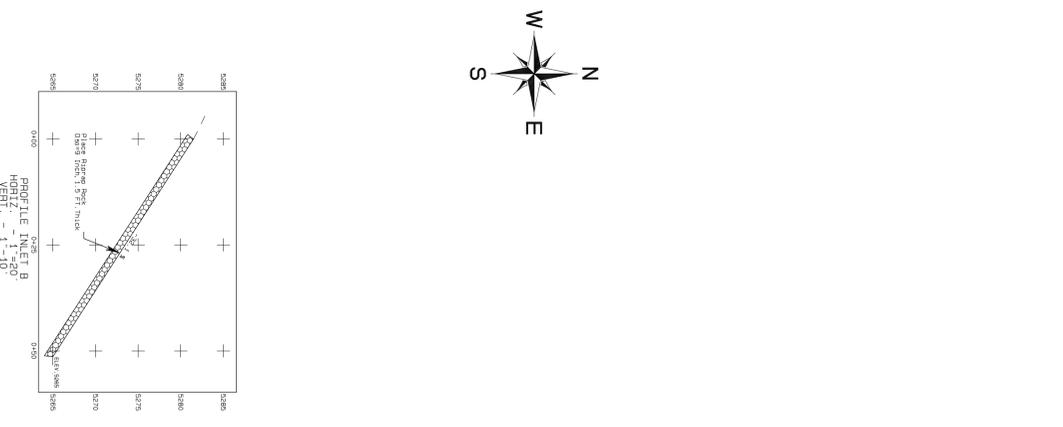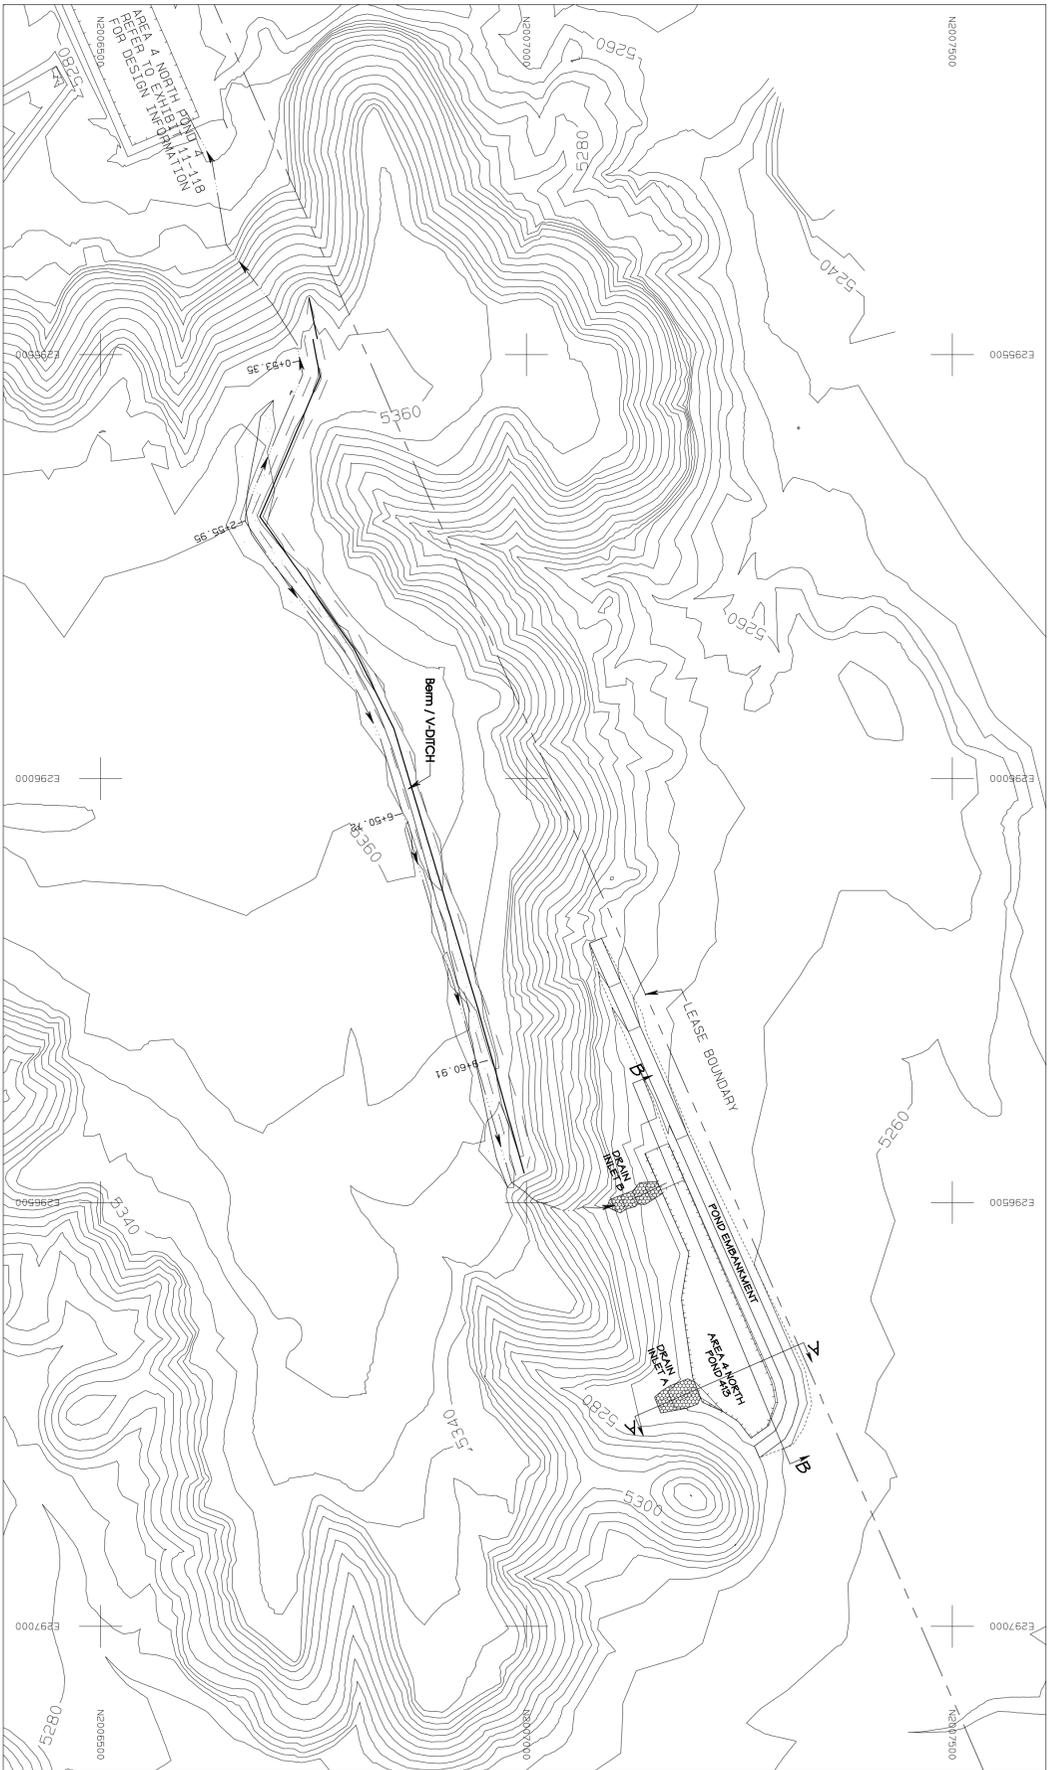

STAGE STORAGE DATA

ELEV. FEET	AREA ACRES	VOLUME ac-ft	CUM. VOLUME ac-ft
5284	0.01	0.0	0.00
5285	0.42	0.22	0.22
5286	0.47	0.44	0.66
5288	0.55	0.51	1.68
5270	0.67	0.61	2.90

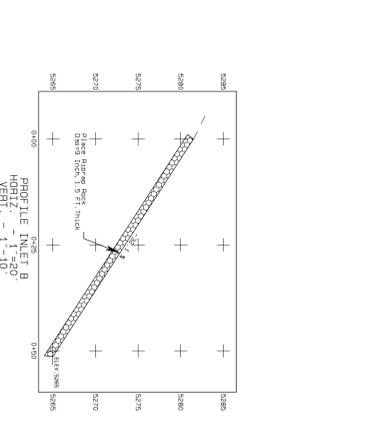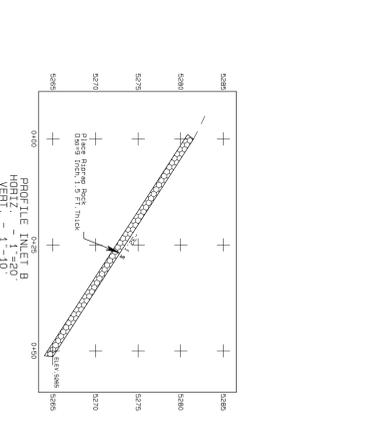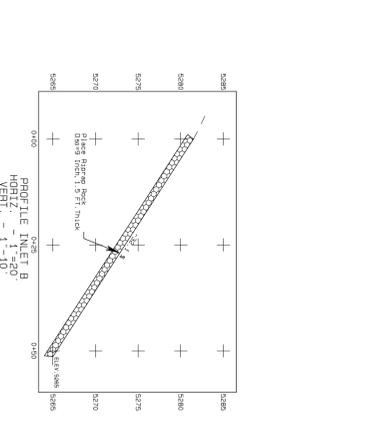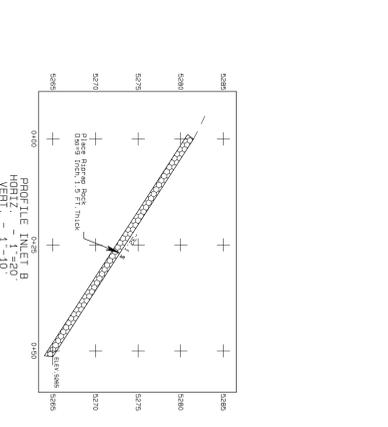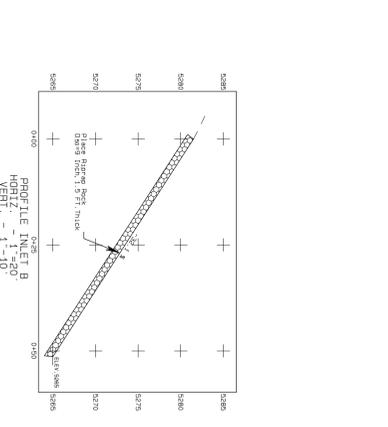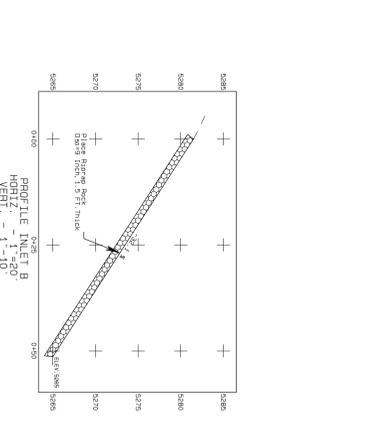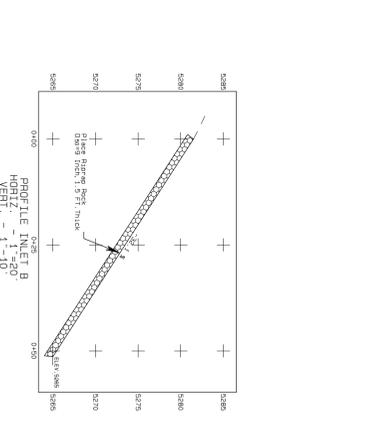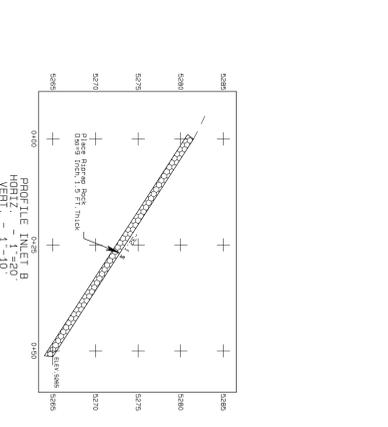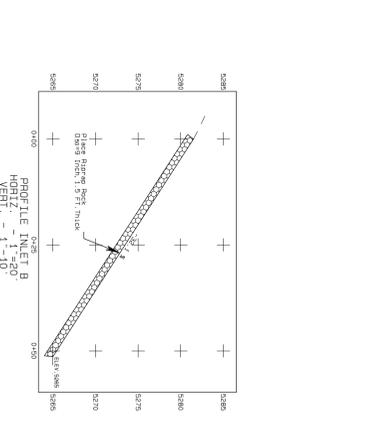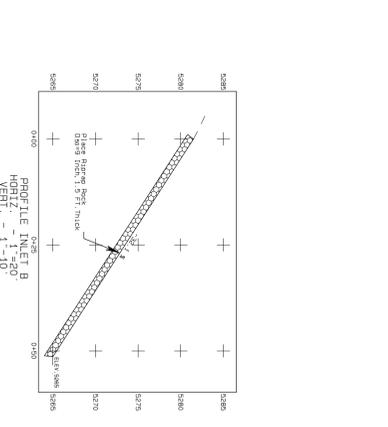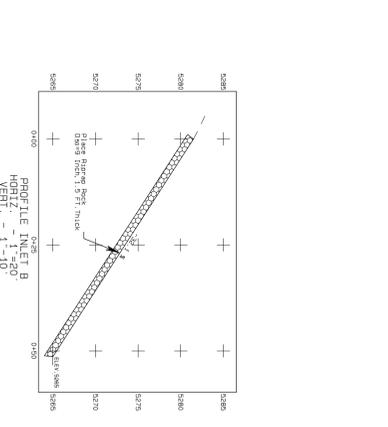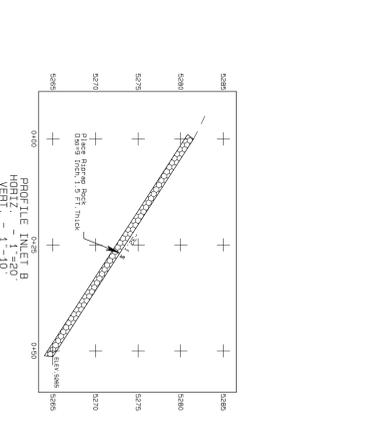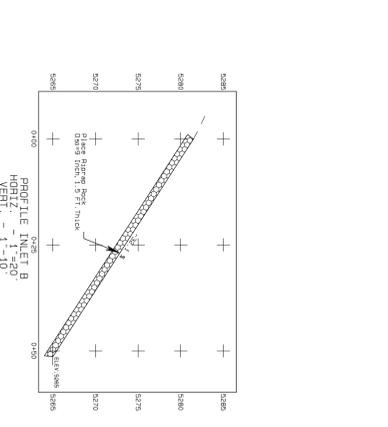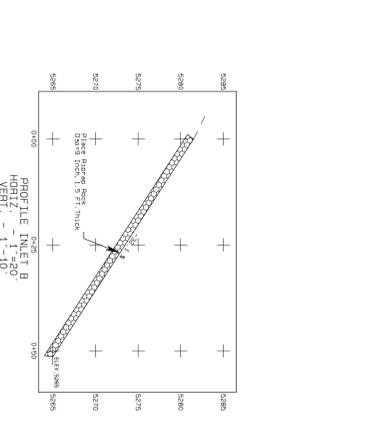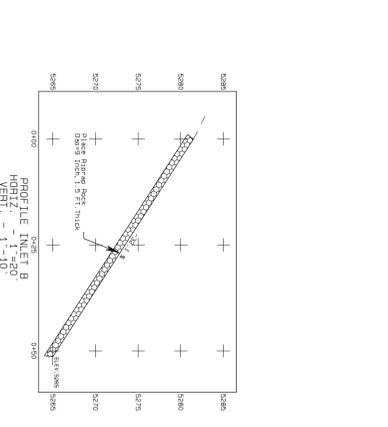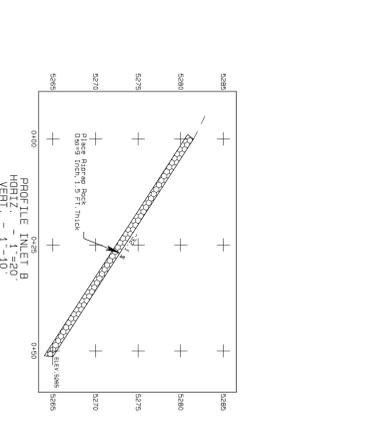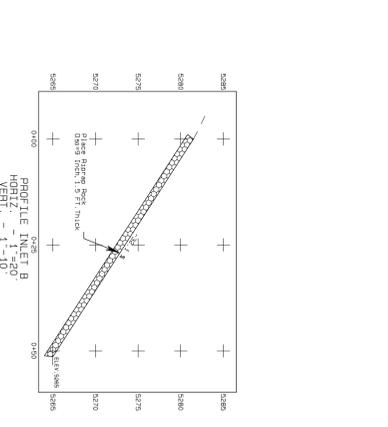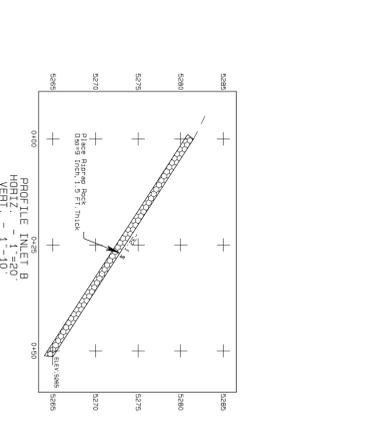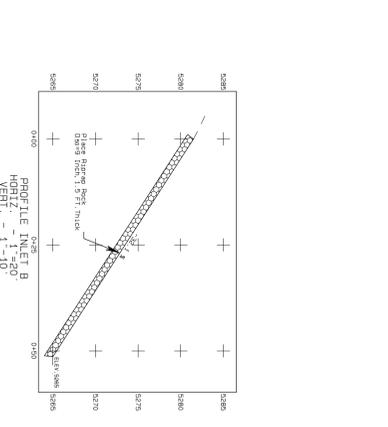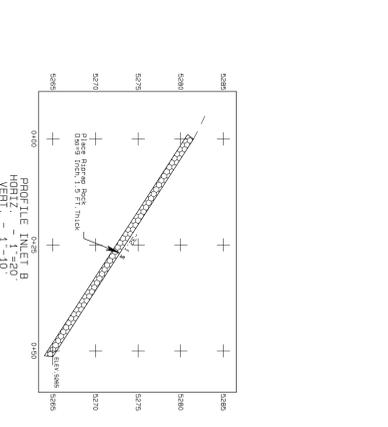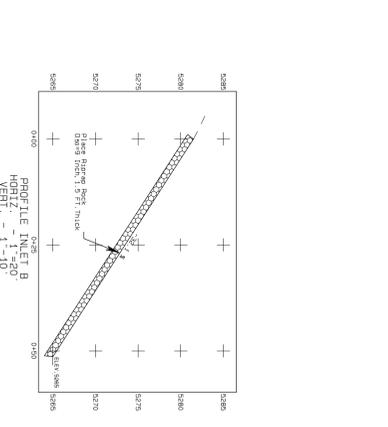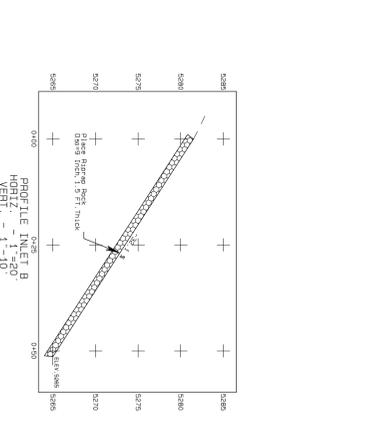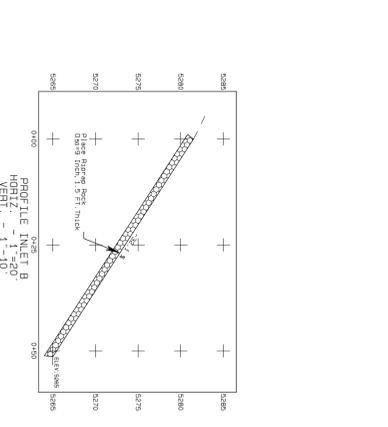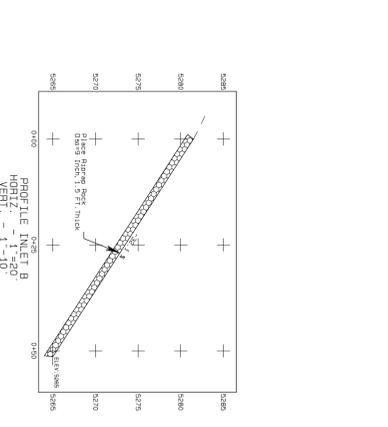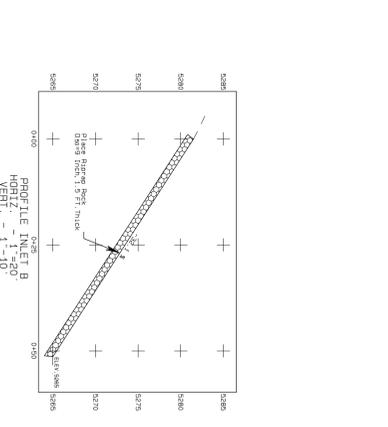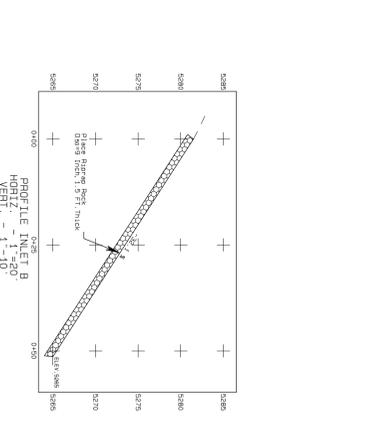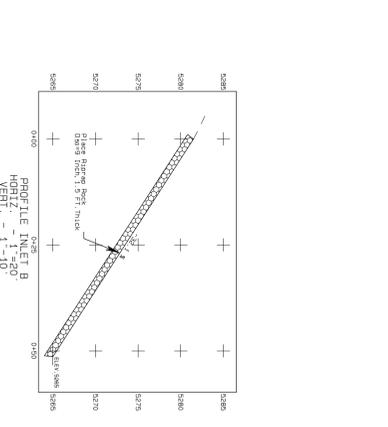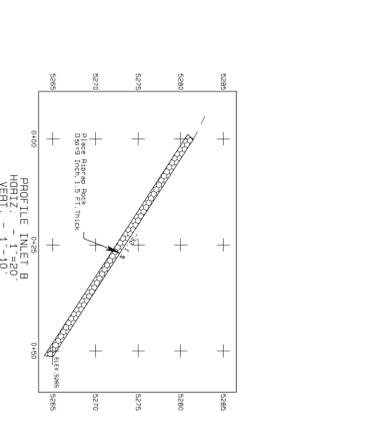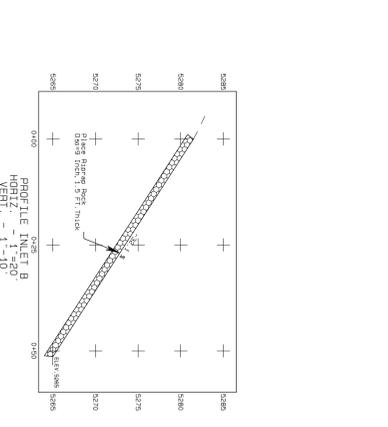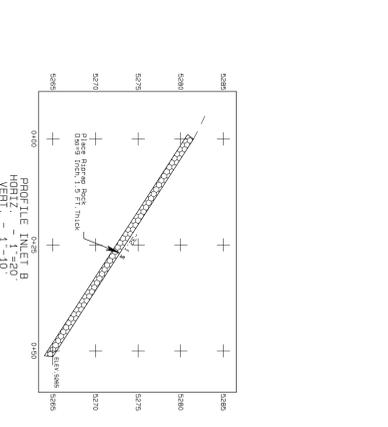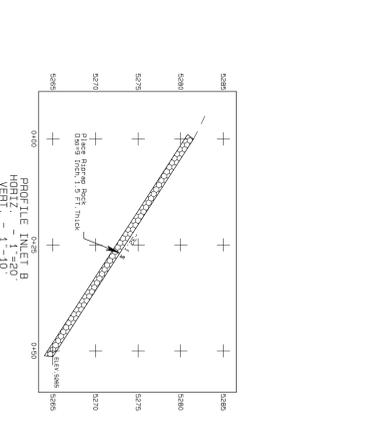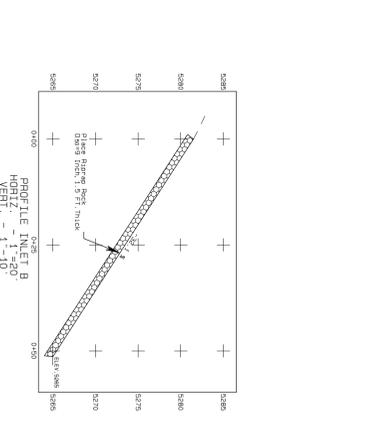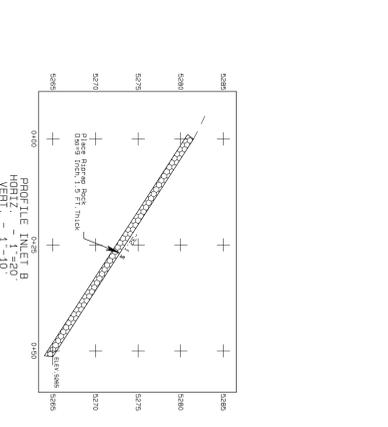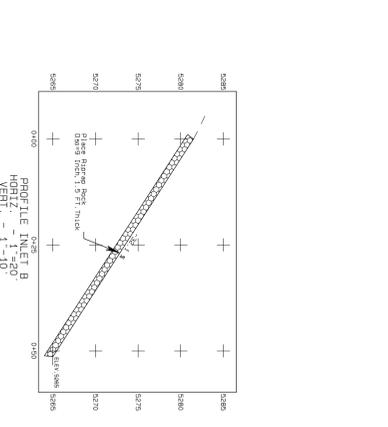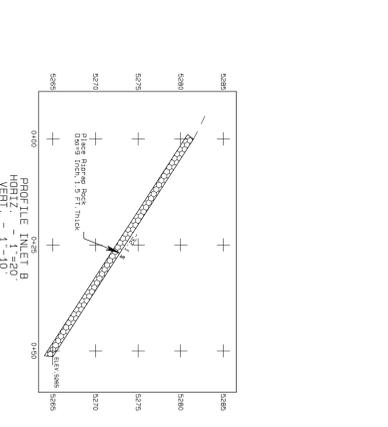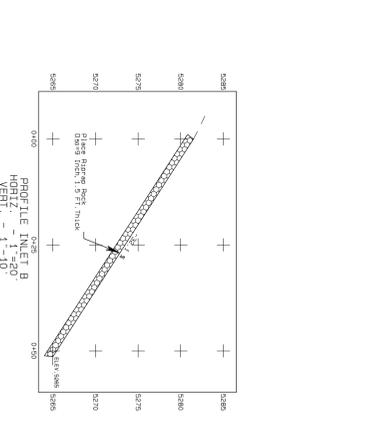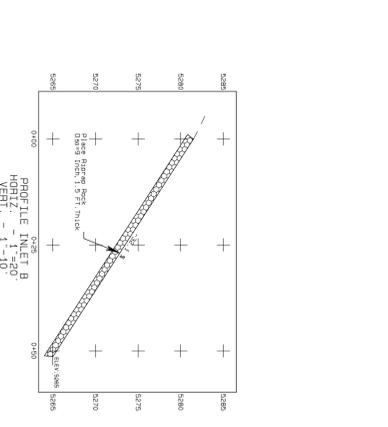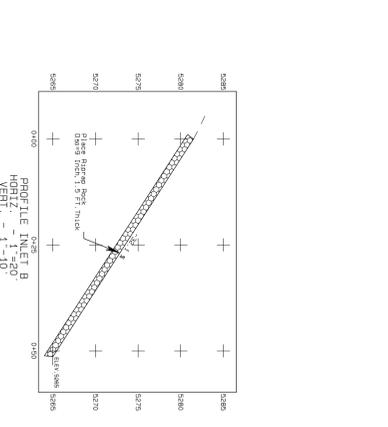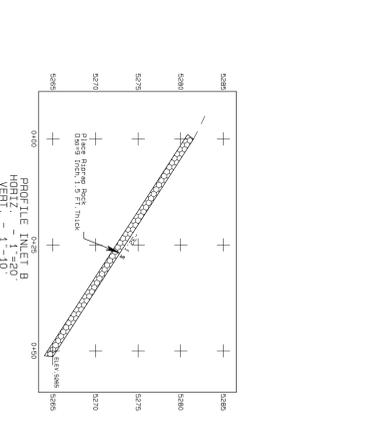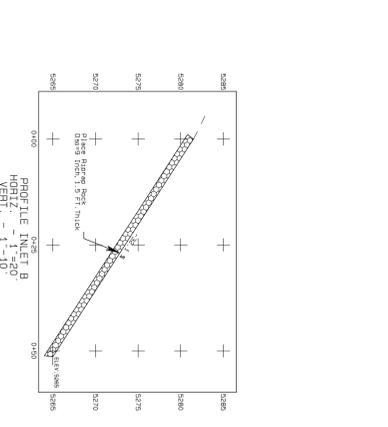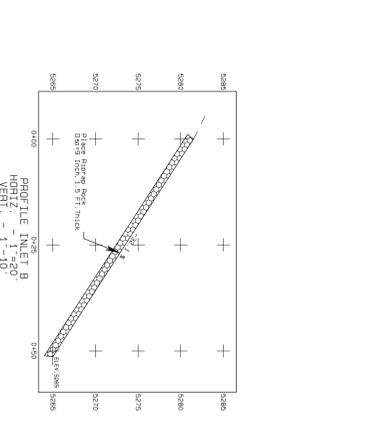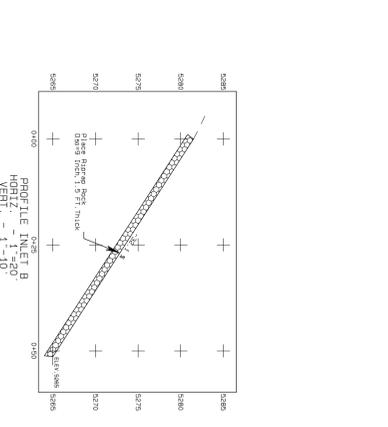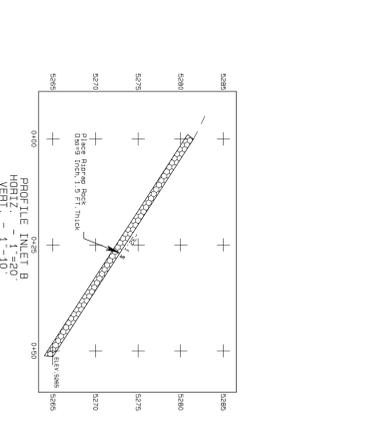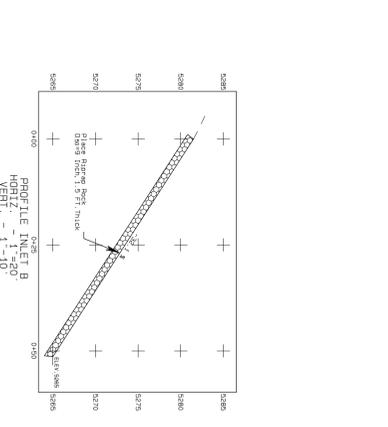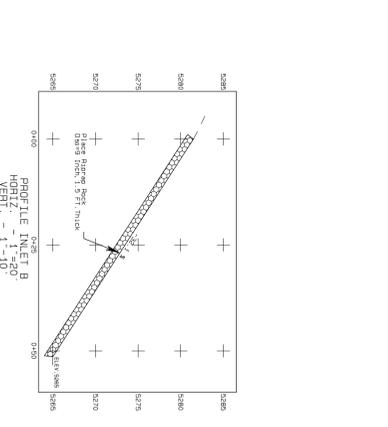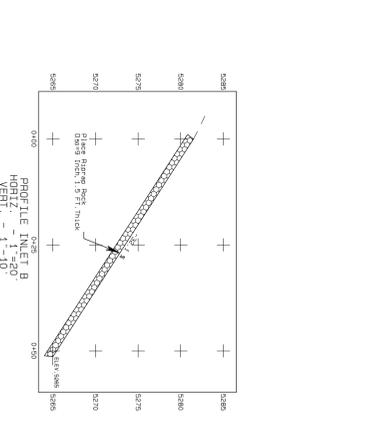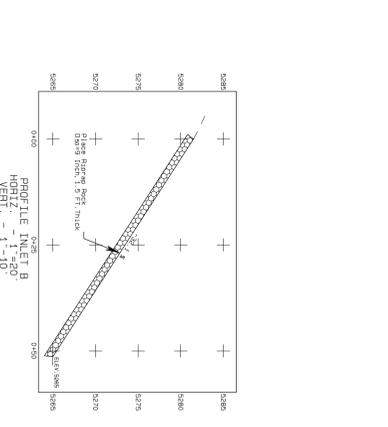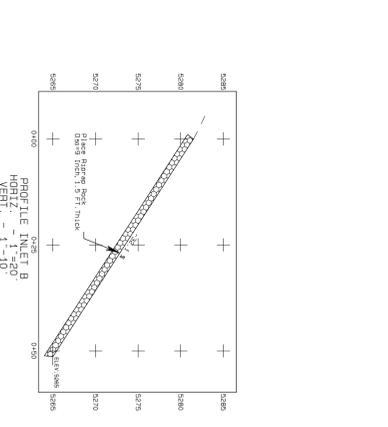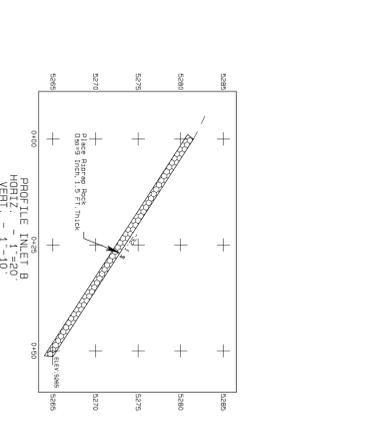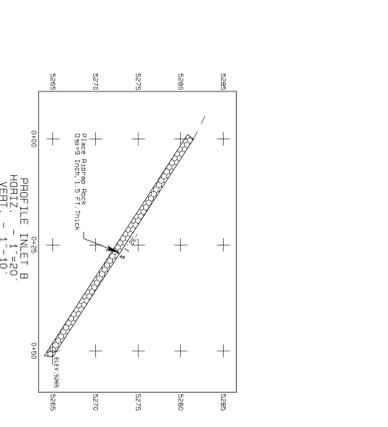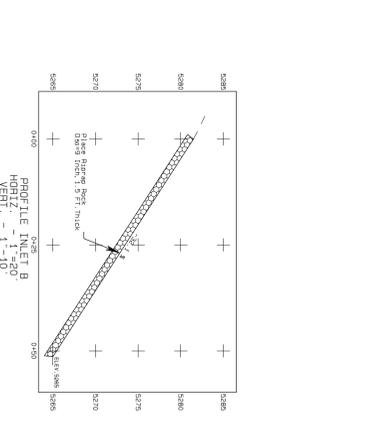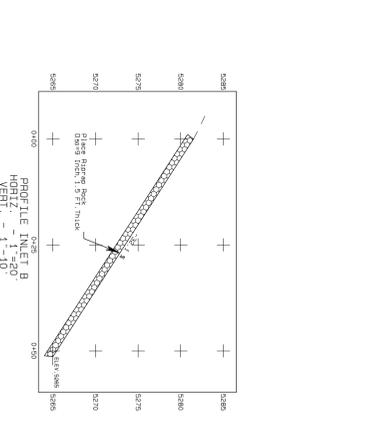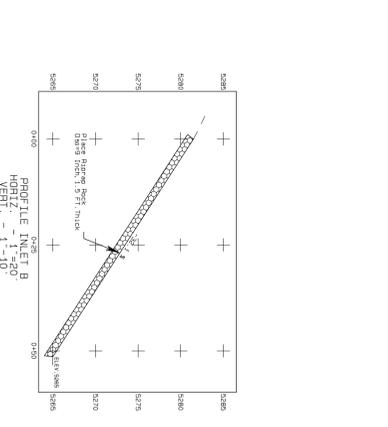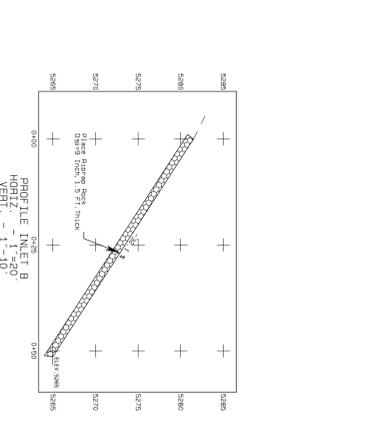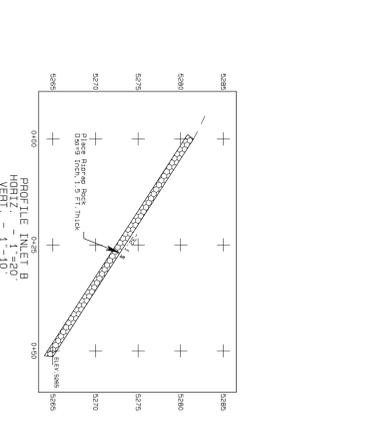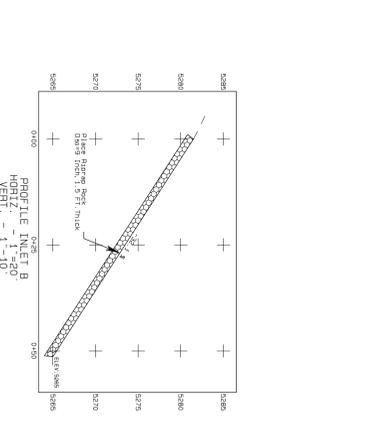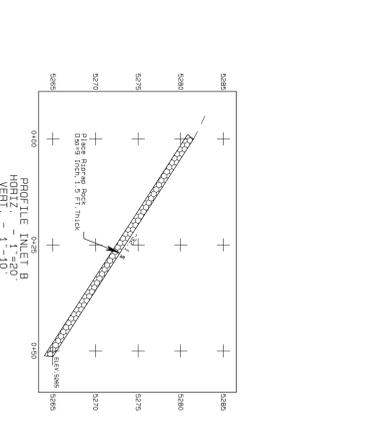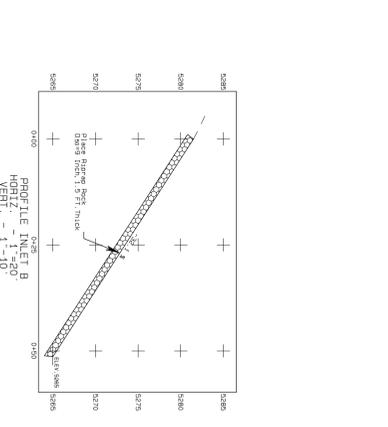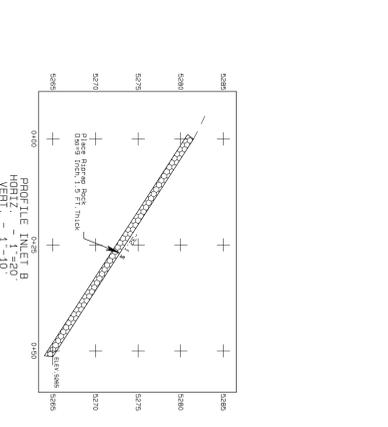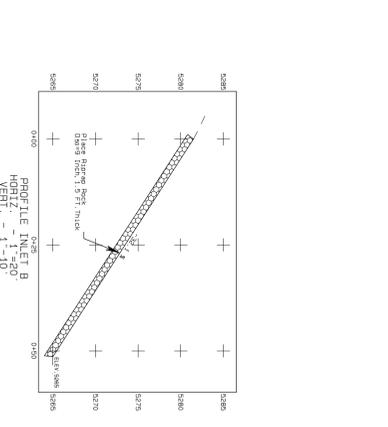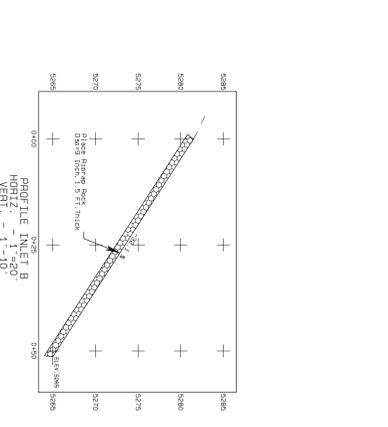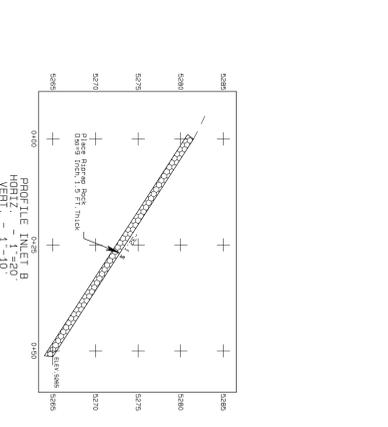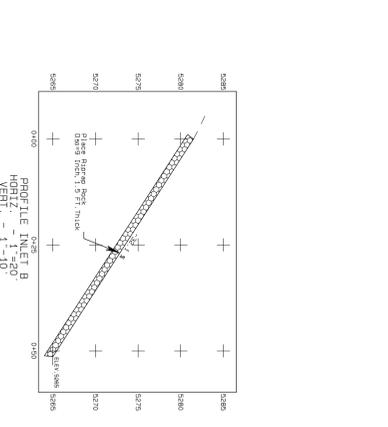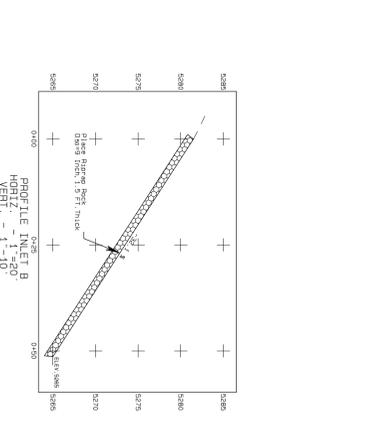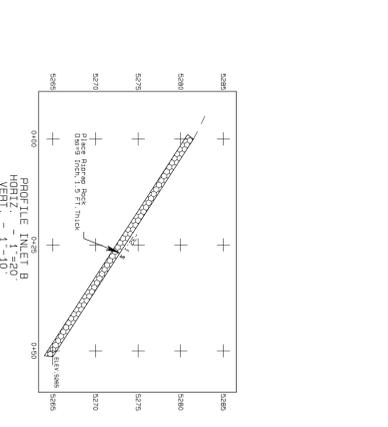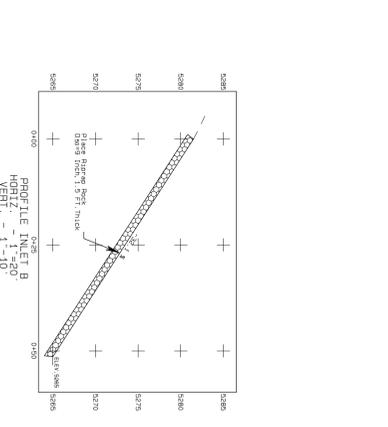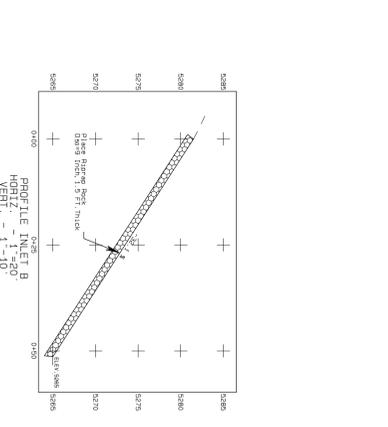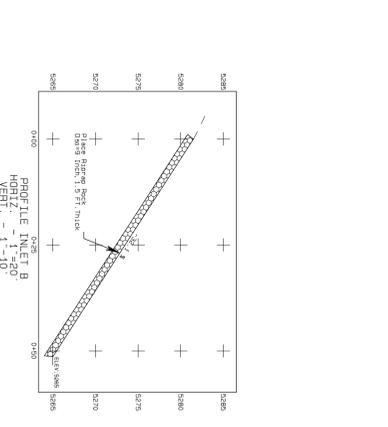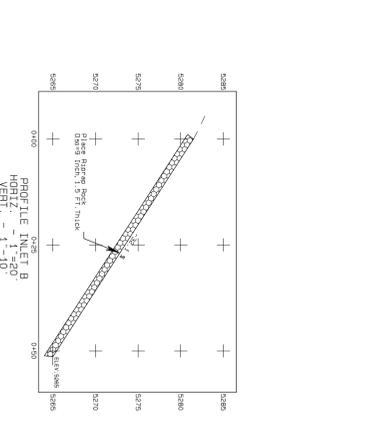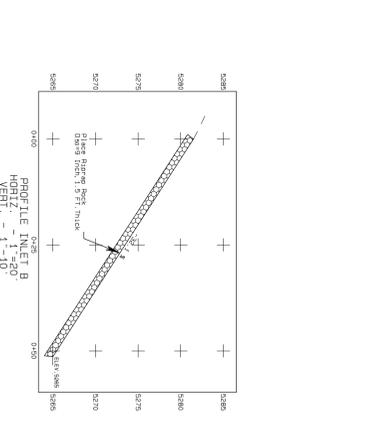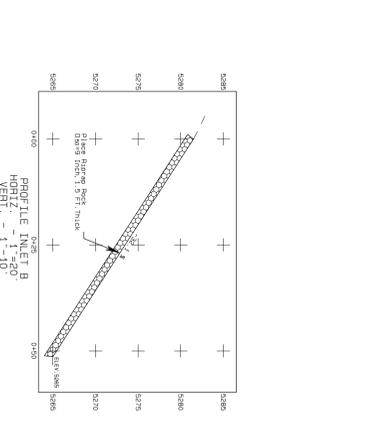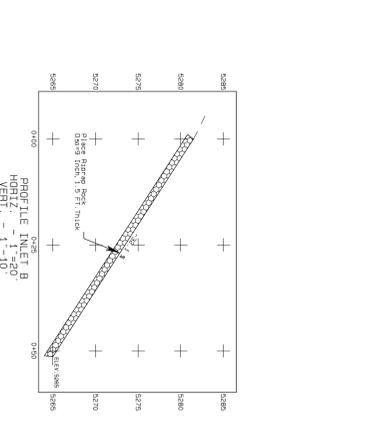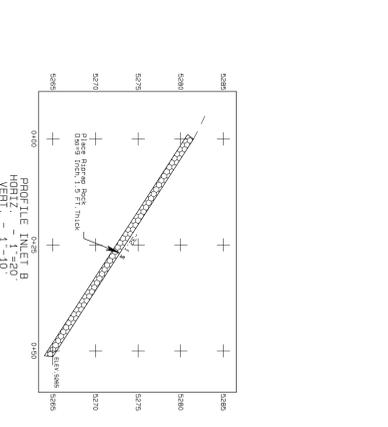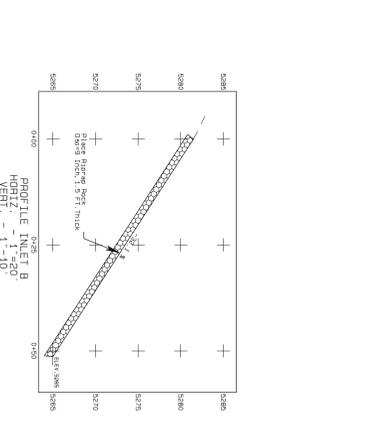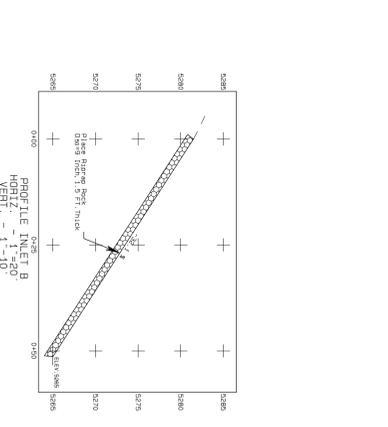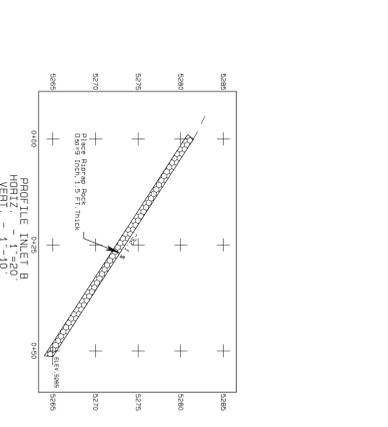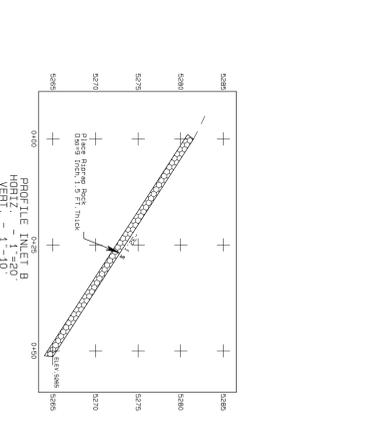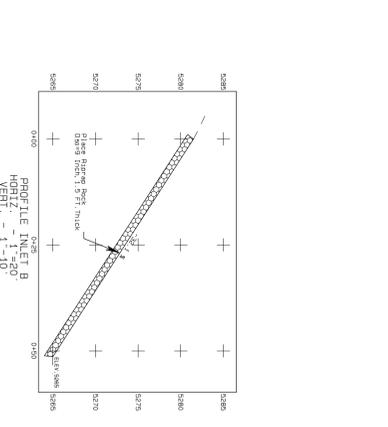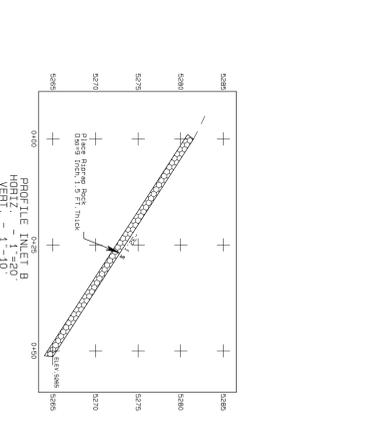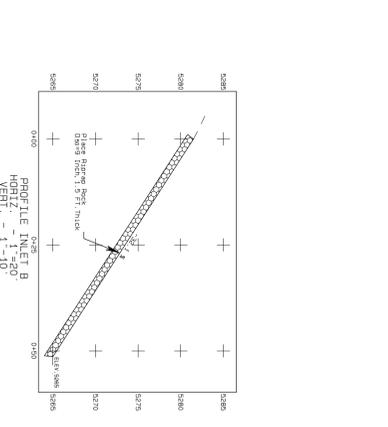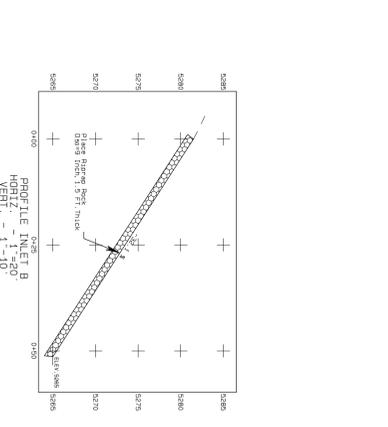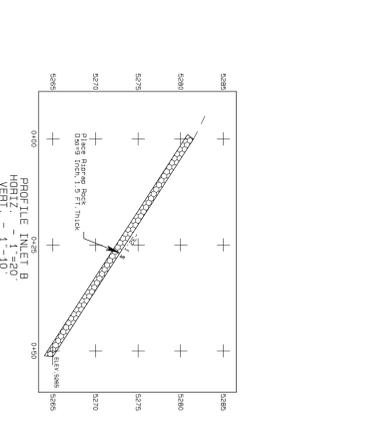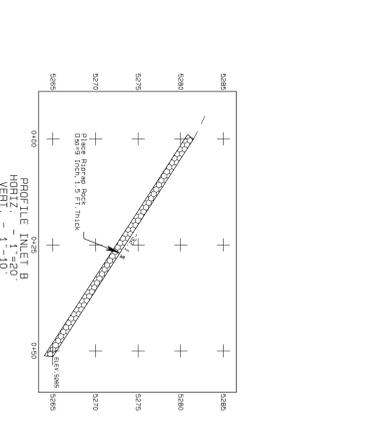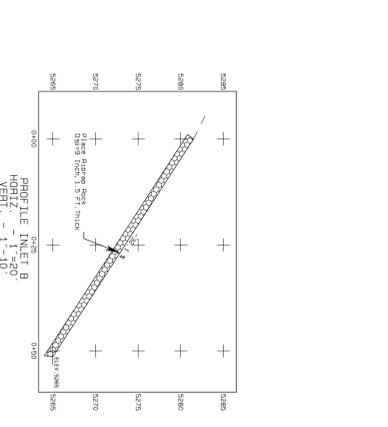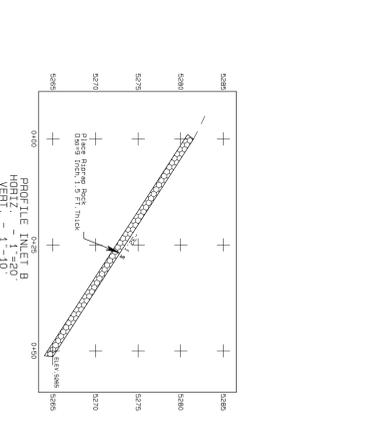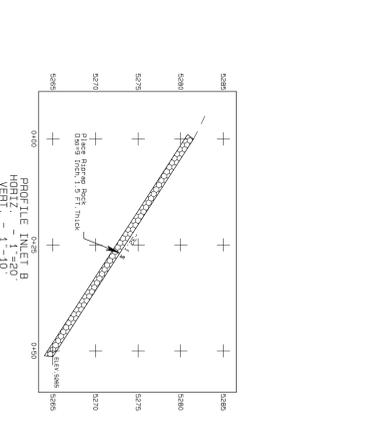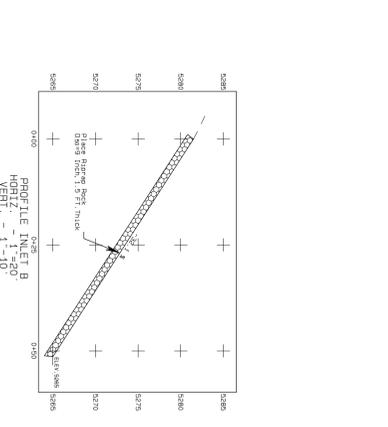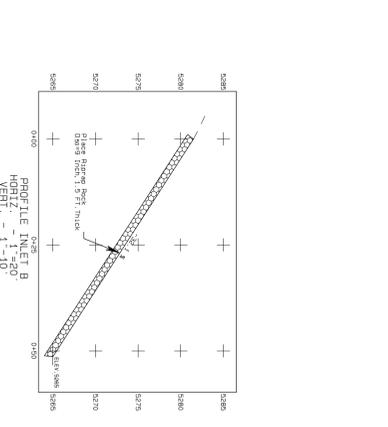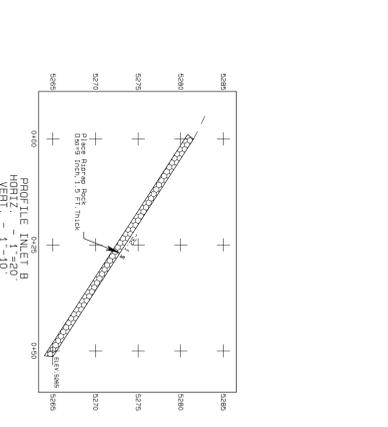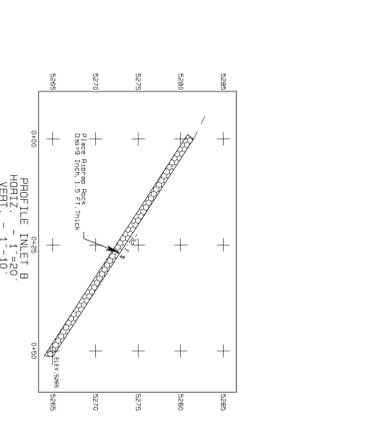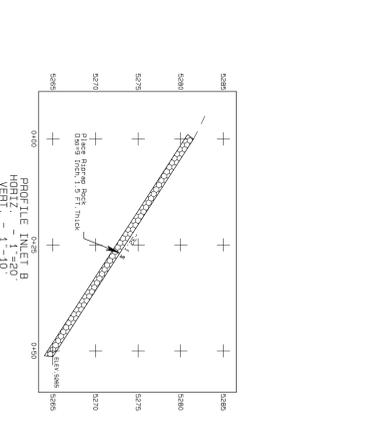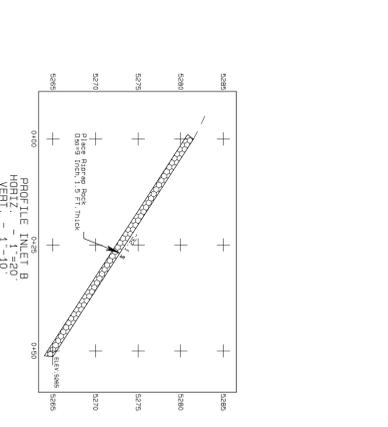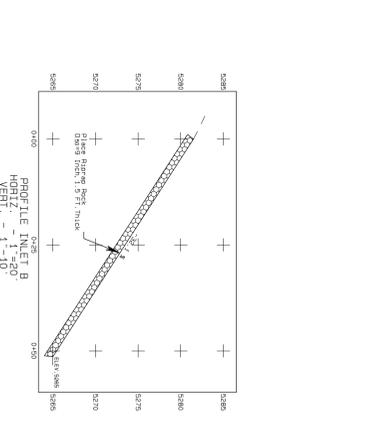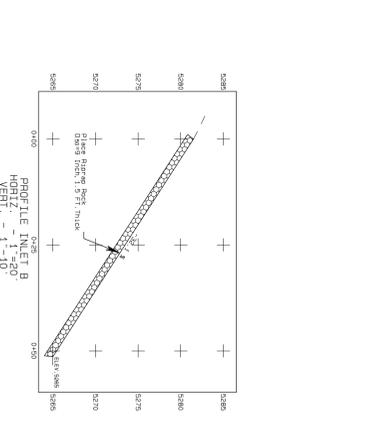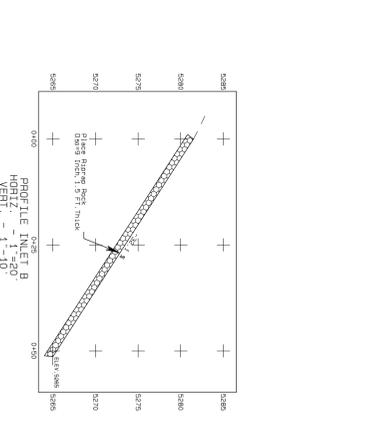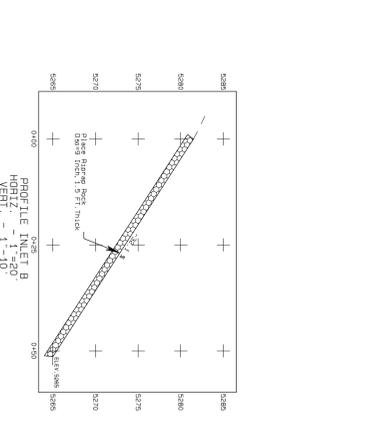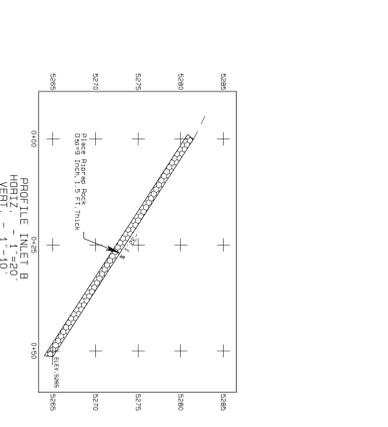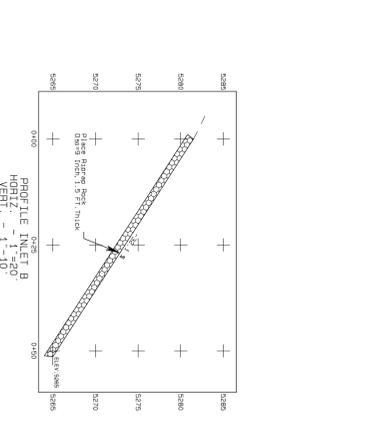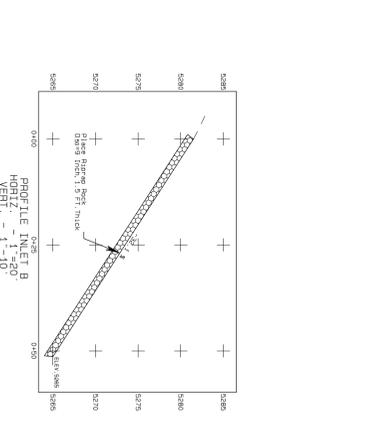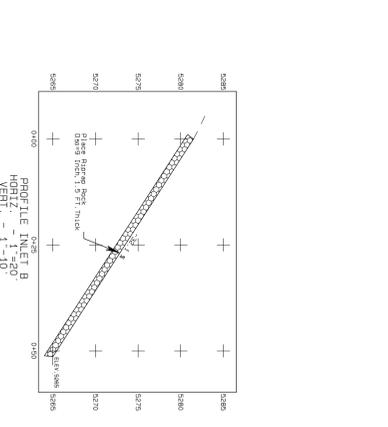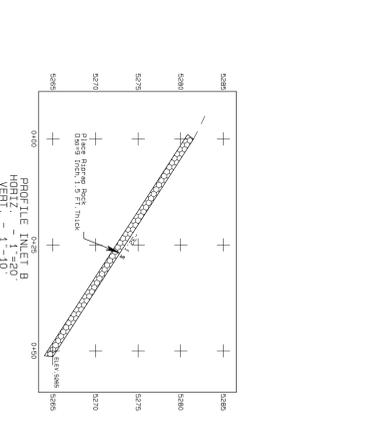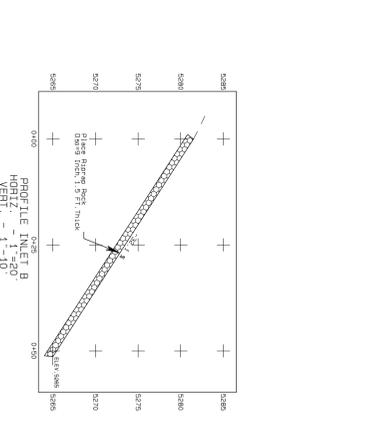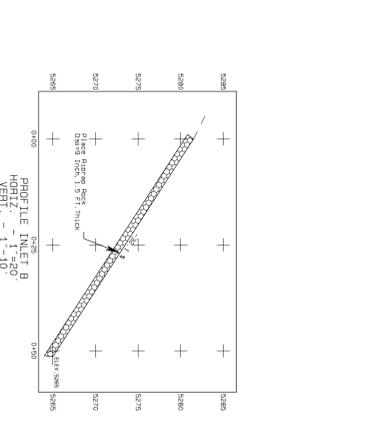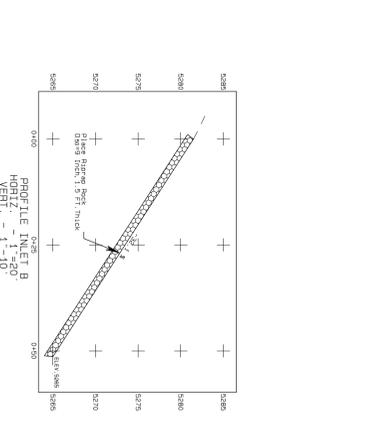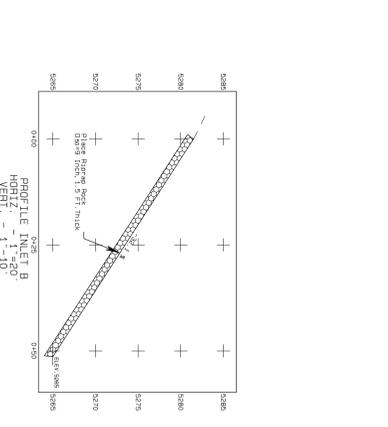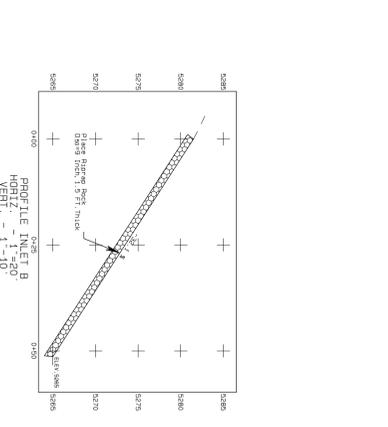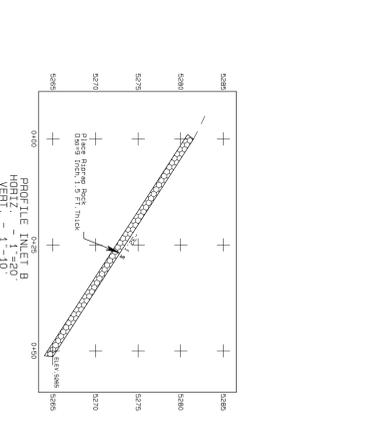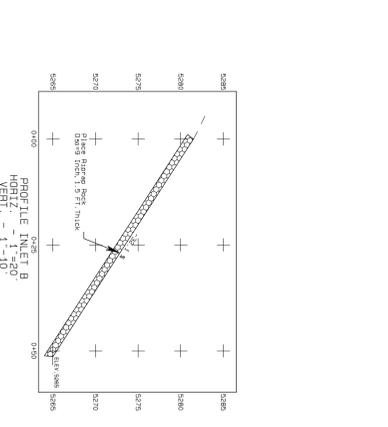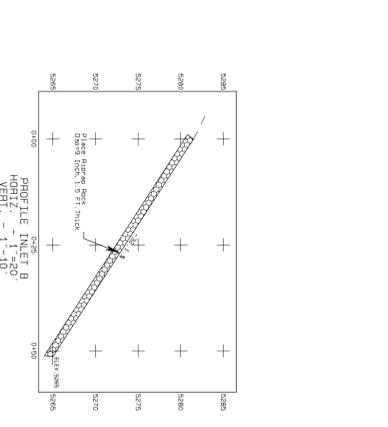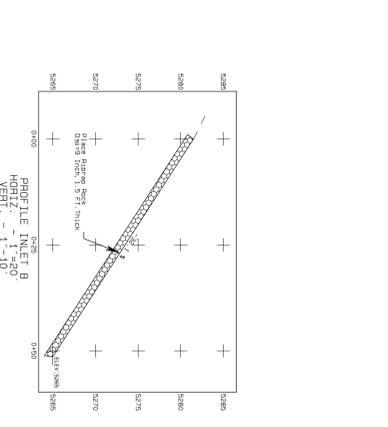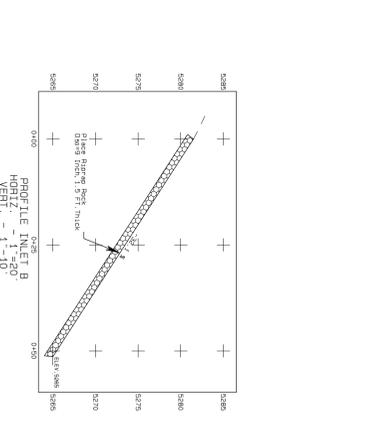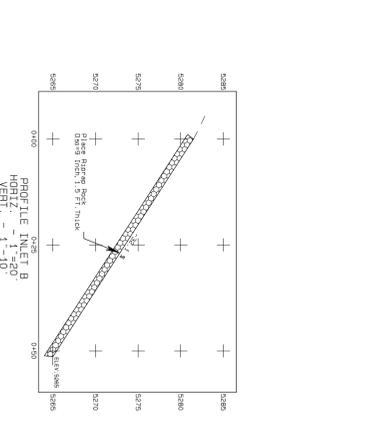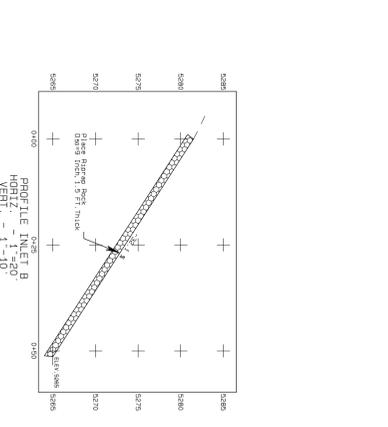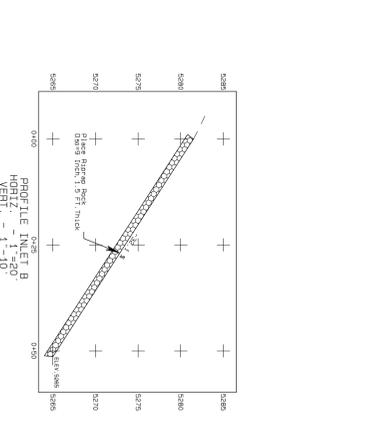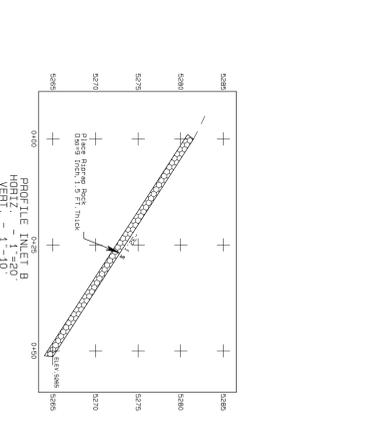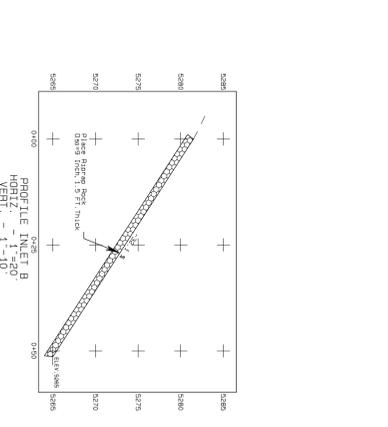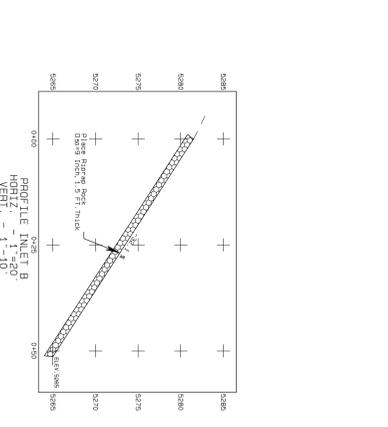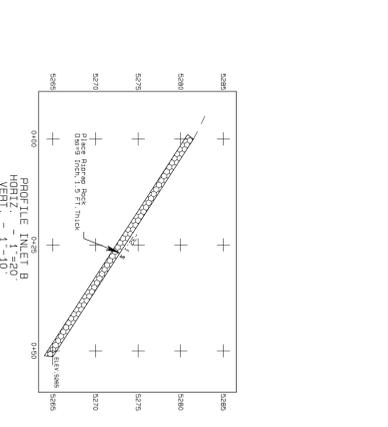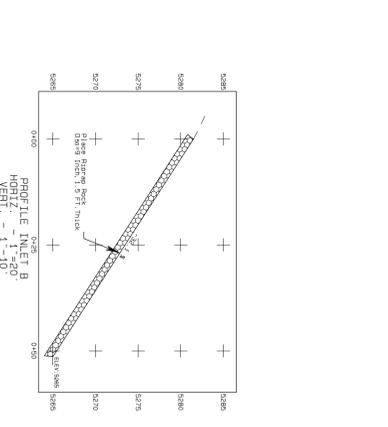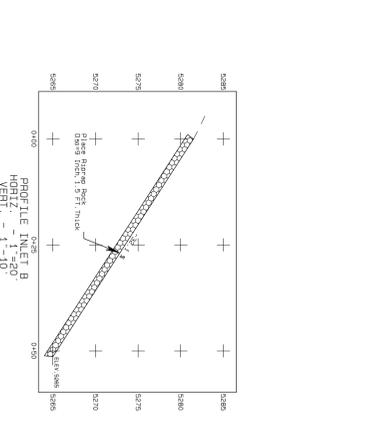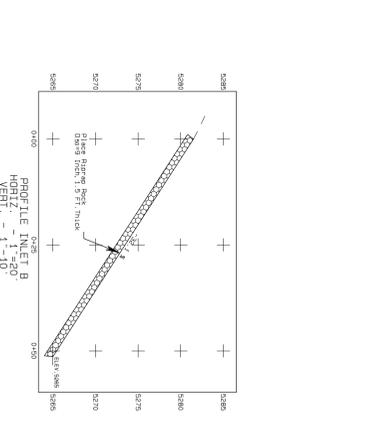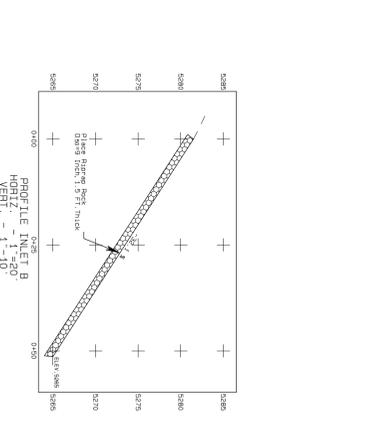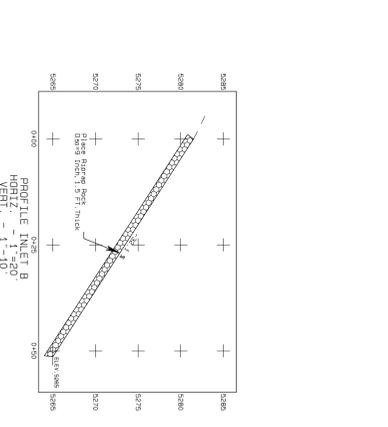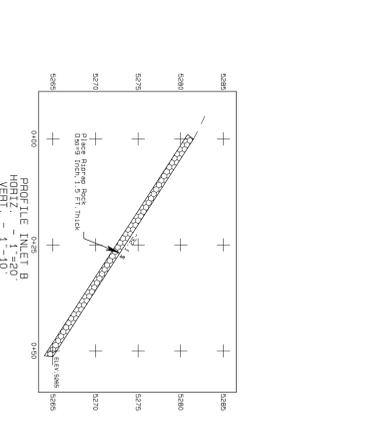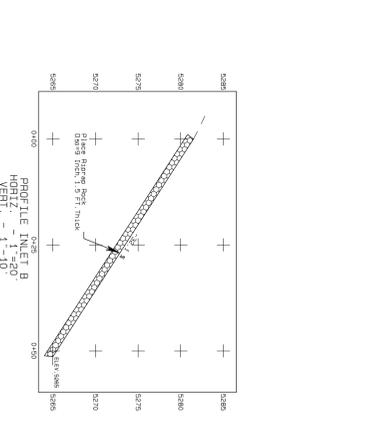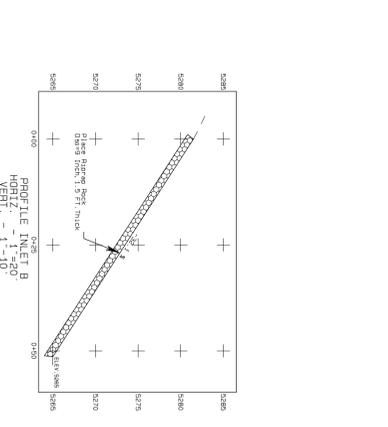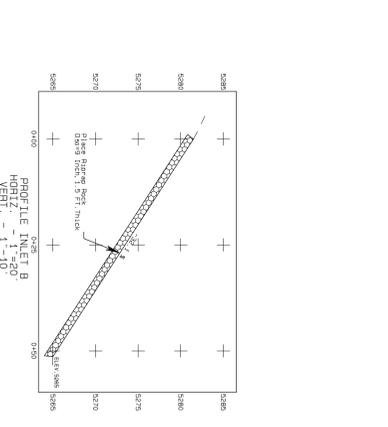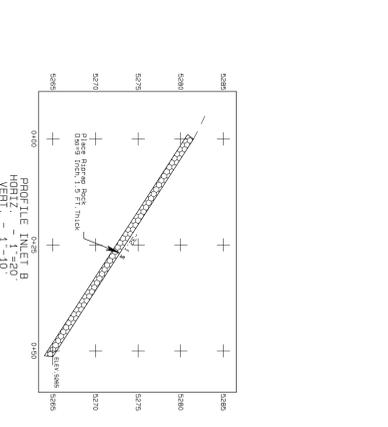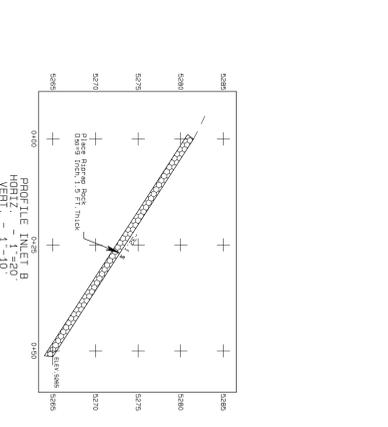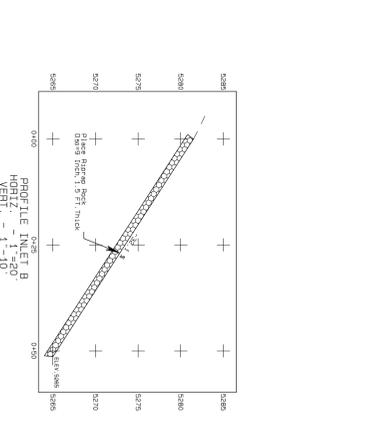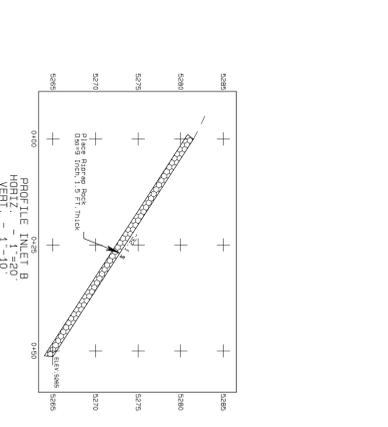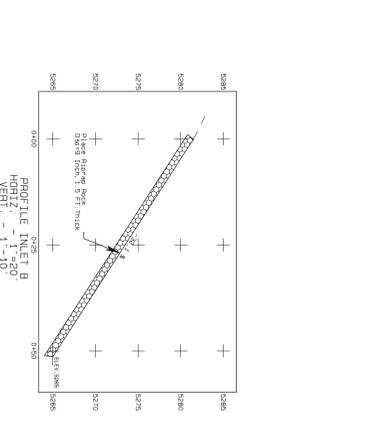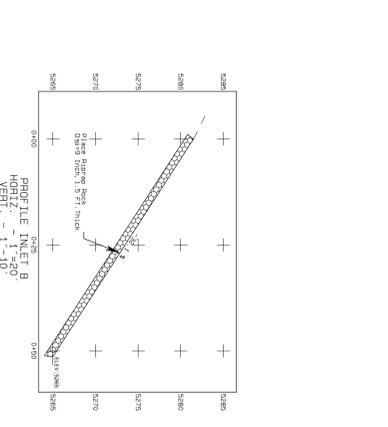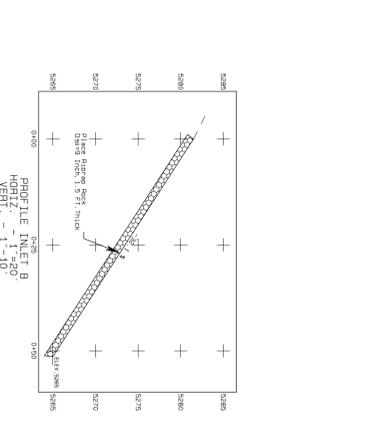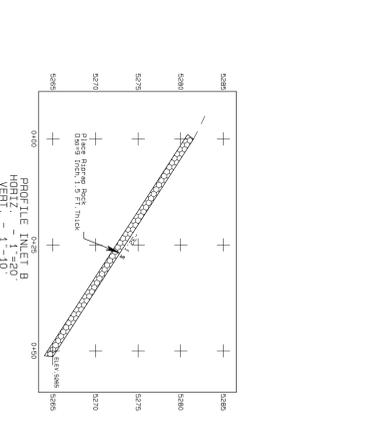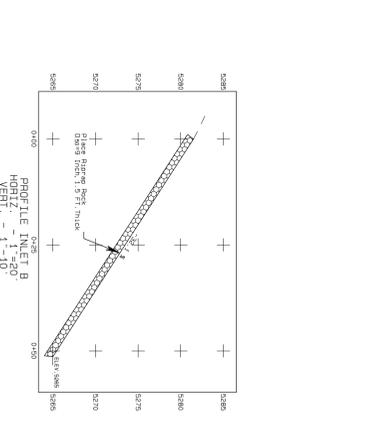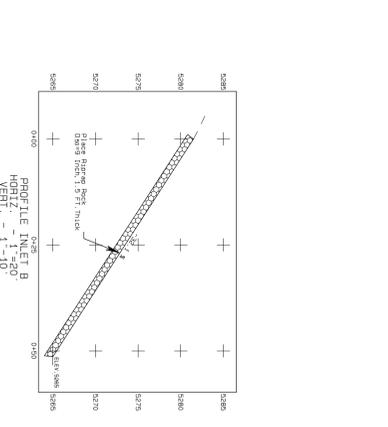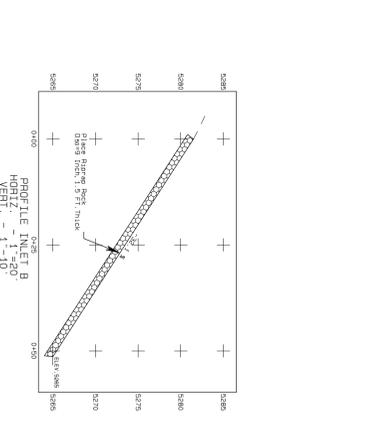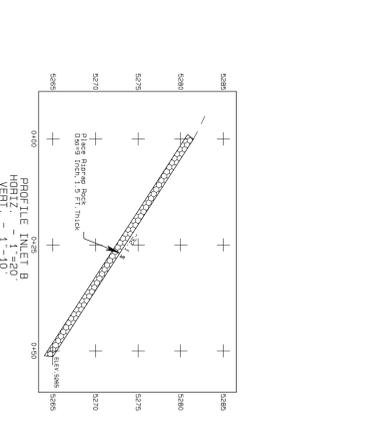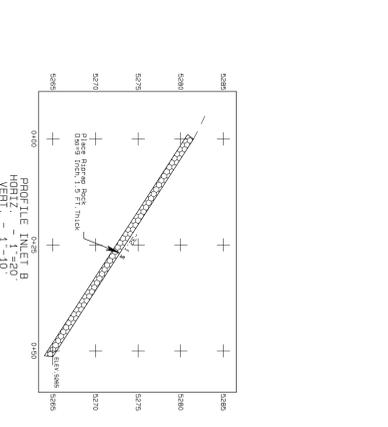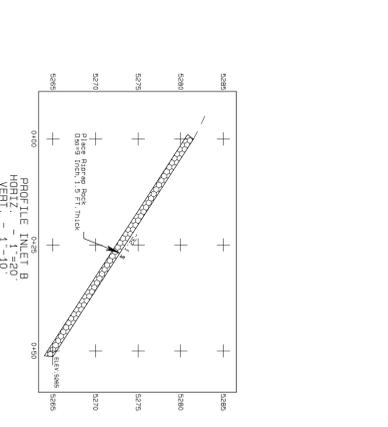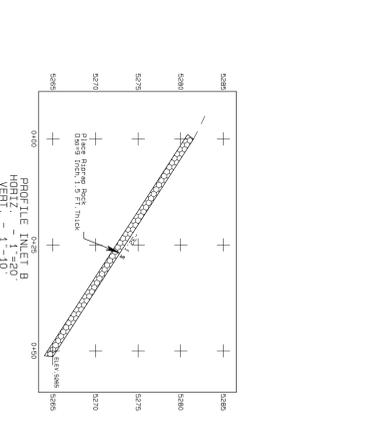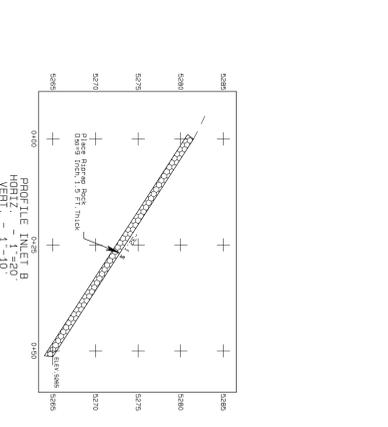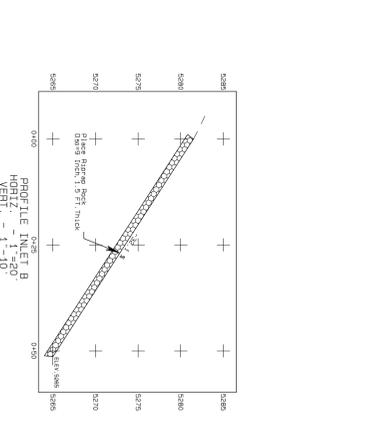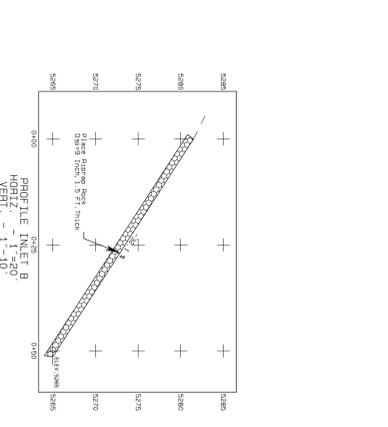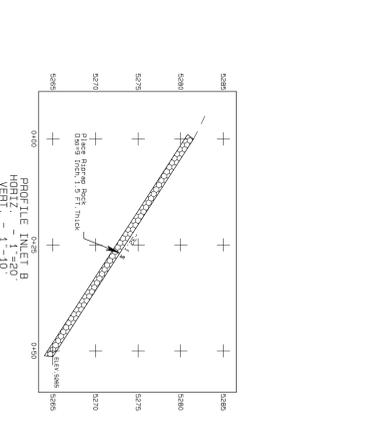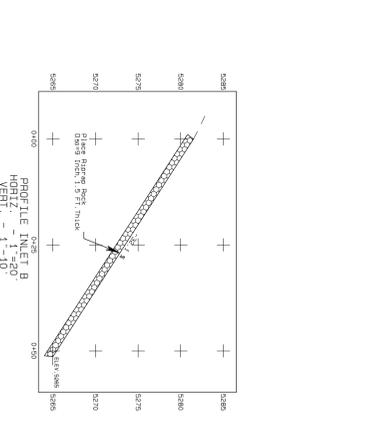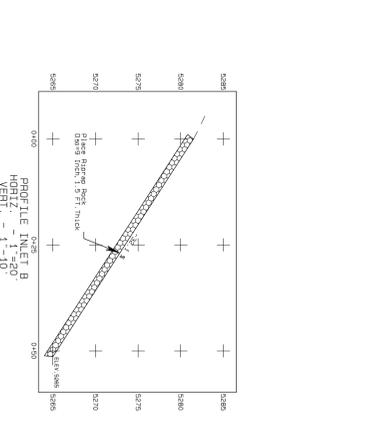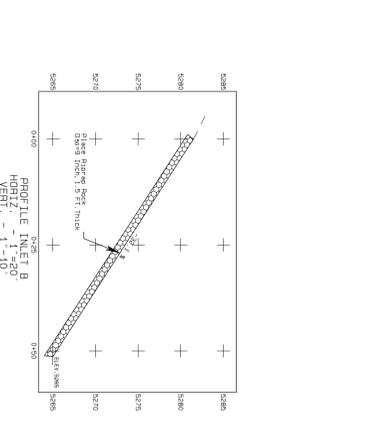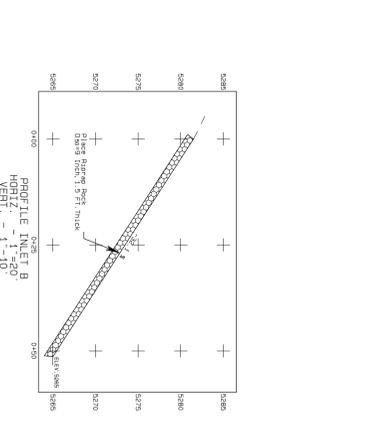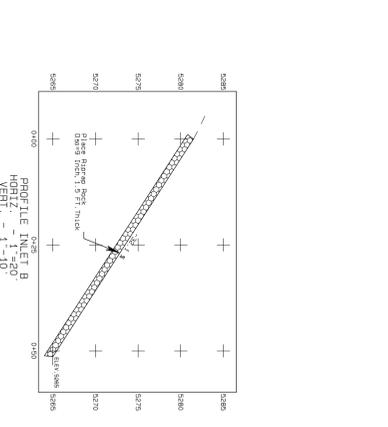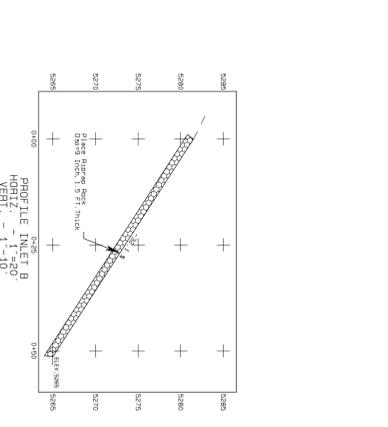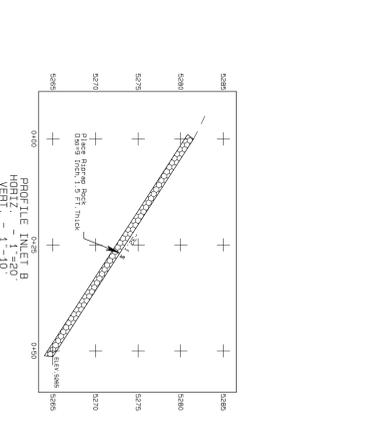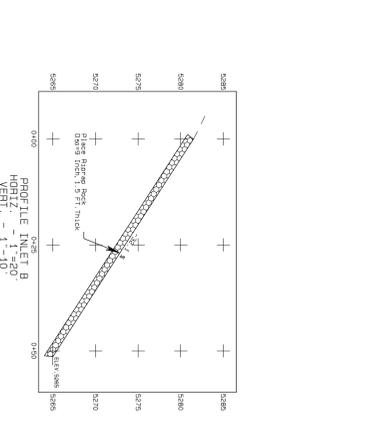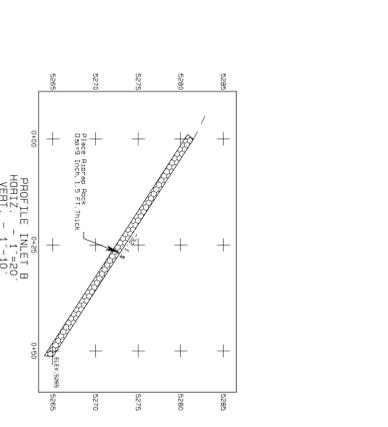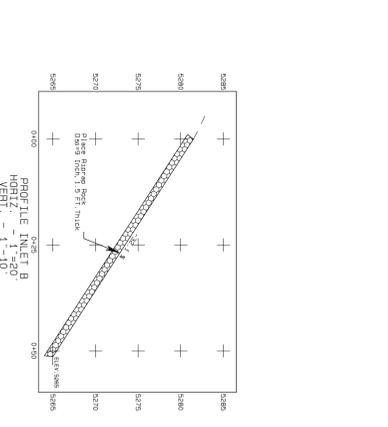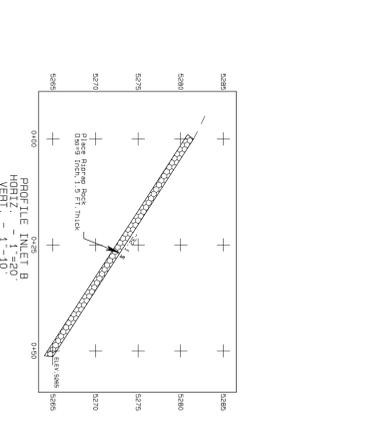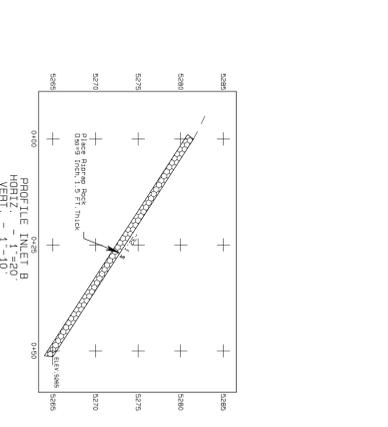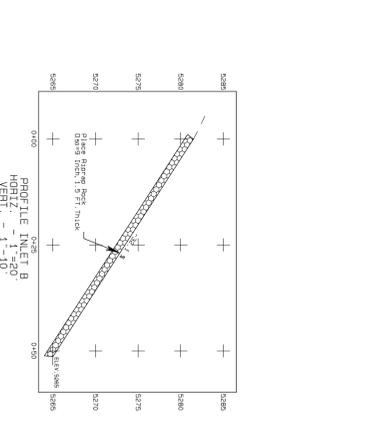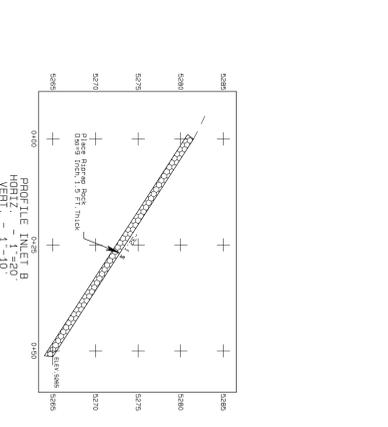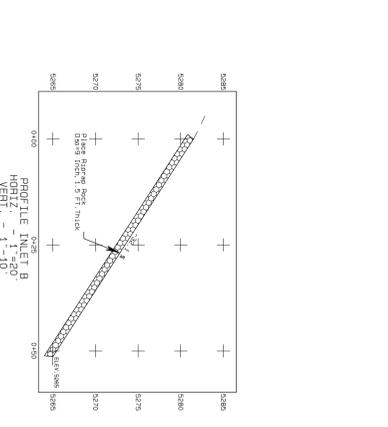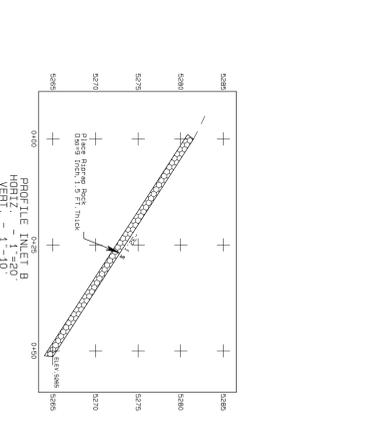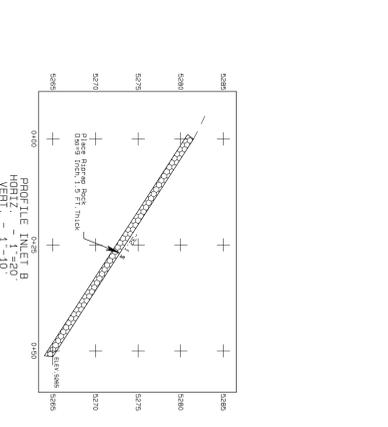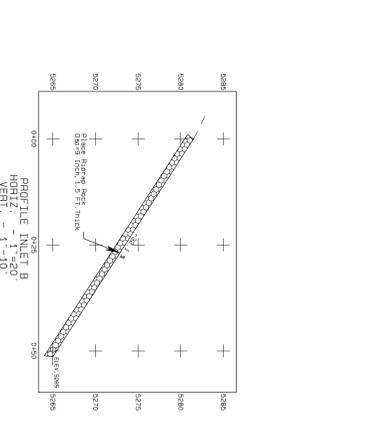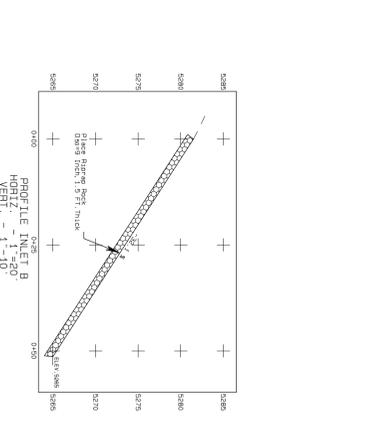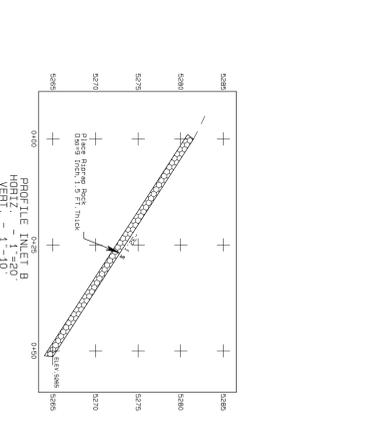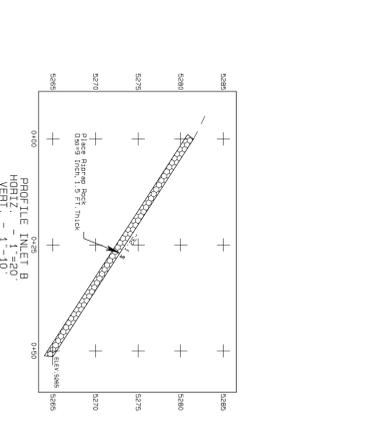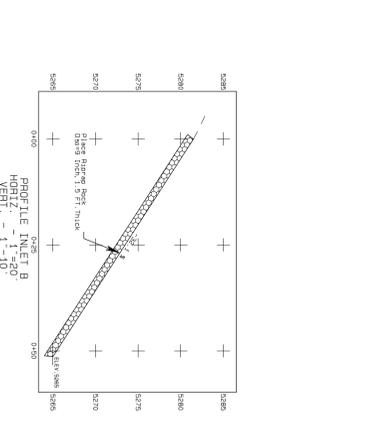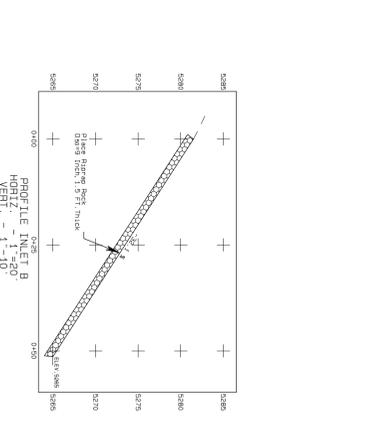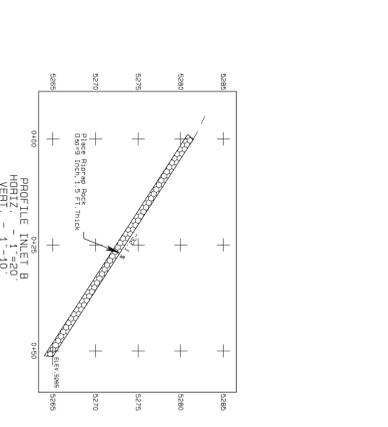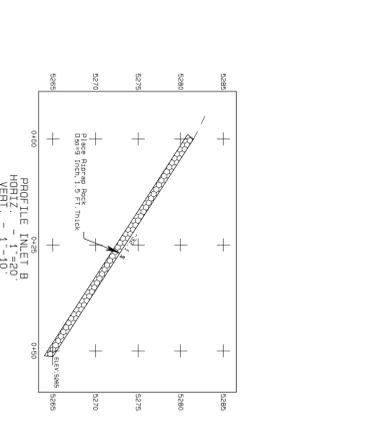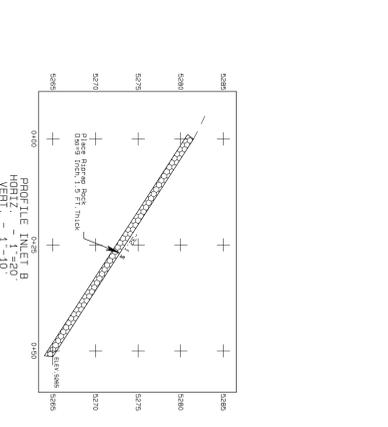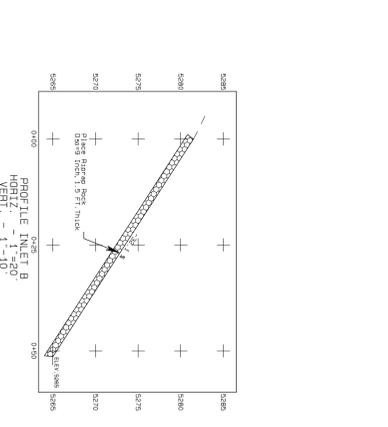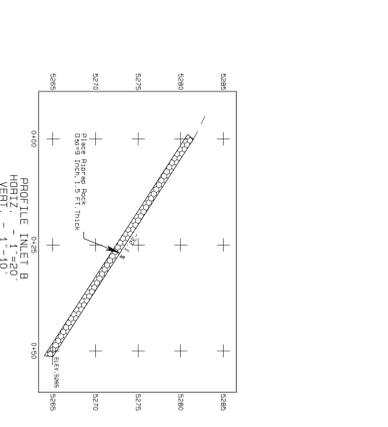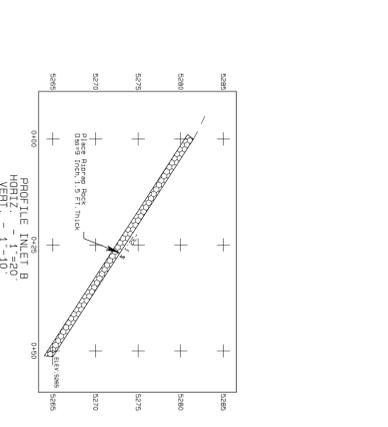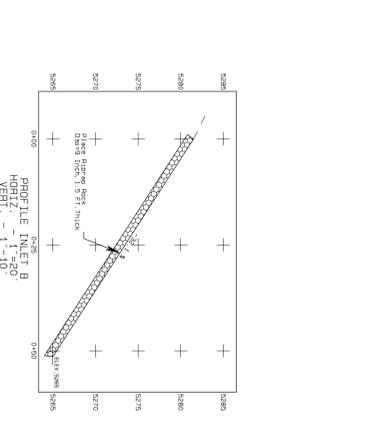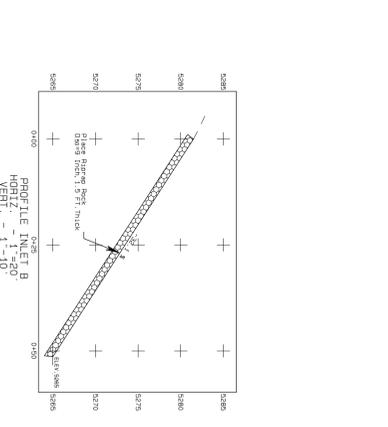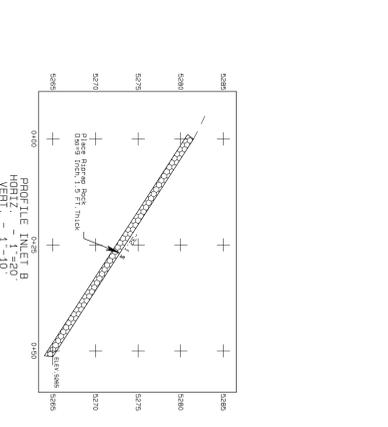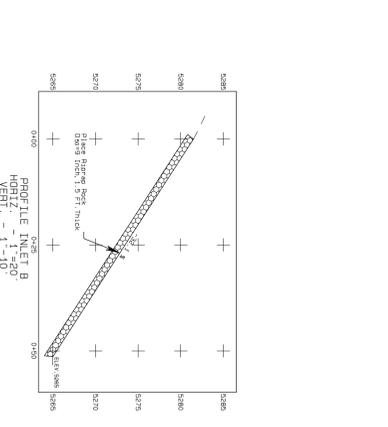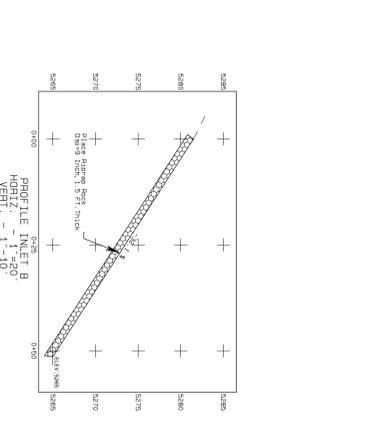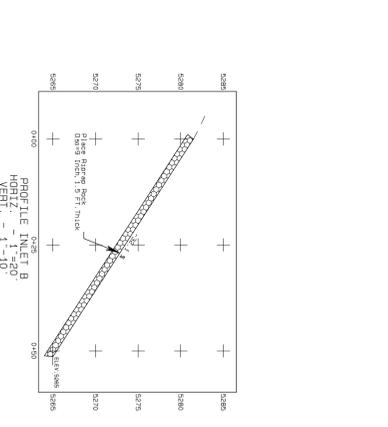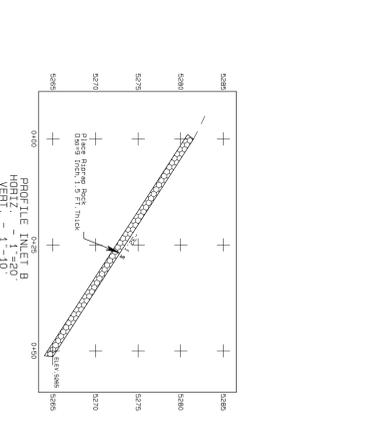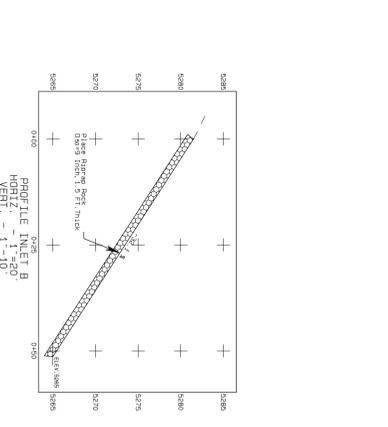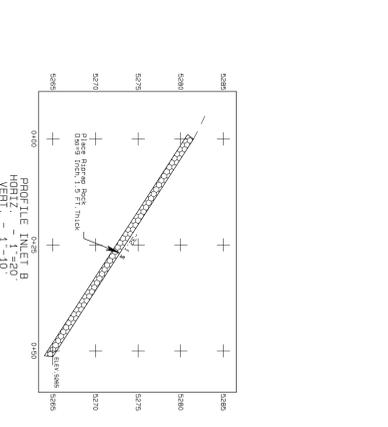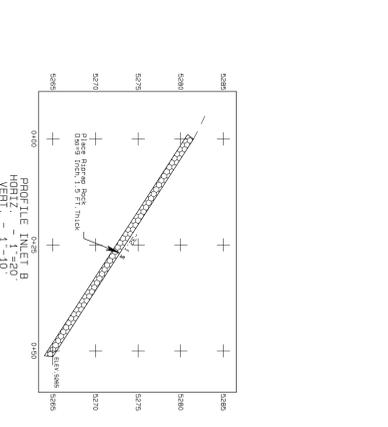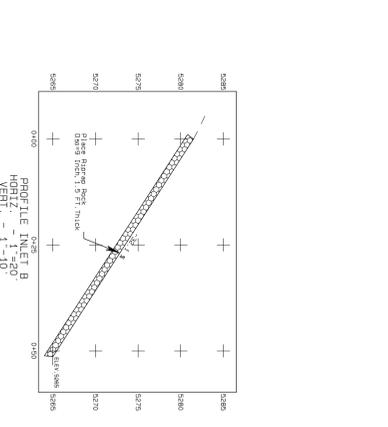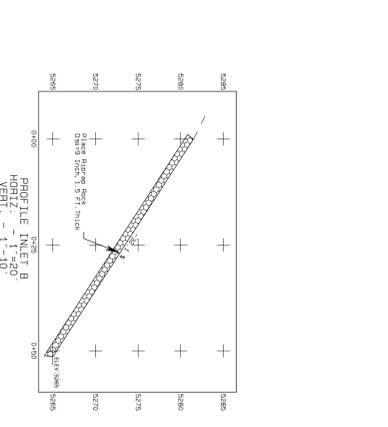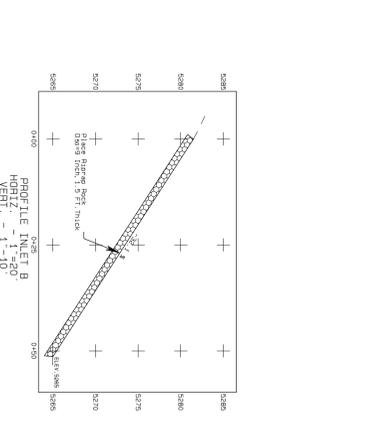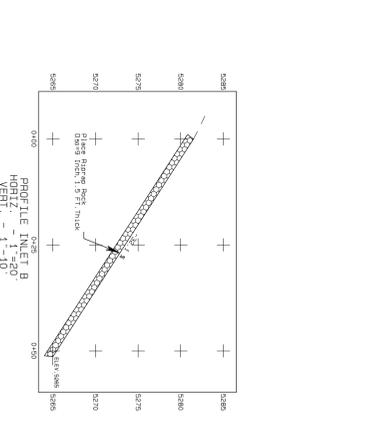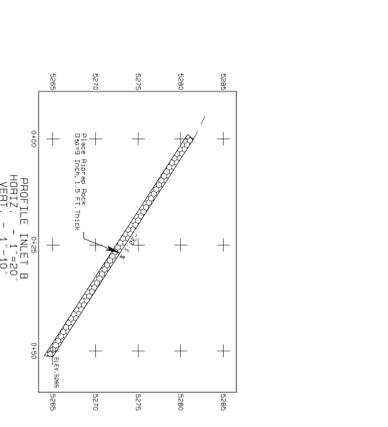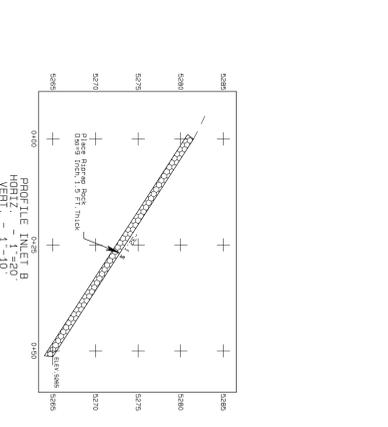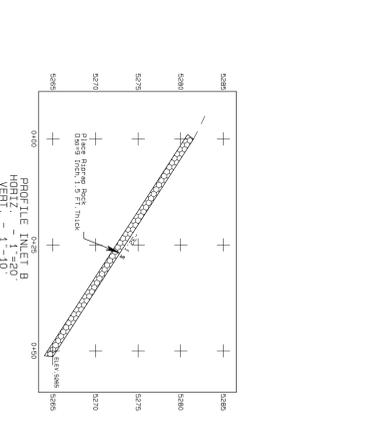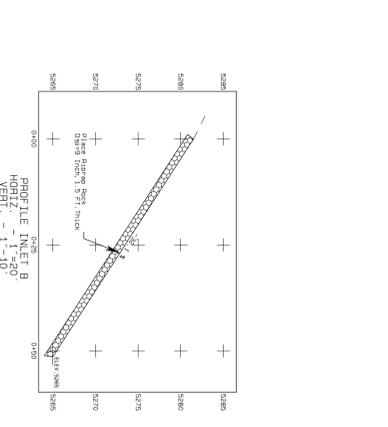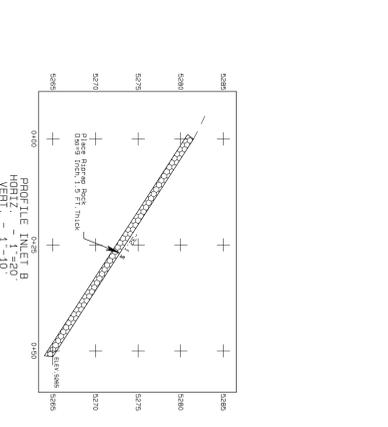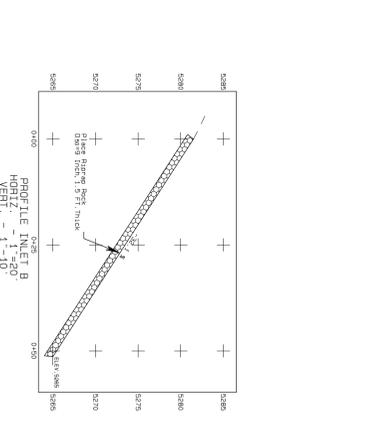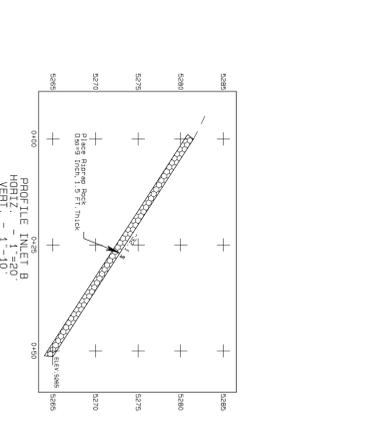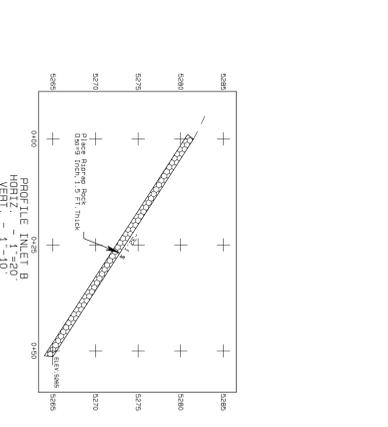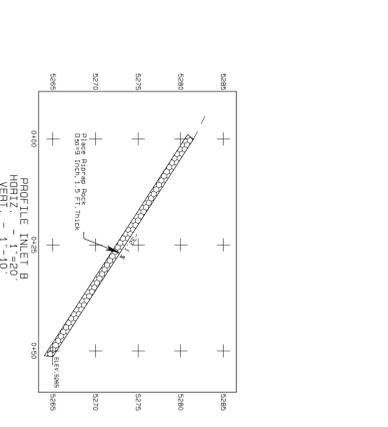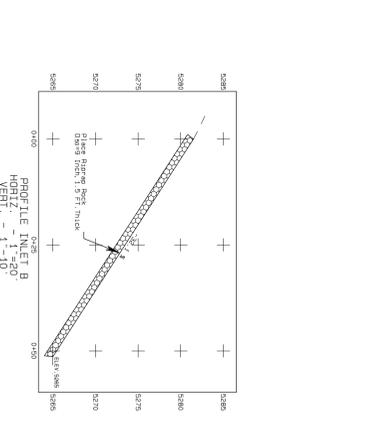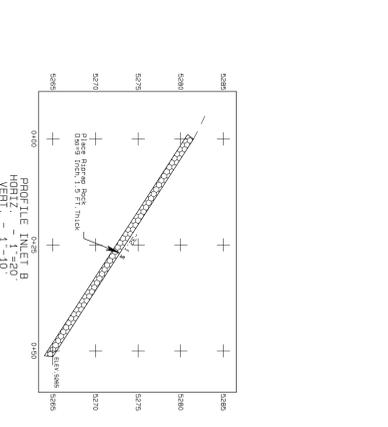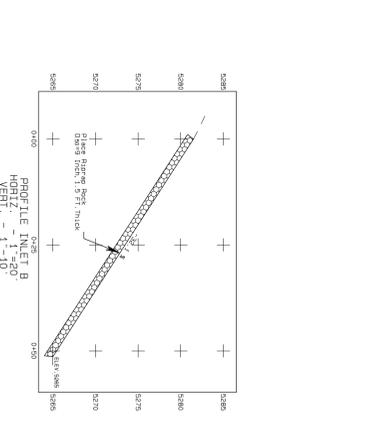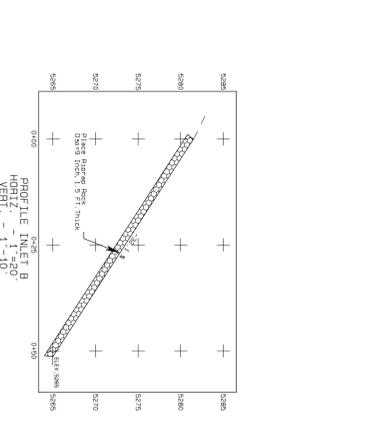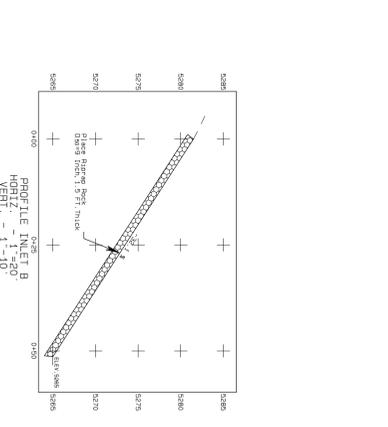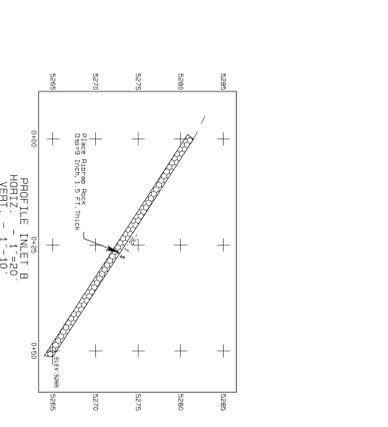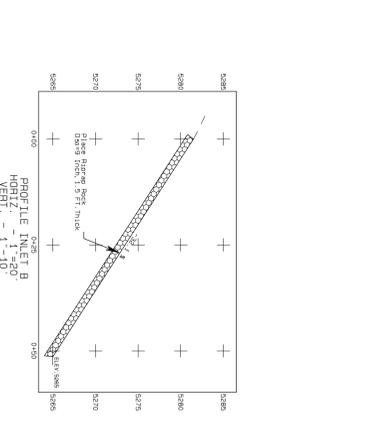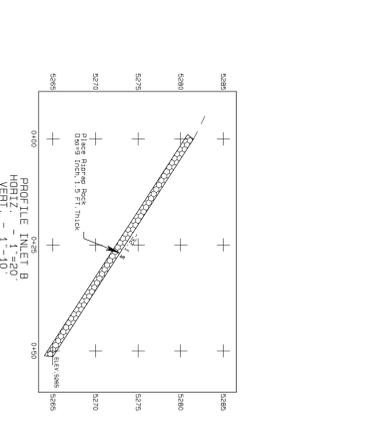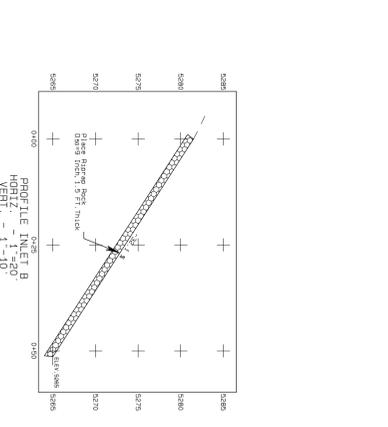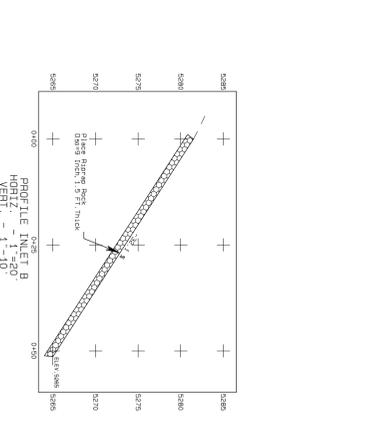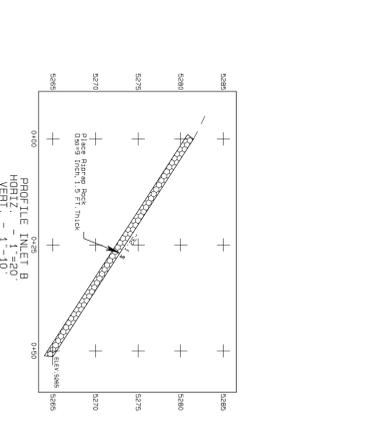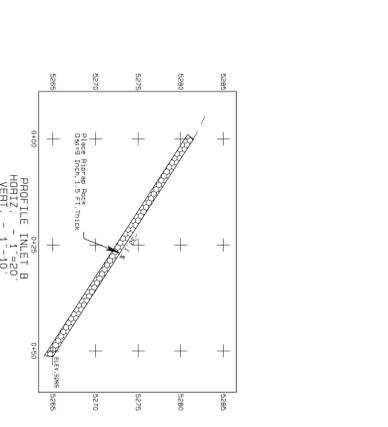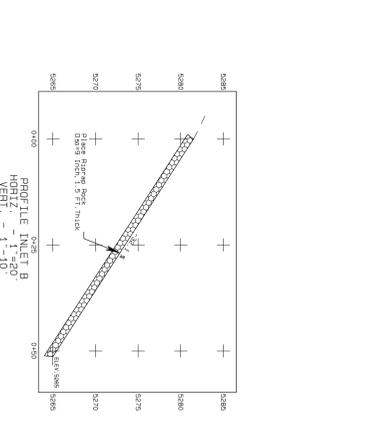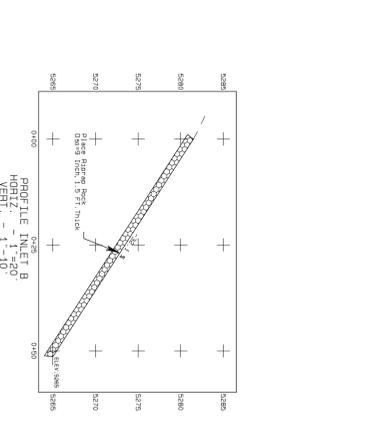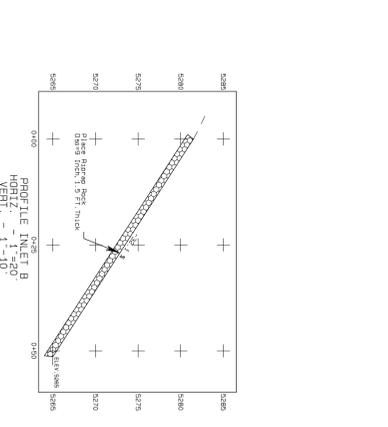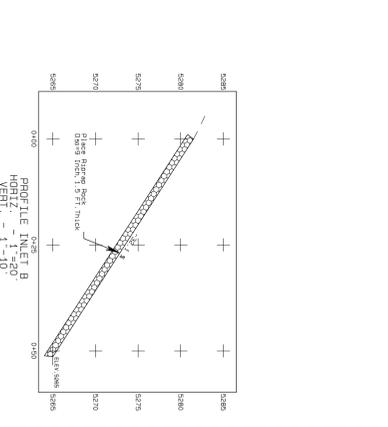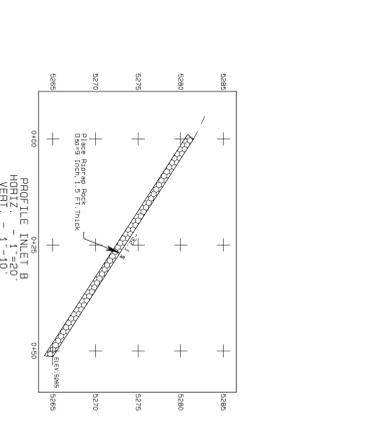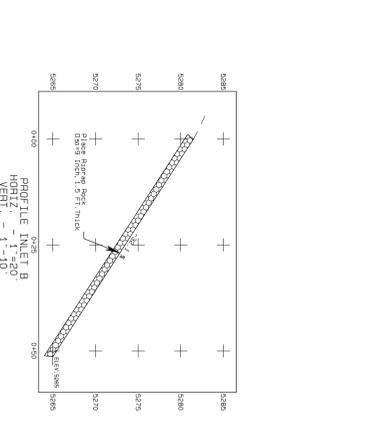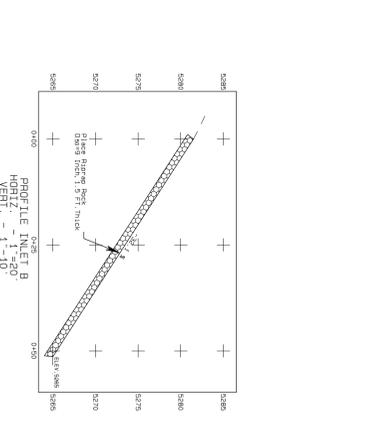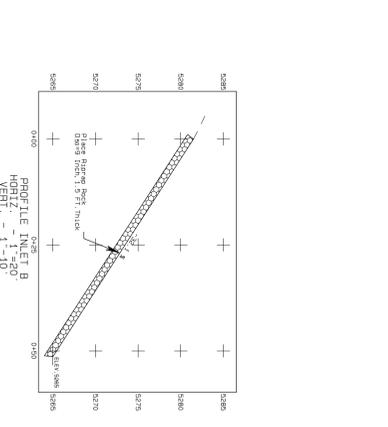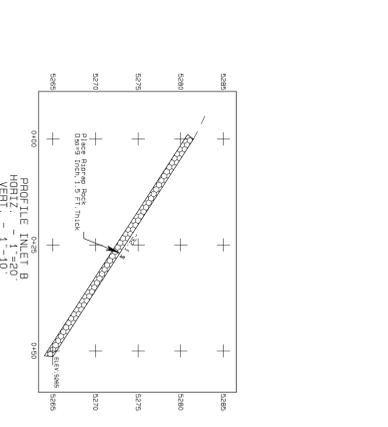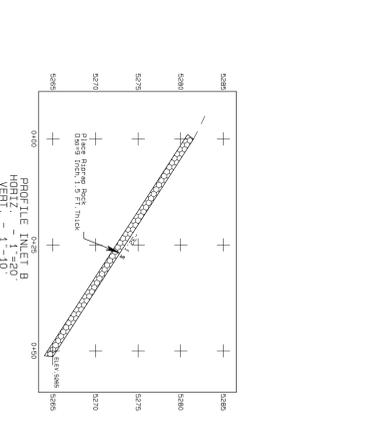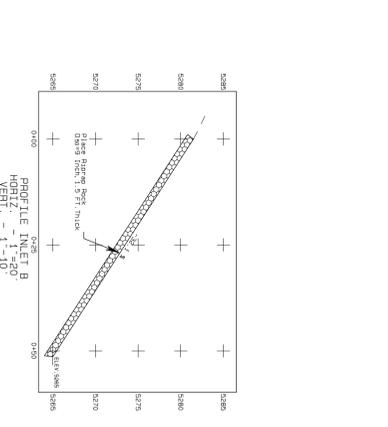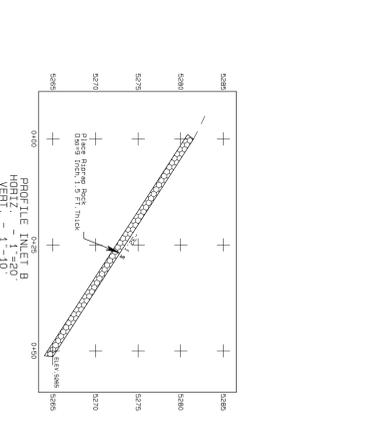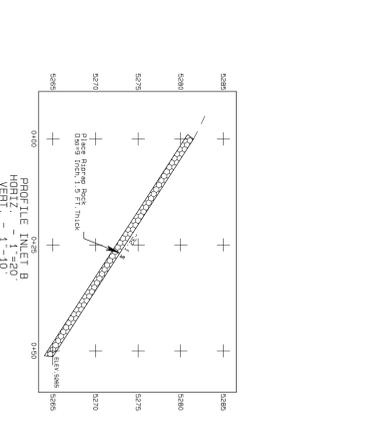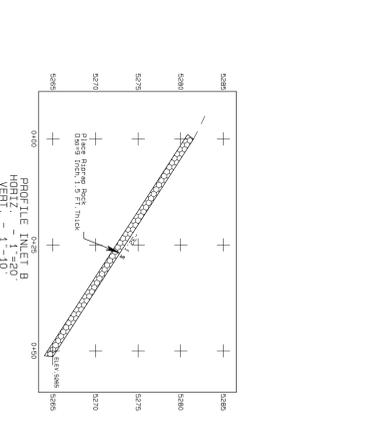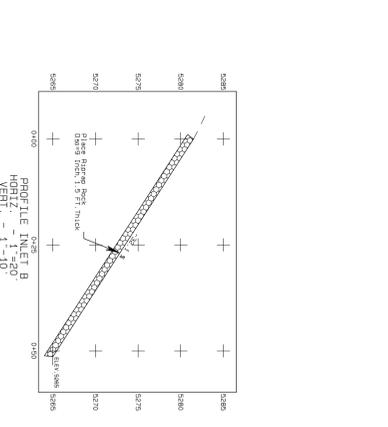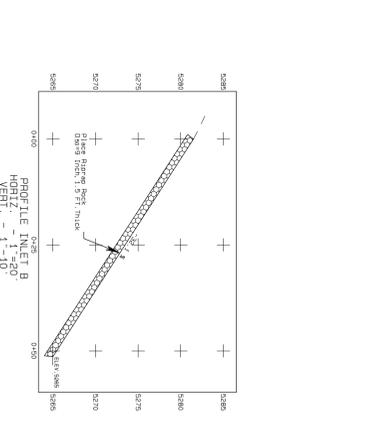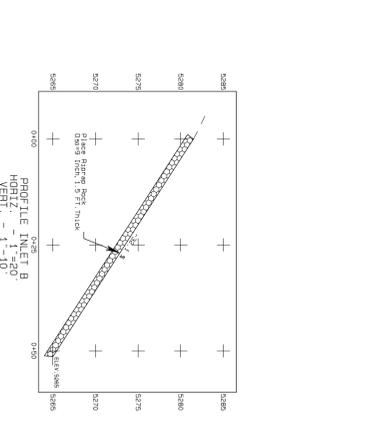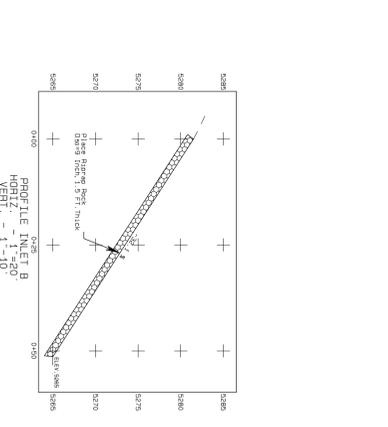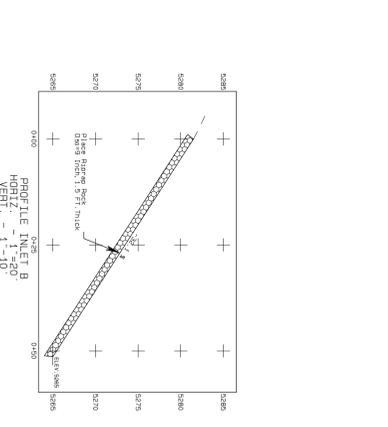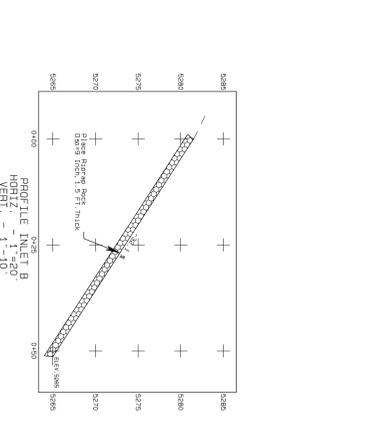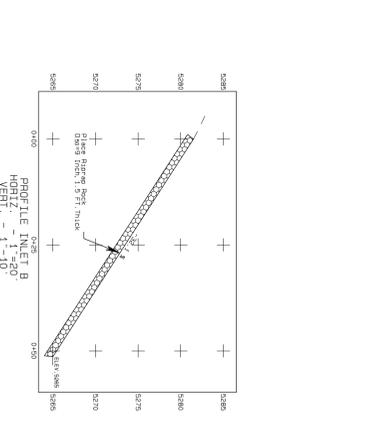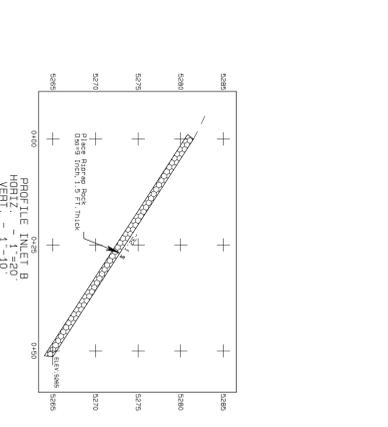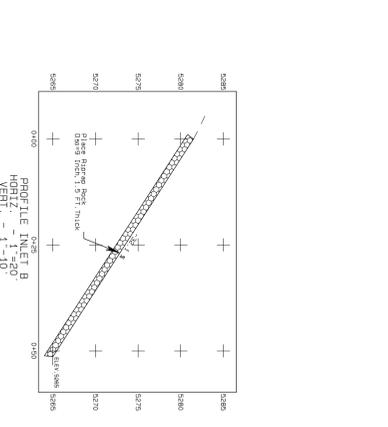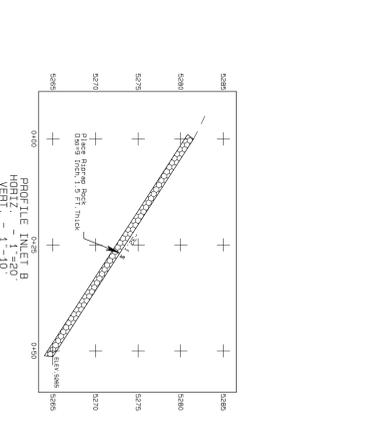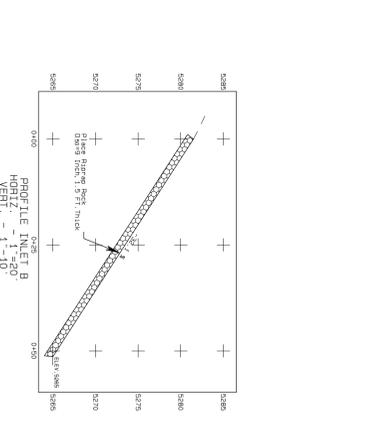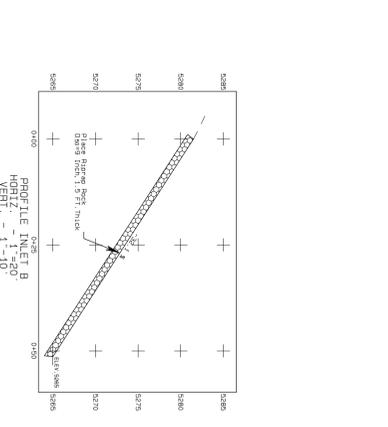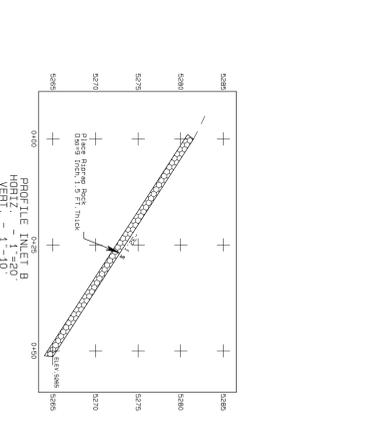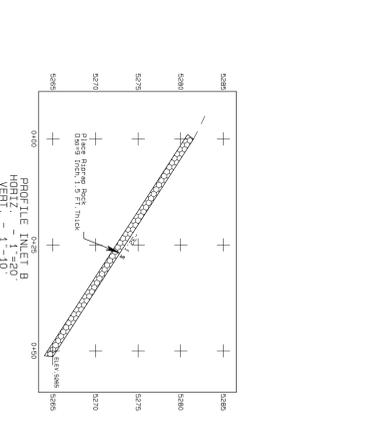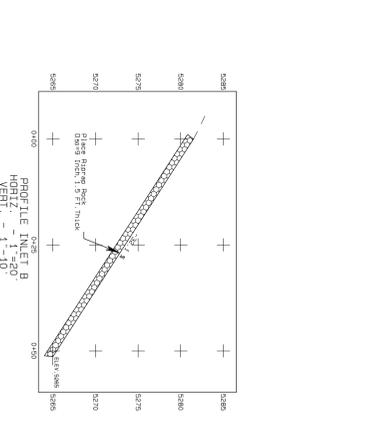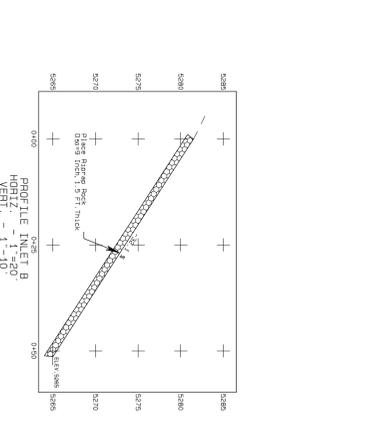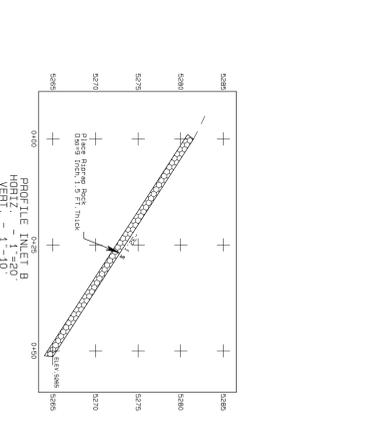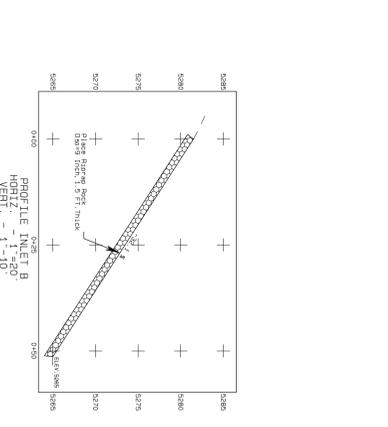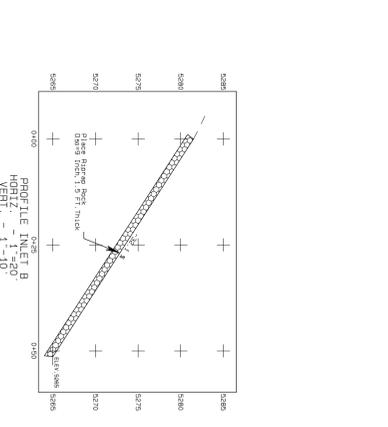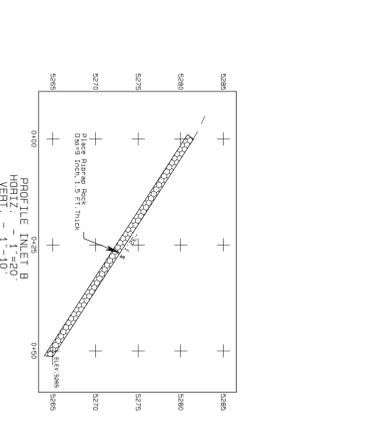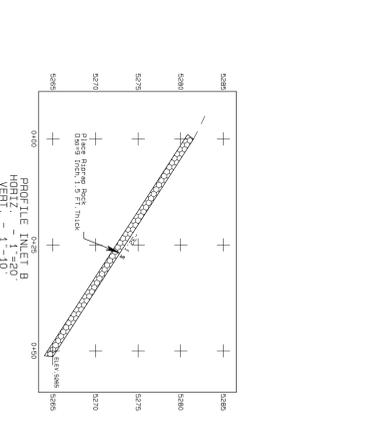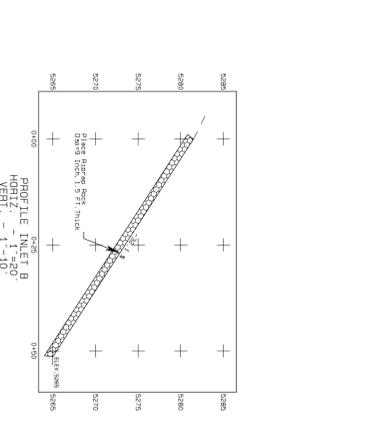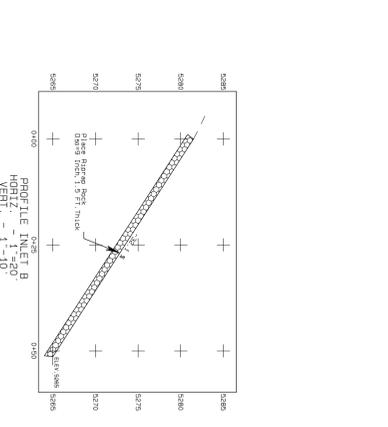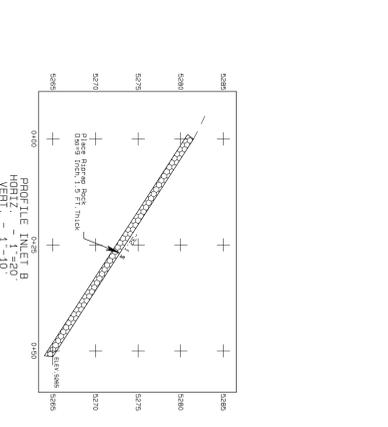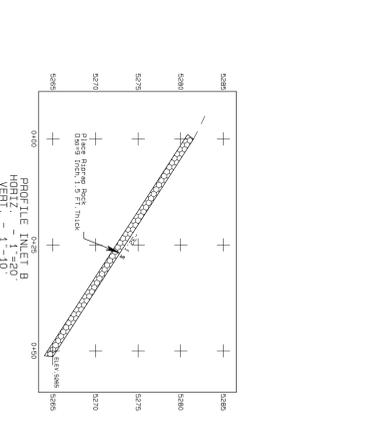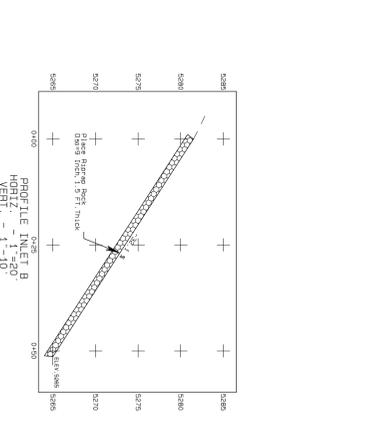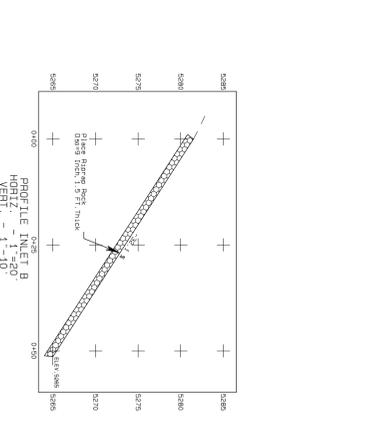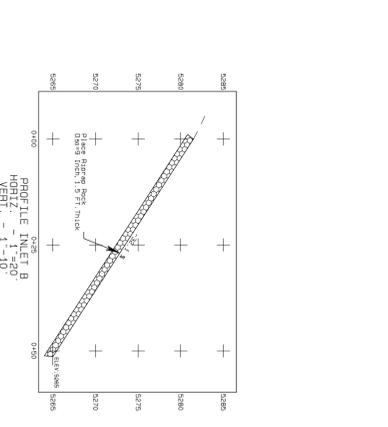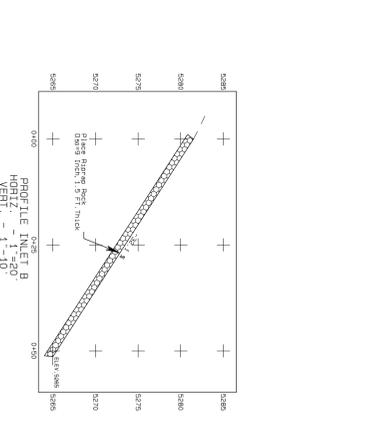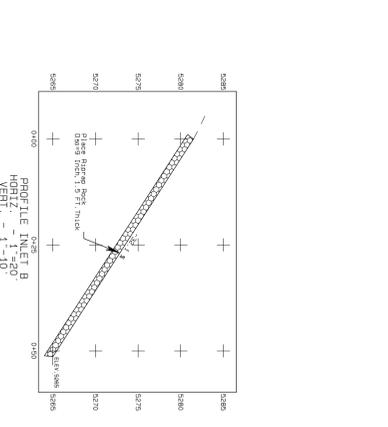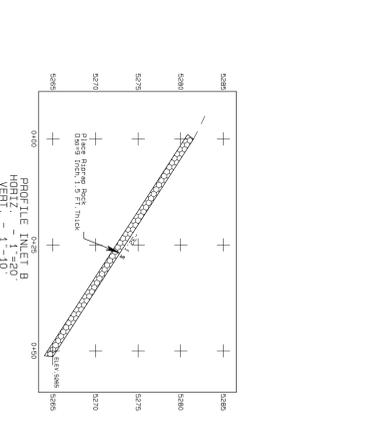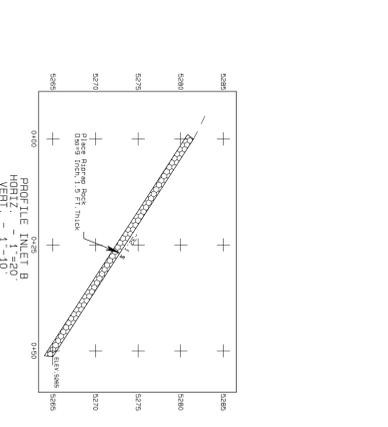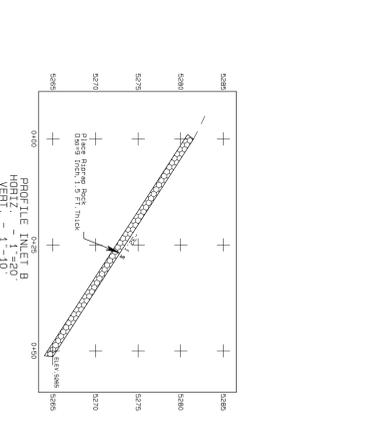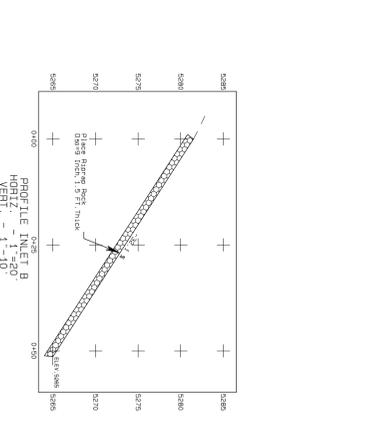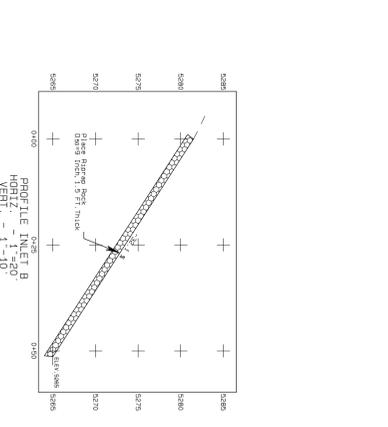

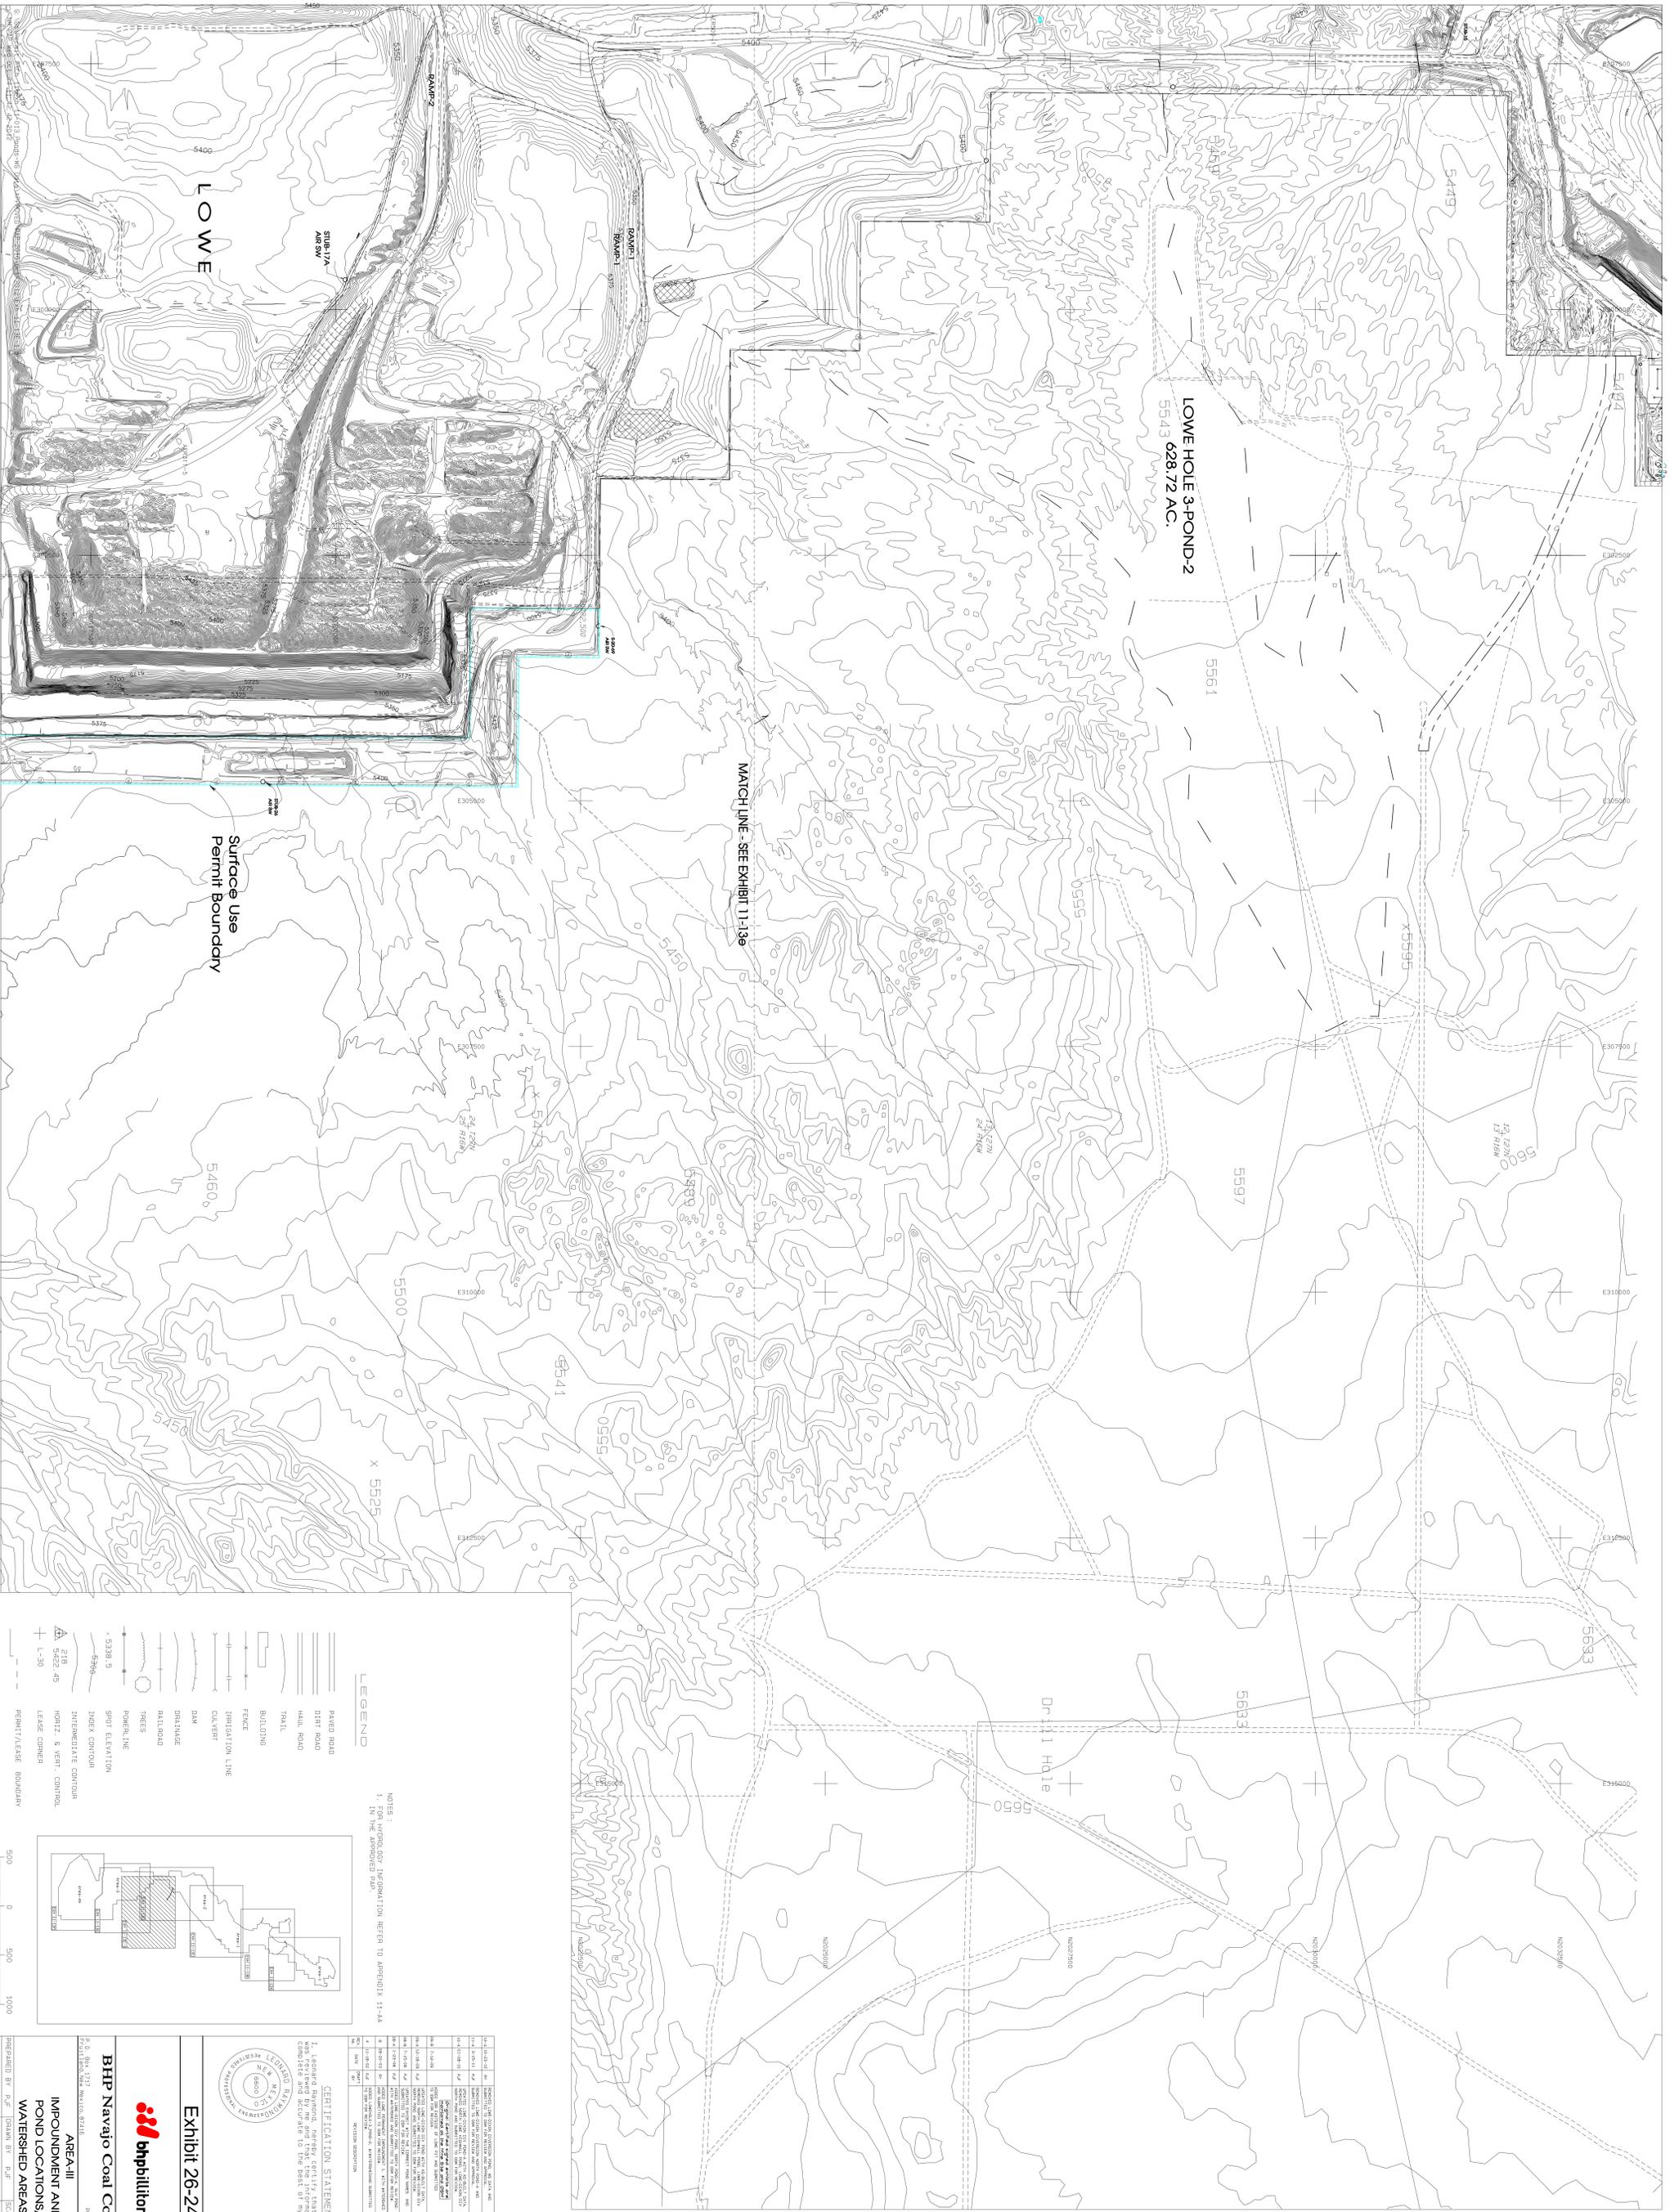

Surface Use  
Permit Boundary


LOWE HOLE 3-POND 2  
5543 628.72 AC.

MATCHLINE - SEE EXHIBIT 11-136

**LEGEND**

- PAVED ROAD
- DIRT ROAD
- WALL ROAD
- TRAIL
- BUILDING
- FENCE
- ISOLATION LINE
- CULVERT
- DAK
- DEBRIS
- RAILROAD
- TREES
- POWERLINE
- SPOT ELEVATION
- INDEX CONTOUR
- INTERMEDIATE CONTOUR
- HORIZ. 5 VERT. CONTROL
- LEAS CORNER
- PERMIT/LEASE BOUNDARY
- PONDS

NOTES:  
1. FOR HYDROLOGY INFORMATION REFER TO APPENDIX 11-44  
IN THE APPROVED PLAN.

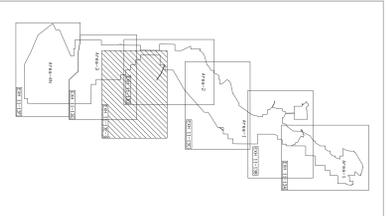

NO.	DATE	BY	REVISION
1	11/11/2010	PLF	INITIAL DESIGN
2	11/11/2010	PLF	REVISED DESIGN
3	11/11/2010	PLF	REVISED DESIGN
4	11/11/2010	PLF	REVISED DESIGN
5	11/11/2010	PLF	REVISED DESIGN
6	11/11/2010	PLF	REVISED DESIGN
7	11/11/2010	PLF	REVISED DESIGN
8	11/11/2010	PLF	REVISED DESIGN
9	11/11/2010	PLF	REVISED DESIGN
10	11/11/2010	PLF	REVISED DESIGN

**CERTIFICATION STATEMENT**

I, Richard Reynolds, hereby certify that this drawing is complete and accurate to the best of my knowledge.



Exhibit 26-24



**BHP Navajo Coal Company**

AREA-III  
IMPOUNDMENT AND  
POND LOCATIONS/  
WATERSHED AREAS

PREPARED BY: PLF  
DATE: Nov. 11, 2010  
SCALE: 1" = 500'

MAP LOCATION: (See Lower Left Corner)

MAP LOCATION (See Lower Left Corner)  
 APPROVED BY DATE NOV. 12, 2024  
 PREPARED BY AVI/AL DRAWN BY DLF SCALE 1" = 500'  
**AREA 4N  
 IMPOUNDMENT AND  
 WATERSHED AREAS**  
 BHP Navajo Coal Company  
 Project No. 1774  
 File No. 2024-0001


**EXHIBIT 26-25**

**CERTIFICATION STATEMENT**  
 I, Leonard R. Breyer, certify that the drawing is complete and accurate to the best of my knowledge.

No.	Date	Revision Description
1	11-12-24	ADDED TO THE PLAN FOR APPROVAL
2	11-12-24	ADDED TO THE PLAN FOR APPROVAL
3	11-12-24	ADDED TO THE PLAN FOR APPROVAL
Revised by Aero - Graphics, Inc.  
 40 West Oakland Avenue  
 Salt Lake City, Utah 84115

DATE OF PHOTOGRAPHY MAY, 2010  
 SCALE 1" = 500'










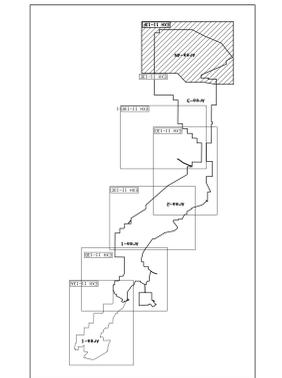


NOTES:  
 1. FOR HYDROLOGY INFORMATION REFER TO APPENDIX 11-4A

**LEGEND**

	ALL PONDS
	WATERSHED BOUNDARY
	PERMIT/LEASE BOUNDARY
	LEASE CORNER
	HORIZ. & VERT. CONTROL
	INTERMEDIATE CONTOUR
	INDEX CONTOUR
	SPOT ELEVATION
	POWER LINE
	TREES
	RAILROAD
	DRAINAGE
	DAM
	CULVERT
	IRRIGATION LINE
	FENCE
	BUILDING
	TRENCH
	HAUL ROAD
	DIRT ROAD
	PAVED ROAD




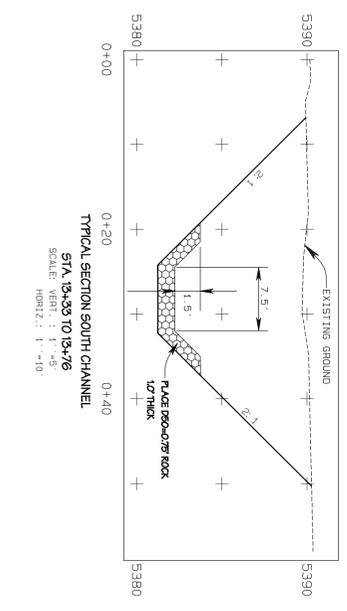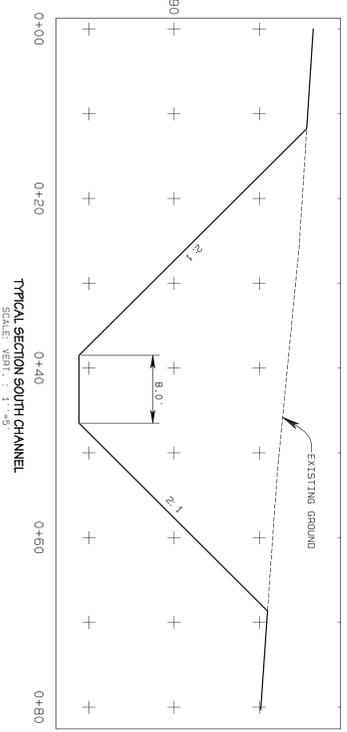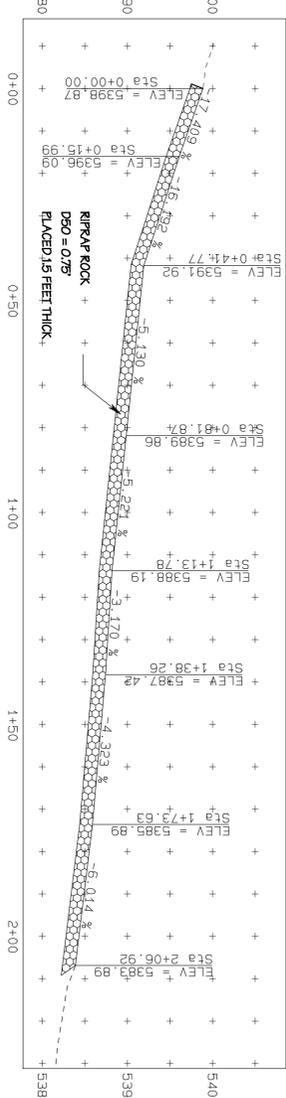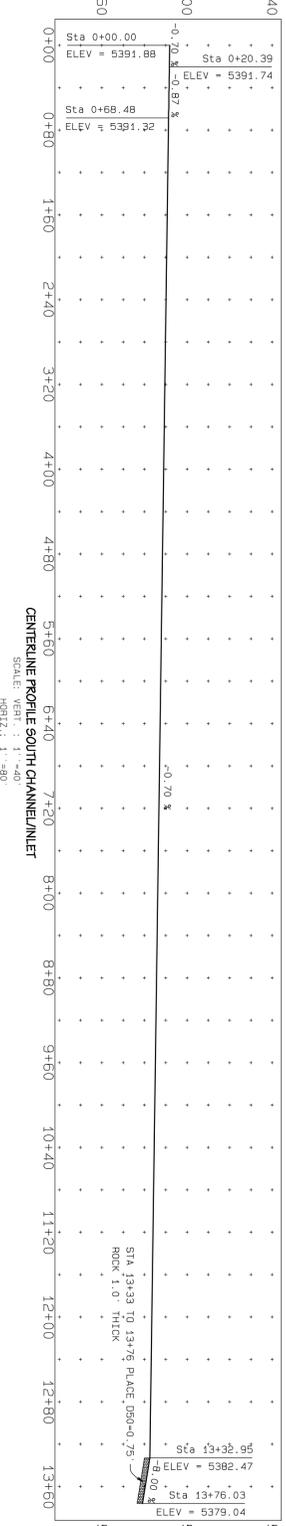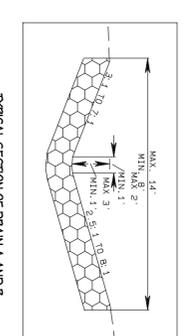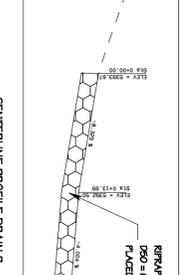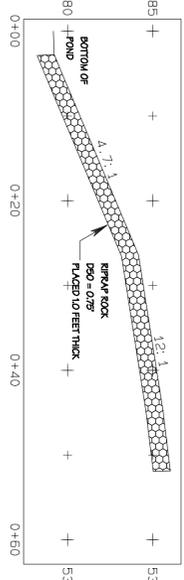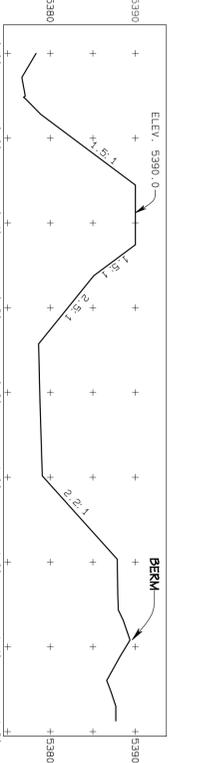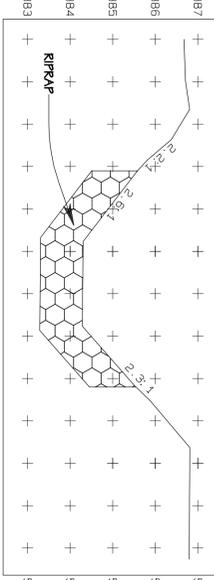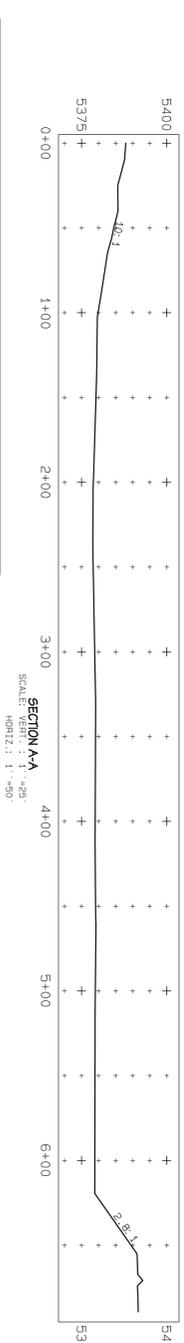

**LEGEND**

- ROAD
- WATERSHED
- BUILDING
- FENCE
- IRRIGATION LINE
- CULVERT
- DAW
- DRAINAGE
- RAILROAD
- TREES
- POWER LINE
- SPOT ELEVATION
- INDEX CONTOUR
- INTERMEDIATE CONTOUR
- LEASE LINE

- NOTES:**
- FOR HYDROLOGY AND DESIGN INFORMATION REFER TO APPENDIX 11-4A IN THE APPROVED PAP.
  - THE POND LOCATION AND WATERSHED AREA ARE PRESENTED ON EXHIBIT 11-13D.

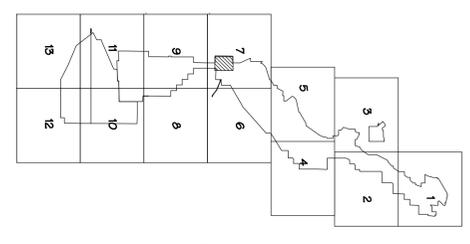

ELEV.	AREA (AC)	INC. VOLUME (AC-FT)	CUM. VOLUME (AC-FT)
5379.0	0.28	0.00	0.00
5380.0	0.48	0.38	0.38
5381.0	0.55	0.52	0.89
5382.0	0.62	0.59	1.48
5383.0	0.72	0.67	2.15
5384.0	0.83	0.77	2.92
5385.0	0.96	0.89	3.82
5386.0	1.10	1.03	4.84
5387.0	1.23	1.23	6.08
5388.0	1.50	1.64	7.71
5389.0	2.85	2.98	10.09
5390.0	3.35	3.10	13.19

**CERTIFICATION STATEMENT**

I, LEONARD RAYMOND, HEREBY CERTIFY THAT THIS DRAWING WAS REVIEWED BY ME AND THAT THE INFORMATION SHOWN IS ACCURATE AND COMPLETE TO THE BEST OF MY KNOWLEDGE.



EXHIBIT 26-26  
MASON POND MODIFICATION  
DESIGN

PLAN, PROFILE, AND SECTIONS

PROJECT:  
DATE:  
DESIGNED BY: Leonard Raymond  
DRAWN BY: P. Foster  
CHECKED BY: L. Raymond  
APPROVED BY: L. Raymond

**bhpbillton**  
**NAVAJO COAL COMPANY**  
**NAVAJO MINE**

PROJECT MANAGER: Ferguson Gorman  
ENGR. of RECORD: Leonard Raymond  
REG. NO: NM-5600  
SHYVA of RECORD: Wilson Begay  
REG. NO: NM-18628

REVISION	DATE
11-A Modified Mason Pond and submitted to GCM for Review.	Jan. 18, 2011


SHEET 1  
OF 1

- LEGEND
- PAVED ROAD
  - DIRT ROAD
  - HAUL ROAD
  - TRAIL
  - BUILDING
  - FENCE
  - IRRIGATION LINE
  - CULVERT
  - DAM
  - DRAINAGE
  - RAILROAD
  - TREES
  - POLES
  - SPOT ELEVATION
  - INDEX CONTOUR
  - INTERMEDIATE CONTOUR
  - HORIZ. & VERT. CONTROL
  - LEASE CORNER
  - GAUGE POST


**Emma's pond**

Elevation	Contour Area (Ac)	Incremental Volume (Ac-ft)	Cumulative Volume (Ac-ft)	Reserve Volume (Ac-ft)
5354.7	0.00	0.00	0.00	10.24
5355.0	0.16	0.02	0.02	10.22
5356.0	1.33	0.75	0.77	9.47
5357.0	2.00	1.67	2.43	7.81
5358.0	2.50	2.25	4.68	5.56
5359.0	2.79	2.65	7.33	2.91
5360.0	3.03	2.91	10.24	-0.00

CAPACITY @ 5359.8 - 9.66 Ac-Ft

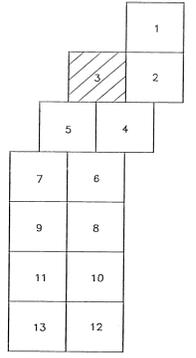

- NOTES:
- REFER TO APPENDIX 11-D FOR HYDROLOGY DATA
  - WATERSHED AREA IS PRESENTED ON EXHIBIT 11-13B

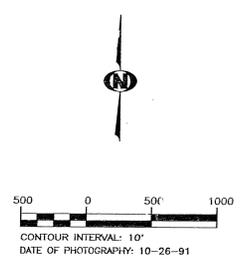

Prepared by  
**SEARCH**  
 Denver, Colorado

**BHP MINERALS INTERNATIONAL**  
 NAVAJO MINE  
 FRUITLAND, NEW MEXICO

**EMMA'S POND "AS-BUILT"**  
**EXHIBIT 26-27**




**Construction Certification**

In November 1991, this structure required sediment removal to maintain storage capacity according to the approved design. This exhibit accurately describes the structure after sediment removal. The structure remains in accordance with the approved design except for these noted changes:




- Storage capacity increased from 6.5 ac-ft to 10.2 ac-ft.
- Embankment width increased 15 feet.
- The drop inlet box and culvert have been plugged closed. The design runoff volume of 5.9 ac-ft from the 100-yr 6-hr storm will be kept available. The volume will be maintained within 10 days after a storm event by pumping water from the pond to a nearby pond with available storage capacity or into water trucks for haulroad dust suppression.

REV. NO.	DATE	REVISIONS	APPROVALS			
			DESIGNER	CHECKER	ENGINEER	PROJECT MGR.
1	8/24/98	CHANGE ELEV. NA TO 11-23 AND CO NAME	JL			
2	7-30-94	LOOSE AS FULL OVERFLOW LOCATION AND SECTIONS D-D' AND E-E'	PJF	LR		
3	4-14-94	UPDATED EXHIBIT AND SUBMITTED TO OSM FOR REVIEW	PJF	LR		


DRAWN BY SEP SCALE 1" = 50'  
 APPROVED BY DATE 01/23/92  
 DRAWING NO. LOCATION NO 11F-02

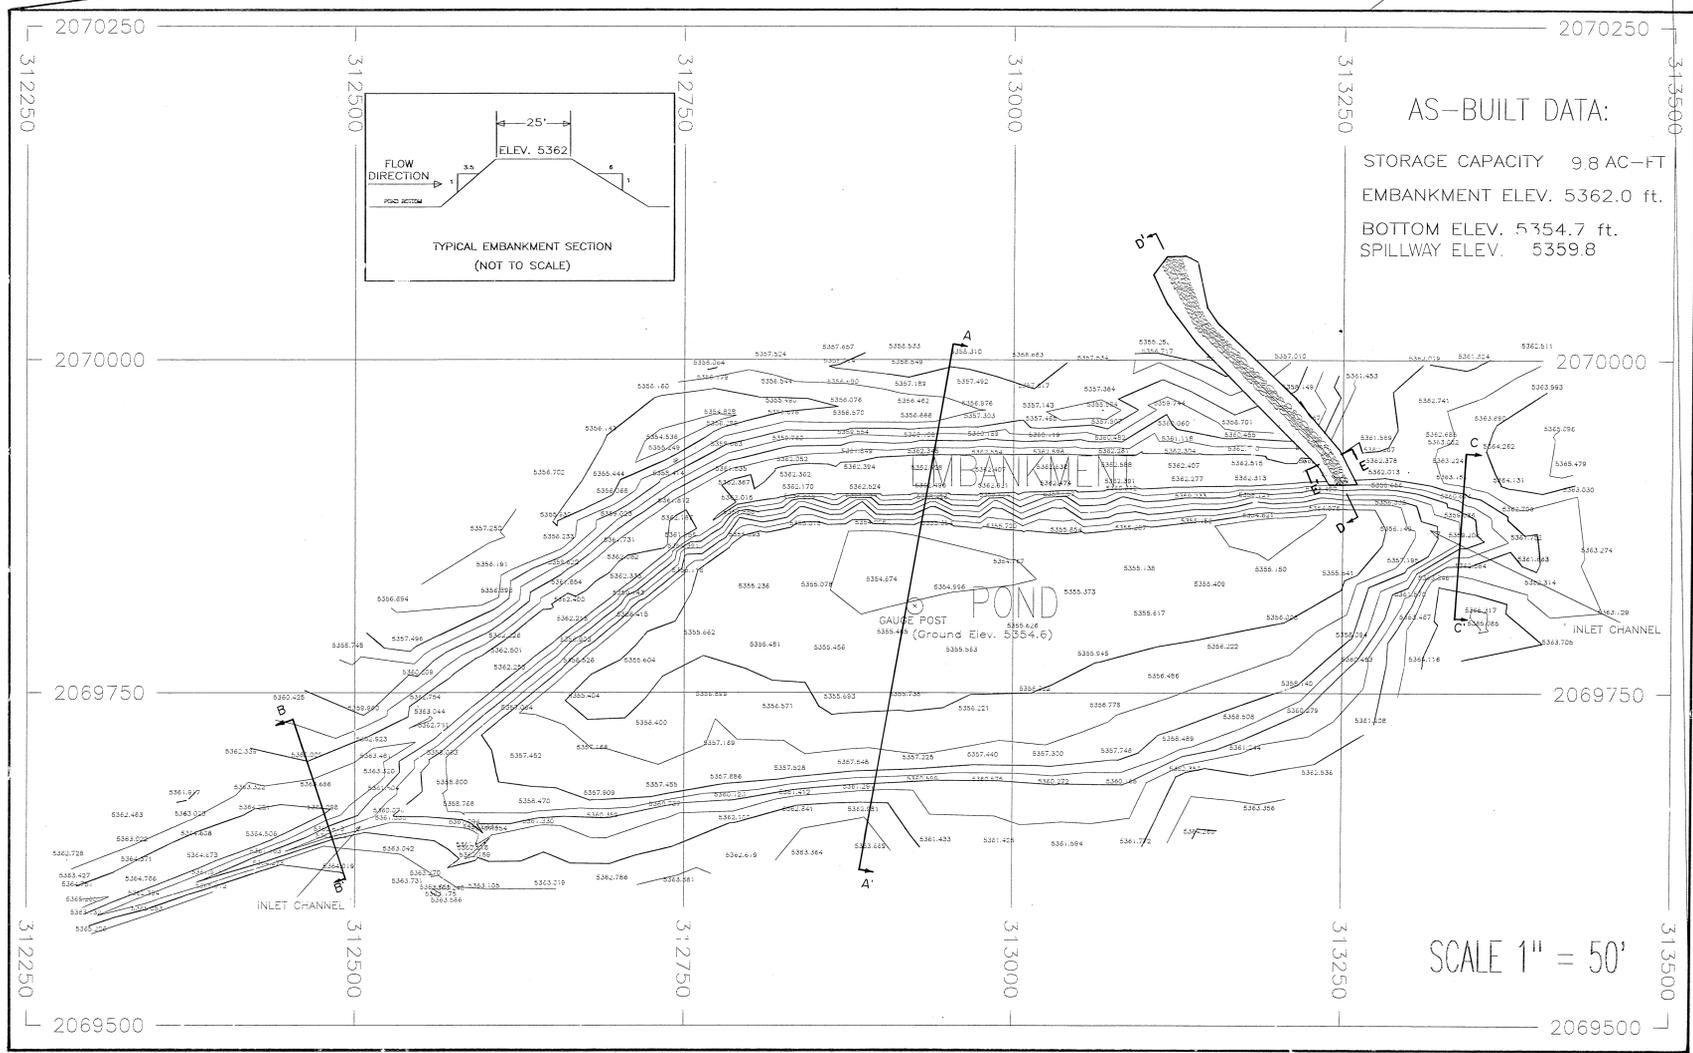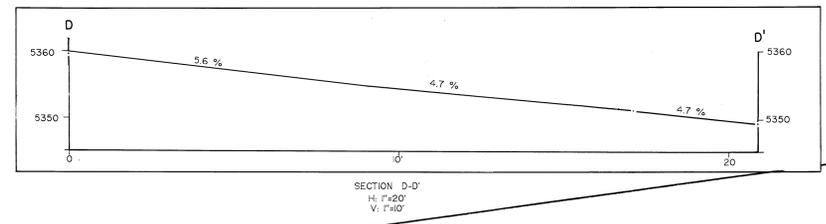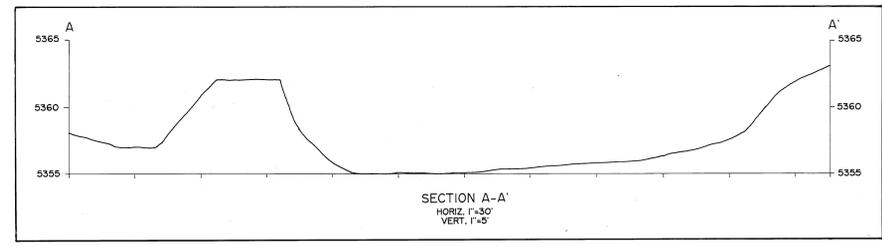


SCALE 1" = 50'

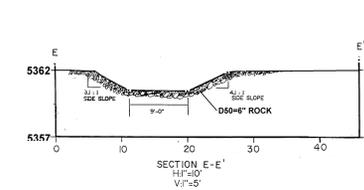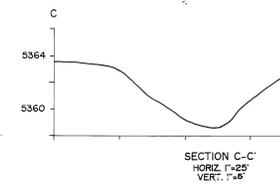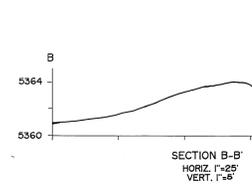



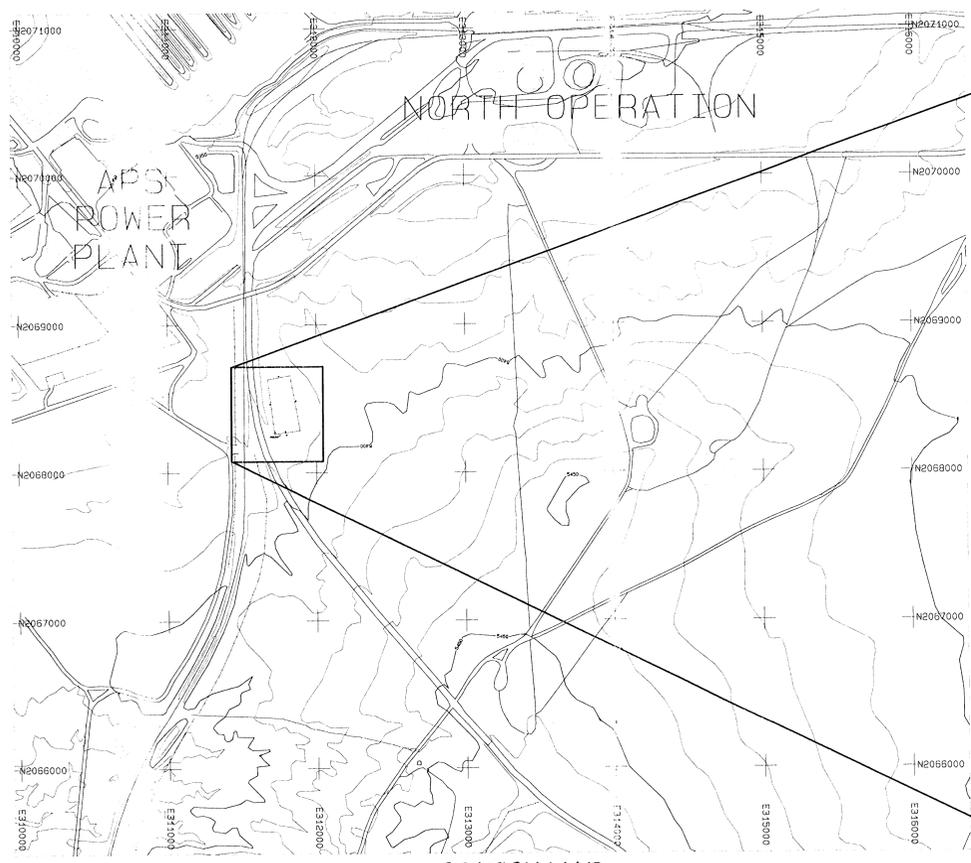

LOCATION MAP  
SCALE 1"=400 FT.

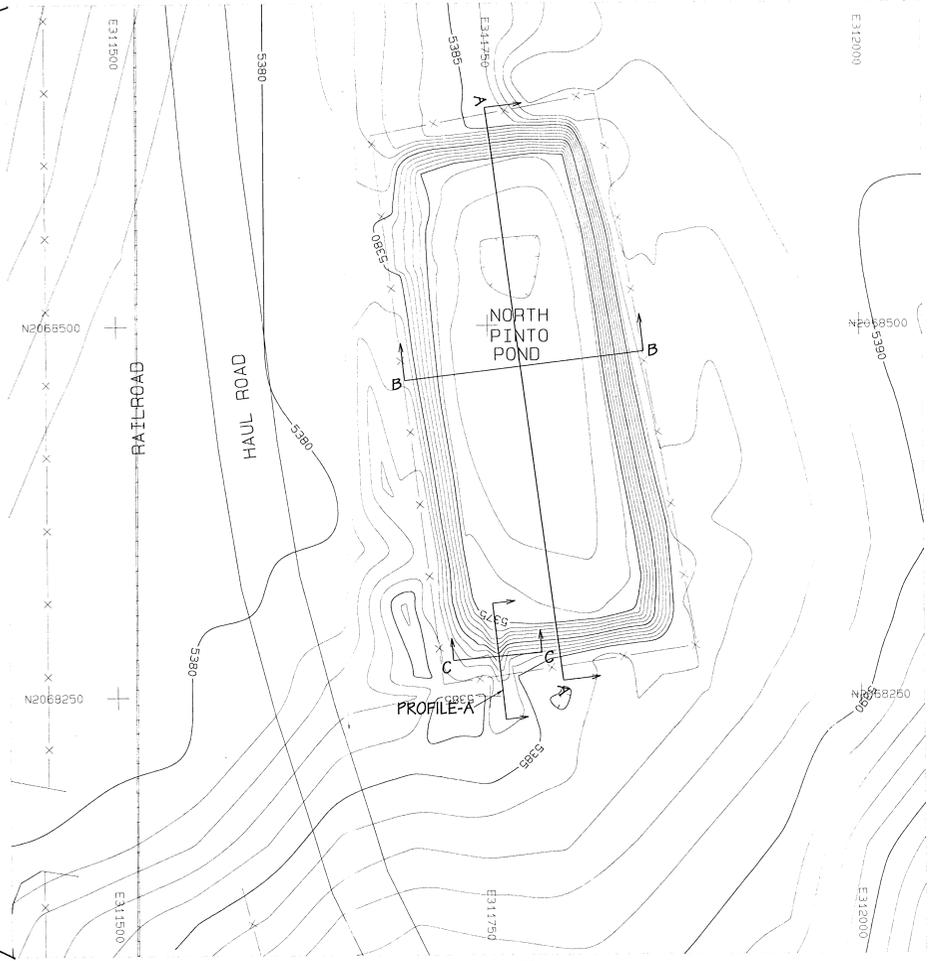

SCALE 1"=40 FT.


**LEGEND**

- ROAD
- WATERSHED
- BUILDING
- FENCE
- IRRIGATION LINE
- CULVERT
- DAM
- DRAINAGE
- RAILROAD
- TREES
- POWERLINE
- SPOT ELEVATION
- INDEX CONTOUR
- INTERMEDIATE CONTOUR
- LEASE CORNER





**STAGE STORAGE DATA**

ELEV feet	AREA acres	VOLUME ac-ft	CUM. VOLUME ac-ft
5372	0.32	0.00	0.00
5373	0.43	0.23	0.23
5374	0.68	0.95	0.78
5375	0.78	0.74	1.52
5376	0.83	0.81	2.34
5377	0.98	0.86	3.20
5378	0.93	0.91	4.11
5379	0.98	0.95	5.07
5380	1.03	1.01	6.08

- NOTES**
- For hydrology and design information refer to Appendix 11-5 in the approved PAP.
  - Spotline Elevations can be found in Table 11-5f.
  - Gauge Post base Elevation: 5372.18 (GPS).

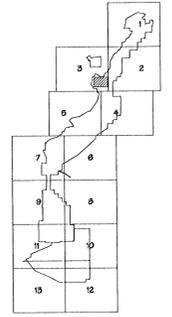

**CERTIFICATION STATEMENT**  
I, Leonard Raymond, hereby certify that this drawing was reviewed by me and that the information shown is complete and accurate to the best of my knowledge.

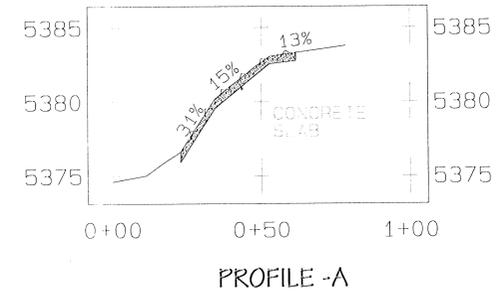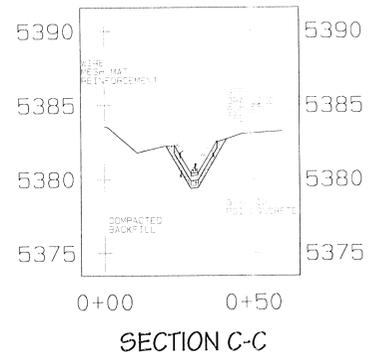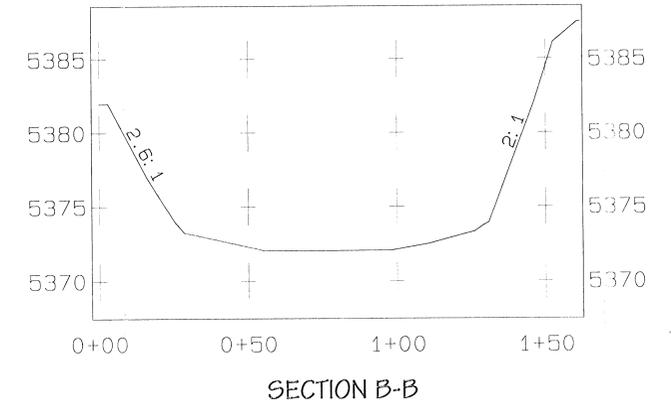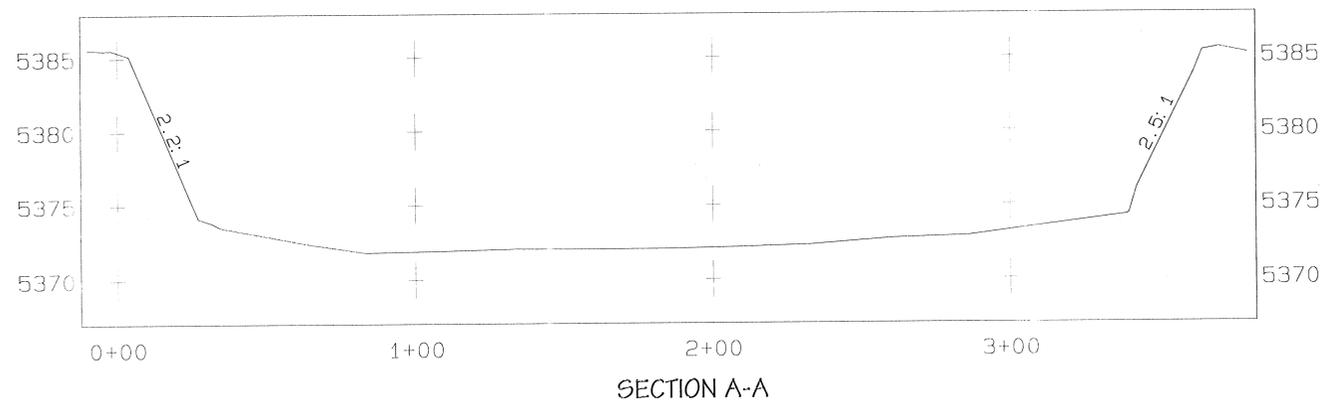


SECTIONS AND PROFILE SCALE - HORIZONTAL 1"=20 FT.  
VERTICAL 1"=4 FT.

REV.	DATE	BY	DESCRIPTION	ENG.	C.C.	P.E.	P.T.
1	05/10/98	BY	RE-SURVEYED AND RE-ASBUILT				
2	1-27-99	PJP	CORRECTED SECTION LABELS				


**EXHIBIT 26-29**  
**NAVAJO COAL COMPANY**  
NAVAJO MINE  
P.O. BOX 195 FRIETLAND, NEW MEXICO 87416

**NORTH PINTO POND AS-BUILT**

PREPARED BY LR	DRAWN BY RY	SCALE AS NOTED
APPROVED BY LR	DATE 05/05/98	REF DWG
DWG LOC J:\NEW_SHOW\PER_0808\04_11\1198 pond AS-BUILT\EXHIBIT26-29.DWG		

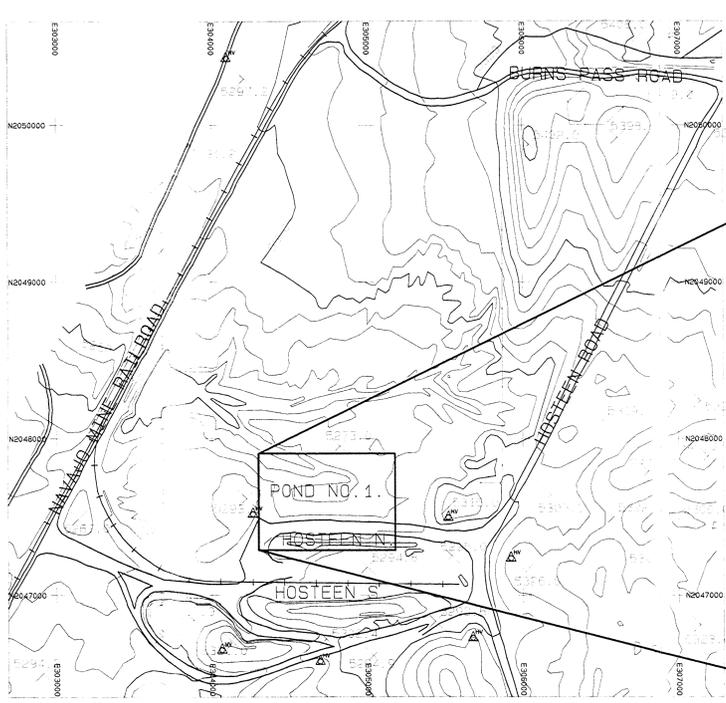

**LOCATION MAP**  
SCALE: 1"=400 FT.

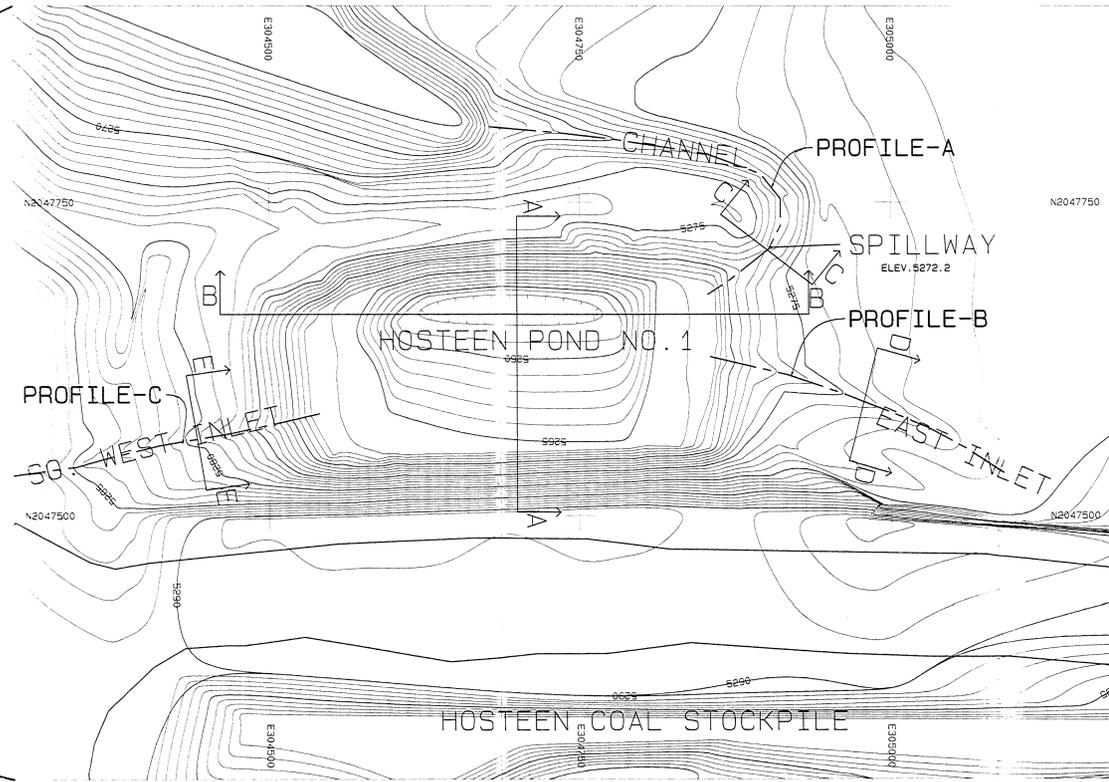

SCALE: 1"=50 FT.



**LEGEND**

- ROAD
- WATERSHED
- BUILDING
- FENCE
- IRRIGATION LINE
- CULVERT
- DAM
- DRAINAGE
- RAILROAD
- TREES
- POWERLINE
- X 5338.5 SPOT ELEVATION
- 5300 INDEX CONTOUR
- 5258 INTERMEDIATE CONTOUR
- L-30 LEASE CORNER


**STAGE STORAGE DATA**

ELEV. FEET	AREA ACRES	VOLUME AC-FT	CUM. VOLUME AC-FT
5258	0.08	0.00	0.00
5259	0.15	0.11	0.11
5260	0.22	0.28	0.30
5261	0.29	0.56	0.55
5262	0.38	0.94	0.89
5263	0.47	1.42	1.32
5264	0.56	2.02	1.83
5265	0.66	2.73	2.45
5266	0.91	3.79	3.24
5267	1.05	5.08	4.29
5268	1.12	6.60	5.33
5269	1.19	8.36	6.49
5270	1.26	10.33	7.72
5271	1.34	12.52	9.03
5272	1.42	14.93	10.42


- NOTES**
- For hydrology and design information refer to Appendix 11-AA in the approved PAP.
  - Blue line elevations can be found in Table 11-5K.
  - Gauge Post Base Elevation: 5257.8 FT. (GPS)

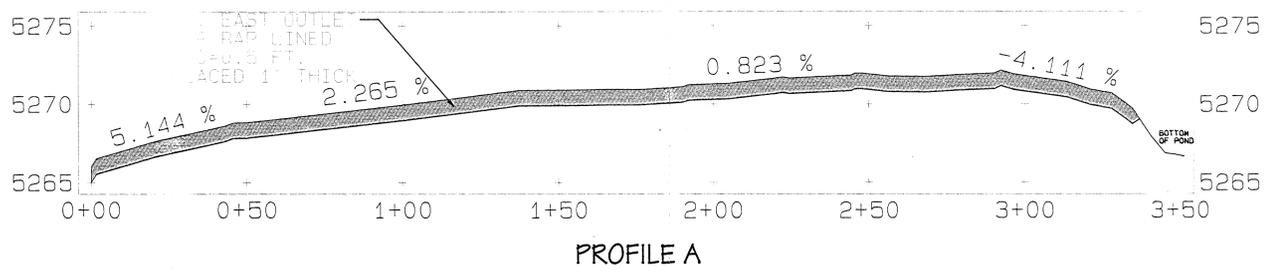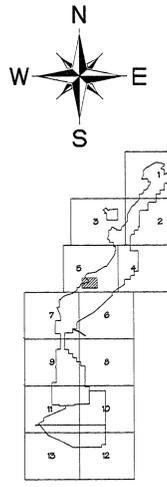


**PROFILE A**

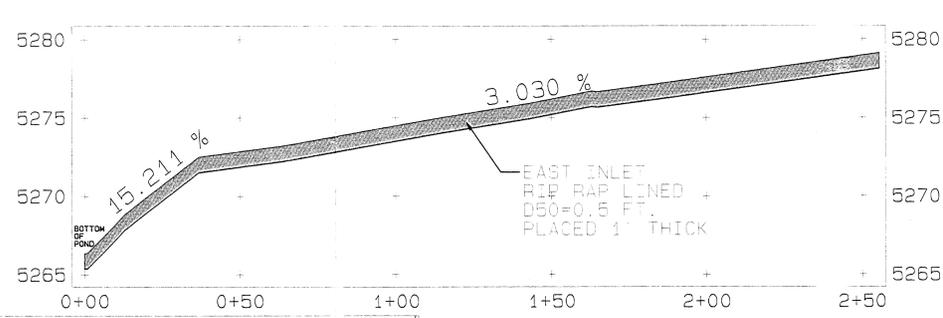


**PROFILE B**

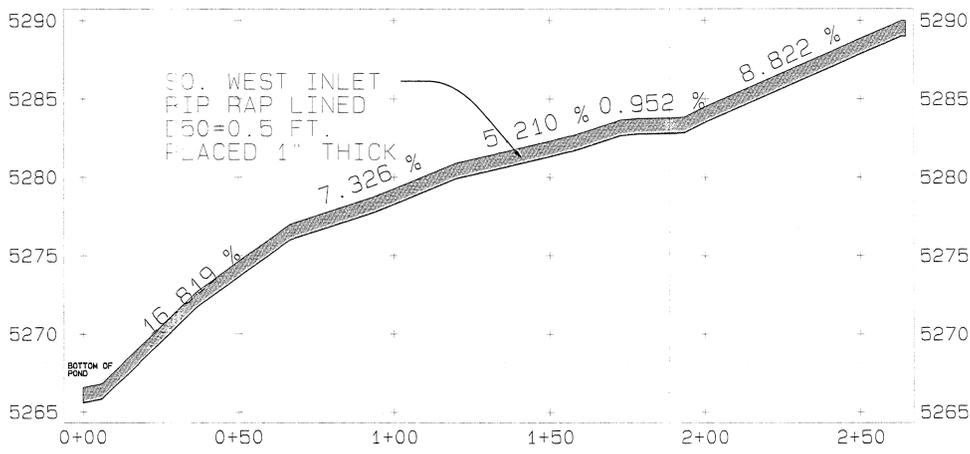


**PROFILE C**

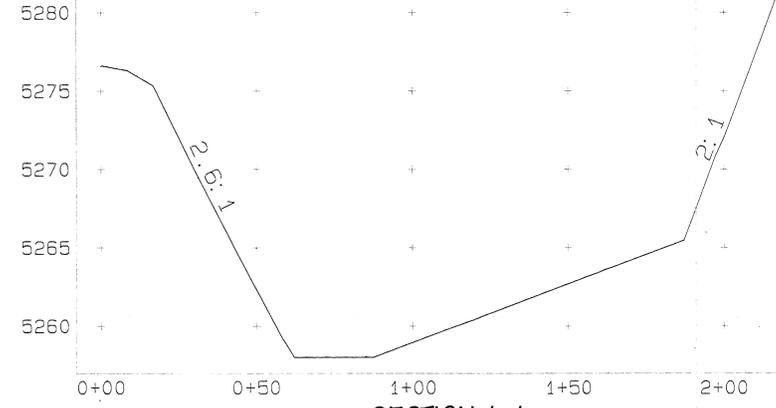


**SECTION A-A**

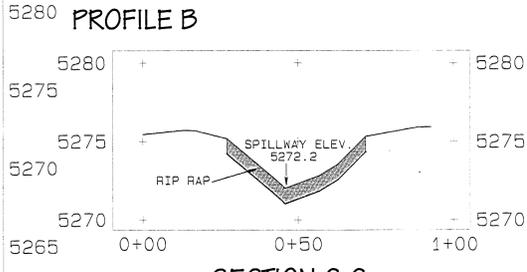


**SECTION C-C**

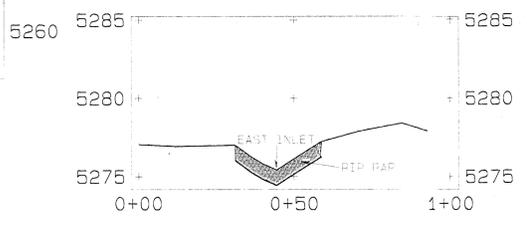

**SECTION D-D**

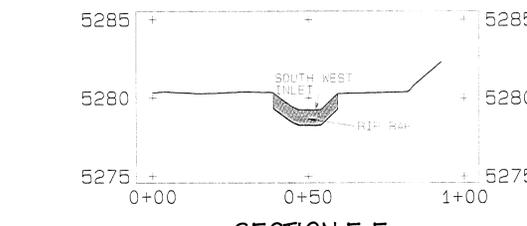

**SECTION E-E**

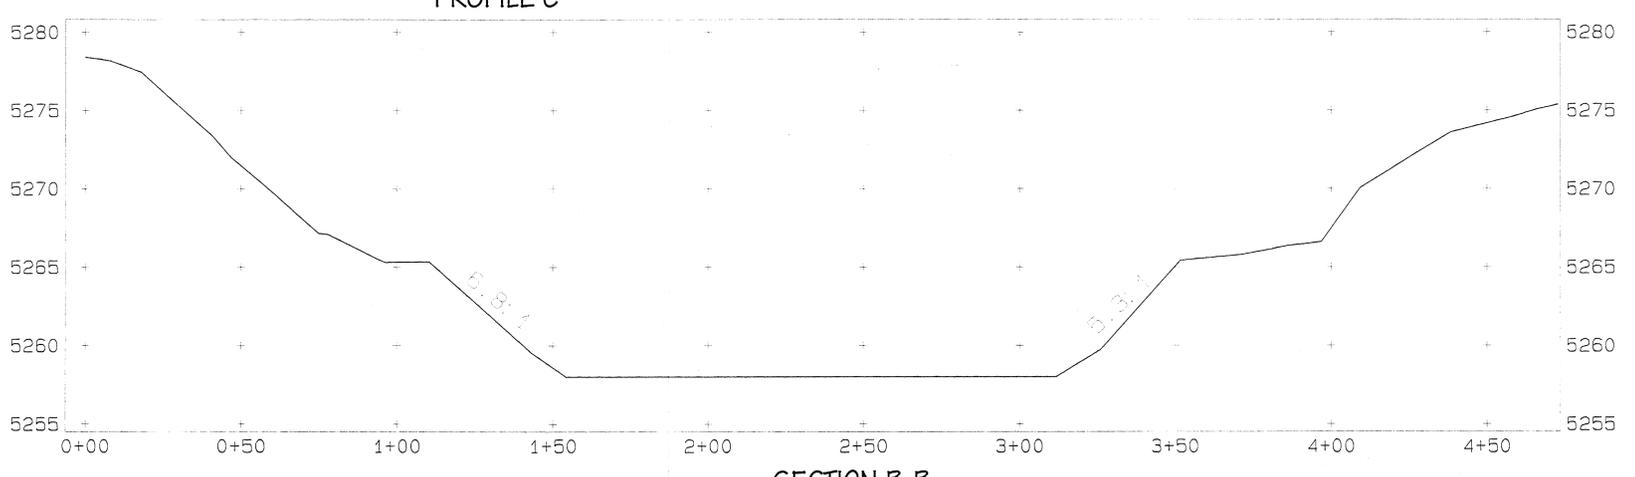

**SECTION B-B**

SECTIONS AND PROFILE SCALE-HORIZONTAL: 1"=20 FT.  
VERTICAL: 1"=4 FT.

**CERTIFICATION STATEMENT**  
I, Leonard Raymond, hereby certify that this drawing was reviewed by me and that the information shown is complete and accurate to the best of my knowledge.




REV. NO.	DATE	BY	REVISION DESCRIPTION	ENG. I. & P. E. P. S. APPROVALS
2	1-27-99	PJP	CORRECTED SECTION LABELS.	
1	05/15/98	RY	RE-SURVEYED AND RE-ASBUILT	


**EXHIBIT 26-30**  
**NAVAJO COAL COMPANY**  
NAVAJO MINE  
P.O. BOX 195 FRUITLAND, NEW MEXICO 87416

**HOSTEEN POND #1**  
**AS-BUILT**

PREPARED BY: LR	DRAWN BY:	SCALE: AS NOTED
APPROVED BY: LR	DATE: 05/15/98	REF: DWG
DWG LOC: J:\NSM_SUBM\PER_PROG\CH_11\1998_pond_Asbuilt.dwg		

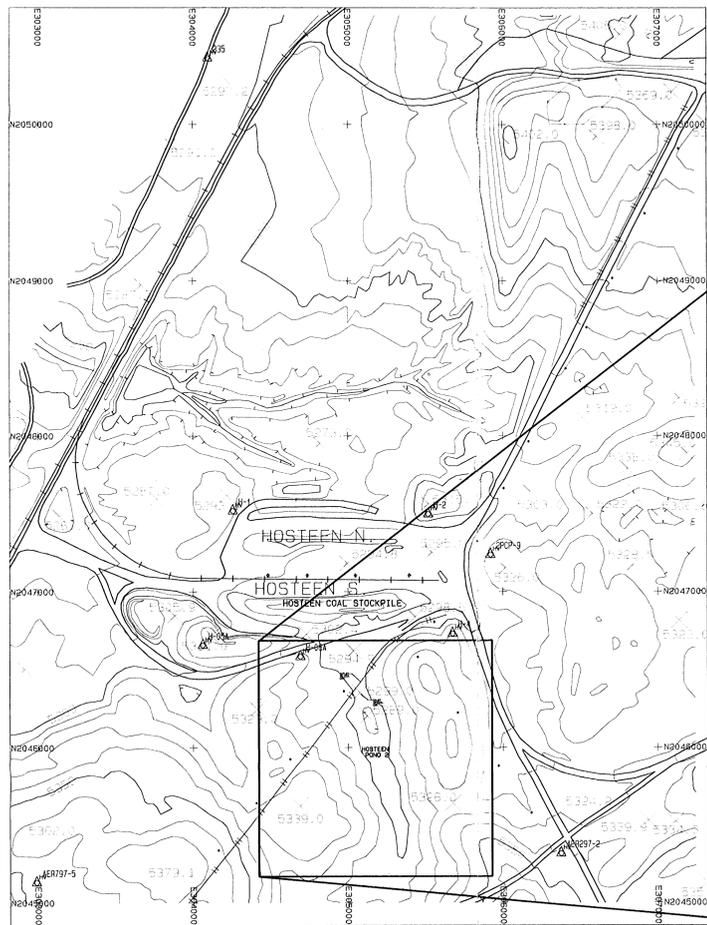

LOCATION MAP  
SCALE: 1"=400 FT.

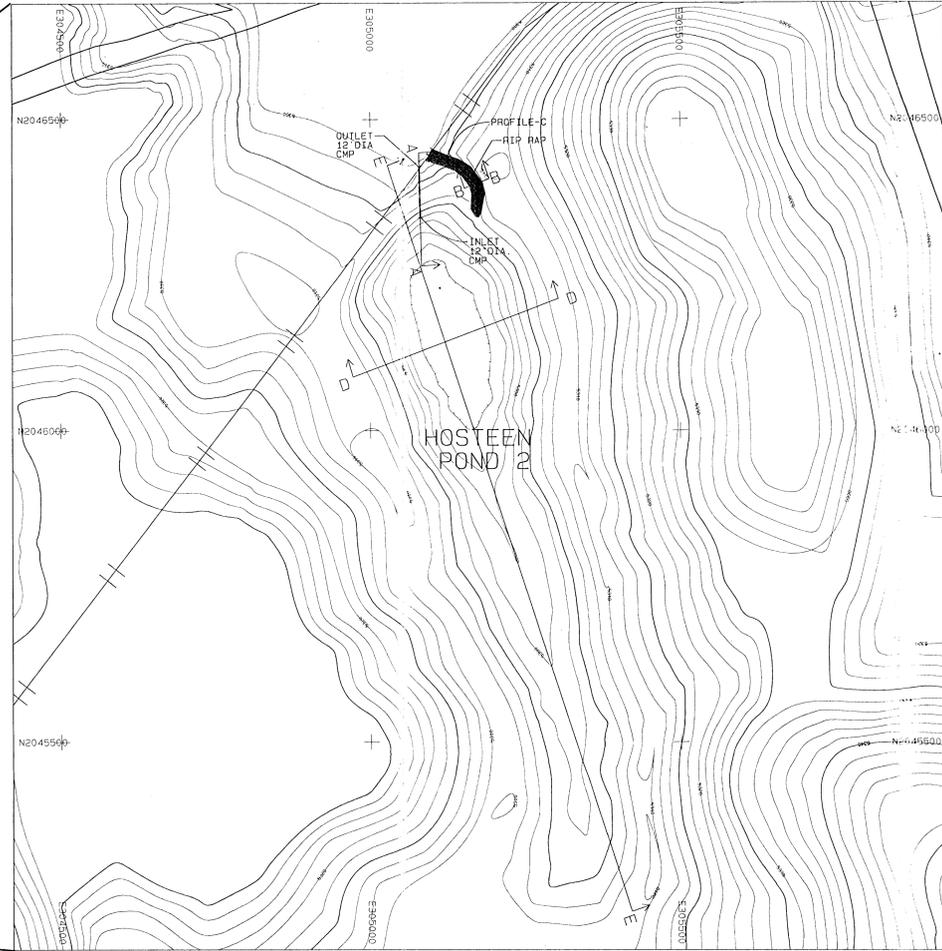

SCALE: 1"=100 FT

LEGEND


- ROAD
- WATERSHED
- BUILDING
- FENCE
- IRRIGATION LINE
- CULVERT
- DAM
- DRAINAGE
- RAILROAD
- TREES
- POWERLINE
- x 5339.5 SPOT ELEVATION
- 5300 INDEX CONTOUR
- 5299 INTERMEDIATE CONTOUR
- ▲ 5422.45 LEASE CORNER
- L-30

STAGE STORAGE DATA


ELEV feet	AREA acres	VOLUME ac-ft	CUM. VOLUME ac-ft
5293	0.23	0.00	0.00
5294	0.52	0.38	0.38
5295	0.73	0.63	1.00
5296	0.94	0.84	1.85
5297	1.12	1.04	2.88
5298	1.31	1.22	4.11
5299	1.63	1.48	5.59
5300	2.00	1.93	7.41
5301	2.44	2.24	9.65
5302	2.92	2.70	12.35

NOTES


- For hydrology and design information refer to Appendix 11-4 in the approved PAP.
- Blue-line Elevations can be found in Table 11-5L.
- Gauge Post base Elevation: 5292.75 (GPS).

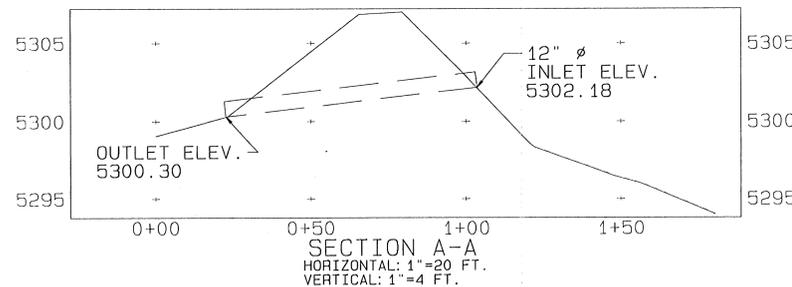


SECTION A-A  
HORIZONTAL: 1"=20 FT.  
VERTICAL: 1"=4 FT.

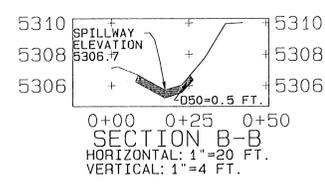


SECTION B-B  
HORIZONTAL: 1"=20 FT.  
VERTICAL: 1"=4 FT.

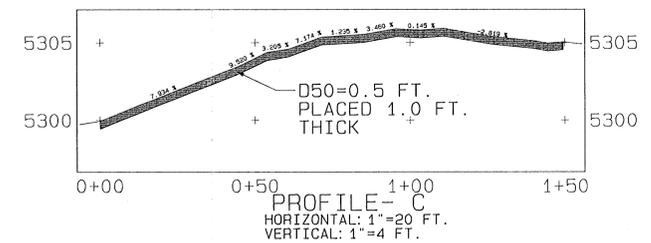


PROFILE-C  
HORIZONTAL: 1"=20 FT.  
VERTICAL: 1"=4 FT.

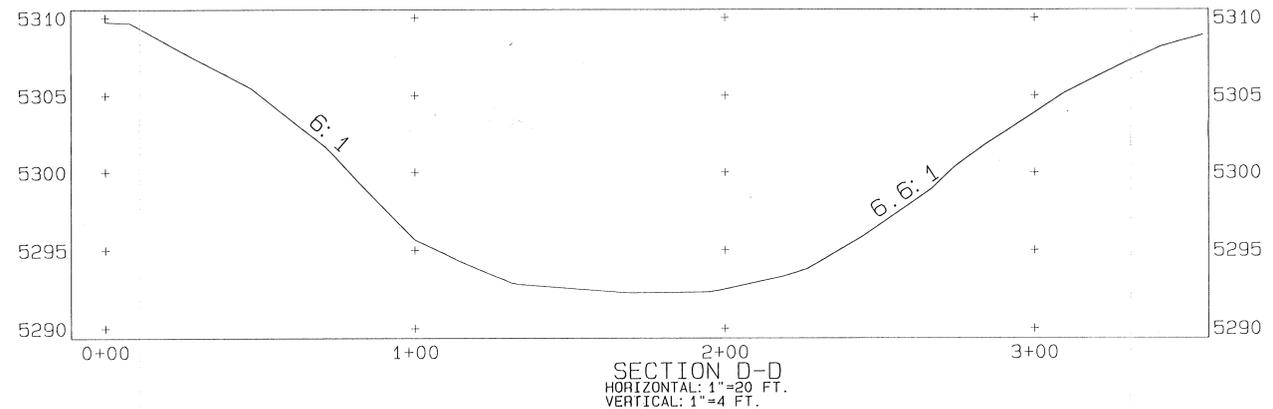

SECTION D-D  
HORIZONTAL: 1"=20 FT.  
VERTICAL: 1"=4 FT.

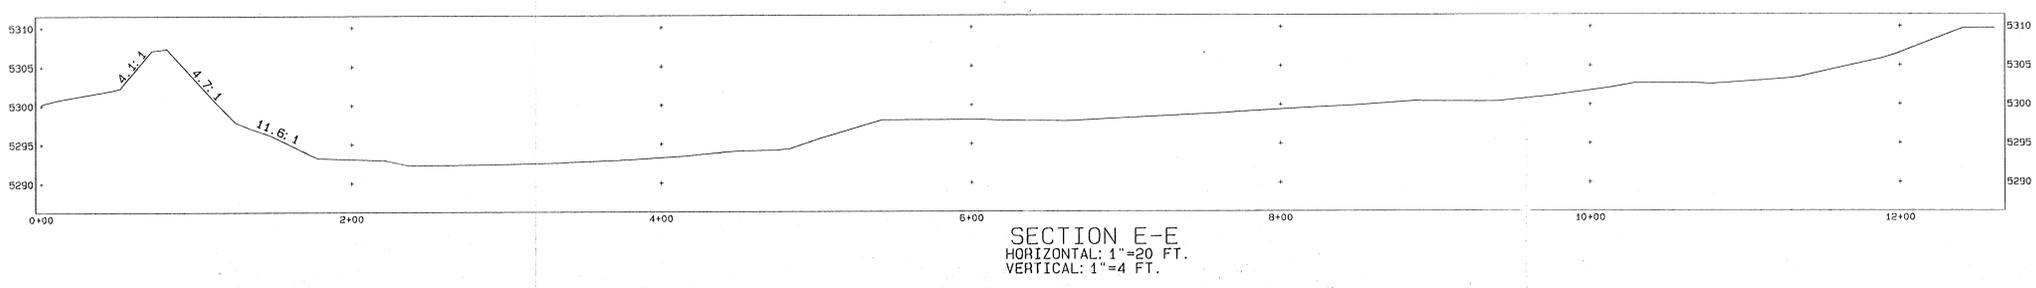


SECTION E-E  
HORIZONTAL: 1"=20 FT.  
VERTICAL: 1"=4 FT.

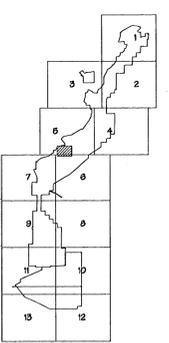

CERTIFICATION STATEMENT

I, Leonard Raymond, hereby certify that this drawing was reviewed by me and that the information shown is complete and accurate to the best of my knowledge.



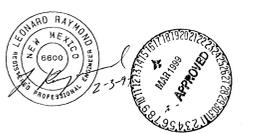


REV. NO.	DATE	BY	REVISION DESCRIPTION	CHK. E. R. P. S. P. M. APPROVAL
2	1-27-99	P.J.F.	CORRECTED SECTION LABELS.	
1	05/04/98	RY	PRE SURVEYED AND RE ASBUILT	

**EXHIBIT 26-31**  
**NAVAJO COAL COMPANY**  
NAVAJO MINE  
P.O. BOX 155 FRUITLAND, NEW MEXICO 87415

**HOSTEEN POND 2**  
**AS-BUILT**

PREPARED BY	DRAWN BY	SCALE AS NOTED
APPROVED BY LR	DATE 05/04/98	REF. DWG.

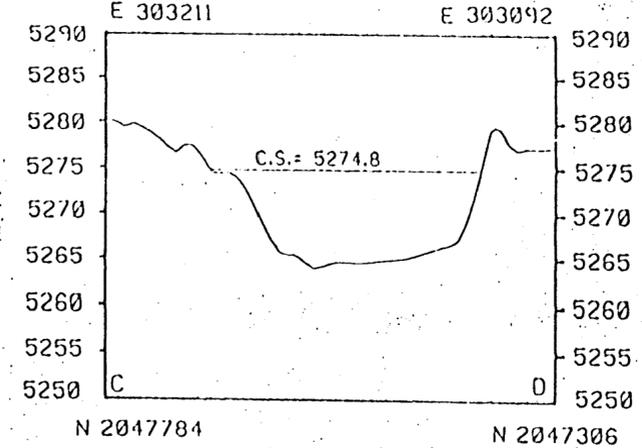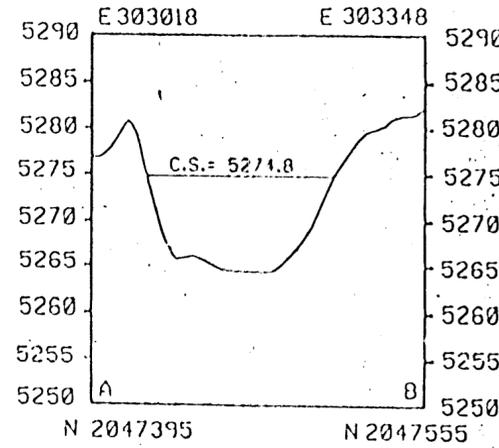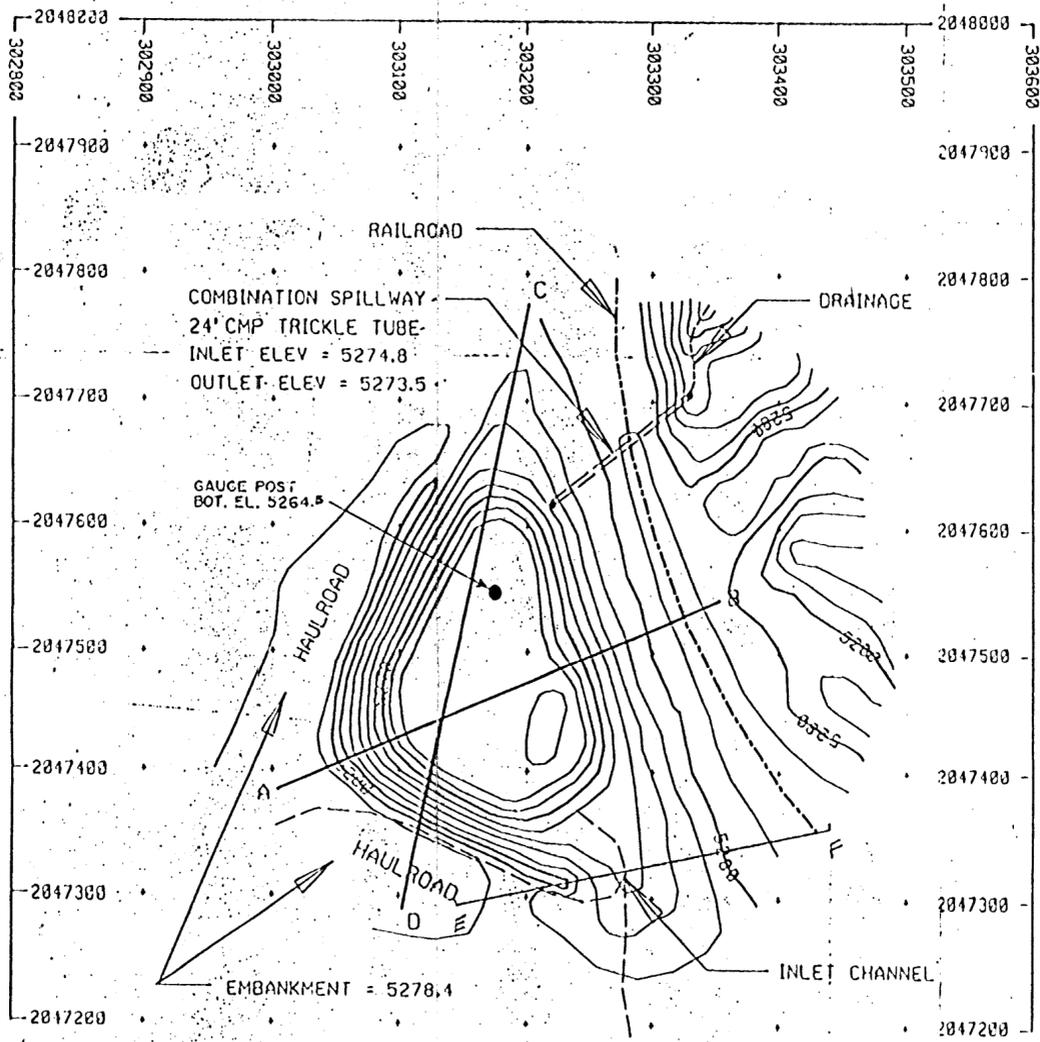

SECTION A-B VERTICAL EXAGGERATION OF 10.00


SECTION C-D VERTICAL EXAGGERATION OF 10.00

**LEGEND**

==== COMBINATION SPILLWAY  
 --- INLET & OUTLET CHANNELS  
 - - - RAILROAD

NOTE: HAULROAD AND RAILROAD SERVE AS POND EMBANKMENTS  
 FOR BLUELINE ELEVATION REFER TO TABLE 11-5M.

STAGE AREA DATA		
ELEVATION	AREA (AC)	VOL. (AC-FT)
5263.0	0.00	0.00
5264.0	0.03	0.02
5266.0	0.51	0.56
5270.0	0.73	3.04
5272.0	0.84	4.61
5273.0	0.94	5.30
5274.0	1.04	6.49
5274.8	1.14	7.38
5275.0	1.17	7.60

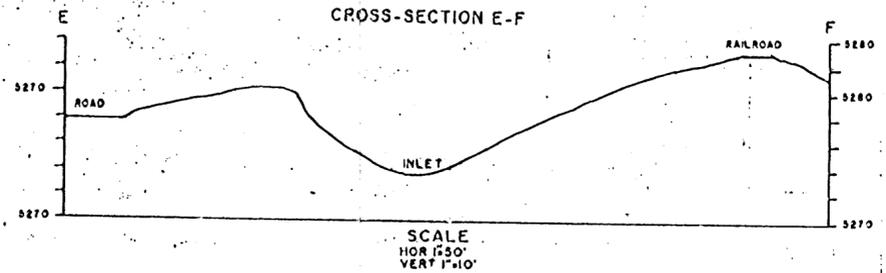

**CERTIFICATION STATEMENT**

I, Leonard Raymond, hereby certify that this drawing was reviewed by me and that the information shown is complete and accurate to the best of my knowledge.




**EXHIBIT 26-32**

		<b>BHP MINERALS INTERNATIONAL</b> MAYAJO  KIXE FRUITLAND, NEW MEXICO USA	
		<b>HOSTEEN POND 3</b> <b>AS - BUILT</b>	
DRAWN BY: JRC		SCALE: 1" = 100'	CONTOUR INT.: 2'
APPROVED BY: <i>[Signature]</i>		DATE: 10/12/98	
DRAWING NO. EXHIBIT 29-4E		LOCATION NO. MF-02	
REV. NO.	DATE	REVISIONS	APPROVALS
1	10/12/98	AS-BUILT CERTIFICATION	JRC [Signature] [Signature] [Signature]
2		9149B ADDED NOTE	

... 14890-1000-36 (9/85) 05 03 35

5X Scale

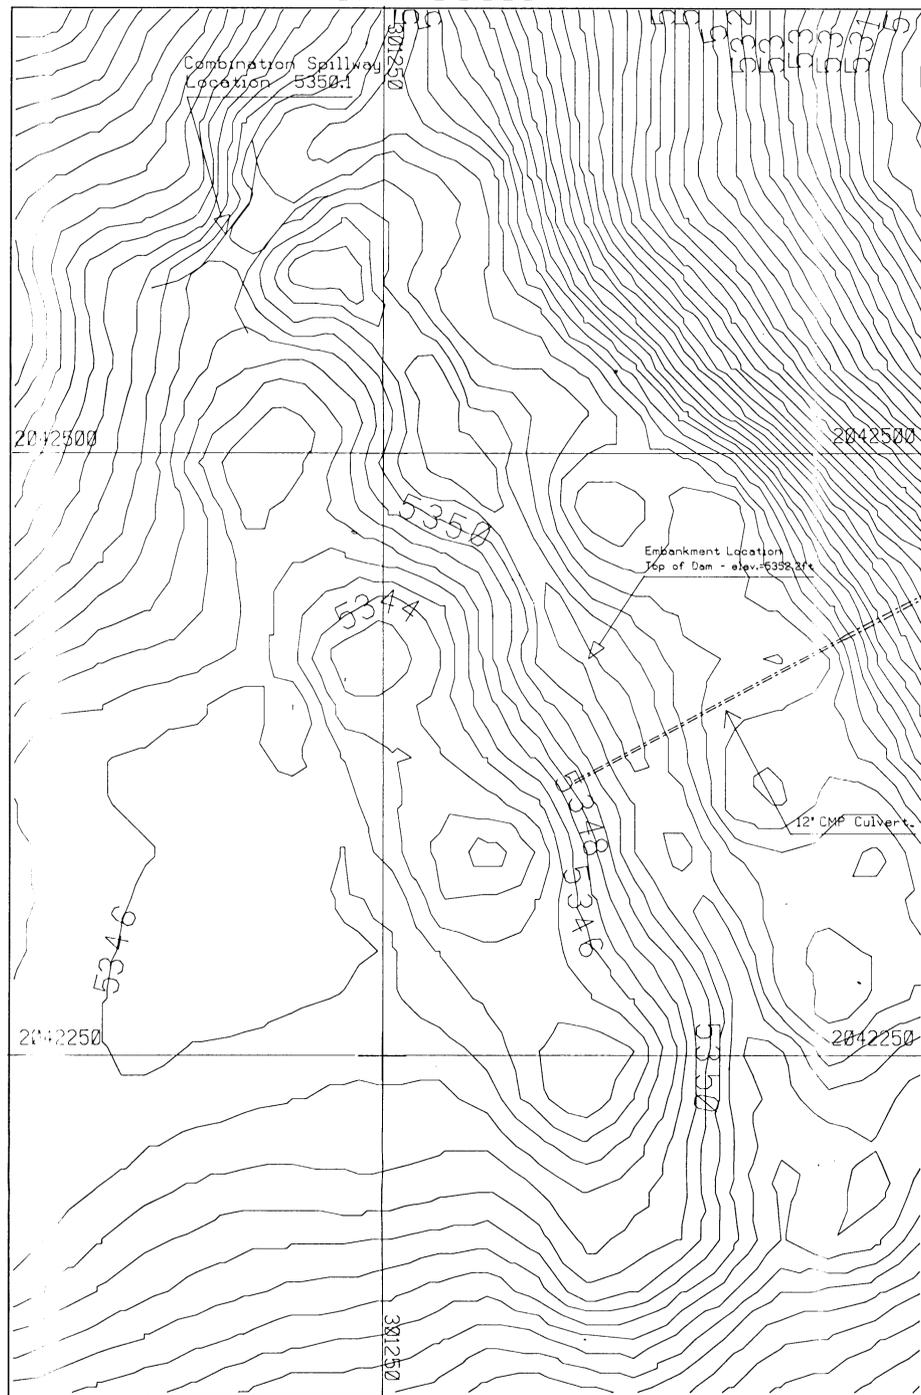

Stage-Area Data

Elevation	Area(acres)	Volume (cu ft)
5342.0	0.00	0.00
5343.0	0.05	0.03
5344.0	0.13	0.12
5345.0	0.14	0.26
5346.0	0.82	0.74
5347.0	1.29	1.00
5348.0	1.59	3.24
5348.3	1.74	3.74

Top of Embankment Elevation 5352.2  
 Combination Spillway Elevation 5350.1  
 Bottom of Pond Elevation 5342.0  
 Top Width of Embankment 12.0 ft.  
 Down-Stream Side Slope (H:V) 3:1  
 Up-Stream Side Slope (H:V) 3:1  
 Maximum Sediment Elevation 5346.5

Combination Spillway Cross-Section


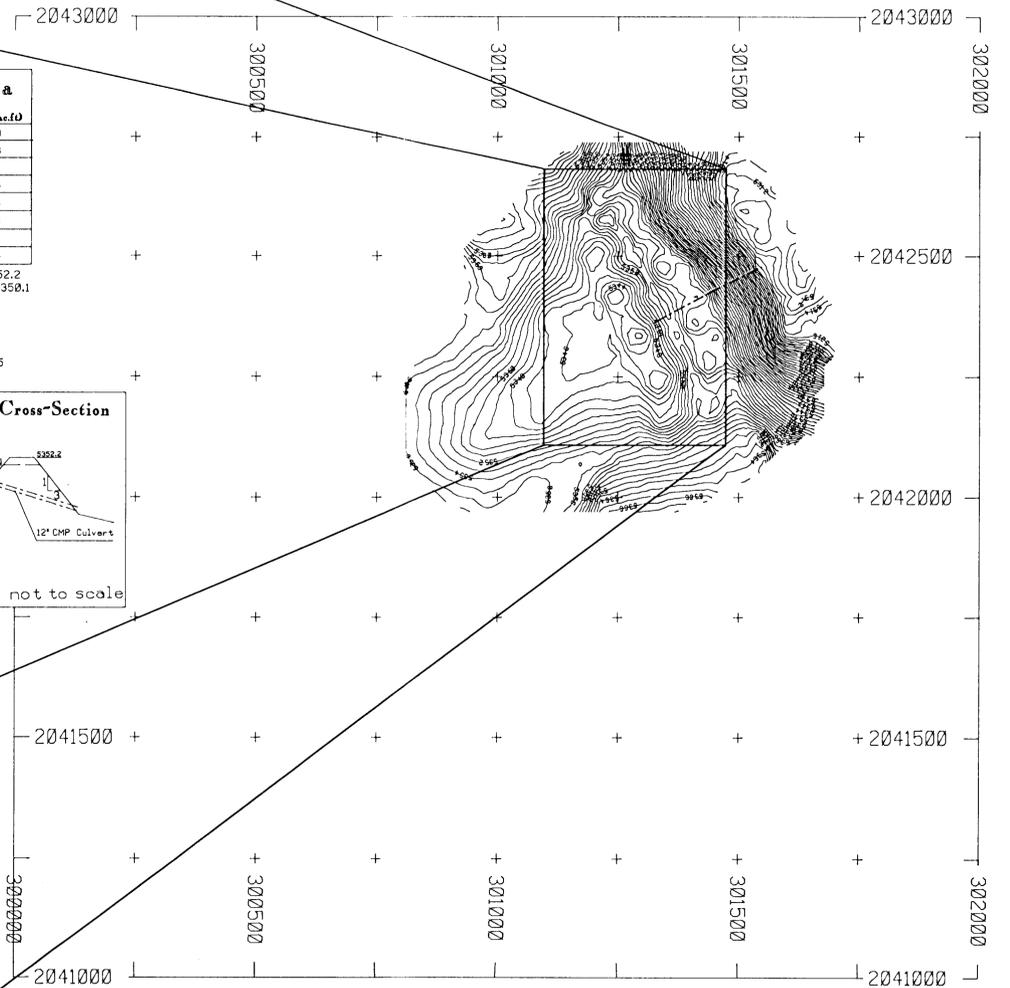


EXHIBIT 26-33

BHP MINERALS INTERNATIONAL INC.

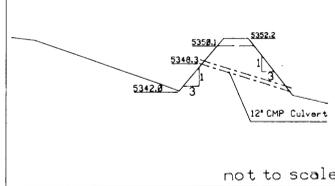

FRUITLAND, NEW MEXICO USA

AS-BUILT  
 Barber Coal Stockpile  
 Detention Pond #3

DRAWN BY: ACCA SCALE: 1"=200' CONTOUR INT.: 1'

APPROVED BY: DATE: 02/14/91

DRAWING NO. LOCATION NO.

REV. NO.	DATE	REVISIONS	APPROVALS		
			Proj. Engineer	Professional Engineer	Chief Engineer
1	02/14/91	As-Built Submittal		REV	
		CHANGE EXHIBIT NO. TO 11-44			



Legend





Area of Detail



Culvert




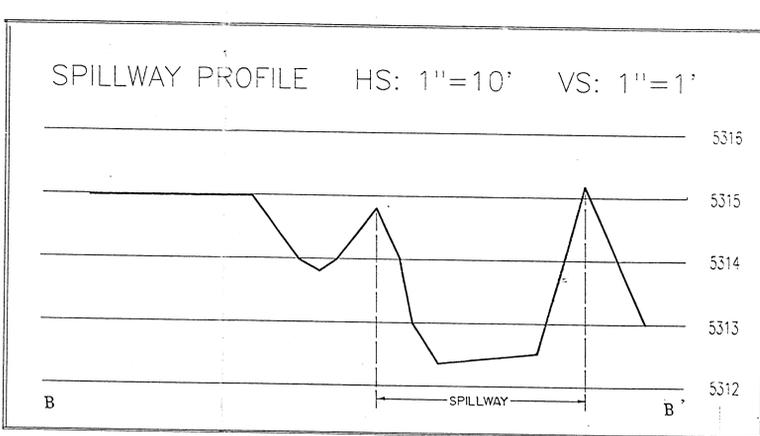
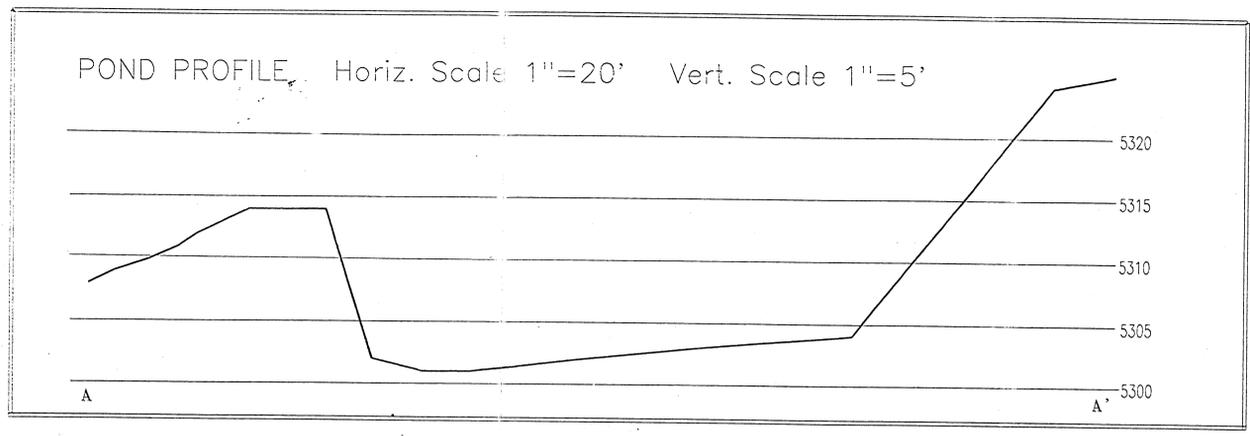


- LEGEND**
- ACCESS DIRT ROAD
  - COMBINATION SPILLWAY
  - - - V-DITCH
  - - - SAFETY BERMS
  - SPOT ELEVATION
  - INDEX CONTOUR
  - INTERMEDIATE CONTOUR
  - GAUGE POST
  - INLET CHANNEL

- NOTES:**
- GAUGE POST BASE ELEVATION 5300.8
  - FOR BLUELINE ELEVATION REFER TO TABLE 11-55 IN THE P&I.

#### Low Stockpile Pond


Elevation	Contour Area (Ac)	Incremental Volume (Ac-ft)	Cumulative Volume (Ac-ft)	Reserve Volume (Ac-ft)
5300.8	0.00	0.00	0.00	5.60
5301.0	0.01	0.00	0.00	5.60
5302.0	0.11	0.06	0.06	5.54
5303.0	0.28	0.17	0.23	5.37
5304.0	0.35	0.29	0.52	5.08
5305.0	0.40	0.38	0.90	4.71
5306.0	0.44	0.42	1.32	4.29
5307.0	0.47	0.46	1.77	3.83
5308.0	0.50	0.49	2.26	3.35
5309.0	0.53	0.52	2.77	2.83
5310.0	0.57	0.55	3.32	2.28
5311.0	0.60	0.59	3.91	1.70
5312.0	0.64	0.62	4.53	1.08
5313.0	0.68	0.66	5.19	0.42
5313.6	0.70	0.42	5.60	0.00

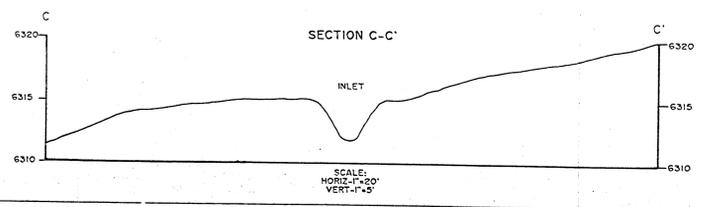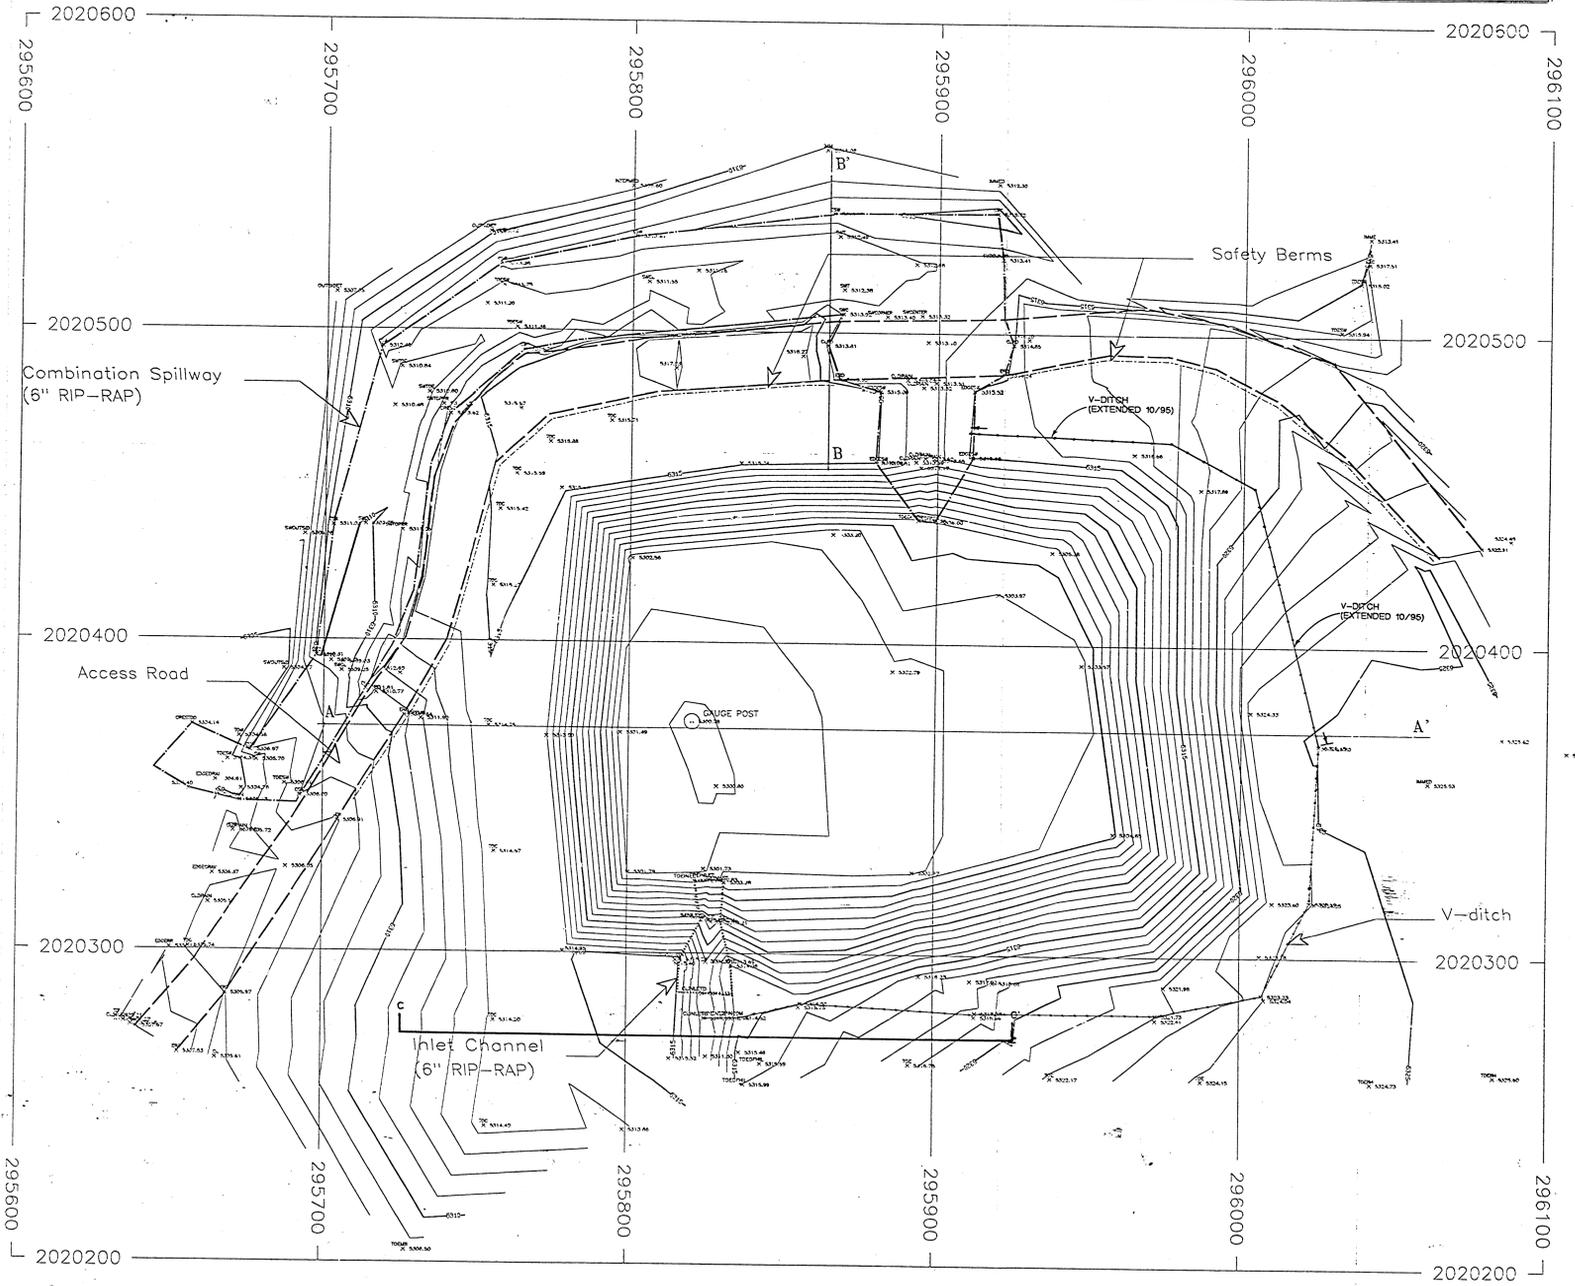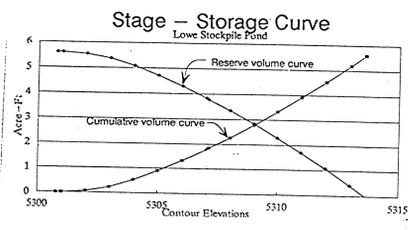

**CERTIFICATION STATEMENT**

I, Leonard Raymond, hereby certify that this drawing was reviewed by me and that the information shown is complete and accurate to the best of my knowledge.

LEONARD RAYMOND  
 REGISTERED PROFESSIONAL ENGINEER  
 STATE OF NEW MEXICO  
 5500  
 2-3-97

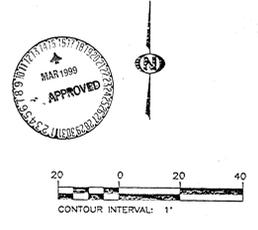



REV. NO.	DATE	REVISIONS	APPROVALS	
			DRY	CHK
1	4/17/83	ADDED X-SECTION C-C'		
2	8/20/93	CHANGE EXHIBIT NO. TO 11-49	JG	
3	11-21-94	ADDED V-DITCH EXTENSION		
4	9-14-98	ADDED NOTES 1 AND 2.	RY	

**EXHIBIT 26-34**

BHP MINERALS INTERNATIONAL INC.  
 NAVAL MINE  
 FRUITLAND, NEW MEXICO

**LOWE STOCKPILE POND**  
**AS-BUILT**

DRIVEN BY SP SCALE 1"=20'  
 APPROVED BY JAC DATE 04/20/92  
 DRAWING NO. EXHIBIT 26-34 LOCATION NO. MF-D2a

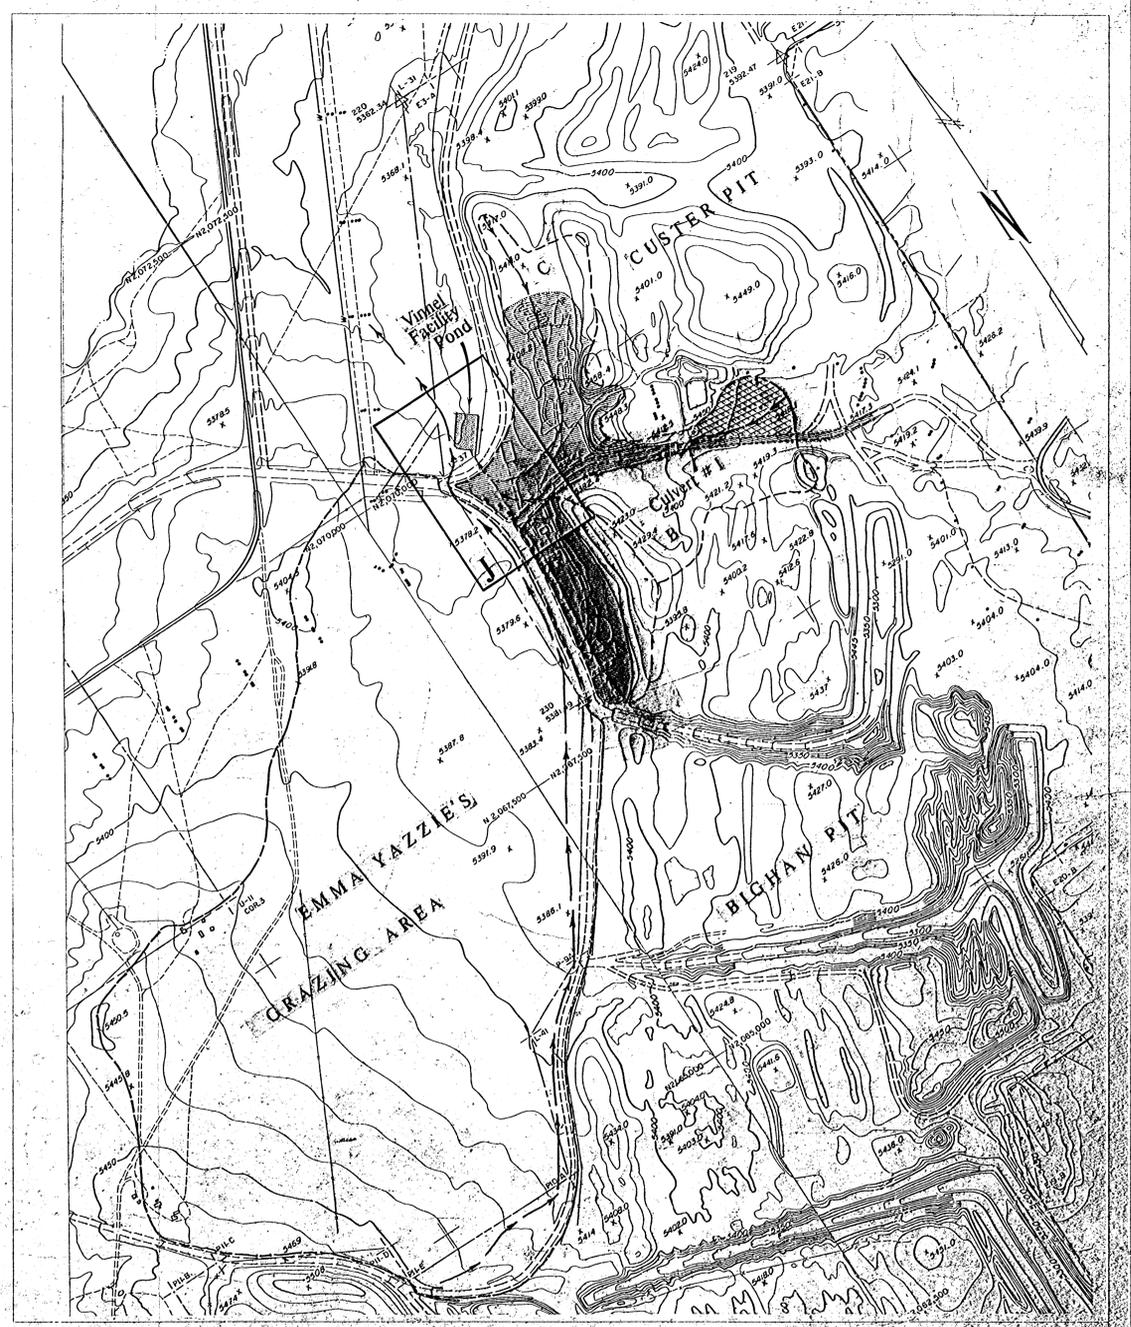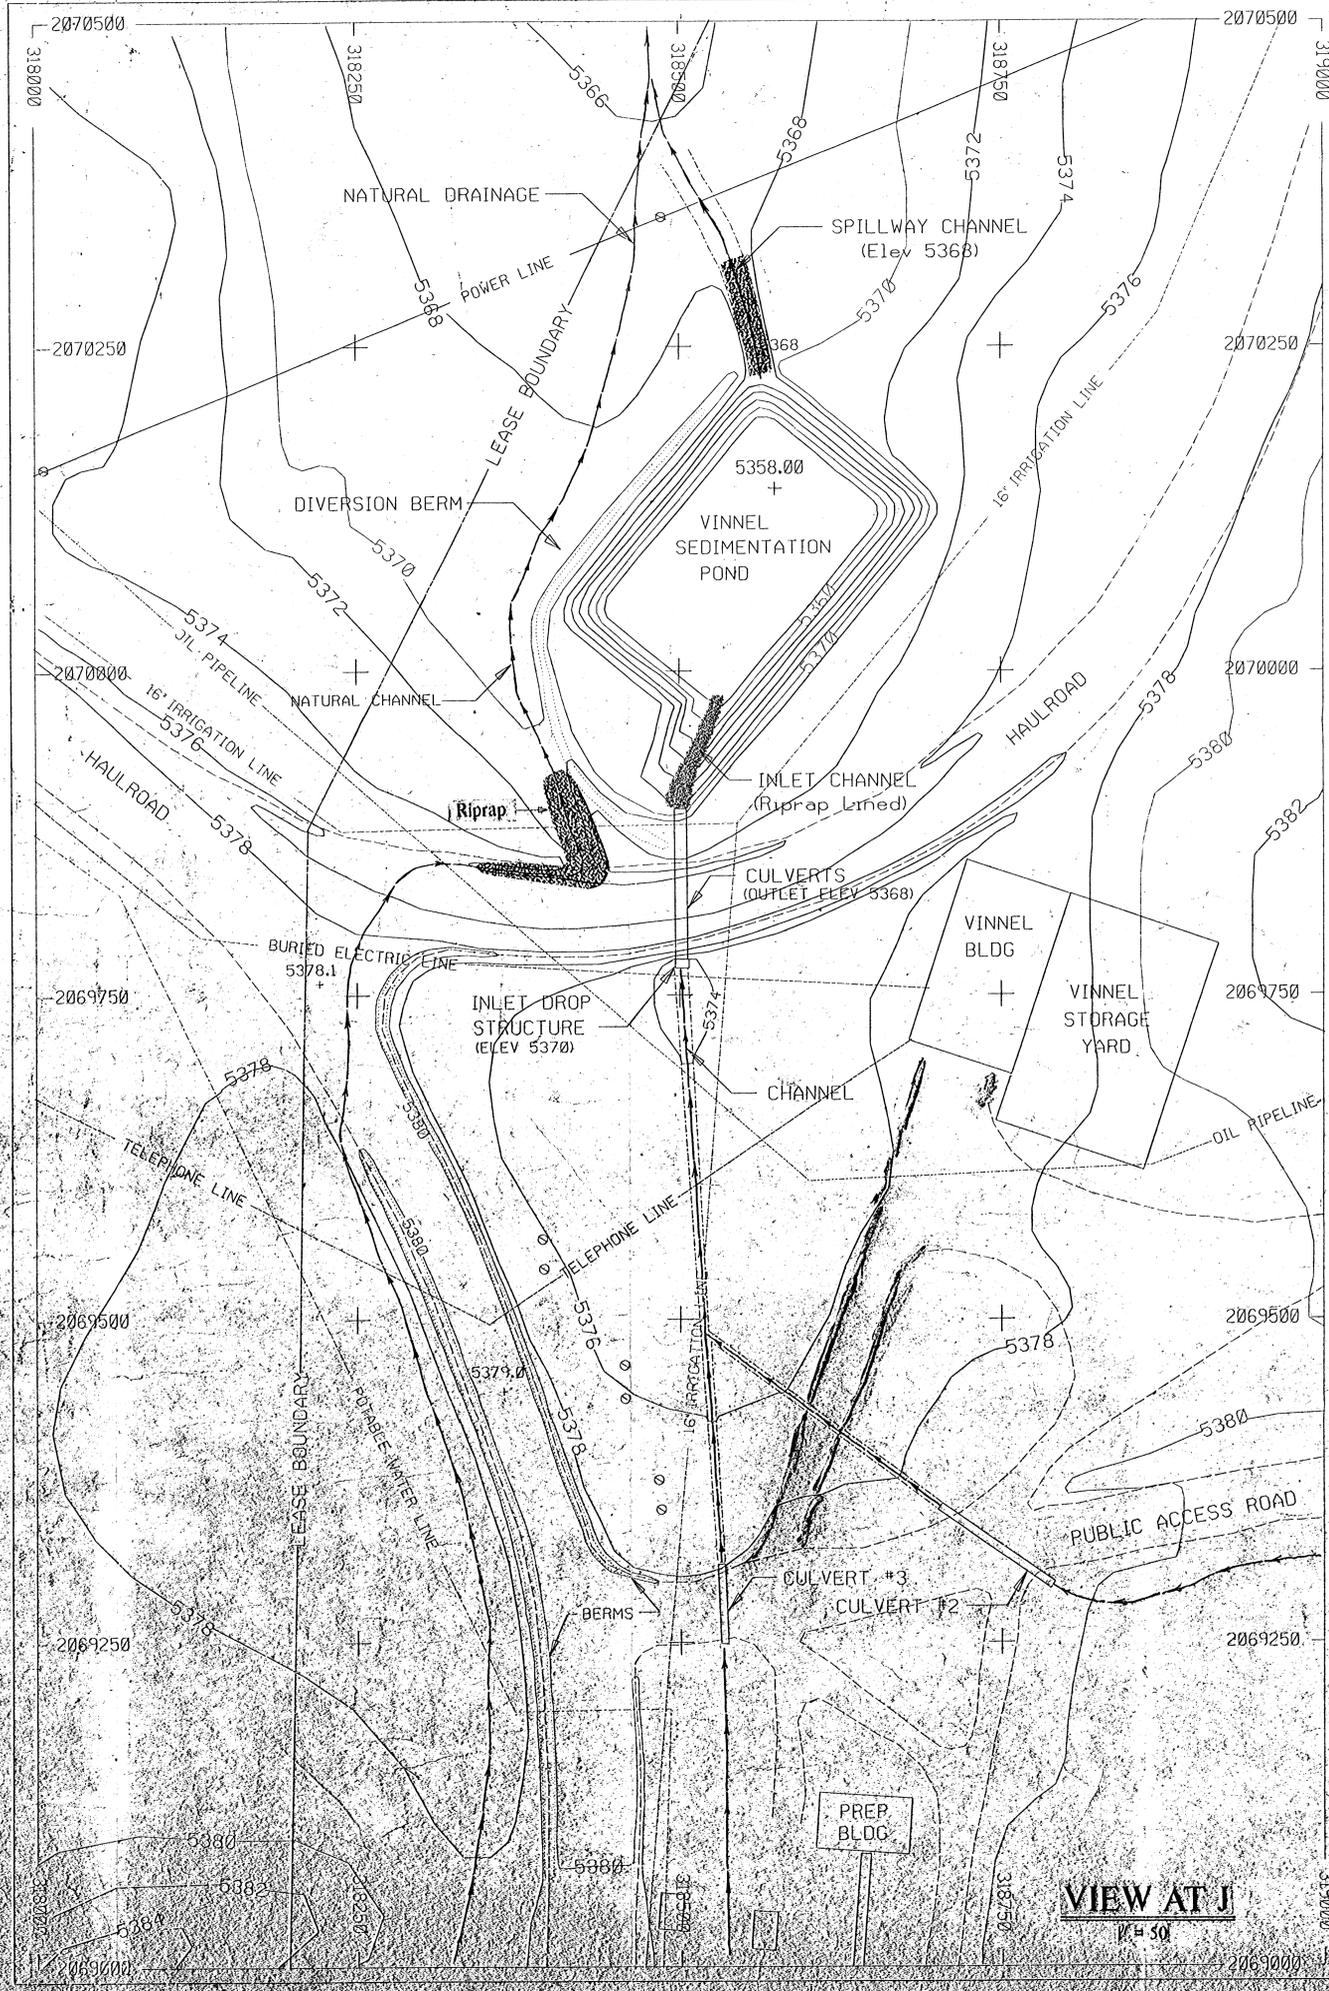

WATERSHED DETAILS  
SCALE 1" = 500'

- LEGEND**
- WATERSHED BOUNDARY
  - CULVERT #1
  - DISTURBED AREA
  - HYDRAULIC LENGTHS
  - CHANNEL CHANNELS
  - SEDIMENTATION POND
  - RIPRAP
  - BERMS
  - ROAD
  - POWER CULVERT





**BHP MINERALS INTERNATIONAL**  
NAVAJO BRONZE  
FRUITLAND, NEW MEXICO USA

**VINNEL HYDROLOGY PLAN**  
EXHIBIT 26-35

DRAWN BY: JRC		SCALE: 1" = 50'	CONTOUR INT: 2'
APPROVED BY: JRC		DATE: 1/1/90	
DRAWING NO:		LOCATION NO:	
REV. NO.	DATE	REVISIONS	APPROVALS
1	3/1/91	POND RELOCATION & DIVERSION STRUCTURES ADDED	SEC [Signature]
2	7/3/91	RIPRAP ADDED	SEC [Signature]
3	7/1/92	RENUMBERED FROM EXH 26-38 TO EXH 26-35	SEC [Signature]
4	7/3/93	CHANGE FROM 2' TO 1'44" CO. CURVE	SEC [Signature]

**VIEW AT J**  
1" = 50'

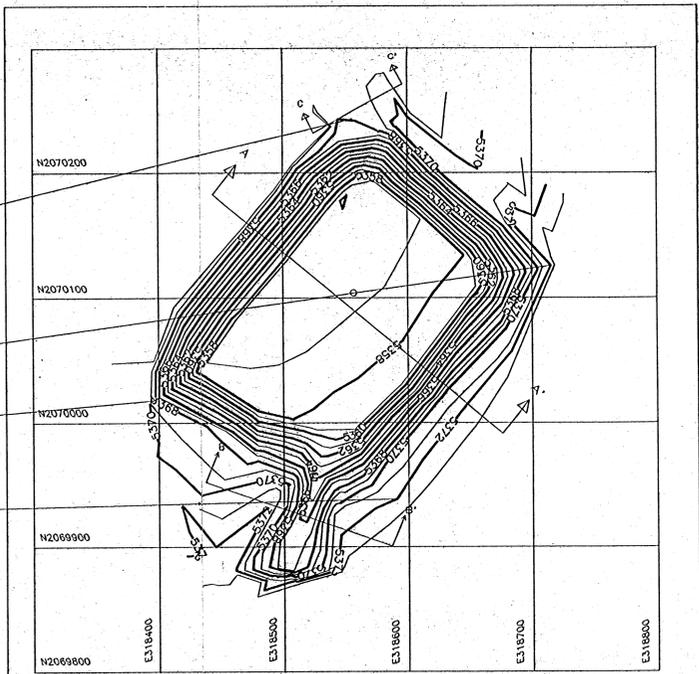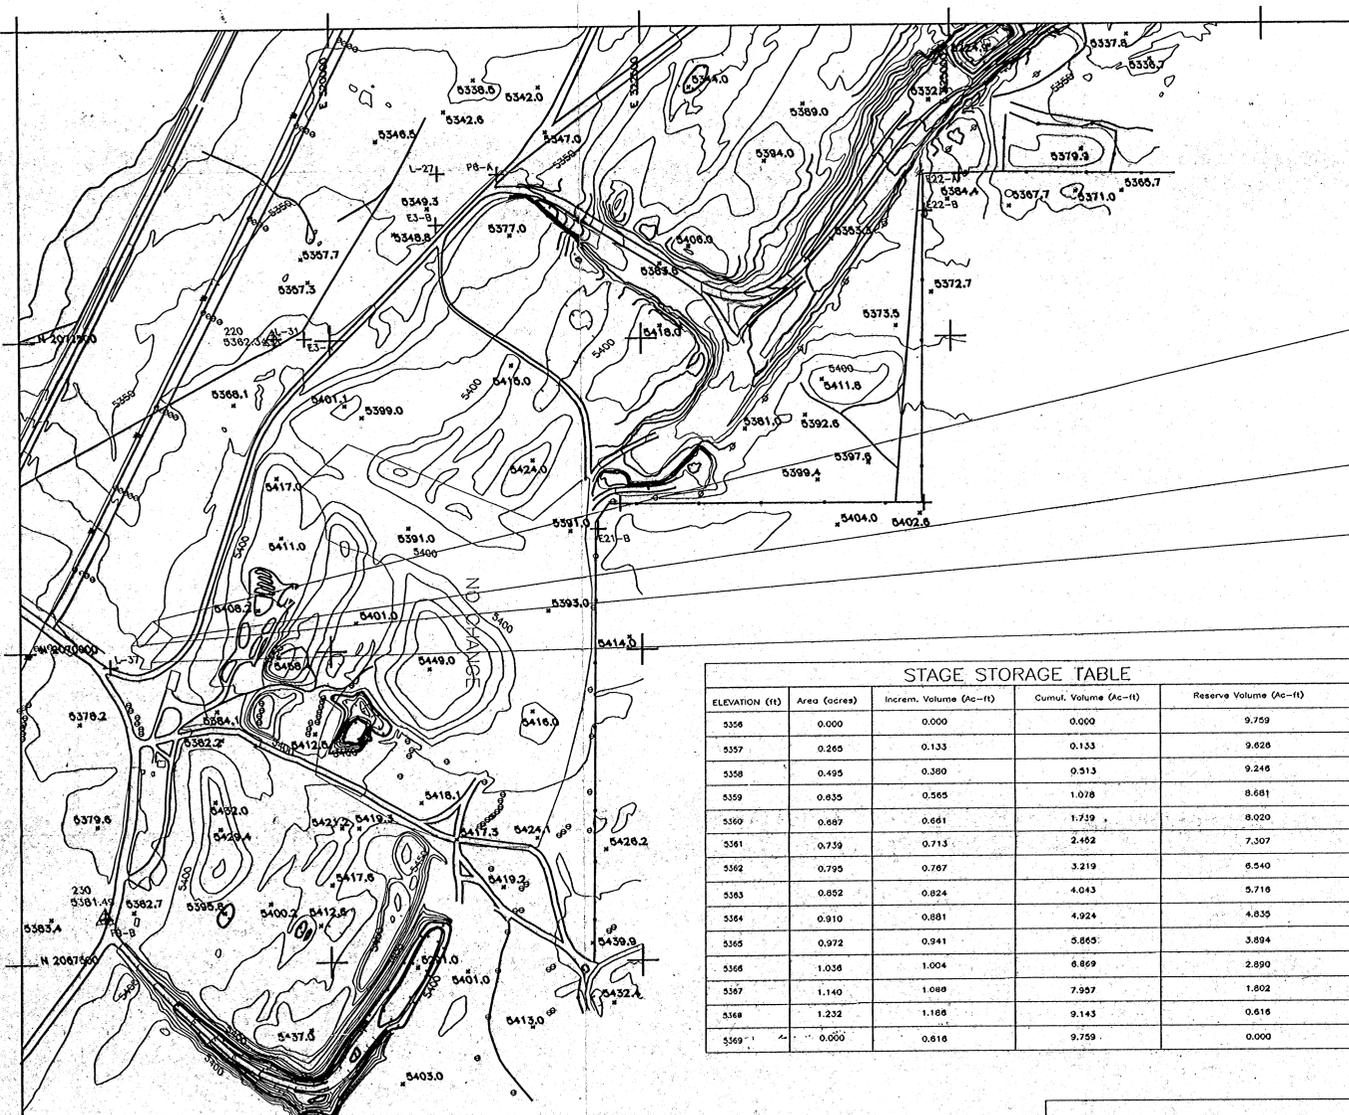







# Vinnel Pond

scale: 1" = 50'

STAGE STORAGE TABLE				
ELEVATION (ft)	Area (acres)	Increment. Volume (Ac-ft)	Cumul. Volume (Ac-ft)	Reserve Volume (Ac-ft)
5356	0.000	0.000	0.000	9.759
5357	0.265	0.133	0.133	9.626
5358	0.495	0.300	0.513	9.246
5359	0.835	0.565	1.078	8.681
5360	0.987	0.661	1.739	8.020
5361	0.759	0.713	2.452	7.307
5362	0.795	0.767	3.219	6.540
5363	0.852	0.824	4.043	5.716
5364	0.910	0.881	4.924	4.835
5365	0.972	0.941	5.865	3.894
5366	1.038	1.004	6.869	2.890
5367	1.140	1.089	7.957	1.802
5368	1.232	1.168	9.143	0.616
5369	0.000	0.616	9.759	0.000

- LEGEND**
- PAVED ROAD
  - DIRT ROAD
  - HAUL ROAD
  - TRAIL
  - BUILDING
  - FENCE
  - CULVERT
  - DAM
  - DRAINAGE
  - RAILROAD
  - TREES
  - POLES
  - SPOT ELEVATION
  - INDEX CONTOUR
  - INTERMEDIATE CONTOUR
  - HORIZ. & VERT. CONTROL
  - LEASE CORNER

- NOTES:**
- GAUGE POST BASE ELEVATION 5357.8 GPS.
  - FOR BLUELINE ELEVATION REFER TO TABLE 11-5AF IN THE PAP.

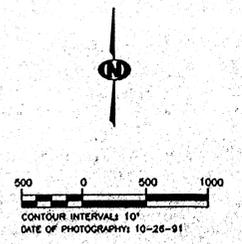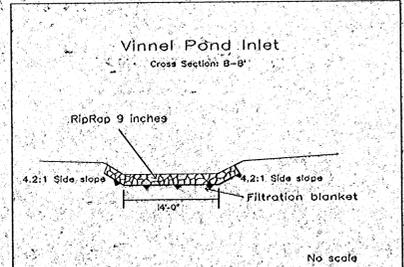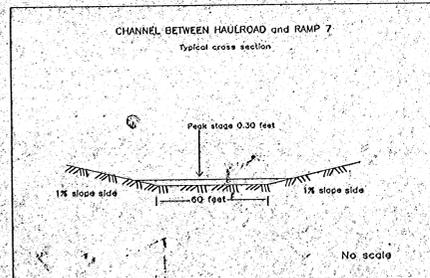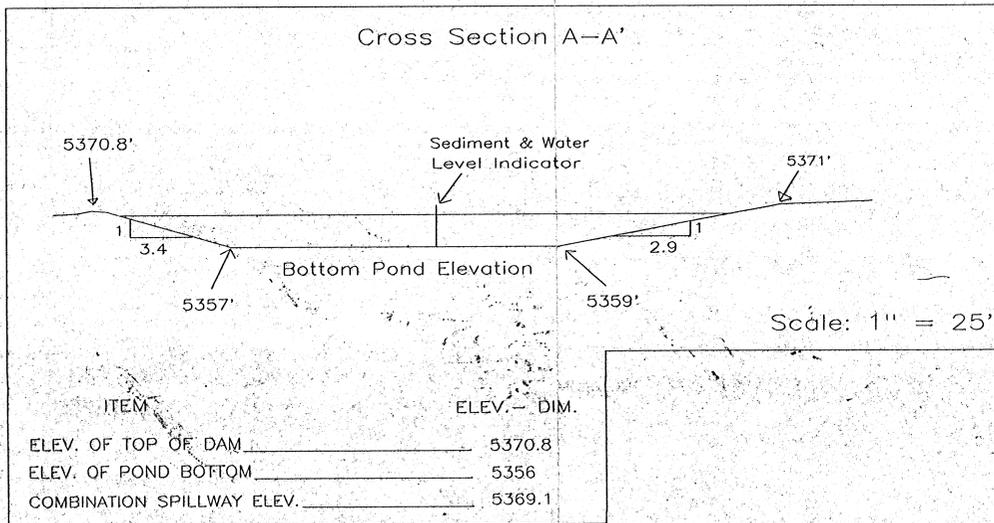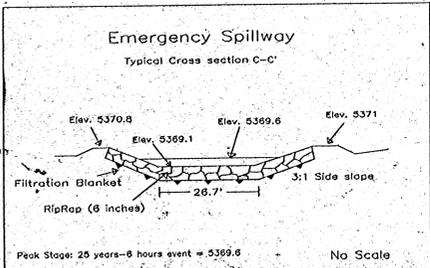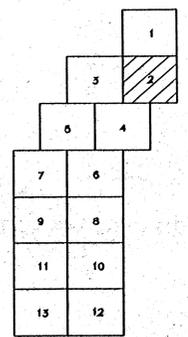

Revised by  
**DATAMAP**  
DIGITAL SERVICES, INC.  
Revision photograph May 30, 1993

**Construction Certification and Inspection Report**

- Vinnel Pond construction has been in accordance with the approved design except for these noted minor changes:
- Pond length, width, top and bottom elevations, spillway width and elevation varied slightly from the design plan, however the as-built volume is greater than the designed volume and does not affect the safety of the pond.
  - The filter channel width was increased to 60 feet with a flatter slope to accommodate the flow rates and field limitations.
- I, Steve Robert Flammang, hereby certify this as-built information concerning the Vinnel Pond as being complete and accurate to the best of my knowledge.

**APPROVED**


Steve Robert Flammang  
Professional Engineer  
No. 10000  
State of New Mexico

**As-Built**

BHP Minerals International  
NAVARO MINE  
FRUITLAND, NEW MEXICO




**Vinnel Pond**  
EXHIBIT 26-36

DRAWN BY: SJP	SCALE: 1" = 500'
APPROVED BY: GATE	DATE: May 1994
DRAWING NO.	LOCATION NO.

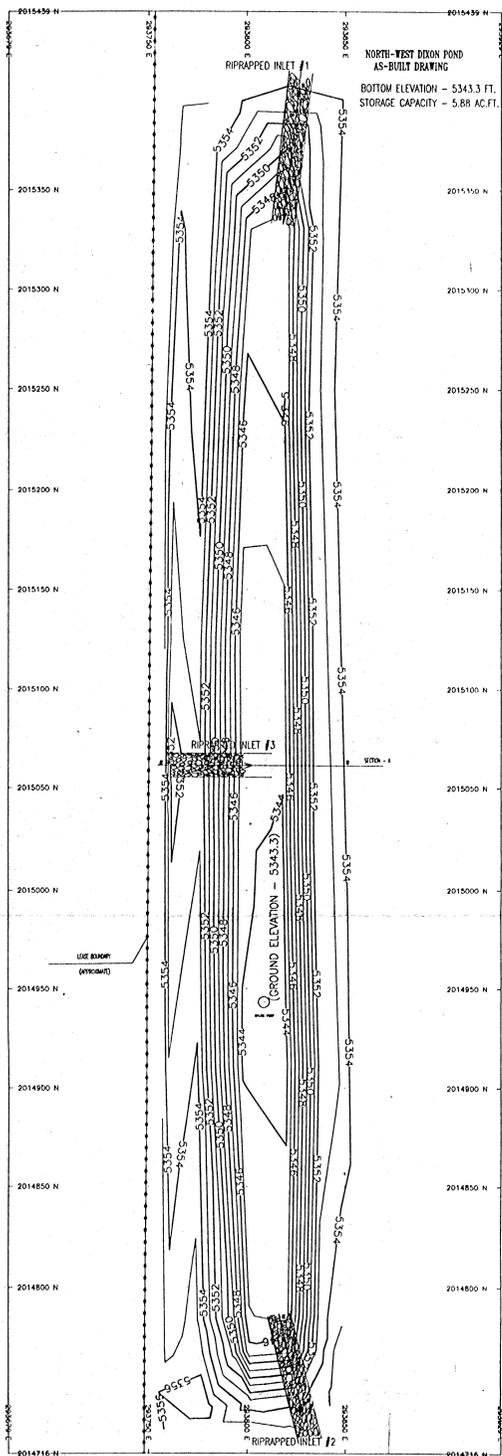



- PAVED ROAD
- DIRT ROAD
- HAUL ROAD
- TRAIL
- BUILDING
- FENCE
- IRRIGATION LINE
- CULVERT
- DAM
- DRAINAGE
- RAILROAD
- TREES
- POLES
- SPOT ELEVATION
- INDEX CONTOUR
- INTERMEDIATE CONTOUR
- HORIZ. & VERT. CONTROL
- LEASE CORNER

ELEVATION	CUMUL. AREA (AC)	NORM. YIELD (AC-FIT)	CUMULATIVE YIELD (AC-FIT)	RESIDUAL YIELD (AC-FIT)
5343	0.00	0.00	0.00	5.88
5344	0.06	0.02	0.02	5.86
5345	0.24	0.14	0.16	5.72
5346	0.35	0.30	0.45	5.43
5347	0.40	0.38	0.83	5.05
5348	0.48	0.44	1.27	4.61
5349	0.57	0.53	1.79	4.09
5350	0.60	0.59	2.38	3.50
5351	0.64	0.72	3.10	2.78
5352	0.69	0.87	3.96	1.92
5353	0.94	0.92	4.88	1.00
5354	1.06	1.00	5.88	0.00

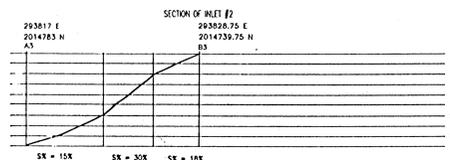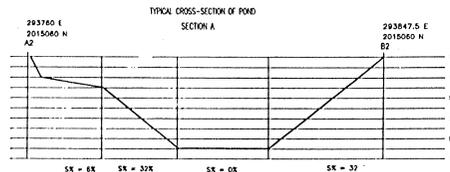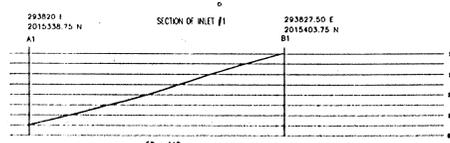

SCALE FOR SECTIONS:  
 VERTICAL SCALE: 1" = 6'  
 HORIZONTAL SCALE: 1" = 15.0'

**NOTES**  
 ADJUSTMENT FOR SURVEY CONTROLS  
 1. Original as built based on level loop for North West Dixon Pond which is 0.58 Feet below the GFS control Jan. 2000.  
 2. Base Elevation of large pond is based on GFS survey, GFS post base Elevation is 5344.62 ft.  
 3. Riprapped Elevations can be found in Table 11-5-A-X.

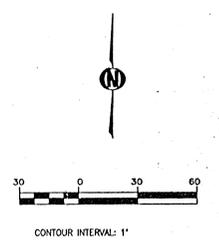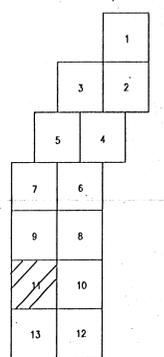


**CERTIFICATION STATEMENT**  
 I, Leonard Raymond, hereby certify that this drawing was reviewed by me and that the information shown is complete and accurate to the best of my knowledge.

4	1-28-99	REVISED NOTE, DESIGN, HATCH, REVISED DISTANCE		
3	5-24-98	REVISED HATCH, DISTANCE		
2	11-29-95	REVISED DESIGNED DATA	DR	
1	01/24/75	CHANGE EXHIBIT NO TO 11-47		
BY	DATE	BY	DATE	


**BHP MINERALS INTERNATIONAL INC.**  
 NAVAJO MINE  
 81111  
 P.O. BOX 156  
 FAULKLAND, NEW MEXICO 87416

**EXHIBIT 26-37**  
**NORTHWEST DIXON POND**  
**AS-BUILT**

PREPARED BY: G.A.P. DATE: MAY 27, 1999. SCALE: 1" = 30'  
 DRAWING NO. 26-37

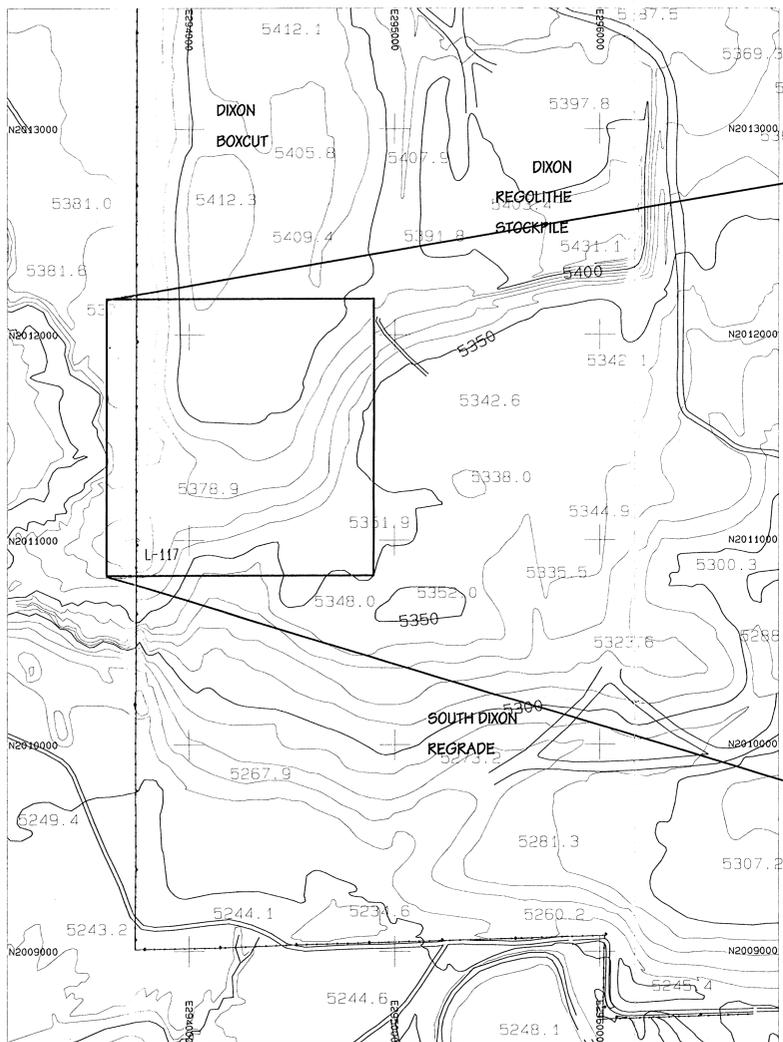

**LOCATION MAP**  
SCALE: 1"=300 FT.

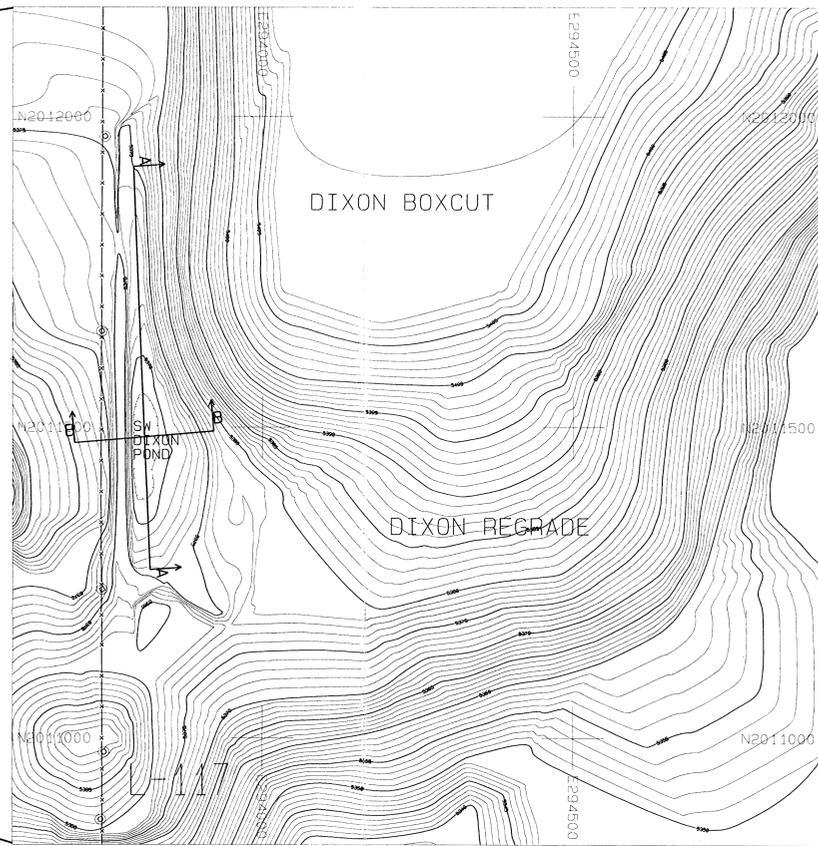

SCALE: 1"=100 FT.

**LEGEND**



- ROAD
- WATERSHED
- BUILDING
- FENCE
- IRRIGATION LINE
- CULVERT
- DAM
- DRAINAGE
- RAILROAD
- TREES
- POWERLINE
- SPOT ELEVATION
- INDEX CONTOUR
- INTERMEDIATE CONTOUR
- LEASE CORNER

**STAGE STORAGE DATA**


ELEV feet	AREA acres	VOLUME ac-ft	CUM. VOLUME ac-ft
5368	0.04	0.00	0.00
5369	0.13	0.08	0.08
5370	0.26	0.20	0.28
5371	0.44	0.35	0.63
5372	0.58	0.51	1.14
5373	0.77	0.68	1.82
5374	0.99	0.89	2.71

**NOTES**

1. For hydrology and design information refer to Appendix 11-AA in the approved PAP.
2. Gauge Post Base Elevation: 5367.53 FT. (GPS)
3. Blue-line Elevations can be found in Table 11-5.

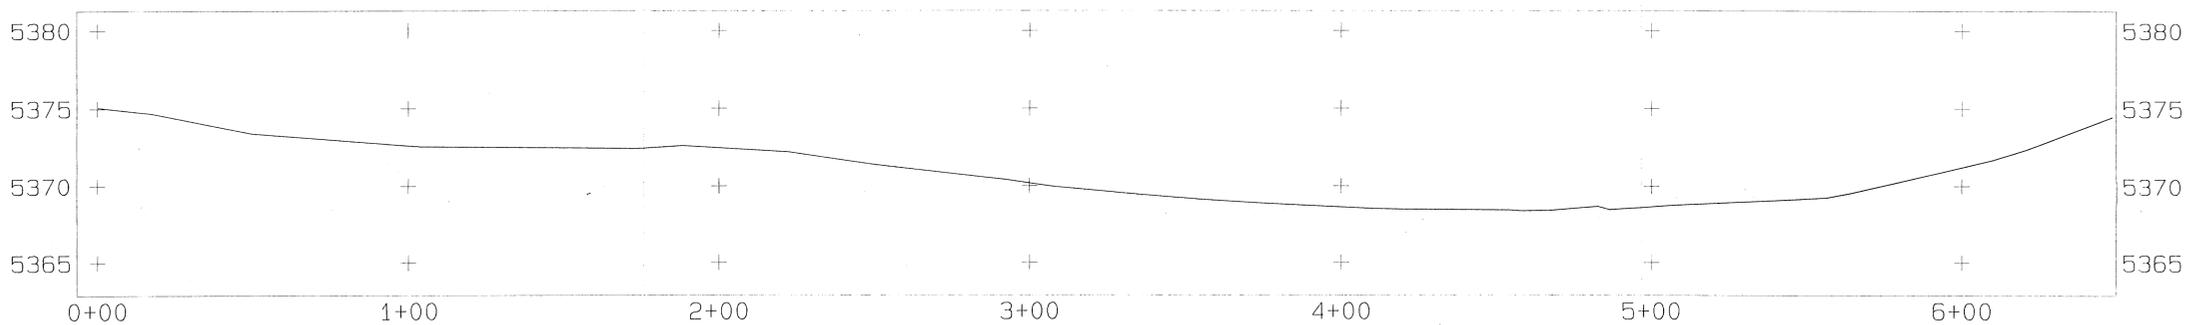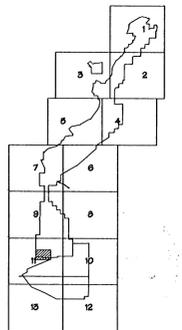

**SECTION A-A**

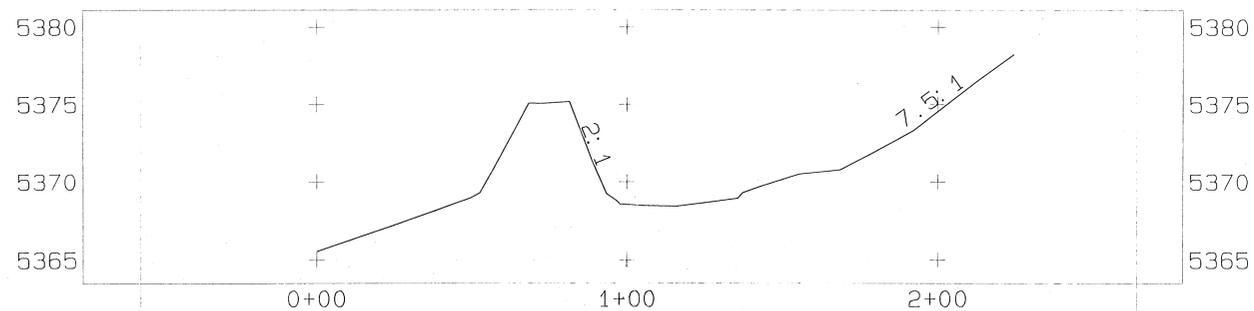

**SECTION B-B**

SECTIONS SCALE-HORIZONTAL: 1"=20 FT.  
VERTICAL: 1"=4 FT.

**CERTIFICATION STATEMENT**

I, Leonard Raymond, hereby certify that this drawing was reviewed by me and that the information shown is accurate and complete to the best of my knowledge.



1 05/15/98 BY RE-SURVEYED AND RE-ASBUILT  
REV. DATE DWT. BY REVISION DESCRIPTION DWG. E.O. P.E. P.S. APPROVAL

**EXHIBIT 26-38**  
**NAVAJO COAL COMPANY**




**ASBUILT**  
**SOUTH WEST DIXON POND**

PREPARED BY LR DRAWN BY RY SCALE AS NOTED  
APPROVED BY LR DATE 05/15/98 REF DWG  
DWG LOC J:\OSM\_SUB\PER\_PROG\CH\_11\1998P01\EXHIBITS\



Scale: 1" = 500'

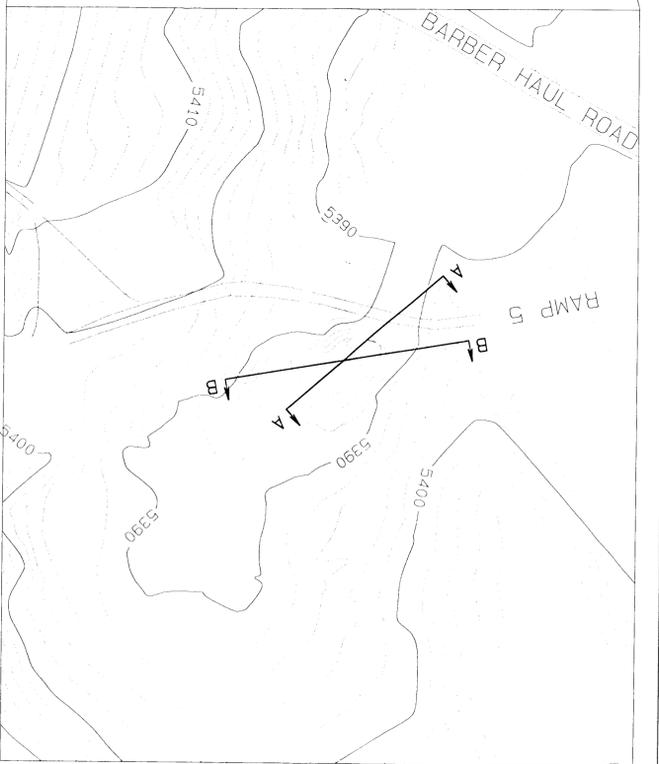


Scale: 1" = 200'

**LEGEND**


	ROAD
	WATERSHED
	BUILDING
	FENCE
	IRRIGATION LINE
	CULVERT
	DAM
	DRAINAGE
	RAILROAD
	TRENCH
	POWERLINE
	SPOT ELEVATION
	INDEX CONTOUR
	INTERMEDIATE CONTOUR
	CONTROL
	LEASE CORNER

**NOTES**


1. For hydrological design information refer to Appendix A design information p.p. 2.
2. See Exhibit 11-050 for South Barber Pond design, respectively.
3. For watershed area, see Exhibit 11-130.
4. See Table 11-5F for impoundment data.

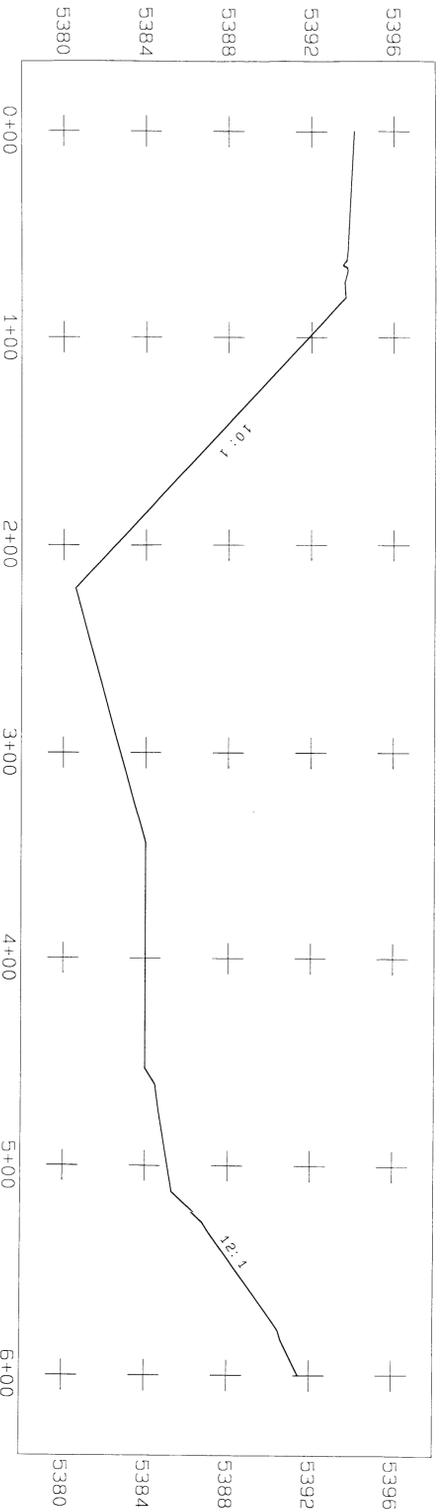

**SECTION B - B**  
Scale Horizontal 1" = 40'  
Vertical 1" = 4'

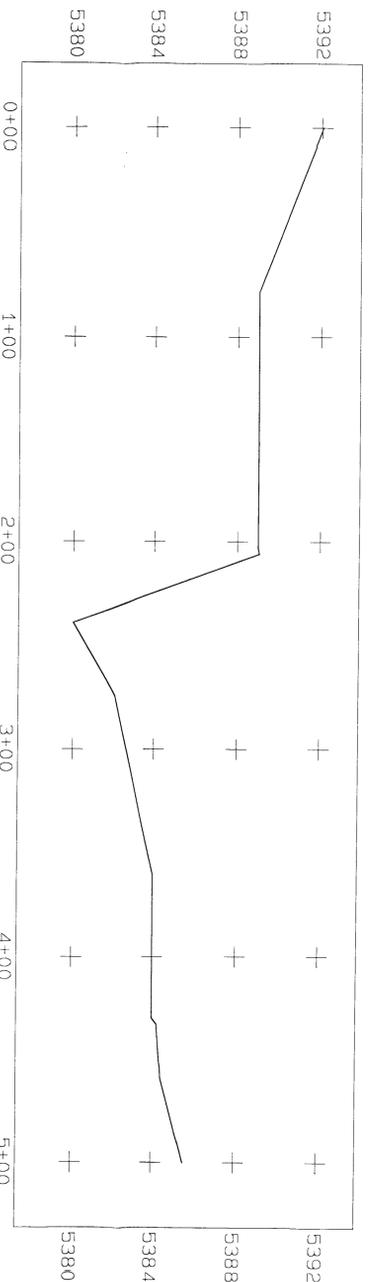

**SECTION A - A**  
Scale Horizontal 1" = 40'  
Vertical 1" = 4'

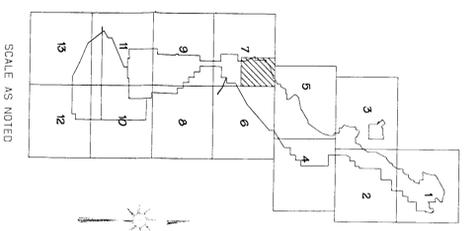

SCALE AS NOTED

**STAGE STORAGE DATA**

ELEV. (ft.)	AREA (ac-ft)	VOLUME (bc-ft)	CUM. VOLUME (bc-ft)
5380	0.00	0.00	0.00
5381	0.05	0.02	0.02
5382	0.13	0.09	0.11
5383	0.25	0.19	0.31
5384	0.68	0.45	0.76
5385	0.94	0.80	1.56
5386	1.17	1.05	2.61
5387	1.45	1.31	3.92
5388	2.02	1.73	5.65
5389	2.72	2.37	8.02

**CERTIFICATION STATEMENT**

I, Leonard Raymond, hereby certify that this drawing was reviewed by me and to the best of my knowledge is complete and accurate to the best of my knowledge.



**EXHIBIT 26-39**  
**SOUTH BARBER POND**  
**DESIGN**

**PLAN, PROFILE AND**  
**SECTION**




ACCOUNT: \_\_\_\_\_  
DATE: JAN. 30, 2006  
DESIGNED BY: WJ. NAPOLEON  
DRAWN BY: WJ. NAPOLEON  
CHECKED BY: LEONARD RAYMOND  
APPROVED BY: LEONARD RAYMOND

**BHP NAVAJO COAL CO.**  
**NAVAJO MINE**

PO BOX 1717, FRUITLAND, NEW MEXICO, 87416

REV. NO.	DESCRIPTION	REV. BY	DATE
1	SUBMITTED TO OSM FOR APPROVAL		01-30-06
2			
3			
4			


PROJECT MANAGER: BEN HOSKIE  
ENGR. of RECORD: LEONARD RAYMOND  
REG. NO. 6600  
SURVYR of RECORD: \_\_\_\_\_  
REG. NO. \_\_\_\_\_

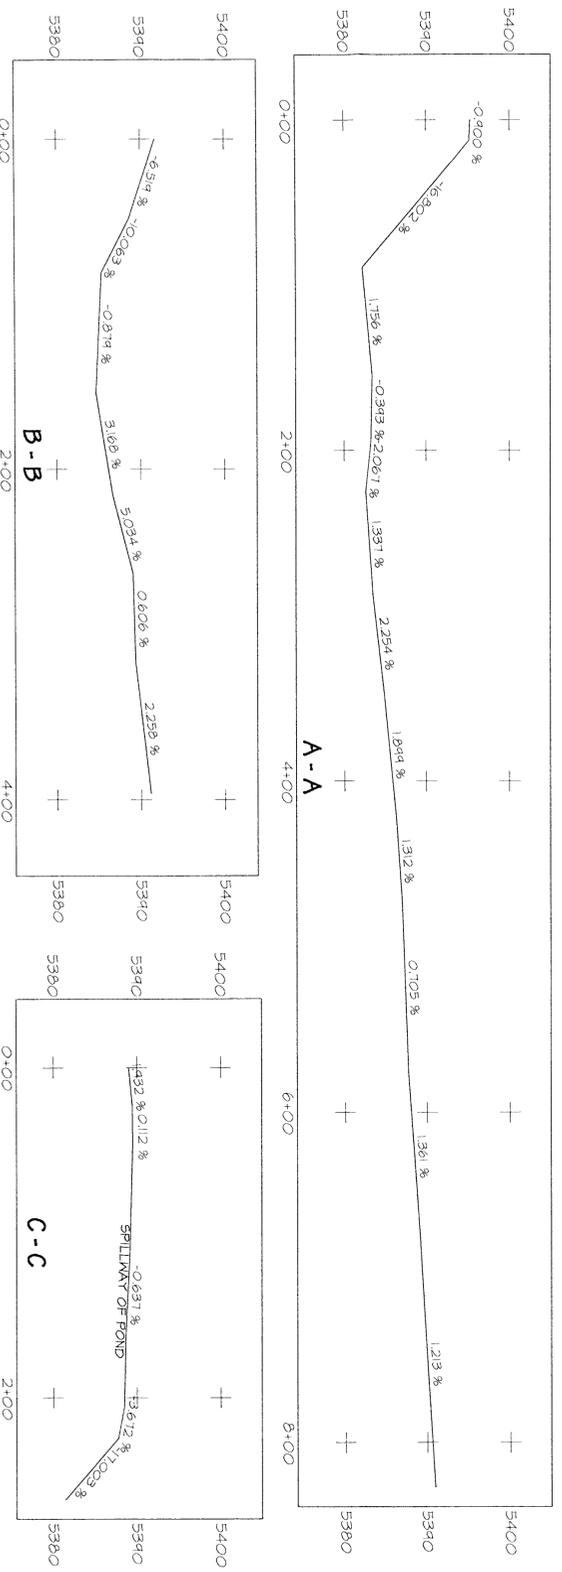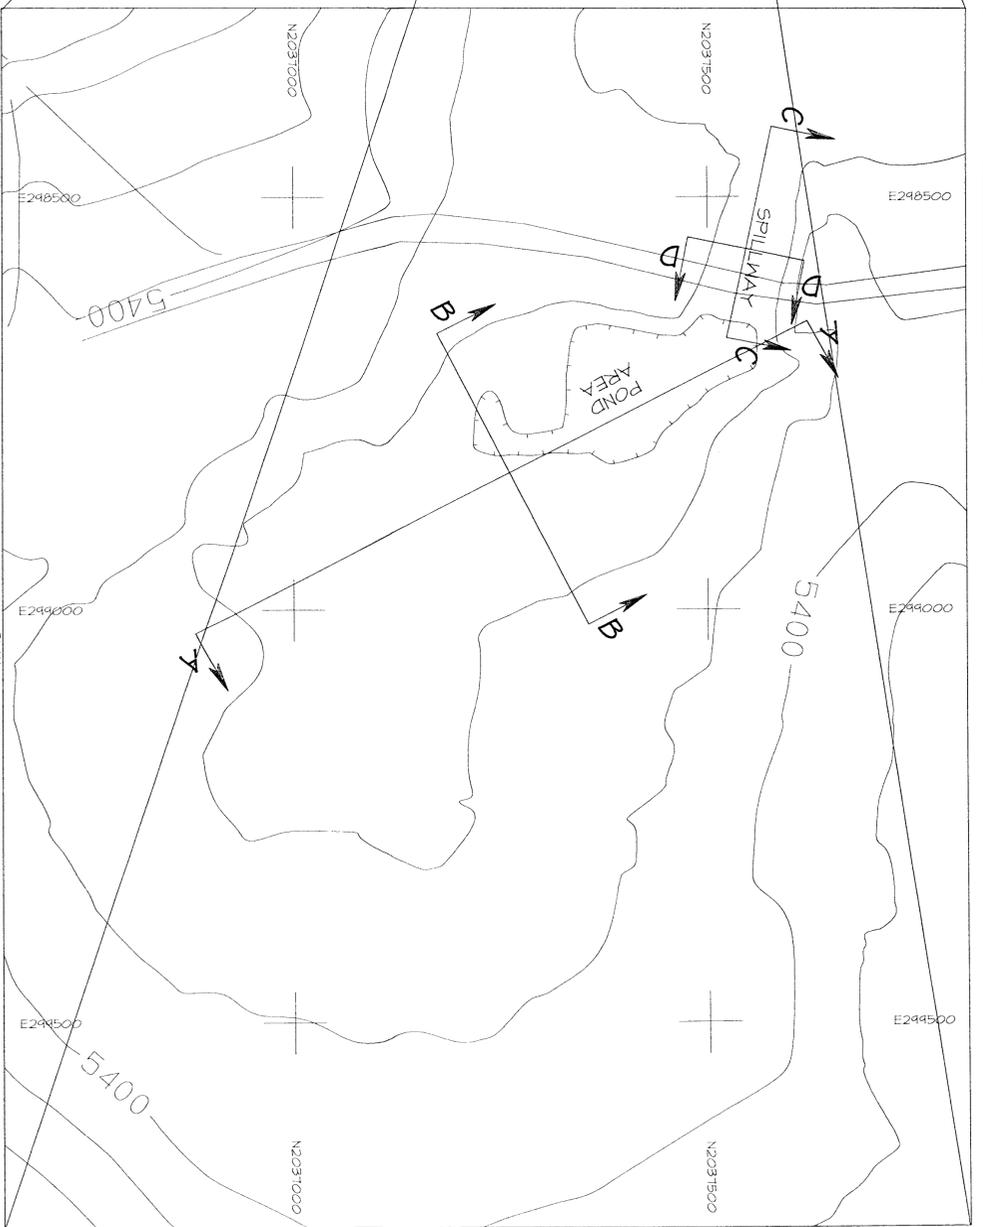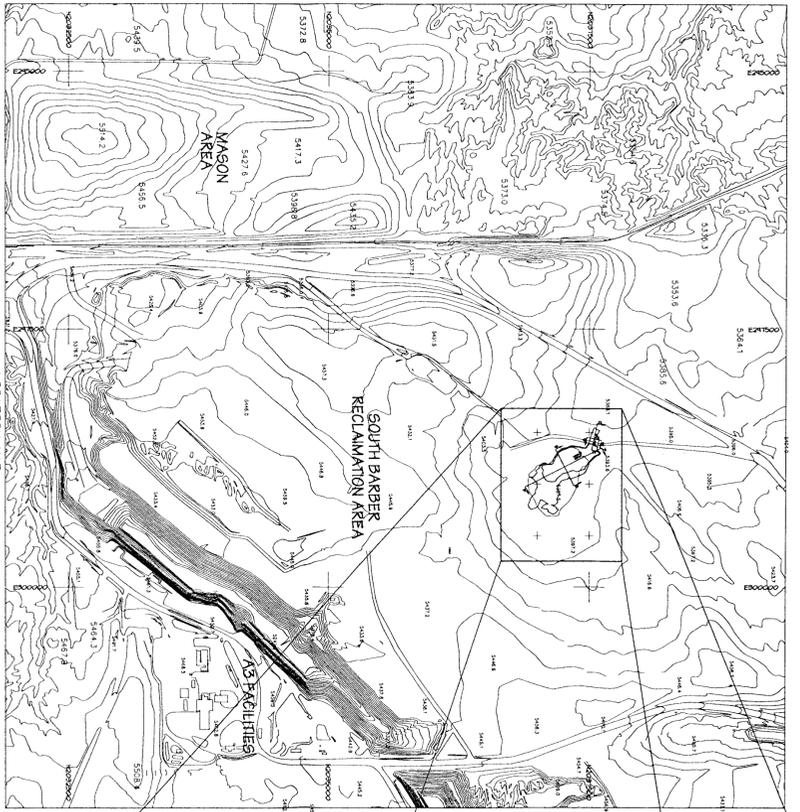


TYPICAL SECTIONS  
SCALE: 1" = 100'

ELEV. Feet.	AREA ac-ft.	VOLUME cu-ft.	CUM. VOLUME
5380.4	0.01	0.00	0.00
5382	0.04	0.03	0.03
5384	0.43	0.52	0.54
5386	1.04	1.52	2.07
5388	2.06	3.15	5.22
5390.4	2.35	0.45	6.17
5394.4	4.82	3.50	4.15

STAGE STORAGE DATA

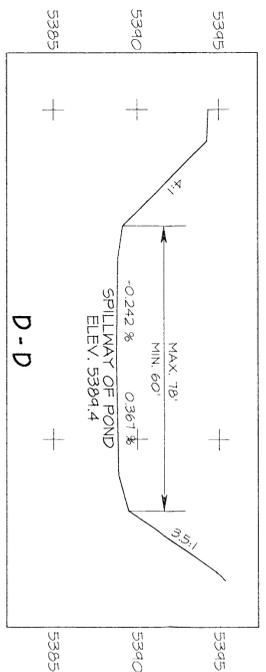

TYPICAL SECTION D-D  
SCALE: 1" = 100'

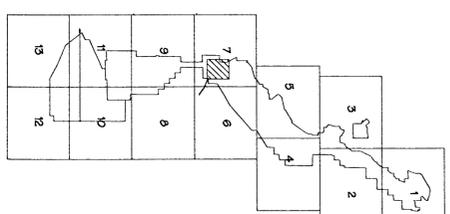

SCALE AS NOTED

LEGEND

- ROAD
- WATERSHED
- BUILDING
- FENCE
- IRRIGATION LINE
- CULVERT
- DAM
- DRAINAGE
- RAILROAD
- TREES
- POWERLINE
- SPOT ELEVATION
- INDEX CONTOUR
- INTERMEDIATE CONTOUR
- PERMIT/LEASE BOUNDARY
- LEASE CORNER

NOTES

1. FOR PROPOSED AND EXISTING INFORMATION, SEE PIP AND SURVEY DATA.
2. FOR WATERSHED AREA, SEE EXHIBIT 11-130.
3. SEE TABLE 11-5F FOR IMPOUNDMENT DATA.

I, Leonard Raymond, hereby certify that this pond has been constructed in accordance with the approved design plans and that the information shown is complete and accurate to the best of my knowledge.

CERTIFICATION STATEMENT



6-16-06




**EXHIBIT 26-40**  
**SOUTH BARBER POND**  
**AS-BUILT**

**PLAN, PROFILE AND SECTIONS**


ACCOUNT: \_\_\_\_\_  
DATE: 6-15-06  
DESIGNED BY: RY  
DRAWN BY: RY  
CHECKED BY: LR  
APPROVED BY: LR

**BHP NAVAJO COAL CO.**  
**NAVAJO MINE**  
PO BOX 1717, FRUITLAND, NEW MEXICO, 87416

NO.	DESCRIPTION	REV. BY	DATE
1	SUBMITTED TO OSM FOR REVIEW	RY	6-15-06
2			
3			
4			
5			

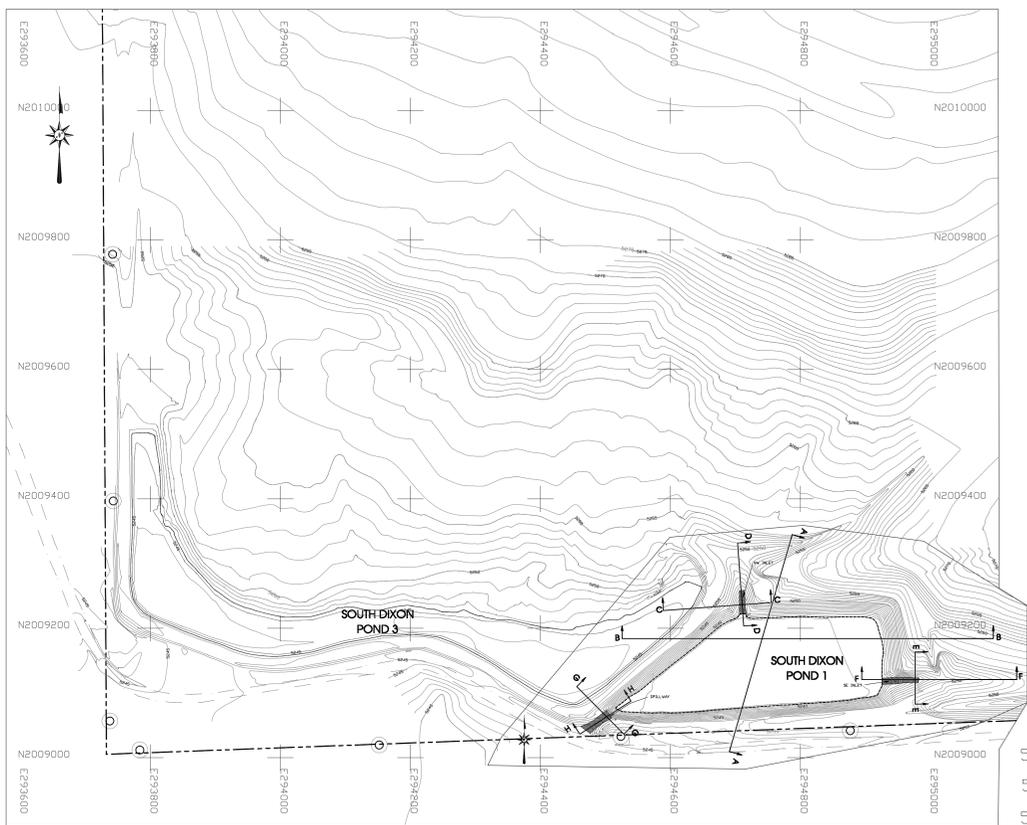

South Dixon Pond-1  
Location Map  
Scale: 1" = 100'

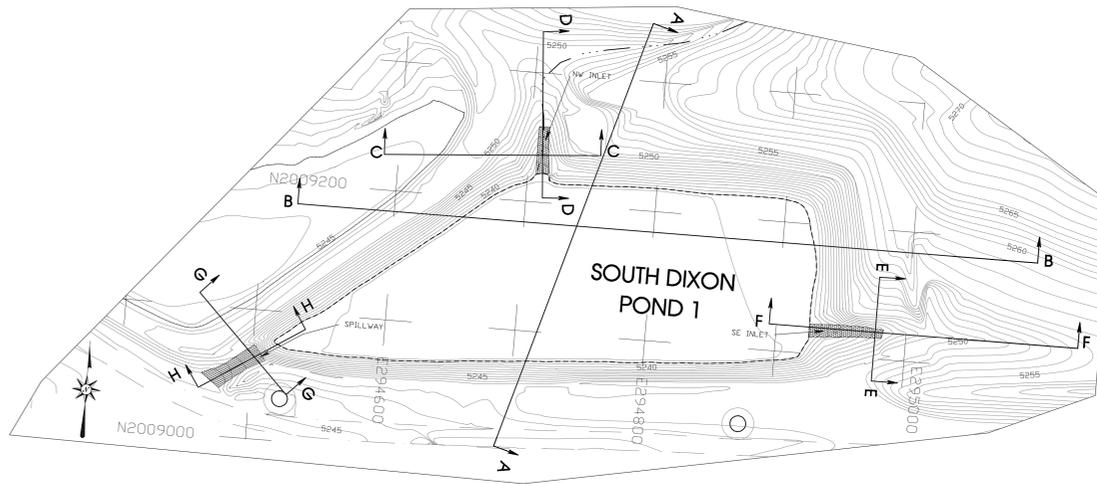

South Dixon Pond-1  
Plan View  
Scale: 1" = 50'

LEGEND


- DIRT ROAD
- POWERLINE
- INDEX CONTOUR
- INTERMEDIATE CONTOUR
- LEASE BOUNDARY

NOTES:


1. For watershed information refer to Exhibit 11-13E in the approved PAP.
2. For hydrology information refer to Appendix 11-AA in the approved PAP.
3. For design information refer to Exhibit 11-51A in the approved PAP.
4. Maximum Water or Sediment Level = 5246.50

STAGE STORAGE DATA


ELEV feet	AREA acres	VOLUME ac-ft	CUM. VOLUME ac-ft
5237	0.777	0.000	0.000
5238	1.006	0.898	0.898
5239	1.098	1.040	1.938
5240	1.107	1.091	3.029
5241	1.197	1.140	4.170
5242	1.207	1.191	5.360
5243	1.298	1.242	6.602
5244	1.311	1.294	7.896
5245	1.368	1.349	9.246
5246	1.430	1.409	10.655
5247	1.495	1.473	12.128
5248	1.555	1.536	13.664
5249	1.602	1.590	15.254

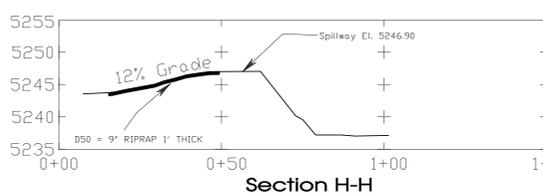


Section H-H

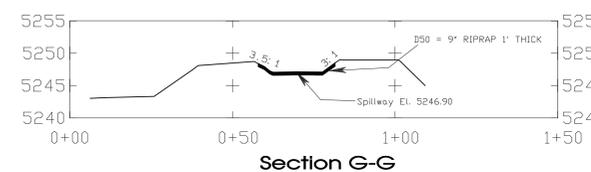

Section G-G

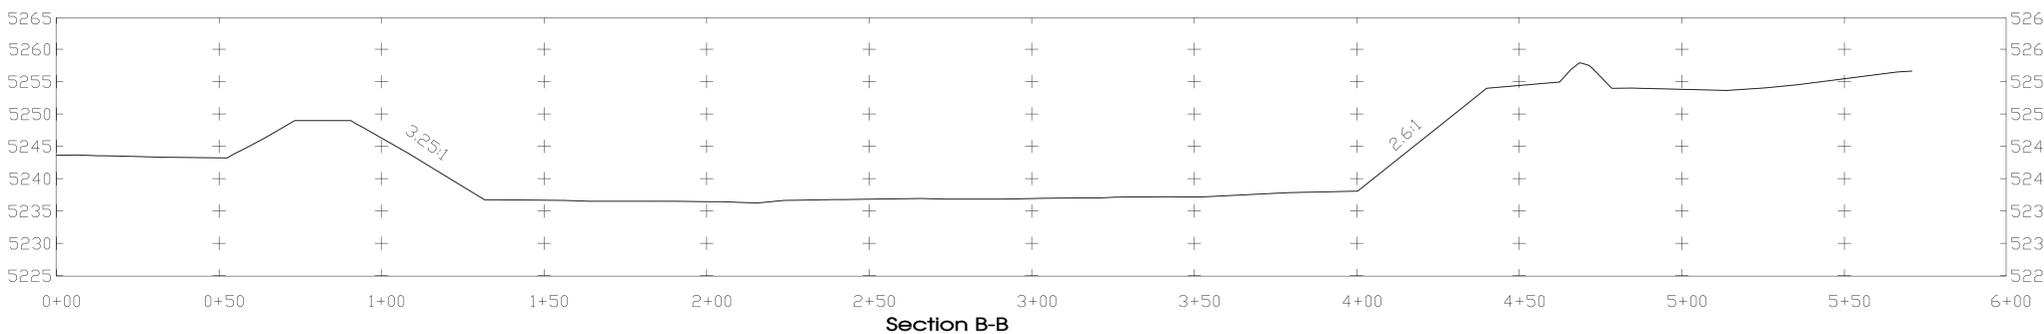


Section B-B

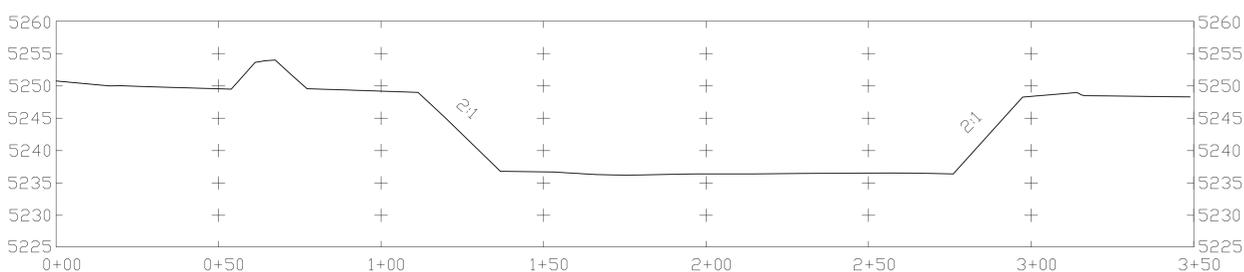


Section A-A


SOUTH DIXON POND-1  
Cross Sections A-A thru H-H  
Scales:  
Horizontal: 1" = 20'  
Vertical: 1" = 10'

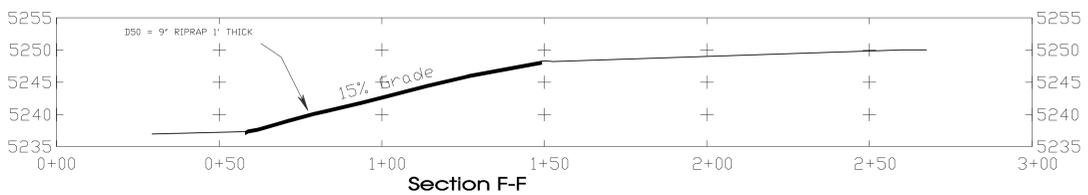


Section F-F

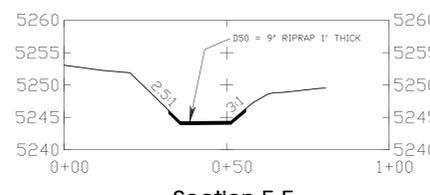

Section E-E

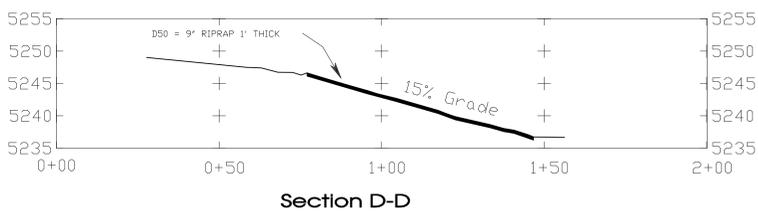

Section D-D

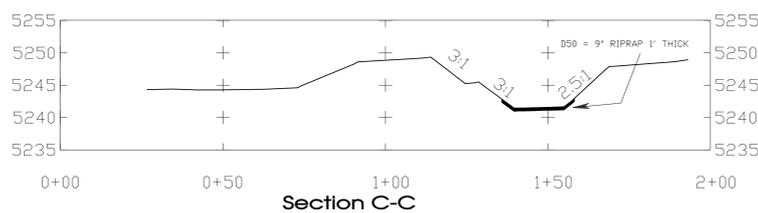

Section C-C



CERTIFICATION STATEMENT

I, Ron C. Van Valkenburg, hereby certify that this drawing was reviewed by me and that the information shown is complete and accurate to the best of my knowledge.



G:\GSA\Permit\F:\Ch 11\Exh 11-061\_S Dixon Pd 1\As-Built Data\Exh 11-51C.D-SDX-PD1-3.ppt

REV	DATE	BY	DESCRIPTION	ENG. (E.G. P.E.)	APPROVALS
00-A	2-03-06	VJF	UPDATED EXHIBIT AND RESUBMITTED TO OSH FOR REVIEW.		
00-B	11-20-08	VJF	UPDATED NOTES, LOCATION MAP TOPS, ADDED TEXT IN SECTION 11-4 AND SUBMITTED TO OSH FOR REVIEW.		
A	03/21/97	VAH	SUBMITTED TO OSH FOR APPROVAL.		

Exhibit 26-41

NAVAJO COAL COMPANY




P.O. BOX 105 FRUITLAND, NEW MEXICO 87416

AREA 3


"AS BUILT"

South Dixon Pond #1


PREPARED BY VAH	DRAWN BY VAH	SCALE AS NOTED
APPROVED BY LR	DATE 03/21/97	REF DWG

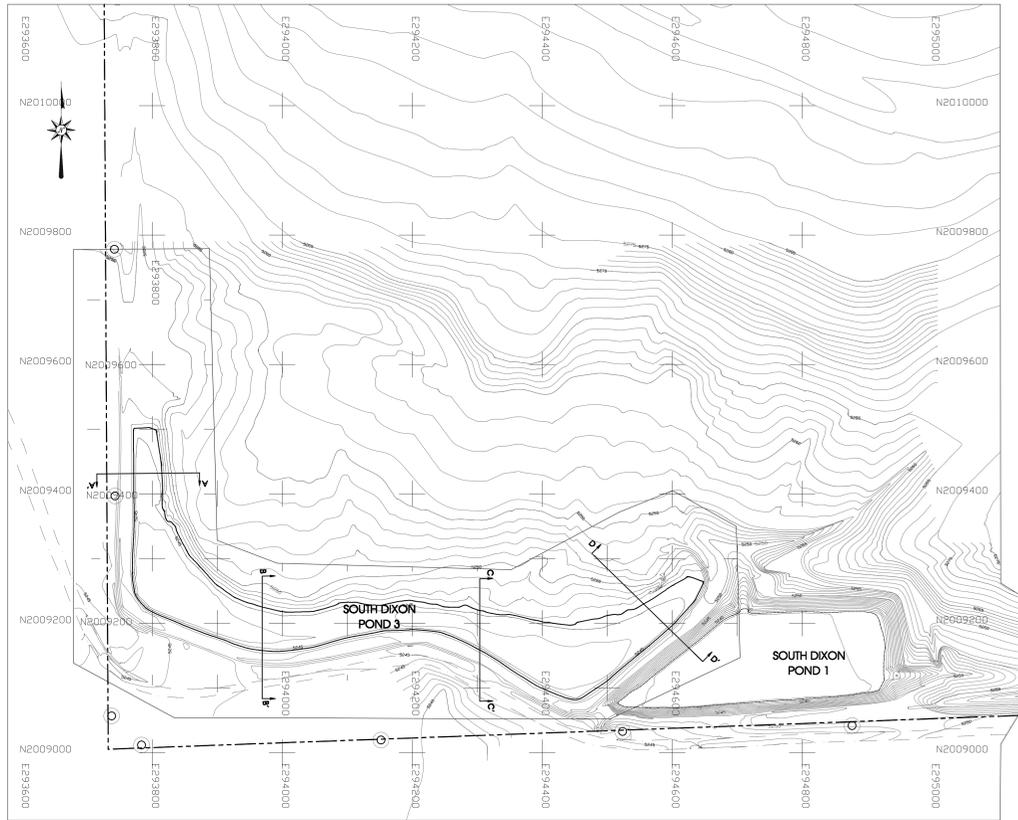


South Dixon Pond-3  
Location Map  
Scale: 1" = 100'

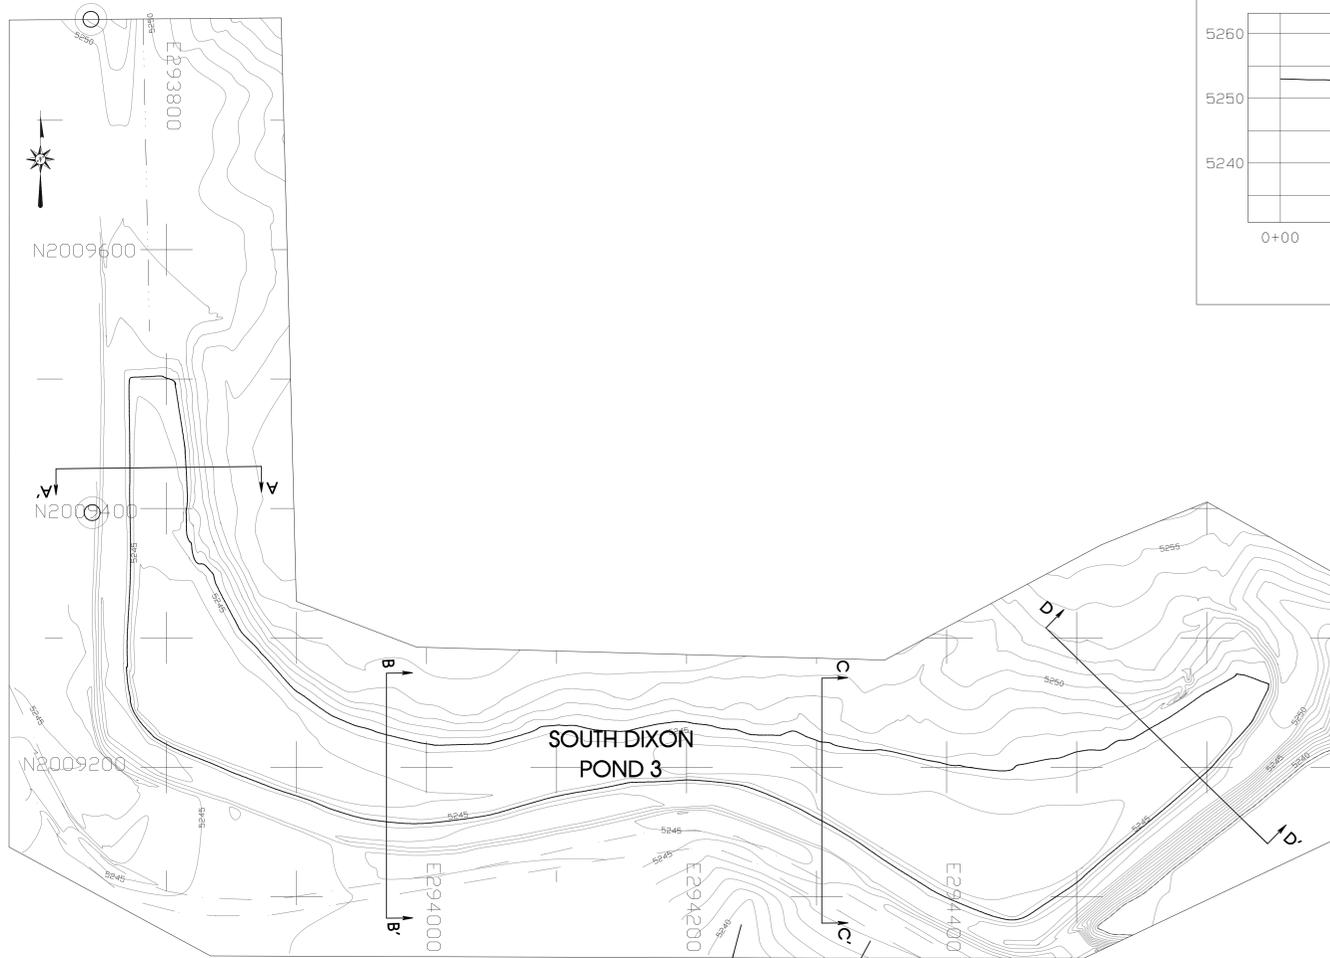


South Dixon Pond-3  
Plan View  
Scale: 1" = 50'  
Contour Interval = 1'-0"

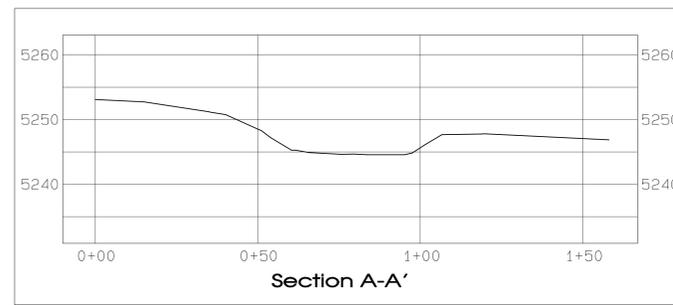


Section A-A'

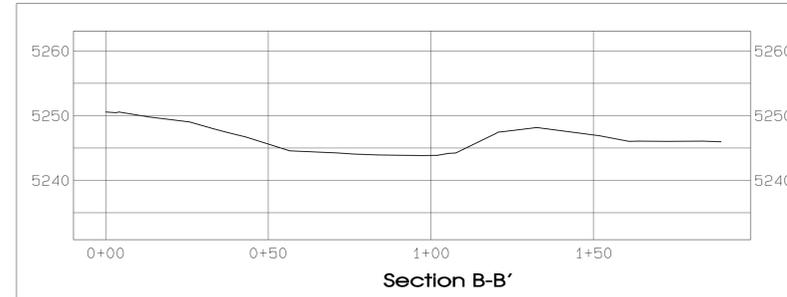

Section B-B'

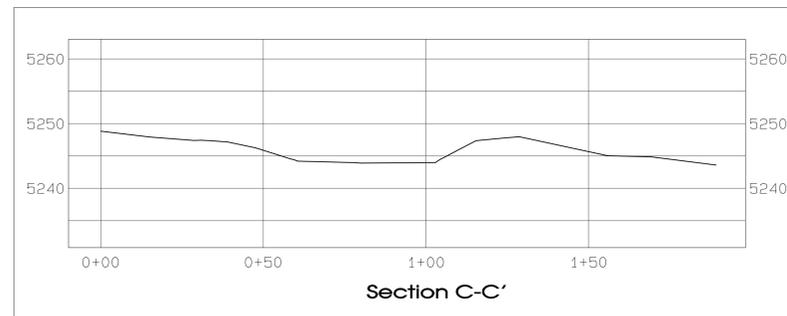

Section C-C'

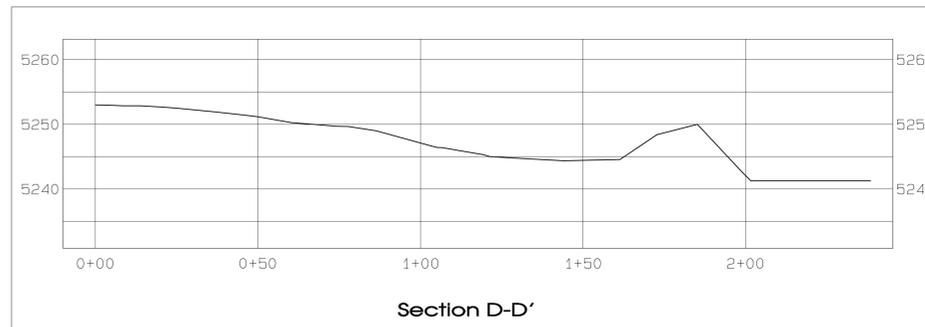

SOUTH DIXON POND-3  
Cross Sections A-A' thru D-D'  
Scales  
Horizontal: 1" = 20'  
Vertical: 1" = 10'

LEGEND


- DIRT ROAD
- POWERLINE
- INDEX CONTOUR
- INTERMEDIATE CONTOUR
- LEASE BOUNDARY

NOTES:

1. For watershed information refer to Exhibit 11-13 E in the approved PAP.
2. For hydrology information refer to Appendix 11-AA in the approved PAP.
3. For design information refer to Exhibit 11-51B in the approved PAP.
4. This pond contains the 100yr-Bq storm, therefore no spillway is needed.
5. Maximum Water or Sediment Level = 5246.25

STAGE STORAGE DATA

ELEV feet	AREA acres	VOLUME ac-ft	CUM. VOLUME ac-ft
5243.5	0.1	0.0	0.0
5244.0	0.7	0.2	0.2
5245.0	1.4	1.0	1.2
5246.0	1.7	1.5	2.8
5247.0	1.9	1.8	4.6

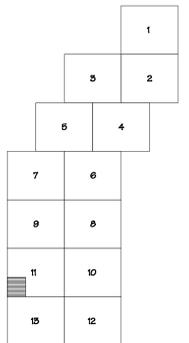

CERTIFICATION STATEMENT

I, Ron C. Van Valkenburg, hereby certify that this drawing was reviewed by me and that the information shown is complete and accurate to the best of my knowledge.



G:\GA\Permit\F\Ch 11\Exh 11-051\_S Dixon Pd 1\As-Built Data\Exh 11-51C\_D-SDX PD1-3.prn

REV	DATE	BY	REVISION DESCRIPTION	ENG. (E.G. P.E.)	APPROVALS
01-A	0-03-09	PLF	UPDATED EXHIBIT AND RESUBMITTED TO OSH FOR REVIEW		
02-A	11-20-08	PLF	AS-BUILT SOUTH DIXON POND-3 AND UPDATED NOTES TO REFLECT STORM DATA AND SUBMITTED TO OSH FOR REVIEW		
03	03/21/97	VAH	SUBMITTED TO OSH FOR APPROVAL		




**Exhibit 26-42**  
**NAVAJO COAL COMPANY**  
NAVAJO MINE  
P.O. BOX 155 FRUITLAND, NEW MEXICO 87416

AREA 3

South Dixon Pond #3  
"AS BUILT" - 2008

PREPARED BY VAH	DRAWN BY VAH	SCALE AS NOTED
APPROVED BY LR	DATE 03/21/97	REF DWG



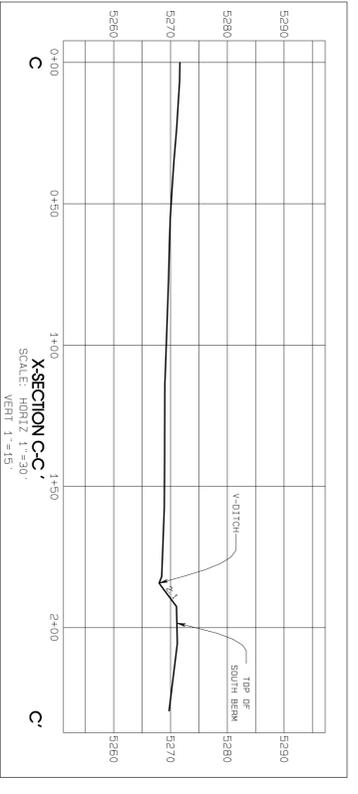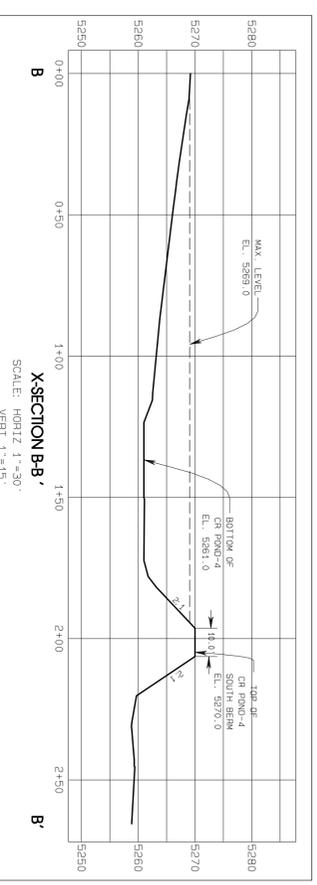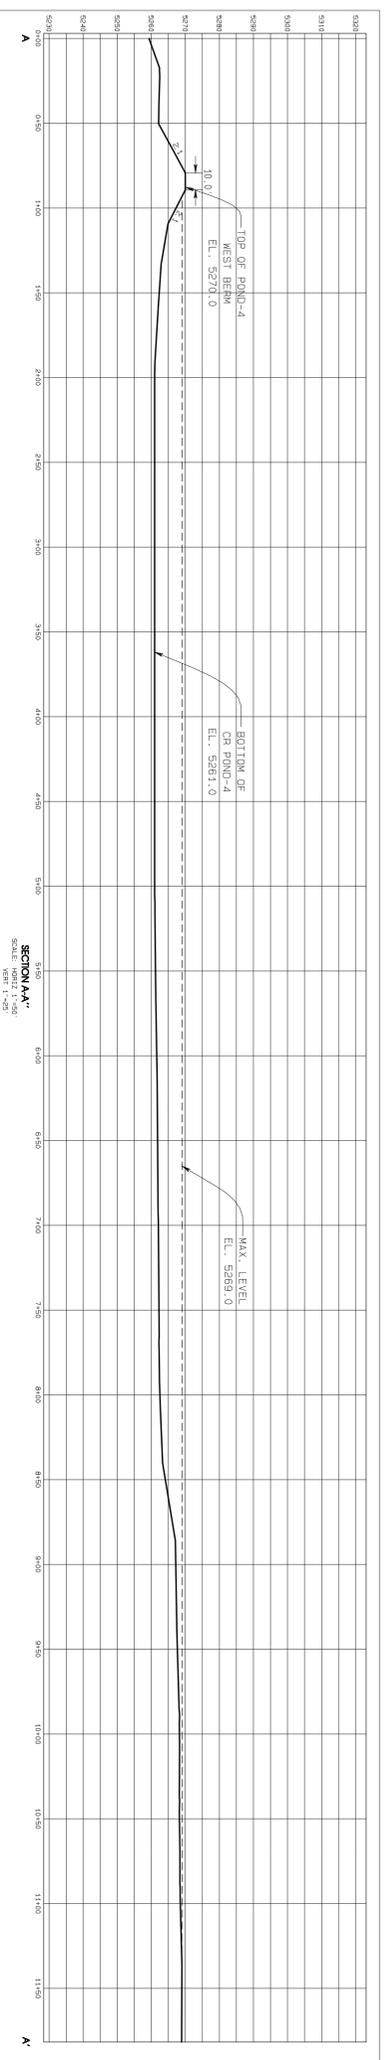

**CR POND-4**  
**STAGE STORAGE DATA**


ELEV. FEET	AREA ACRES	VOLUME AC-FT	CUM. VOLUME AC-FT
5281	0.319	0.0	0.0
5282	0.650	0.5	0.5
5283	1.036	0.8	1.3
5284	1.296	1.2	2.5
5285	1.524	1.4	3.9
5286	1.730	1.6	5.5
5287	1.938	1.8	7.4
5288	2.179	2.1	9.4
5289	2.646	2.4	11.8

Pond Crest Elevation-5270.0  
As-Built Volume at Crest (Ac-FT)-11.84

**LEGEND**

	ROAD
	WATERSHED
	BUILDINGS
	FENCE
	IRRIGATION LINE
	CULVERT
	DAM
	DRAINAGE
	RAILROAD
	TREES
	POWER LINE
	SPOT ELEVATION
	INDEX CONTOUR
	INTERMEDIATE CONTOUR
	LEASE CORNER
	PERMIT/LEASE BOUNDARY

- NOTES**
1. For hydrology and design information refer to Appendix 11-4A in the approved PAP.
  2. Refer to Table 11-5 for additional data.

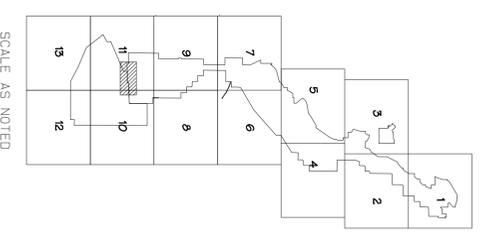


**CERTIFICATION STATEMENT**

I, Ron C. Van Valkenburg, hereby certify that this embankment has been constructed in accordance with the approved design plans and that the information shown is complete and accurate to the best of my knowledge except as noted below:

1. Approximately 1,000 feet of the embankment extension was removed at the East end to construct the Cottonwood Crossing Haulroad. This reduced the watershed area for CR Pond-4. The hydrology for the pond was revised accordingly. See Appendix 11-AA for supporting data.



<p><b>EXHIBIT 26-43</b> <b>CR POND-4</b> <b>AS-BUILT</b></p>	<p><b>X-SECTIONS</b></p>	<table border="1" style="width: 100%; border-collapse: collapse;"> <tr><td>PROJECT:</td><td>AREA-3 CR POND-4 AS-BUILT</td></tr> <tr><td>DATE:</td><td>DEC. 14, 2009</td></tr> <tr><td>PREPARED BY:</td><td>RJ.FOSTER</td></tr> <tr><td>DRAWN BY:</td><td>RJ.FOSTER</td></tr> <tr><td>CHECKED BY:</td><td>RON C. VAN VALKENBURG</td></tr> <tr><td>APPROVED BY:</td><td>RON C. VAN VALKENBURG</td></tr> </table>	PROJECT:	AREA-3 CR POND-4 AS-BUILT	DATE:	DEC. 14, 2009	PREPARED BY:	RJ.FOSTER	DRAWN BY:	RJ.FOSTER	CHECKED BY:	RON C. VAN VALKENBURG	APPROVED BY:	RON C. VAN VALKENBURG	 <p><b>NAVAJO COAL COMPANY</b> <b>NAVAJO MINE</b></p> <p>PO BOX 1717, FRUITLAND, NEW MEXICO, 87416 PHONE 505-598-3209/FAX 505-598-3361</p>	<table border="1" style="width: 100%; border-collapse: collapse;"> <tr><td>PROJECT MANAGER:</td><td>F. GORMAN</td></tr> <tr><td>ENGR. OF RECORD:</td><td>RON C. VAN VALKENBURG</td></tr> <tr><td>REG. NO.:</td><td>NM 9263</td></tr> <tr><td>DRAWN BY:</td><td>RJ.FOSTER</td></tr> <tr><td>REG. NO.:</td><td></td></tr> </table>	PROJECT MANAGER:	F. GORMAN	ENGR. OF RECORD:	RON C. VAN VALKENBURG	REG. NO.:	NM 9263	DRAWN BY:	RJ.FOSTER	REG. NO.:		<table border="1" style="width: 100%; border-collapse: collapse;"> <tr><td>REVISION</td><td>DATE</td></tr> <tr><td>1 PREPARED AS-BUILT FOR CR POND-4 AND SUBMITTED TO OSM FOR REVIEW</td><td>DEC. 17, 2009</td></tr> <tr><td> </td><td> </td></tr> <tr><td> </td><td> </td></tr> </table>	REVISION	DATE	1 PREPARED AS-BUILT FOR CR POND-4 AND SUBMITTED TO OSM FOR REVIEW	DEC. 17, 2009				
PROJECT:	AREA-3 CR POND-4 AS-BUILT																																		
DATE:	DEC. 14, 2009																																		
PREPARED BY:	RJ.FOSTER																																		
DRAWN BY:	RJ.FOSTER																																		
CHECKED BY:	RON C. VAN VALKENBURG																																		
APPROVED BY:	RON C. VAN VALKENBURG																																		
PROJECT MANAGER:	F. GORMAN																																		
ENGR. OF RECORD:	RON C. VAN VALKENBURG																																		
REG. NO.:	NM 9263																																		
DRAWN BY:	RJ.FOSTER																																		
REG. NO.:																																			
REVISION	DATE																																		
1 PREPARED AS-BUILT FOR CR POND-4 AND SUBMITTED TO OSM FOR REVIEW	DEC. 17, 2009																																		
DRAWING PLAN 2 SHEET 2 OF 2																																			





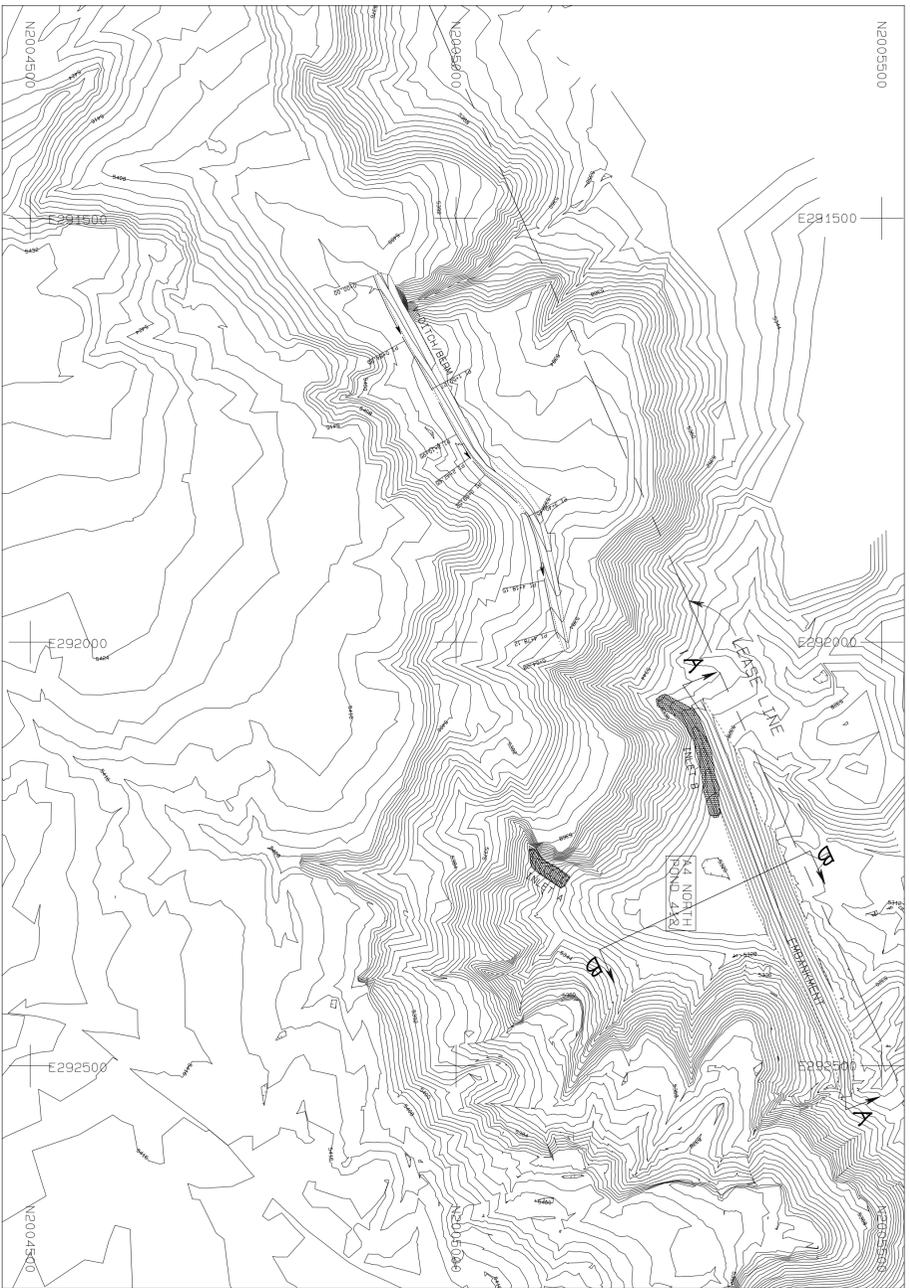


**LEGEND**

- ROAD
- WATERSEED
- BUILDINGS
- DRAIN DITCH
- IRRIGATION LINE
- CULVERT
- DAM
- DRAINAGE
- RAILROAD
- TREES
- POWERLINE
- SPOT ELEVATION
- INDEX CONTOUR
- INTERMEDIATE CONTOUR
- 5298
- 5300
- X5329.5
- 218
- 5422.45
- L-30
- PERMIT/LEASE BOUNDARY
- LEASE CORNER

**NOTES**



1. For hydrology and design information refer to Appendix 31-4A in the approved PAP.
2. The watershed areas for Impoundment and pond locations are shown on Exhibit 31-3A.

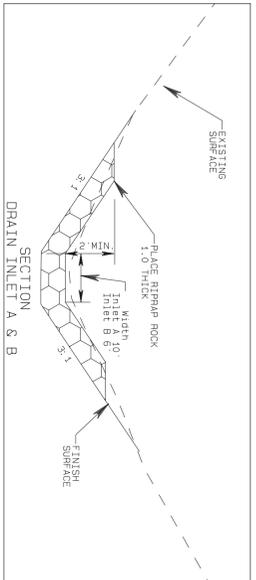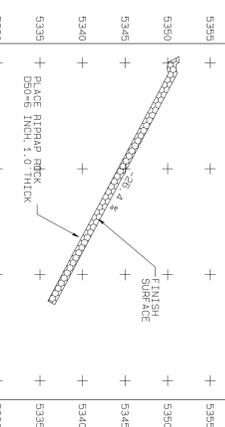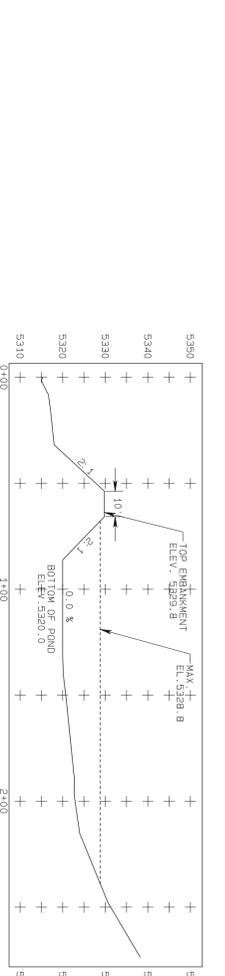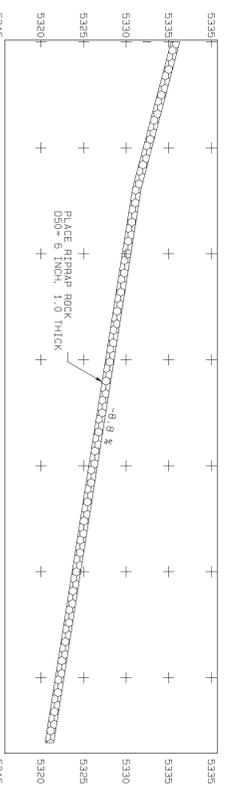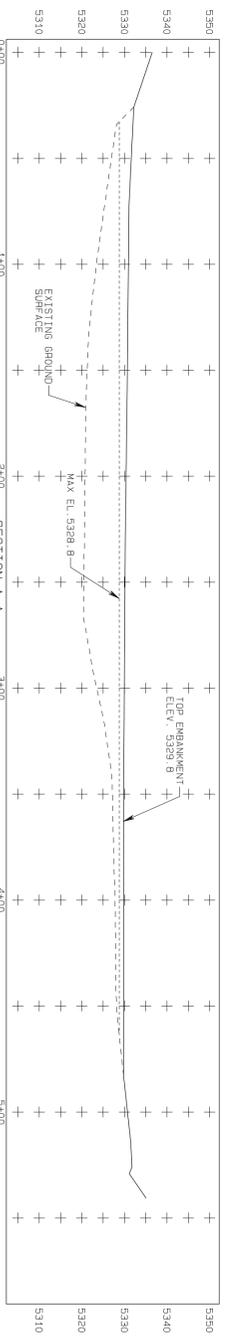

**STAGE STORAGE DATA**

ELEV feet	AREA acres	VOLUME ac-ft	CUM. VOLUME ac-ft
5320	1.01	0.0	0.0
5321	1.17	0.1	0.09
5322	0.23	0.2	0.29
5323	0.29	0.3	0.55
5324	0.35	0.3	0.87
5325	0.41	0.4	1.24
5326	0.46	0.4	1.68
5327	0.52	0.5	2.17
5328	0.59	0.6	2.72
5329	0.67	0.6	3.36
5330	0.75	0.7	4.07

Pond Crest Elevation Post (AC-F1) 5329.8  
 Design Water Elevation 5328.8  
 Capacity @ Max. Water Elevation 3.32

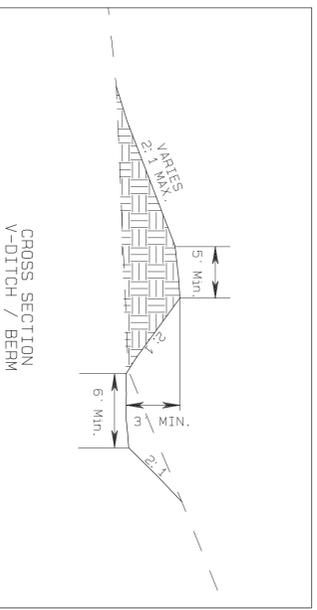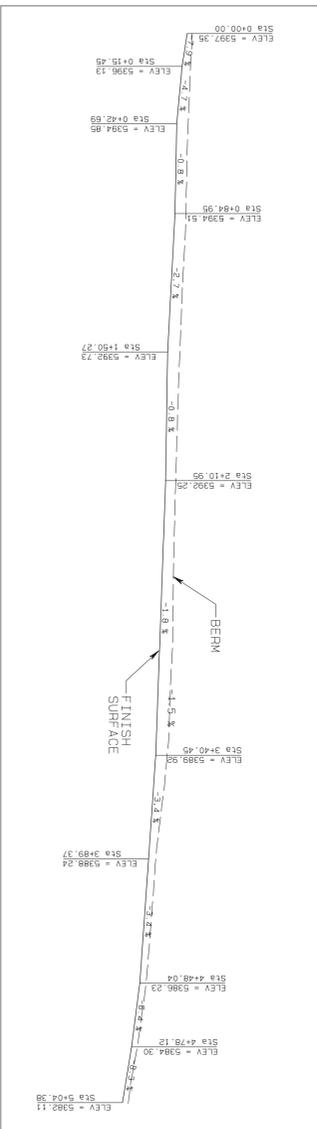


**CERTIFICATION STATEMENT**

I, Ron C. VAN WALKENBURG, hereby certify that this information has been prepared by me or under my direct supervision and that the information shown is complete and accurate to the best of my knowledge except as noted below:  
 1. Minor elevation differences for pond contour resulted in smaller capacity. The smaller as-built capacity will contain the design 100-yr 6-hr storm event.



<p><b>EXHIBIT 26-44</b>  <b>AREA 4 NORTH POND 412</b>  <b>AS-BUILT</b></p>	<p><b>PLAN, PROFILE AND SECTION</b></p>	<p>ACCOUNT: _____          DATE: 01-26-10          DESIGNED BY: RY          DRAWN BY: RY          CHECKED BY: RCV          APPROVED BY: RCV</p>	<p><b>BHP NAVAJO COAL CO.</b>  <b>NAVAJO MINE</b>          PO BOX 1717, FRUITLAND, NEW MEXICO, 87416</p>
<p>PROJECT MANAGER: FG          ENGR. of RECORD: RCV          REG. NO: 9263          SVR. of RECORD: _____          REG. NO: _____</p>	<p>DESCRIPTION          1. SUBMITTED TO OSM FOR APPROVAL RY 11-19-04          2. SUBMITTED TO OSM FOR APPROVAL RY 01-29-10          3. Prepared As-Built for Area 4 Pond 412 and submitted to OSM for Review and Approval PF 07-29-10          4. SUBMITTED TO OSM FOR REVIEW AND APPROVAL PF 01-26-11</p>	<p>REV NO. _____          DATE _____</p>	

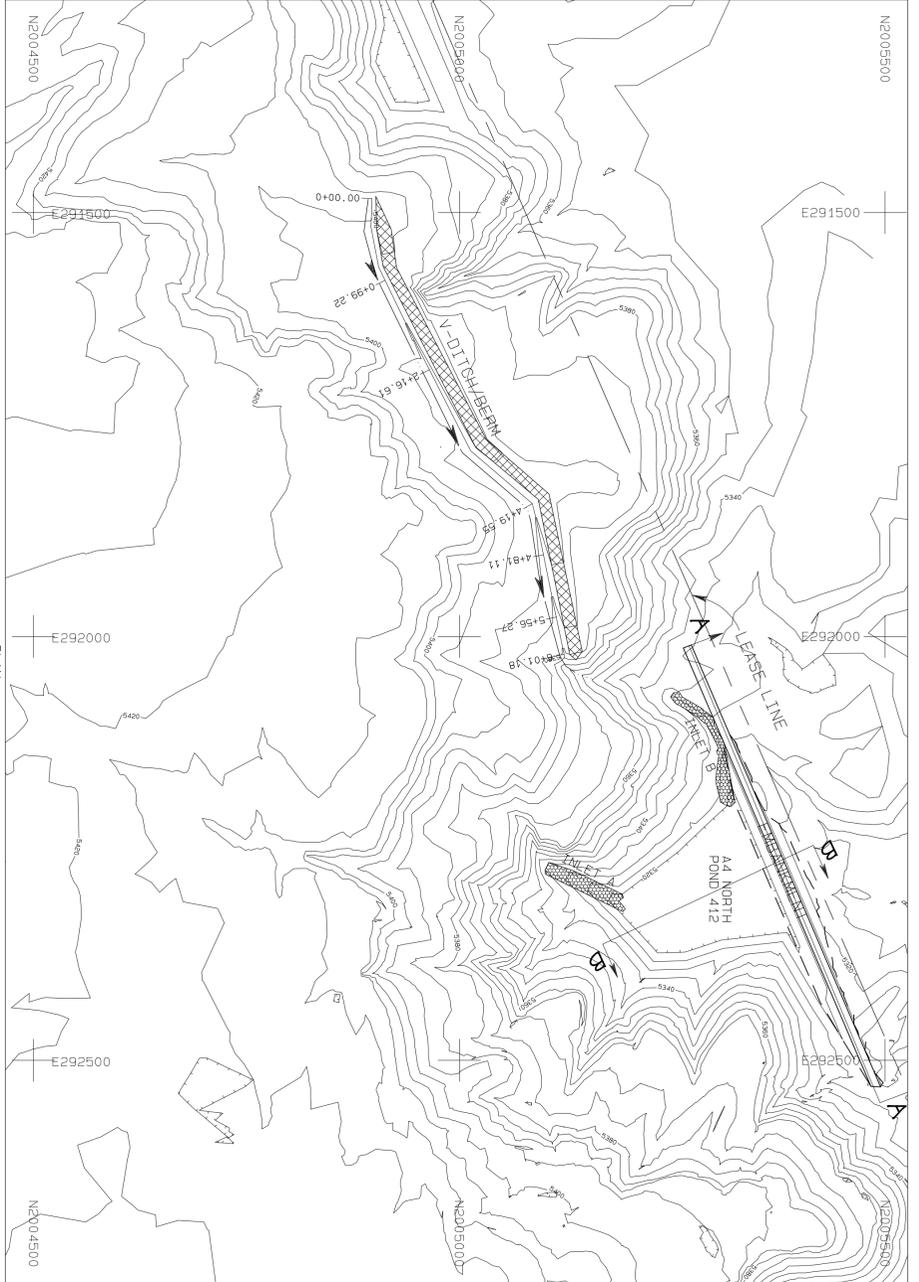


**LEGEND**






- ROAD
- WATERSHED
- BUILDING
- DRAIN DITCH
- PARALLEL LINE
- CULVERT
- DAM
- DRAINAGE
- RAILROAD
- TREES
- POWERLINE
- SPOT ELEVATION
- INDEX CONTOUR
- INTERMEDIATE CONTOUR
- LEASE CORNER
- PERMIT/LEASE BOUNDARY

**NOTES**

1. For hydrology and design information refer to Appendix 11-A in the approved P&P.
2. The watershed areas for Impoundment and Pond 412 are shown on drawing 11-13P.


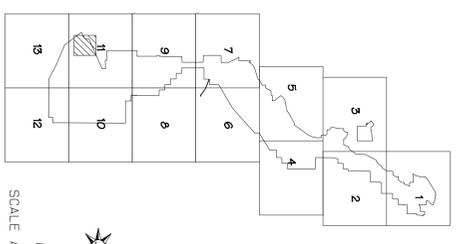


SCALE AS NOTED

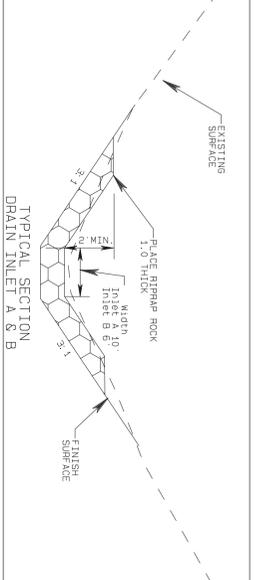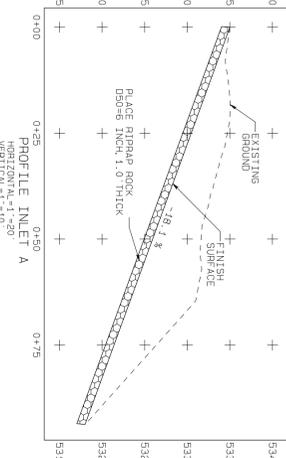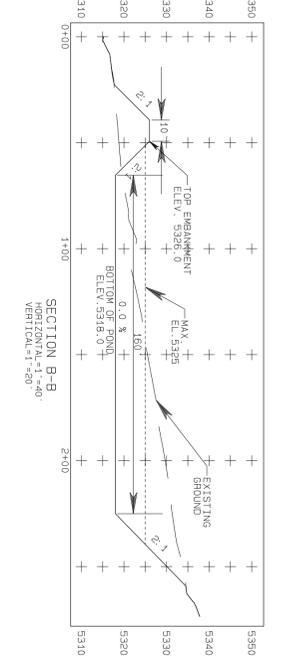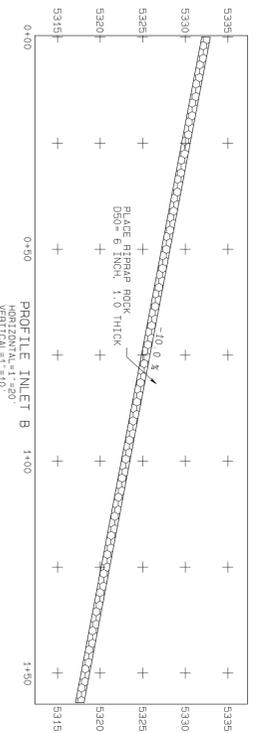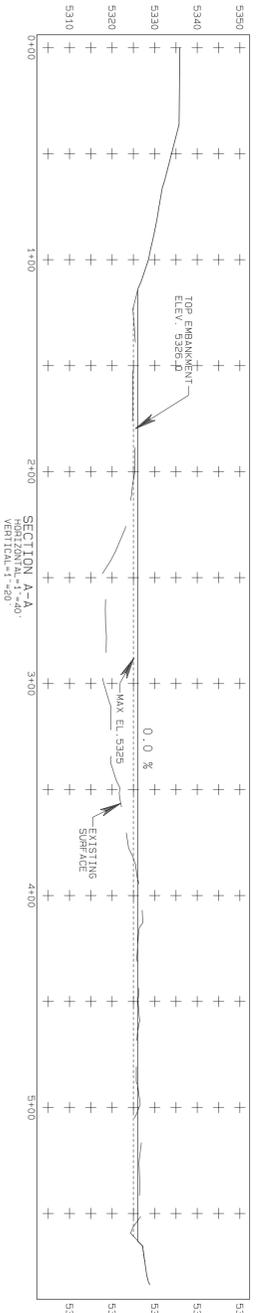

**STAGE STORAGE DATA**

ELEV. FEET	AREA ACRES	VOLUME AC-FT	CUM. VOLUME AC-FT
5318	0.42	0.0	0.0
5320	0.48	0.9	0.9
5322	0.56	1.0	1.9
5324	0.64	1.2	3.1
5326	0.77	1.4	4.5

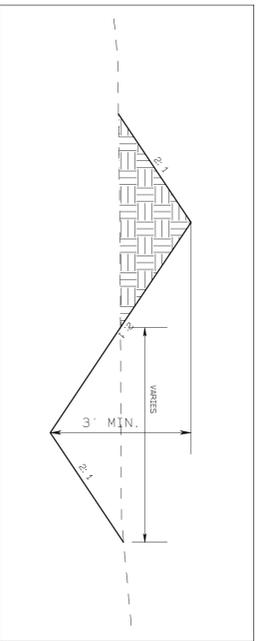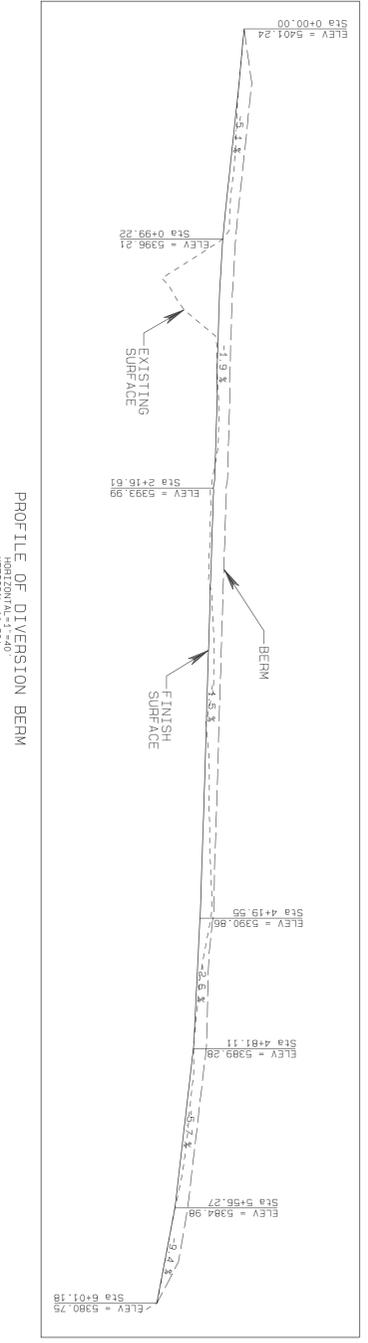

**CERTIFICATION STATEMENT**

I, Ron C. VAN VALKENBURG, hereby certify that this drawing was reviewed by me and that the information shown is complete and accurate to the best of my knowledge.



**EXHIBIT 26-45  
AREA 4 NORTH POND 412  
DESIGN**







**PLAN, PROFILE AND  
SECTION**

ACCOUNT: \_\_\_\_\_  
DATE: 01-26-10  
DESIGNED BY: RY  
DRAWN BY: RB  
CHECKED BY: RCV  
APPROVED BY: RCV

**BHP NAVAJO COAL CO.  
NAVAJO MINE**

PO BOX 1717, FRUITLAND, NEW MEXICO, 87416

REV NO.	DESCRIPTION	REV BY	DATE
1	SUBMITTED TO OSM FOR APPROVAL	RY	11-19-04
2	SUBMITTED TO OSM FOR APPROVAL	RY	01-26-10
11-A	AREA 4 NORTH REVISION RESUBMITTAL TO OSM FOR REVIEW AND APPROVAL	PJF	FEB-2011

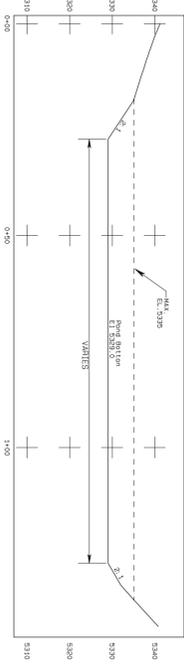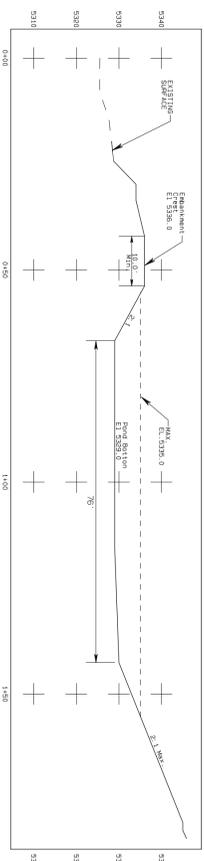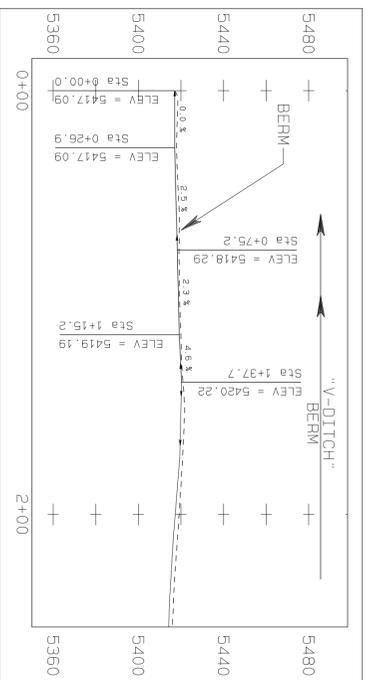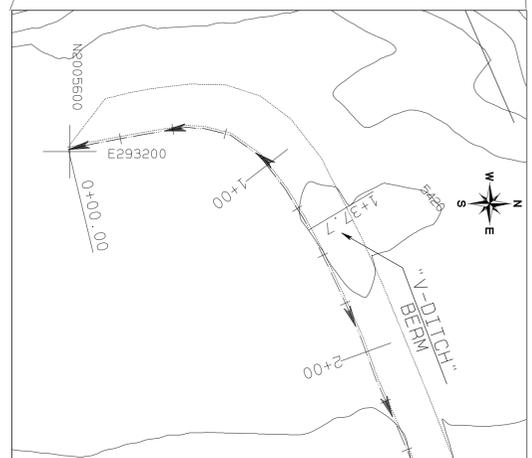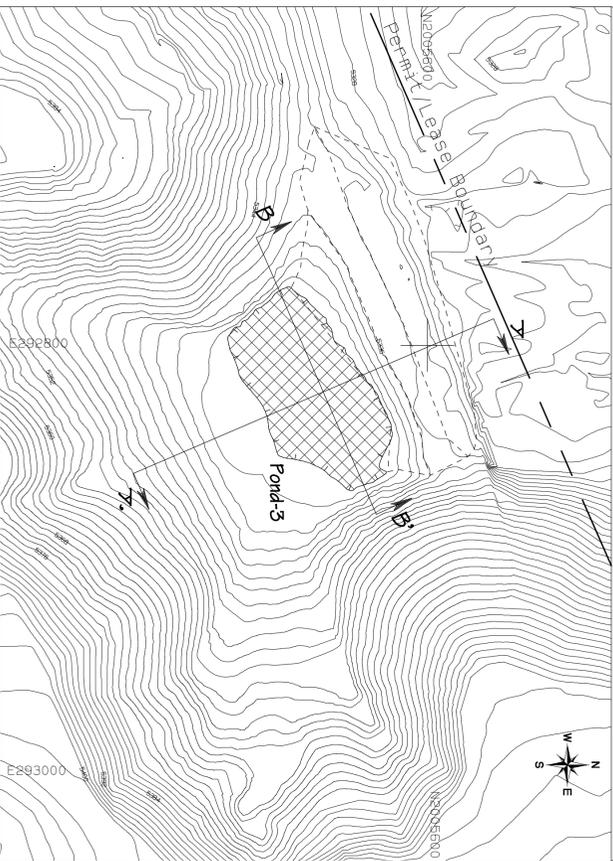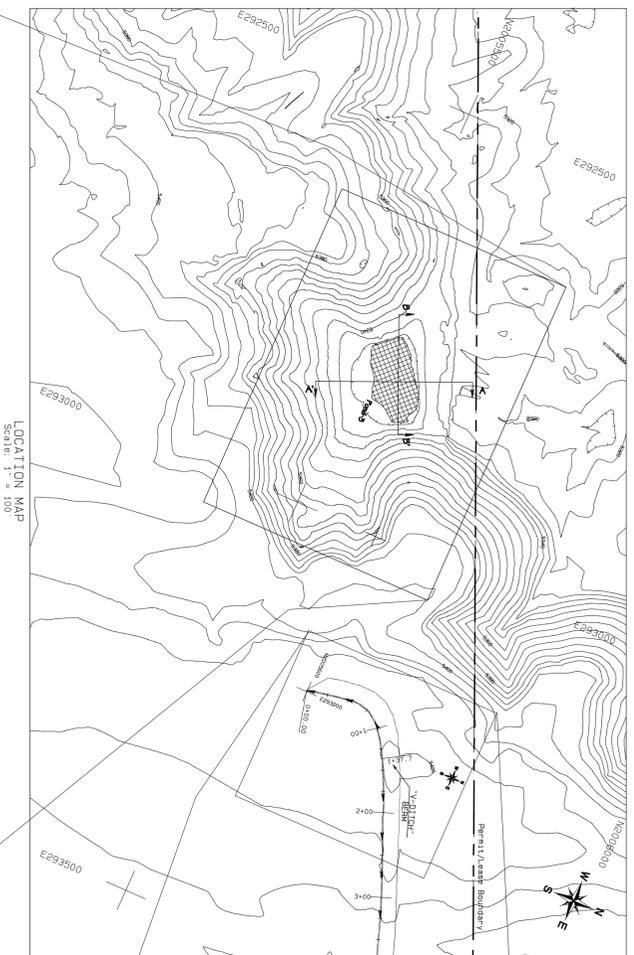


**LEGEND**

- ROAD
- WATERSHED
- BUILDING
- FENCE
- IRRIGATION LINE
- CULVERT
- DAM
- RAILROAD
- TREES
- POWER LINE
- SPOT ELEVATION
- INDEX CONTOUR
- INTERMEDIATE CONTOUR
- LEASE CORNER
- PERMIT/LEASE BOUNDARY
- DRAIN FLOW

**NOTES**

- For hydroplaning information refer to pond design at the approved map.
- The watershed area for Reservoir and pond locations are shown on Exhibit 11-13F.

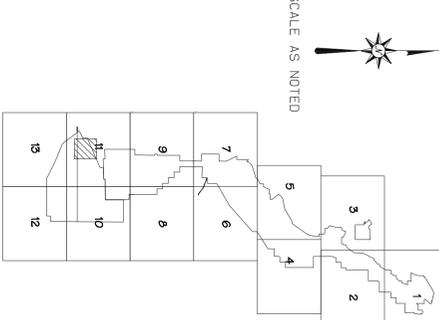

**STAGE STORAGE DATA**

ELEV	AREA	VOLUME	CUM. VOLUME
Feet	ac-ft	ac-ft	ac-ft
5329	0.09	0.0	0.0
5330	0.197	0.12	0.12
5331	0.186	0.12	0.30
5332	0.208	0.48	0.48
5333	0.229	0.71	0.71
5334	0.249	0.95	0.95
5335	0.270	1.21	1.21
5336	0.294	1.49	1.49

**CERTIFICATION STATEMENT**

I, Ron C. Van Valkenburg, hereby certify that this structure has been constructed in accordance with the approved design plans and that the information shown is complete and accurate except as noted below:  
 1. Only minor elevation differences for pond bottom and embankment crest.





ACCOUNT: \_\_\_\_\_  
 DATE: 01-26-10  
 DESIGNED BY: RY  
 DRAWN BY: RY  
 CHECKED BY: RCV  
 APPROVED BY: RCV

**BHP NAVAJO COAL CO.**  
**NAVAJO MINE**  
 PO BOX 1717, FRUITLAND, NEW MEXICO, 87416

REV	DATE	DESCRIPTION
1	11-19-04	SUBMITTED TO USM FOR APPROVAL
2	01-13-10	REVISIONS TO PER FOR APPROVAL. ADD SCHEDULE FROM
3	01-26-10	PREPARED AS-BUILT AND SUBMITTED TO USM FOR REVIEW
4	06-21-10	
5		


PROJECT MANAGER: FG  
 ENGR. OF RECORD: RCV  
 REG. NO.: 9263  
 SRVYR. OF RECORD:  
 REG. NO.:

**EXHIBIT 26-46**  
**AREA 4 NORTH POND 3**  
**AS-BUILT**

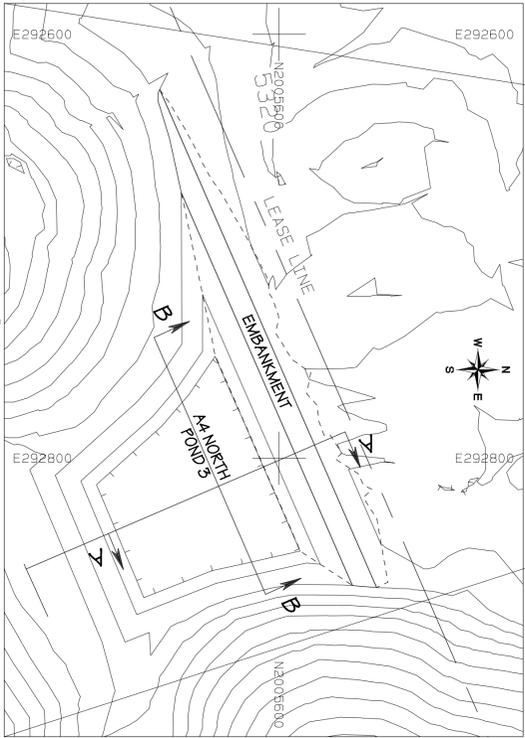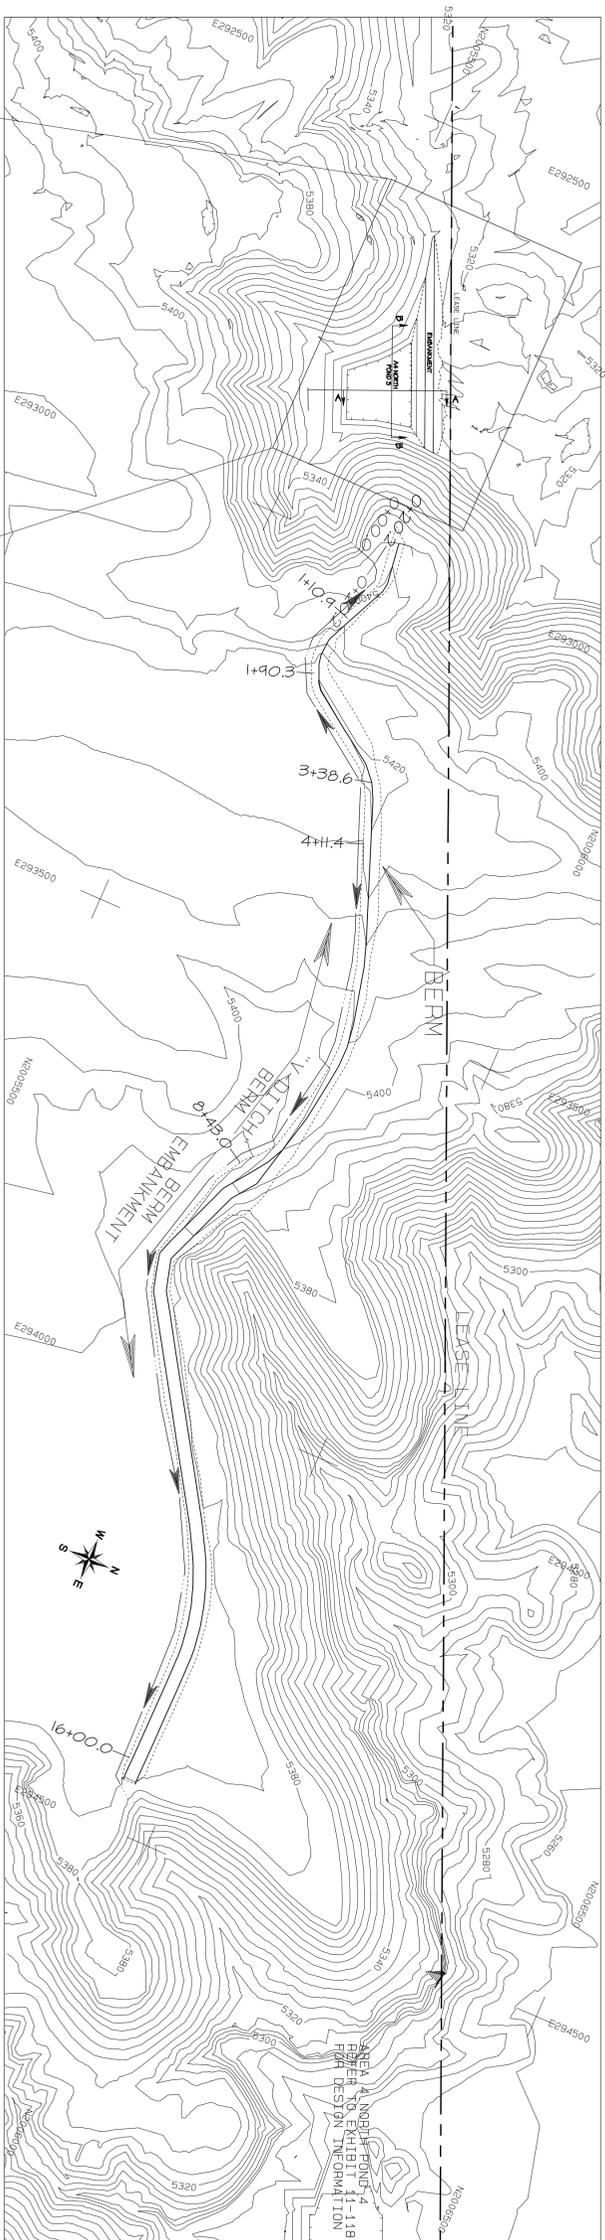


LOCATION MAP  
Scale: 1" = 100'


PLAN  
Scale: 1" = 40'

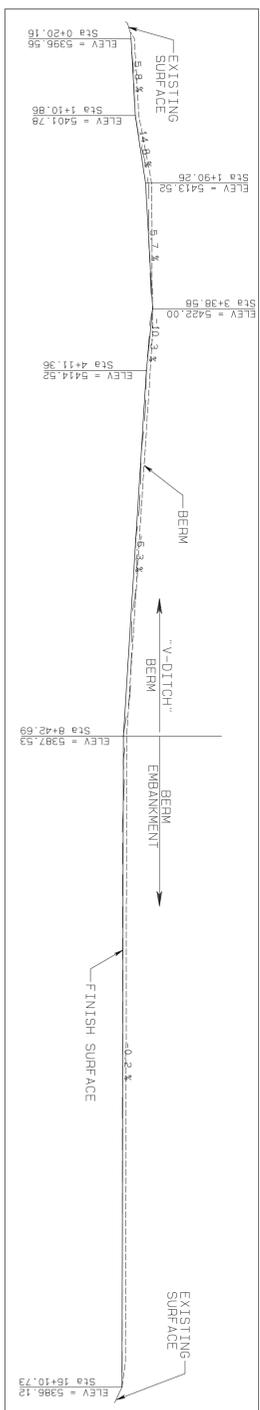



PROFILE - DIVERSION BERM  
Scale: 1" = 100'

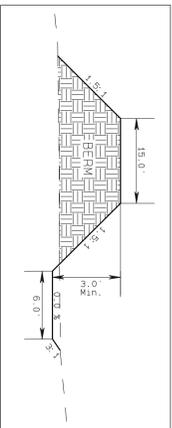

TYPICAL SECTION BERM  
FROM STA. 8+43 TO 16+00  
N.T.S.

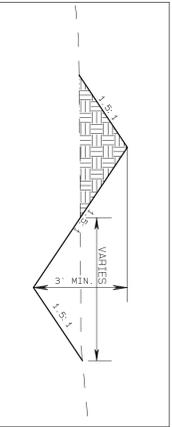

TYPICAL SECTION "V-DITCH" BERM  
FROM STA. 0+00 TO 8+43  
N.T.S.

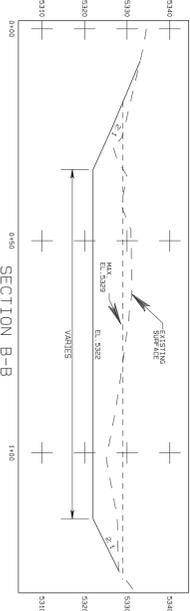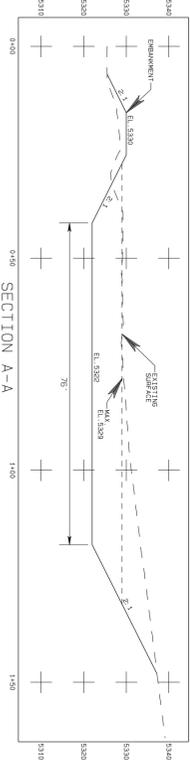


SECTIONS A AND B  
SCALE: 1" = 20'

**LEGEND**

- ROAD
- WATERSHED
- BUILDING
- FENCE
- IRRIGATION LINE
- CULVERT
- DAM
- DRAINAGE
- RAILROAD
- TREES
- POWERLINE
- SPOT ELEVATION
- INDEX CONTOUR
- INTERMEDIATE CONTOUR
- LEASE CORNER
- PERMIT/LEASE BOUNDARY
- DRAIN FLOW

**NOTES**

1. For hydrology and design information, refer to Appendix 11-5A in the approved PAP.
2. The watershed areas for Impoundment and pond locations are shown on Exhibit 11-13F.

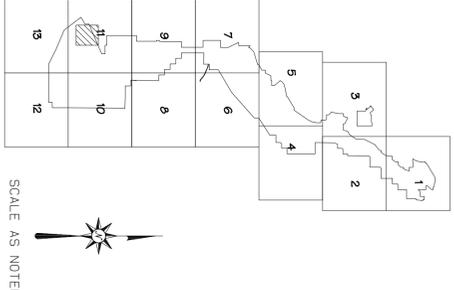

SCALE AS NOTED

ELEV	AREA	VOLUME	CUM. VOLUME
feet	acres	ac-ft	ac-ft
5322	0.13	0.0	0.0
5324	0.16	0.3	0.3
5326	0.20	0.4	0.7
5328	0.24	0.4	1.1
5330	0.29	0.5	1.6

**CERTIFICATION STATEMENT**

I, Ron C. VAN WALKENBURG, hereby certify that this drawing was reviewed by me and that the information shown is complete and accurate to the best of my knowledge.







**EXHIBIT 26-47  
AREA 4 NORTH POND 3  
DESIGN**

**PLAN, PROFILE AND  
SECTION**

ACCOUNT: 01-26-10  
DATE: 01-26-10  
DESIGNED BY: RY  
DRAWN BY: RB  
CHECKED BY: RCV  
APPROVED BY: RCV


**BHP NAVAJO COAL CO.  
NAVAJO MINE**  
PO BOX 1717, FRUITLAND, NEW MEXICO, 87416

REV	DESCRIPTION	REV BY	DATE
1	SUBMITTED TO OSM FOR APPROVAL	RY	11-19-04
2	SUBMITTED TO OSM FOR APPROVAL AND DIVERSION BERM	RY	01-26-10
3	AREA 4 NORTH DIVISION SUBMITTAL TO OSM FOR REVIEW AND APPROVAL	PJF	FEB-2011

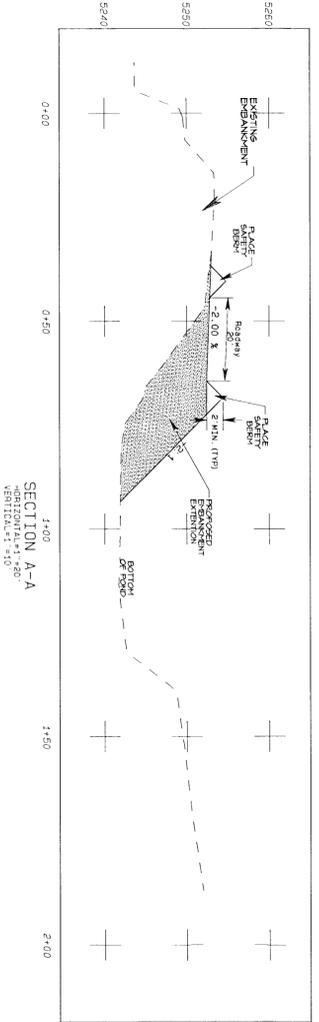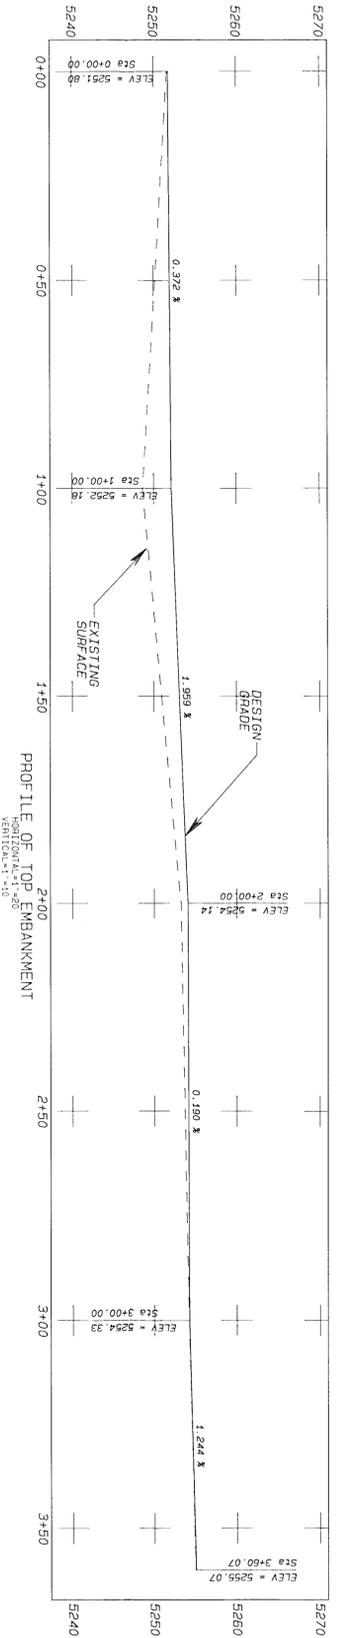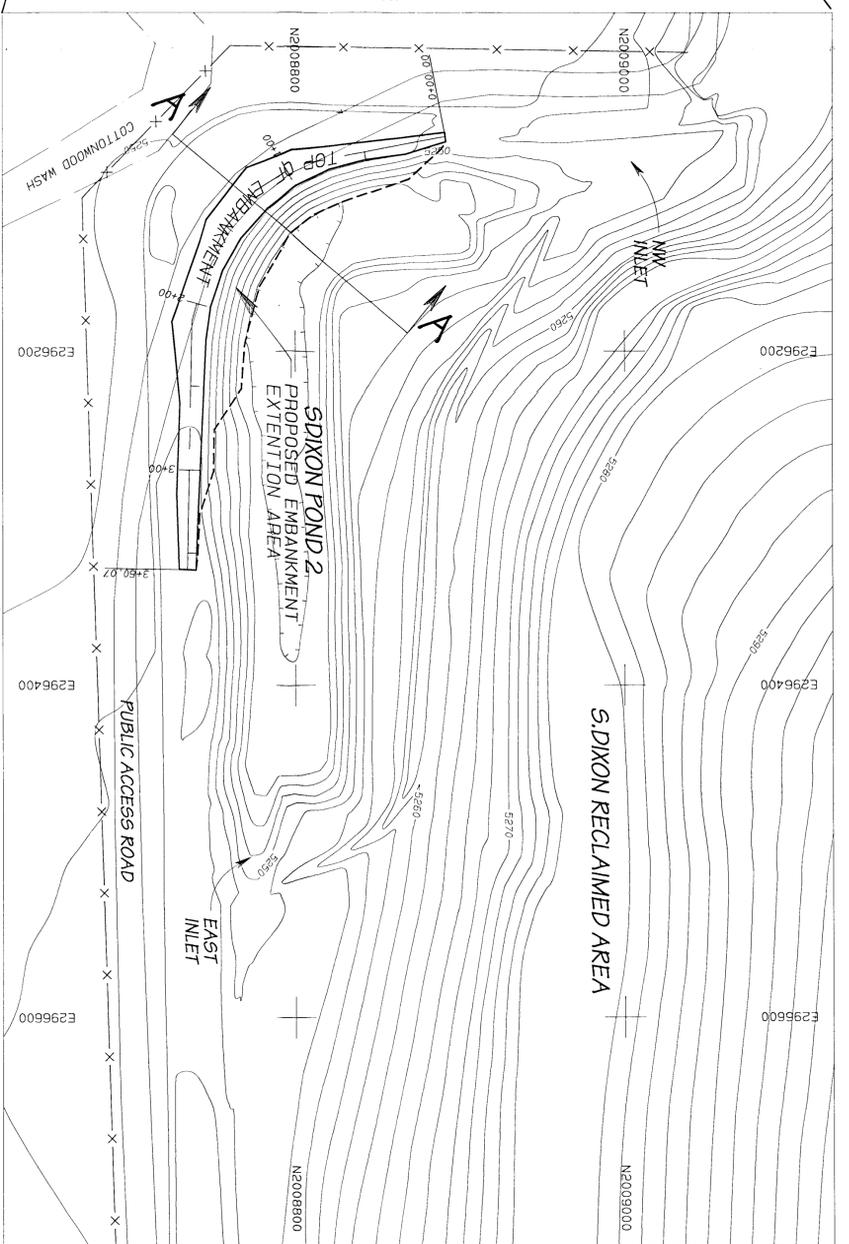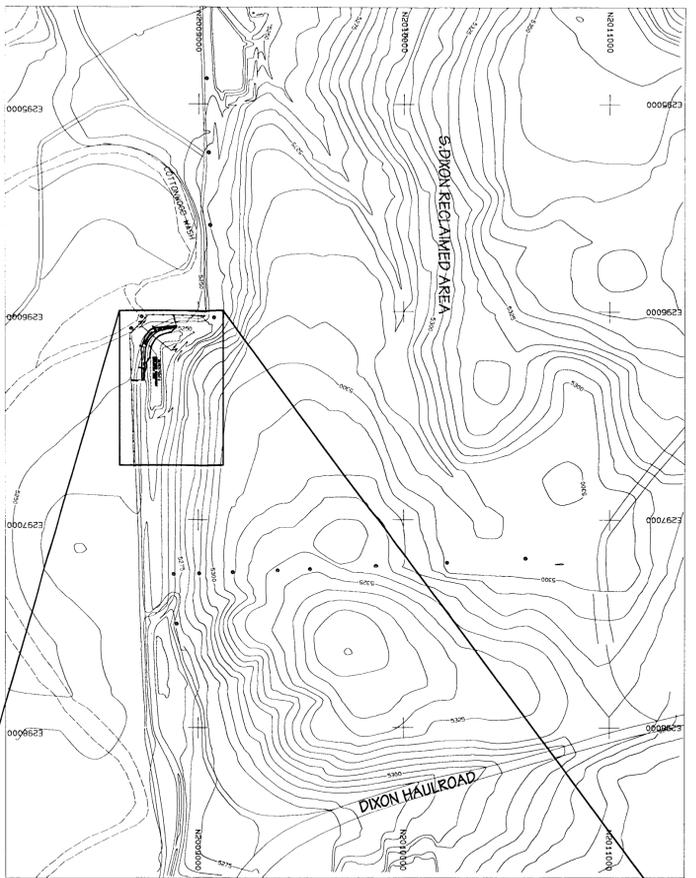

**STAGE STORAGE DATA**

ELEV feet	AREA acres	VOLUME ac-ft	CUM. VOLUME ac-ft
5242	0.16	0.00	0.00
5243	0.35	0.26	0.26
5244	0.46	0.40	0.66
5245	0.51	0.48	1.14
5246	0.56	0.54	1.69
5247	0.62	0.59	2.27
5248	0.68	0.63	2.92
5249	0.74	0.71	3.63
5250	0.83	0.78	4.41
5250.6	0.91	0.85	4.99
5251.6	1.06	0.98	5.94

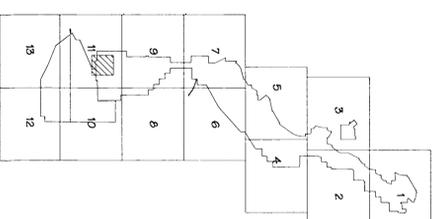

SCALE AS NOTED

- LEGEND**
- ROAD
  - WATERFISHED
  - BUILDING
  - FENCE
  - IRIGATION LINE
  - CULVERT
  - DAK
  - DRAINAGE
  - RAILROAD
  - TREES
  - POWERLINE
  - SPOT ELEVATION
  - INDEX CONTOUR
  - INTERMEDIATE CONTOUR
  - LEASE CORNER
  - PERMIT/LEASE BOUNDARY
- NOTES**
- For photography and design information refer to Appendix 11-1 in the approved PAP.

**CERTIFICATION STATEMENT**

I, Leonard Raymond, hereby certify that this drawing was reviewed by me and that the information shown is complete and accurate to the best of my knowledge.



11-1805



**EXHIBIT 26-48**  
**SOUTH DIXON POND-2**  
**MODIFICATION**  
**DESIGN**

**PLAN, PROFILE AND**  
**SECTION**

ACCOUNT: \_\_\_\_\_  
DATE: 11-18-05  
DESIGNED BY: LR  
DRAWN BY: LR  
CHECKED BY: LR  
APPROVED BY: LR



**BHP NAVAJO COAL CO.**  
**NAVAJO MINE**

PO BOX 1717, FRUITLAND, NEW MEXICO, 87416








REV NO.	DESCRIPTION	REV BY	DATE
1	SUBMITTED TO OSM FOR APPROVAL		11-18-05
2			
3			
4			
5			

PROJECT MANAGER: LR  
ENGR. OF RECORD: LR  
REG. NO. 5650  
SURVR. OF RECORD: LR  
REG. NO.



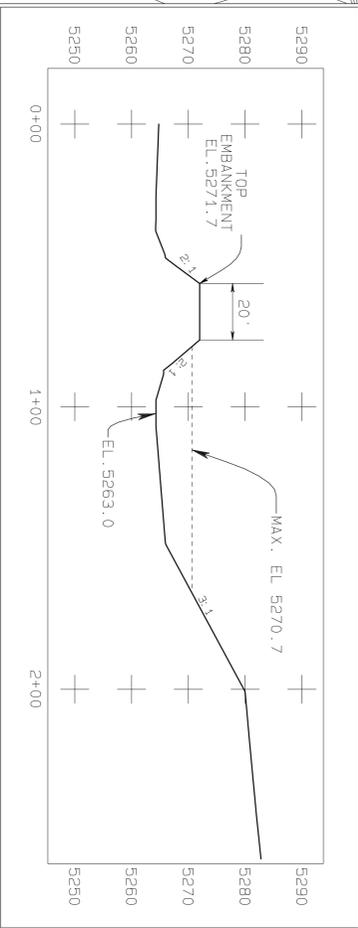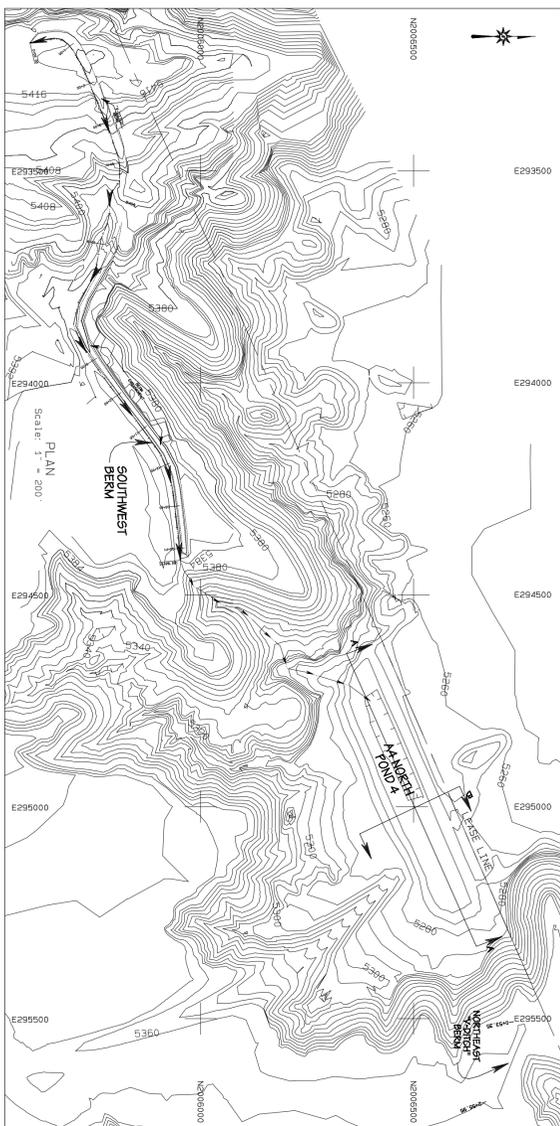

STAGE STORAGE DATA				
ELEV	AREA	VOLUME	CUM. VOLUME	
feet	acres	ac-ft	ac-ft	
5283	0.00	0.00	0.00	
5264	1.116	0.1	0.06	
5266	0.777	0.9	0.99	
5268	0.966	1.7	2.64	
5270	1.133	2.1	4.74	
5272	1.307	2.4	7.18	
Design High Water at Crest				EL. 5271.7
Design Capacity at High Water EL.				6.8 Ac-Ft

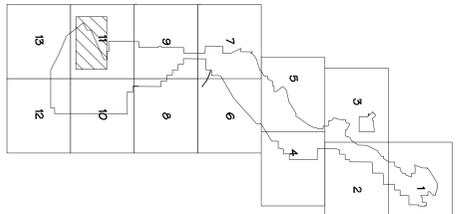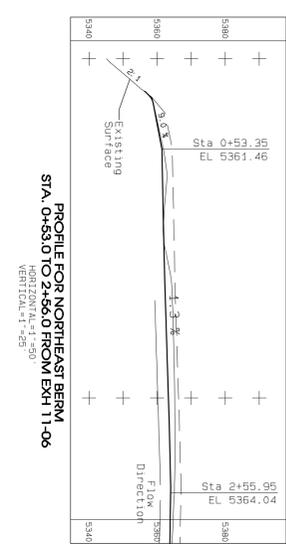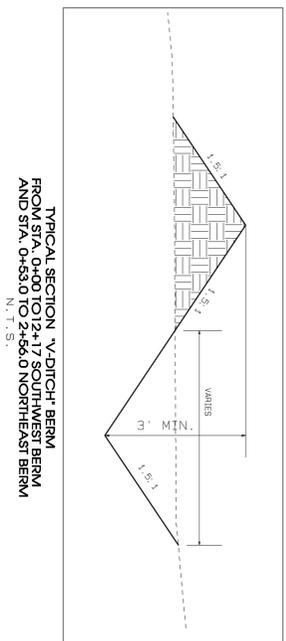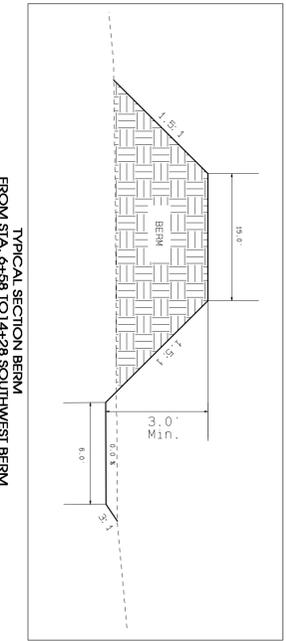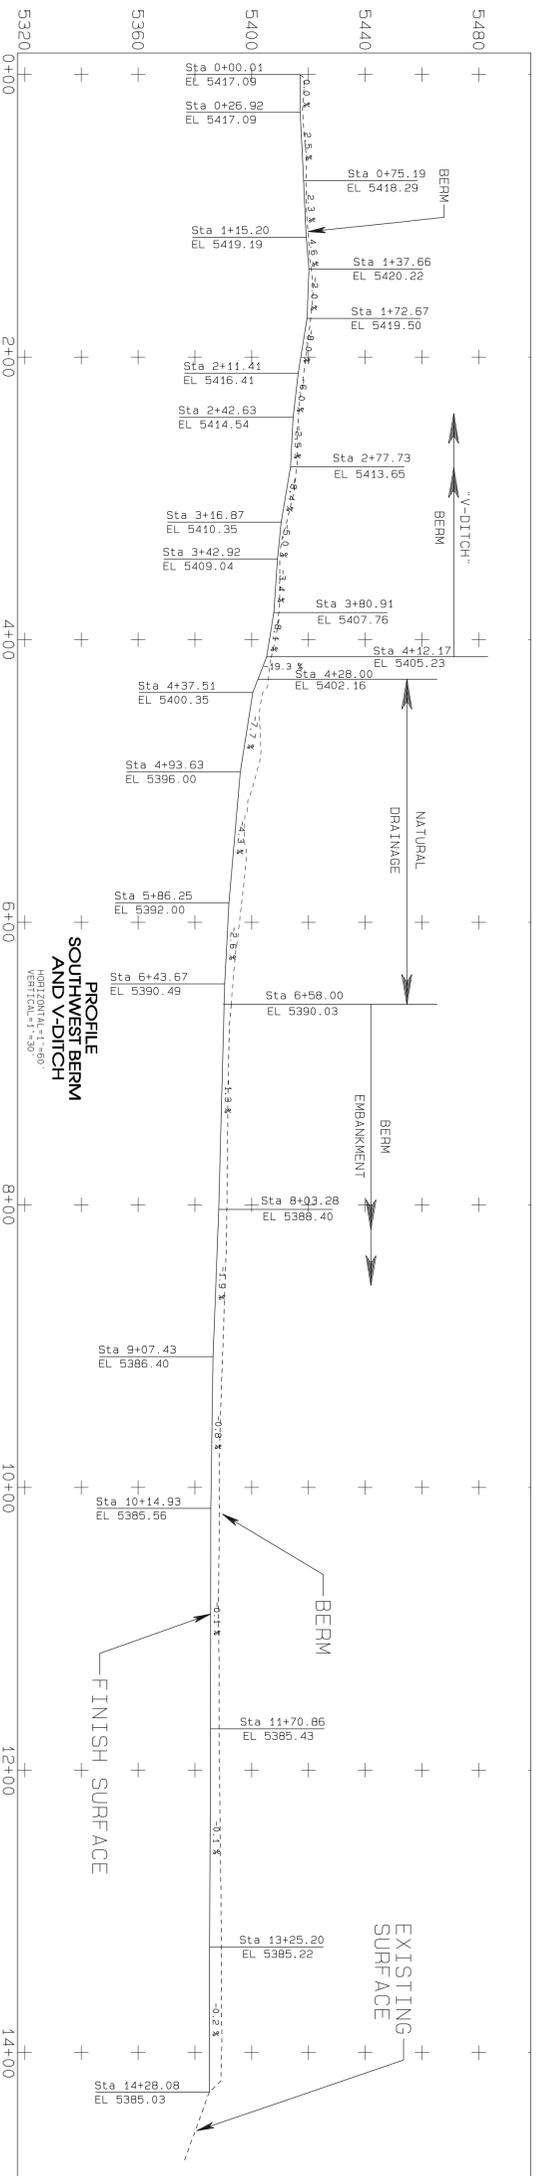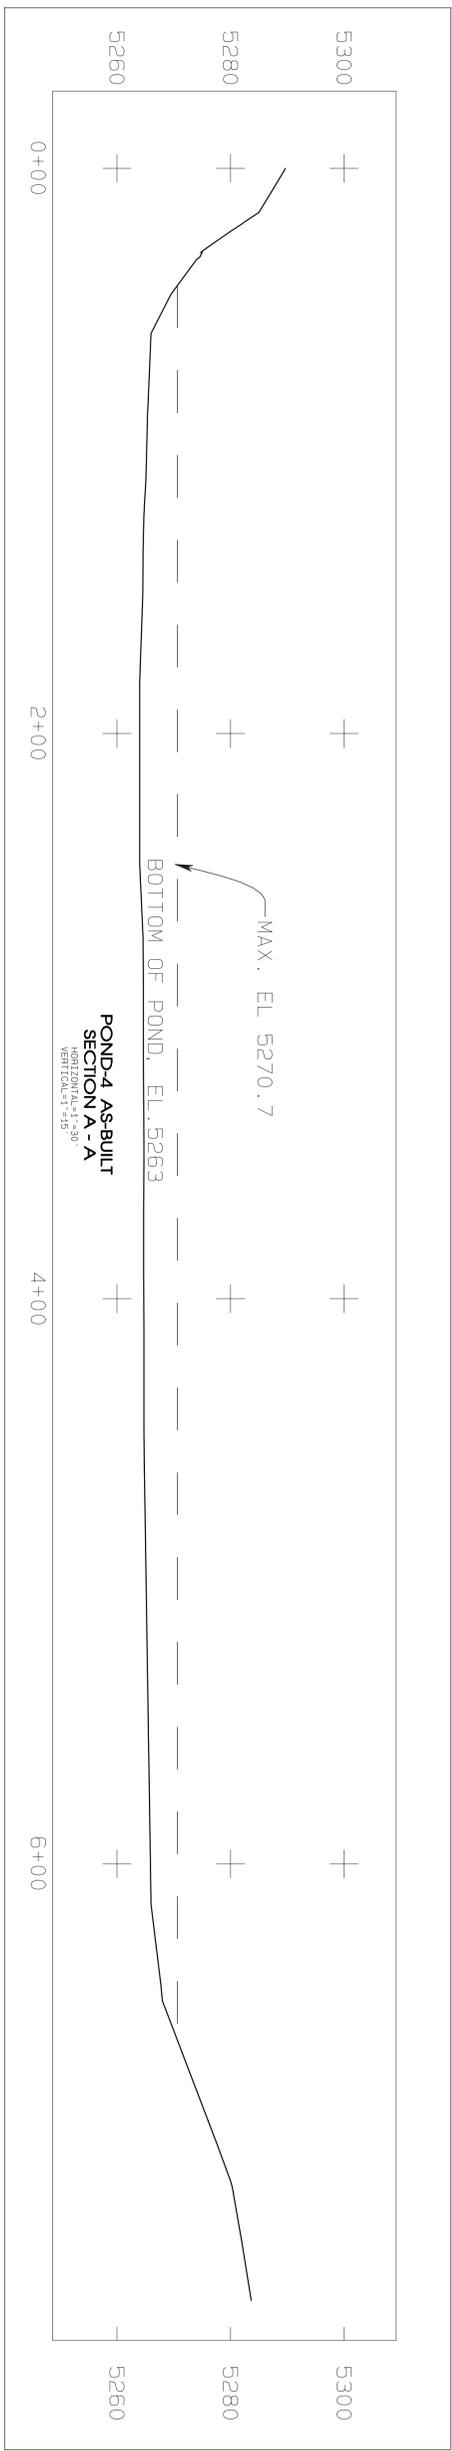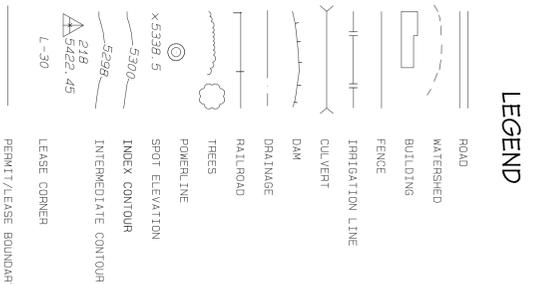



- NOTES**
1. For hydrology and design information refer to Appendix 11.3A on the approved paper.
  2. The watershed areas for impoundment and pond installation are shown on Exhibit 11-3B.

**CERTIFICATION STATEMENT**

I, Ron C. Van Valkenburg, hereby certify that this structure has been constructed in accordance with the approved design plans and that the information shown is complete and accurate except as noted below:

1. Only minor elevation and dimension differences for pond bottom and embankment crest.



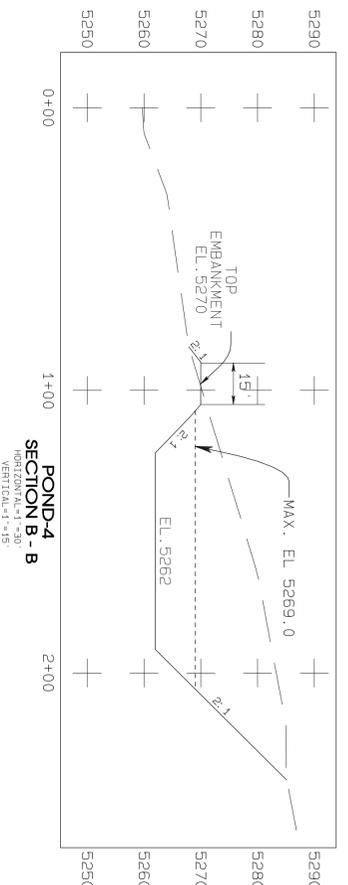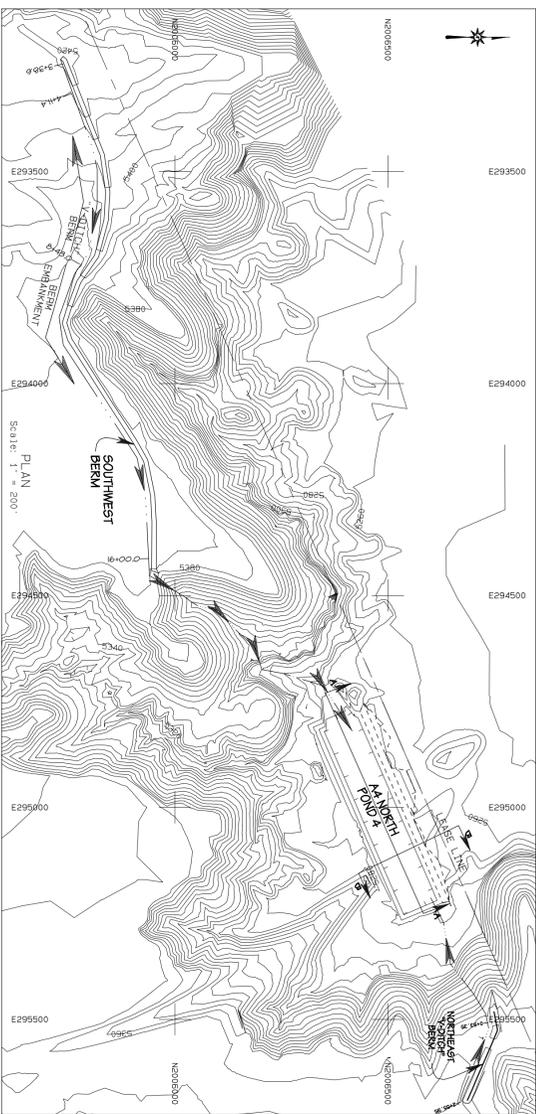



**STAGE STORAGE DATA**

ELEV	AREA	VOLUME	CUM. VOLUME
feet	acres	ac-ft	ac-ft
5262	0.65	0.00	0.00
5264	0.79	1.44	1.44
5266	0.95	1.74	3.18
5268	1.15	2.10	5.28
5270	1.40	2.56	7.84

Design High Water EL. 5269.0  
Design Capacity at High Water EL. 6.6 ac-ft

- LEGEND**
- ROAD
  - WATERSHED
  - BUILDING
  - FENCE
  - PARITATION LINE
  - CULVERT
  - DAM
  - DRAINAGE
  - RAILROAD
  - TREES
  - POWER LINE
  - SPOT ELEVATION
  - INDEX CONTOUR
  - INTERMEDIATE CONTOUR
  - LEASE CORNER
  - PERMIT/LEASE BOUNDARY




- NOTES**
- For hydrology and design information refer to Appendix 11-A in the approved PAP.
  - The watershed areas for Impoundment and pond locations are shown on Exhibit 11-13P.

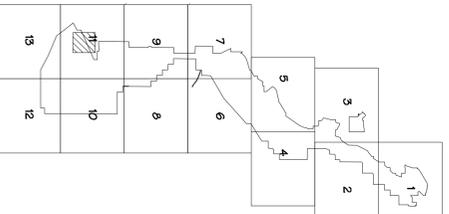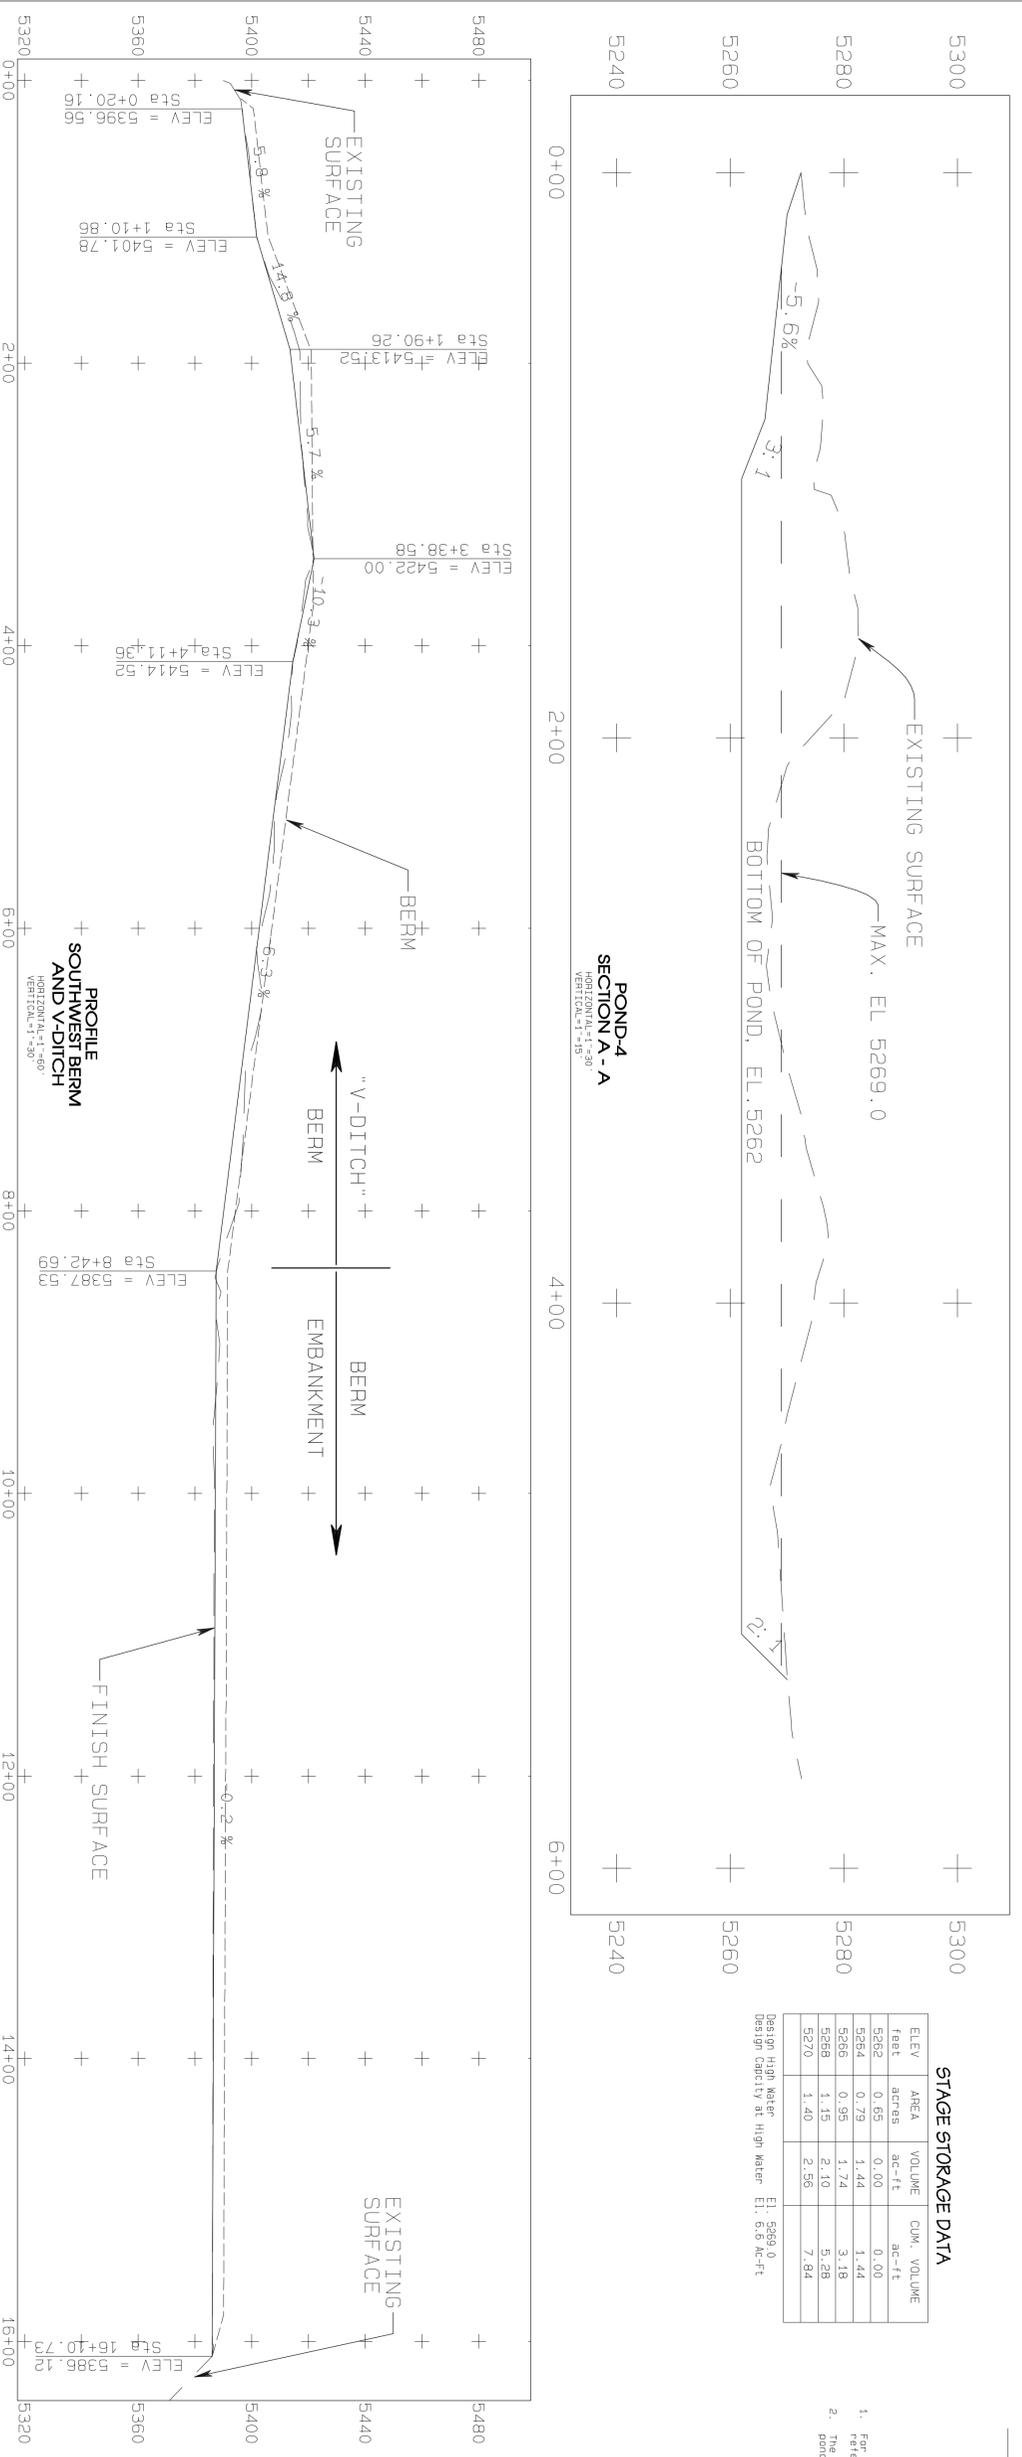


SCALE AS NOTED


**CERTIFICATION STATEMENT**

I, Ron C. Van Valkenburg, hereby certify that this drawing was reviewed by me and that the information shown is complete and accurate to the best of my knowledge.

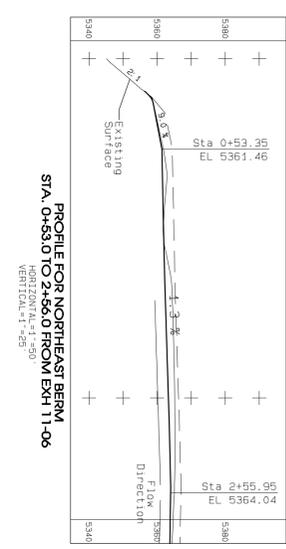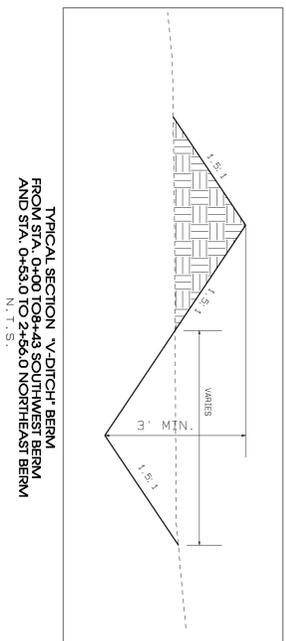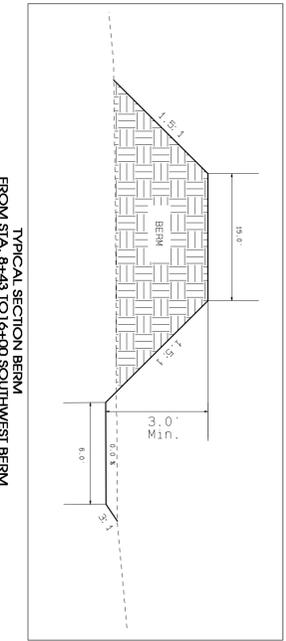

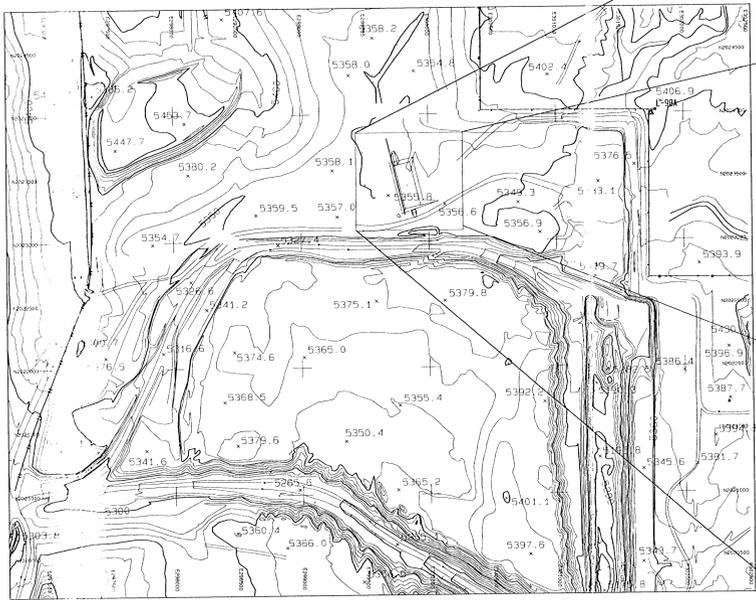

LOCATION MAP  
SCALE: 1" = 500'

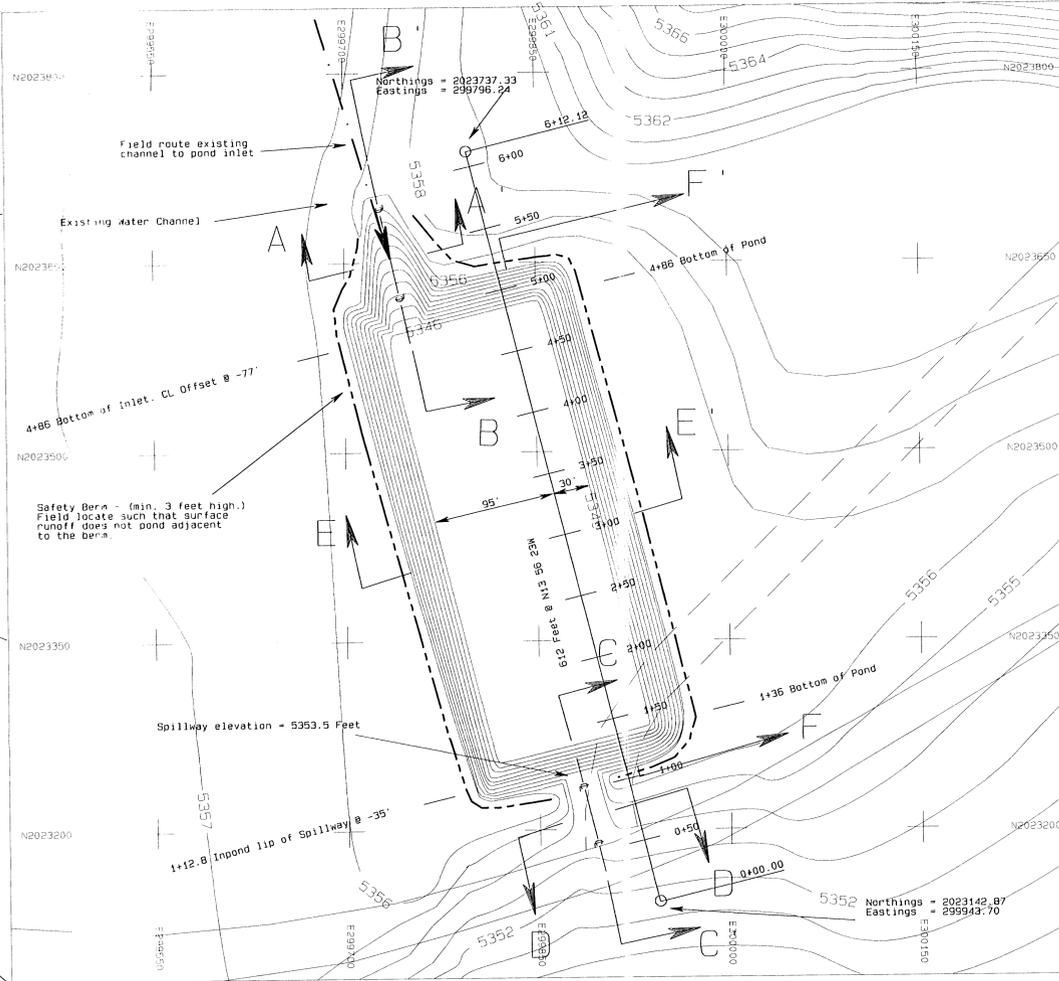

SCALE: 1" = 50'

LEGEND


- PAVED ROAD
- DIRT ROAD
- HAUL ROAD
- TRAIL
- BUILDING
- FENCE
- IRRIGATION LINE
- CULVERT
- DAM
- DRAINAGE
- RAILROAD
- TREES
- POWERLINE
- SPOT ELEVATION
- INDEX CONTOUR
- INTERMEDIATE CONTOUR
- LEASE CORNER
- PERMIT BOUNDARY

NOTES


- For hydrology and design information refer to Appendix 11-22 in the approved PAP.

STAGE STORAGE DATA


ELEV. FEET	AREA ACRES	VOLUME AC-FT	CUM. VOLUME AC-FT
5345	1.00	0.00	0.00
5347	1.07	1.03	1.03
5348	1.14	1.1	2.14
5349	1.20	1.17	3.31
5350	1.28	1.28	4.6
5351	1.35	1.3	5.9
5352	1.43	1.4	7.3
5353	1.50	1.42	8.72
5354	1.58	1.53	10.26
5355	1.66	1.63	11.9
5356			

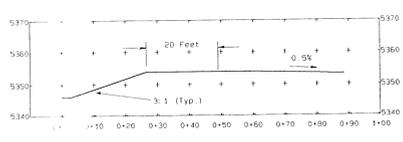



SECTION CC'  
SCALE: 1" = 20'

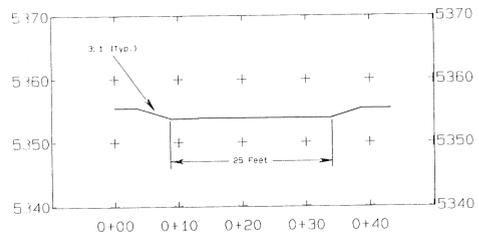


SECTION DD'  
SCALE: 1" = 20'

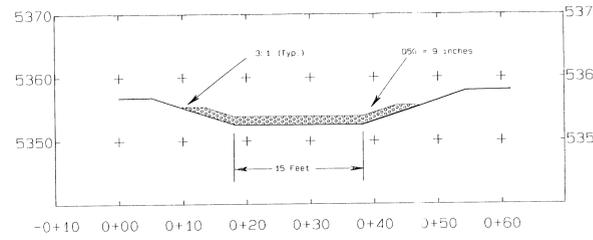


SECTION AA'  
SCALE: 1" = 20'

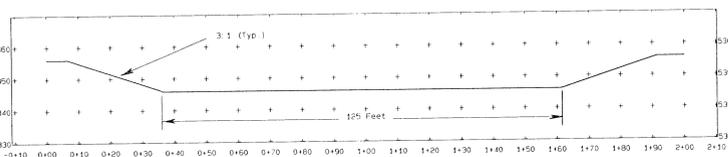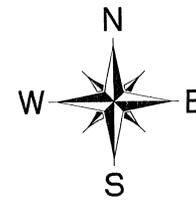


SECTION EE'  
SCALE: 1" = 20'

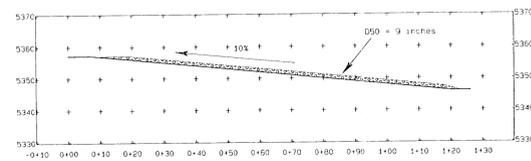

SECTION BB'  
SCALE: 1" = 20'

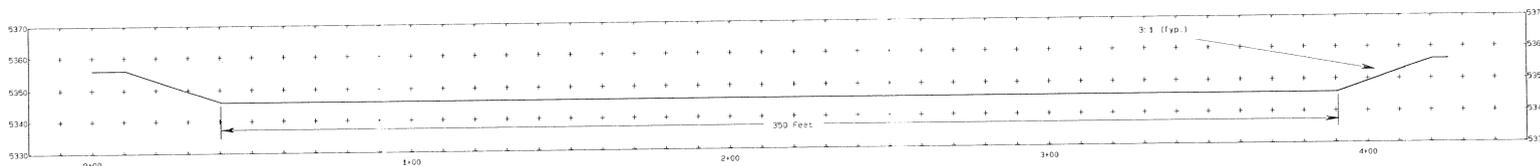

SECTION FF'  
SCALE: 1" = 20'

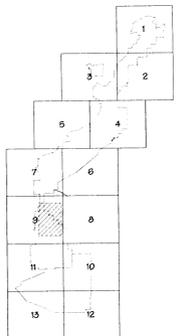

CERTIFICATION STATEMENT

I, Leonard Raymond, hereby certify that this drawing was reviewed by me and that the information shown is accurate and complete to the best of my knowledge.

*Leonard Raymond*  
2-11

NO.	DATE	DESCRIPTION	BY	APPROVED



EXHIBIT 26-52  
NAVAJO COAL COMPANY




AREA 3  
"DESIGN"  
LOWE HOLE 3 POND 2

PREPARED BY: BH DRAWN BY: BH SCALE AS NOTED  
 APPROVED BY: LR DATE: 09/24/97 REF: CAG  
 DWG. LOC: G:\USER\KFM\APR\1\USS\KOR\LOWE\_POND\LOWE\_POND.PR



LOCATION MAP  
SCALE: 1" = 500'

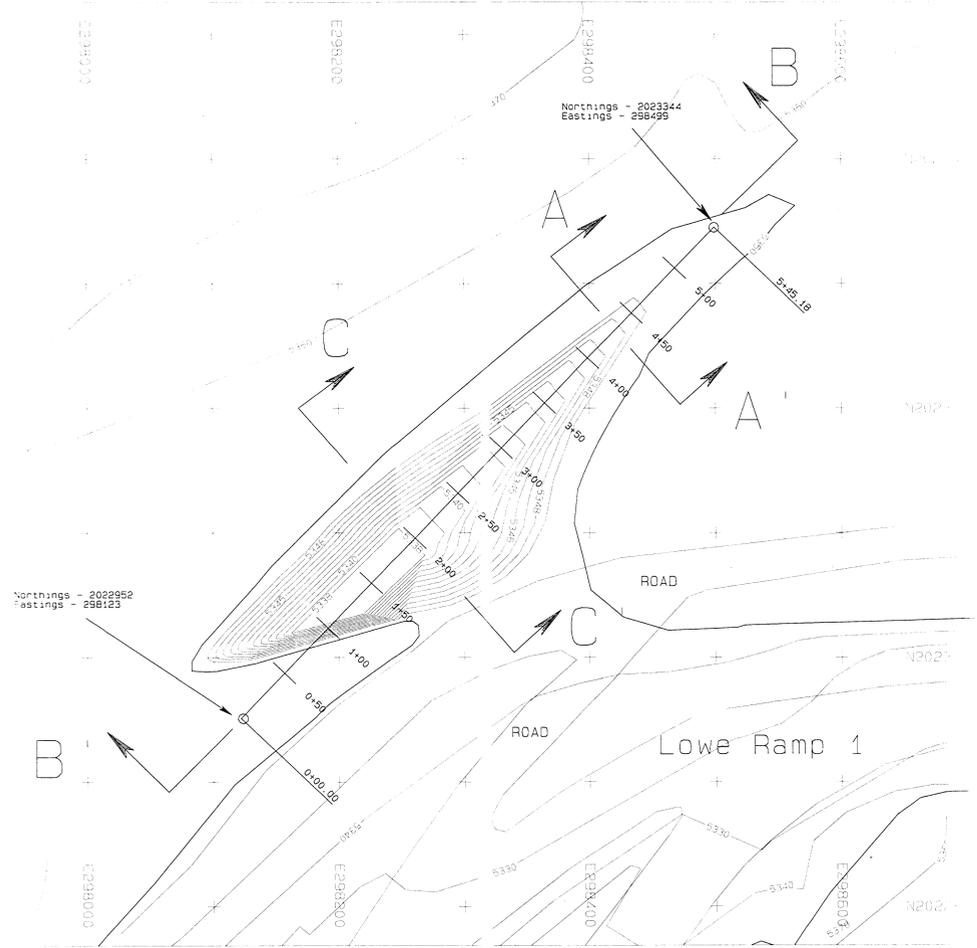

SCALE: 1" = 50'

LEGEND



- PAVED ROAD
- DIRT ROAD
- HAUL ROAD
- TRAIL
- BUILDING
- FENCE
- IRRIGATION LINE
- CULVERT
- DAM
- DRAINAGE
- RAILROAD
- TREES
- POWERLINE
- SPOT ELEVATION
- INDEX CONTOUR
- INTERMEDIATE CONTOUR
- LEASE CORNER
- PERMIT BOUNDARY

NOTES


1. For hydrology and design information refer to appendix 11-12 in the approved PAP.

STAGE STORAGE DATA



ELEV	AREA	VOLUME	CUM. VOLUME
feet	ac-ft	ac-ft	ac-ft
5338	0.08	0.00	0.00
5339	0.11	0.09	0.09
5340	0.15	0.13	0.22
5341	0.19	0.17	0.39
5342	0.24	0.22	0.61
5343	0.29	0.26	0.87
5344	0.36	0.32	1.19
5345	0.42	0.39	1.58
5346	0.49	0.45	2.03
5347	0.56	0.53	2.56
5348	0.64	0.6	3.16
5349	0.73	0.68	3.84
5350	0.82	0.77	4.61

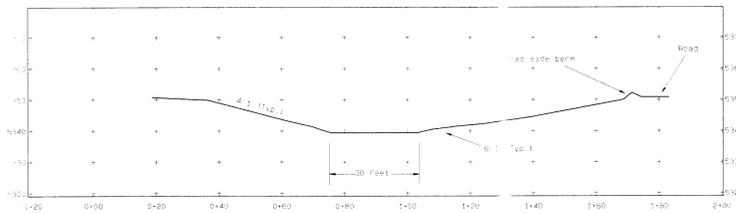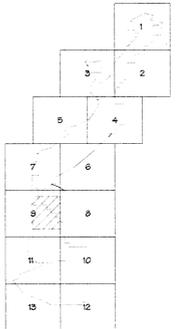

SECTION CC'  
SCALE: 1" = 20'

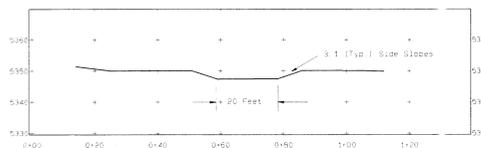

SECTION AA'  
SCALE: 1" = 20'

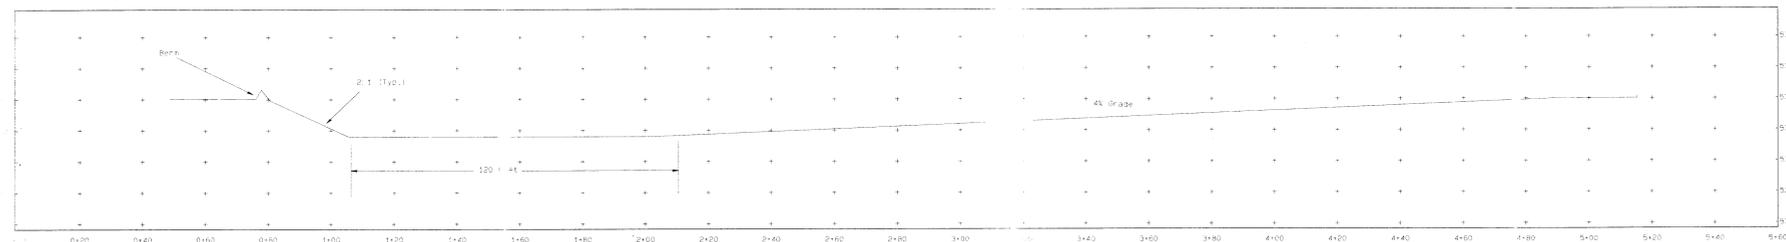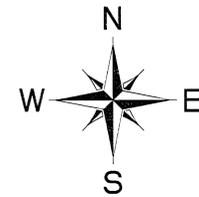

SECTION BB'  
SCALE: 1" = 20'

CERTIFICATION STATEMENT

I, Leonard Reynolds, hereby certify that this drawing was reviewed by me and that the information shown is accurate and complete to the best of my knowledge.

*L. Reynolds*  
10/20/11





APPROVED BY: [Signature] DATE: 10/20/11

EXHIBIT 26-53  
NAVAJO COAL COMPANY

NAVAJO MINE

AREA 3  
"DESIGN"  
LOWE HOLE 3 POND 3

PREPARED BY: [Signature] SCALE: AS SHOWN  
APPROVED BY: [Signature] DATE: 10/20/11  
DRAWN BY: [Signature] DATE: 10/20/11

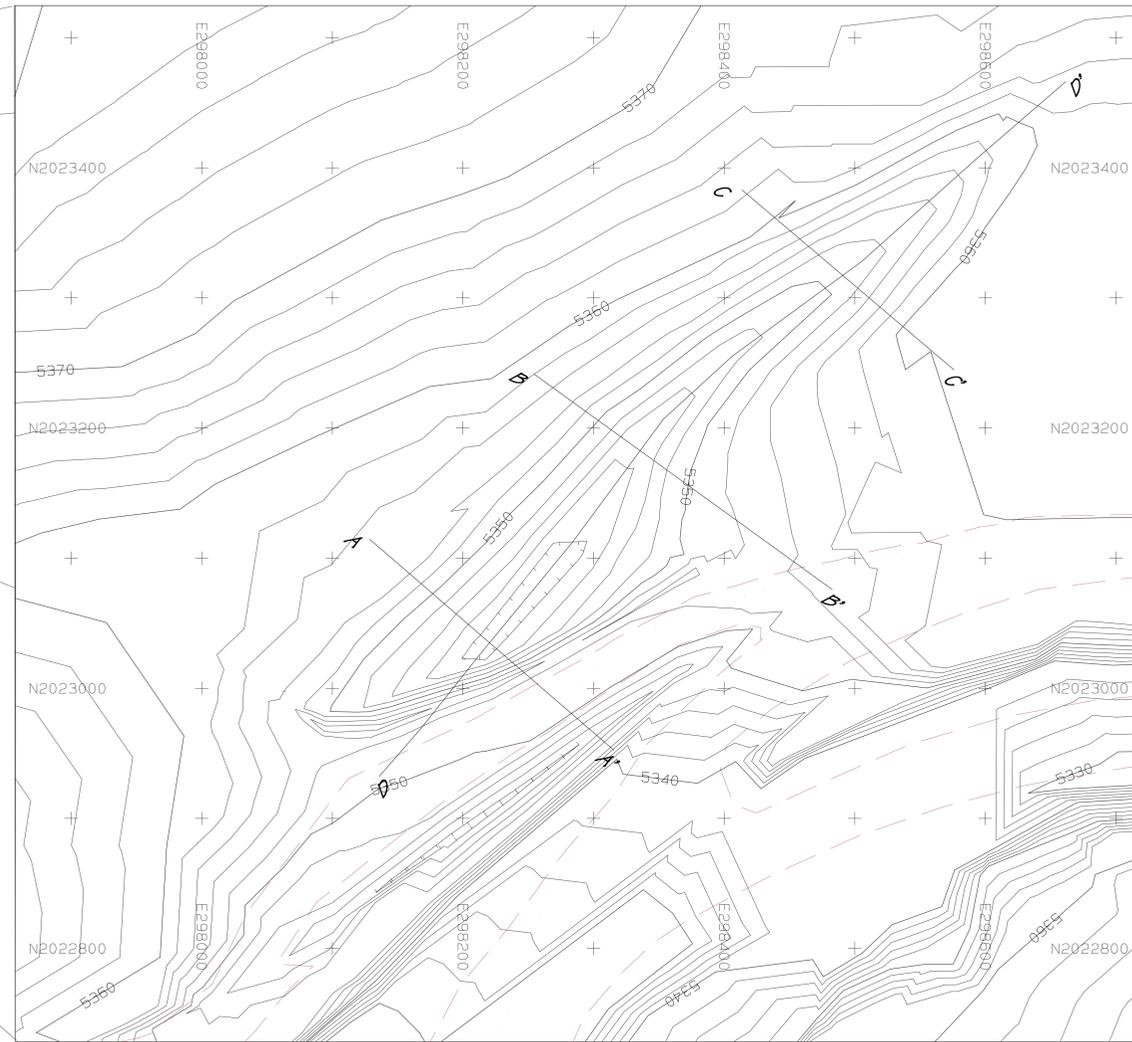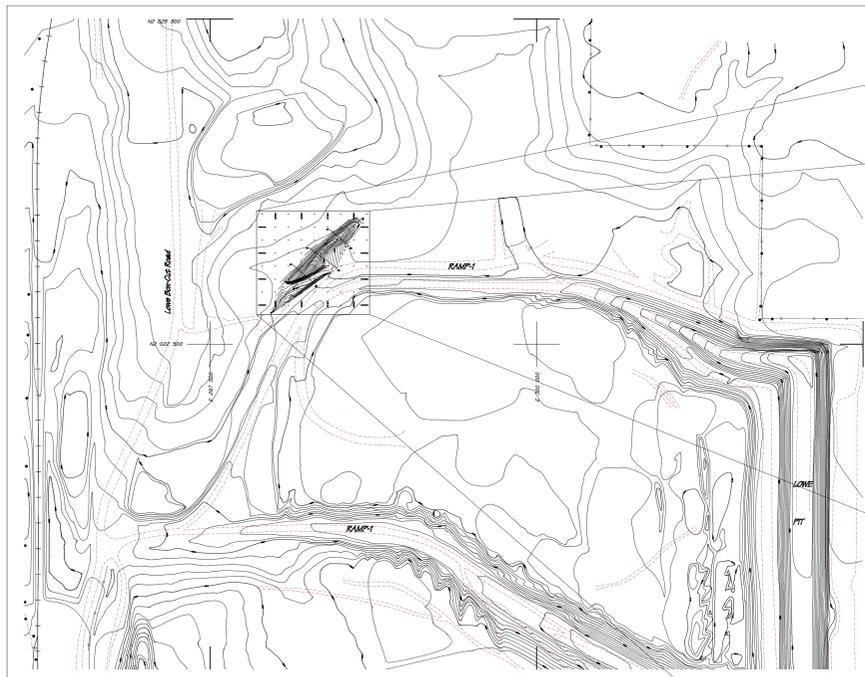






**LEGEND**

- ROAD
- WATERSHED
- BUILDING
- FENCE
- IRRIGATION LINE
- CULVERT
- DAM
- DRAINAGE
- RAILROAD
- TREES
- POWERLINE
- SPOT ELEVATION
- INDEX CONTOUR
- INTERMEDIATE CONTOUR
- LEASE CORNER

**STAGE STORAGE DATA**

ELEV feet	AREA acres	VOLUME ac-ft	CUM. VOLUME ac-ft
5342	0.052	0.00	0.00
5343	0.107	0.080	0.080
5344	0.171	0.140	0.220
5345	0.244	0.209	0.429
5346	0.326	0.287	0.715
5347	0.420	0.376	1.091
5348	0.523	0.475	1.566
5349	0.642	0.587	2.153
5350	0.778	0.715	2.869
5351	0.928	0.860	3.728
5352	1.103	1.023	4.752

- NOTES**
- For hydrology and design information refer to Appendix 11-AA in the approved PAP.
  - For Watershed area see exhibits 11-13d and 11-13e.
  - For "Blue line" elevation refers to Table 11-5A4, Lowe Hole 3 Pond 3.

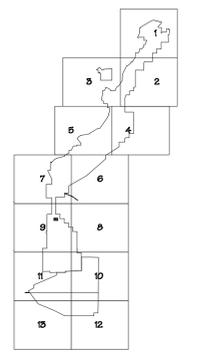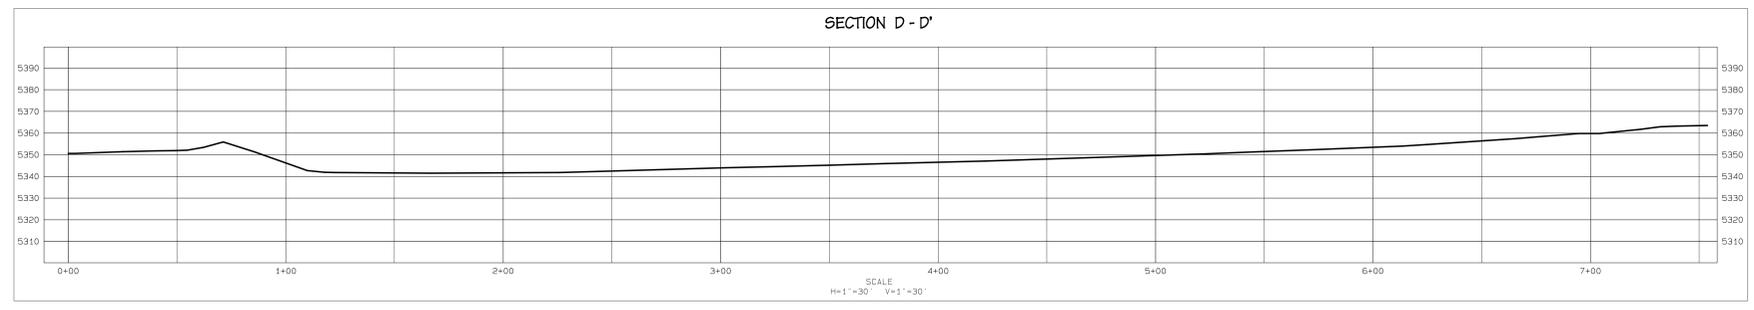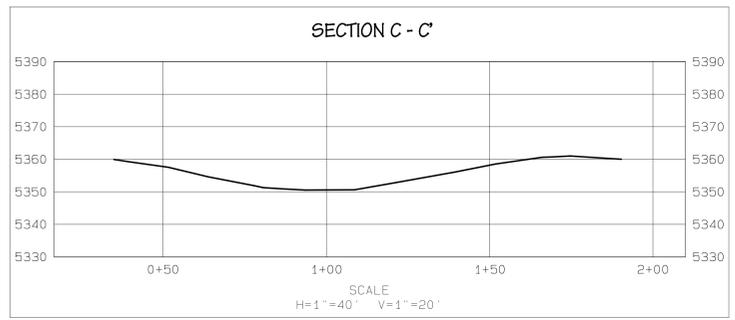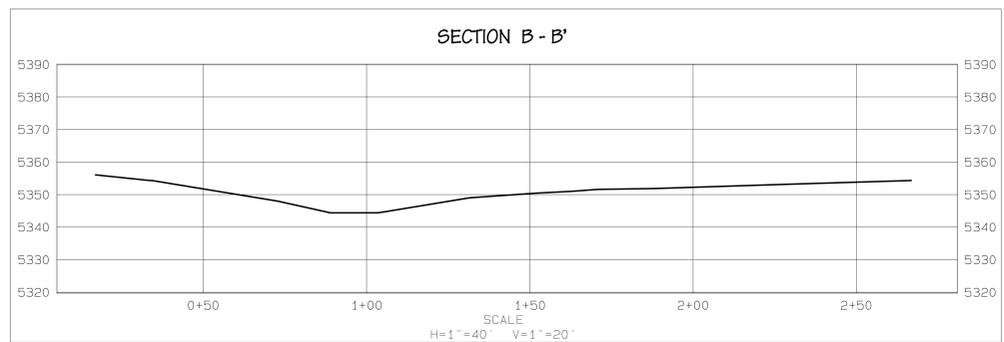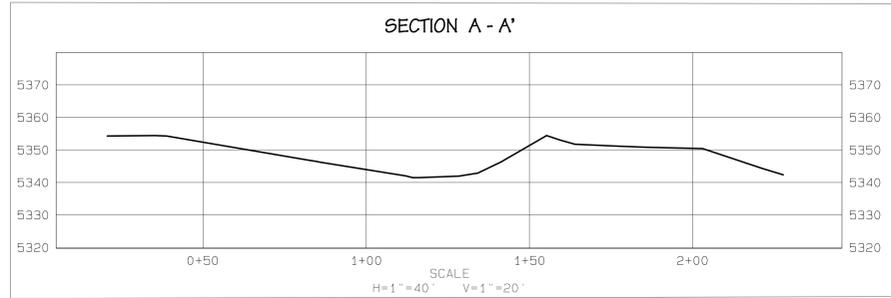

**CERTIFICATION STATEMENT**  
 I, Leonard Raymond, hereby certify that this impoundment has been constructed in accordance with the approved design plans and that this information shown is complete and accurate to the best of my knowledge.




REV. NO.	DATE	BY	REVISION DESCRIPTION	CHK	HC	LR
A	07/27/99	PJF	Submittal to OSM for Review			

**EXHIBIT 26-54**  
**NAVAJO COAL COMPANY**

NAVAJO MINE  
 P.O. BOX 155 FRUITLAND, NEW MEXICO 87416





**LOWE HOLE 3 POND 3**  
**AS-BUILT**

PREPARED BY PJF DRAWN BY PJFOSTER SCALE = AS NOTED  
 APPROVED BY LR DATE 07/19/99  
 PATH: G:\Gs\Permit\F\Ch 11\Exh 11-127\_Lowe Hole 3 Pd 2\Exhibit 2610\exh

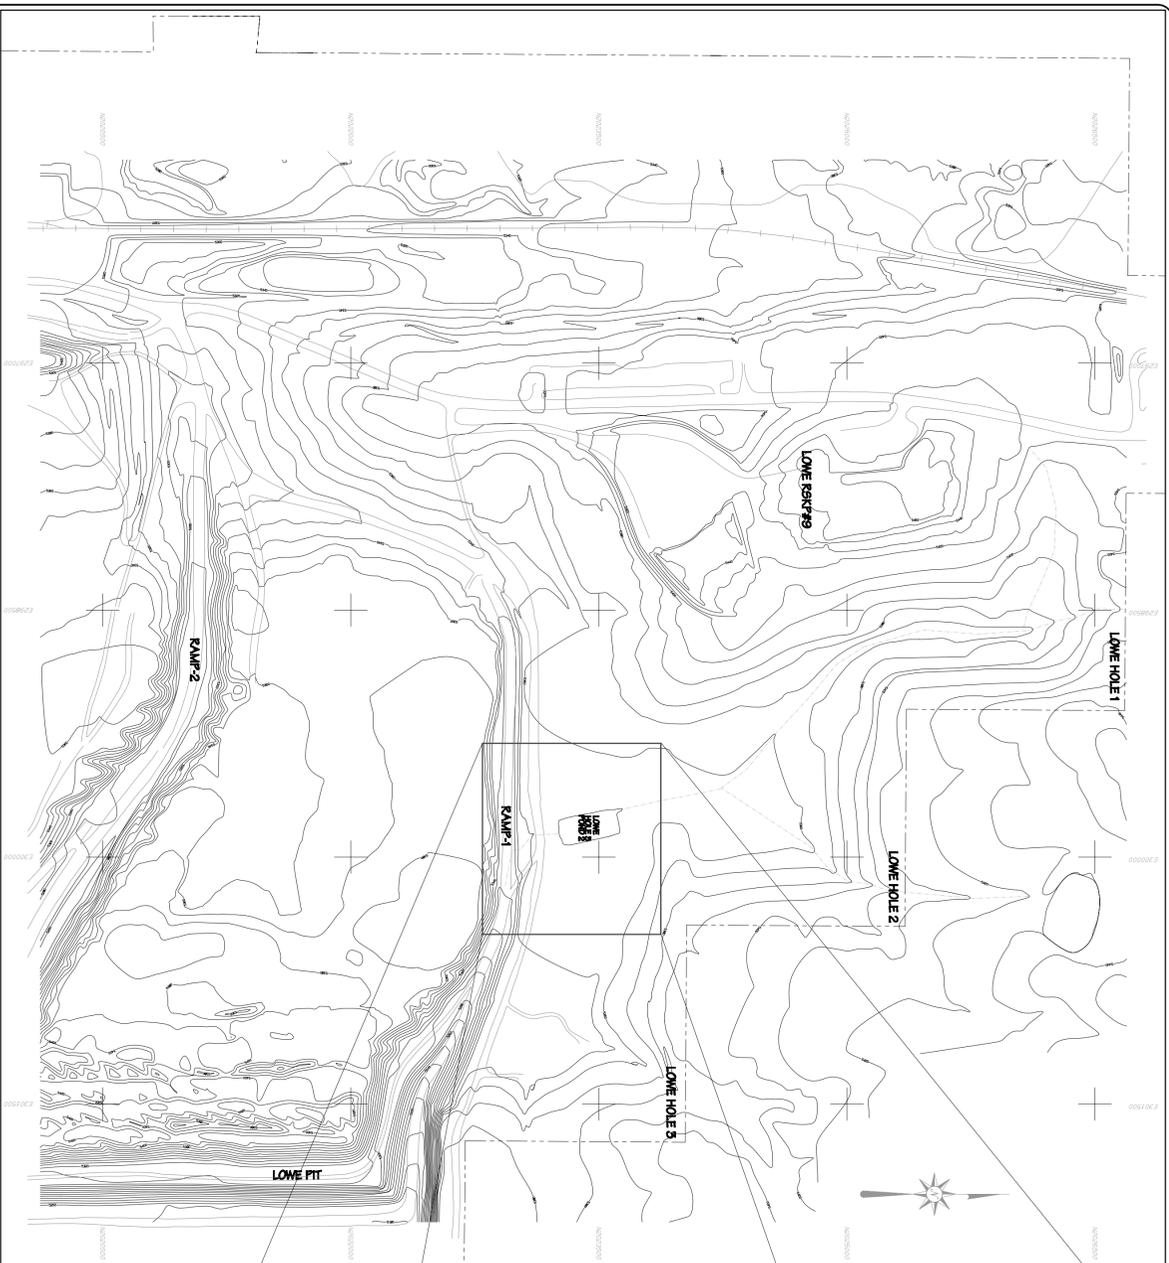

ELEV	AREA	VOLUME	CUM. VOLUME
feet	acres	bc-ft	bc-ft
5343.5	0.04	0.00	0.00
5344	0.17	0.05	0.05
5345	0.65	0.41	0.46
5346	1.03	0.84	1.30
5347	1.11	1.07	2.37
5348	1.18	1.15	3.52
5349	1.26	1.22	4.74
5350	1.34	1.30	6.04
5351	1.46	1.40	7.44
5352	1.63	1.54	8.99
5352.5	1.72	0.83	9.82

- LEGEND**
- ROAD
  - TRAIL
  - BUILDING
  - IRIGATION LINE
  - CULVERT
  - DAM
  - DRAINAGE
  - RAILROAD
  - TREES
  - POWERLINE
  - SPOT ELEVATION
  - INDEX CONTOUR
  - INTERMEDIATE CONTOUR
  - CONTROL
  - PERMIT BOUNDARY
  - SEDIMENT CONTROL STRUCTURE

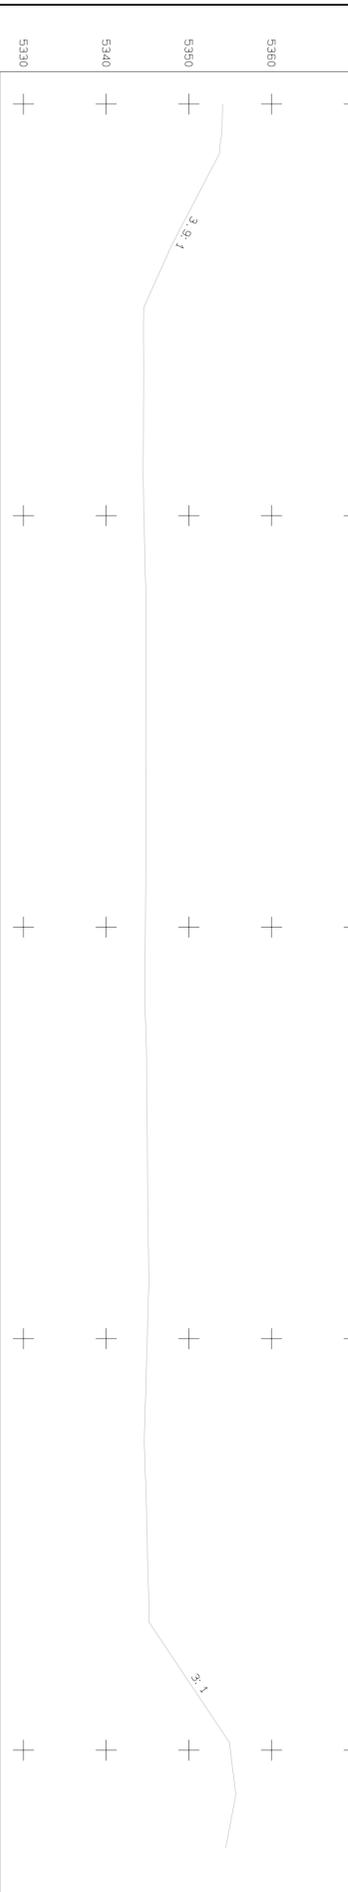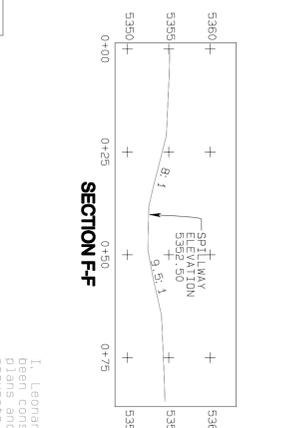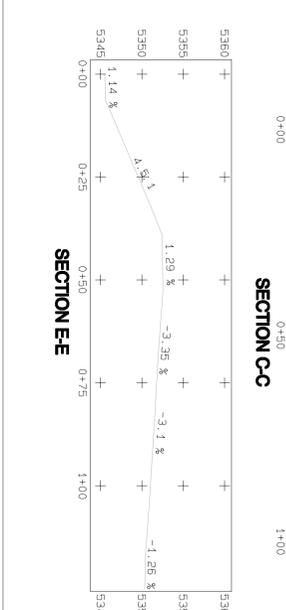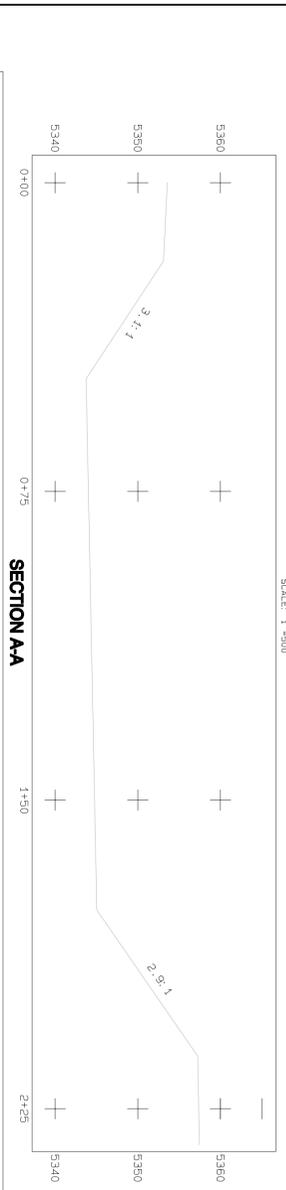

**NOTES**

1. For hydrology and design information refer to Appendix 11-A in the approved map.

**CERTIFICATION STATEMENT**

I, Leonard Raymond, hereby certify that this Pond has been constructed in accordance with approved design plans and that the information shown is complete and accurate to the best of my knowledge, except as noted below.




**SECTIONS AND PROFILE**


VERTICAL: 1"=10'

1. Due to a sink hole that developed in the pond, the spillway was reconstructed at a lower elevation. The as-built spillway passes the required storm event (25 Year 6 HR).

<b>EXHIBIT 26-55</b> <b>LOWE HOLE 3, POND 2</b> <b>AS-BUILT</b>	<b>PLAN, PROFILE &amp; SECTION</b>	ACCOUNT: _____ DATE: September 15, 2000 DESIGNED BY: _____ DRAWN BY: RY CHECKED BY: _____ APPROVED BY: LR	<b>BHP-NAVAJO COAL CO.</b> <small>PO BOX 155, FRUITLAND, NEW MEXICO, 87416</small>	PROJECT MANAGER: Corey Nelson ENGR. of RECORD: Leonard Raymond REG. NO: 6600 SURVY of RECORD: _____ REG. NO: _____	<table border="1"> <thead> <tr> <th>REVISION</th> <th>DATE</th> </tr> </thead> <tbody> <tr> <td>1 AS-BUILT</td> <td>09/05/00</td> </tr> <tr> <td>2 Updated Spillway and Inpond Volume</td> <td>04/28/03</td> </tr> <tr> <td>3</td> <td></td> </tr> <tr> <td>4</td> <td></td> </tr> <tr> <td>5</td> <td></td> </tr> </tbody> </table>	REVISION	DATE	1 AS-BUILT	09/05/00	2 Updated Spillway and Inpond Volume	04/28/03	3		4		5	
REVISION	DATE																
1 AS-BUILT	09/05/00																
2 Updated Spillway and Inpond Volume	04/28/03																
3																	
4																	
5																	

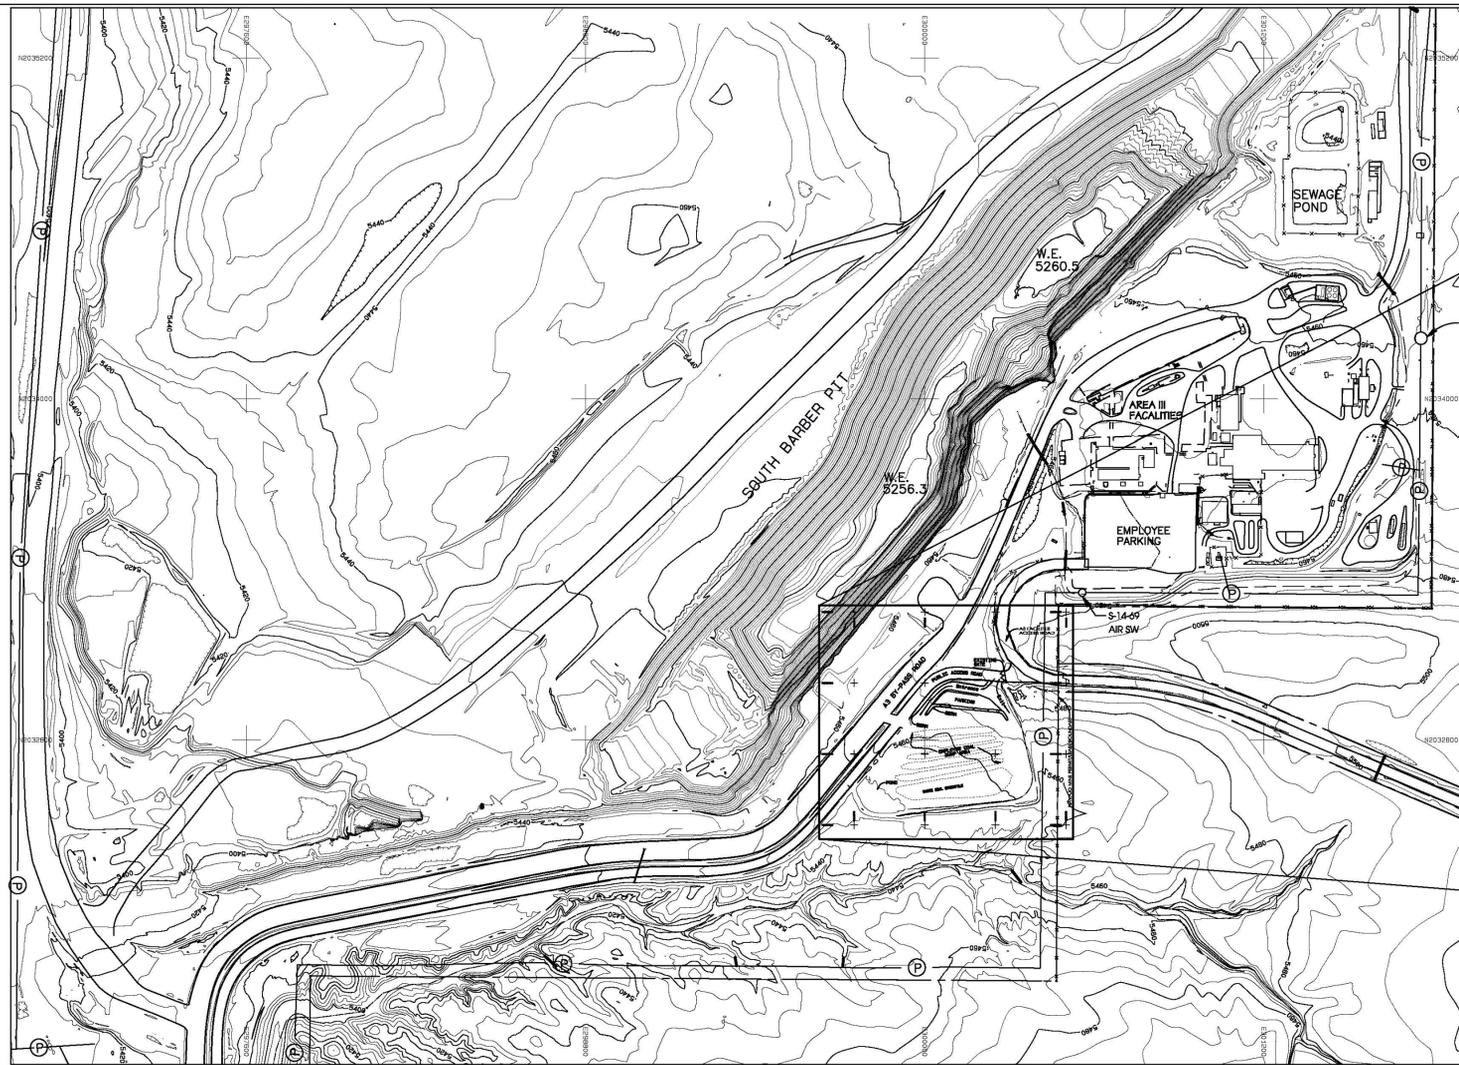

LOCATION MAP  
SCALE 1"=300'

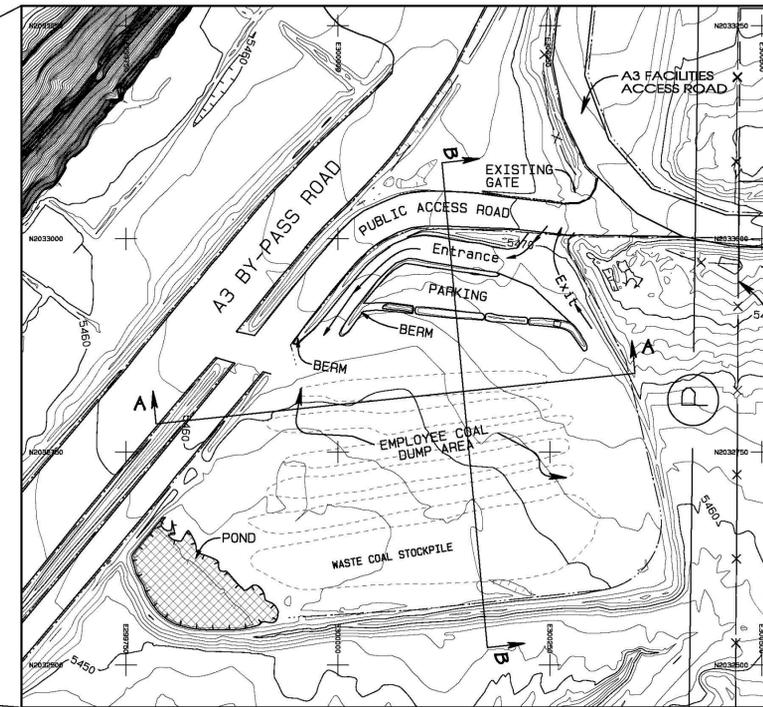


SCALE 1"=100'

**LEGEND**

	ROAD
	BUILDING
	FENCE
	IRRIGATION LINE
	CULVERT
	DAM
	DRAINAGE
	RAILROAD
	TREES
	POWERLINE
	SPOT ELEVATION
	INDEX CONTOUR
	INTERMEDIATE CONTOUR
	CONTROL
	LEASE
	LOCATION
	WATERSHED

**NOTES**


- For hydrology and design information refer to Appendix 11-AA in the approved PA.
- See Table 11-5AL for impoundment data.

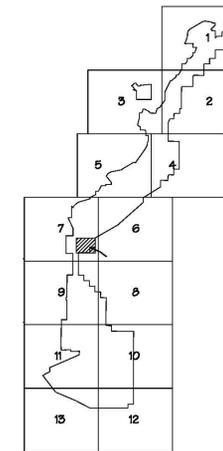


SCALE AS NOTED

**STAGE STORAGE DATA**

ELEV feet	AREA acres	VOLUME ac-ft	CUM. VOLUME ac-ft
5453	0.06	0.00	0.00
5454	0.19	0.12	0.12
5455	0.28	0.23	0.35
5456	0.83	0.55	0.90
5457	1.22	1.02	1.93
5458	1.59	1.41	3.33

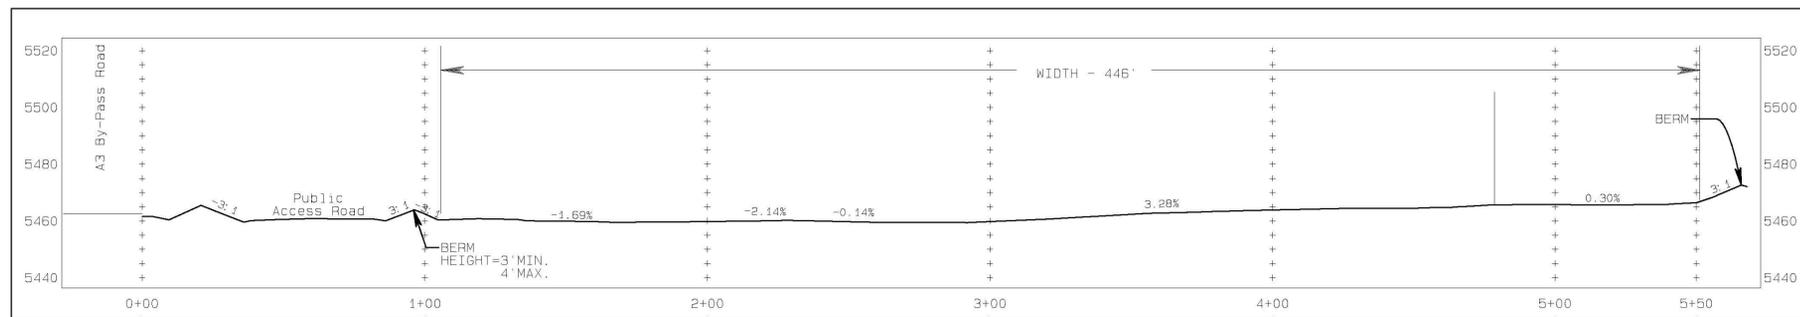

CROSS SECTION A-A'  
SCALE  
H: 1"=30' V: 1"=30'

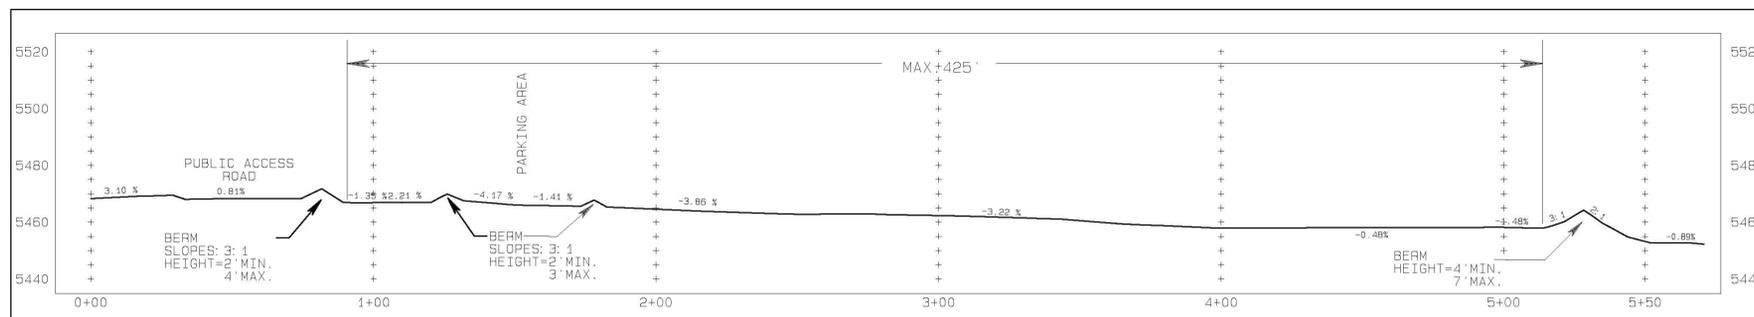

PROFILE B-B'  
SCALE  
H: 1"=30' V: 1"=30'

**CERTIFICATION STATEMENT**

I, Leonard Raymond, hereby certify that this structures has been constructed in accordance with the approved design plans and that the information shown is complete and accurate to the best of my knowledge, except as noted below.



DATE	REVISION	BY	DATE
11/01/20	AS-BUILT	JLR	11/01/20
12-4	UPGRADE SURFACE TO CURRENT AND STAGE	JLR	11/19/12
	12-4	REVISION	
		DESIGNED BY: JLR	
		CHECKED BY: JLR	
		APPROVED BY: JLR	

**bhpblliton**  
**BHP NAVAJO COAL COMPANY**  
**NAVAJO MINE**

PROJECT: ENCL. POND AS-BUILT  
DATE: November 19, 2012  
DESIGNED BY: JLR  
DRAWN BY: JLR  
CHECKED BY: JLR  
APPROVED BY: JLR

PROJECT MANAGER: James L. Shuckler  
ENGR. of RECORD: LEONARD RAYMOND  
REG. NO. NM-8800  
STATE of RECORD: NM  
REG. NO.

PO BOX 1717, FRUITLAND, NEW MEXICO, 87418 / PHONE 505-598-4800/FAX 505-598-3361




**PLAN, PROFILE AND SECTION**

**Exhibit 26-56**

**EMPLOYEE'S COAL DUMP**

**AS-BUILT**

G:\US\Projects\Final\11-132\_Employee Coal Dump\Cont11 2012\As-Built\11-132\_26-56.dwg, 11/19/12, JLR

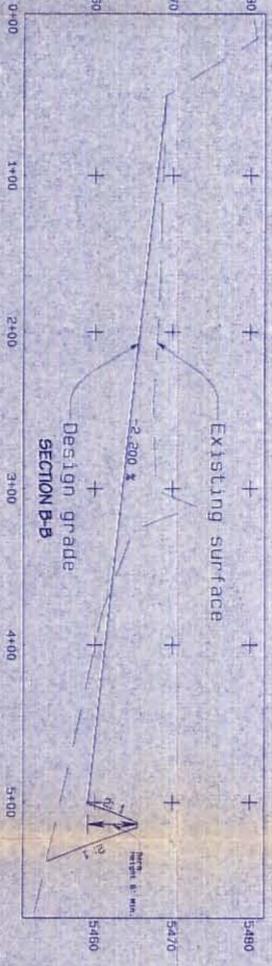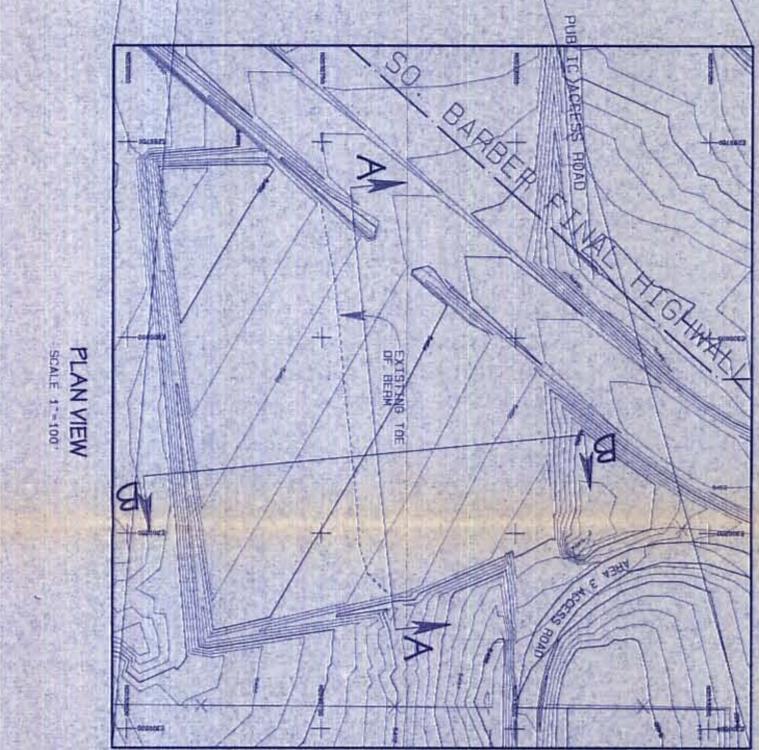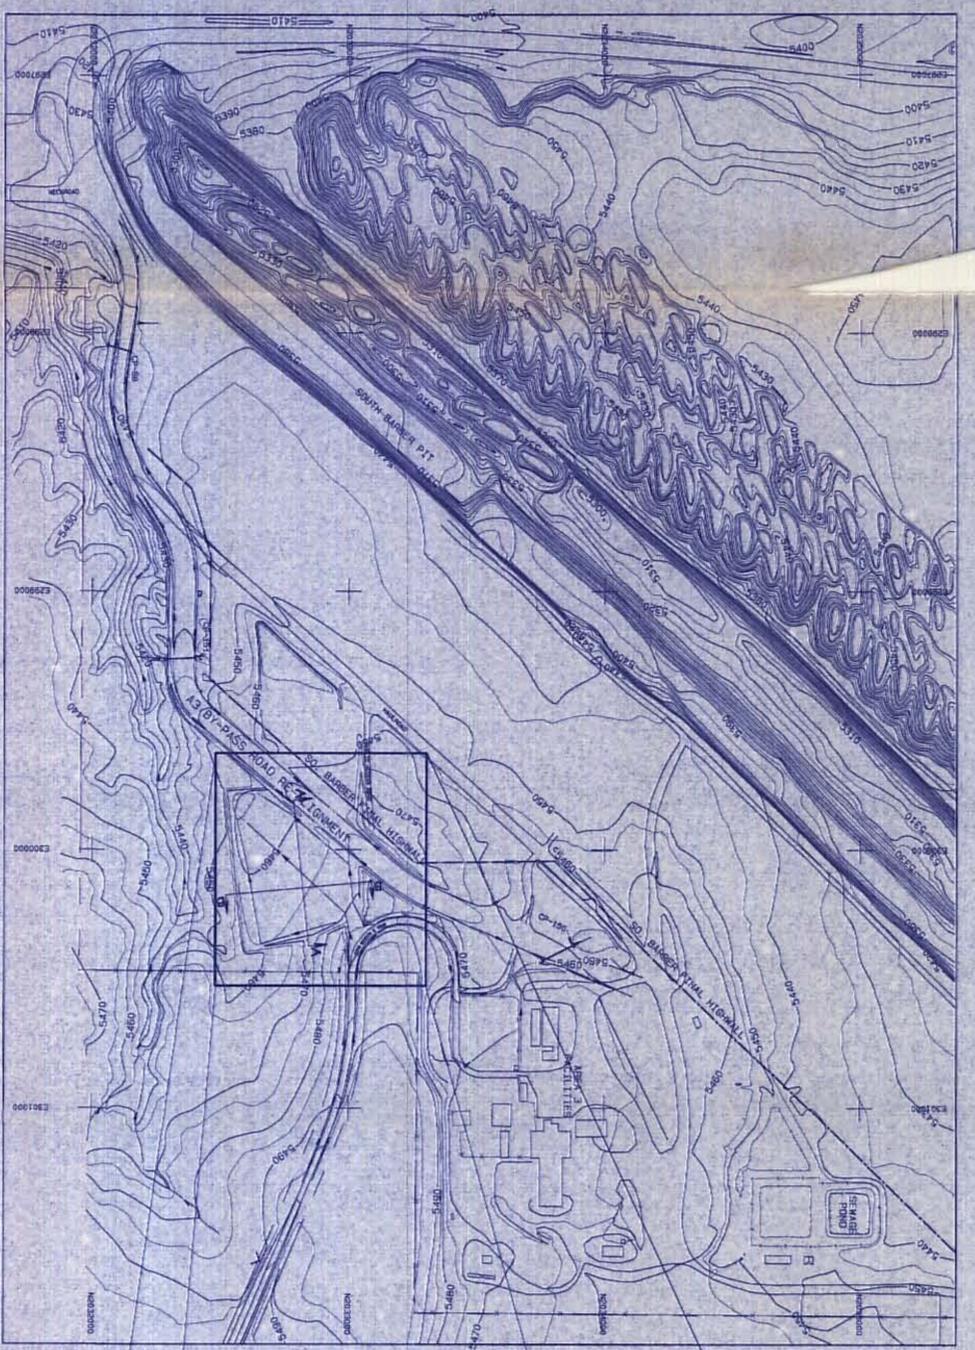

SECTIONS  
SCALE 1\"/>


LOCATION AND DRAINAGE PLAN  
SCALE 1\"/>

PLAN VIEW  
SCALE 1\"/>

SCALE AS NOTED

STAGE STORAGE DATA.

ELEV.	AREA	VOLUME	CUM. VOLUME
5461	0.05	0.00	0.00
5465	0.24	0.40	0.40
5468	0.83	1.17	1.57
5469	1.47	2.31	3.98

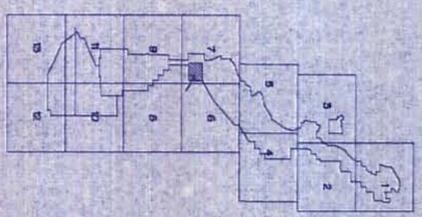

- NOTES
1. For hydrology and design information see P&P.
  2. See notes 11-24, for improvement data.
  3. See notes 11-25, for head re-alignment.

LEGEND

- HEAD
- TAIL
- BUILDING
- FENCE
- TERMINATION LINE
- CO. VERT.
- DAM
- DEWATER
- HALLS/D
- TREES
- POWDER LINE
- SPOT ELEVATION
- INTERMEDIATE CANTON
- ADDITION
- LEAK
- LOCATION
- WATERBOD


CERTIFICATION STATEMENT

I, Leonard Rayford, hereby certify that this drawing has been reviewed by me and that the information shown is complete and accurate to the best of my knowledge.




SHEET 1 OF 1	EXHIBIT 26-56 EMPLOYEE COAL DUMP MODIFICATION DESIGN	PLAN, PROFILE AND SECTION	ACCOUNT: BHP-NAVAJO COAL CO.	PROJECT MANAGER: DOREY NELSON	DATE: Apr 11, 2000	REVISION	DATE
			DESIGNED BY: RY		ENGR. OF RECORD: LEONARD RAYFORD	1	04/12/00
			CHECKED BY: LR	YES: NO: YES	APPROVED BY: LR	2	
				NO: YES: NO: YES		3	
						4	
						5	


PERMIT COPY  
NM-0003E

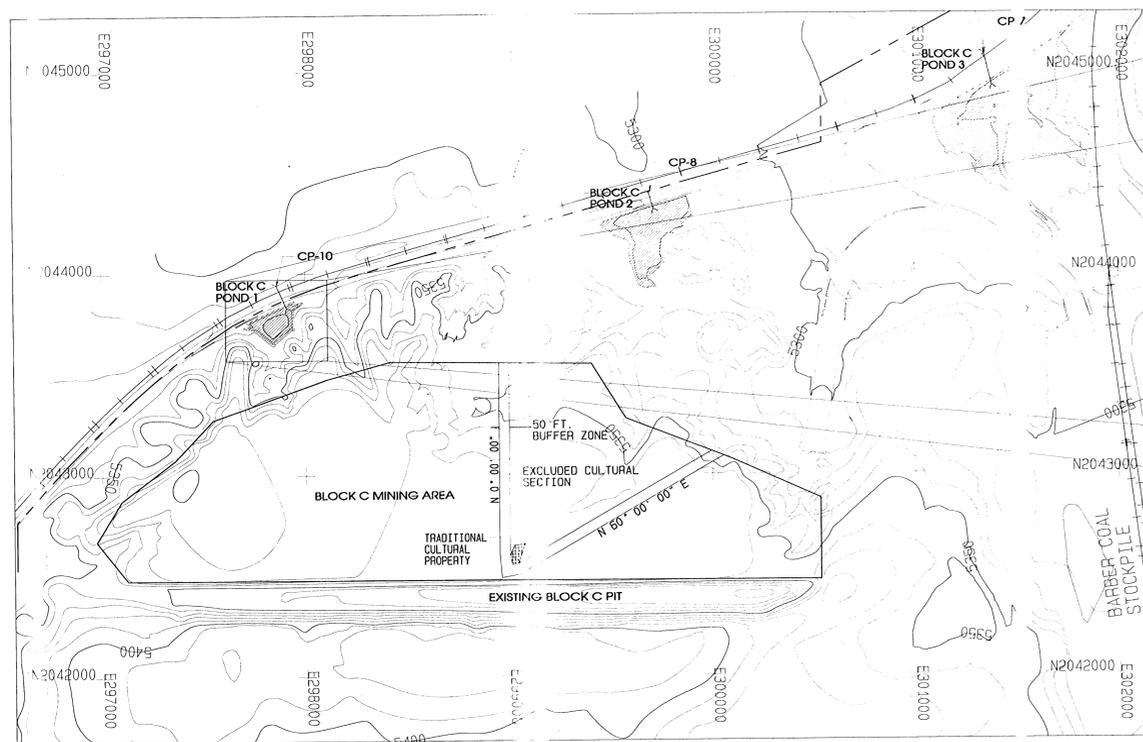

**BLOCK C LOCATION MAP**  
SCALE: 1" = 300'

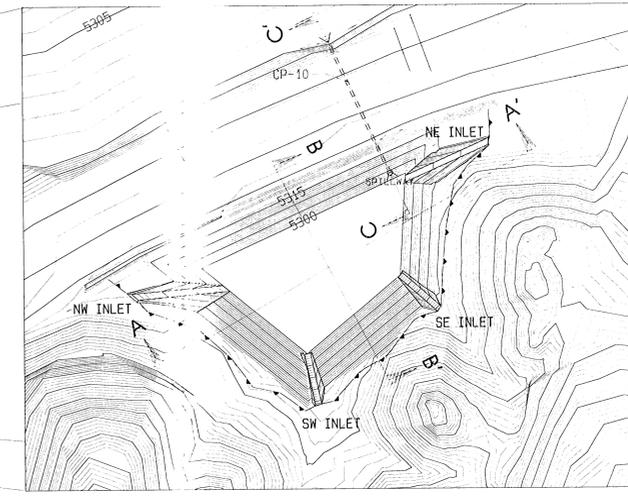

**BLOCK C POND 1**  
SCALE: 1" = 50'

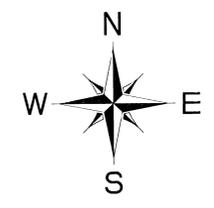

**LEGEND**


- ROAD
- LEASE LINE
- WATERSHED
- BERM
- IRRIGATION LINE
- CULVERT
- DAM
- DRAINAGE
- RAILROAD
- TREES
- POKER LINE
- SPOT ELEVATION
- INDEX CONTOUR
- INTERMEDIATE CONTOUR
- LEASE CORNER

**STAGE STORAGE DATA**

ELEV	AREA	VOLUME	CUM. VOLUME
Feet	Acres	cu-ft	cu-ft
5300	0.29	0.00	0.00
5301	0.30	0.30	0.30
5302	0.32	0.32	0.61
5303	0.34	0.33	0.95
5304	0.36	0.35	1.30
5305	0.38	0.37	1.67
5306	0.40	0.39	2.10
5307	0.42	0.40	2.48
5308	0.45	0.44	2.92
5309	0.47	0.46	3.38
5310	0.49	0.48	3.87
5311	0.52	0.51	4.38
5312	0.54	0.53	4.91
5313	0.57	0.56	5.47
5314	0.59	0.58	6.05
5315	0.62	0.61	6.67

**NOTES**


- For hydrology and design information refer to Appendix 11-5A in the approved PAP.
- Construct berms to drain into inlet entrances. Field locate as required.
- Refer to Table 11-5AG for "blue-line" elevation.
- Refer to Exhibit 11-130 for watershed information.

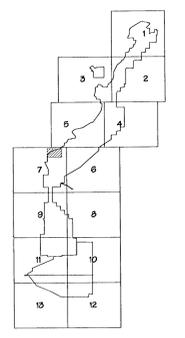


**CERTIFICATION STATEMENT**

I, Leonard Raymond, hereby certify that this drawing has been reviewed by me and that the information shown is complete and accurate to the best of my knowledge.


*Signature*  
1-29-99

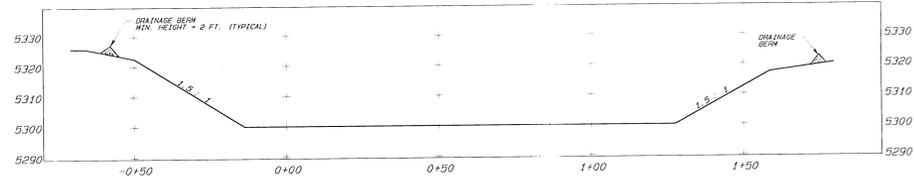


**SECTION A-A'**  
SCALE: 1" = 20'

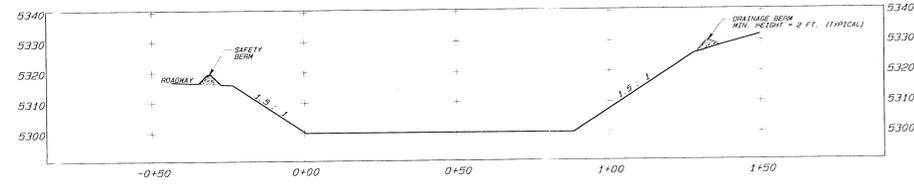


**SECTION B-B'**  
SCALE: 1" = 20'

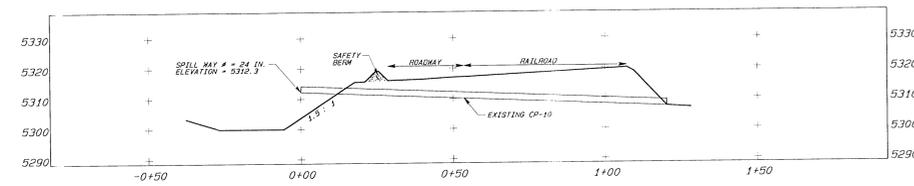

**SECTION C-C'**  
SCALE: 1" = 20'

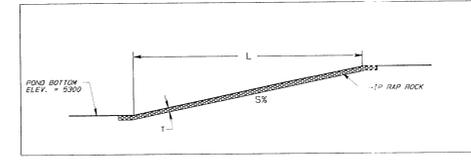

**TYPICAL INLET PROFILE**  
NTS

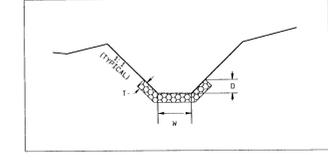

**TYPICAL INLET CROSS SECTION**  
NTS

**INLET SCHEDULE**

INLET	L	S	W	D	T	REP. REL. ROCK
	ft	%	ft	ft	ft	
NW	75.0	20.0	5.0	1.0	1.50	12.0
NE	75.0	20.0	5.0	1.0	1.13	9.0
SW	42.0	25.0	5.0	1.0	1.50	12.0
SE	40.0	25.0	5.0	1.0	1.13	9.0




DATE	BY	REVISION DESCRIPTION	ENG.	D.R.	P.E.	P.S.	SCALE
01/29/99	BH	SUBMITTED TO GDM FOR APPROVAL					

**EXHIBIT 26-57**  
**NAVAJO COAL COMPANY**  
NAVAJO MINE  
P.O. BOX 195 FRUITLAND, NEW MEXICO 87416

**BLOCK C POND 1**  
**DESIGN**

PREPARED BY BH	DRAWN BY BH	SCALE AS NOTED
APPROVED BY LR	DATE 01/29/99	REF DWG
DWG LDC J:\VGM_BUM\PER_PROG\CH_11\11-133, 134, 135\lccdesign.dwg		



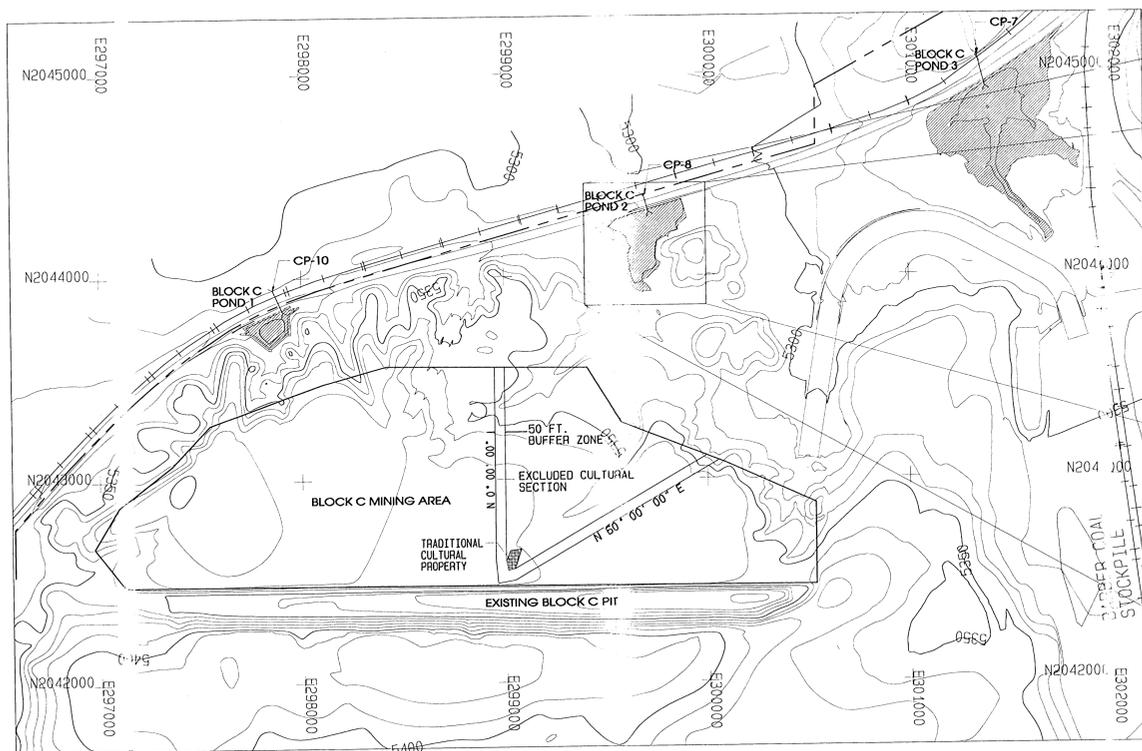

**BLOCK C LOCATION MAP**  
SCALE: 1" = 300'



**BLOCK C POND 2**  
SCALE: 1" = 50'

**LEGEND**




- ROAD
- LEASE LINE
- WATERSHED
- BERM
- IRRIGATION LINE
- CULVERT
- DAM
- DRAINAGE
- RAILROAD
- TREES
- POWERLINE
- SPOT ELEVATION
- INDEX CONTOUR
- INTERMEDIATE CONTOUR
- LEASE CORNER

**STAGE STORAGE DATA**


ELEV. FEET	AREA ACRES	VOLUME AC-FT	CUM. VOLUME AC-FT
5301	0.46	0.00	0.00
5302	0.49	0.48	0.48
5303	0.53	0.51	0.99
5304	0.56	0.55	1.54
5305	0.60	0.59	2.13
5306	0.67	0.64	2.77
5307	0.79	0.74	3.51
5308	0.92	0.86	4.37
5309	1.17	1.05	5.42
5310	1.53	1.36	6.79
5311	2.00	1.78	8.57
5312	2.51	2.27	10.84

**NOTES**


- For hydrology and design information refer to Appendix 11-A in the approved PAP.
- Construct berms to drain into inlet entrances. Field locate as required.
- Refer to Table 11-5A for "blue-line" elevation.
- Refer to Exhibit 11-130 for watershed information.

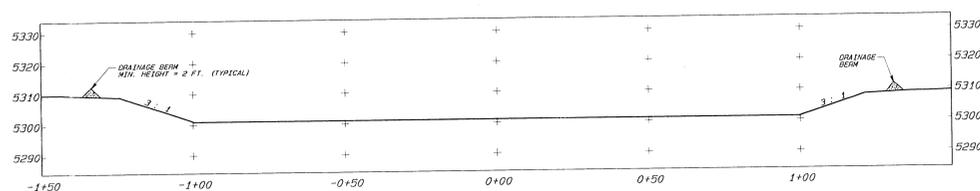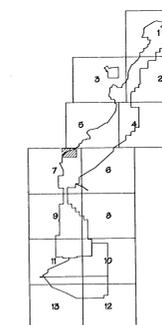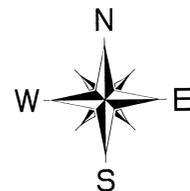

**SECTION A-A'**  
SCALE: 1" = 20'

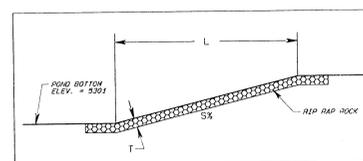

**TYPICAL INLET PROFILE**  
NTS

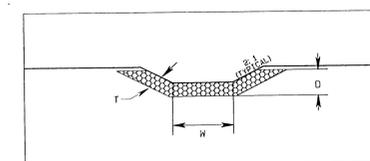


**TYPICAL INLET CROSS SECTION**  
NTS

**CERTIFICATION STATEMENT**

I, Leonard Raymond, hereby certify that this drawing has been reviewed by me and that the information shown is complete and accurate to the best of my knowledge.

LEONARD RAYMOND  
REGISTERED PROFESSIONAL ENGINEER  
STATE OF NEW MEXICO  
NO. 5500  
1-21-11

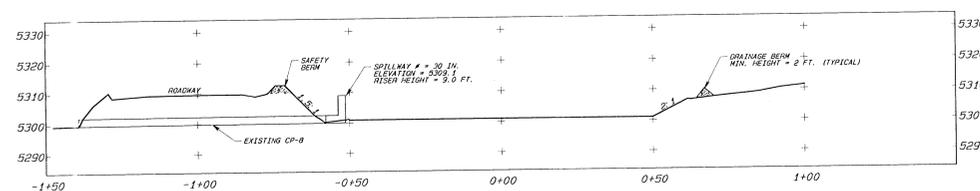

**SECTION B-B'**  
SCALE: 1" = 20'

**INLET SCHEDULE**

INLET	L ft	S %	W ft	D ft	T ft	RIP RAP ROCK 250 10
E	28.0	25.0	5.0	1.0	1.13	9.0
S	16.0	25.0	10.0	1.0	1.13	9.0
W	28.0	25.0	8.0	1.0	1.13	9.0




DATE	01/29/99	BY	BH	SUBMITTED TO	OSM FOR APPROVAL	DATE	01/29/99
SCALE	AS NOTED	PROJECT	EXHIBIT 26-59	DESIGNER	NAVJO COAL COMPANY	DATE	01/29/99

**EXHIBIT 26-59**  
**NAVAJO COAL COMPANY**  
NAVAJO MINE  
SAFETY  
P.O. BOX 155  
FREDLAND, NEW MEXICO 87415


**BLOCK C POND 2**  
**DESIGN**

PREPARED BY	DRAWN BY	SCALE	AS NOTED	
APPROVED BY	DATE	01/29/99	REF	DWG
DWG LOC: J:\NOSH\SUBM\PER_PROD\CH_51\11-133_134_8135\ocdesign.dwg				

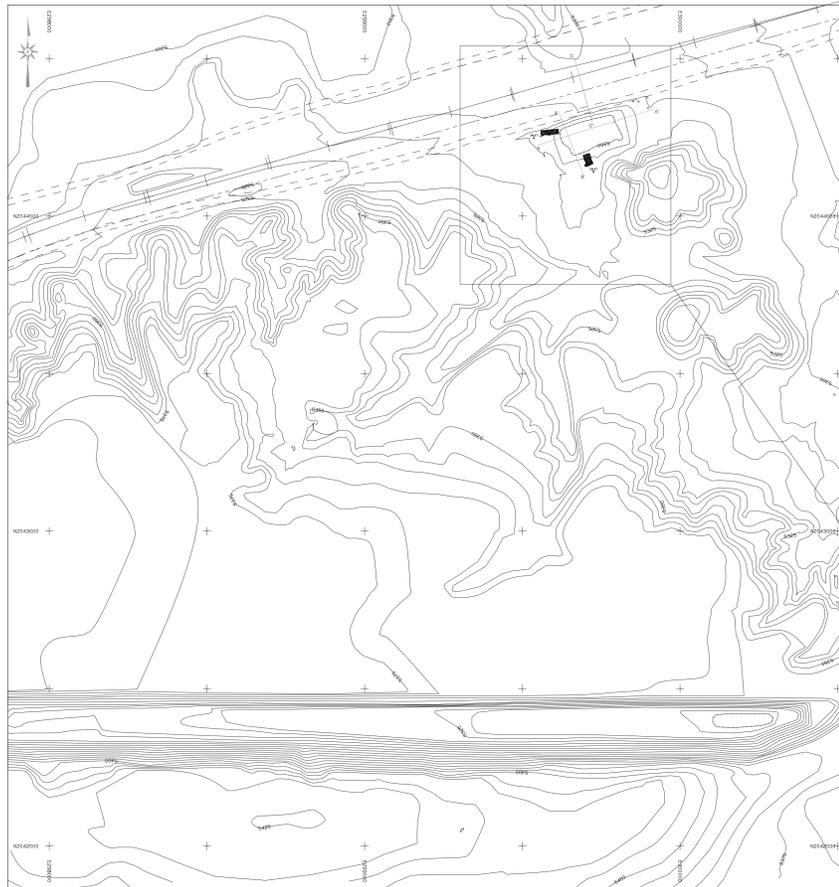

**BLOCK-C POND-2 LOCATION MAP**

SCALE: 1"=200'

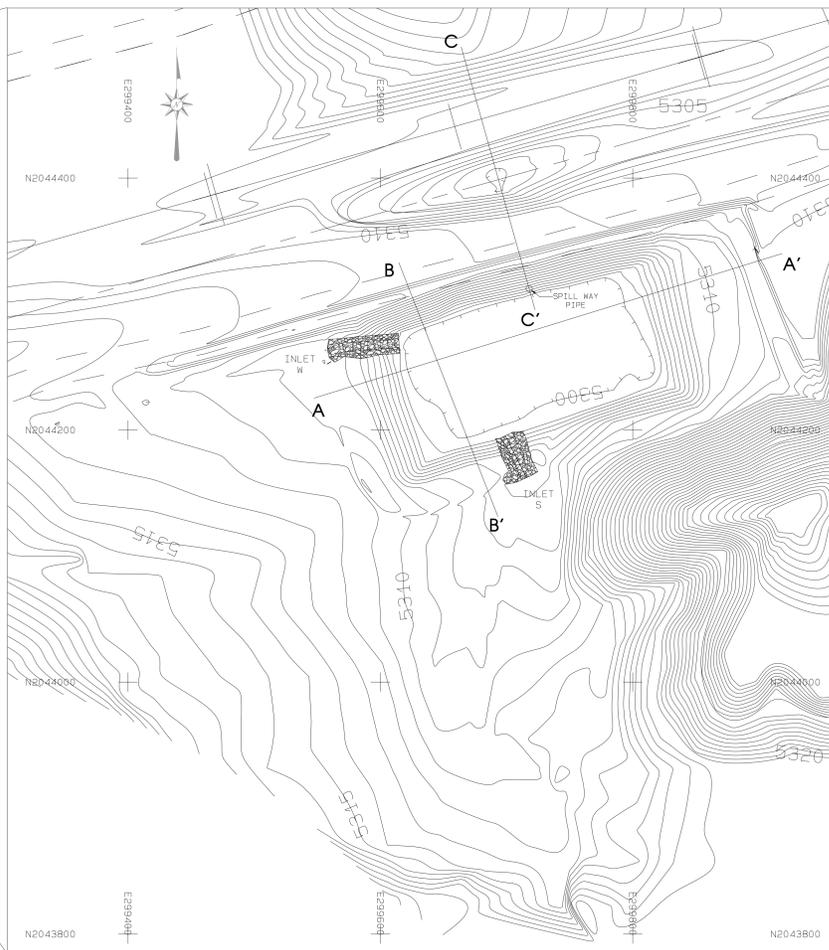

**BLOCK-C POND 2**

SCALE: 1"=50'

**LEGEND**



- ROAD
- - - WATERSHED
- ▭ BUILDING
- - - FENCE
- ||| IRRIGATION LINE
- ⌒ CULVERT
- ⌒ DAM
- - - DRAINAGE
- ⌒ RAILROAD
- TREES
- ⊙ POWERLINE
- ⊙ x5328.5 SPOT ELEVATION
- 5300 INDEX CONTOUR
- 5298 INTERMEDIATE CONTOUR
- - - LEASE/PERMIT BOUNDARY

**STAGE STORAGE DATA**

ELEV. FEET	AREA AC-FEET	VOLUME AC-FEET	CUM. VOLUME AC-FEET
5300	0.36	0.41	0.00
5301	0.46	0.49	0.41
5302	0.51	0.53	0.90
5303	0.55	0.58	1.44
5304	0.60	0.63	2.01
5305	0.65	0.69	2.64
5306	0.71	0.78	3.33
5307	0.83	0.91	4.10
5308	0.98	1.08	5.01
5309	1.17	1.36	6.10
5310	1.52	1.76	7.45
5311	1.98	2.26	9.22


**NOTES**

- For hydrology and design information refer to Appendix 11-44 in the approved PAP.
- Refer to Table 11-54H for "blue-line" elevation.
- Refer to Exhibit 11-130 for watershed information.
- Gauge Post Base Elevation : 5298.58

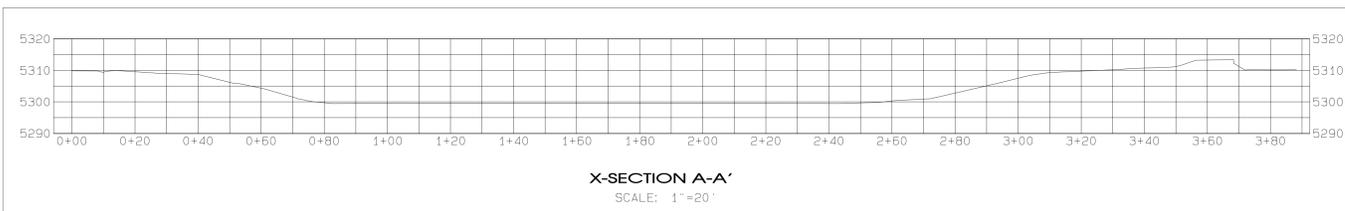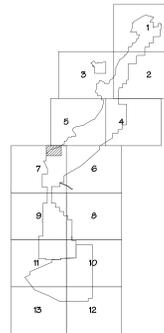


**X-SECTION A-A'**

SCALE: 1"=20'

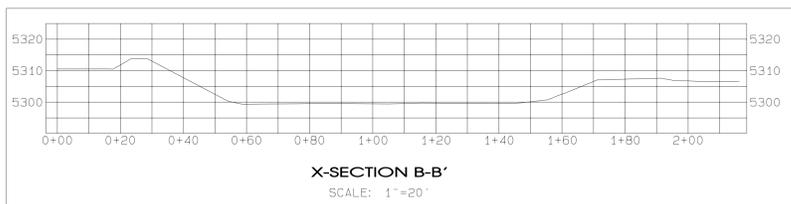


**X-SECTION B-B'**

SCALE: 1"=20'

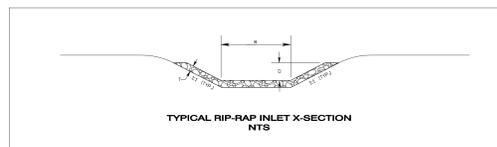


**TYPICAL RIP-RAP INLET X-SECTION NTS**

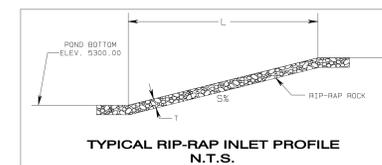

**TYPICAL RIP-RAP INLET PROFILE N.T.S.**

**INLET SCHEDULE**

INLET	L (ft.)	S (ft.)	R (ft.)	D (ft.)	T (ft.)	RIP RAP ROCK (cu. ft.)
W	57.0	15.0	7.0	1.0	1.0	9.0
S	38.0	15.0	7.5	1.0	1.0	9.0

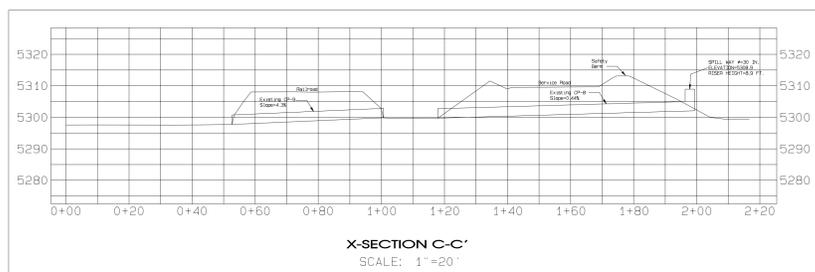

**X-SECTION C-C'**

SCALE: 1"=20'

**CERTIFICATION STATEMENT**

I, Leonard Raymond, hereby certify that this impoundment has been constructed in accordance with the approved design plans and that this information shown is complete and accurate to the best of my knowledge.



REV. NO.	DATE	DWMT. BY	REVISION DESCRIPTION	ENG. I.S. P.E. P.L.S. CIVIL ENGINEER
A	12/15/99	PJF	SUBMITTED TO OSM	BH MC LR

**EXHIBIT 26-60**

**NAVAJO COAL COMPANY**




**BLOCK-C POND 2 AS-BUILT**


PREPARED BY	DRAWN BY	SCALE
PJF	PJF	AS NOTED

APPROVED BY LR DATE 12/03/99

PATH : G:\Department\15\1509\SUB\PER\9900\CH\_11\_PAP\_EXHIBIT11-133\_134\_6135-BLK-C

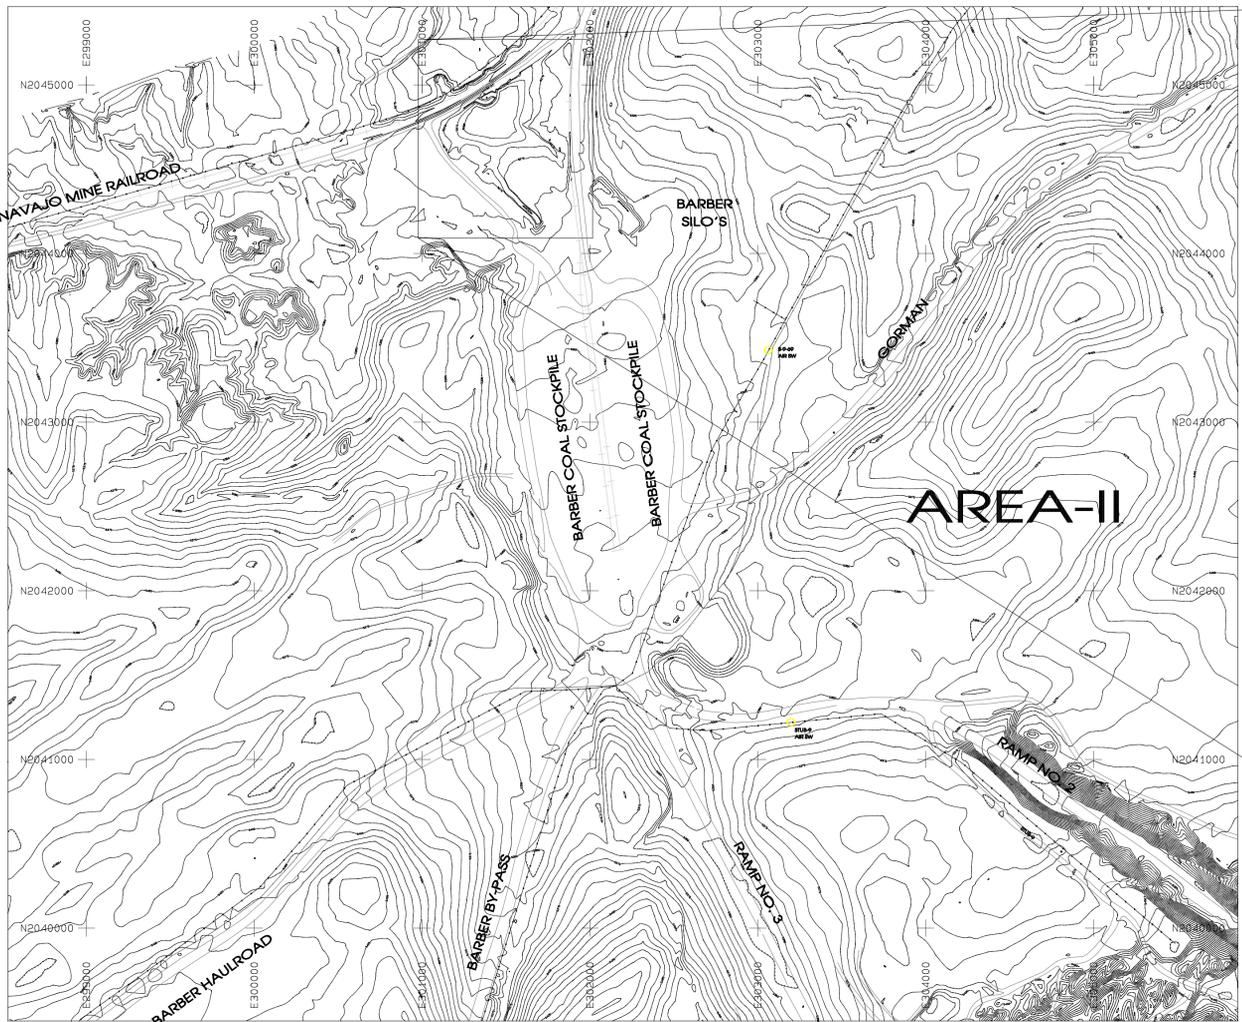


Location Map  
Scale 1" = 500'

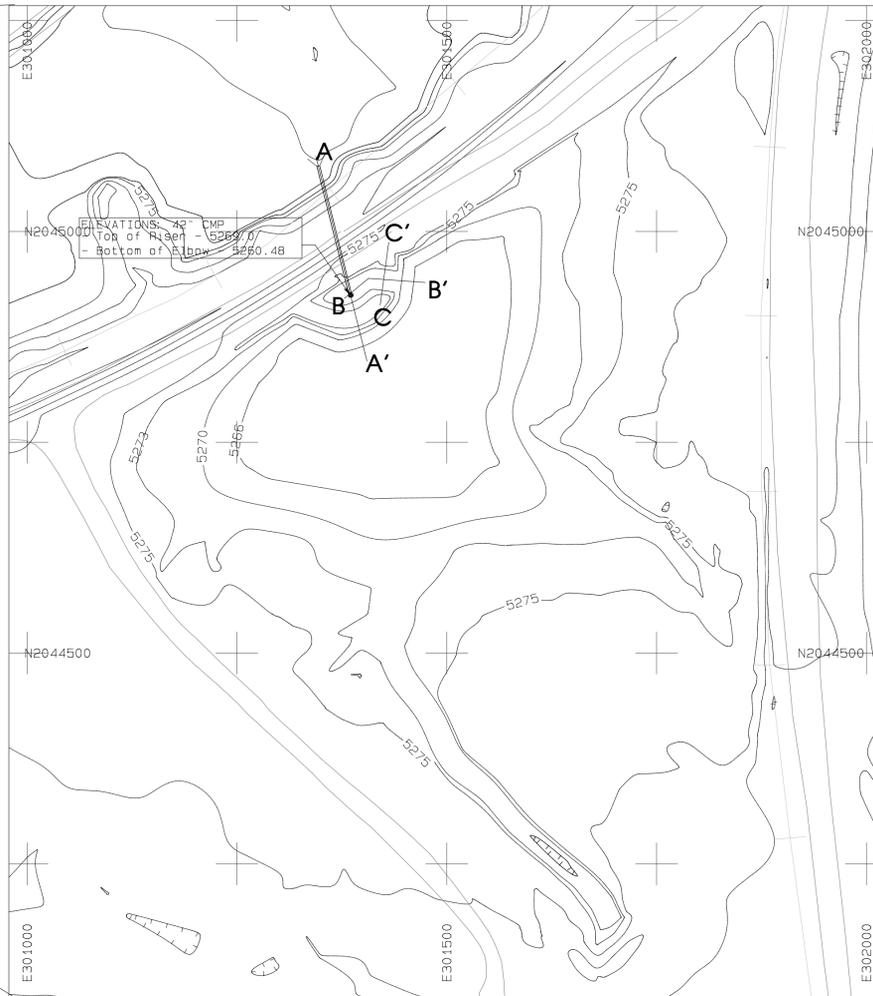

Project Area  
Scale 1" = 100'


**LEGEND**

- ROAD
- WATERSHED
- BUILDING
- FENCE
- IRRIGATION LINE
- CULVERT
- DAM
- DRAINAGE
- RAILROAD
- TREES
- POWER LINE
- SPOT ELEVATION
- INDEX CONTOUR
- INTERMEDIATE CONTOUR
- LEAVE CORNER
- LEASE/PERMIT BOUNDARY

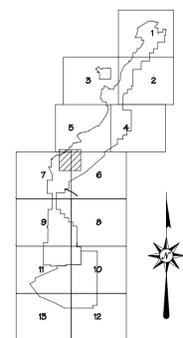

**NOTES**


1. For hydrology and design information refer to Appendix 11-AA in the Approved PAP.
2. Refer to Table 11-5A1 for "blue-line" elevation.
3. Refer to Exhibit 11-13C and 11-13D for watershed information.
4. Gauge Post Base Elevation 5265.0

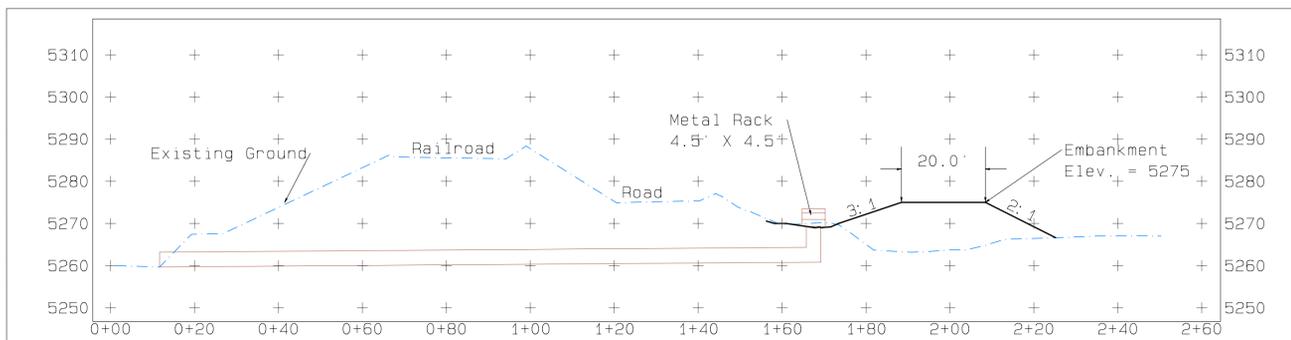


PROFILE A-A'  
Scale 1" = 20'

**STAGE STORAGE DATA**

ELEV feet	AREA acres	VOLUME ac-ft	CUM. VOLUME ac-ft
5266	1.46	0.00	0.00
5267	1.65	1.55	1.55
5268	1.87	1.77	3.32
5269	2.10	1.98	5.30
5270	2.35	2.22	7.52
5271	2.73	2.54	10.06
5272	3.20	2.96	13.02
5273	4.23	3.70	16.72
5274	5.40	3.81	21.53
5275	6.50	5.94	27.47

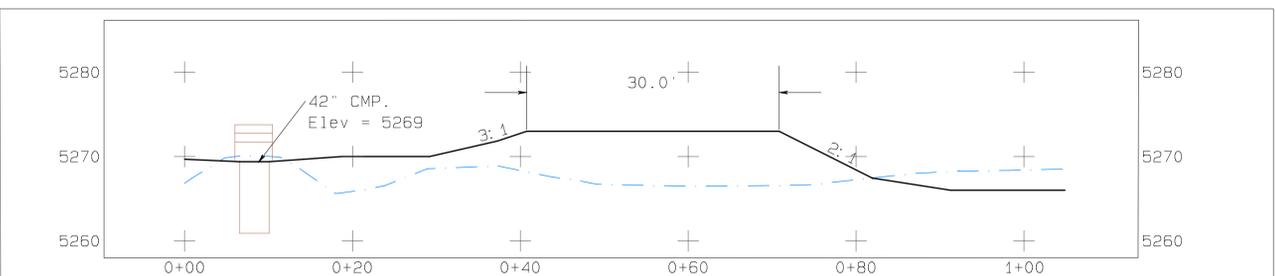

Profile B-B'  
Scale 1"=10'

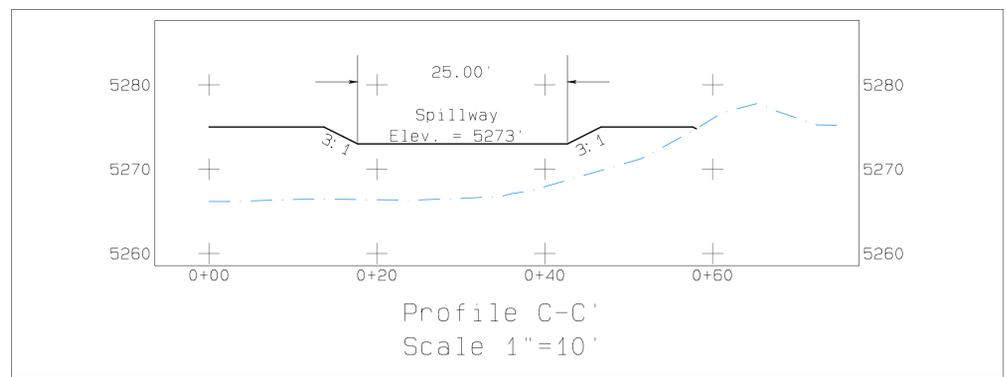

Profile C-C'  
Scale 1"=10'

**CERTIFICATION STATEMENT**

I, Kevin A. Bane, hereby certify that this drawing was reviewed by me and that the information shown is accurate and complete to the best of my knowledge.




REV. NO.	DATE	BY	REVISION DESCRIPTION	LR	MC	LR
A	8/7/07	SS	SUBMITTED TO OSM FOR REVIEW AND APPROVAL			

**EXHIBIT 26-61**  
**BHP BILLITON NAVAJO COAL COMPANY**  
 NAVAJO MINE  
 P.O. BOX 1717 FRUITLAND, NEW MEXICO 87418/PHONE 505-598-5861/FAX 505-598-3361

**Block C Pond 3  
Design**


PREPARED BY	SS	DRAWN BY	SS	SCALE	1" = 200'
APPROVED BY	LR	DATE	8/08/07		



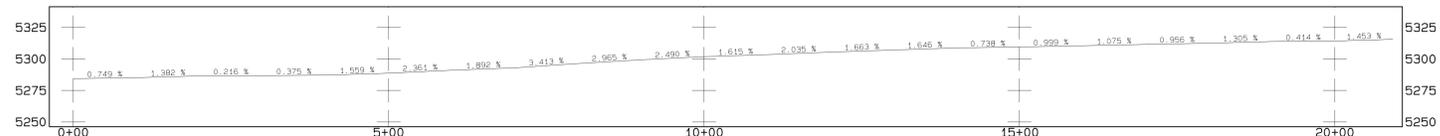


PROFILE OF WEST DRAIN DITCH


HORIZONTAL SCALE: 1"=100'  
VERTICAL SCALE: 1"=50'

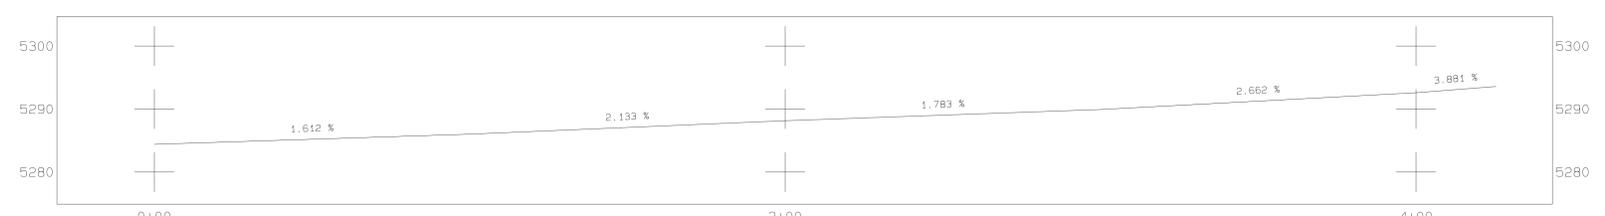

PROFILE OF NORTH DRAIN DITCH

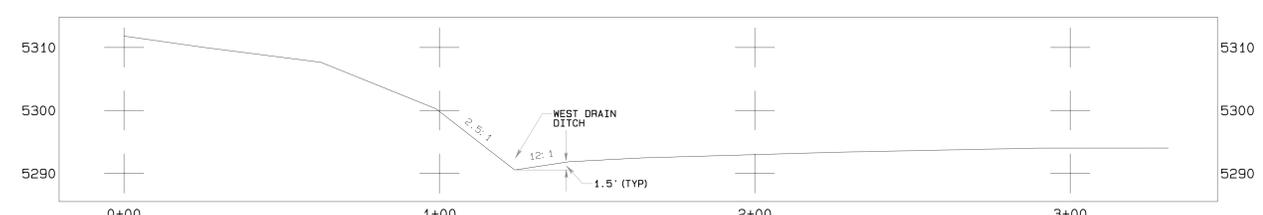

TYPICAL SECTION C - C

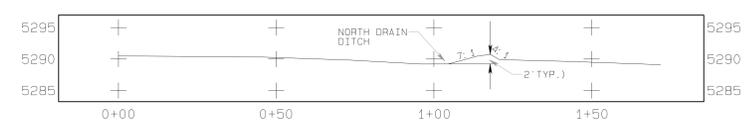

TYPICAL SECTION D - D


HORIZONTAL SCALE: 1"=20'  
VERTICAL SCALE: 1"=10'

LEGEND

- ROAD
- LEASE LINE
- WATERSHED
- BERM
- IRRIGATION LINE
- CULVERT
- DAM
- DRAINAGE
- RAILROAD
- TREES
- POWERLINE
- SPOT ELEVATION
- INDEX CONTOUR
- INTERMEDIATE CONTOUR
- LEASE CORNER

NOTES

1. For hydrology and design information refer to appendix 11-AA in the approved PAP.
2. Refer to Table 11-5AI for additional data.
3. Refer to Exhibit 11-13C and 11-13D for watershed information.
4. Gauge Post Base Elevation : 5264.08

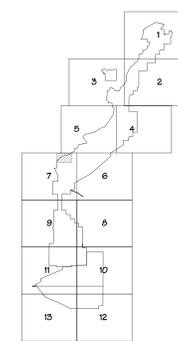

CERTIFICATION STATEMENT

I, Leonard Raymond, hereby certify that this impoundment has been constructed in accordance with the approved design plans and that this information shown is complete and accurate to the best of my knowledge.



REV. NO.	DATE	BY	DESCRIPTION	APP'D.
A	6/6/02	LR	SUBMITTED TO DSM FOR REVIEW	RY MC LR


EXHIBIT 26-63

NAVAJO COAL COMPANY




BLOCK C POND 3  
TYPICAL SECTION AND PROFILE  
OF MODIFIED SURFACE DRAINAGE  
AS-BUILT


PREPARED BY RY	DRAWN BY RY	SCALE AS NOTED
APPROVED BY LR	DATE 06/06/02	REF DWG
DWG LOC: C:\dept\mex15a\gsk\sub\pdr\pdr02\ch_11\pdp\enr\2011-11-13\134_6135-RL-C		

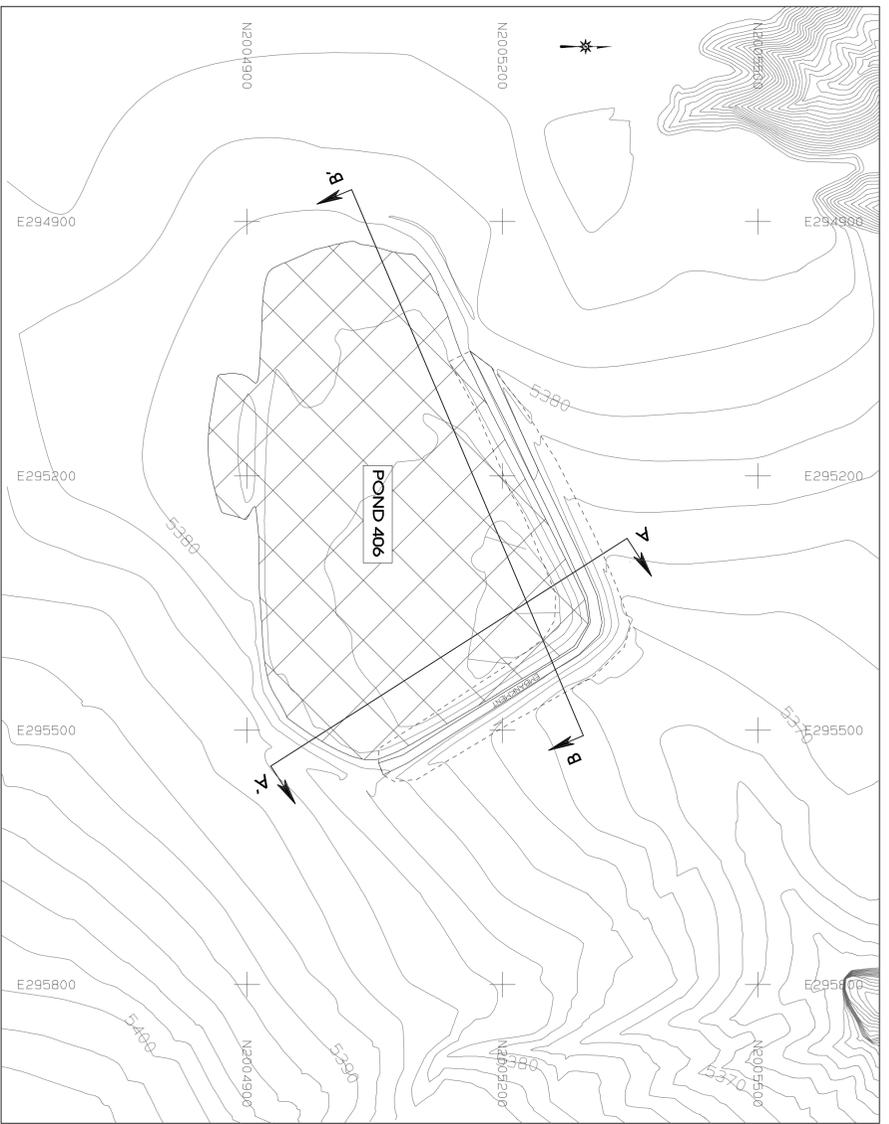

**PLAN VIEW**  
 CONTOUR INT: 2 FT  
 SCALE: 1"=100'

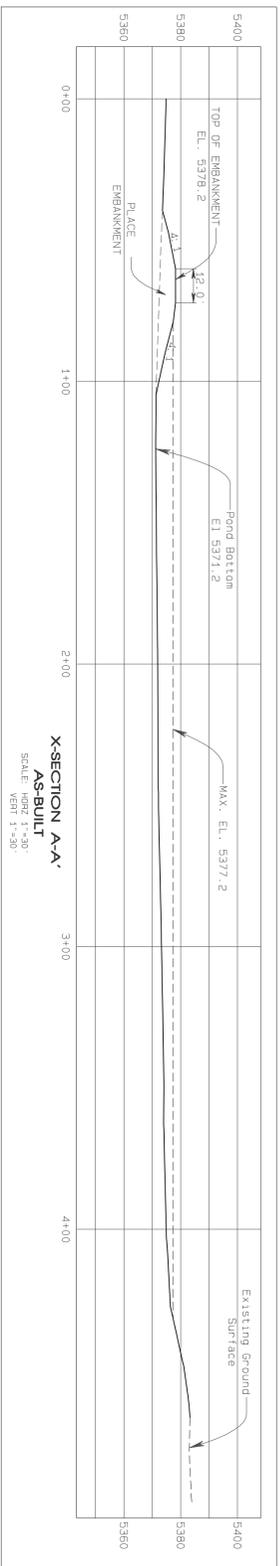

**X-SECTION A-A'**  
 AS-BUILT  
 SCALE: HORIZ 1"=30'  
 VERT 1"=30'

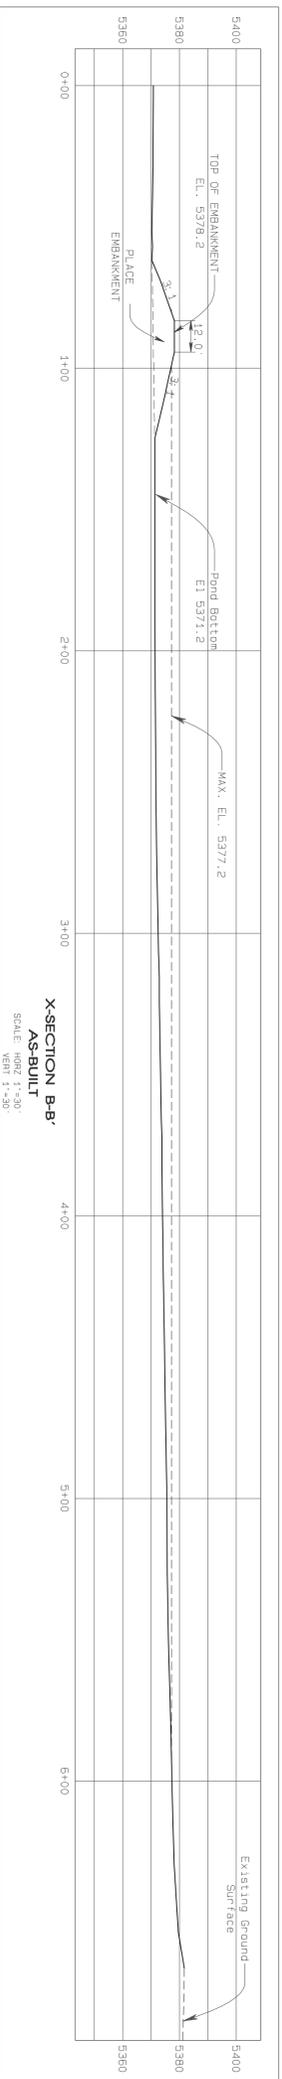

**X-SECTION B-B'**  
 AS-BUILT  
 SCALE: HORIZ 1"=30'  
 VERT 1"=30'

**LEGEND**

- ROAD
- BUILDING
- FENCE
- CULVERT
- DRAINAGE
- POWERLINE
- INDEX CONTOUR
- PERMIT/LEASE BOUNDARY


**NOTES**

- For location of drainage control structures and waterways, refer to Exhibit 11-13F and the hydrology and sedimenting design data for the drainage area as provided on the referenced in Table 11-5 of the NM PAP.

**STAGE STORAGE DATA**

ELEV feet	AREA acres	VOLUME ac-ft	CUM. VOLUME ac-ft
5371.2	0.00	0.1	0.1
5372	0.29	0.6	0.7
5373	0.88	1.2	1.9
5374	1.47	1.9	3.8
5375	2.35	2.7	6.5
5376	3.00	3.7	10.2
5377	3.49	4.7	13.7
5378	3.83	5.7	17.4
5379	4.17	6.7	21.1

Crest of Embankment 5379.2  
 As-Built Volume at Crest Elevation 14.2

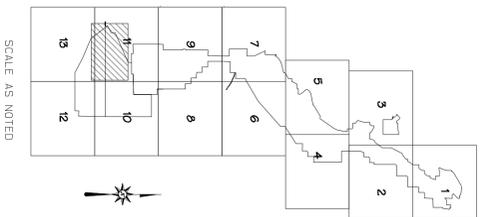

SCALE AS NOTED

**CERTIFICATION STATEMENT**

I, Ron C. Van Valkenburg, hereby certify that this embankment has been constructed in accordance with the approved design plans and that the information shown is complete and accurate to the best of my knowledge except as noted below:  
 1. Only minor elevation differences for pond bottom and embankment crest.



PROJECT: A4N  
 DATE: AUG. 8, 2009  
 DESIGNED BY: RCV  
 DRAWN BY: P.J.FOSTER  
 CHECKED BY: RCV  
 APPROVED BY: RCV

**bhpbilliton**  
**NAVAJO COAL COMPANY**  
**NAVAJO MINE**


PROJECT MANAGER: F. GORMAN  
 ENR. OF RECORD: RON C. VAN VALKENBURG  
 REG. NO: NM 9263  
 SRVYR OF RECORD:  
 REG. NO:

REVISION	DATE
09-APPROVED AND DEVELOPMENT AND SUBMITTED TO SON FOR REVIEW	8/28/09
10-1 PREPARED AS-BUILT FOR AREA NORTH POND-406 AND SUBMITTED TO SON FOR REVIEW	1/19/2010


**EXHIBIT 26-64**  
**AREA 4 NORTH**  
**POND 406**  
**As-Built**

**PLAN, PROFILE AND SECTION**


SHEET  
 OF 0

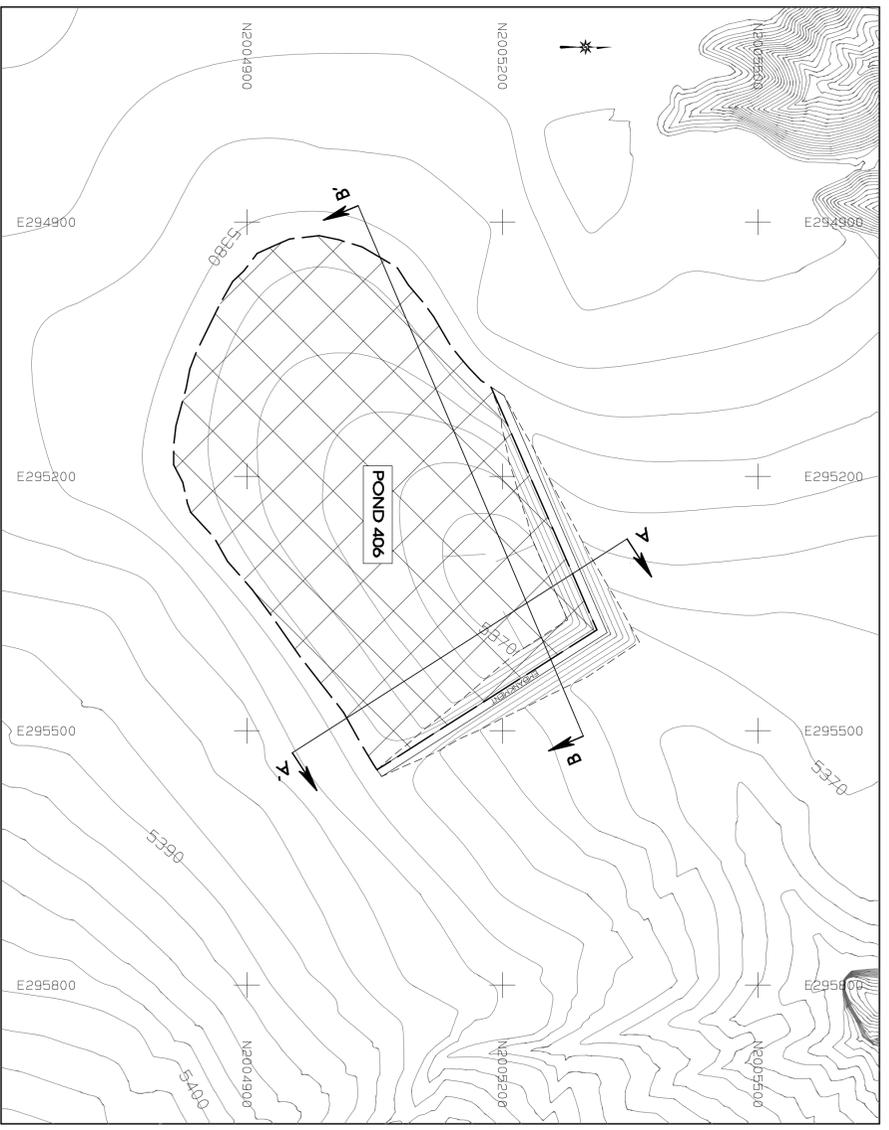

**PLAN VIEW**  
 CONTOUR INT: 2 FT  
 SCALE: 1"=100'

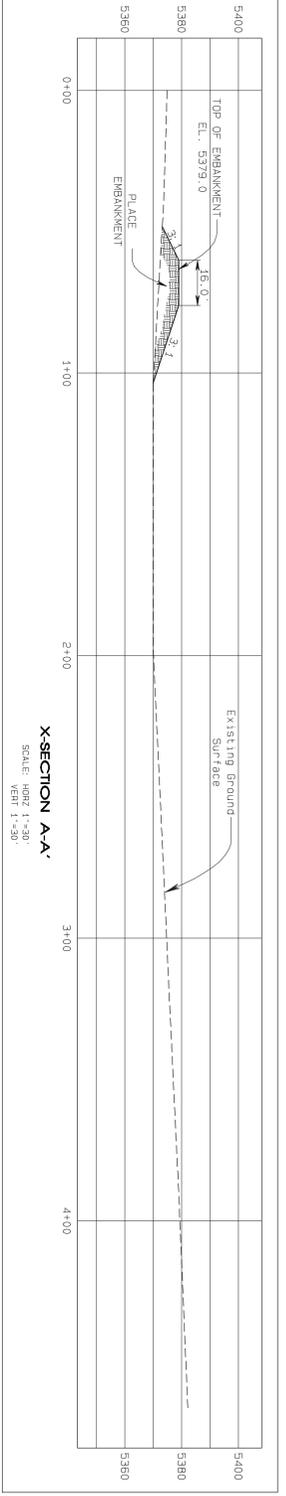

**X-SECTION A-A'**  
 SCALE: HORIZ 1"=30'  
 VERT 1"=30'

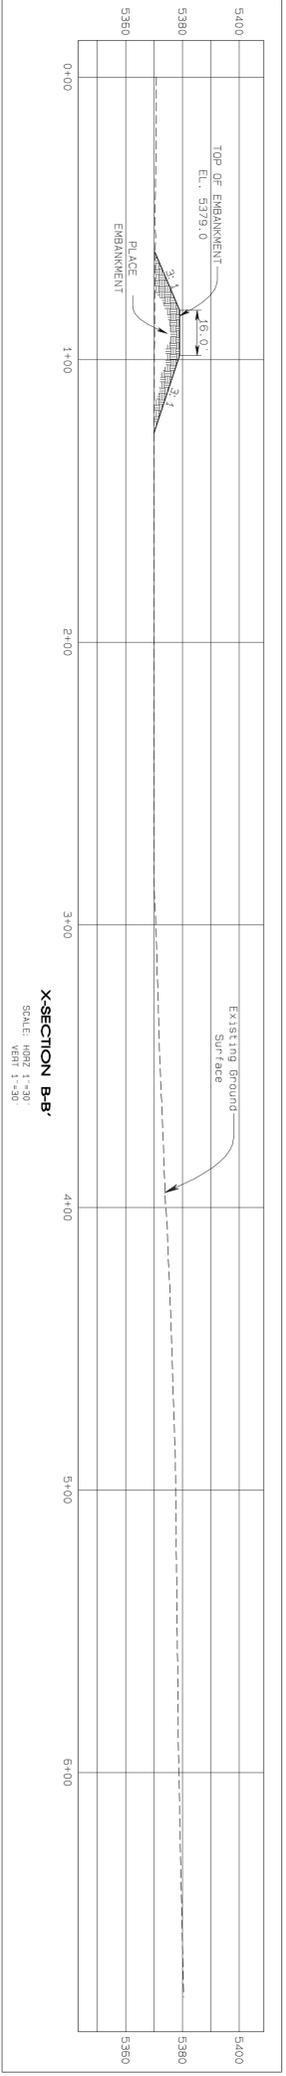

**X-SECTION B-B'**  
 SCALE: HORIZ 1"=30'  
 VERT 1"=30'

**LEGEND**


- ROAD
- BUILDING
- FENCE
- CULVERT
- DRAINAGE
- POWERLINE
- INDEX CONTOUR
- INTERMEDIATE CONTOUR
- PERMIT/LEASE BOUNDARY

**NOTES**

1. For location of drainage control structures and watersheds, refer to Exhibit 11-13F.
2. The hydrology and supporting design data for the Table 11-5 of the NW map.

**STAGE STORAGE DATA**

ELEV feet	AREA acres	VOLUME ac-ft	CUM. VOLUME ac-ft
5370	0.36	0.00	0.00
5371	0.54	0.5	0.50
5372	0.78	0.7	1.10
5373	1.09	0.90	2.00
5374	1.54	1.30	3.30
5375	1.92	1.70	5.10
5376	2.43	2.20	7.20
5377	2.95	2.70	9.90
5378	3.58	3.30	13.20
5379	4.26	3.90	17.10

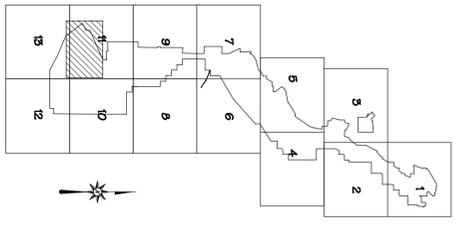

SCALE AS NOTED

**CERTIFICATION STATEMENT**

I, Ron C. Van Valkenburg, hereby certify that this drawing was reviewed by me and that the information shown is complete and accurate to the best of my knowledge.



**bhpbilliton**  
**NAVAJO COAL COMPANY**  
**NAVAJO MINE**

PO BOX 1717, FRUITLAND, NEW MEXICO, 87416 PHONE 505-598-3209/FAX 505-598-3361


PROJECT: A4N  
 DATE: AUG. 8, 2009  
 DESIGNED BY: RCV  
 DRAWN BY: PJFOSTER  
 CHECKED BY: RCV  
 APPROVED BY: RCV

**PLAN, PROFILE AND SECTION**


**EXHIBIT 26-64**  
**AREA 4 NORTH**  
**POND 406**  
**Design**

REVISION	DATE
09-A UPDATED SAN DEVELOPMENT AND SUBMITTED TO OSM FOR REVIEW	8/28/09
11-A AREA 4 NORTH REVISION RESUBMITTAL TO OSM FOR REVIEW AND APPROVAL.	FEB-2011


PROJECT MANAGER: F. GORMAN  
 ENGR. of RECORD: RON C. VAN VALKENBURG  
 REG. NO: NM 9263  
 SURVEY of RECORD:  
 REG. NO:

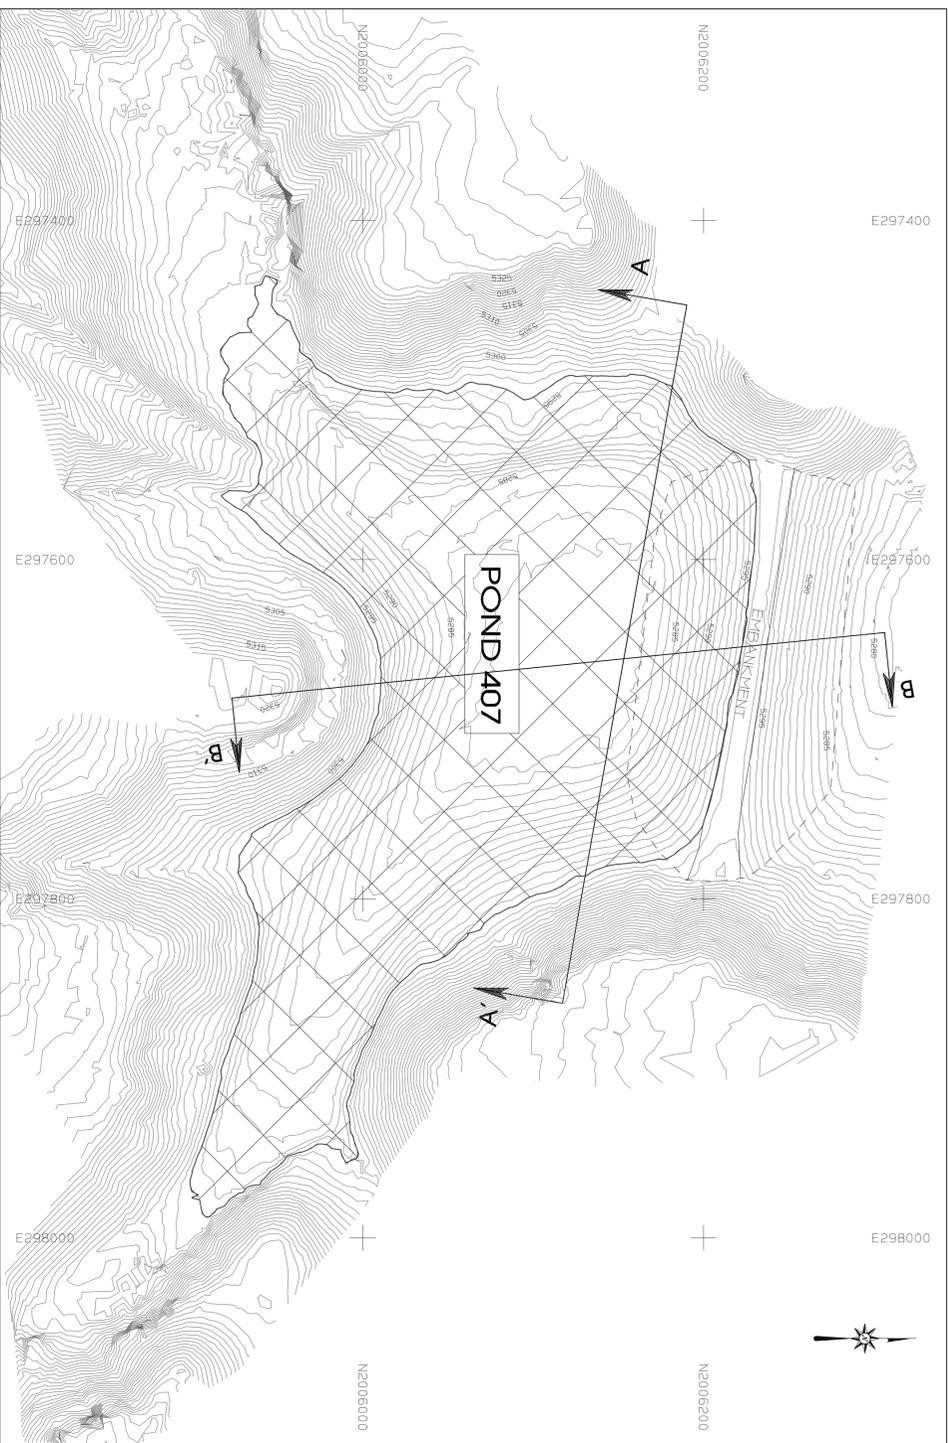

**PLAN VIEW**  
SCALE: 1" = 50'

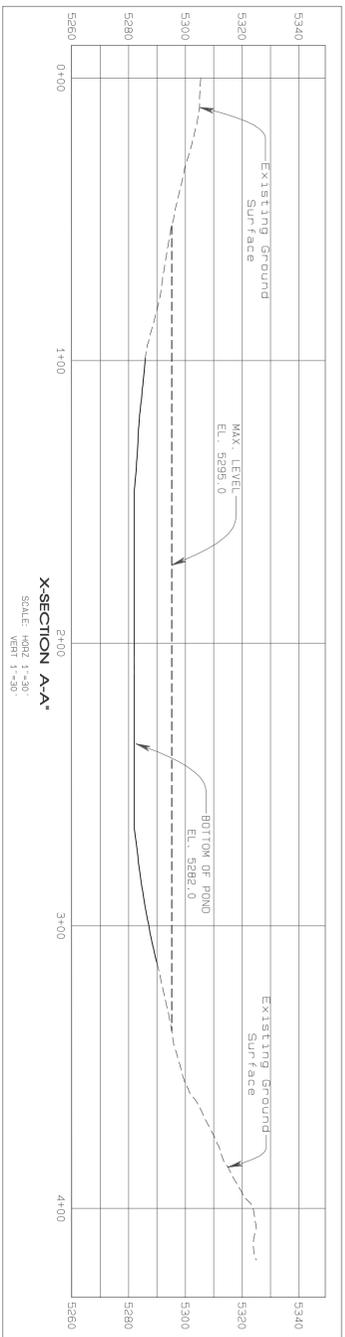

**X-SECTION A-A'**  
SCALE: HORIZ 1" = 30'  
VERT 1" = 30'

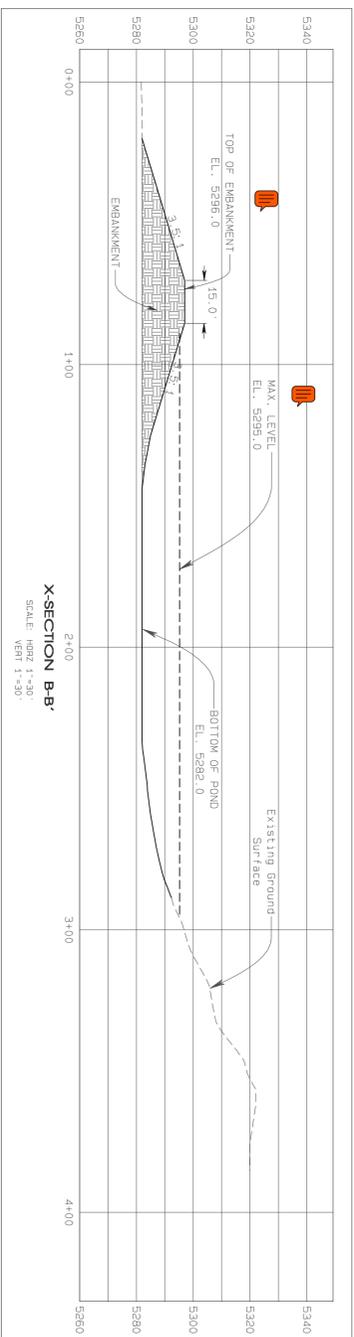

**X-SECTION B-B'**  
SCALE: HORIZ 1" = 30'  
VERT 1" = 30'

**LEGEND**

- ROAD
- BUILDING
- FENCE
- CULVERT
- DRAINAGE
- POWER LINE
- INDEX CONTOUR
- INTERMEDIATE CONTOUR
- PERMIT/LEASE BOUNDARY


**NOTES**

- For location of drainage control structures and watersheds, refer to Exhibit 11-13F.
- The hydrology and supporting design data for the pond are shown on the maps as referenced on Table 11-7 of the NW MAP.

**STAGE STORAGE DATA**

ELEV feet	AREA acres	VOLUME ac-ft	CUM. VOLUME ac-ft
5292	0.23	0.0	0.0
5293	0.36	0.3	0.3
5294	0.49	0.4	0.7
5295	0.61	0.6	1.3
5296	0.72	0.7	1.9
5297	0.83	0.8	2.7
5298	0.94	0.9	3.6
5299	1.06	1.0	4.6
5300	1.18	1.1	5.7
5301	1.31	1.2	7.0
5302	1.45	1.4	8.3
5303	1.61	1.5	9.9
5304	1.77	1.7	11.6
5305	1.92	1.8	13.4
5306	2.09	2.0	15.4
5307	2.26	2.2	17.6

Net of Embankment  
Spill Volume at Crest Elevation 15.4

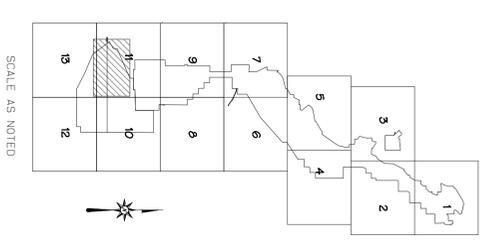

SCALE AS NOTED

**CERTIFICATION STATEMENT**  
I, Ron C. Van Valkenburg, hereby certify that this impoundment has been constructed in accordance with the approved design plans and that the information shown is complete and accurate to the best of my knowledge.



PROJECT: 44W  
DATE: AUG. 8, 2009  
DESIGNED BY: RCV  
DRAWN BY: PJFOSTER  
CHECKED BY: RCV  
APPROVED BY: RCV

**bhpbilliton**  
**NAVAJO COAL COMPANY**  
**NAVAJO MINE**


PROJECT MANAGER: F. GORMAN  
ENR. of RECORD: RON C. VAN VALKENBURG  
REG. NO: NM 9263  
SRVYR of RECORD:  
REG. NO:

REVISION	DATE
09- UPDATED PLAN DEVELOPMENT AND SUBMITTED TO DSK FOR REVIEW	8/28/09
10- PREPARED AS-BUILT FOR POND 407 AND SUBMITTED TO DSK FOR REVIEW	2-09-10


**EXHIBIT 26-65**  
**AREA 4 NORTH**  
**POND 407**  
**AS-BUILT**

**PLAN, PROFILE AND SECTION**


DRAWING  
SHEET 07 OF 0

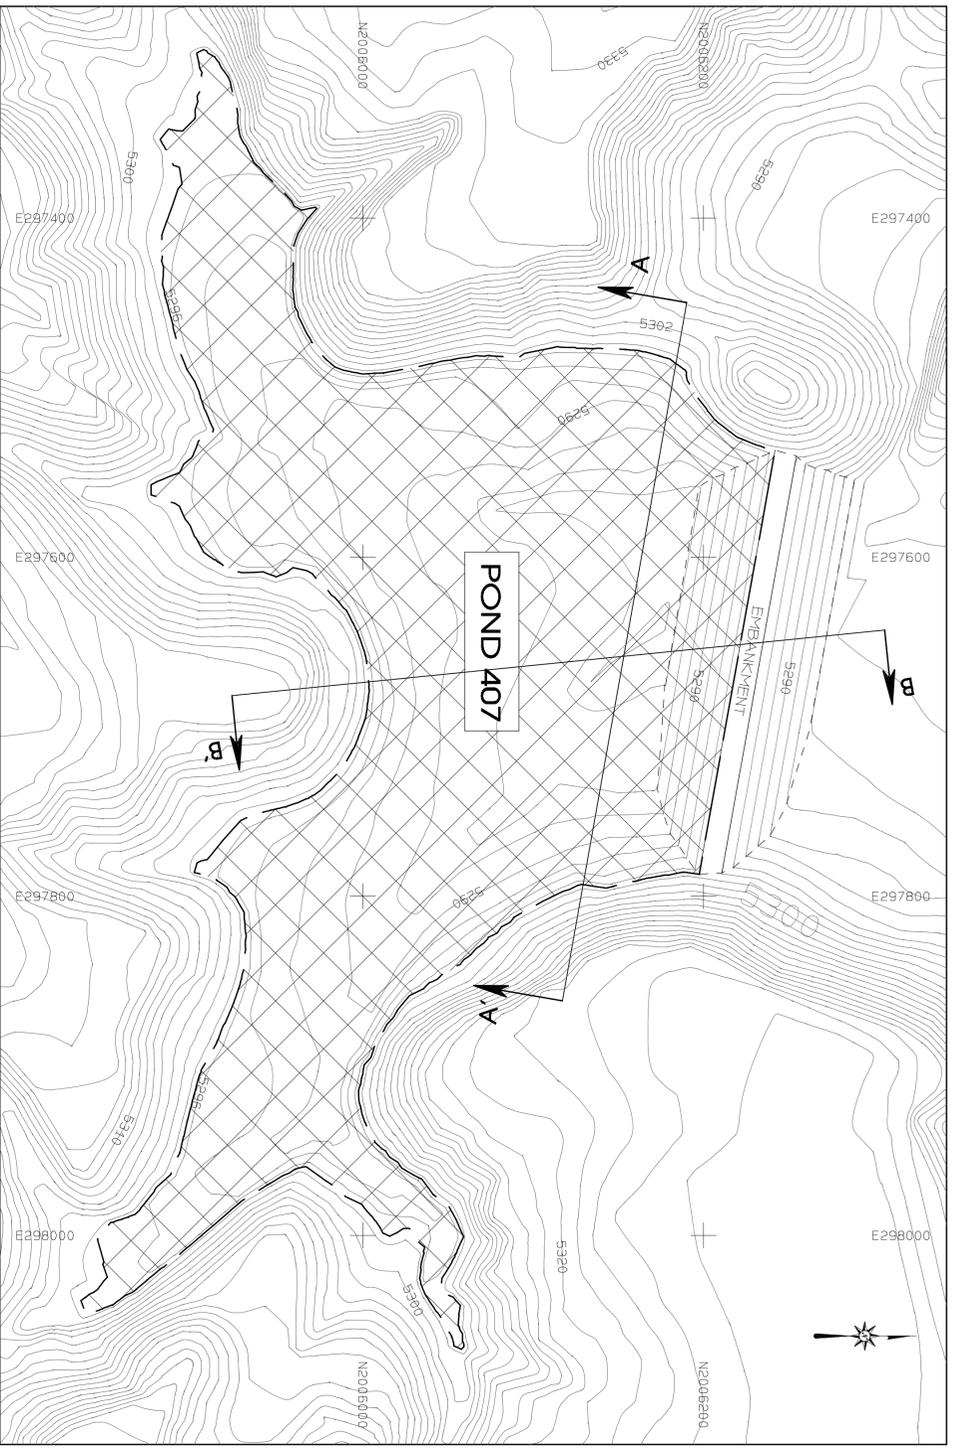

**PLAN VIEW**  
SCALE: 1"=50'

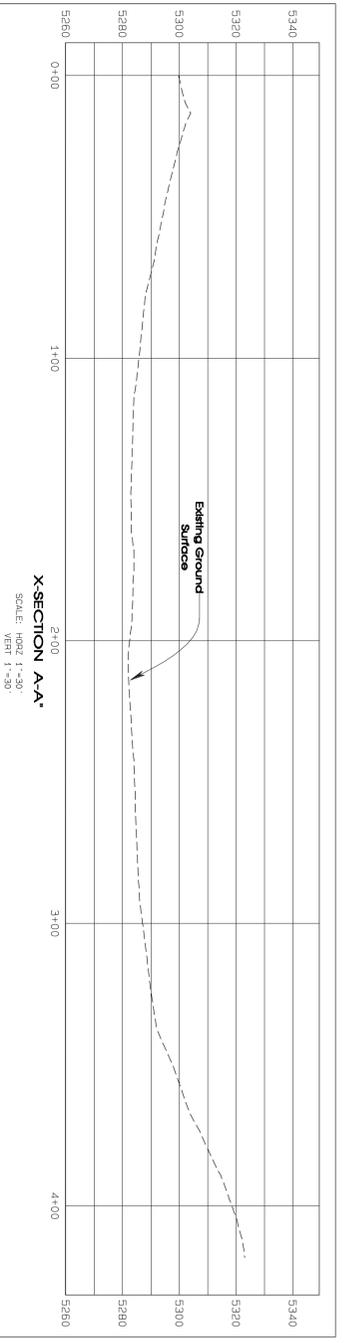

**X-SECTION A-A'**  
SCALE: HORIZ. 1"=30'  
VERT. 1"=30'

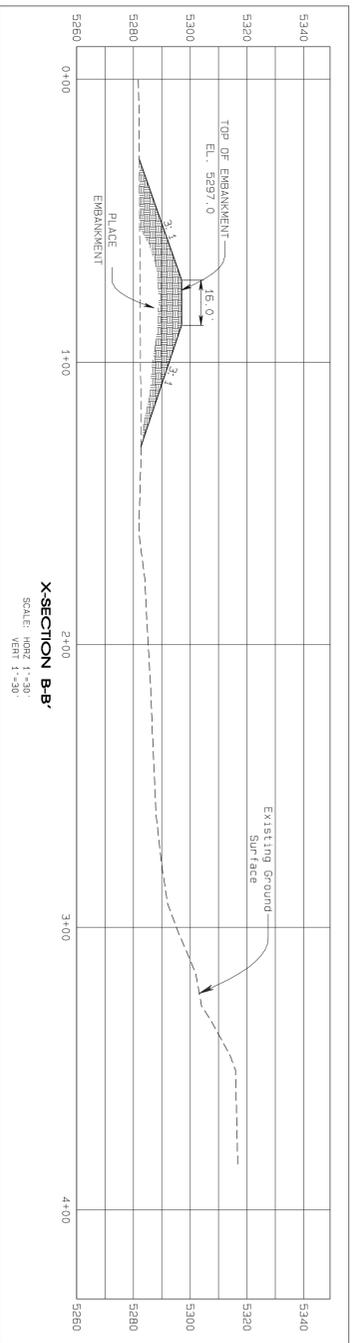

**X-SECTION B-B'**  
SCALE: HORIZ. 1"=30'  
VERT. 1"=30'

**LEGEND**


- ROAD
- BUILDING
- FENCE
- CULVERT
- DRAINAGE
- POWERLINE
- INDEX CONTOUR
- INTERMEDIATE CONTOUR
- PERMIT/LEASE BOUNDARY

**NOTES**

1. For location of drainage control structures and waterways, refer to Exhibit 11-13F.
2. The hydrology and supporting design data for the final design are referenced on Table 11-5 of the NW map.

**STAGE STORAGE DATA**

ELEV. feet	AREA acres	VOLUME ac-ft	CUM. VOLUME ac-ft
5282	0.01	0.00	0.00
5284	0.14	0.10	0.10
5286	0.44	0.50	0.70
5288	0.81	1.20	2.00
5290	1.22	2.00	4.00
5292	1.64	2.90	6.90
5294	2.09	3.70	10.60
5296	2.54	4.60	15.20
5297	2.79	2.70	17.90

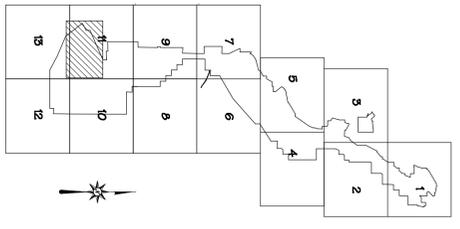

SCALE AS NOTED

**CERTIFICATION STATEMENT**

I, Ron C. Van Valkenburg, hereby certify that this drawing was reviewed by me and that the information shown is complete and accurate to the best of my knowledge.



REVISION	DATE
09-UPDATED SAN DEVELOPMENT AND SUBMITTED TO OSM FOR REVIEW	8/28/09
11-AREA 4 NORTH REVISION RESUBMITTAL TO OSM FOR REVIEW AND APPROVAL	FEB-2011


**bhpbillion**  
**NAVAJO COAL COMPANY**  
**NAVAJO MINE**

PROJECT: 44N  
DATE: AUG. 8, 2009  
DESIGNED BY: RCY  
DRAWN BY: PJFOSTER  
CHECKED BY: RCY  
APPROVED BY: RCY


**PLAN, PROFILE AND SECTION**

**EXHIBIT 26-65**  
**AREA 4 NORTH**  
**POND 407**  
**Design**

DRAWING  
SHEET  
OF 0

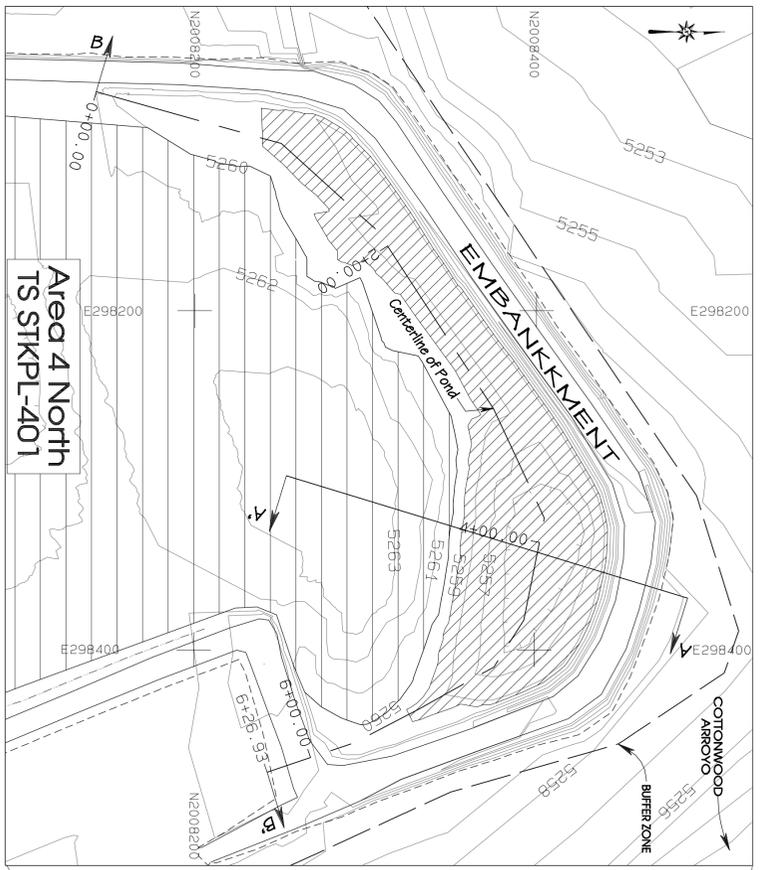

PLAN VIEW  
 COS SCALE 1"=50' FT  
 SCALE 1"=50'

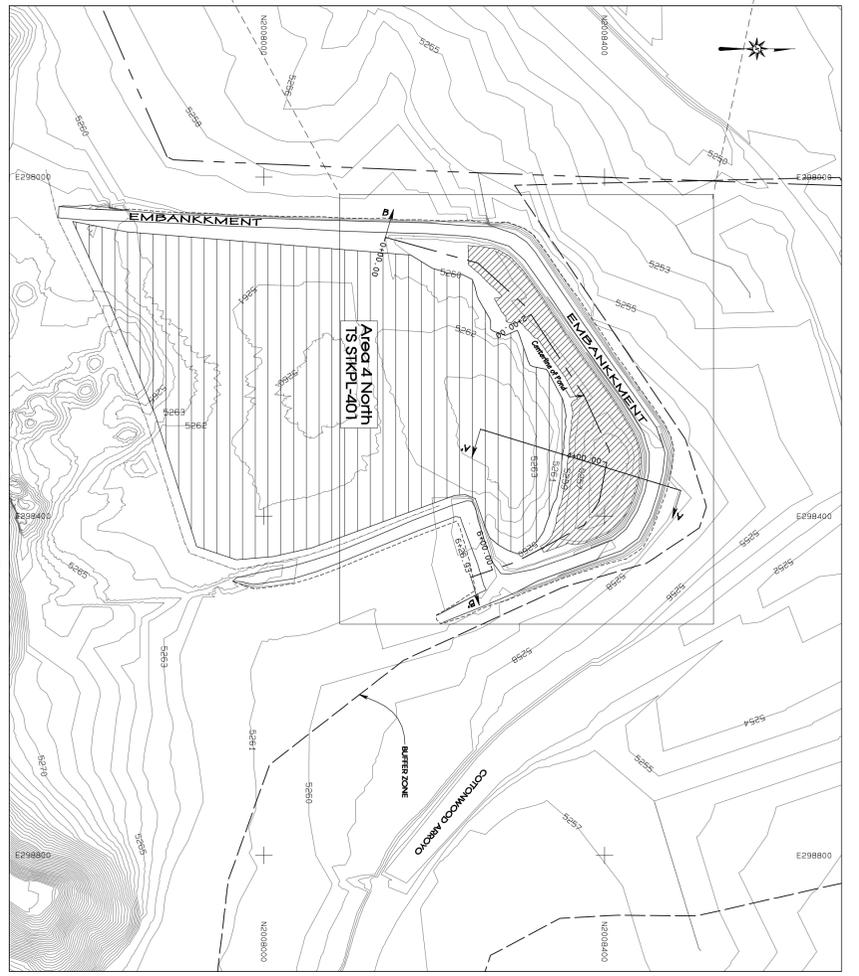

PLAN VIEW  
 SCALE: 1"=100'

**LEGEND**


ROAD	ROAD
MATERIALS	MATERIALS
BUILDING	BUILDING
FENCE	FENCE
IRRIGATION LINE	IRRIGATION LINE
CULVERT	CULVERT
DAM	DAM
DRAINAGE	DRAINAGE
RAILROAD	RAILROAD
TREES	TREES
POWERLINE	POWERLINE
SPOT ELEVATION	SPOT ELEVATION
INDEX CONTOUR	INDEX CONTOUR
INTERMEDIATE CONTOUR	INTERMEDIATE CONTOUR
5300	5300
X 5339.5	X 5339.5
218	218
5422.45	5422.45
L-30	L-30
PERMIT/LEASE BOUNDARY	PERMIT/LEASE BOUNDARY
LEASE CORNER	LEASE CORNER

**NOTES**


1. For location of drainage control structures and waterways, refer to Exhibit 11-13P.
2. The hydrology and supporting design data for the Pond bottom at El. 5295 (Design was El. 5284). Cottonwood Arroyo Design was El. 5299 Ac-Ft). Storage Capacity 1.5 Ac-Ft. (Design was 0.9 Ac-Ft).

**STAGE STORAGE DATA**


ELEV feet	AREA acres	VOLUME ac-ft	CUM. VOLUME ac-ft
5284.8	0.00	0.0	0.0
5285	0.005	0.0	0.0
5285	0.073	0.0	0.0
5287	0.195	0.1	0.2
5288	0.342	0.3	0.4
5289	0.540	0.4	0.9
5280	0.712	0.5	1.5

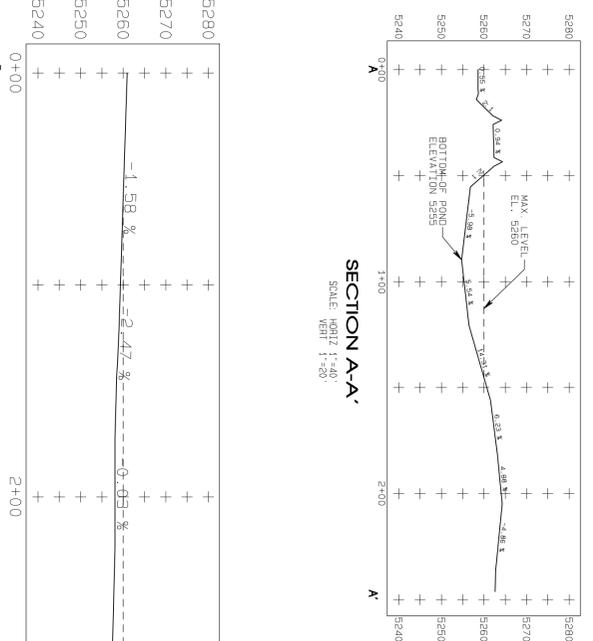

SECTION A-A  
 SCALE: HORIZ 1"=40'  
 VERT 1"=20'

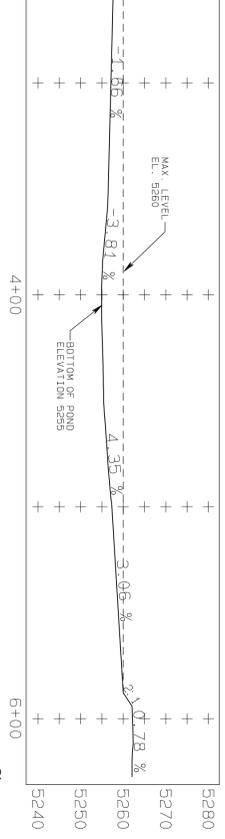

SECTION B-B  
 SCALE: HORIZ 1"=40'  
 VERT 1"=20'

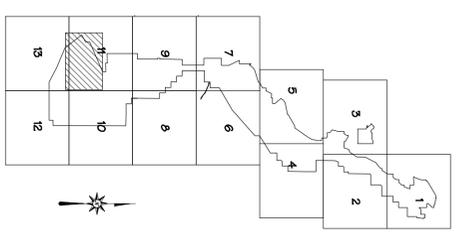

SCALE AS NOTED

**CERTIFICATION STATEMENT**

I, Ron C. VAN VALKENBURG, hereby certify that this Impoundment has been constructed in accordance with the Approved Design Plans except: El. 5284). Cottonwood Arroyo Design was El. 5299 Ac-Ft). Storage Capacity 1.5 Ac-Ft. (Design was 0.9 Ac-Ft).



REVISION	DATE
1	8-28-09
2	12-02-09
11A	1-26-2011



PROJECT MANAGER: FG  
 ENGR. of RECORD: RCV  
 REG. NO. 9293  
 SURV. of RECORD:  
 REG. NO.

**bhpbilliton**  
**BHP NAVAJO COAL CO.**  
**NAVAJO MINE**  
 PO BOX 1717, FRUITLAND, NEW MEXICO, 87416 PHONE: 505-598-3309/FAX: 505-598-3361

ACCOUNT:  
 DATE: Dec. 02, 2009  
 DESIGNED BY: RY  
 DRAWN BY: PJF  
 CHECKED BY: RCV  
 APPROVED BY: RCV

**PLAN, PROFILE AND SECTION**

**EXHIBIT 26-66**  
**Area 4 North Pond 408**  
**As-Built**

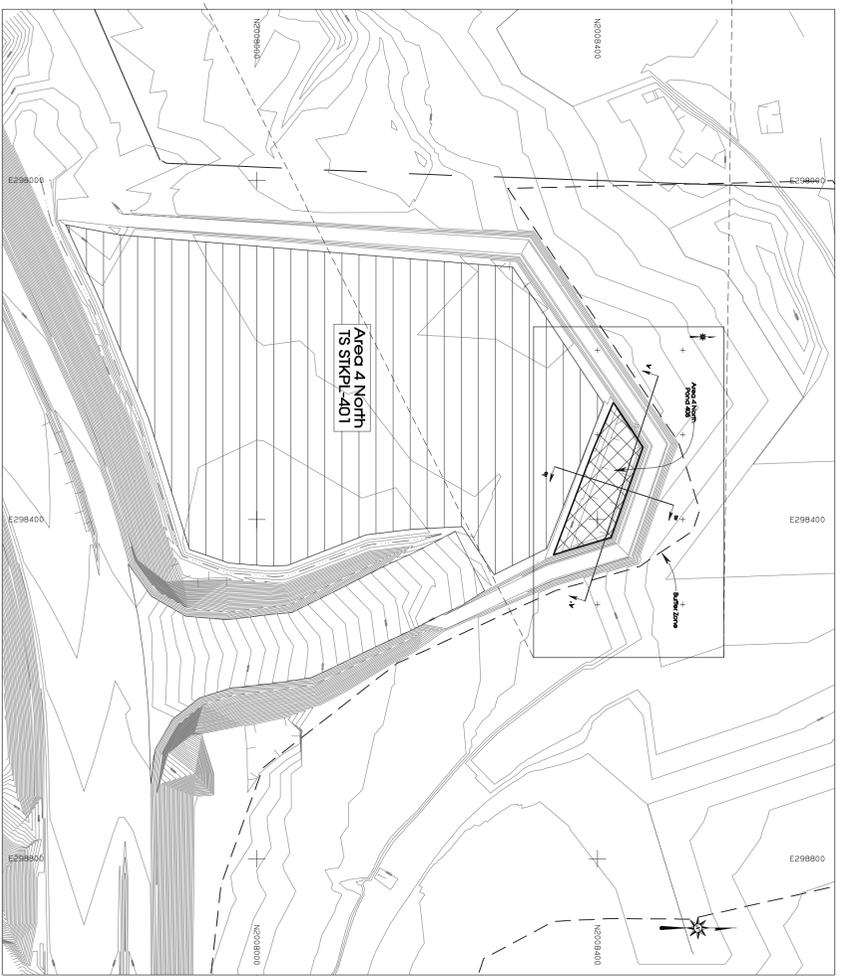
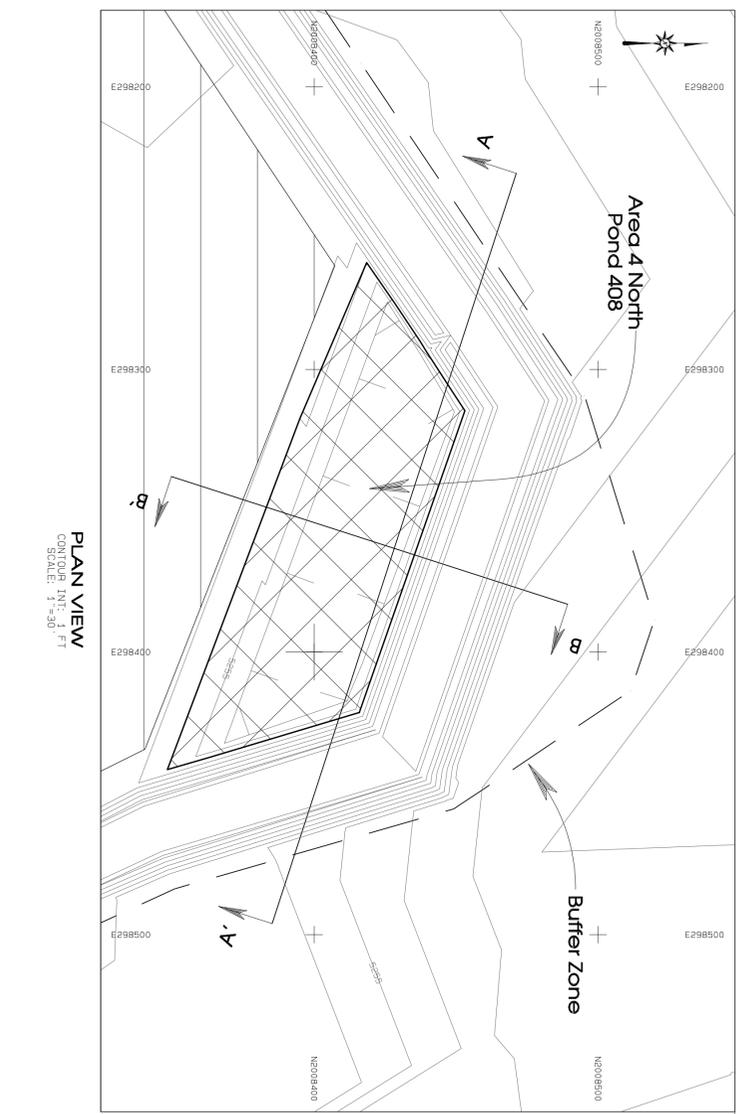


**LEGEND**

- ROAD
- MATERIALS
- BUILDING
- FENCE
- IRRIGATION LINE
- CULVERT
- DAM
- DRAINAGE
- RAILROAD
- TREES
- POWERLINE
- SPOT ELEVATION
- INDEX CONTOUR
- INTERMEDIATE CONTOUR
- 218
- 5298
- 5300
- X 5339.5
- PERMIT/LEASE BOUNDARY
- LEASE CORNER
- PERMIT/LEASE BOUNDARY


**NOTES**

1. For location of drainage control structures and waterheads, refer to Exhibit 11-13F.
2. The hydrology and supporting design data for the Table 11-5 of the NM PAP.

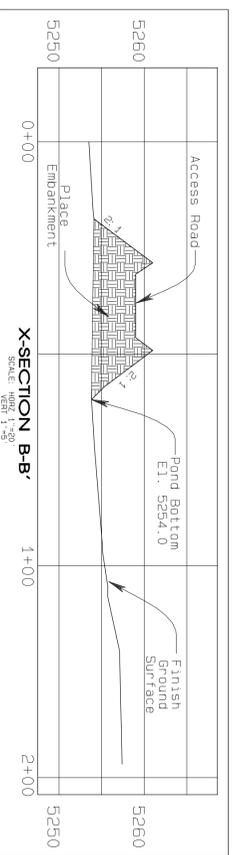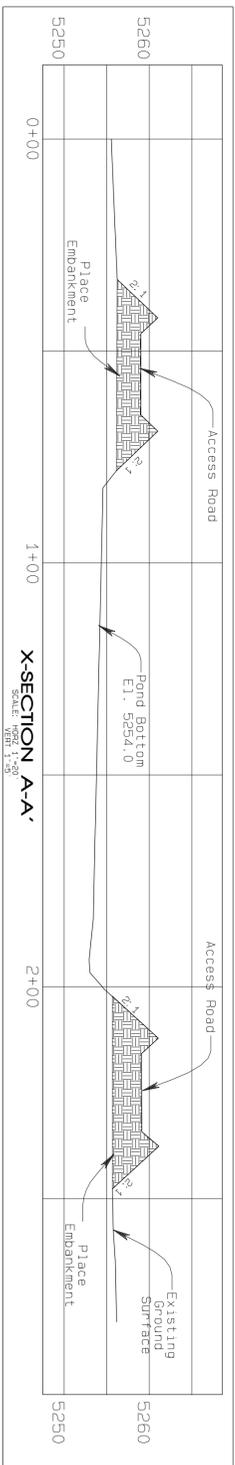

**STAGE STORAGE DATA**

ELEV feet	AREA acres	VOLUME ac-ft	CUM. VOLUME ac-ft
5254	0.11	0.00	0.00
5255	0.15	0.10	0.10
5256	0.19	0.20	0.30
5257	0.24	0.20	0.50

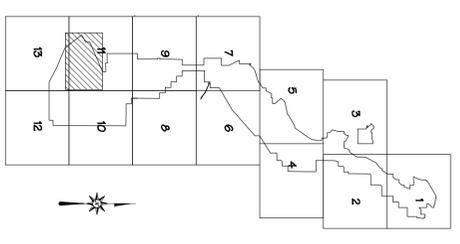

**CERTIFICATION STATEMENT**

I, Ron C. VAN VALKENBURG, hereby certify that this drawing was reviewed by me and that the information shown is complete and accurate to the best of my knowledge.



**EXHIBIT 26-67**  
**Area 4 North**  
**Pond 408**  
**Design**


**PLAN, PROFILE AND SECTION**

ACCOUNT: \_\_\_\_\_  
DATE: AUG. 23, 2009  
DESIGNED BY: RY  
DRAWN BY: P.J.F.  
CHECKED BY: RCV  
APPROVED BY: RCV


**bhpbilliton**  
**BHP NAVAJO COAL CO.**  
**NAVAJO MINE**

PROJECT MANAGER: FG  
ENGR. of RECORD: RCV  
REG. NO.: 9293  
SRVR of RECORD: \_\_\_\_\_  
REG. NO.: \_\_\_\_\_


REVISION	DATE
1 SUBMITTED TO OSM FOR APPROVAL	B-28-09
11-A AREA 4 NORTH REVISION RESUBMITTAL TO OSM FOR REVIEW AND APPROVAL	FEB-2011

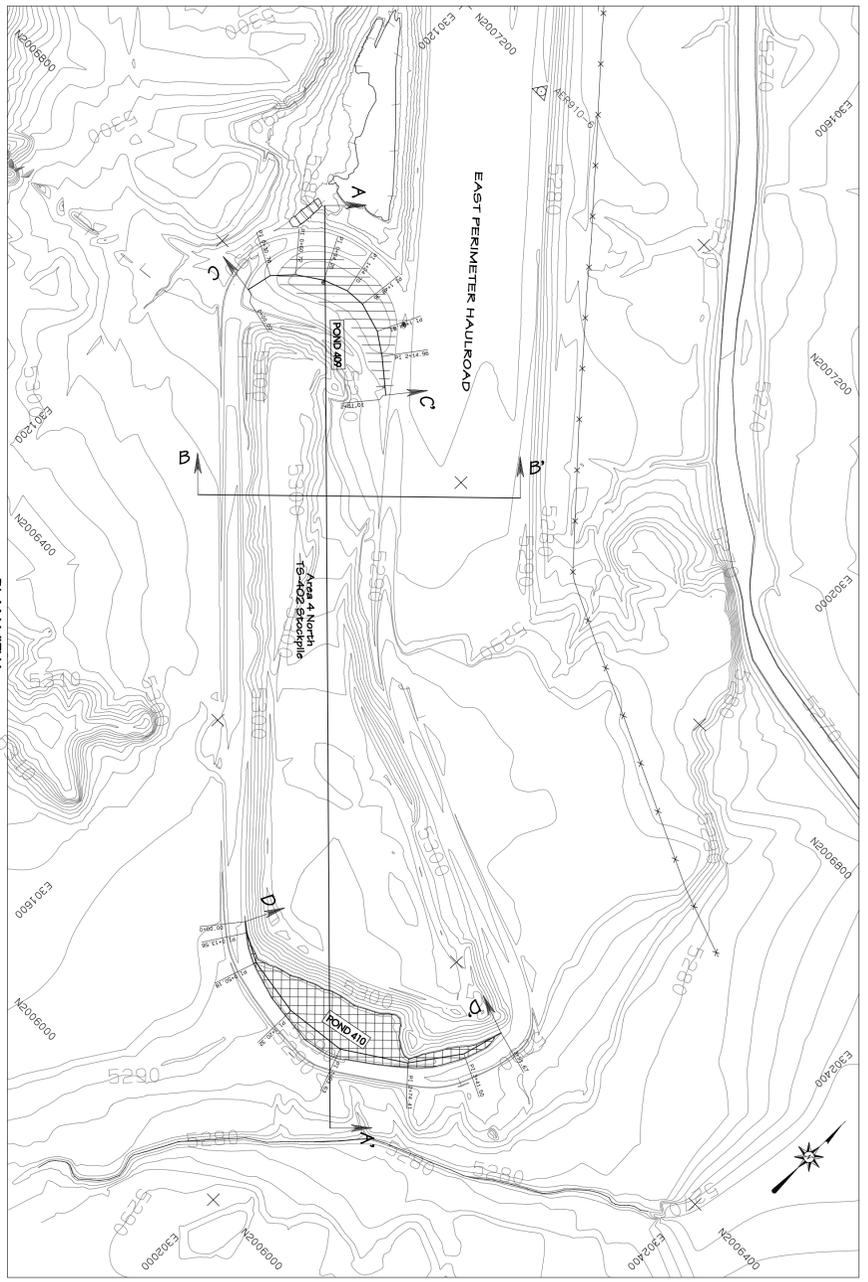


PLAN VIEW  
SCALE HORIZ: 1"=100'  
VERTICAL INTERVAL: 2 FT.

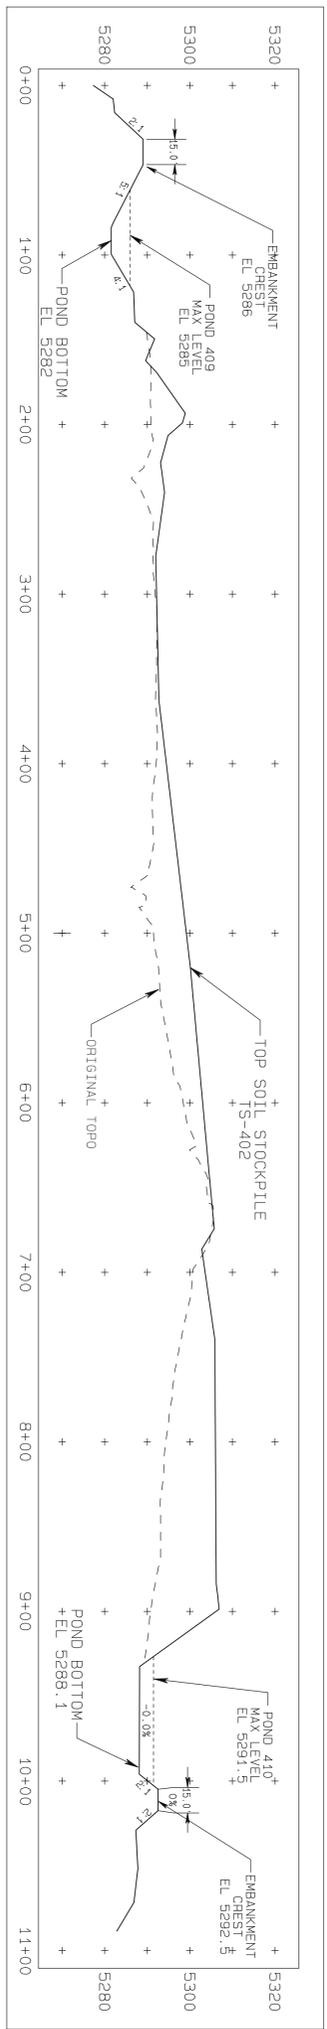


SECTION A-A'  
SCALE HORIZ: 1"=50'  
VERT: 1"=50'

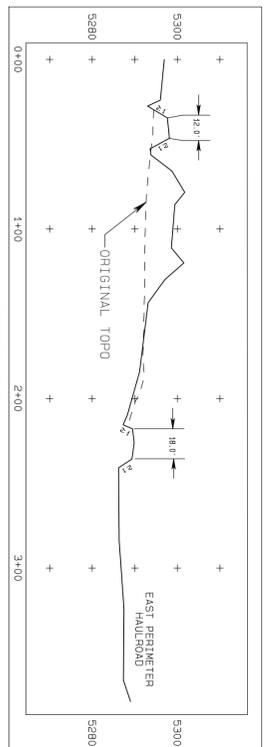

SECTION B-B'  
SCALE HORIZ: 1"=50'  
VERT: 1"=50'

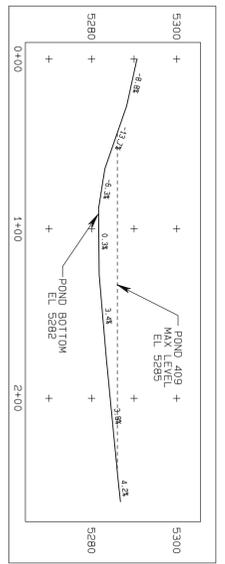

SECTION C-C'  
SCALE HORIZ: 1"=50'  
VERT: 1"=50'

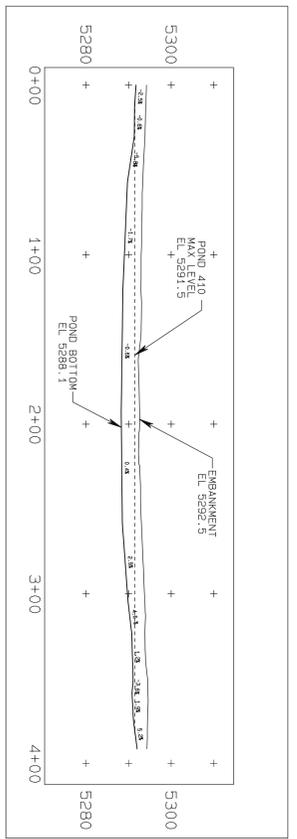

SECTION D-D'  
SCALE HORIZ: 1"=50'  
VERT: 1"=50'

**STAGE STORAGE DATA  
A4 NORTH POND-410**

ELEV feet	AREA acres	VOLUME ac-ft	CUM. VOLUME ac-ft	VOLUME ac-ft
5288.1	0.00	0.0	0.00	0.00
5289.1	0.12	0.1	0.09	0.09
5290	0.21	0.2	0.21	0.21
5291	0.25	0.2	0.44	0.44
5292	0.29	0.3	0.71	0.71
5293	0.33	0.3	1.02	1.02

Crest Elevation 5292.5  
Capacity @ Crest E1. (Ac-Ft.) 5292.5  
Max. Water Elevation 5291.5  
Capacity @ Max. Water Level (Ac-Ft.) 0.9


**STAGE STORAGE DATA  
A4 NORTH POND-409**

ELEV feet	AREA acres	VOLUME ac-ft	CUM. VOLUME ac-ft	VOLUME ac-ft
5286	0.02	0.0	0.01	0.01
5283	0.06	0.0	0.05	0.05
5284	0.10	0.1	0.13	0.13
5285	0.15	0.1	0.25	0.25
5286	0.22	0.2	0.44	0.44

Crest Elevation 5286.0  
Capacity @ Crest E1. (Ac-Ft.) 5286.0  
Max. Water Elevation 5285.0  
Capacity @ Max. Water Level (Ac-Ft.) 0.26

- NOTES**
- For location of drainage control structures and waterways, refer to Exhibit 11-13F.
  - The hydrology and supporting design data for the Table 91-5 the New Map.

REVISION	DATE
1	SUBMITTED TO OSM FOR APPROVAL 12/12/04
2	SUBMITTED TO OSM FOR APPROVAL 08/31/09
3	PREPARED AS-BUILT SUBMITTED TO OSM FOR REVIEW 12/03/09
4	UPDATED AS-BUILT SUBMITTED TO OSM FOR REVIEW 8-11-10
5	UPDATED AS-BUILT FOR A4N POND 410 SUBMITTED TO OSM FOR REVIEW (NOT SUBMITTED) 11-02-10
5A	SUBMITTED TO OSM FOR REVIEW AND APPROVAL 1-26-2011

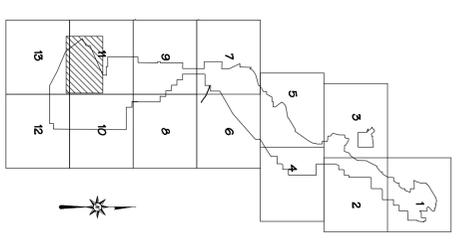

SCALE AS NOTED

**CERTIFICATION STATEMENT**

I, Ron C. VAN VALKENBURG, hereby certify that this impoundment has been constructed in accordance with the approved design plans except: design was 0.2 Ac-Ft. Pond 410 Capacity 0.9 Ac-Ft. (design was 0.4 Ac-Ft.)



**EXHIBIT 26-68  
Area 4 North  
Pond 409 AND 410  
As-Built**


**PLAN, PROFILE AND  
SECTION**

ACCOUNT: Dec. 03, 2009  
DESIGNED BY: RV  
DRAWN BY: P.J. Foster  
CHECKED BY: RCV  
APPROVED BY: RCV



PROJECT MANAGER: FG  
ENGR. of RECORD: RCV  
REG. NO: 6600  
SRVR. of RECORD: RCV  
REG. NO:

SHEET 1  
OF 1

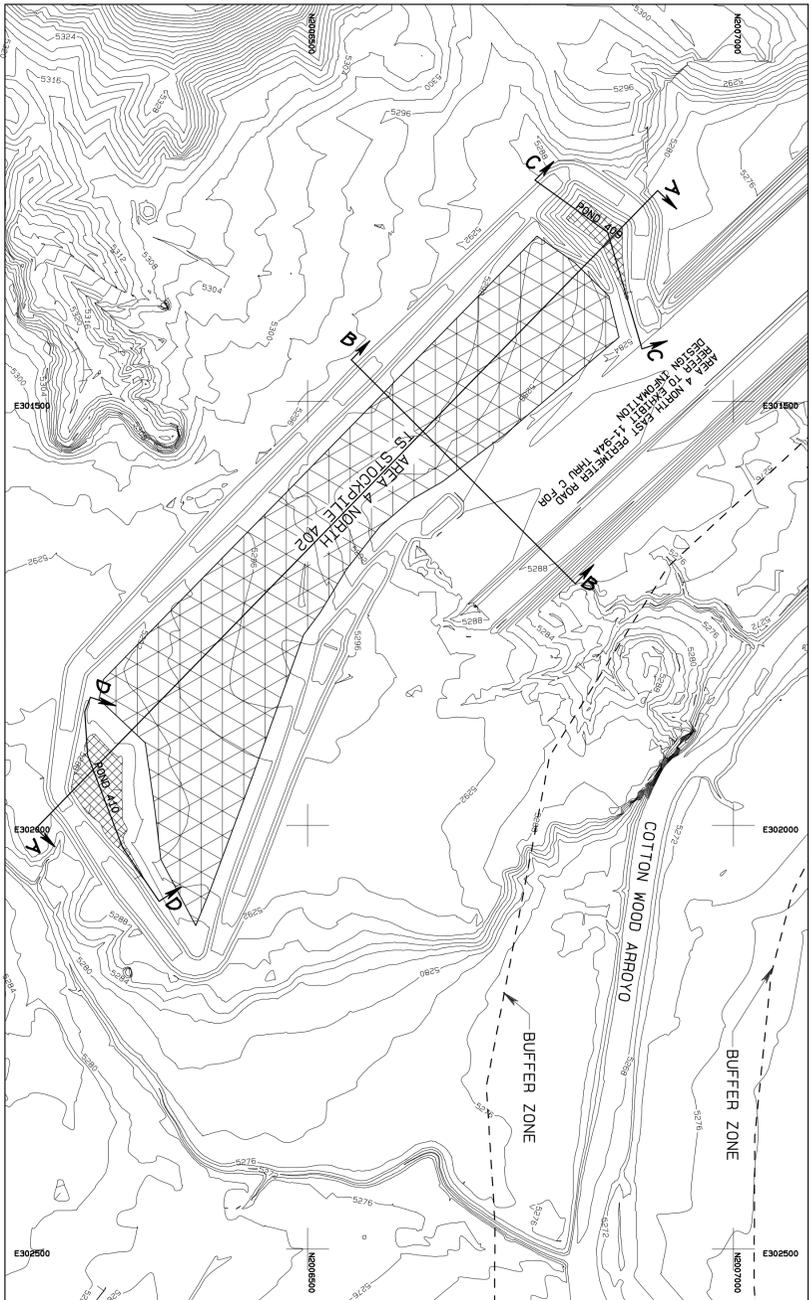


**LEGEND**


- ROAD
- WATERSHED
- BUILDING
- FENCE
- IRRIGATION LINE
- CULVERT
- DAM
- DRAINAGE
- RAILROAD
- TREES
- POWERLINE
- SPOT ELEVATION
- INDEX CONTOUR
- INTERMEDIATE CONTOUR
- LEASE CORNER
- PERMIT/LEASE BOUNDARY

**NOTES**

1. For location of drainage control structures and waterfalls, refer to Exhibit 11-33B for the final design and construction details.
2. The proposed and existing structures are defined on Table 11-5 the NM PAP.

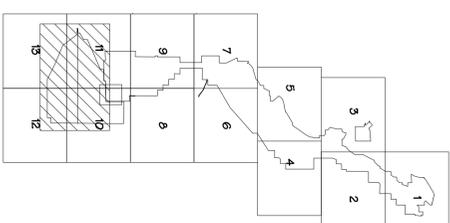

SCALE AS NOTED

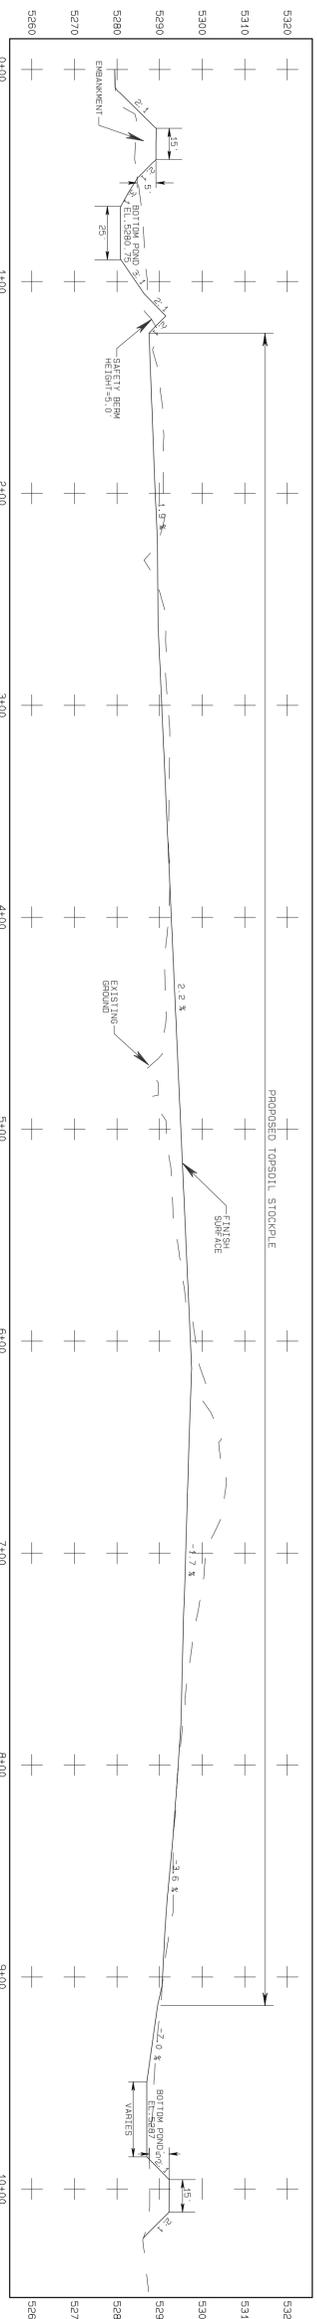




**STAGE STORAGE DATA FOR POND 409**

ELEV. feet	AREA acres	VOLUME ac-ft	CUM. VOLUME ac-ft
5280	7.5	0.0	0.00
5281	0.04	0.0	0.0
5282	0.06	0.1	0.5
5283	0.08	0.1	0.13
5284	0.13	0.1	0.23



**STAGE STORAGE DATA FOR POND 410**

ELEV. feet	AREA acres	VOLUME ac-ft	CUM. VOLUME ac-ft
5287	0.0	0.0	0.00
5288	0.12	0.1	0.1
5289	0.17	0.1	0.2
5290	0.26	0.2	0.4

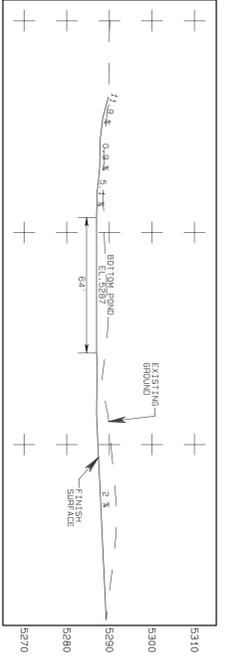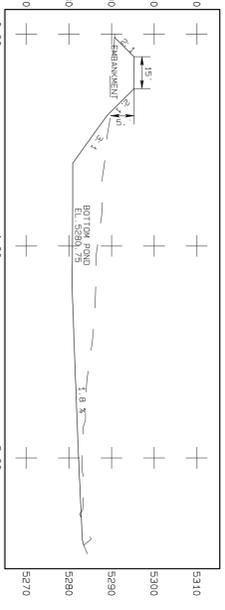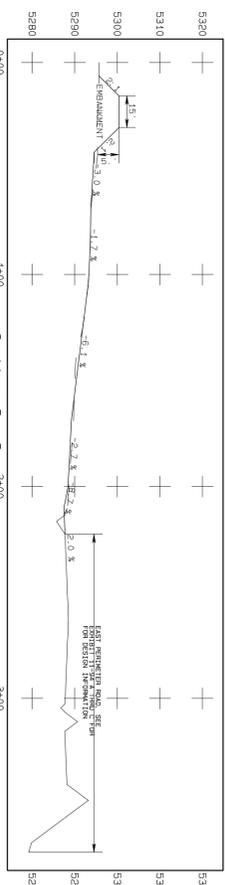

**CERTIFICATION STATEMENT**

I, Leonard Raymond, hereby certify that this drawing was reviewed by me and that the information shown is complete and accurate to the best of my knowledge.



**EXHIBIT 26-69**  
AREA 4 NORTH  
POND 409 AND 410  
Design


**PLAN, PROFILE AND SECTIONS**

ACCOUNT: \_\_\_\_\_  
DATE: AUGUST 28, 2009  
DESIGNED BY: RCV  
DRAWN BY: RY  
CHECKED BY: RCV  
APPROVED BY: RCV


**bhpbilliton**  
**BHP NAVAJO COAL CO.**  
**NAVAJO MINE**  
PO BOX 1717, MULLLAND, NEW MEXICO, 87416. PHONE: 505-598-3269/FAX: 505-598-3361

PROJECT MANAGER: FG  
ENGR. OF RECORD: RCV  
REG. NO: 9263  
SAVVA OF RECORD:  
REG. NO:


REVISION	DATE
1	08/28/09
2	
3	
4	
5	

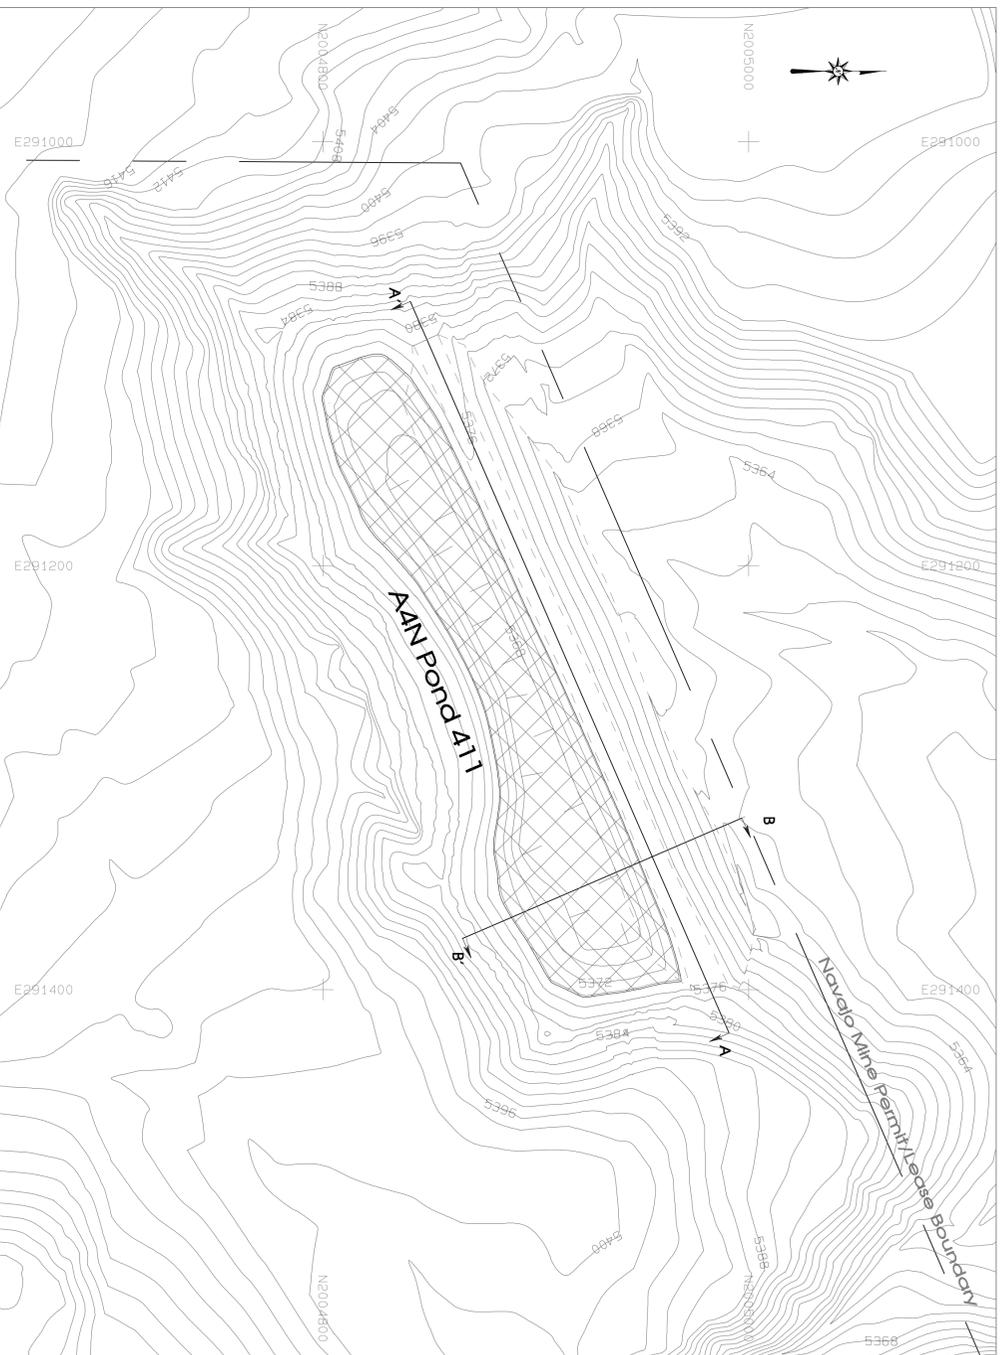

PLAN VIEW  
1" = 40'

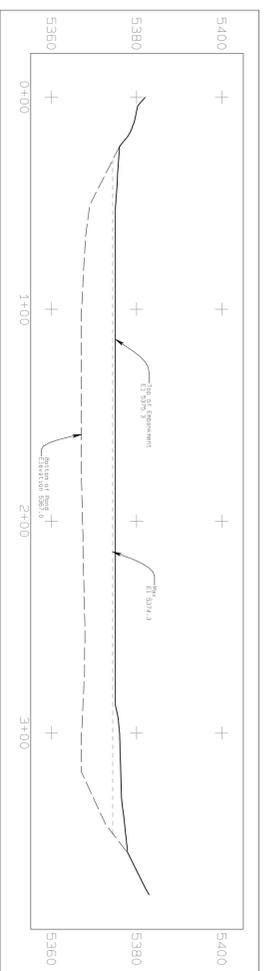

CROSS SECTION A - A'  
SCALE - H = 1" = 40'  
V = 1" = 20'

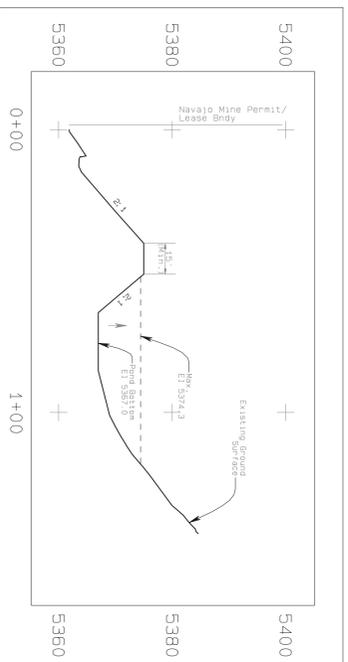


CROSS SECTION B - B'  
SCALE - H = 1" = 30'  
V = 1" = 15'

LEGEND

- ROAD
- WATERSHED
- BUILDING
- FENCE
- IRRIGATION LINE
- CULVERT
- DAM
- DRAINAGE
- RAILROAD
- TREES
- POWER LINE
- X 5338.15 SPOT ELEVATION
- 5300 INDEX CONTOUR
- 5298 INTERMEDIATE CONTOUR
- 218 LEASE CORNER
- 5422.45
- L-30 PERMIT/LEASE BOUNDARY

NOTES

1. For hydrology and design information refer to Appendix 11-1A in the approved P&E.
1. Refer to Exhibit 11-1B for watershed information and location of ponds.

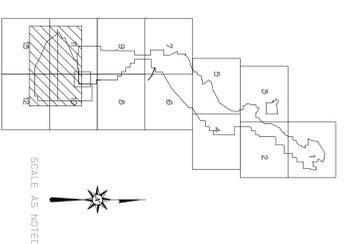

STAGE STORAGE DATA

ELEV. feet	AREA ac-ft	VOLUME ac-ft	CUM. VOLUME ac-ft
5367	0.05	0.0	0.00
5368	0.13	0.1	0.09
5369	0.18	0.2	0.25
5370	0.21	0.2	0.44
5371	0.25	0.2	0.67
5372	0.28	0.3	0.93
5373	0.32	0.3	1.23
5374	0.35	0.3	1.57
5375	0.39	0.4	1.94
5376	0.43	0.4	2.35

Pond Crest/Spillway Elevation: 5375.3  
 As-Built Volume of Pond: 2.35 ac-ft  
 Capacity @ Max. Water Elevation: 5372.3  
 Required Volume (100 yr. 6 hr.): (Ac-ft) 1.2

CERTIFICATION STATEMENT

I, Ron C. VAN VALKENBURG, hereby certify that this structure has been constructed in accordance with the approved plans and specifications and that the same are shown to be complete and accurate to the best of my knowledge, except as noted below:  
 1. Only minor elevation differences for pond bottom and embankment crest.



EXHIBIT 26-70  
AREA 4 NORTH  
POND 411  
As-Built


PLAN, PROFILE AND SECTIONS

ACCOUNT: \_\_\_\_\_  
 DATE: AUGUST 31, 2009  
 DESIGNED BY: RCV  
 DRAWN BY: RCV  
 CHECKED BY: RCV  
 APPROVED BY: RCV


**bhpbilliton**  
 BHP NAVAJO COAL CO.  
 NAVAJO MINE  
 P.O. BOX 1717, FRUITLAND, NEW MEXICO 87416 PHONE 505-598-3200/FAX 505-598-3361

PROJECT MANAGER: FG  
 ENGR. of RECORD: RCV  
 REG. NO: 8803  
 SRVA of RECORD:  
 REG. NO:


REVISION	DATE
1 PREPARED FOR SUBMITTAL TO GDM	1-28-10
2 PREPARED AS-BUILT FOR LAW POND-411 AND SUBMITTED TO GDM FOR REVIEW	7-28-10
3	
4	

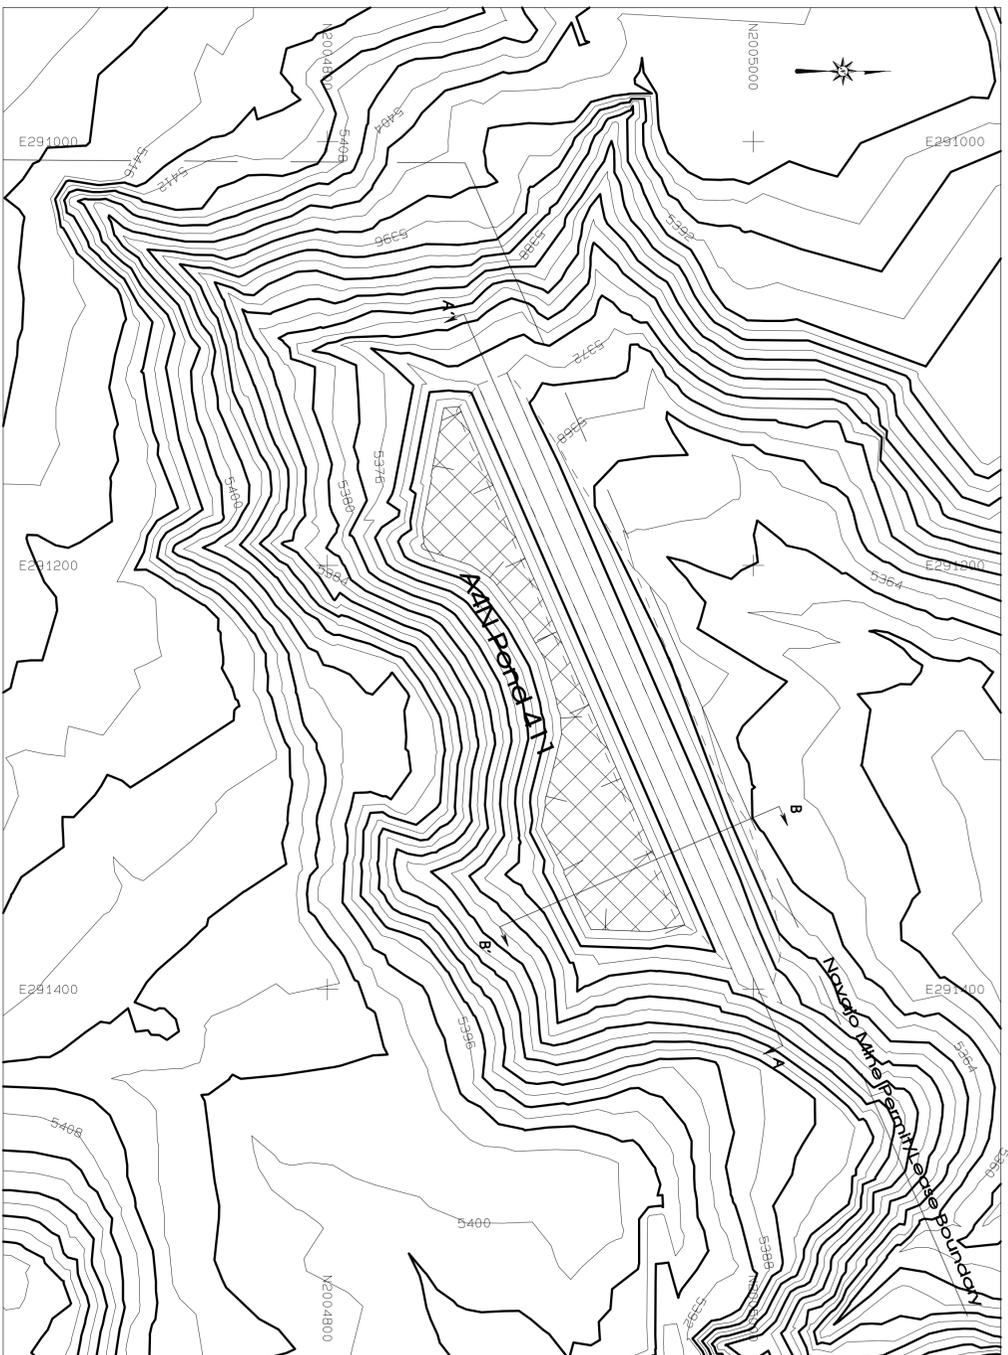

PLAN VIEW  
1" = 40'

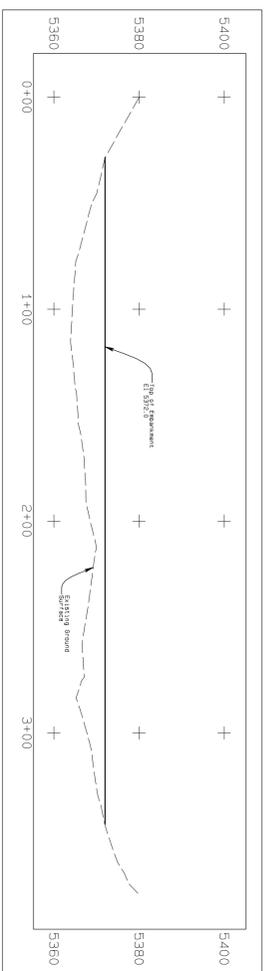

GROSS SECTION A-A  
SCALE - H - 1" = 40'  
V - 1" = 20'

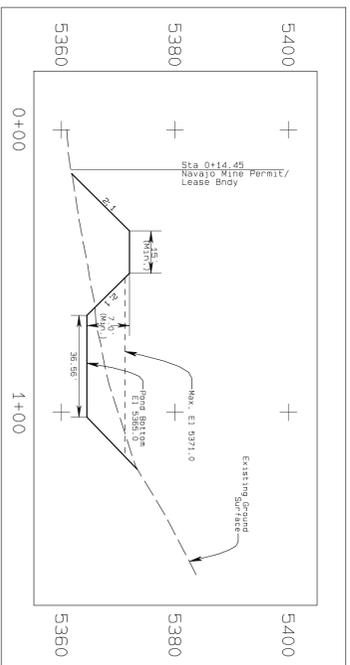


GROSS SECTION B-B  
SCALE - H - 1" = 40'  
V - 1" = 20'

LEGEND

- ROAD
- WATERSHED
- BUILDING
- FENCE
- IRRIGATION LINE
- CULVERT
- DAM
- DRAINAGE
- RAILROAD
- TREES
- POWERLINE
- SPOT ELEVATION
- INDEX CONTOUR
- INTERMEDIATE CONTOUR
- PERMIT/LEASE BOUNDARY

NOTES

1. For hydrology and design information refer to Appendix 11.4 of the approved map.
1. Information and location of ponds.

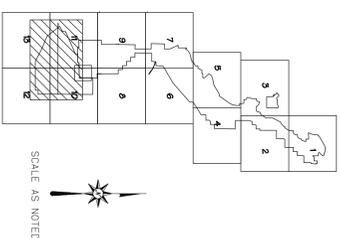

SCALE AS NOTED

STAGE STORAGE DATA

ELEV feet	AREA acres	VOLUME ac-ft	CUM. VOLUME ac-ft
5365	0.13	0.0	0.0
5366	0.162	0.1	0.1
5368	0.217	0.4	0.5
5370	0.276	1.5	1.0
5372	0.344	0.6	1.6

CERTIFICATION STATEMENT

I, Ron C. VAN VALKENBURG, hereby certify that this drawing was reviewed by me and that the information shown is complete and accurate to the best of my knowledge.



REVISION	DATE
11	PREPARED FOR SUBMITTAL TO DSM
12	
13	
14	
15	

PROJECT MANAGER: FG  
ENGR. of RECORD: RCV  
REG. NO: 8868  
SRVR of RECORD:  
REG. NO:


**bhpbilliton**  
**BHP NAVAJO COAL CO.**  
**NAVAJO MINE**  
PO BOX 1717, FRUITLAND, NEW MEXICO, 87416 PHONE: 505-598-3209/FAX 505-598-3361

ACCOUNT:  
DATE: AUGUST 31, 2009  
DESIGNED BY: REV  
DRAWN BY: RY  
CHECKED BY: REV  
APPROVED BY: RCV

PLAN, PROFILE AND SECTIONS

EXHIBIT 26-71  
AREA 4 NORTH  
POND 411  
Design

DRWING  
SHEET 1  
1

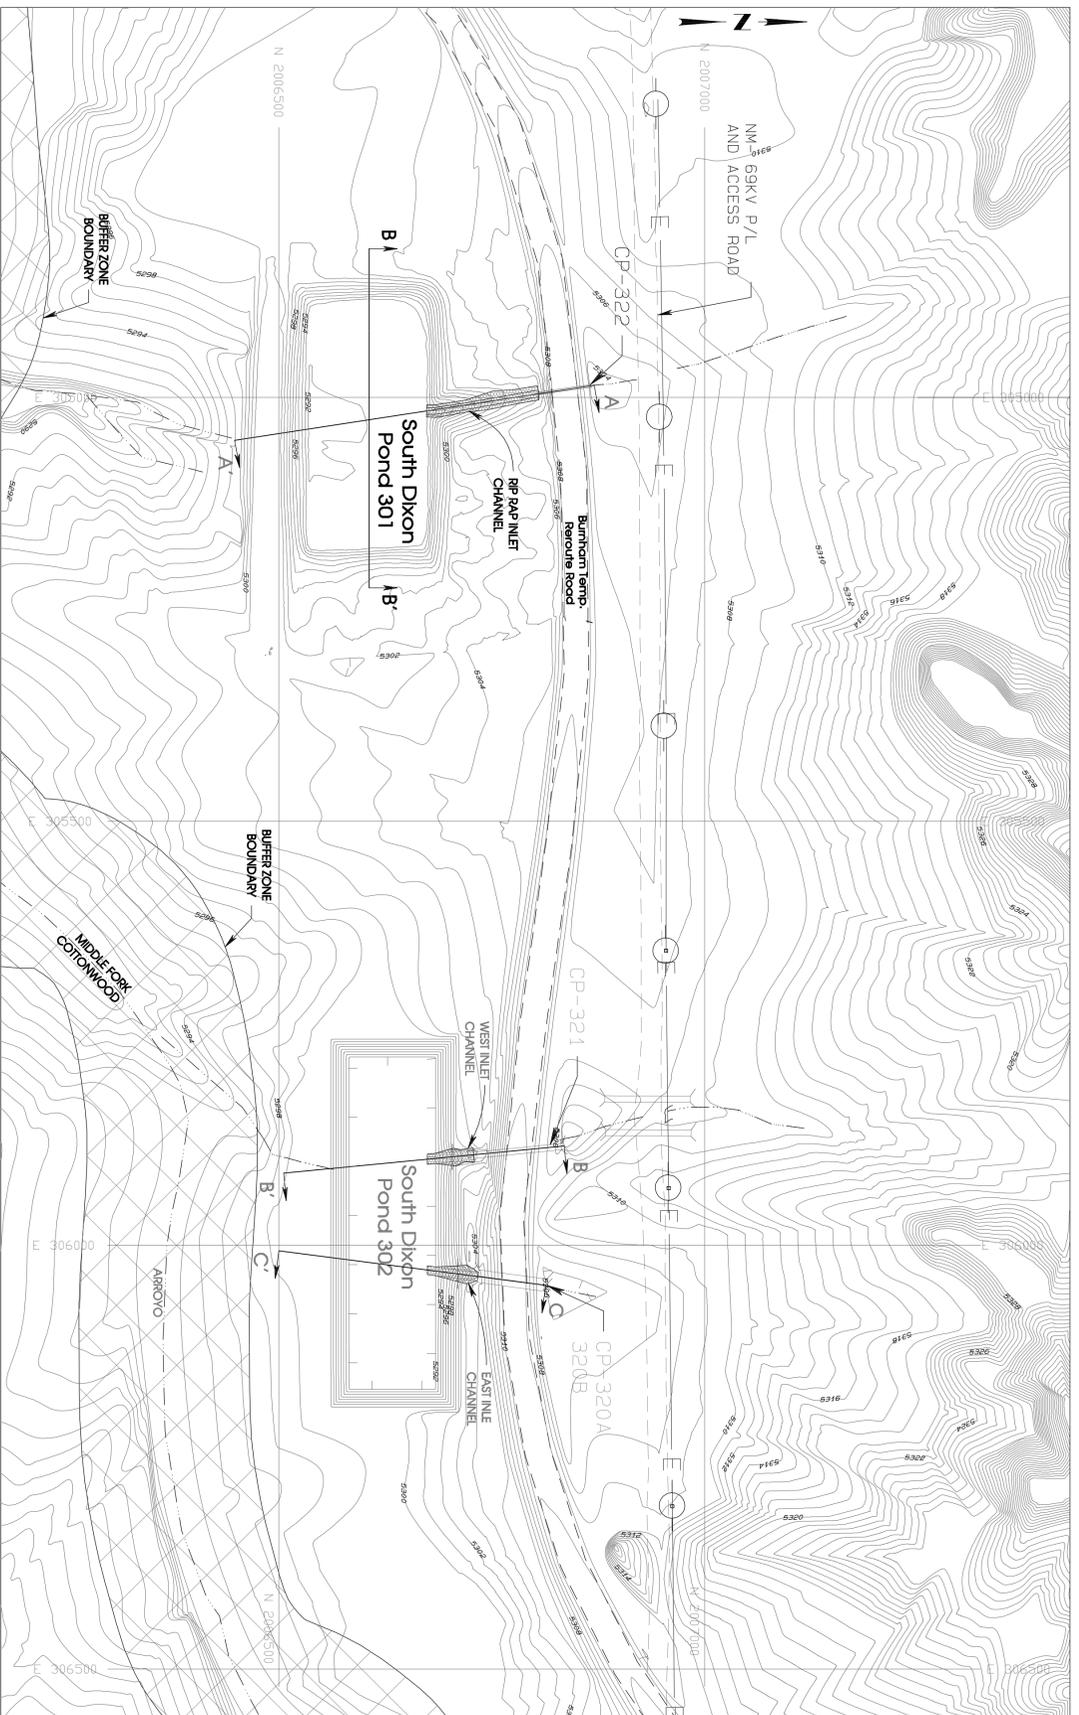


PLAN VIEW  
SCALE: 1" = 100'

**SOUTH DIXON POND 301  
STAGE STORAGE DATA**





ELEV feet	AREA acres	VOLUME ac-ft	CUM. VOLUME ac-ft
5292	0.11	0.00	0.00
5293	0.94	0.53	0.53
5294	1.01	0.98	1.50
5295	1.08	1.05	2.55
5296	1.15	1.12	3.67
5297	1.23	1.19	4.86
5298	1.32	1.28	6.13
5299	1.44	1.38	7.52
5300	1.54	1.54	9.05

**SOUTH DIXON POND 302  
STAGE STORAGE DATA**


ELEV feet	AREA acres	VOLUME ac-ft	CUM. VOLUME ac-ft
5292	0.92	0.0	0.0
5293	0.99	1.0	1.0
5294	1.06	1.0	2.0
5295	1.13	1.1	3.1
5296	1.20	1.2	4.2
5297	1.28	1.2	5.5
5298	1.35	1.3	6.8
5299	1.44	1.4	8.2
5300	1.52	1.5	9.7

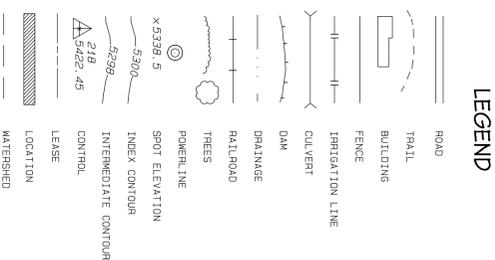


- NOTES**
- For hydrology and design information refer to Table 11-5 in the approved PAP.
  - The watershed areas for culverts are shown on Exhibit 11-13E.

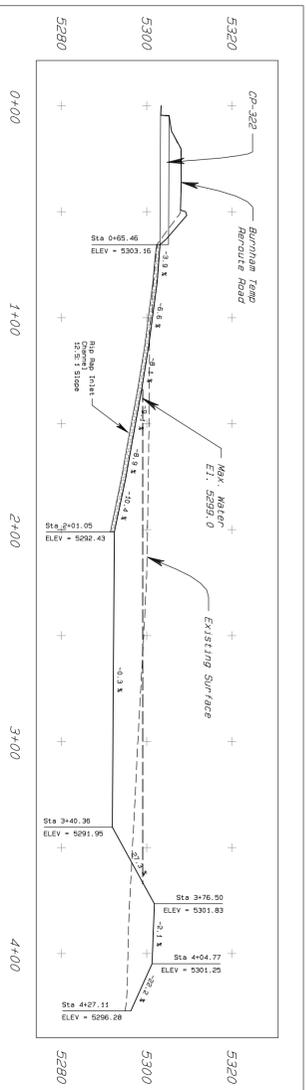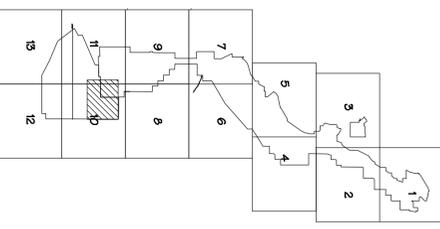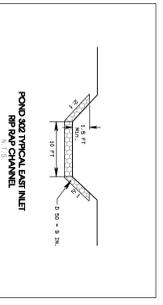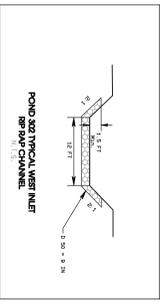


POND 301  
PROFILE VIEW A-A'  
SCALE: H 1" = 40'  
V 1" = 20'

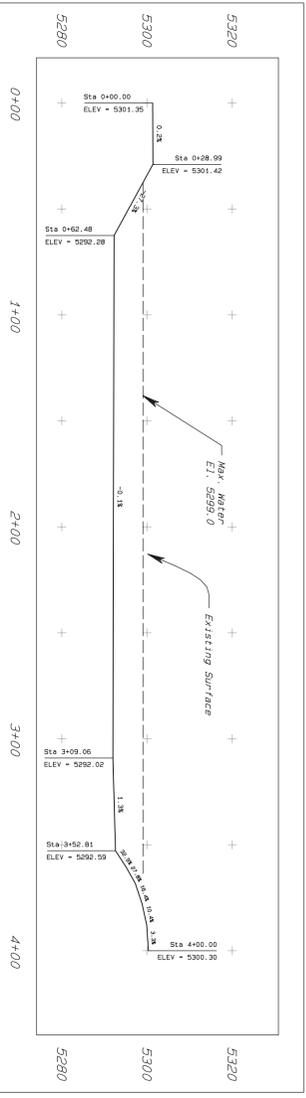

POND 301  
PROFILE VIEW B-B'  
SCALE: H 1" = 40'  
V 1" = 20'

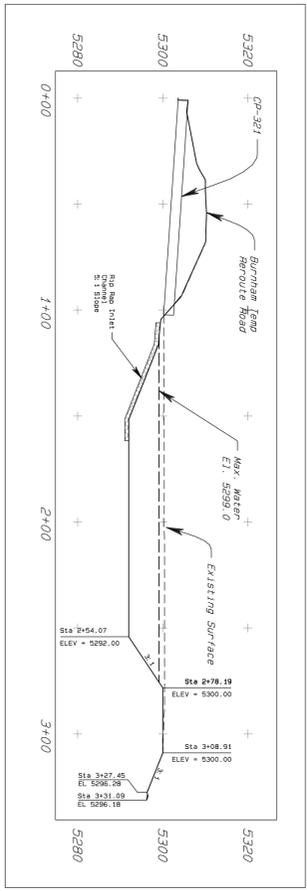

PROFILE VIEW B-B'  
SCALE: H 1" = 40'  
V 1" = 20'

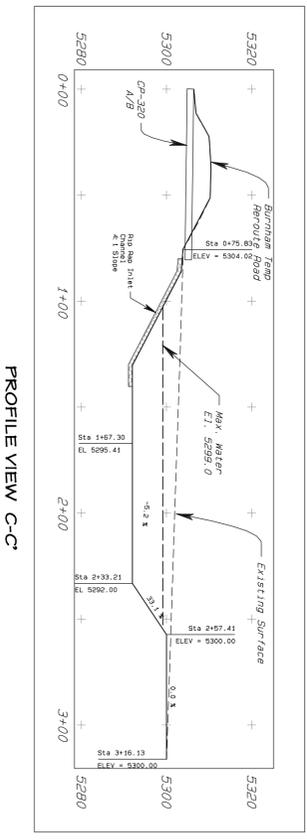

PROFILE VIEW C-C'  
SCALE: H 1" = 40'  
V 1" = 20'

**CERTIFICATION STATEMENT**

I, Leonard Raymond, hereby certify that this pond (Pond 301) has been constructed in accordance with the approved design plans and that the information shown is complete and accurate to the best of my knowledge, except as noted below.



- Only the construction of Pond 301 has been completed to date. Pond 302 will be built at a later date. When the construction of Pond 302 is completed this drawing will be updated. The bottom width of the inlet channel into Pond 301 varies from 8 feet to 14 feet. The RP PAP channel section and steepest slope will be stable for the 10 year storm event. The SEDCAD data in the PAP has been revised accordingly.

**EXHIBIT 26-72**  
**SOUTH DIXON**  
**PONDS 301 (AS-BUILT) AND**  
**302 (APPROVED DESIGN)**


**LOCATION MAP/  
PLAN/PROFILE VIEW  
AND SECTIONS**

PROJECT: South Dixon Ponds-301/302  
DATE: FEB. 16, 2010  
DESIGNED BY: F.Gorman  
DRAWN BY: R.Foster  
CHECKED BY: RCV  
APPROVED BY: RCV


**BHP-NAVAJO COAL CO.**  
PO BOX 155, FRUITLAND, NEW MEXICO, 87416

REVISION	DATE
1	3-03-10
2	11-29-10
3	
4	


PROJECT MANAGER: F. GORMAN  
ENGR. OF RECORD: RON VAN VALKENBURG  
REG. NO. 9683  
SURVYR OF RECORD: REG. NO.

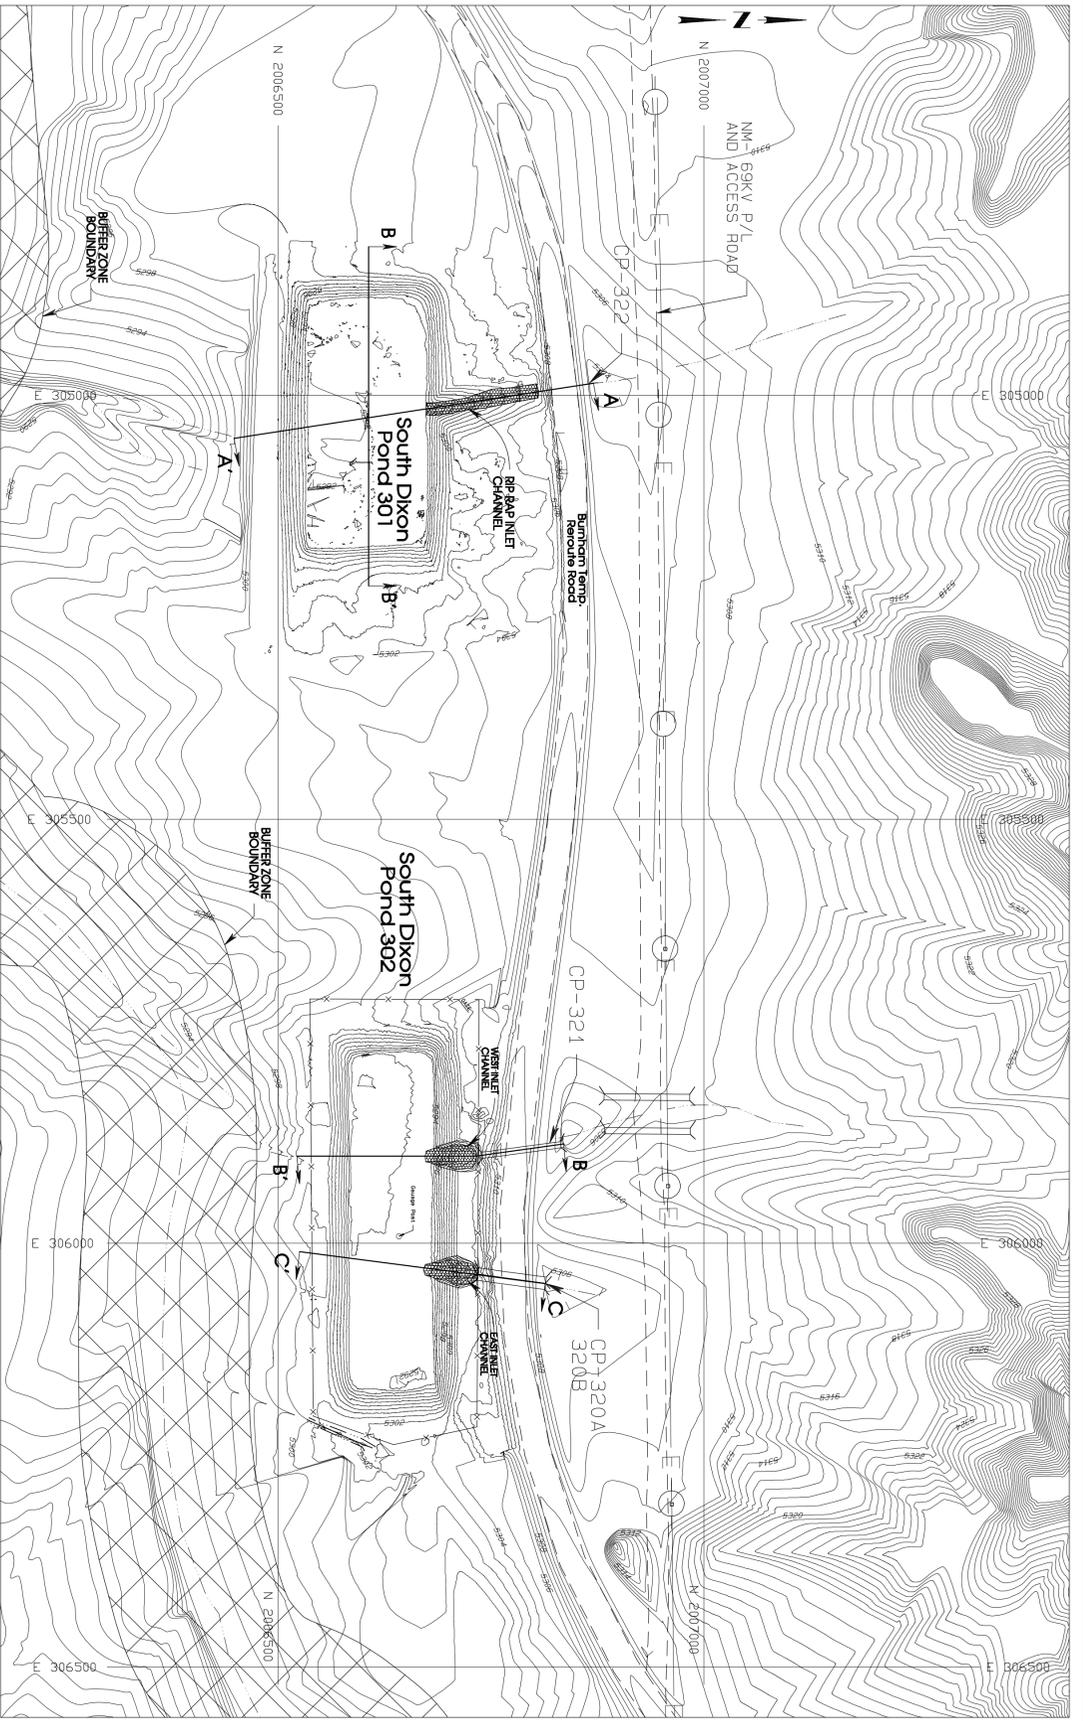


PLAN VIEW  
SCALE: 1"=100'

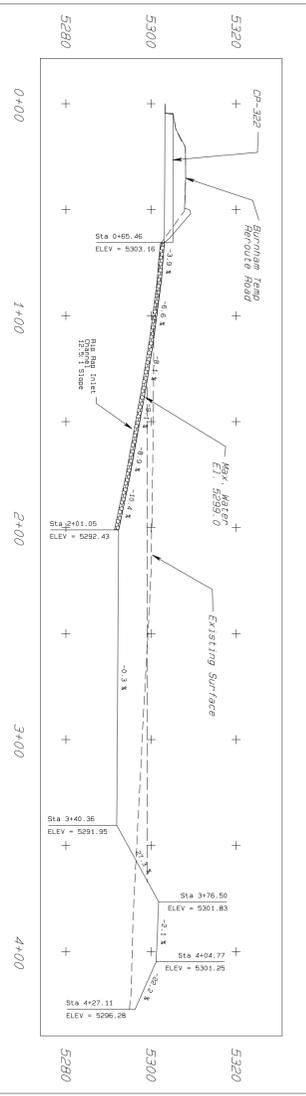


POND 301  
PROFILE VIEW A-A'  
SCALE: H 1"=40'  
V 1"=20'

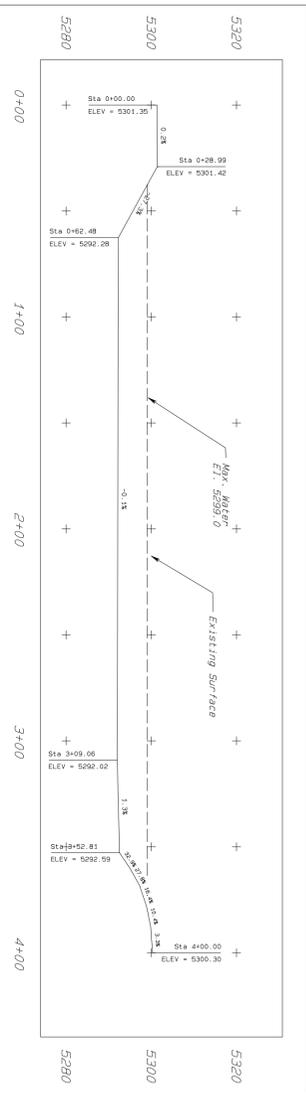

POND 301  
PROFILE VIEW B-B'  
SCALE: H 1"=40'  
V 1"=20'

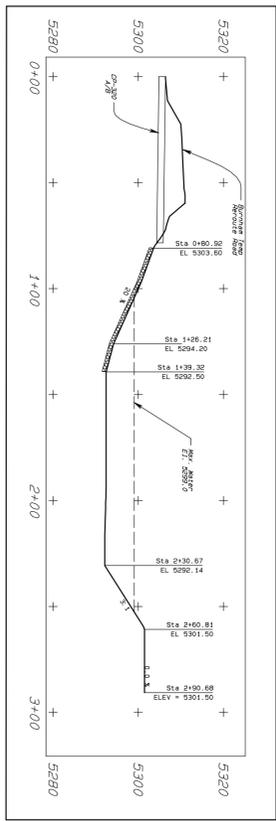

POND 302 - PROFILE VIEW B-B'  
SCALE: H 1"=40'  
V 1"=20'

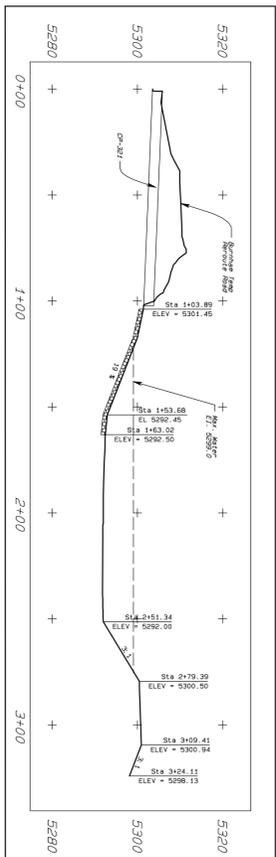

POND 302 - PROFILE VIEW C-C'  
SCALE: H 1"=40'  
V 1"=20'

**SOUTH DIXON POND 301  
STAGE STORAGE DATA**

ELEV feet	AREA acres	VOLUME ac-ft	CUM. VOLUME ac-ft
5292	0.11	0.00	0.00
5293	0.94	0.53	0.53
5294	1.01	0.98	1.50
5295	1.08	1.05	2.55
5296	1.15	1.12	3.67
5297	1.23	1.19	4.86
5298	1.32	1.28	6.13
5299	1.44	1.38	7.52
5300	1.64	1.54	9.05

**SOUTH DIXON POND 302  
STAGE STORAGE DATA**




ELEV feet	AREA acres	VOLUME ac-ft	CUM. VOLUME ac-ft
5291	0.00	0.0	0.0
5292	0.28	0.14	0.14
5293	0.90	0.59	0.73
5294	0.96	1.93	1.66
5295	1.02	0.98	2.65
5296	1.09	1.06	3.71
5297	1.17	1.13	4.84
5298	1.26	1.21	6.05
5299	1.35	1.30	7.35
5300	1.44	1.39	8.75

**LEGEND**

- ROAD
- TRAIL
- BUILDINGS
- FENCE
- IRRIGATION LINE
- CULVERT
- DAW
- DRAINAGE
- FALLOUT
- TREES
- PANEL LINE
- SPOT ELEVATION
- INDEX CONTOUR
- INTERMEDIATE CONTOUR
- CONTROL
- LEASE
- LOCATION
- MATERIAL

**NOTES**

- For hydrology and design information refer to Table 11-5 in the approved PAP.
- The watershed areas for the ponds are shown on Exhibit 11-13E.

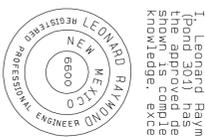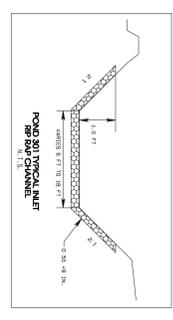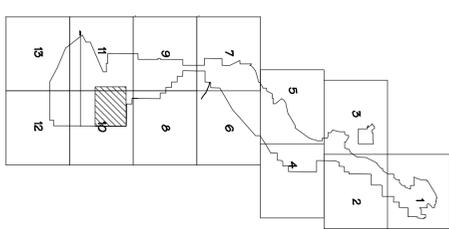

**CERTIFICATION STATEMENT**  
I, Leonard Raymond, hereby certify that this pond (Pond 301) has been constructed in accordance with the design shown on this drawing and that the design shown is complete and accurate to the best of my knowledge, except as noted below.

- The east inlet to Pond 302 was built at a gradient less than design (9.5% vs 10 feet). The SEDAD was adjusted accordingly.
- The bottom width of the inlet channel into Pond 301 varies and steps (as shown) will be 10 feet in 10 feet in section event. The SEDAD data in the PAP has been revised accordingly.

**EXHIBIT 26-73**

**AREA-3  
SOUTH DIXON  
PONDS 301 (AS-BUILT) AND  
PONDS 302 (AS-BUILT / 10-27-11)**


**LOCATION MAP/  
PLAN/PROFILE VIEW  
AND SECTIONS**





**BHP NAVAJO COAL COMPANY  
NAVAJO MINE**

PO BOX 1717, FRUITLAND, NEW MEXICO, 87416 / PHONE 505-598-4200/FAX 505-598-3361

PROJECT:	PROJECT MANAGER:	REVISION	REV	DATE
South Dixon Ponds-301/302	F. GORMAN			
DATE: FEB. 16, 2010	ENGR. of RECORD: RON VAN VALKENBURG	1 PREPARED POND DESIGN AND SUBMITTED TO DSM FOR REVIEW.		3-03-10
DESIGNED BY: F.Gorman	REG. NO: 9263	2 PREPARED AS-BUILT FOR POND 301 AND SUBMITTED TO DSM FOR REVIEW.		11-29-10
DRAWN BY: P.Foster	SRVYR of RECORD:	11-A PREPARED AS-BUILT FOR POND 302 AND SUBMITTED TO DSM FOR REVIEW.		10-27-11
CHECKED BY: RCV	REG. NO:			
APPROVED BY: RCV				

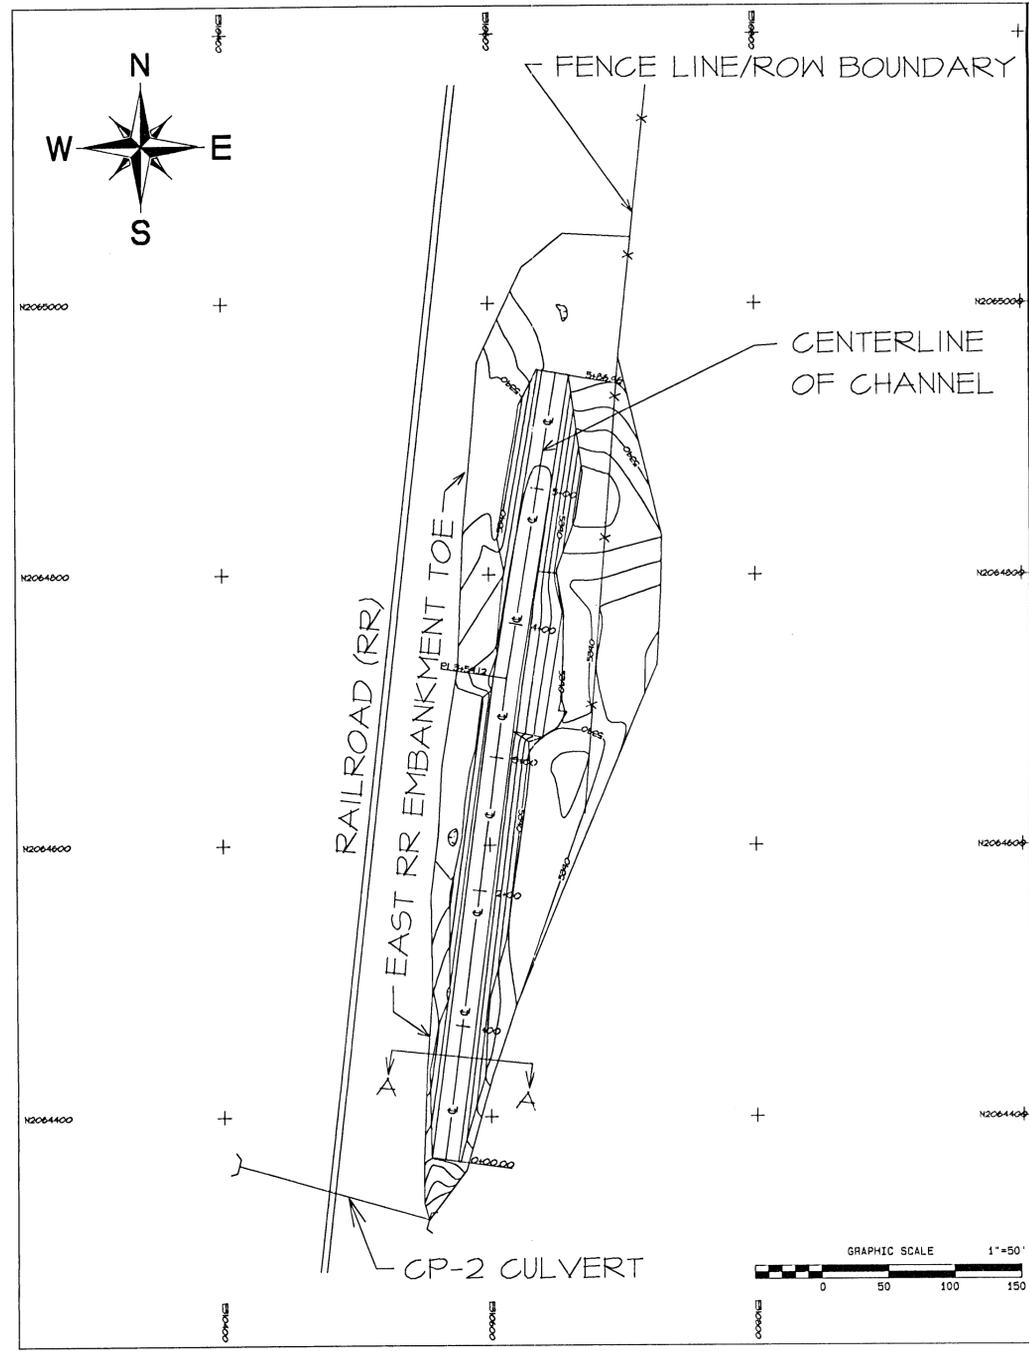

PLAN VIEW



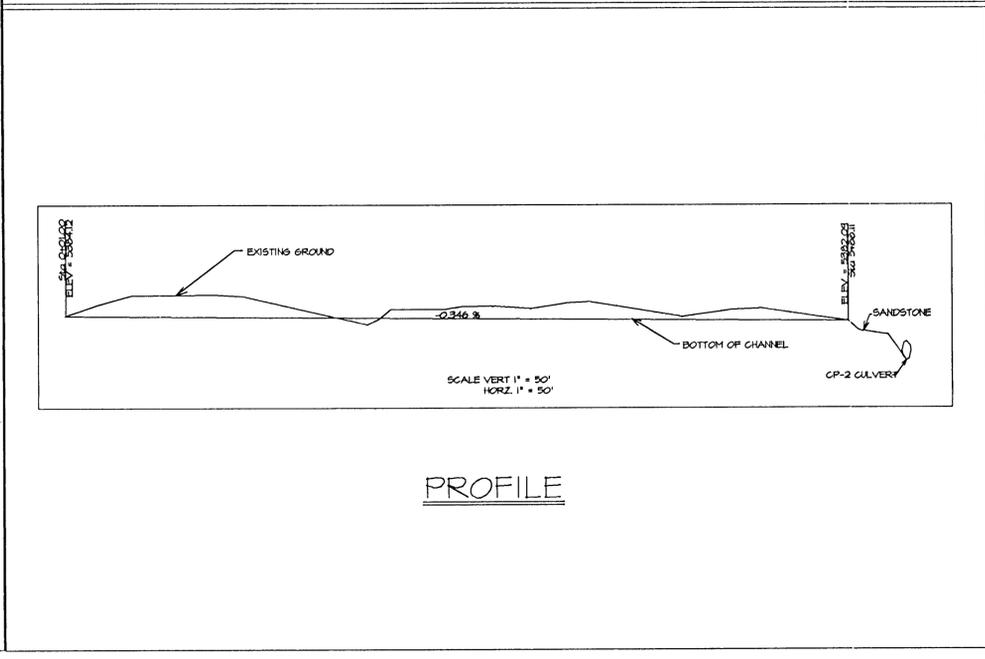
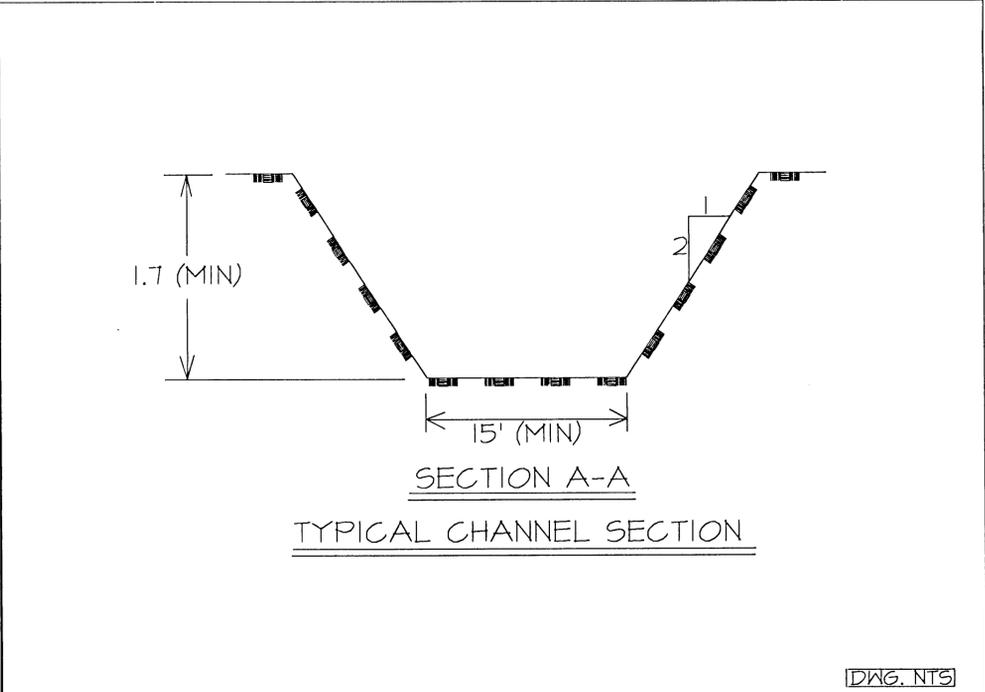


LEGEND

- ==== RAILROAD
- |—|— CULVERT
- x-x-x- FENCE LINE
- - - - CENTERLINE







A		SUBMIT TO OSM FOR APPROVAL		JL		JL	
REV.	DATE	DRAWN BY	REVISION DESCRIPTION	CHK.	APP.	P.E.	DATE
<b>EXHIBIT 26-75</b> <b>BHP MINERALS INTERNATIONAL INC.</b> > NAVAJO MINE < P.O. BOX 155 FRUITLAND, NEW MEXICO 87416							
<b>RAILROAD SIDE DITCH/CHANNEL</b> <b>AT CP-2 CULVERT</b>							
PREPARED BY	E.T.	DRAWN BY	E.T.	SCALE	AS NOTED		
APPROVED BY	L.R.	DATE	08-07-95	DWG. LOC.			
DWG. NO.		REF. DWG.					

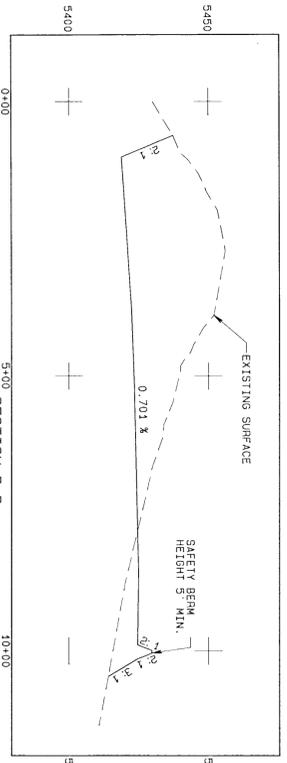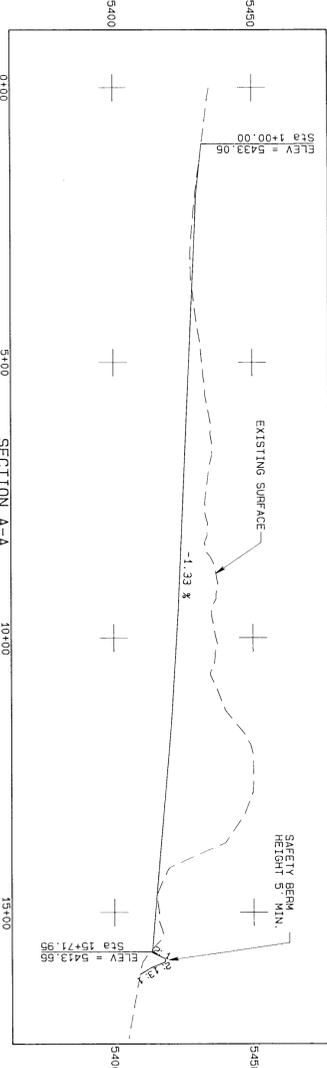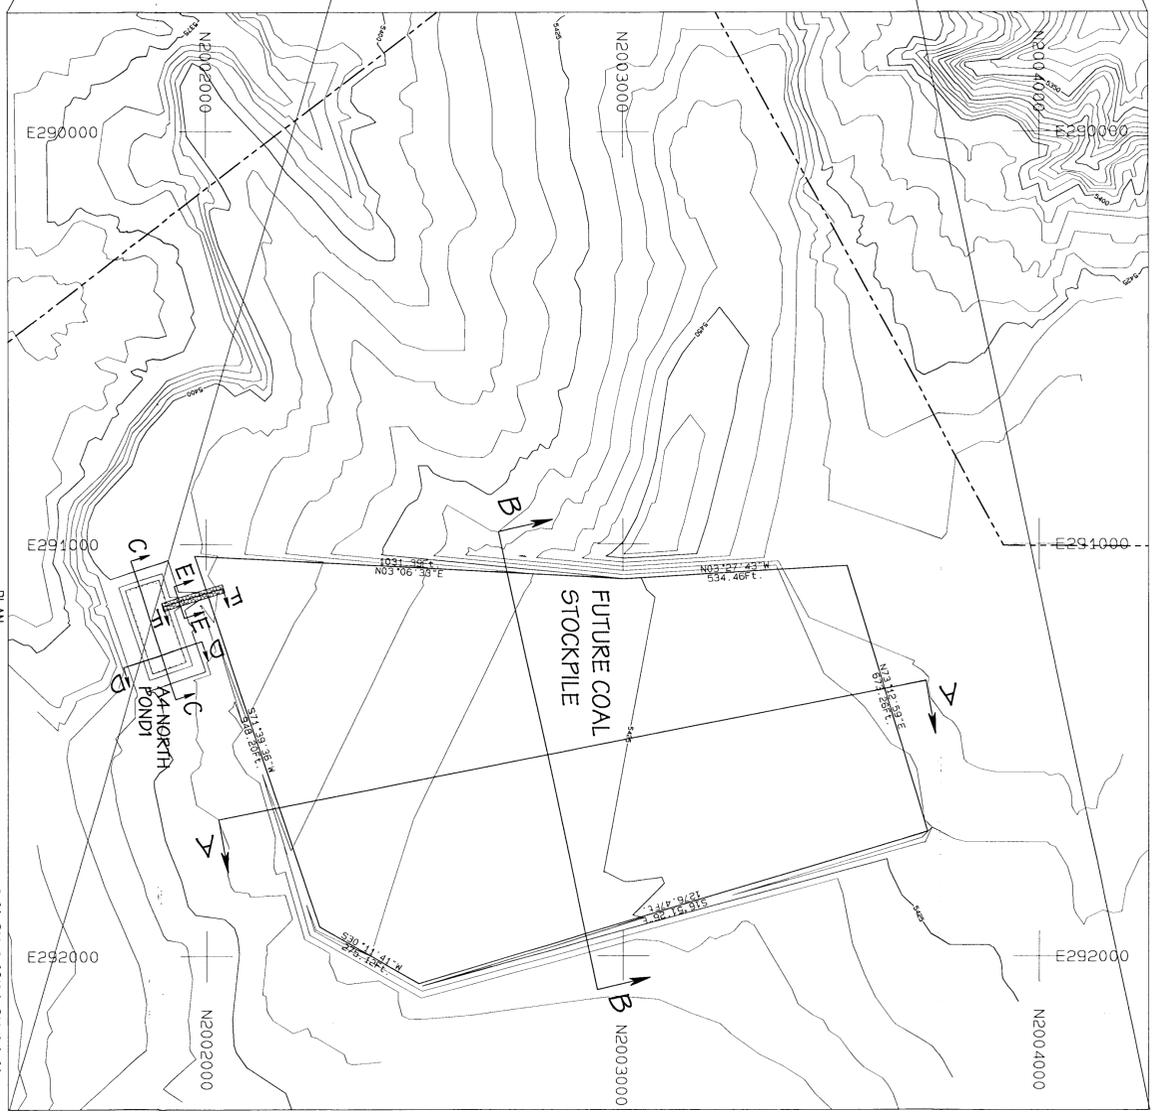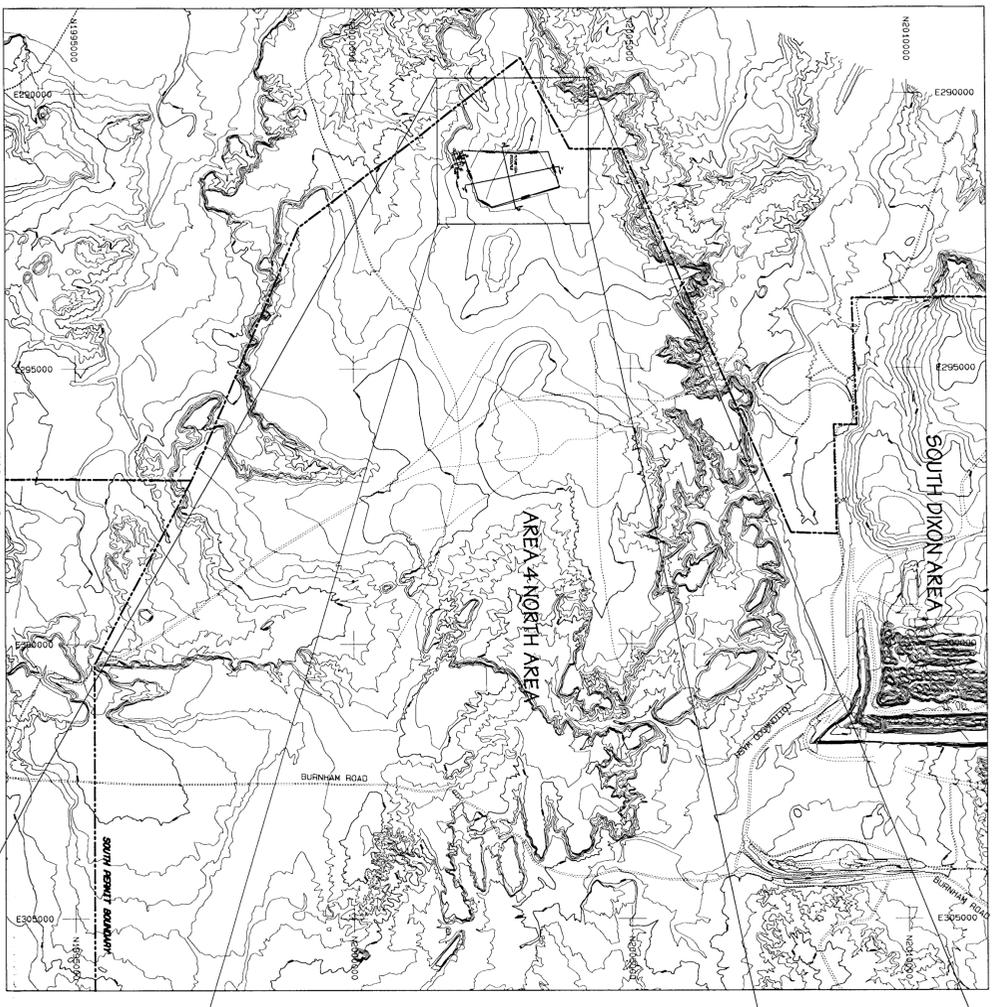

**STAGE STORAGE DATA**



ELEV. FEET	AREA AC.-FT.	VOLUME CU.-FT.	CUM. VOLUME
5390	0.42	0.00	0.00
5391	0.46	0.44	0.44
5392	0.50	0.48	0.92
5393	0.54	0.52	1.44
5394	0.58	0.56	2.00
5395	0.63	0.60	2.61
5396	0.67	0.65	3.25
5397	0.72	0.69	3.95
5398	0.77	0.74	4.69
5399	0.82	0.79	5.48
5400	0.87	0.84	6.32

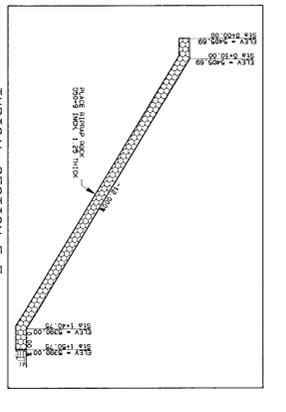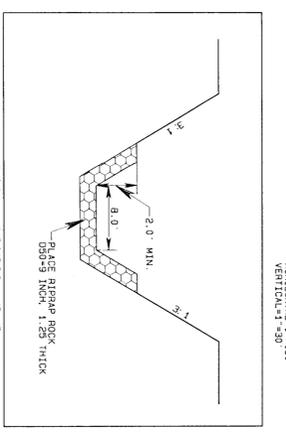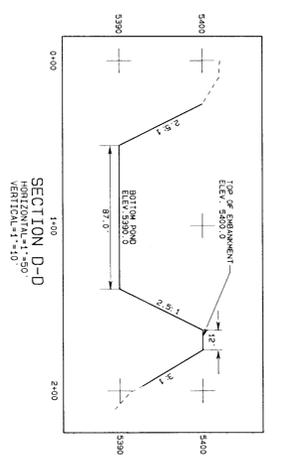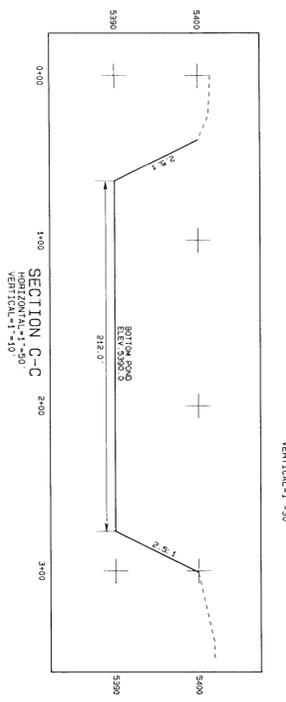

**LEGEND**


- ROAD
- WATERSHED
- BUILDING
- FENCE
- IRRIGATION LINE
- CULVERT
- DAM
- RAILROAD
- RAILROAD
- TREES
- POWER LINE
- SPOT ELEVATION
- INDEX CONTOUR
- INTERMEDIATE CONTOUR
- 2'10" PER 45'
- 2'10" PER 45'
- L-30
- PERMIT/LEASE BOUNDARY
- LEASE CORNER

- NOTES**
- For hydrology and design information refer to Appendix 11-A in the approved map.
  - The watershed areas for impoundment and pond locations are shown on Exhibit 11-13P.

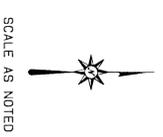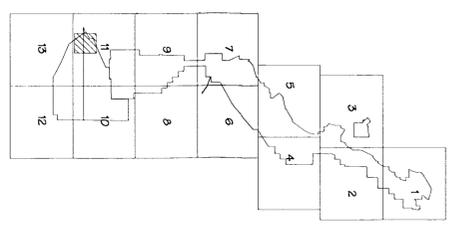


**CERTIFICATION STATEMENT**

I, Leonard Raymond, hereby certify that this drawing was reviewed by me and that the information shown is complete and accurate to the best of my knowledge.

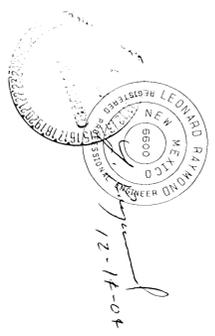



11-16-04

Path: C:\Vay\Terraced\11\Area 4 North\DESIGN\ponds\pond1.dwg

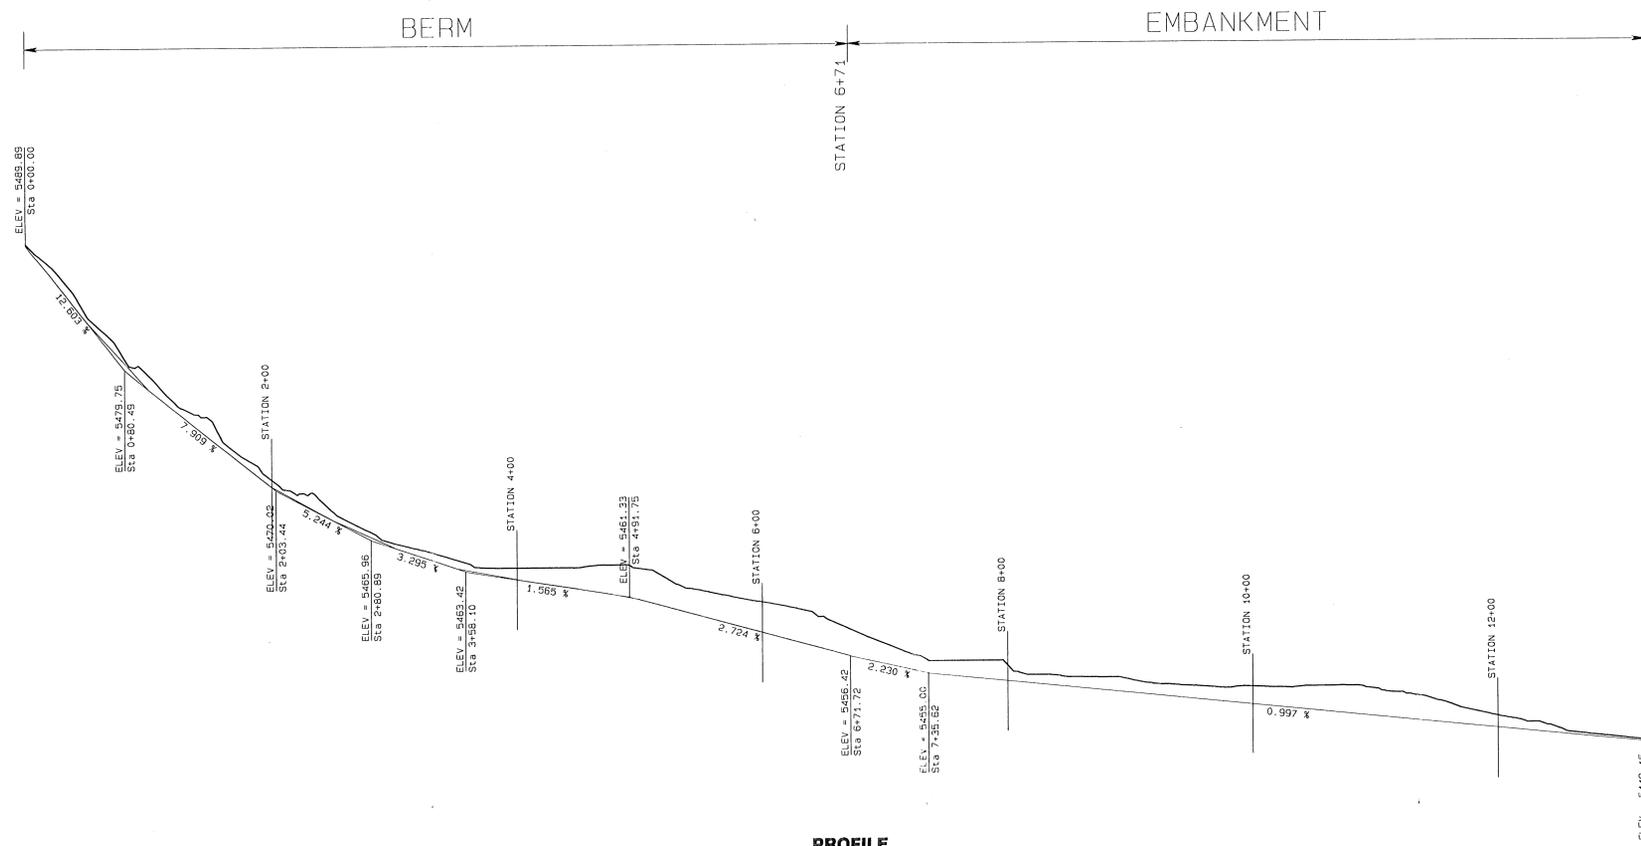


**PROFILE**  
 HOR: 1" = 50'  
 VER: 1" = 5'


**PLAN**  
 SCALE: 1" = 50'

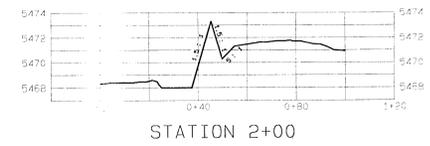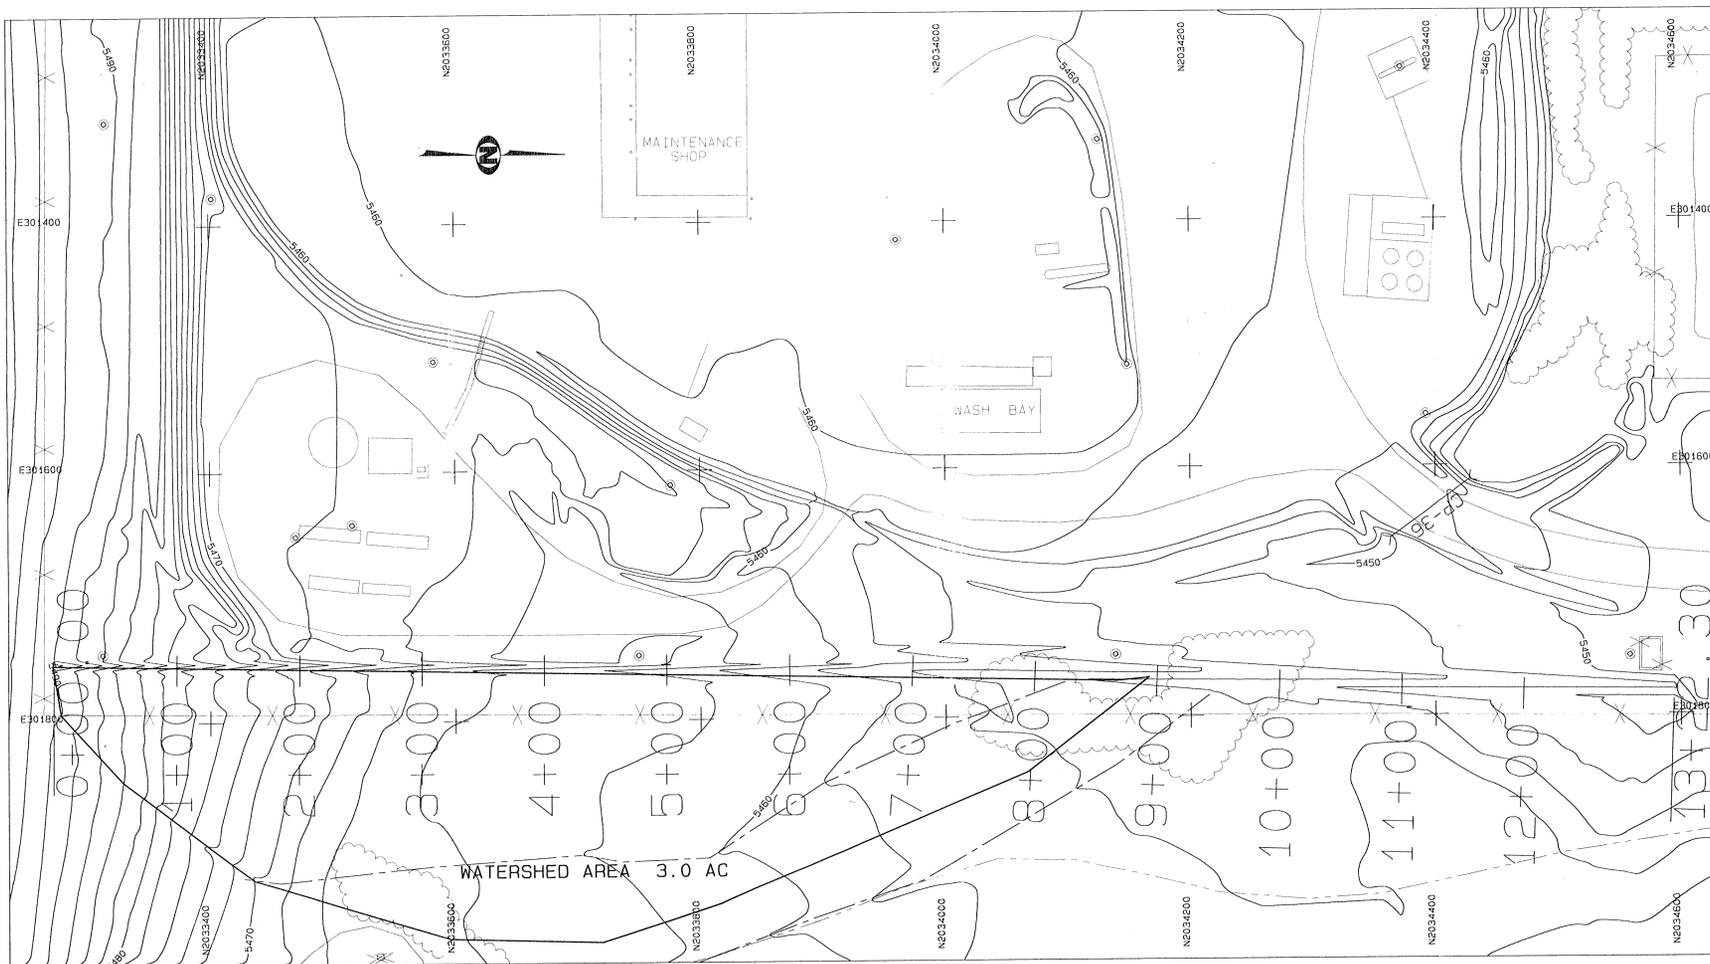


STATION 2+00

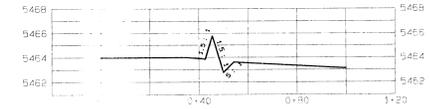


STATION 4+00

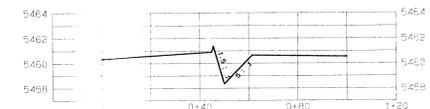


STATION 6+00

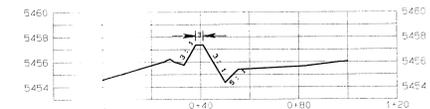

STATION 8+00

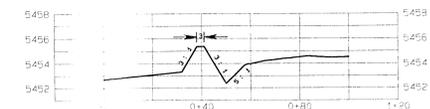

STATION 10+00

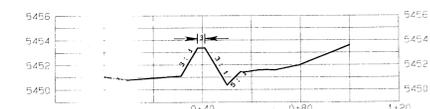

STATION 12+00

**SECTIONS**  
 HOR: 1" = 50'  
 VER: 1" = 5'

**LEGEND**

- PIPELINE
- POWER POLE
- SHRUBS
- CULVERT
- DRAINAGE

**NOTES**


REFER TO APPENDIX 11-2 FOR DESIGN INFORMATION

**Certification Statement**


I, Leonard Raymond, hereby certify that this drawing was reviewed by me and that the information is accurate and complete to the best of my knowledge.




A 4/96		BTS SUBMITTED TO OSM FOR APPROVAL		BS	JE
REV. NO.	DATE	DRYF. BY	REVISION DESCRIPTION	ENG. I. D. P. E.	P. E. P. E.
<b>EXHIBIT 26-77</b>					
BHP MINERALS INTERNATIONAL INC.					
NAVAJO MINE					
P.O. BOX 195 FRUITLAND, NEW MEXICO 87416					
<b>AREA 3 SHOP DIVERSION PLAN, PROFILE &amp; CROSS-SECTIONS</b>					
PREPARED BY	BTS	DRAWN BY	BTS	SCALE AS NOTED	
APPROVED BY	LR	DATE	4/22/96	DWG. LOC.	
DWG. NO.		REF. DWG.			

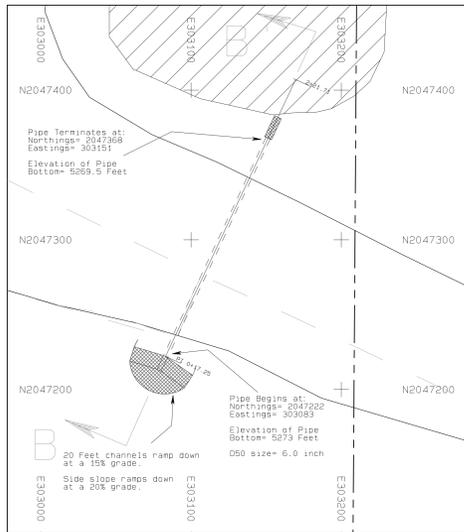

PLAN VIEW: CP-104 CULVERT  
SCALE: 1"=40'

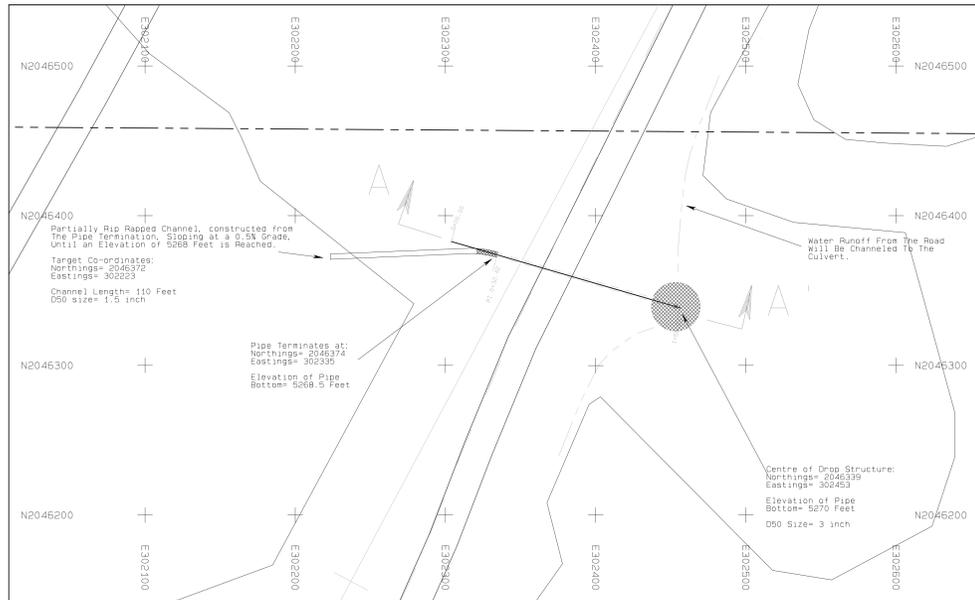

PLAN VIEW: CP-103 CULVERT  
SCALE: 1"=40'

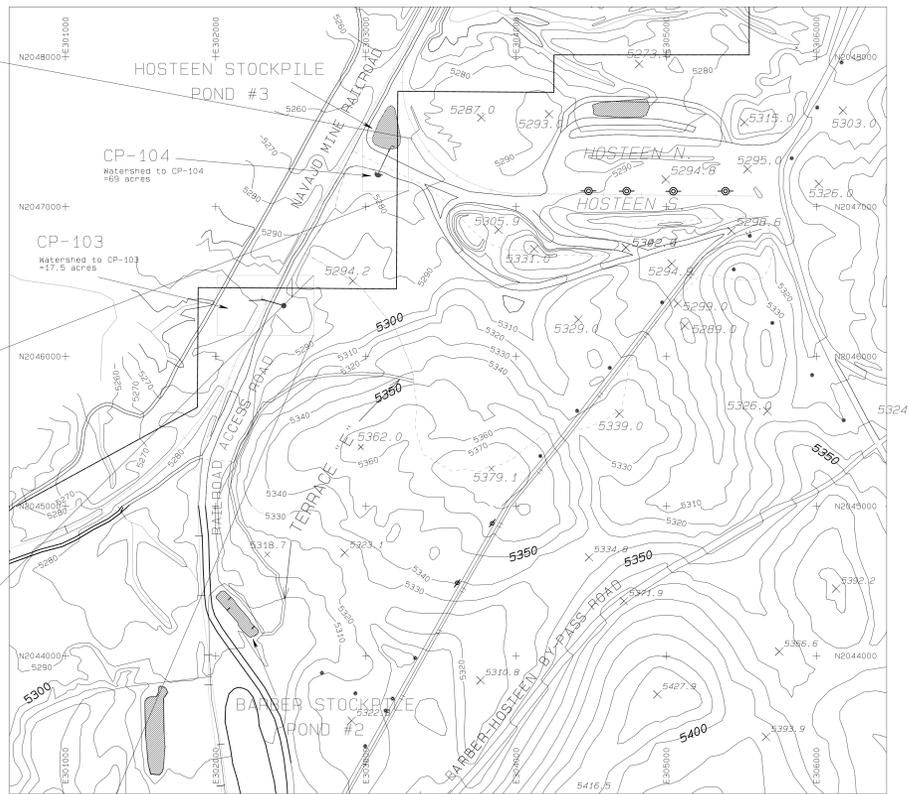

LOCATION MAP  
SCALE: 1"=400'

LEGEND


- PAVED ROAD
- DIRT ROAD
- HAUL ROAD
- TRAIL
- BUILDING
- FENCE
- IRRIGATION LINE
- CULVERT
- DAM
- DRAINAGE
- RAILROAD
- TREES
- POWERLINE
- SPOT ELEVATION
- INDEX CONTOUR
- INTERMEDIATE CONTOUR
- HORIZ. & VERT. CONTROL
- LEASE CORNER
- LEASE BOUNDARY
- POND
- WATERSHED

NOTE:  
DESIGN DATA PERTAINING TO THIS DIAGRAM CAN BE FOUND IN APPENDIX 11-V


			1
		3	2
	5	4	
7	6		
9	8		
11	10		
13	12		

CERTIFICATION STATEMENT

I, Leonard Raymond, hereby certify that this drawing was reviewed by me and that the information shown is accurate and complete to the best of my knowledge.

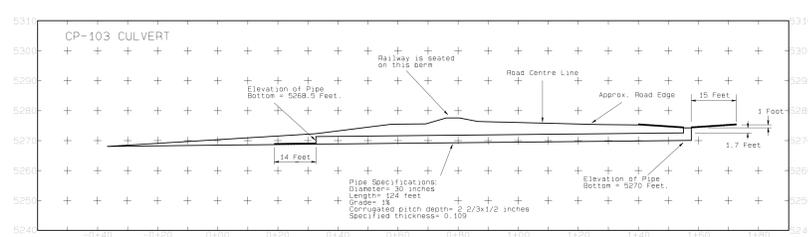

SECTION A A'  
SCALE: 1"=20'






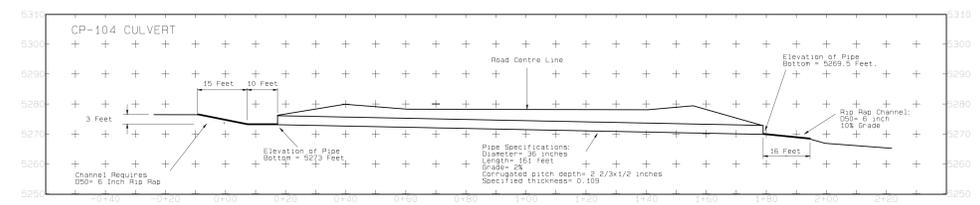


SECTION B B'  
SCALE: 1"=20'


REV. NO.	DATE	DRAWN BY	REVISION DESCRIPTION	ENG. (I.C.G. P.E. P.S. INC.)
A	02/19/97	RH	SUBMITTED TO GDM FOR APPROVAL	

**EXHIBIT 26-78**  
**NAVAJO COAL COMPANY**  
NAVAJO MINE  
P.O. BOX 123 FRUITLAND, NEW MEXICO 87416  
**CULVERTS CP 103 AND CP 104**  
**PLANS, SECTIONS and DETAILS**



PREPARED BY/RH	DRAWN BY/RH	SCALE AS NOTED
APPROVED BY/LR	DATE 02/19/97	REF DWG
DWG LOC		

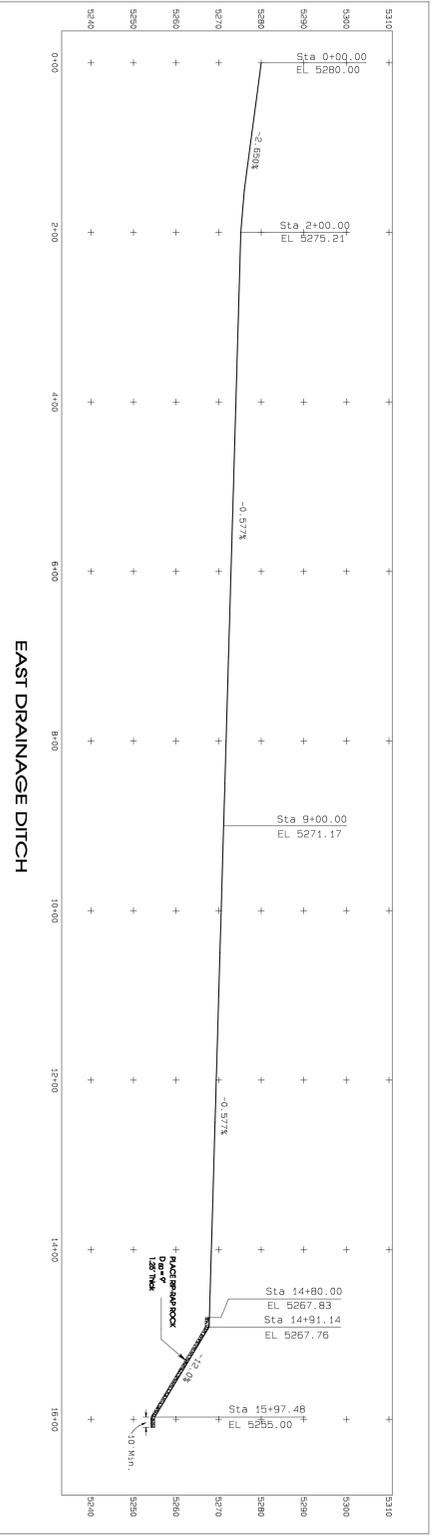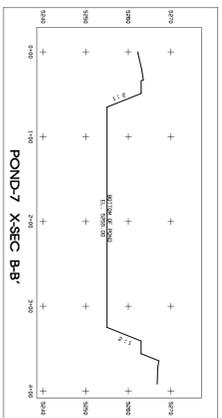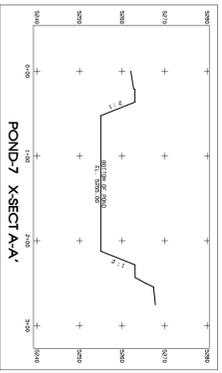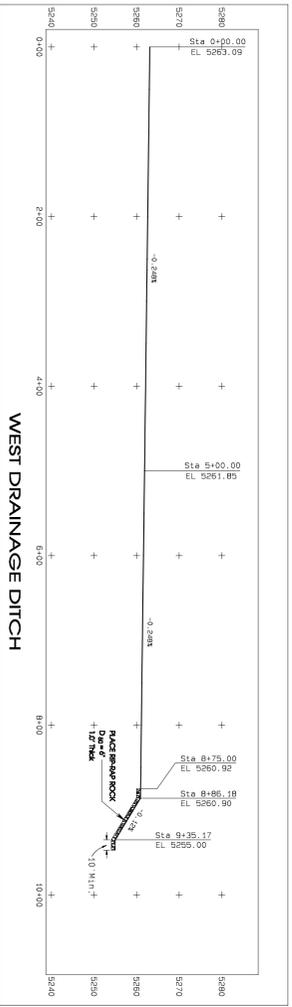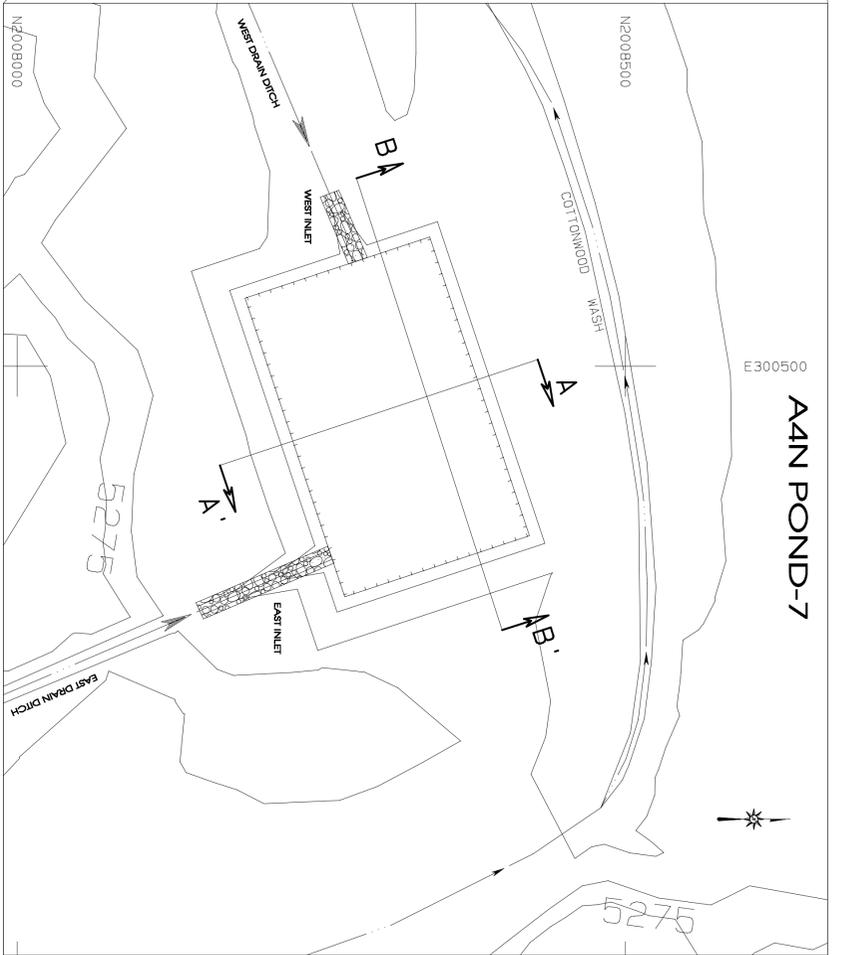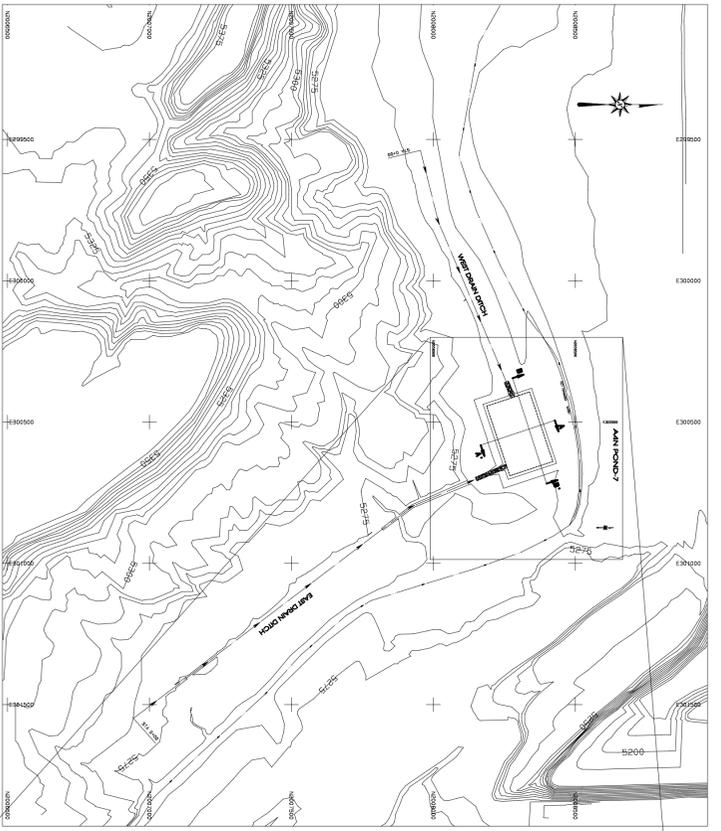


STAGE STORAGE DATA			
ELEV. FEET	AREA ACRES	VOLUME AC-FT	CUM. VOLUME AC-FT
5255	0.95	0.00	0.00
5256	1.00	0.98	0.98
5257	1.04	1.02	1.99
5258	1.08	1.06	3.05
5259	1.13	1.11	4.16
5260	1.18	1.16	5.32
5261	1.24	1.21	6.52
5262	1.39	1.31	7.83
5263	1.48	1.43	9.26

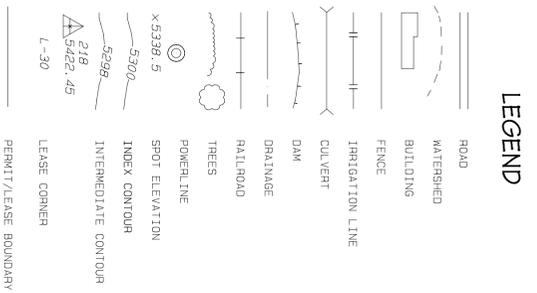

- NOTES**
1. For hydrology and design information refer to Appendix 11-A in the approved PAP.
  2. The watershed areas for Impoundment and pond locations are shown on Exhibit 11-13P.

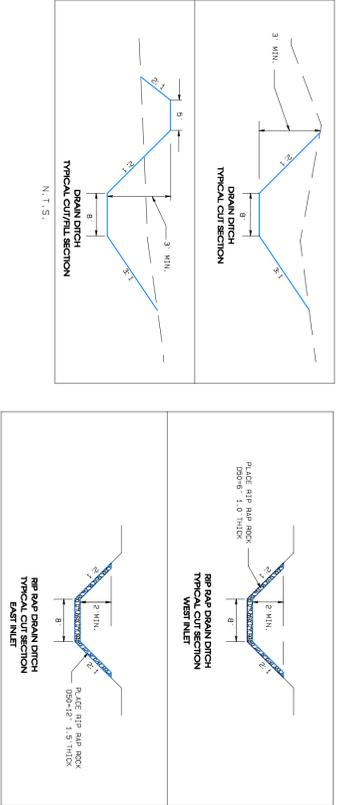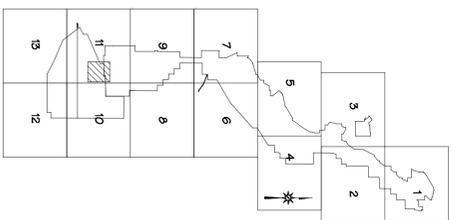

**CERTIFICATION STATEMENT**  
 I, Leonard Raymond, hereby certify that this drawing was reviewed by me and that the information shown is complete and accurate to the best of my knowledge.

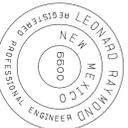

REV	DATE	DESCRIPTION
1	12-09-04	SUBMITTED TO OSM FOR APPROVAL



**BHP NAVAJO COAL CO.**  
**NAVAJO MINE**  
 PO BOX 1717, FRUITLAND, NEW MEXICO, 87416

ACCOUNT: \_\_\_\_\_  
 DATE: 11-19-04  
 DESIGNED BY: PUF  
 DRAWN BY: LR  
 CHECKED BY: LR  
 APPROVED BY: LR

**PLAN, PROFILE AND SECTION**

**EXHIBIT 26-79**  
**AREA 4 NORTH POND 7**  
**DESIGN**




SHEET 1  
 OF 1

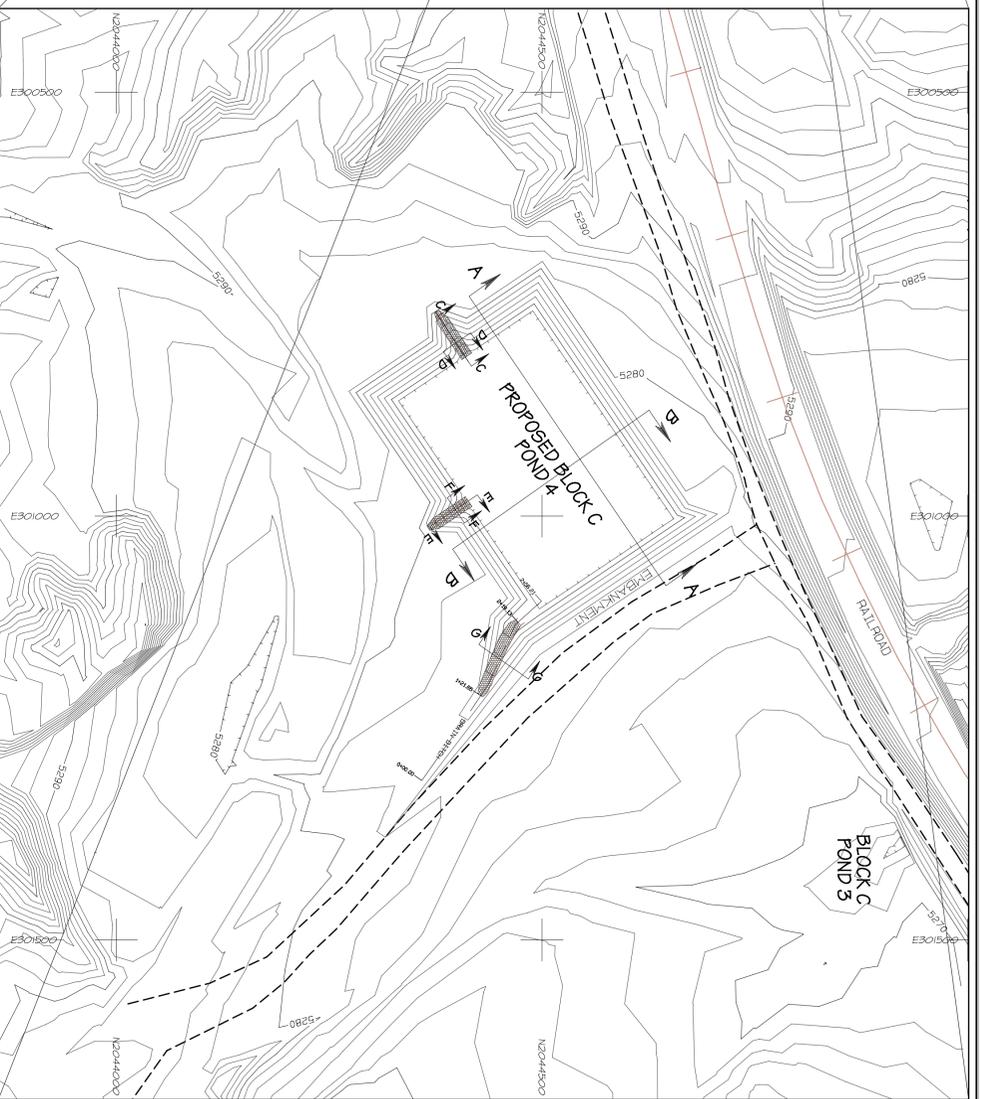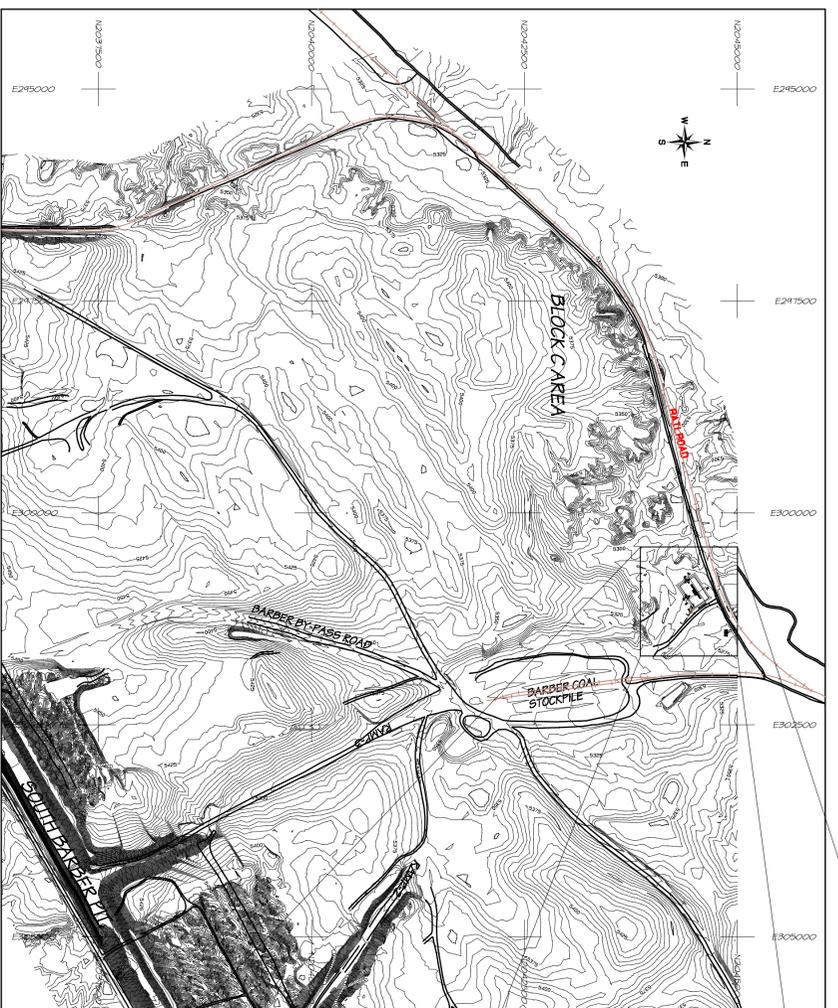

**LEGEND**





- ROAD
- WATERSHED
- BUILDING
- FENCE
- IRRIGATION LINE
- CULVERT
- DAM
- DRAINAGE
- RAILROAD
- TREES
- POWER LINE
- SPOT ELEVATION
- INDEX CONTOUR
- INTERMEDIATE CONTOUR
- LEASE CORNER
- PERMIT/LEASE BOUNDARY

- NOTES**
1. FOR HYDROLOGY AND DESIGN INFORMATION POND 4 IS 500' DIA. POND 5 IS 150' DIA. IN THE 500' DIA. POND 4 AREAS SHOWN ON EXHIBIT 11-130.
  2. THE WATERSHED AREAS FOR IMPROVEMENT AND POND LOCATIONS ARE SHOWN ON EXHIBIT 11-130.

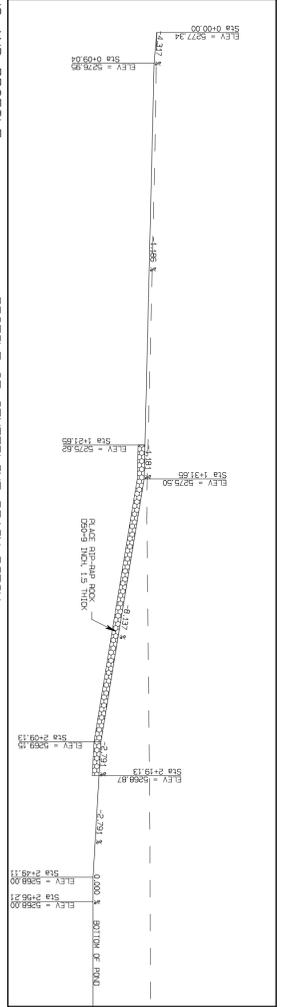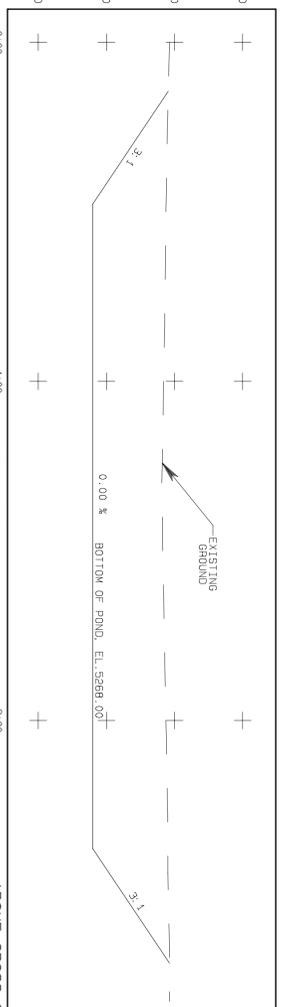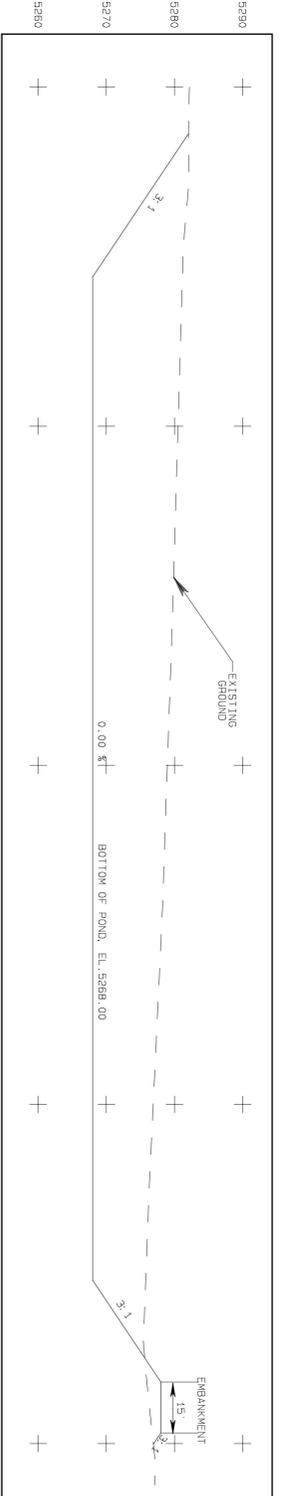

**STAGE STORAGE DATA**



ELEV. FEET	AREA ACRES	VOLUME ac-ft	CUM. VOLUME ac-ft
5298	1.29	0.00	0.00
5299	1.37	1.33	1.33
5280	1.45	1.41	2.75
5271	1.54	1.49	4.24
5272	1.62	1.58	5.82
5273	1.71	1.66	7.48
5274	1.80	1.75	9.24
5275	1.90	1.85	11.09
5276	2.01	1.95	13.04
5277	2.23	2.12	15.15
5278	2.71	2.47	17.62

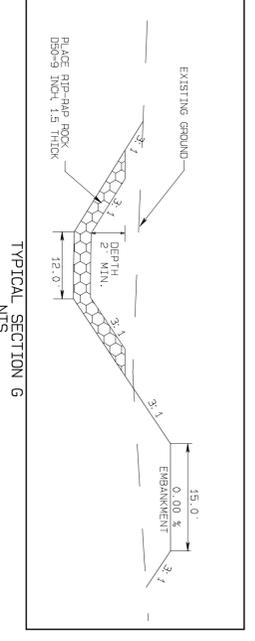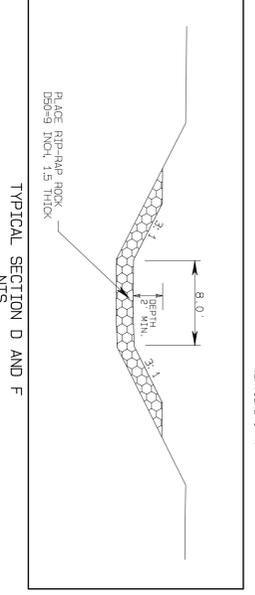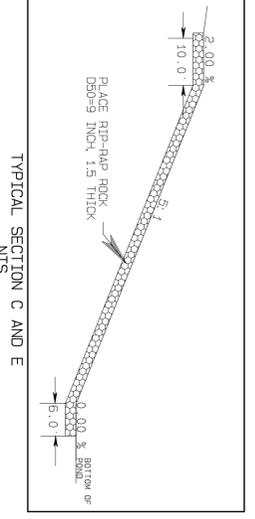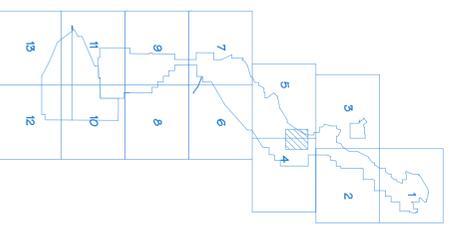

**CERTIFICATION STATEMENT**  
 I, Kevin A. Bane, hereby certify that this drawing was reviewed by me and that the information shown is complete and accurate to the best of my knowledge.





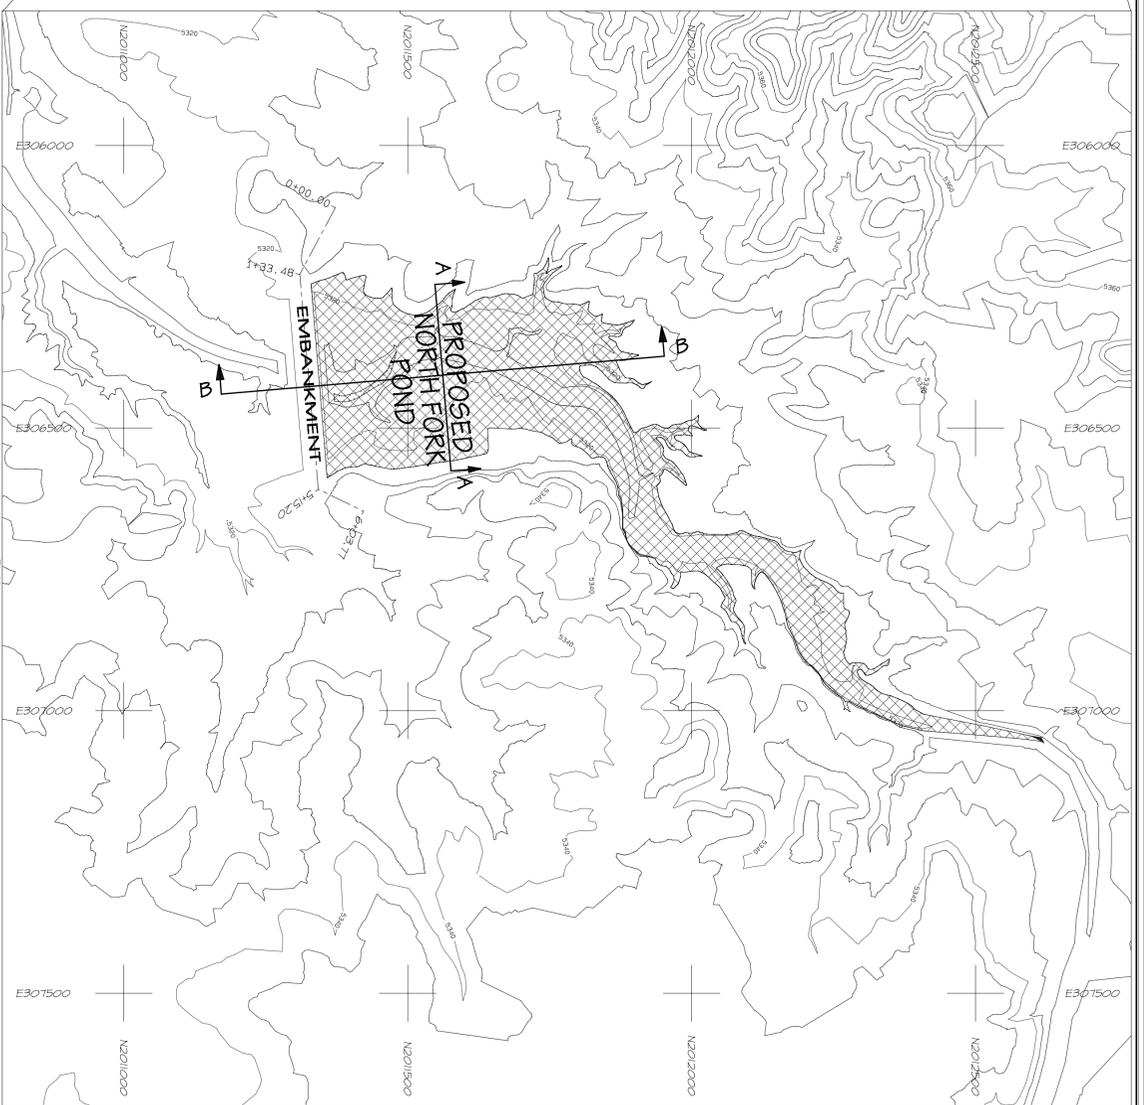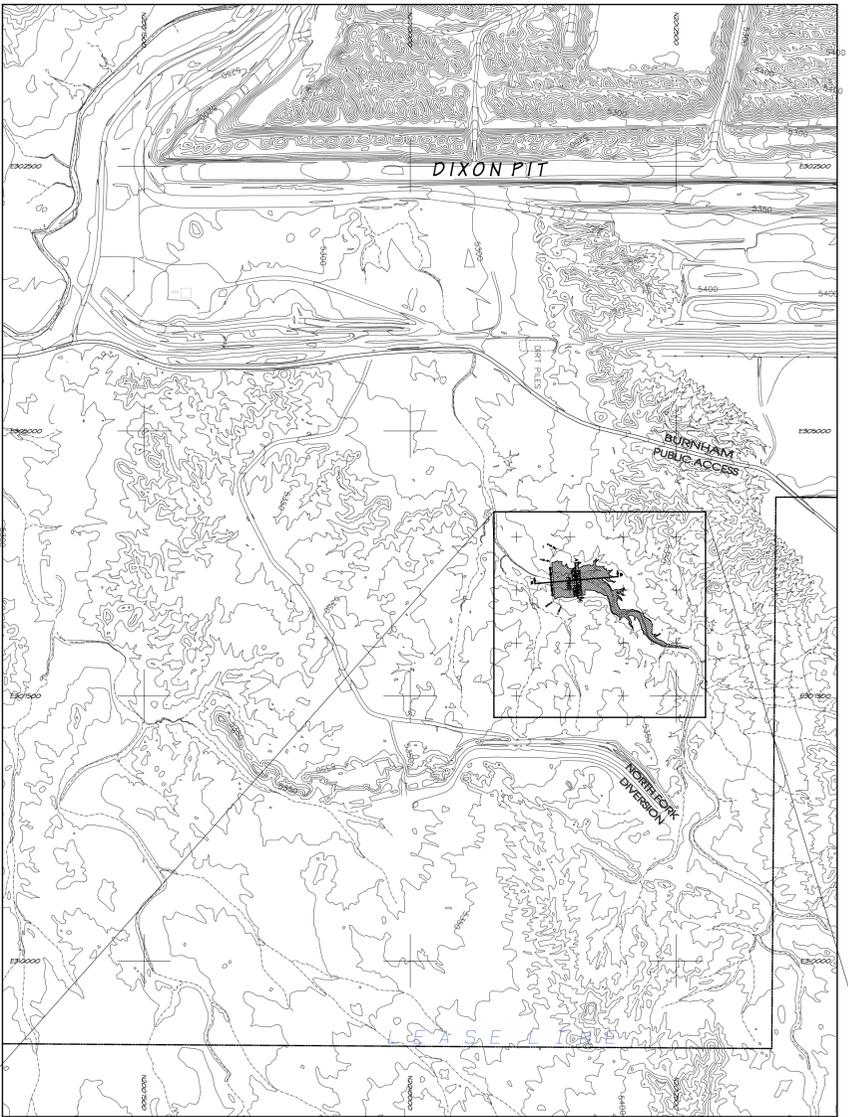


**LEGEND**




- ROAD
- WATERSHED
- BUILDING
- FENCE
- IRRIGATION LINE
- CULVERT
- DAM
- DRAINAGE
- RAILROAD
- TREES
- POWERLINE
- SPOT ELEVATION
- INDEX CONTOUR
- INTERMEDIATE CONTOUR
- PERMIT/LEASE BOUNDARY
- LEASE CORNER
- L-30
- 5298
- 5300
- X 5328.5
- 218
- 5422.45

**NOTES**

1. For hydrology and design information refer to appendix 11-2A in the approved P&S.
2. The watershed areas for impoundment and pond locations are shown on Exhibit 11-13B.

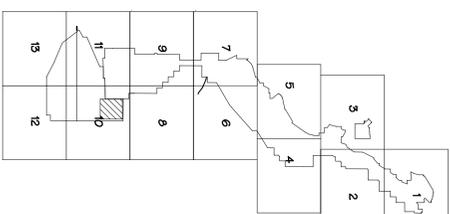

SCALE AS NOTED

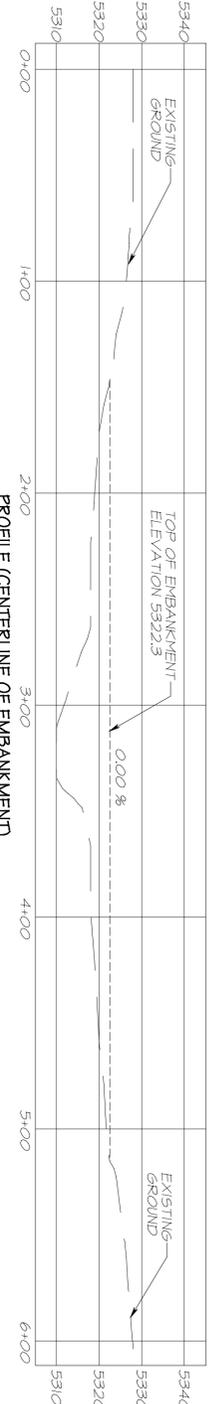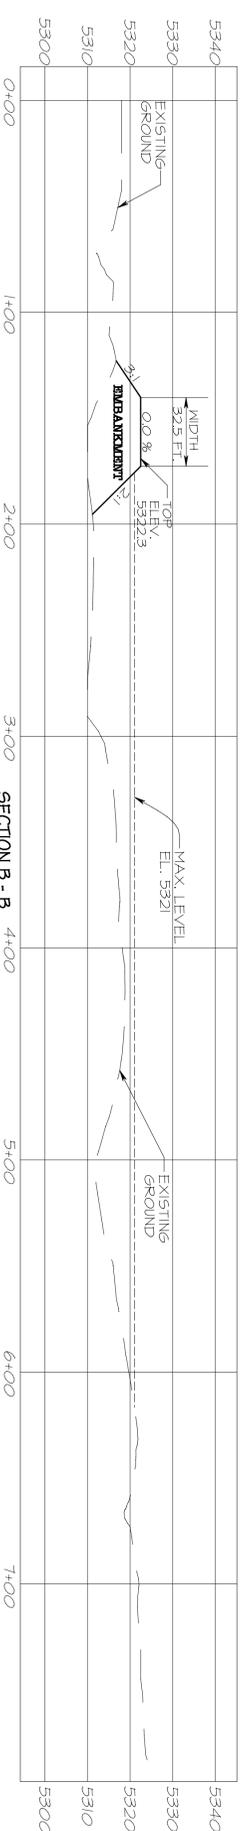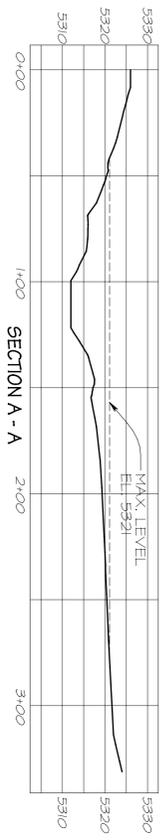

**STAGE STORAGE DATA**

ELEV. feet	AREA acres	VOLUME ac-ft	CUM. VOLUME ac-ft
5310	0.03	0.00	0.00
5312	0.21	0.2	0.2
5314	0.45	0.7	0.9
5316	0.96	1.4	2.3
5318	1.72	2.7	5.0
5320	3.05	4.8	9.7
5322	4.82	7.9	17.6
5324	7.65	12.5	30.1

Design Pond Crest Elevation - 5323.3  
Design Volume (Ac-ft) - 19.50

**CERTIFICATION STATEMENT**  
I, Ron C. VAN VALKENBURG, hereby certify that this drawing was reviewed by me and that the information shown is complete and accurate to the best of my knowledge.



**Original Signed by P.E.**

**EXHIBIT 26-82  
NORTH FORK POND  
DESIGN**

**PLAN, PROFILE AND  
SECTION**

ACCOUNT: \_\_\_\_\_  
DATE: 1-19-08  
DESIGNED BY: RCV  
DRAWN BY: RCV  
CHECKED BY: RCV  
APPROVED BY: RCV

**BHP NAVAJO COAL CO.  
NAVAJO MINE**  
PO BOX 1717, FRUITLAND, NEW MEXICO, 87416



REV	DESCRIPTION	REV BY	DATE
1	SUBMITTED TO OSM FOR APPROVAL	RCV	1-19-08
2	DESIGNED, DRAWN AND SUBMITTED TO OSM FOR REVIEW	PJF	7-15-08
3			
4			
5			

SHEET 1  
OF 1








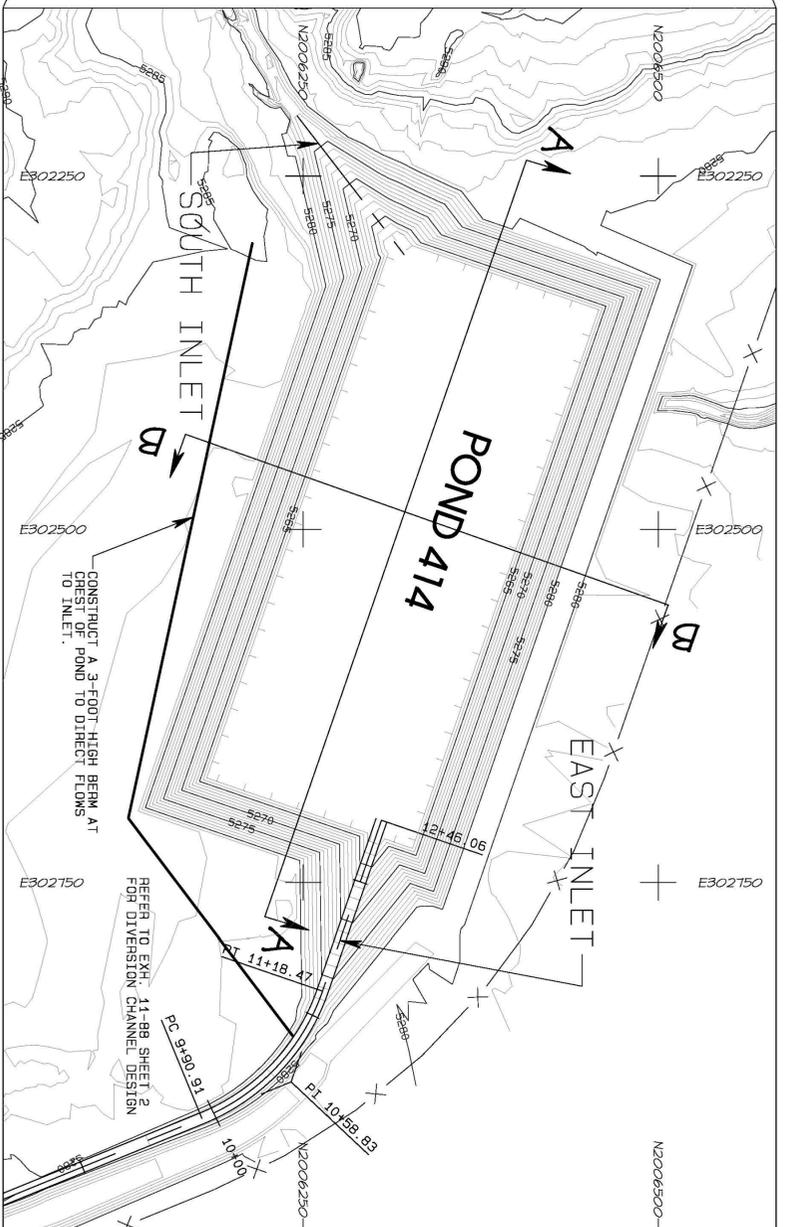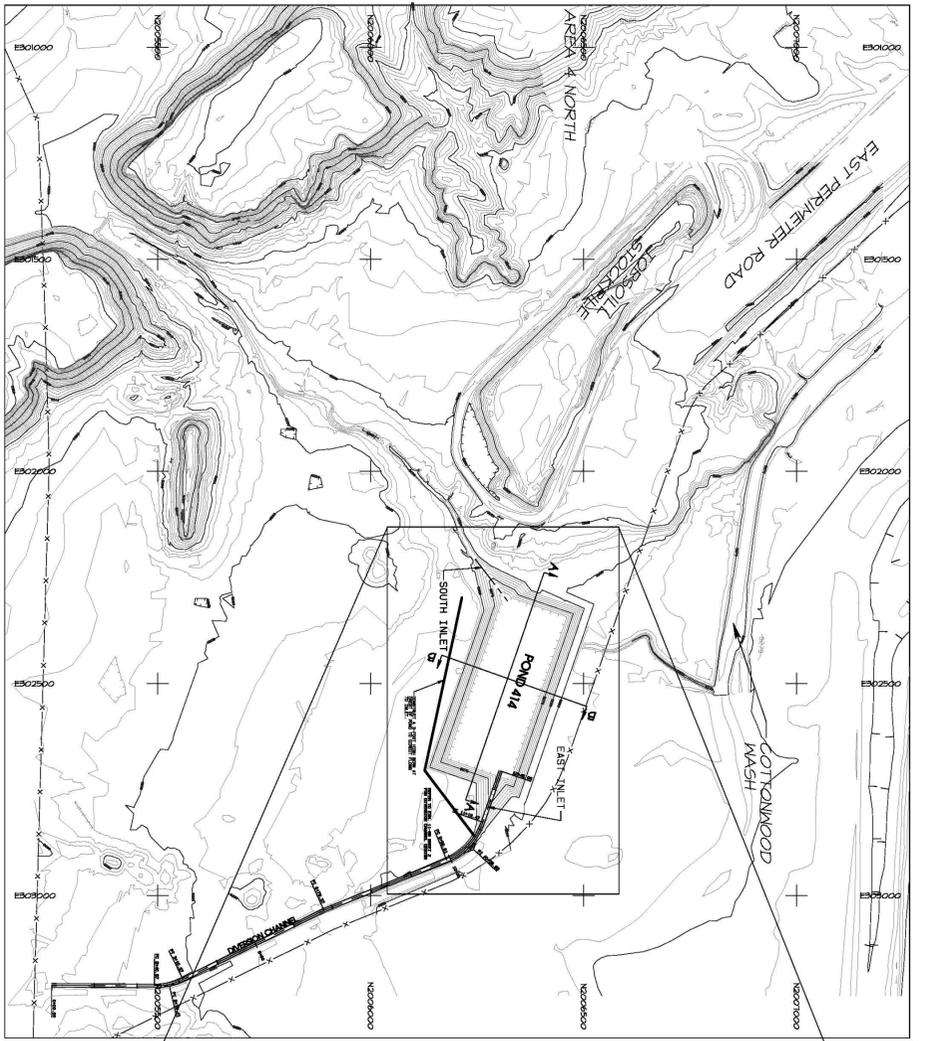





**LEGEND**

- ROAD
- CAVART
- DRAINAGE
- POWERLINE
- INDEX CONTOUR
- IMMEDIATE CONTOUR
- L-30 LEASE CORNER
- PERMIT/LEASE BOUNDARY
- WATER LINE
- IRIGATION LINE

- NOTES**
- For hydrology and design information refer to Appendix 11-A in the approved P&E. The watershed areas for the impoundments are shown on Exhibit 11-13.





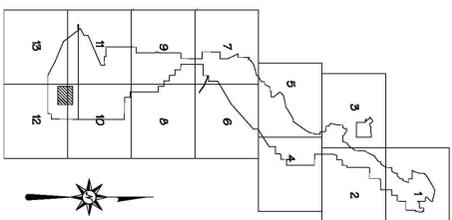


SCALES AS NOTED

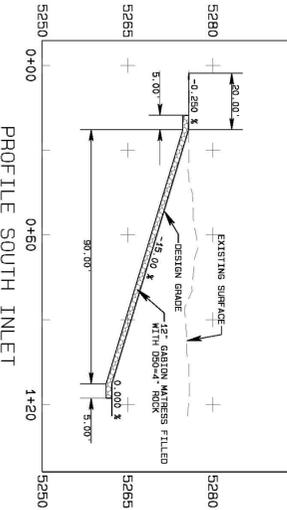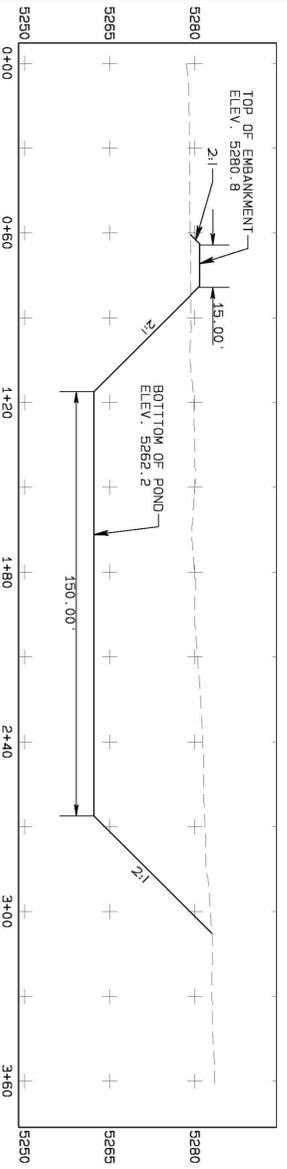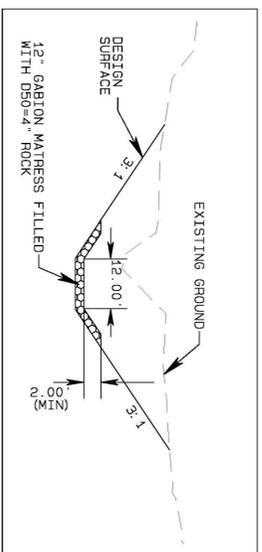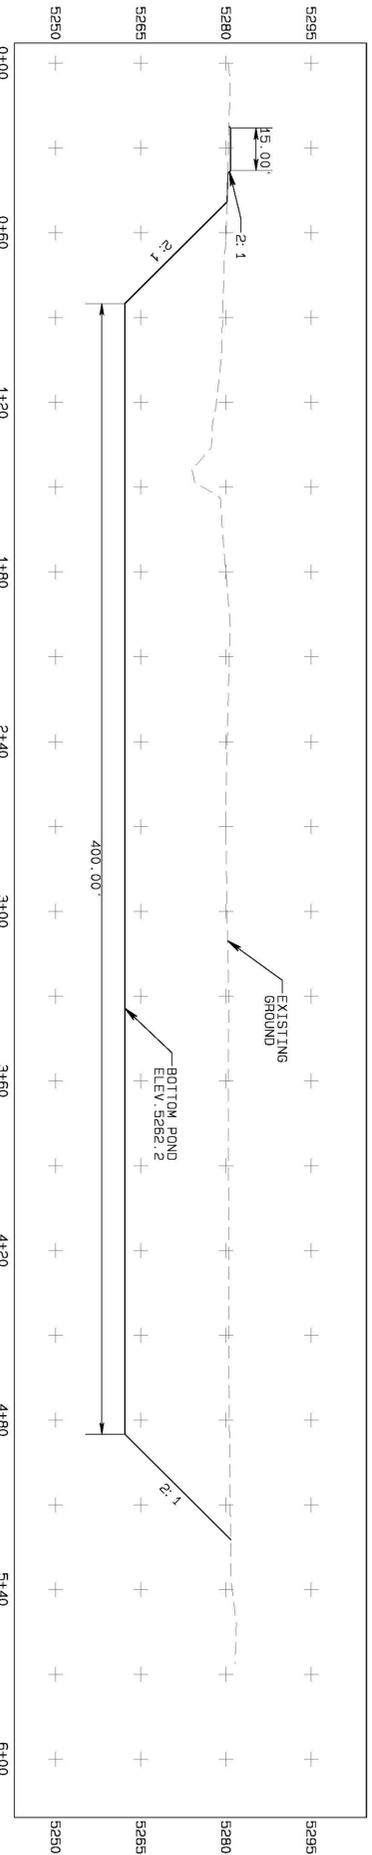

**A&A POND 414  
STAGE STORAGE DATA**


ELEV.	AREA	VOLUME	CUM. VOLUME
AC-FT	AC-FT	AC-FT	AC-FT
5295.0	1.36	0.00	0.00
5294.0	1.46	0.10	0.10
5293.0	1.57	0.27	0.27
5292.0	1.69	0.51	0.51
5291.0	1.82	0.82	0.82
5290.0	1.95	1.18	1.18
5289.0	2.09	1.60	1.60
5288.0	2.24	2.08	2.08
5287.0	2.40	2.62	2.62
5286.0	2.57	3.22	3.22
5285.0	2.75	3.89	3.89
5284.0	2.94	4.62	4.62
5283.0	3.14	5.42	5.42
5282.0	3.35	6.29	6.29
5281.0	3.57	7.24	7.24
5280.0	3.80	8.27	8.27
5279.0	4.04	9.38	9.38
5278.0	4.29	10.57	10.57
5277.0	4.55	11.84	11.84
5276.0	4.82	13.19	13.19
5275.0	5.10	14.62	14.62
5274.0	5.39	16.13	16.13
5273.0	5.69	17.72	17.72
5272.0	6.00	19.39	19.39
5271.0	6.32	21.14	21.14
5270.0	6.65	22.97	22.97
5269.0	7.00	24.88	24.88
5268.0	7.36	26.87	26.87
5267.0	7.74	28.94	28.94
5266.0	8.13	31.09	31.09
5265.0	8.54	33.32	33.32
5264.0	8.96	35.63	35.63
5263.0	9.40	38.03	38.03
5262.0	9.86	40.51	40.51
5261.0	10.34	43.08	43.08
5260.0	10.83	45.74	45.74
5259.0	11.34	48.49	48.49
5258.0	11.86	51.32	51.32
5257.0	12.40	54.24	54.24
5256.0	12.96	57.25	57.25
5255.0	13.53	60.35	60.35
5254.0	14.12	63.54	63.54
5253.0	14.72	66.82	66.82
5252.0	15.34	70.19	70.19
5251.0	15.97	73.65	73.65
5250.0	16.62	77.20	77.20
5249.0	17.29	80.84	80.84
5248.0	17.97	84.57	84.57
5247.0	18.67	88.39	88.39
5246.0	19.39	92.30	92.30
5245.0	20.12	96.30	96.30
5244.0	20.87	100.39	100.39
5243.0	21.64	104.57	104.57
5242.0	22.42	108.84	108.84
5241.0	23.22	113.20	113.20
5240.0	24.04	117.65	117.65
5239.0	24.87	122.19	122.19
5238.0	25.72	126.82	126.82
5237.0	26.59	131.54	131.54
5236.0	27.48	136.35	136.35
5235.0	28.39	141.25	141.25
5234.0	29.31	146.24	146.24
5233.0	30.25	151.32	151.32
5232.0	31.20	156.49	156.49
5231.0	32.17	161.75	161.75
5230.0	33.16	167.10	167.10
5229.0	34.16	172.54	172.54
5228.0	35.18	178.07	178.07
5227.0	36.21	183.69	183.69
5226.0	37.26	189.40	189.40
5225.0	38.32	195.20	195.20
5224.0	39.40	201.09	201.09
5223.0	40.50	207.07	207.07
5222.0	41.61	213.14	213.14
5221.0	42.74	219.30	219.30
5220.0	43.88	225.55	225.55
5219.0	45.04	231.89	231.89
5218.0	46.21	238.32	238.32
5217.0	47.40	244.84	244.84
5216.0	48.61	251.45	251.45
5215.0	49.83	258.15	258.15
5214.0	51.07	264.94	264.94
5213.0	52.32	271.82	271.82
5212.0	53.59	278.79	278.79
5211.0	54.87	285.85	285.85
5210.0	56.17	293.00	293.00
5209.0	57.48	300.24	300.24
5208.0	58.80	307.57	307.57
5207.0	60.14	315.00	315.00
5206.0	61.49	322.51	322.51
5205.0	62.86	330.11	330.11
5204.0	64.24	337.80	337.80
5203.0	65.63	345.58	345.58
5202.0	67.04	353.45	353.45
5201.0	68.46	361.41	361.41
5200.0	69.90	369.46	369.46
5199.0	71.35	377.60	377.60
5198.0	72.82	385.83	385.83
5197.0	74.30	394.15	394.15
5196.0	75.80	402.56	402.56
5195.0	77.31	411.06	411.06
5194.0	78.84	419.64	419.64
5193.0	80.38	428.31	428.31
5192.0	81.94	437.07	437.07
5191.0	83.51	445.92	445.92
5190.0	85.10	454.86	454.86
5189.0	86.70	463.89	463.89
5188.0	88.32	473.01	473.01
5187.0	89.95	482.22	482.22
5186.0	91.60	491.52	491.52
5185.0	93.26	500.91	500.91
5184.0	94.94	510.39	510.39
5183.0	96.63	519.96	519.96
5182.0	98.34	529.62	529.62
5181.0	100.06	539.37	539.37
5180.0	101.80	549.20	549.20
5179.0	103.56	559.12	559.12
5178.0	105.33	569.13	569.13
5177.0	107.12	579.23	579.23
5176.0	108.93	589.42	589.42
5175.0	110.75	599.70	599.70
5174.0	112.59	610.07	610.07
5173.0	114.44	620.53	620.53
5172.0	116.31	631.08	631.08
5171.0	118.20	641.72	641.72
5170.0	120.11	652.45	652.45
5169.0	122.03	663.27	663.27
5168.0	124.07	674.18	674.18
5167.0	126.12	685.18	685.18
5166.0	128.19	696.27	696.27
5165.0	130.28	707.45	707.45
5164.0	132.38	718.72	718.72
5163.0	134.50	730.08	730.08
5162.0	136.64	741.53	741.53
5161.0	138.80	753.07	753.07
5160.0	140.97	764.70	764.70
5159.0	143.16	776.42	776.42
5158.0	145.37	788.23	788.23
5157.0	147.60	800.13	800.13
5156.0	149.84	812.12	812.12
5155.0	152.10	824.20	824.20
5154.0	154.38	836.37	836.37
5153.0	156.68	848.63	848.63
5152.0	159.00	861.08	861.08
5151.0	161.34	873.71	873.71
5150.0	163.70	886.43	886.43
5149.0	166.08	899.24	899.24
5148.0	168.48	912.14	912.14
5147.0	170.90	925.23	925.23
5146.0	173.34	938.41	938.41
5145.0	175.80	951.68	951.68
5144.0	178.28	965.04	965.04
5143.0	180.78	978.49	978.49
5142.0	183.30	992.03	992.03
5141.0	185.84	1005.66	1005.66
5140.0	188.40	1019.38	1019.38
5139.0	190.98	1033.19	1033.19
5138.0	193.58	1047.09	1047.09
5137.0	196.20	1061.08	1061.08
5136.0	198.84	1075.16	1075.16
5135.0	201.50	1089.33	1089.33
5134.0	204.18	1103.59	1103.59
5133.0	206.88	1117.94	1117.94
5132.0	209.60	1132.38	1132.38
5131.0	212.34	1146.91	1146.91
5130.0	215.10	1161.53	1161.53
5129.0	217.88	1176.24	1176.24
5128.0	220.68	1191.04	1191.04
5127.0	223.50	1205.93	1205.93
5126.0	226.34	1220.91	1220.91
5125.0	229.20	1235.98	1235.98
5124.0	232.08	1251.14	1251.14
5123.0	235.00	1266.39	1266.39
5122.0	237.94	1281.73	1281.73
5121.0	240.90	1297.16	1297.16
5120.0	243.88	1312.68	1312.68
5119.0	246.88	1328.29	1328.29
5118.0	249.90	1343.99	1343.99
5117.0	252.94	1359.78	1359.78
5116.0	256.00	1375.66	1375.66
5115.0	259.08	1391.63	1391.63
5114.0	262.18	1407.69	1407.69
5113.0	265.30	1423.84	1423.84
5112.0	268.44	1440.08	1440.08
5111.0	271.60	1456.41	1456.41
5110.0	274.78	1472.83	1472.83
5109.0	277.98	1489.34	1489.34
5108.0	281.20	1505.94	1505.94
5107.0	284.44	1522.63	1522.63
5106.0	287.70	1539.41	1539.41
5105.0	291.00	1556.28	1556.28
5104.0	294.32	1573.24	1573.24
5103.0	297.66	1590.29	1590.29
5102.0	301.02	1607.43	1607.43
5101.0	304.40	1624.66	1624.66
5100.0	307.80	1641.98	1641.98
5099.0	311.22	1659.39	1659.39
5098.0	314.66	1676.89	1676.89
5097.0	318.12	1694.48	1694.48
5096.0	321.60	1712.16	1712.16
5095.0	325.10	1729.93	1729.93
5094.0	328.62	1747.79	1747.79
5093.0	332.16	1765.74	1765.74
5092.0	335.72	1783.78	1783.78
5091.0	339.30	1801.91	1801.91
5090.0	342.90	1820.13	1820.13
5089.0	346.52	1838.44	1838.44
5088.0	350.16	1856.84	1856.84
5087.0	353.82	1875.33	1875.33
5086.0	357.50	1893.91	1893.91
5085.0	361.20	1912.58	1912.58
5084.0	364.92	1931.34	1931.34
5083.0	368.66	1950.19	1950.19
5082.0	372.42	1969.13	1969.13
5081.0	376.20	1988.16	1988.16
5080.0	380.00	2007.28	2007.28
5079.0	383.82	2026.49	2026.49
5078.0	387.66	2045.79	2045.79
5077.0	391.52	2065.18	2065.18
5076.0	395.40	2084.66	2084.66
5075.0	399.30	2104.23	2104.23
5074.0	403.22	2123.89	2123.89
5073.0	407.16	2143.64	2143.64
5072.0	411.12	2163.48	2163.48
5071.0	415.10	2183.41	2183.41
5070.0	419.10	2203.43	2203.43
5069.0	423.12	2223.54	2223.54
5068.0	427.16	2243.74	2243.74
5067.0	431.22	2264.03	2264.03
5066.0	435.30	2284.41	2284.41
5065.0	439.40	2304.88	2304.88
5064.0	443.52	2325.44	2325.44
5063.0	447.66	2346.09	2346.09
5062.0	451.82	2366.83	2366.83
5061.0	456.00	2387.66	2387.66
5060.0	460.20	2408.58	2408.58
5059.0	464.42	2429.59	2429.59
5058.0	468.66	2450.69	2450.69
5057.0	472.92	2471.88	

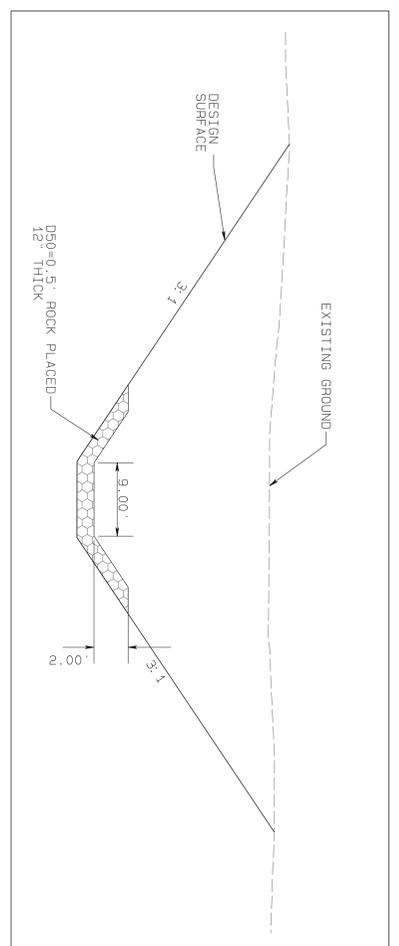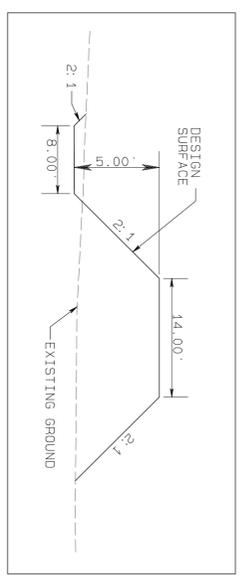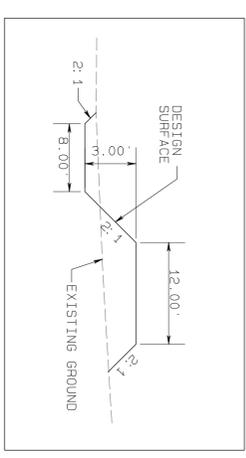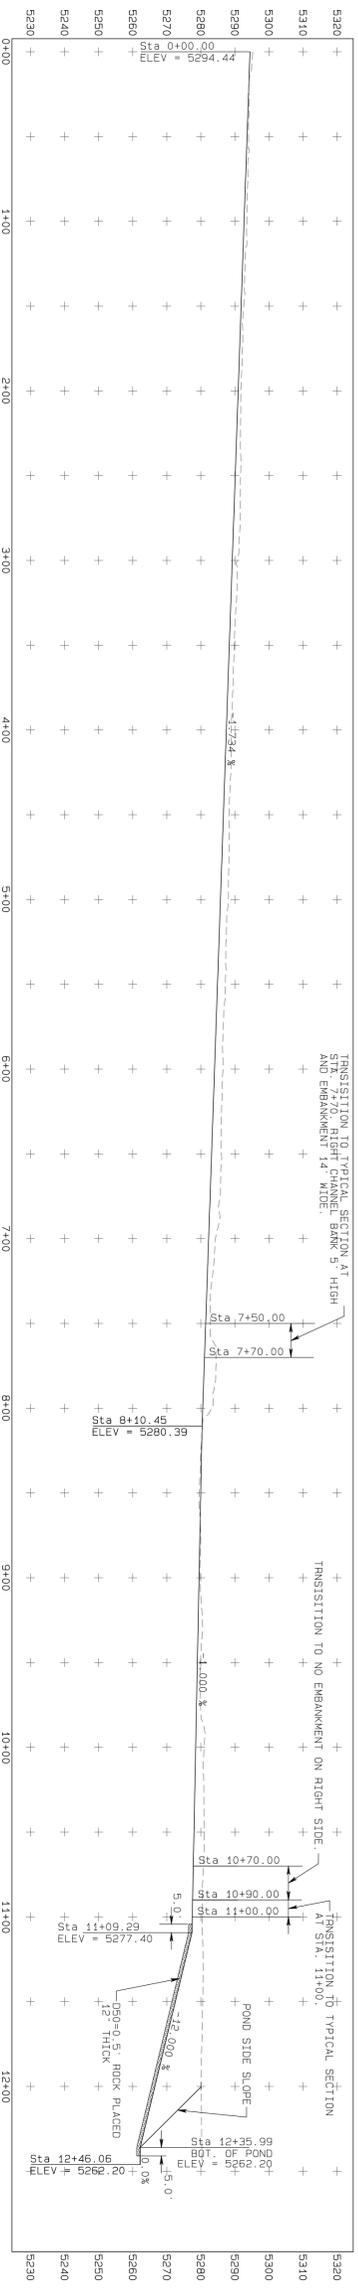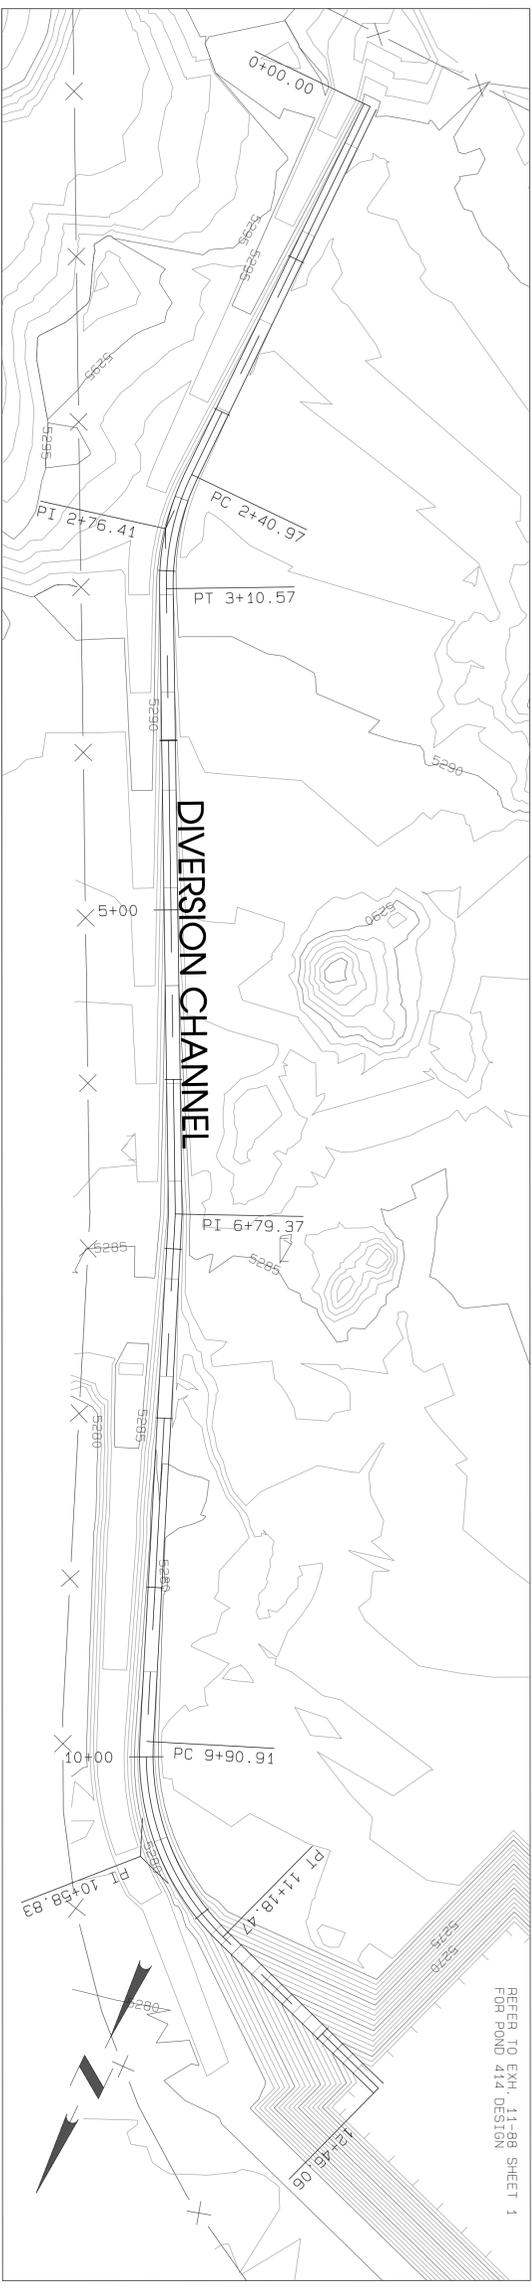

**LEGEND**

- ROAD
- CAULVERT
- DRAINAGE
- POWER LINE
- INDEX CONTOUR
- INTERMEDIATE CONTOUR
- L-30 LEASE CORNER
- PBM/L-30 LEASE BOUNDARY
- WATER LINE
- IRRIGATION LINE


- NOTES**
- For topographic information refer to adjacent design in the approved paper.
  - The waterpiped areas for the impoundments are shown on Exhibit 11-13E.

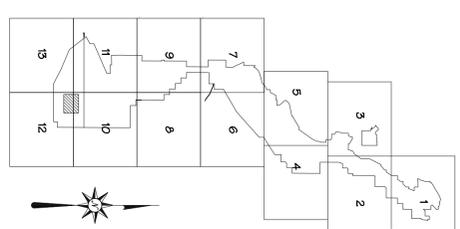


**CERTIFICATION STATEMENT**

I, Leonard Raymond, hereby certify that this drawing was reviewed by me and that the information shown is accurate and complete to the best of my knowledge.




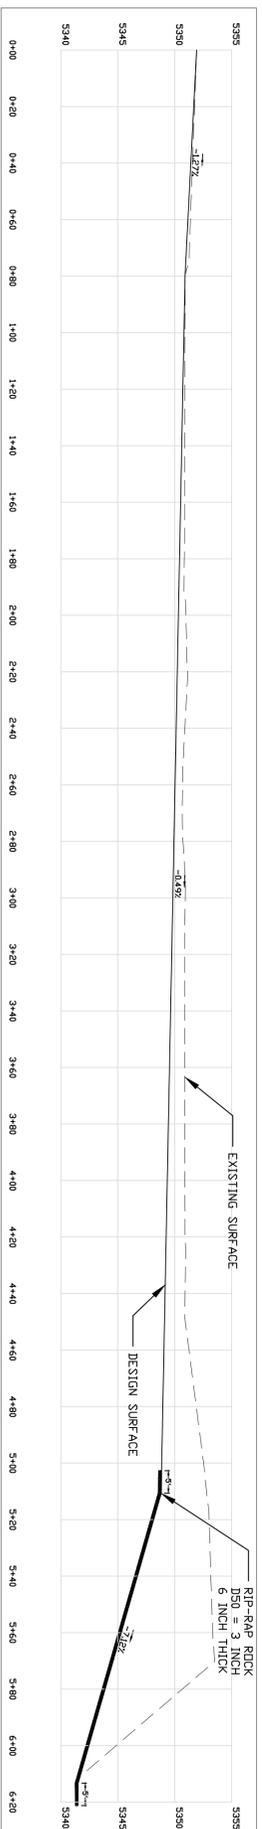


PROFILE VIEW - NORTH DRAINAGE  
STAT. 0+00 TO 6+16.53  
SCALE 1" = 30.77'

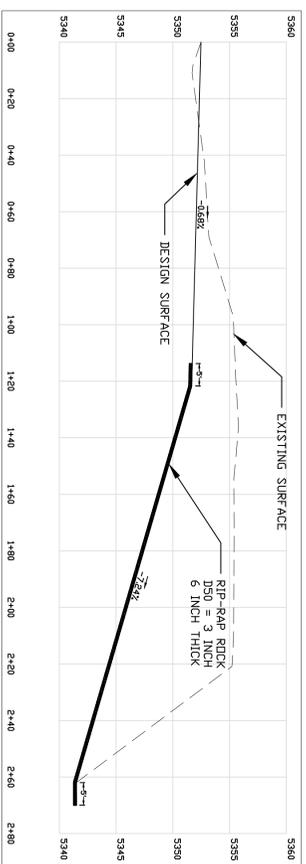


PROFILE VIEW - SOUTH DRAINAGE  
STAT. 0+00 TO 2+62.52  
1" = 30.77'

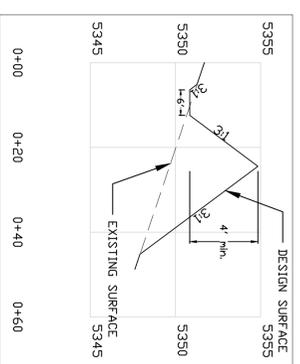


TYPICAL SECTION CC - NORTH DRAINAGE  
STAT. 0+00 TO 5+20  
NTS

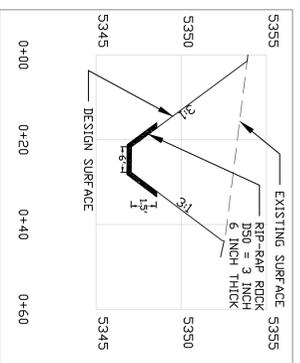


TYPICAL SECTION DD - NORTH DRAINAGE  
STAT. 5+20 TO 6+16.53  
NTS

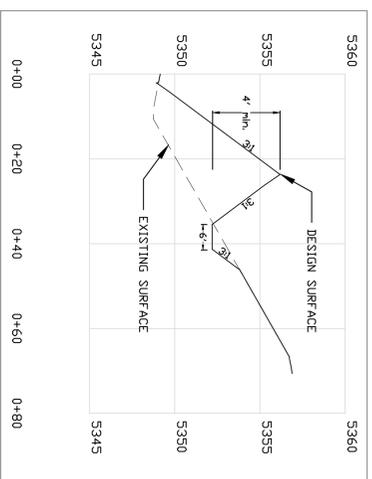


TYPICAL SECTION AA - SOUTH DRAINAGE  
STAT. 0+00 TO 1+40  
NTS

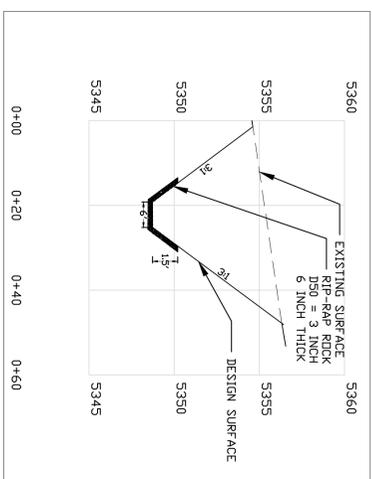


TYPICAL SECTION BB - SOUTH DRAINAGE  
STAT. 1+40 TO 2+62.52  
NTS

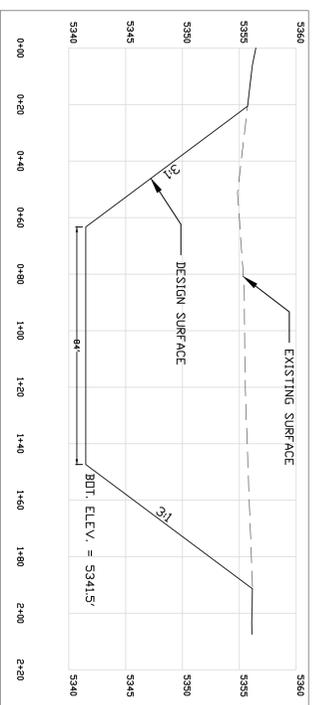


TYPICAL SECTION EE - POND 201 NORTH TO SOUTH  
NTS

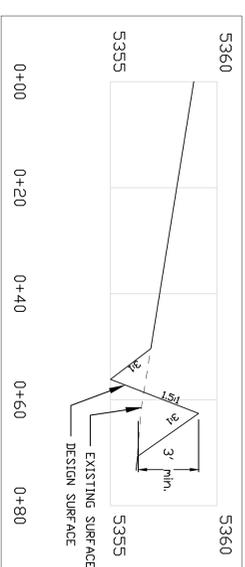

TYPICAL SECTION GG - BERM  
NTS

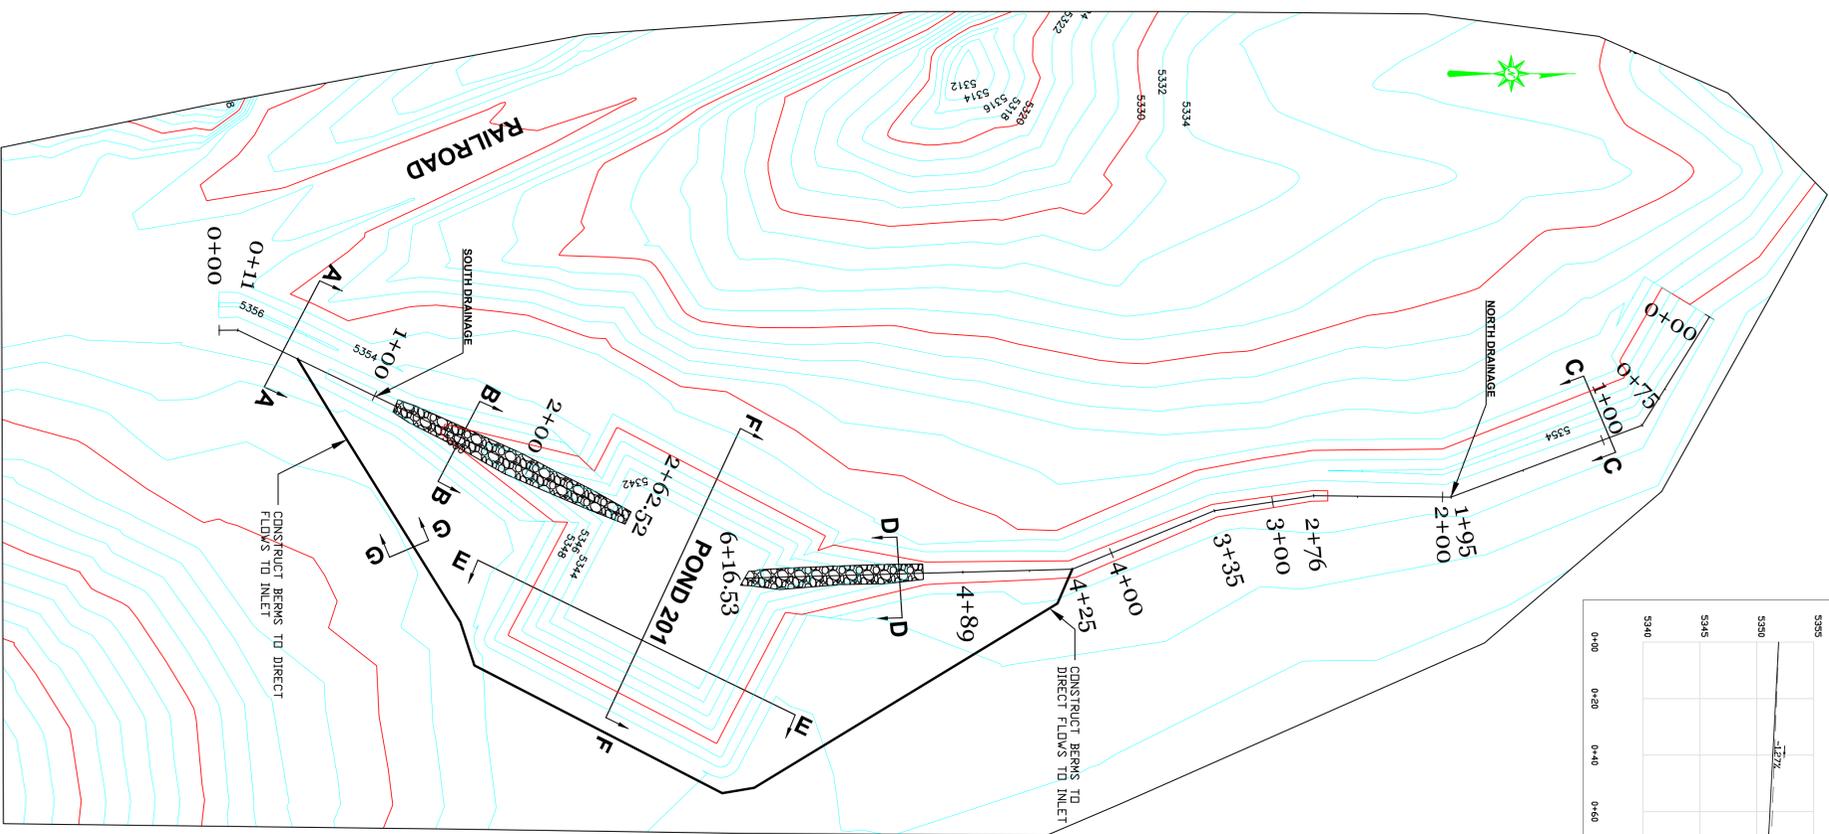


PLAN VIEW  
SCALE 1" = 50'

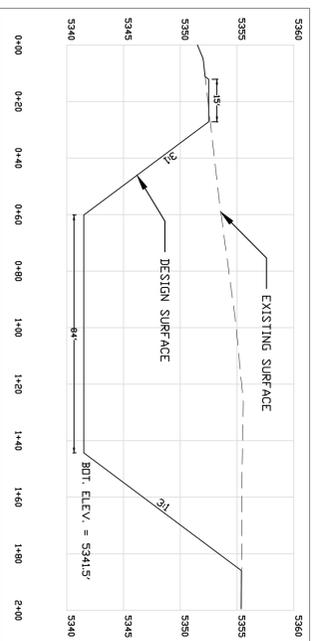

TYPICAL SECTION FF - POND 201 EAST TO WEST  
NTS


**POND 201  
STAGE STORAGE DATA**

ELEV. (FT)	AREA (AC)	INC. VOL. (AC-FT)	ACCUM. VOL. (AC-FT)
5341.5	7.568.8	0.17	0
5342	8.097.9	0.19	0.09
5343	9.227.5	0.21	0.29
5344	10.441.4	0.24	0.51
5345	11.740.8	0.27	0.77
5346	13.045.5	0.30	1.05
5347	14.429.9	0.33	1.37
5348	15.912.5	0.37	1.72
5349	17.466.6	0.40	2.10
5350	19.098.7	0.44	2.52
5351	20.808.8	0.48	2.98
5352	22.642.1	0.52	3.48

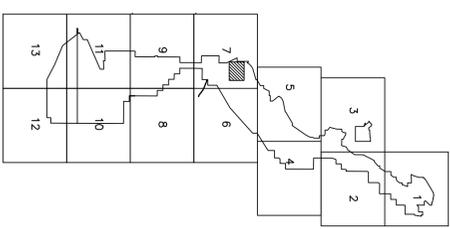

- NOTES:
- FOR HYDROLOGY INFORMATION REFER TO APPENDIX A IN THE APPROPRIATE PAR.
  - THE WATERSHED FOR POND 201 IS SHOWN IN 11-13D

CERTIFICATION STATEMENT  
I, Leonard Raymond, hereby certify that this drawing was prepared by me or under my direct supervision and that I am a duly Licensed Professional Engineer in the State of New Mexico.

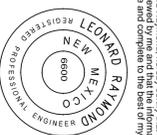

PROJECT:	Area 2 Pond 201	PROJECT MANAGER:	Ramsey R. Yazzie	REVISION	DATE
DATE:	03-01-13	ENGR. of RECORD:	Leonard Raymond	134	03/12/2013
DESIGNED BY:	Ramsey R. Yazzie	REG. NO.:	NM_6600	SUBMITTED TO OSM FOR REVIEW AND APPROVAL	
DRAWN BY:	Ramsey R. Yazzie	SRVYR. of RECORD:	Wilson Begay		
CHECKED BY:	L. Raymond	REG. NO.:	NM_16628		
APPROVED BY:	L. Raymond				



BHP NAVAJO COAL COMPANY  
NAVAJO MINE


PO BOX 1717, FRUITLAND, NEW MEXICO, 87416 / PHONE 505-598-4200 / FAX 505-598-3361

PLAN, PROFILES  
AND SECTIONS


EXHIBIT 26-87  
AREA 2  
POND 201  
DESIGN

DRAWING


SHEET 1  
OF 1

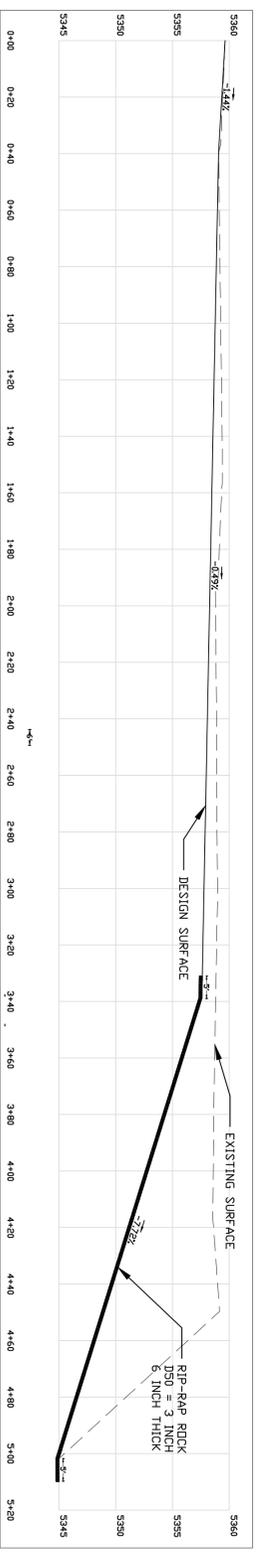


PROFILE VIEW - NORTH DRAINAGE  
STAT. 0+00 TO 5+05.85  
SCALE 1" = 30.77'

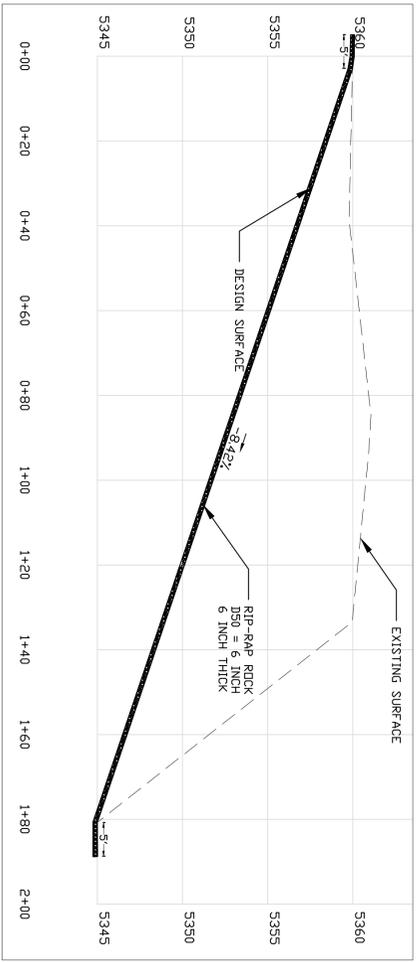


PROFILE VIEW - EAST DRAINAGE  
STAT. 0+00 TO 1+71.99  
1" = 20'

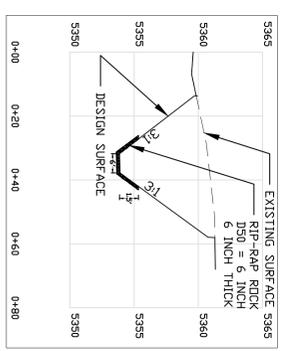


TYPICAL SECTION HH - EAST DRAINAGE  
STAT. 0+00 TO 1+71.99  
NTS

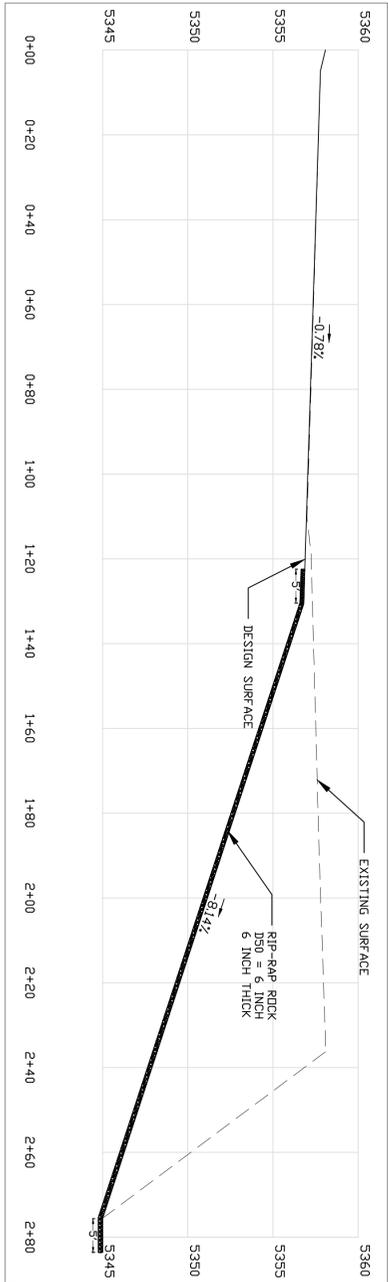


PROFILE VIEW - SOUTH DRAINAGE  
STAT. 0+00 TO 2+76.63  
1" = 20'

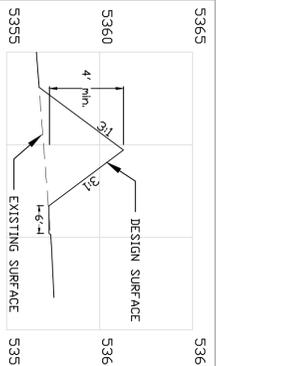


TYPICAL SECTION KK - SOUTH DRAINAGE  
STAT. 0+00 TO 1+90  
NTS

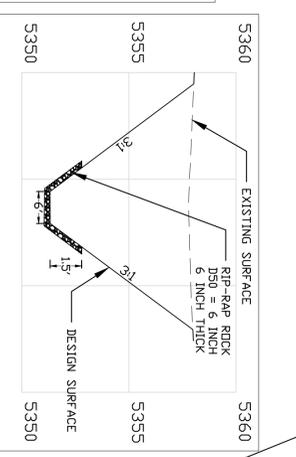


TYPICAL SECTION LL - SOUTH DRAINAGE  
STAT. 1+90 TO 2+76.63  
NTS

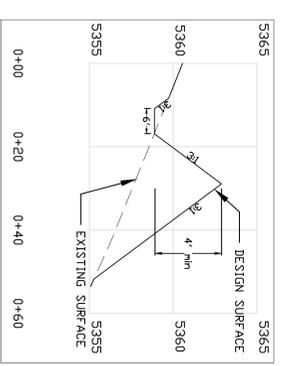


TYPICAL SECTION II - NORTH DRAINAGE  
STAT. 0+00 TO 4+20  
NTS

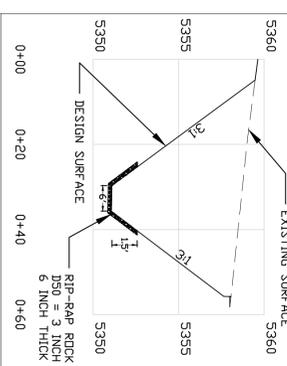


TYPICAL SECTION JJ - NORTH DRAINAGE  
STAT. 4+20 TO 5+05.85  
NTS

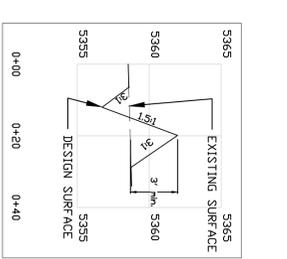


TYPICAL SECTION MM - BERM  
NTS

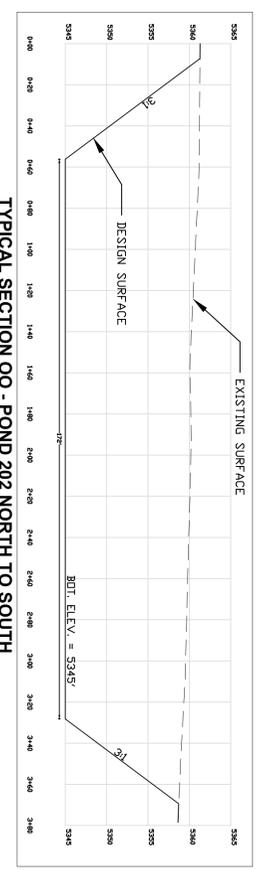


TYPICAL SECTION OO - POND 202 NORTH TO SOUTH  
NTS

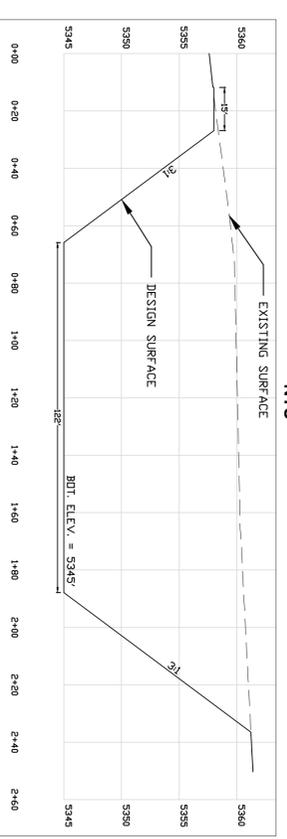

TYPICAL SECTION NN - POND 202 EAST TO WEST  
NTS

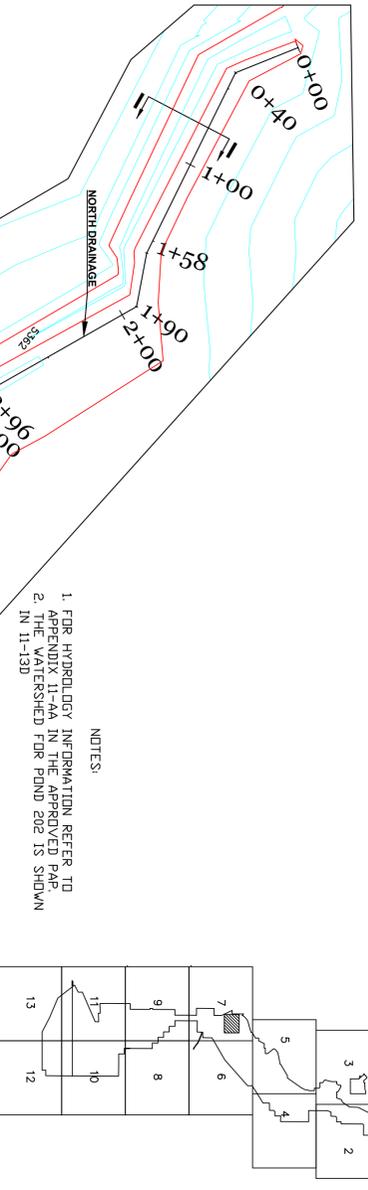

- NOTES:
1. FOR HYDROLOGY INFORMATION, REFER TO APPENDIX II-A IN THE APPROVED PAP.
  2. THE WATERSHED FOR POND 202 IS SHOWN IN 11-13D

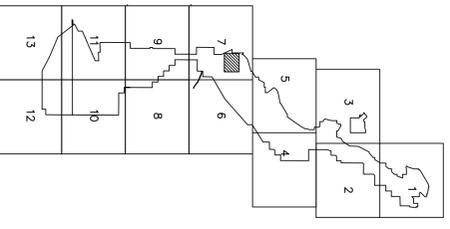

STAGE STORAGE DATA

ELEV. (FT)	AREA (FT <sup>2</sup> )	AREA (AC)	INC. VOL. (AC-FT)	ACCU. VOL. (AC-FT)
5345	33,183.4	0.76	0	0
5346	36,583.4	0.82	0.79	0.79
5347	38,055.4	0.87	0.85	1.63
5348	40,599.4	0.93	0.90	2.54
5349	43,215.3	0.99	0.96	3.50
5350	45,903.3	1.05	1.02	4.52
5351	48,663.3	1.12	1.09	5.61
5352	51,495.3	1.18	1.15	6.76
5353	54,399.3	1.25	1.22	7.97
5354	57,375.2	1.32	1.28	9.26
5355	60,423.2	1.39	1.35	10.61
5356	63,543.2	1.46	1.42	12.03
5357	66,735.2	1.53	1.50	13.53
5358	69,999.7	1.61	1.57	15.10

PLAN VIEW  
SCALE 1" = 50'

CERTIFICATION STATEMENT  
I, Leonard Raymond, hereby certify that this drawing was prepared by me or under my direct supervision and completed to the best of my knowledge.




EXHIBIT 26-88  
AREA 2  
POND 202  
DESIGN

PLAN, PROFILES  
AND SECTIONS





**bhpbilliton**  
BHP NAVAJO COAL COMPANY  
NAVAJO MINE

PROJECT:	Area 2 Pond 202	PROJECT MANAGER:	Ramsey R. Yazzie	REVISION	Rev	DATE
DATE:	03-01-13	ENGR. of RECORD:	Leonard Raymond	13A	RY	03/12/2013
DESIGNED BY:	Ramsey R. Yazzie	REG. NO.:	NM_6800			
DRAWN BY:	Ramsey R. Yazzie	SRVYR. of RECORD:	Wilson Begay			
CHECKED BY:	L. Raymond	REG. NO.:	NM_18628			
APPROVED BY:	L. Raymond					



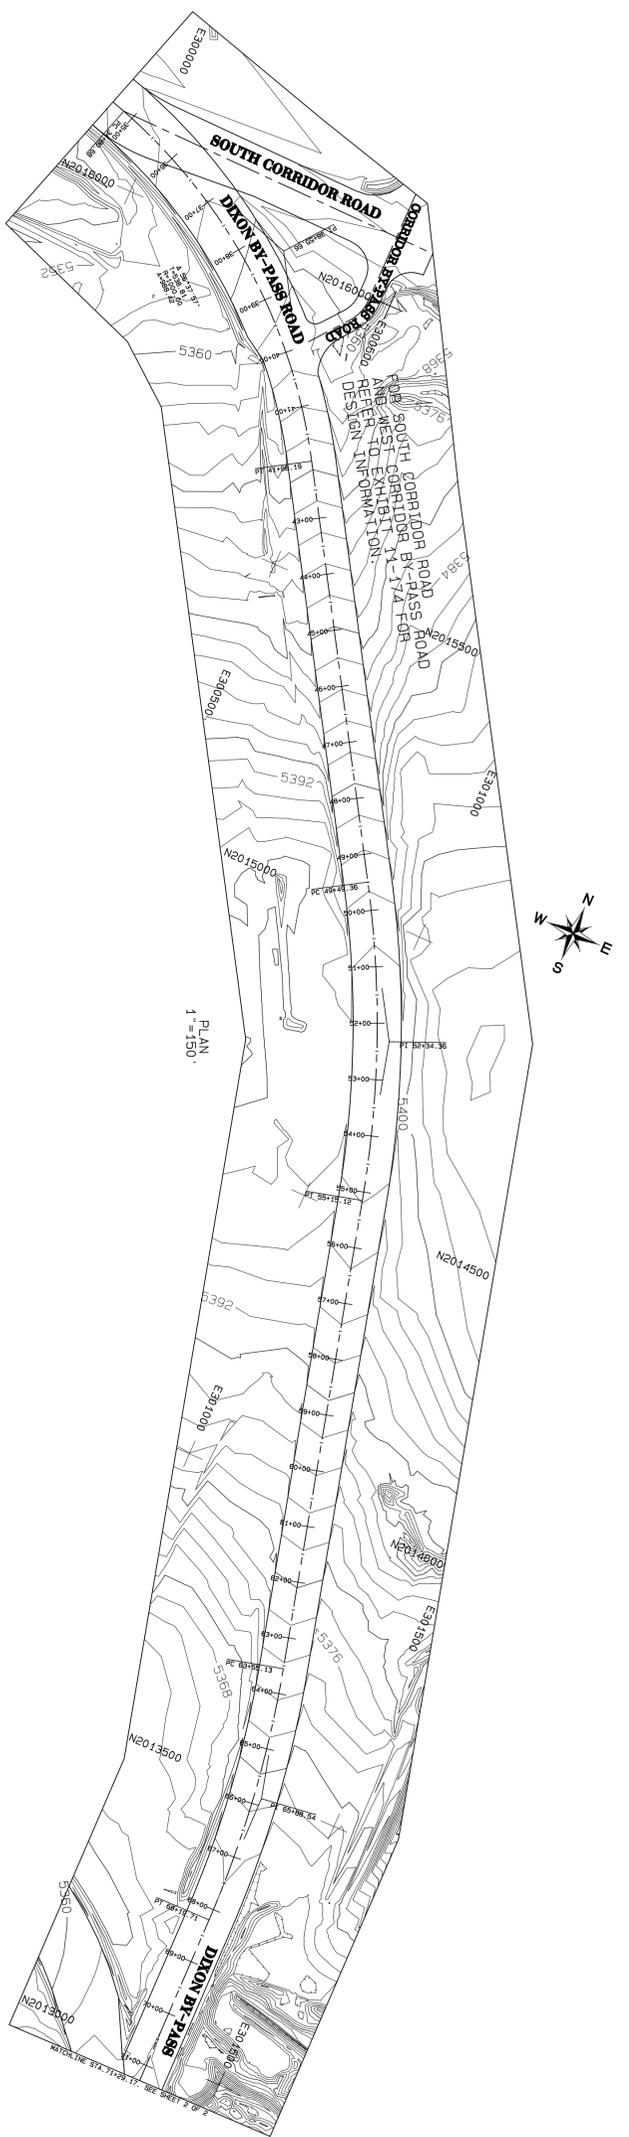

- LEGEND**
- ROAD
  - CULVERT
  - DRAINAGE
  - POWER LINE
  - INDEX CONTOUR
  - INTERMEDIATE CONTOUR
  - LEASE CORNER
  - PERMIT/LEASE BOUNDARY
  - WATER LINE
  - IRRIGATION LINE
- NOTES**
1. For hydrology and design information refer to Appendix 11 in the approved P&P.
  2. The watershed areas for culverts are shown on Exhibit 11-12E.

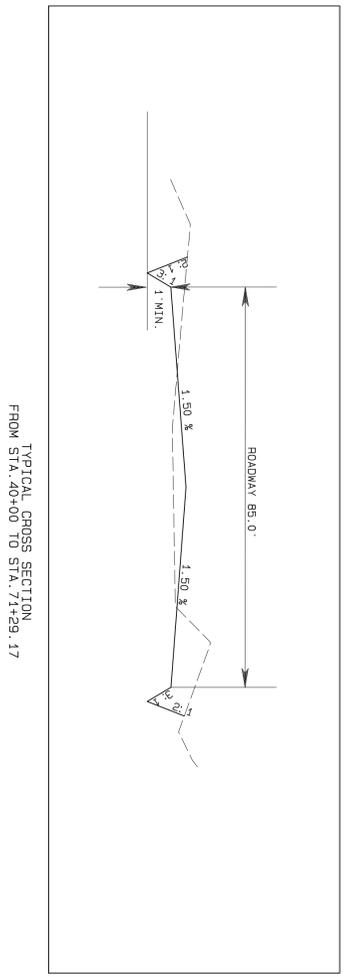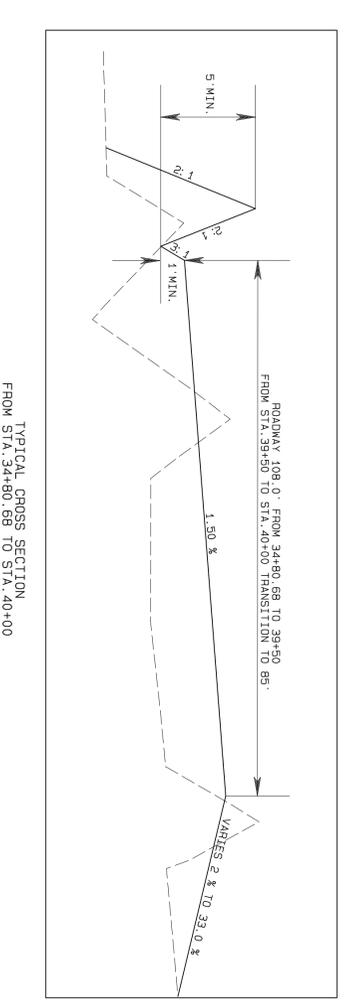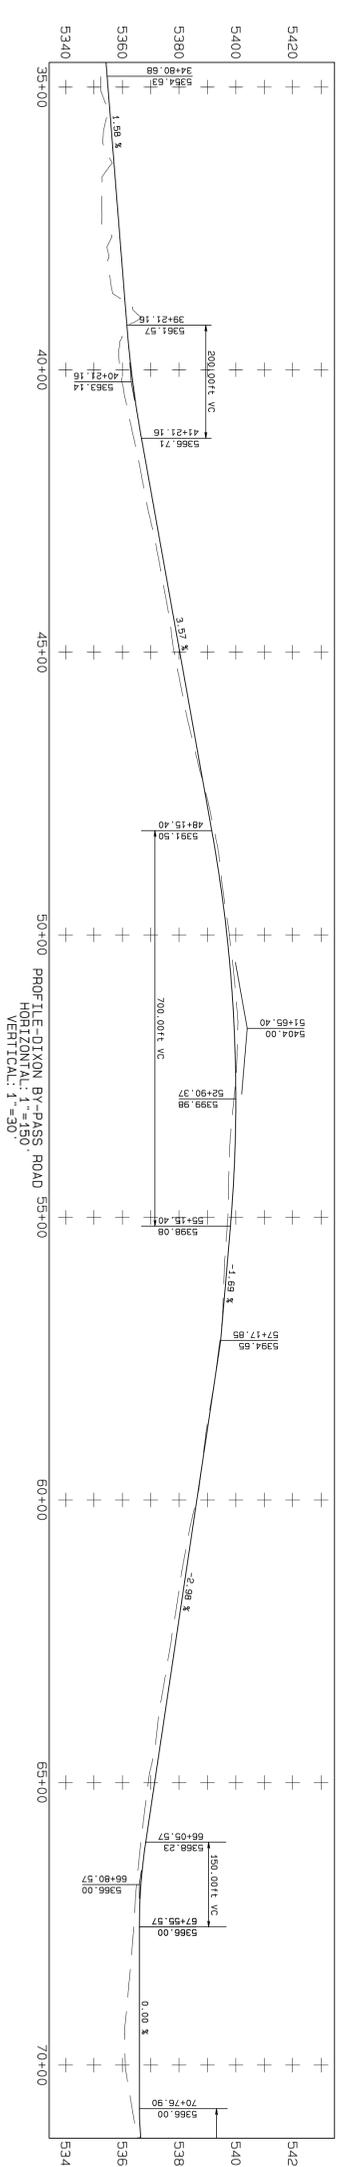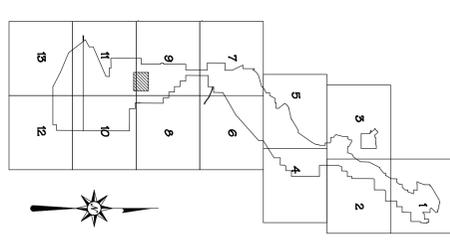

**CERTIFICATION STATEMENT**

I, Leonard Raymond, hereby certify that this drawing was reviewed by me and that the information shown is accurate and complete to the best of my knowledge.



**EXHIBIT 26-90**  
**DIXON BY-PASS ROAD**  
**DESIGN**

**PLAN, PROFILE AND SECTIONS**







PROJECT: ROADS RE-ALIGNMENT  
DATE: 5-30-13  
DESIGN BY: RY  
DRAWN BY: RY  
CHECKED BY: LR  
APPROVED BY: LR

**bhpbilliton**  
**NAVAJO COAL COMPANY**  
**NAVAJO MINE**

PROJECT MANAGER:	ENGR. of RECORD:	REV. NO.:	SRVYR of RECORD:	REV. NO.:	REVISION	DATE
J.S	LR	6600			Submitted to OSM for Approval	05-30-13

SHEET 1 OF 2



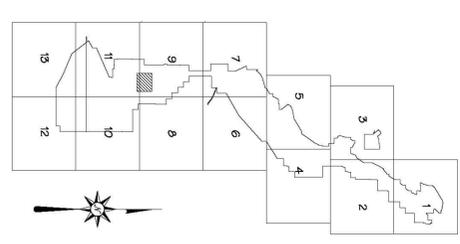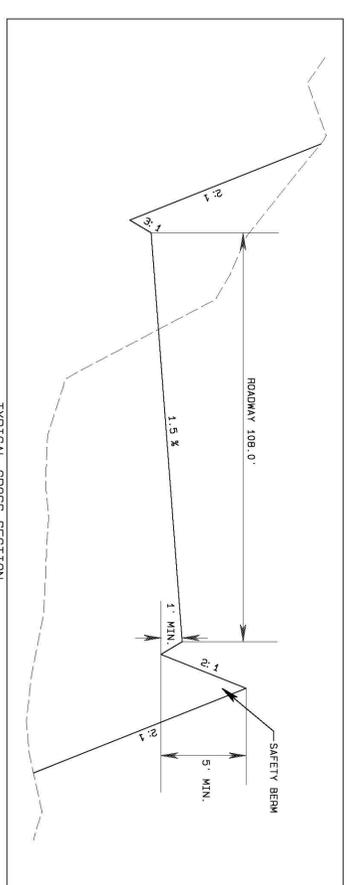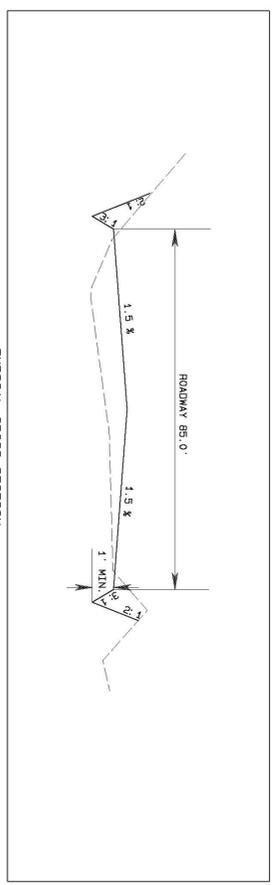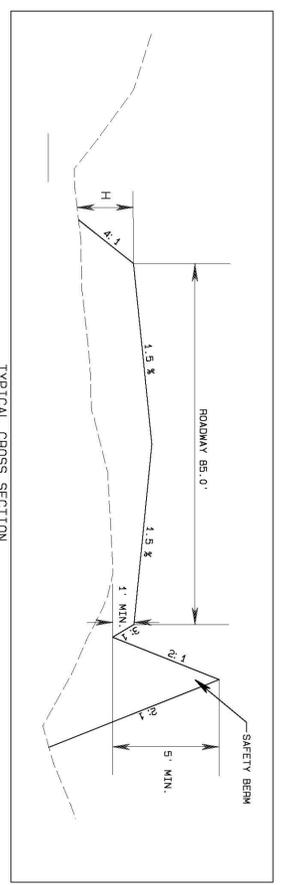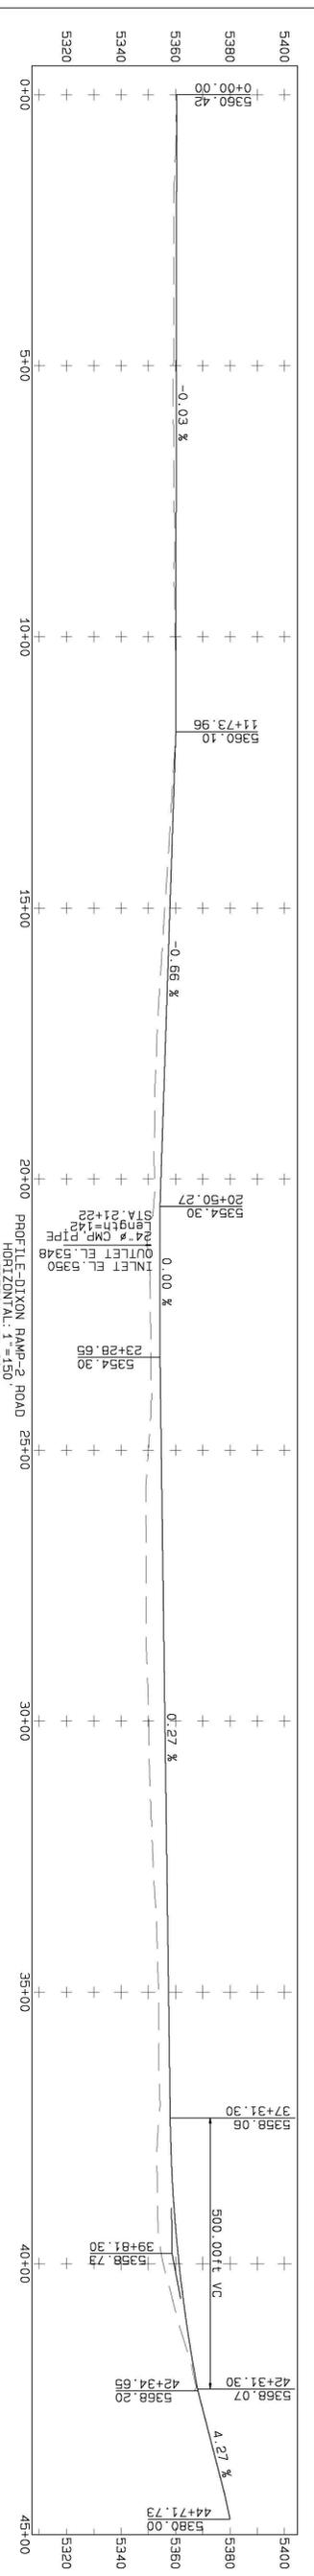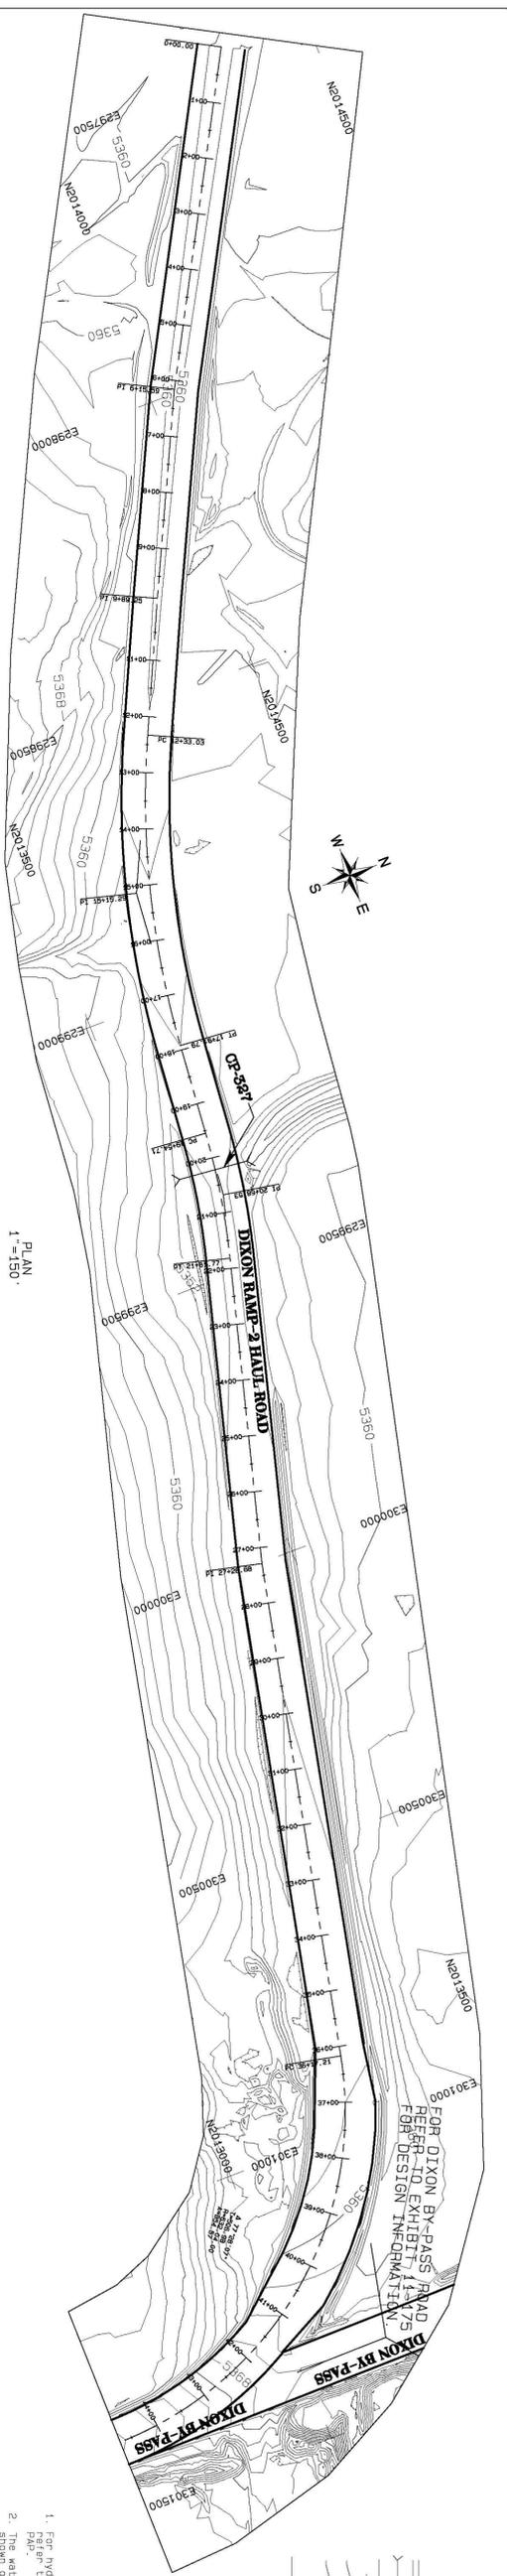

**NOTES**

1. For hydrology and design information refer to Appendix 11.9 in the approved P&I.
2. The watered areas for culverts are shown on Exhibit 11-12E.

H ≤ 4.0' SIDE SLOPE = 4:1  
H > 4.0' SIDE SLOPE = 2:1 WITH SAFETY BERM

**CERTIFICATION STATEMENT**

I, Leonard Raymond, hereby certify that this drawing was reviewed by me and that the information shown is accurate and complete to the best of my knowledge.



PROJECT: ROADS RE-ALIGNMENT  
DATE: 5-30-13  
DESIGN BY: RY  
DRAWN BY: RY  
CHECKED BY: LR  
APPROVED BY: LR

**bhpbilliton**  
**NAVAJO COAL COMPANY**  
**NAVAJO MINE**

REVISION	DATE
12-A Submitted to OSM for Approval	05-30-13
ENGR. of RECORD: LR	
REG. NO: 6600	
SRVIR of RECORD:	
REG. NO:	

**EXHIBIT 26-91**  
**DIXON RAMP-2 HAUL ROAD**  
**DESIGN**


SHEET 1 OF 1

**PLAN, PROFILE AND SECTIONS**


PO BOX 1717, FRUITLAND, NEW MEXICO, 87416 PHONE 505-598-3209/FAX 505-598-3361





PLAN VIEW  
SCALE: 1"=100'

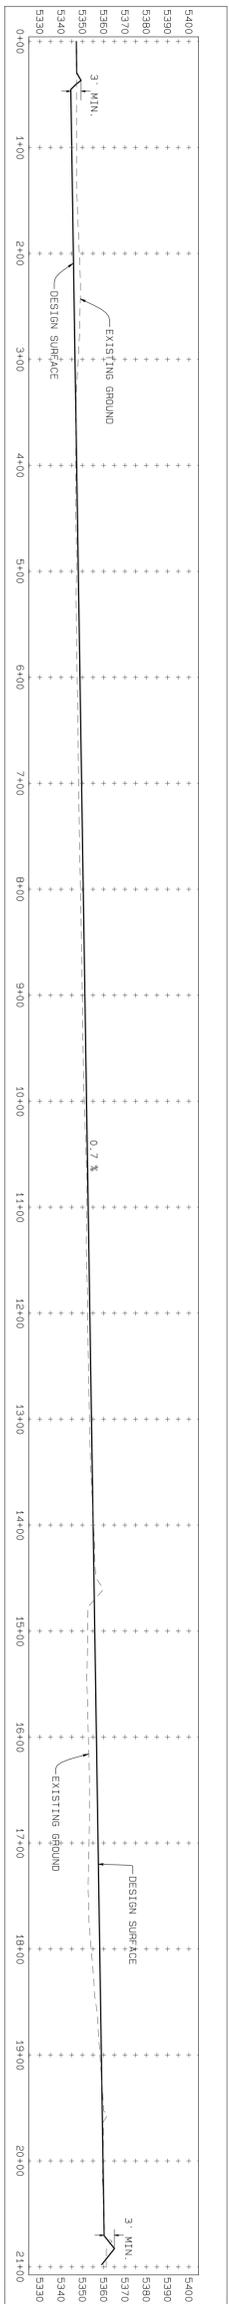

PROFILE A-A'  
HORIZONTAL: 1"=80'  
VERTICAL: 1"=40'

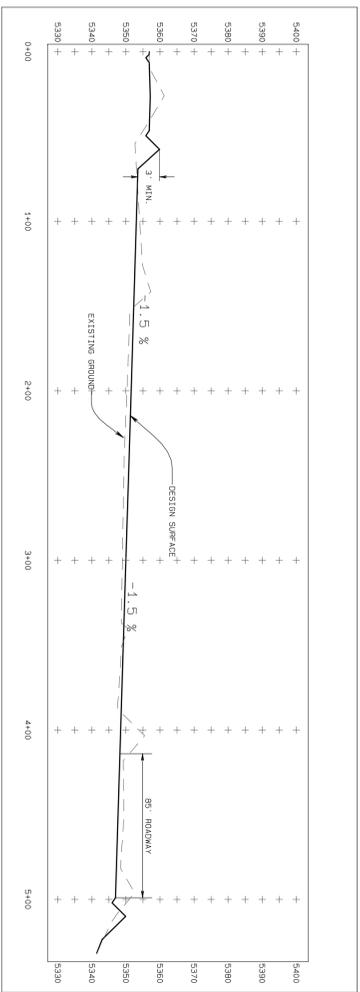

CROSS SECTION B-B'  
HORIZONTAL: 1"=50'  
VERTICAL: 1"=25'

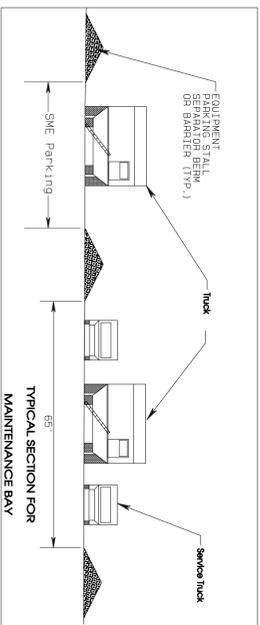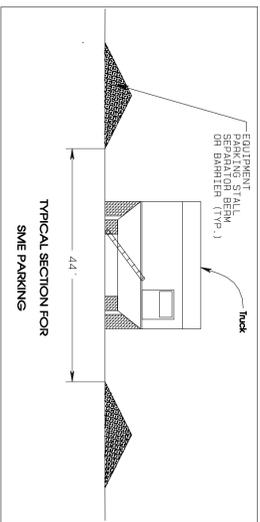


LEGEND

- ROAD
- DRAINAGE
- POWELL LINE
- INDEX CONTOUR
- LEASE CORNER
- INTERMEDIATE CORNER
- RENT/LEASE BOUNDARY
- MATERIAL LINE
- IRRIGATION LINE

NOTES

1. For North & South Corridor Road and West Corridor By-Pass Road refer to Exhibit 11-174 for Design Information.
2. For Dixon By-Pass Road, refer to Exhibit 11-175 for Design Information.

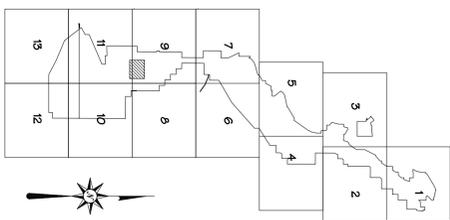

**CERTIFICATION STATEMENT**  
I, Leonard Raymond, hereby certify that this drawing was reviewed by me and that the information shown is accurate and complete to the best of my knowledge.




**EXHIBIT 26-92**  
**CORRIDOR READY LINE**  
**DESIGN**

**PLAN, PROFILE AND**  
**SECTIONS**

PROJECT: AREA 3 CORRIDOR READY LINE  
DATE: 5-30-13  
DESIGN BY: RY  
DRAWN BY: PUF  
CHECKED BY: LR  
APPROVED BY: LR

**bhpbilliton**  
**NAVAJO COAL COMPANY**  
**NAVAJO MINE**

PROJECT MANAGER:	J.S	REVISION	DATE
ENGR. of RECORD:	LR	13-A Submitted to GSM for Approval	05-30-13
REG. NO:	6600	13-B BY DISCUSSION AND SUBMITTED TO GSM FOR APPROVAL	08-09-13
SRVYR. of RECORD:			
REG. NO:			

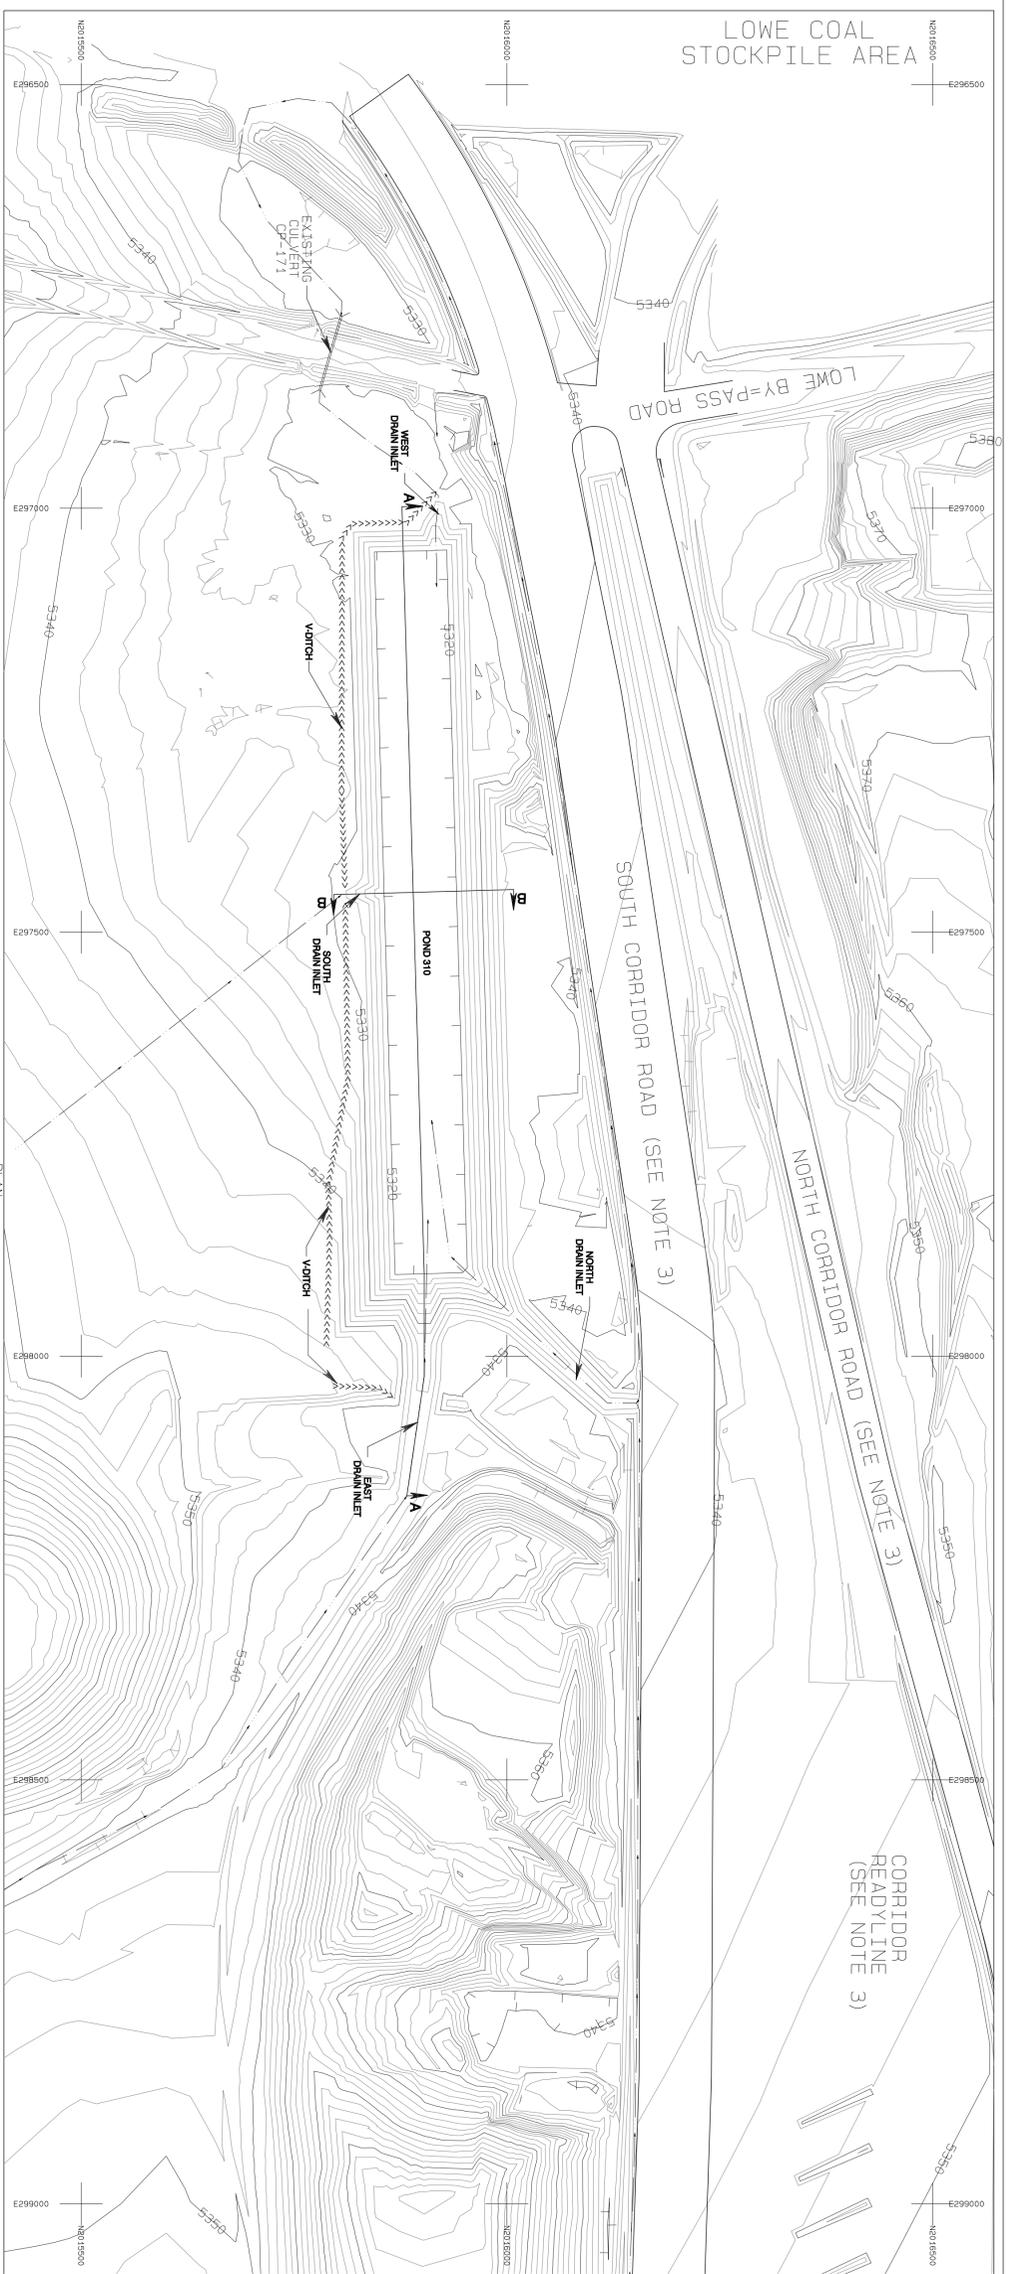

**LEGEND**

- ROAD
- DRAINAGE
- POWERLINE
- INDEX CORRIDOR
- INTERMEDIATE CORRIDOR
- PERMIT/LEASE BOUNDARY
- MATERIAL LINE
- IRIGATION LINE

**NOTES**



- For hydrology and design information refer to Appendix A and B.
- The watershed area for ponds are shown on Exhibit 11-13E.
- For Corridor Ready-Line, refer to Exhibit 11-17 and Top North and South Corridor Road Refer to Exhibit 11-17A for design information.

**CERTIFICATION STATEMENT**

I, Leonard Raymond, hereby certify that this drawing was reviewed by me and that the information shown is accurate and complete to the best of my knowledge.

**CERTIFICATION STATEMENT**


I, Leonard Raymond, hereby certify that this drawing was reviewed by me and that the information shown is accurate and complete to the best of my knowledge.

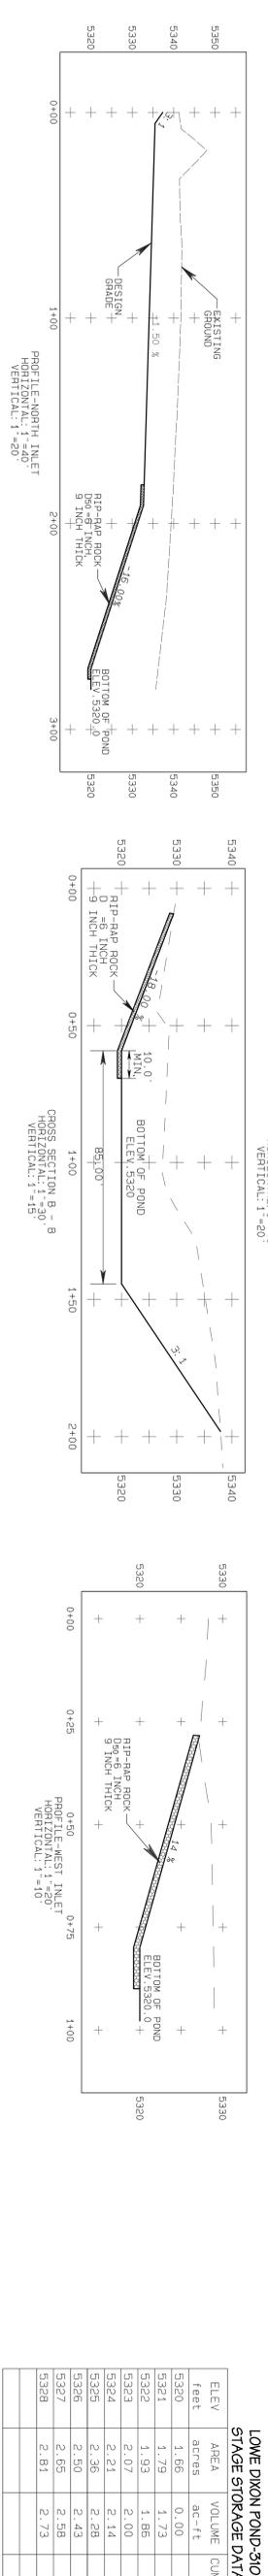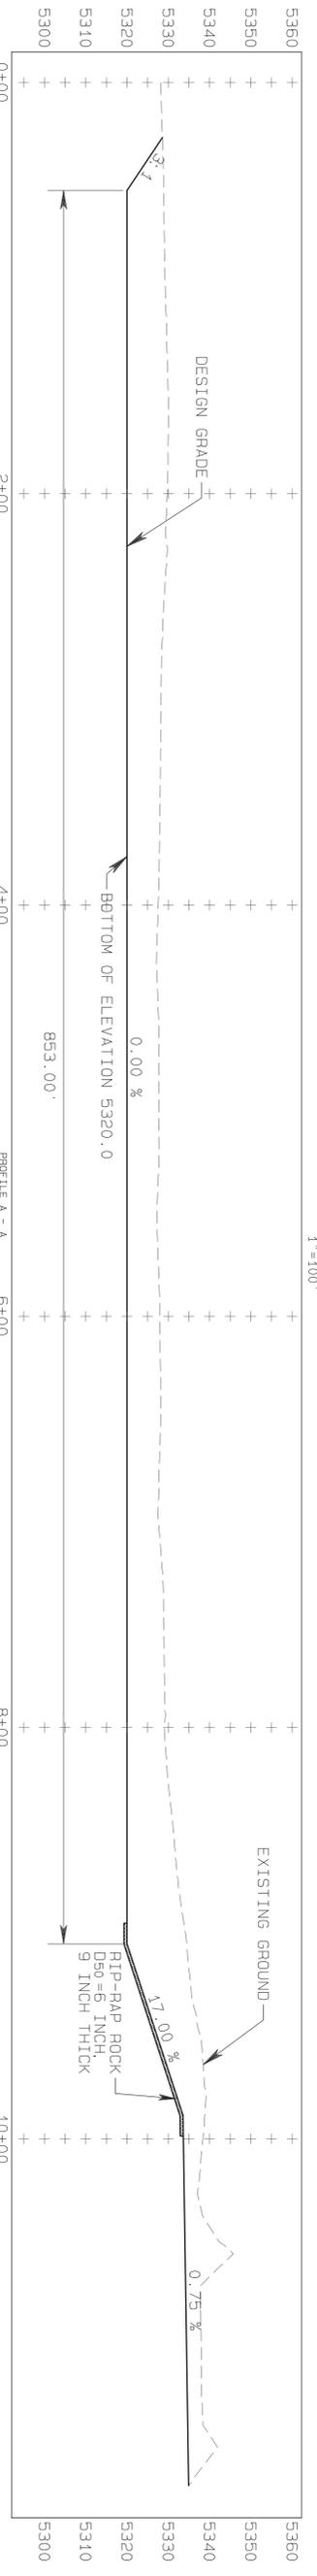

**LOWE COAL POND-310**

**STAGE STORAGE DATA**


ELEV. feet	AREA acres	VOLUME cu-ft	CUM. VOLUME ac-ft
5320	1.66	0.00	0.00
5321	1.79	1.73	1.73
5322	1.93	1.86	3.59
5323	2.07	2.00	5.59
5324	2.21	2.14	7.73
5325	2.36	2.28	10.01
5326	2.50	2.43	12.44
5327	2.65	2.58	15.02
5328	2.81	2.73	17.75

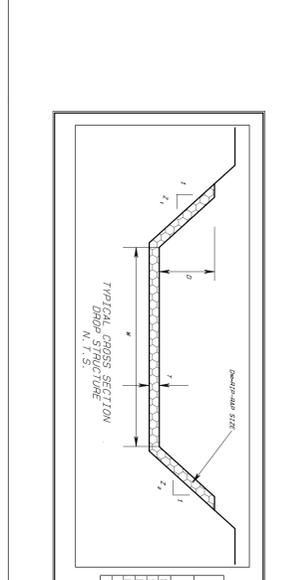

**CROSS SECTION OF POND INLETS**

**SEDIMENT/SPILLWAYS COMMON STRUCTURE SCHEDULE**

Structure ID	Structure Type	WD	CD	T	Z	Open	T
1	NORTH DRAIN INLET	Rip-rap rock 9 inch thick	8	2	3	3	6
2	SOUTH DRAIN INLET	Rip-rap rock 9 inch thick	8	2	3	3	6
3	WEST DRAIN INLET	Rip-rap rock 9 inch thick	8	2	3	3	6
4	EAST DRAIN INLET	Rip-rap rock 9 inch thick	8	2	3	3	6

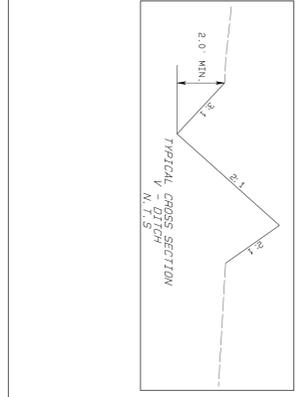

**EXHIBIT 26-93**

**POND 310 DESIGN**

**PLAN, PROFILE AND SECTIONS**

**PROJECT: ROADS RE-ALIGNMENT**


**DATE: 5-30-13**

**DESIGN BY: RY**


**DRAWN BY: RY**

**CHECKED BY: LR**


**APPROVED BY: LR**

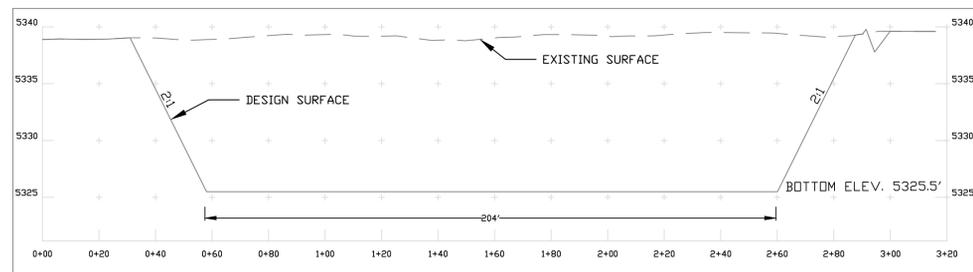


**TYPICAL SECTION A-A**  
HORIZ.: 1" = 30' VERT.: 1" = 5'

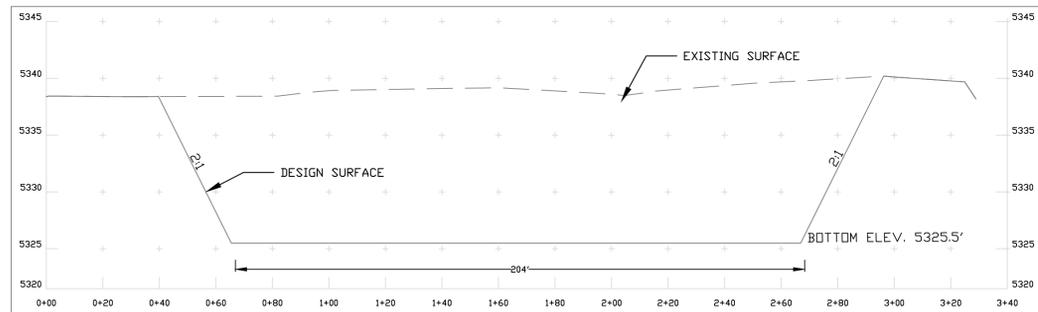


**TYPICAL SECTION B-B**  
HORIZ.: 1" = 30' VERT.: 1" = 5'

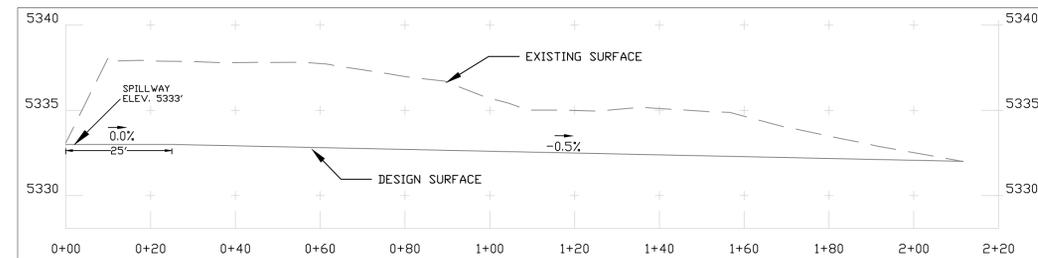


**PROFILE VIEW - SPILLWAY**  
STAT. 0+00 to 2+11.66  
HORIZ.: 1" = 20' VERT.: 1" = 5'

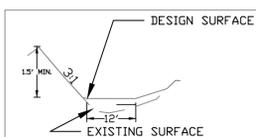


**TYPICAL SECTION C-C**  
STAT. 0+00 to 1+74.08  
NTS

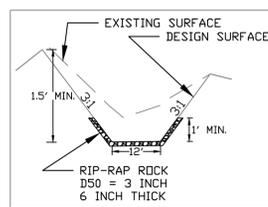

**TYPICAL SECTION D-D**  
STAT. 1+74.08 to 2+19.25  
NTS

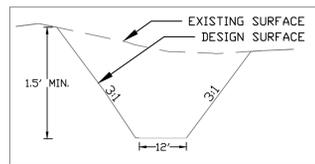

**TYPICAL SECTION E-E**  
STAT. 2+19.25 to 4+11.47  
NTS

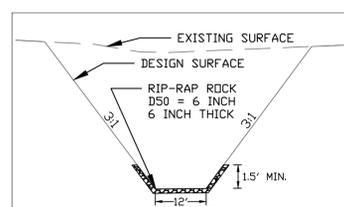


**TYPICAL SECTION F-F**  
STAT. 4+11.47 to 4+73.95  
NTS


**LOWE POND 311 STORAGE TABLE**

ELEV. (FT)	AREA (AC)	INC. VOL (AC-FT)	ACCU. M. VOL (AC-FT)
5325.5	0.93	0	0
5326	0.95	0.47	0.47
5327	0.99	0.97	1.45
5328	1.04	1.02	2.46
5329	1.08	1.06	3.52
5330	1.12	1.10	4.62
5331	1.18	1.15	5.77
5332	1.25	1.21	6.98
5333	1.37	1.31	8.30
5334	1.63	1.50	9.80
5335	1.98	1.80	11.60


SPILLWAY ELEV. 5,333'  
DESIGN STORM VDL. 6.9 AC. FT

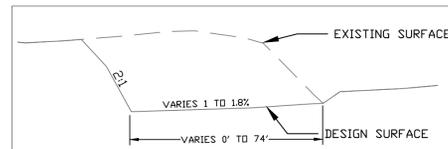


**TYPICAL SECTION G-G**  
HORIZ.: 1" = 20' VERT.: 1" = 5'

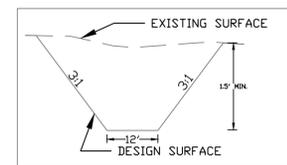


**TYPICAL SECTION H-H**  
NTS

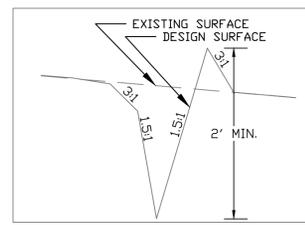

**TYPICAL SECTION I-I**  
NTS

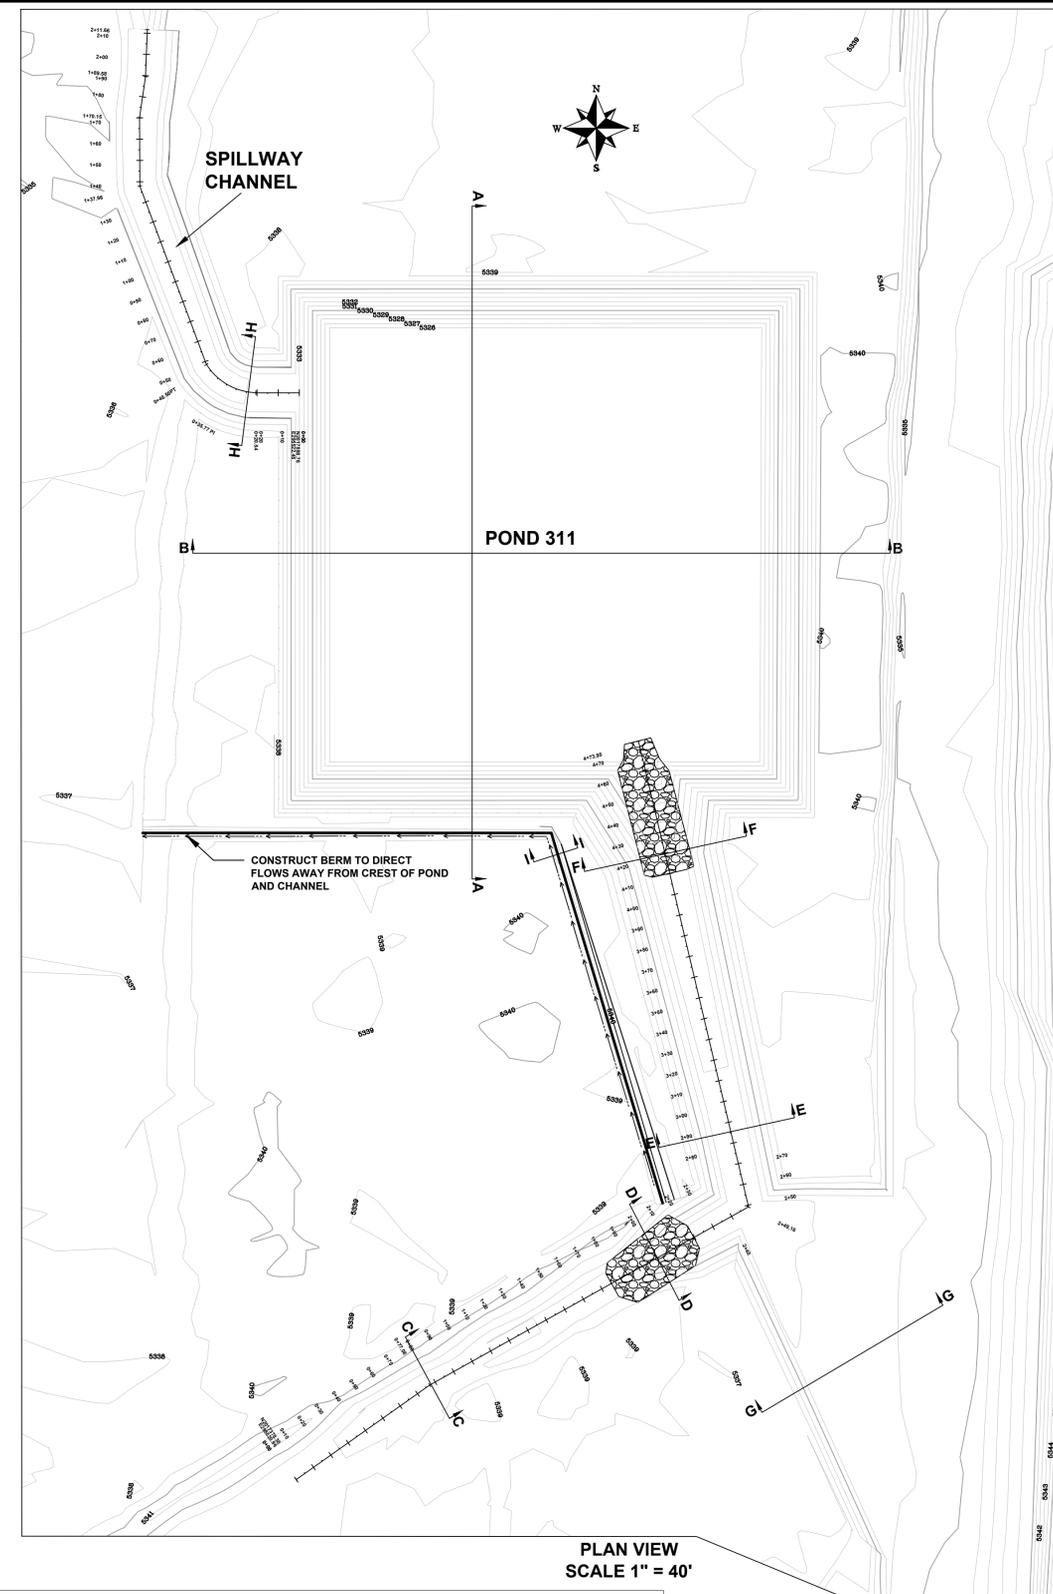


**PLAN VIEW**  
SCALE 1" = 40'

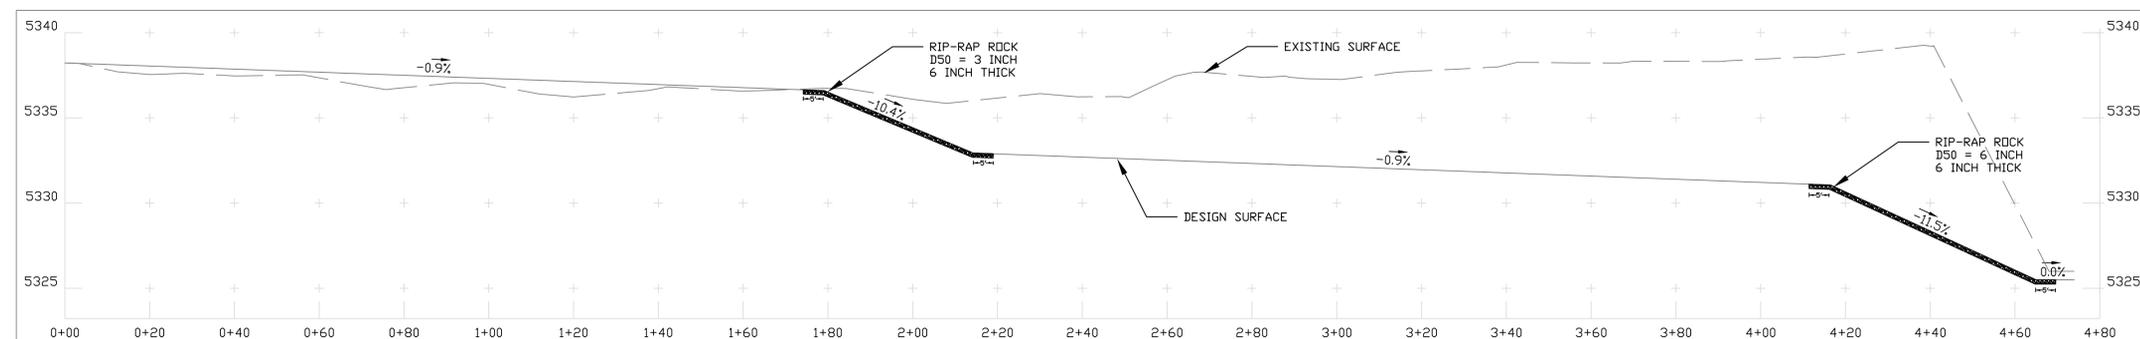

**PROFILE VIEW - SOUTH DRAINAGE**  
STAT. 0+00 to 4+73.95  
H. Scale: 1" = 20' V. Scale: 1" = 5'

**LEGEND**

- ROAD
- WATERSHED
- BUILDING
- FENCE
- IRRIGATION LINE
- CULVERT
- DAM
- DRAINAGE
- RAILROAD
- TREES
- POWERLINE
- SPOT ELEVATION
- INDEX CONTOUR
- INTERMEDIATE CONTOUR
- LEASE CORNER
- LEASE/PERMIT BOUNDARY

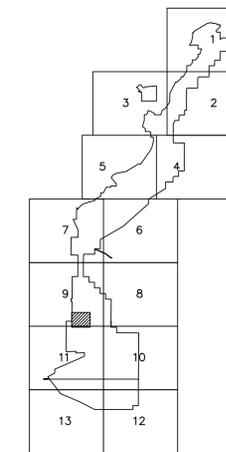

**NOTES:**

1. FOR HYDROLOGY INFORMATION REFER TO APPENDIX 11-AA IN THE APPROVED PAP.
2. THE WATERSHED FOR LOWE POND IS SHOWN IN EXHIBIT 11-13E

**CERTIFICATION STATEMENT**

I, Leonard Raymond, hereby certify that this drawing was reviewed by me and that the information shown is accurate and complete to the best of my knowledge.



NO.	DATE	BY	REVISION DESCRIPTION	TR	LR
13A	06/13/13	RRY	SUBMITTED TO DSH FOR REVIEW AND APPROVAL	TR	LR

**EXHIBIT 26-94**



**BHP Navajo Coal Company**

P.O. Box 1717  
Fruitland, New Mexico 87416  
Phone: 505-598-4200  
Fax: 505-568-3361

**POND 311**  
**PLAN, PROFILE,**  
**AND SECTION**

Prepared By: RRY  
Approved By: LR  
Drawn By: DESIGN  
Plot Date: 6/27/13  
Scale: VARIES  
Layout: 24X36\_LS

Drawing: Lowe Pond Design FINAL EXHIBIT DRAWINGS.dwg

## **Appendix 26.A**

Low Rail Embankments #2 Modification

---

Appendix 26.A

Low Railroad Embankment #2 Modification

Due to reformatting of the Navajo Mine PAP, the following references in this appendix have been changed, deleted or renumbered:

<u>NM-0003F Paper Reference</u>	<u>NM-0003F Electronic Permit</u>
Exhibit 11-13E	Exhibit 26-12
Exhibit 11-67	Exhibit 26-14
Exhibit 11-67A	Exhibit 26-15
Table 11-5Q	Table 26-5.11
Table 11-5R	Table 26-5.12
Appendix 11-AA	Appendix 26.C
Chapter 11 Section 11.5.4.2	Part 4 Section 26.2.1
Sediment Ponds	Sediment Ponds

# Lowe Railroad MSHA Impoundment

## **Background**

The Lowe Railroad MSHA Impoundment (MSHA ID No. 1211-NM-09-00097-01) is located immediately north of the Lowe Coal Stockpile in Area III, see Exhibit 11-13E. The impoundment was constructed in 1981 when the railroad was extended further south to facilitate mining operations. The impoundment's embankment has a maximum height of approximately 50 feet with side slopes of 1.5 horizontal to 1.0 vertical. The top width of the embankment is 35 feet. The maximum capacity of the impoundment is approximately 100 acre-feet.

Within the Lowe Railroad MSHA Impoundment watershed there are two smaller impoundments (Lowe Railroad Impoundments #1 and #2) and a topsoil stockpile (LWR1\_TS\_W), see Exhibit 11-67 and 11-67A, respectively. Both Lowe Railroad Impoundments #1 and #2 were designed as total containment structures, 100 year-6 hour storm event, therefore no spillway were required (30 CFR 816.49(a)(9)(ii)(B)) and will retain surface runoff and sediment generated from the areas disturbed by mining activities. In addition, the impoundments will keep the 100 year-6 hour flood from impacting the topsoil stockpile.

## **Hazard Classification**

In the event of a failure of the MSHA Impoundment Embankment, the potential for loss of life or significant property damage downstream is very low. There are no dwellings, public buildings, commercial buildings, or public transportation/utilities downstream of the MSHA Impoundment. Additionally, it will not constitute a hazard to mine employees and equipment since it is downstream of the active pit and reclamation activities. Lowe Railroad Impoundment would be classified as a low hazard dam.

Lowe Railroad Impoundments #1 and #2 were designed to safely retain the 100 year – 6 hour runoff of 6.87 and 6.55 acre-feet, respectively. The capacity of Impoundment #1 is 19.20 acre-feet and Impoundment #2 has a capacity of 18.37 acre-feet. Both structures will retain surface water runoff and sediment storage. Water and/or sediment level will be kept below the maximum permissible level, see NM-0003E Chapter 11 Sediment Ponds 11.5.4.2 for additional information on the maximum permissible level.

## **Watershed Area**

Lowe Railroad Impoundment #1 has a watershed of 105.73 acres. The watershed drainage is from the Lowe Coal Stockpile, overburden material adjacent to the Lowe bypass road, and part of the topsoil stockpile material. Impoundment #2 has a watershed of 133.27 acres. The drainage extends north to the mid point of the Neck Road, see Exhibit 11-13E for the watershed boundaries.

## **Design Criteria**

The design criteria and key assumptions made for the hydrology analysis for Lowe Railroad Impoundments #1 and #2, are as follows:

## **Lowe Railroad MSHA Impoundment**

1. The design storm event for both impoundments is 100 year-6 hour, see Appendix 11-AA for SedCad Modeling analysis.
2. The capacity to store runoff from a 100 year – 6 hour storm will be maintained at all times. Water and/or sediment will not be higher than the maximum permissible level see tables 11-5Q and 11-5R. This is the elevation at which the impoundment can no longer contain the designed storm event. If the water and/or sediment exceed the permissible level then it will either be pumped and/or cleaned to an acceptable elevation.
3. Since the railroad embankment has the potential to impound 100 acre-feet of water and is about 50 feet high the MSHA impoundment criteria is applicable as required by 30 CFR 77.216.

### **Stability Analysis**

The slope stability analysis for Lowe MSHA Impoundment was performed by Western Technologies, Incorporated located in Farmington, New Mexico. For more information, refer to the analysis report titled “Lowe Railroad Impoundment #1 – Stability Analysis”, can be found in this appendix. Note: Lowe Railroad MSHA Impoundment is referred to as Lowe Railroad Embankment #1 in the stability analysis report.

The static factors of safety for the upstream and downstream slopes of the railroad embankment are 3.1 and 3.7, respectively. This indicates that the railroad embankment is stable and meets the minimum safety factor of 1.5. Modifications to Impoundments #1 and #2 have not affected the stability of the Railroad embankment; therefore; the report is still valid.

### **Summary**

Low Railroad Impoundments #1 and #2 will safely retain the 100 year -6 hour storm event. If a storm exceeds the designed storm event, the railroad embankment has the potential to 100 acre-feet of water. Therefore, it is considered a MSHA Impoundment. The Railroad embankment meets the minimum static safety factor if such an event were to happen.

## **Lowe Railroad MSHA Impoundment**

### **Modifications**

April 2008 Impoundments #1 and #2 were both modified due to an OSM Notice of Violation, the berm breached on the topsoil stockpile and the 100 year-6 hour storm floodplain had the potential to impact the topsoil stockpile. The impoundments were redesigned to contain the 100 year- 6 hour storm event. The north embankment on Impoundment #1 was raised and the spillway on Impoundment #2 was closed. The western topsoil berm is now the railroad embankment. This will reduce the loss of topsoil in the event of a 100 year- 6 hour storm.

In 1995, Impoundment #2 was modified based on a September and October, 1994 OSM/AFO inspection. The inspection was an observance of seepage on the western boundary of the impoundment. BHP installed a 3 ½' spoil clay liner. The permeability of the spoil material was tested by AGRA Earth & Environment. Clay liner is shown on the as-built design, Exhibit 11-67A. For additional information see Lowe Railroad Embankment #2 Modification on the following page, this includes the permeability results.

NAVAJO MINE  
LOWE RAILROAD EMBANKMENT #2 MODIFICATION

BHP Minerals International Inc. is proposing to modify the Lowe Railroad Embankment #2 impoundment. This embankment is located along the railroad just north of Lowe Stockpile (also see EXHIBIT 11-13E, "Area III Impoundments and Pond Location/Watershed Areas", for location). The embankment occasionally contains surface water runoff to the east of the railroad. In addition, EXHIBIT's 11-67 and 11-67a shows the location of the embankment and the drainage area. This modification addresses the seepage of water from the western face of the Lowe Railroad Embankment #2. This situation was observed by OSM/AFO during a September and October, 1994 inspection.

BHP proposes that we level the area and backfill the pond with approximately 28,600 cyds of existing spoil material. The clay material from the existing North Lowe Pit spoil pile will be used. Once the area has been completely leveled from elevations 5325' down to 5310', the area will be covered with 3 1/2' of clay liner material. The spoil clay material was tested for permeability by AGRA Earth & Environmental. A copy of the AGRA laboratory results are provided within the appendix. A portion of railroad embankment will also be lined with the clay material. The proposed work modification is shown on EXHIBIT 11-67 as cross-sections C-C and D-D.

Currently the basin capacity is 18.18 acre-feet at 5320' elevation. It was determined the highest point of elevation was 5325' before it drops back down in elevation. After the spoil clay material has been brought in and compacted and backfilled against the railroad embankment, the basin capacity is calculated to be 16.39 acre-feet at elevation 5325' which is substantially greater than the required

(12/08/95;12/26/95)

capacity of 12.32 acre-feet for a 100-yr., 6-hr. storm.

Lowe Railroad Embankment #2 watersheds are approximately 105.1 acres of mostly disturbed land. The SEDCAD+ analysis provided in APPENDIX 11-AA is valid for the embankment modification proposal. The modification will compile with Federal regulation 30 CFR 816.46, which requires that a sedimentation pond without a spillway contain runoff generated from a 100-yr., 6-hr event. Runoff quantities were determined using the SEDCAD+ computer model.

(12/08/95;12/26/95)



AGRA Earth &  
Environmental, Inc.  
2060 Afton Place  
Farmington, New Mexico 87401  
Tel (505) 327-7928  
Fax (505) 326-5721

# LABORATORY REPORT

Client: BHP Minerals - Navajo Mine Area III  
P.O. Box 155  
Fruitland, NM 87416

AGRA Project No.: C95-9506

February 2, 1995  
Page (1 of 1)

Project Low Pond #2 Liner  
Location Navajo Mine Area III

Type of Material Clay  
Source of Material Low Stockpile Northeast

Requested By E. Tsosie Date 1/10/95 Sampled By L. Waresback/AGRA Date 1/10/95  
Submitted By L. Waresback/AGRA Date 1/10/95

Reviewed By L. Waresback

### Sieve Analysis, ASTM

Sieve Size	Accumulative Percent Passing	Specification
3"		
2 1/2"		
2"		
1 1/2"		
1"		
3/4"		
1/2"	100	
3/8"	98	
1/4"	-	
No. 4	96	
No. 8	93	
No. 10	92	
No. 16	91	
No. 30	88	
No. 40	87	
No. 50	86	
No. 100	83	
No. 200	78	

### Moisture-Density Relationship, Test Method ASTM D698A

Maximum Dry Density: 98.1 pcf	Optimum Moisture Content: 20.5 percent
-------------------------------	--

### Plasticity Index, ASTM D4318

	Results	Specification
Liquid Limit (LL)	63	
Plastic Limit (PL)	21	
Plasticity Index (PI=LL-PL)	42	

### Other

Permeability $8.4 \times 10^{-9}$ cm/sec. Spec. $1.0 \times 10^{-7}$ cm/sec. minimum Remolded to 95% of ASTM D698 at Optimum Moisture Content.
--

Distribution: Client, Billing /mir

Engineering & Environmental Services

# LABORATORY REPORT

Client: BHP Minerals - Navajo Mine Area III  
 P.O. Box 155  
 Fruitland, NM 87416

AGRA Project No.: C95-9506

February 2, 1995  
 Page (1 of 1)

Project Lowe Pond #2 Liner  
 Location Navajo Mine Area III

Type of Material Clay  
 Source of Material Lowe Pit West  
 Requested By E. Tsosie  
 Submitted By L. Waresback/AGRA

Date 1/10/95 Sampled By L. Waresback/AGRA Date 1/10/95  
 Date 1/10/95

Reviewed By L. Waresback

### Sieve Analysis, ASTM

Sieve Size	Accumulative Percent Passing	Specification
3"		
2 1/2"		
2"		
1 1/2"		
1"		
3/4"	100	
1/2"	98	
3/8"	97	
1/4"	-	
No. 4	92	
No. 8	89	
No. 10	88	
No. 16	85	
No. 30	83	
No. 40	82	
No. 50	81	
No. 100	79	
No. 200	76	

### Moisture-Density Relationship, Test Method ASTM D698A

Maximum Dry Density: 102.9pcf	Optimum Moisture Content: 18.0 percent
-------------------------------	--

### Plasticity Index, ASTM D4318

	Results	Specification
Liquid Limit (LL)	49	
Plastic Limit (PL)	25	
Plasticity Index (PI=LL-PL)	24	

### Other

Permeability $1.3 \times 10^{-8}$ cm/sec. Spec. $1.0 \times 10^{-7}$ cm/sec. minimum Remolded to 95% of ASTM D698 at Optimum Moisture Content.
--

Distribution: Client, Billing /mir

### Low Railroad Embankment #2 As-Built/ Modification

Reclamation on the eastern edge of Lowe Railroad Embankment #2 Pond has changed the topography so that the current pond can retain over 20 acre-feet. Therefore, the pond must be modified or permitted by MSHA. To eliminate this problem, a spillway has been added to the western end of the pond along the 5324' elevation. The crest of the spillway extends 426' southwards at elevation 5324'. When topography starts to break, the spillway slopes 434' downward at -7.3% towards Lowe Railroad Embankment #1. The pond will contain 11.11 acre-feet at the 5324' elevation. The pond must hold 8.07 acre-feet to contain the 10 year, 24-hour storm event. The spillway is designed for the 25 year, 6-hour storm event, and the peak stage is at 5325.09' elevation. This allows for one foot of free board in the spillway.

The spillway outflow channel will show signs of scouring during an overflow event from the spillway. In the past, overflow through the spillways have been very infrequent; especially, since the average annual rainfall for the area is only 7.0 inches. The outflow channel will be inspected and maintained. Any sediment generated will be retained in Lowe Railroad Embankment #1, immediately downstream, and it will not leave the permit area.

## **Lowe Railroad MSHA Impoundment**

Pages 11-Q-9 through 11-Q-28 left blank

Due to text updates

# LOWE RAILROAD IMPOUNDMENT #1

## STABILITY ANALYSIS



11-Q-29

**GEOTECHNICAL EVALUATION**  
**LOWE RAILROAD EMBANKMENT I**  
**AREA III - NAVAJO MINE**  
**FRUITLAND, NEW MEXICO**  
**JOB NO. 3127JC127**

Prepared for:

**BHP - NAVAJO MINE**

August 8, 1997



Lawrence E. Cynova, P.E.  
Geotechnical Engineer



*Jon C. Schwindt*  
Jon C. Schwindt, P.E.  
Vice President

August 8, 1997

BHP - Navajo Mine  
P.O. Box 1717  
Fruitland, New Mexico 87416

Attn: Mr. Leonard Raymond

Re: Geotechnical Evaluation  
Lowe Railroad Embankment I  
Area III - Navajo Mine  
Fruitland, New Mexico

Job No. 3127JC127

Western Technologies Inc. has completed the geotechnical evaluation for the existing Lowe Railroad Embankment I at Navajo Mine, south of Fruitland, New Mexico. This study was performed in general accordance with our verbal/telephone quote and BHP purchase order AG9559 on July 24, 1997. The original study for this project was conducted in January of 1988. This report is to cover additional depth of water behind the railroad embankment. The results of our evaluation, including the field observations, borings logs and the geotechnical recommendations are attached.

We appreciate being of service to you in the geotechnical engineering phase of this project. If conditions change, or if you have any questions concerning this report and consulting services, please do not hesitate to contact us. We look forward to working with you on future projects.

Sincerely,  
WESTERN TECHNOLOGIES INC.  
Geotechnical Engineering Services

Lawrence E. Cynova, P.E.  
Geotechnical Engineer

Copies to: Addressee (4)



**TABLE OF CONTENTS**

Page No.

**1.0 PURPOSE** ..... 1

**2.0 PROJECT DESCRIPTION** ..... 1

**3.0 SCOPE OF SERVICES** ..... 1

    3.1 Field Exploration ..... 1

    3.2 Laboratory Analysis ..... 2

    3.3 Analyses and Report ..... 2

**4.0 SITE CONDITIONS** ..... 2

    4.1 Surface ..... 2

    4.2 Geologic History ..... 2

**5.0 ANALYSIS PROCEDURES** ..... 3

    5.1 General ..... 3

    5.2 Material Properties ..... 3

    5.3 Slope Stability Analysis ..... 4

**VICINITY MAP** ..... Plate 1

**BORING LOCATION DIAGRAM** ..... Plate 2

**SLOPE PROFILES** ..... Plate 3

**APPENDIX A**

    Definition of Terminology ..... A-1

    Method of Soil Classification ..... A-2

    Boring Log Notes ..... A-3

    Boring Logs ..... A-4 & A-5

**APPENDIX B**

    Laboratory Tests ..... B-1

**APPENDIX C**

    Slope Stability Analysis Sheets ..... C-1 to C-2



**GEOTECHNICAL EVALUATION  
LOWE RAILROAD EMBANKMENT I  
FRUITLAND, NEW MEXICO  
JOB NO. 3127JC127**

**1.0 PURPOSE**

This report contains the results of our geotechnical evaluation of the existing railroad slope located at the Lowe Railroad Embankment I, Area III of the Navajo Mine, south of Fruitland, New Mexico. The purpose of these services is to determine the depth of fill, material types and stability of the existing slopes.

**2.0 PROJECT DESCRIPTION**

Project information supplied by Mr. Leonard Raymond, indicates that the railroad embankment was constructed in about 1981. The embankment has a railroad and service road and is about 35 feet in width. The railroad fill is several thousand feet in length. Our work was primarily concerned with the deep fill which is approximately 600 feet in length. It is understood that this embankment area has a small drainage area and the maximum water behind the embankment will be at elevation 5308. The embankment is approximately 50 feet in height at its highest point. The area behind the embankment is dry about 70 percent of the time. After a precipitation event and if significant water is present behind embankment, the water will be pumped/hailed away.

**3.0 SCOPE OF SERVICES**

**3.1 Field Exploration**

Two borings were drilled to depths ranging from 41 to 42 feet below existing site grades on the existing railroad embankment area. A field log was prepared for each boring. The final logs describe the materials encountered, their thicknesses, and locations where samples were obtained. The Unified Soil Classification System was used to classify soils. The soil classification symbols appear on the boring logs and are briefly described in Appendix A.





## 5.0 ANALYSIS PROCEDURES

### 5.1 General

The slope stability analysis was conducted on the highest section of the embankment where water is stored after precipitation runoff. A fully loaded coal train was assumed to be on the railroad embankment during this analysis.

### 5.2 Material Properties

The sandy clay materials encountered in the embankment areas have moderate to high cohesion and moderate to moderately high angles of internal friction. The direct shear tests were conducted at or slightly above existing moisture contents for embankment materials and in the saturated condition for ponds materials. The large particle size of the embankment materials caused difficulty in trimming soils samples and therefore soil samples were remolded to near in-place densities. The claystone or shale under the soils at the embankments was assumed to have high cohesion and low to moderately high angles of internal friction. Based upon our observations and our experience with similar materials, the following material properties were assigned to the existing slope materials:

#### Sandy Clay - Native Area

Dry unit weight - 107 (pcf) pounds per cubic foot  
Angle of internal friction - 20°  
Cohesion - 300 (pcf) pounds per cubic foot

#### Sandy Clay - Saturated Zone

Dry unit weight - 95 (pcf) pounds per cubic foot  
Angle of internal friction - 20°  
Cohesion - 300 (pcf) pounds per cubic foot

#### Sandy Clay - Embankment Area

Dry unit weight - 107 (pcf) pounds per cubic foot  
Angle of internal friction - 32°  
Cohesion - 1400 (pcf) pounds per cubic foot

#### Claystone

Dry unit weight - 110 (pcf) pounds per cubic foot  
Angle of internal friction - 0°  
Cohesion - 10,000 (psf) pounds per cubic foot



### 5.3 Slope Stability Analysis

The static stability of the existing slope was analyzed using strength parameters from test results and estimates from observations and past experience with similar materials. The analysis was conducted on the slope configuration (Plate 3) as measured in the field by BHP personnel. A computer program (SB Slope developed by Von Guten Engineering Software) using simplified Bishop's Analysis was performed for the existing slope configurations.



The following table presents the results of the analysis:

<u>Section</u>	<u>Analysis</u>	<u>Factor of Safety</u>
Downstream	Circle 1	3.7
Upstream	Circle 2	3.1


A minimum static factor of safety of 1.5 is required for embankments by the Mine Safety & Health Administration.

Based upon laboratory test results, estimates of soil parameters and our computer analysis, the upstream and downstream slope of the railroad embankment meets the static factor of safety.



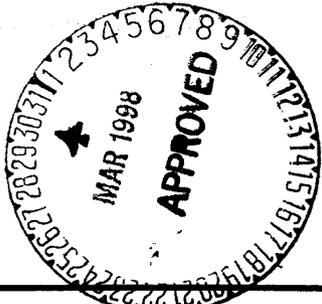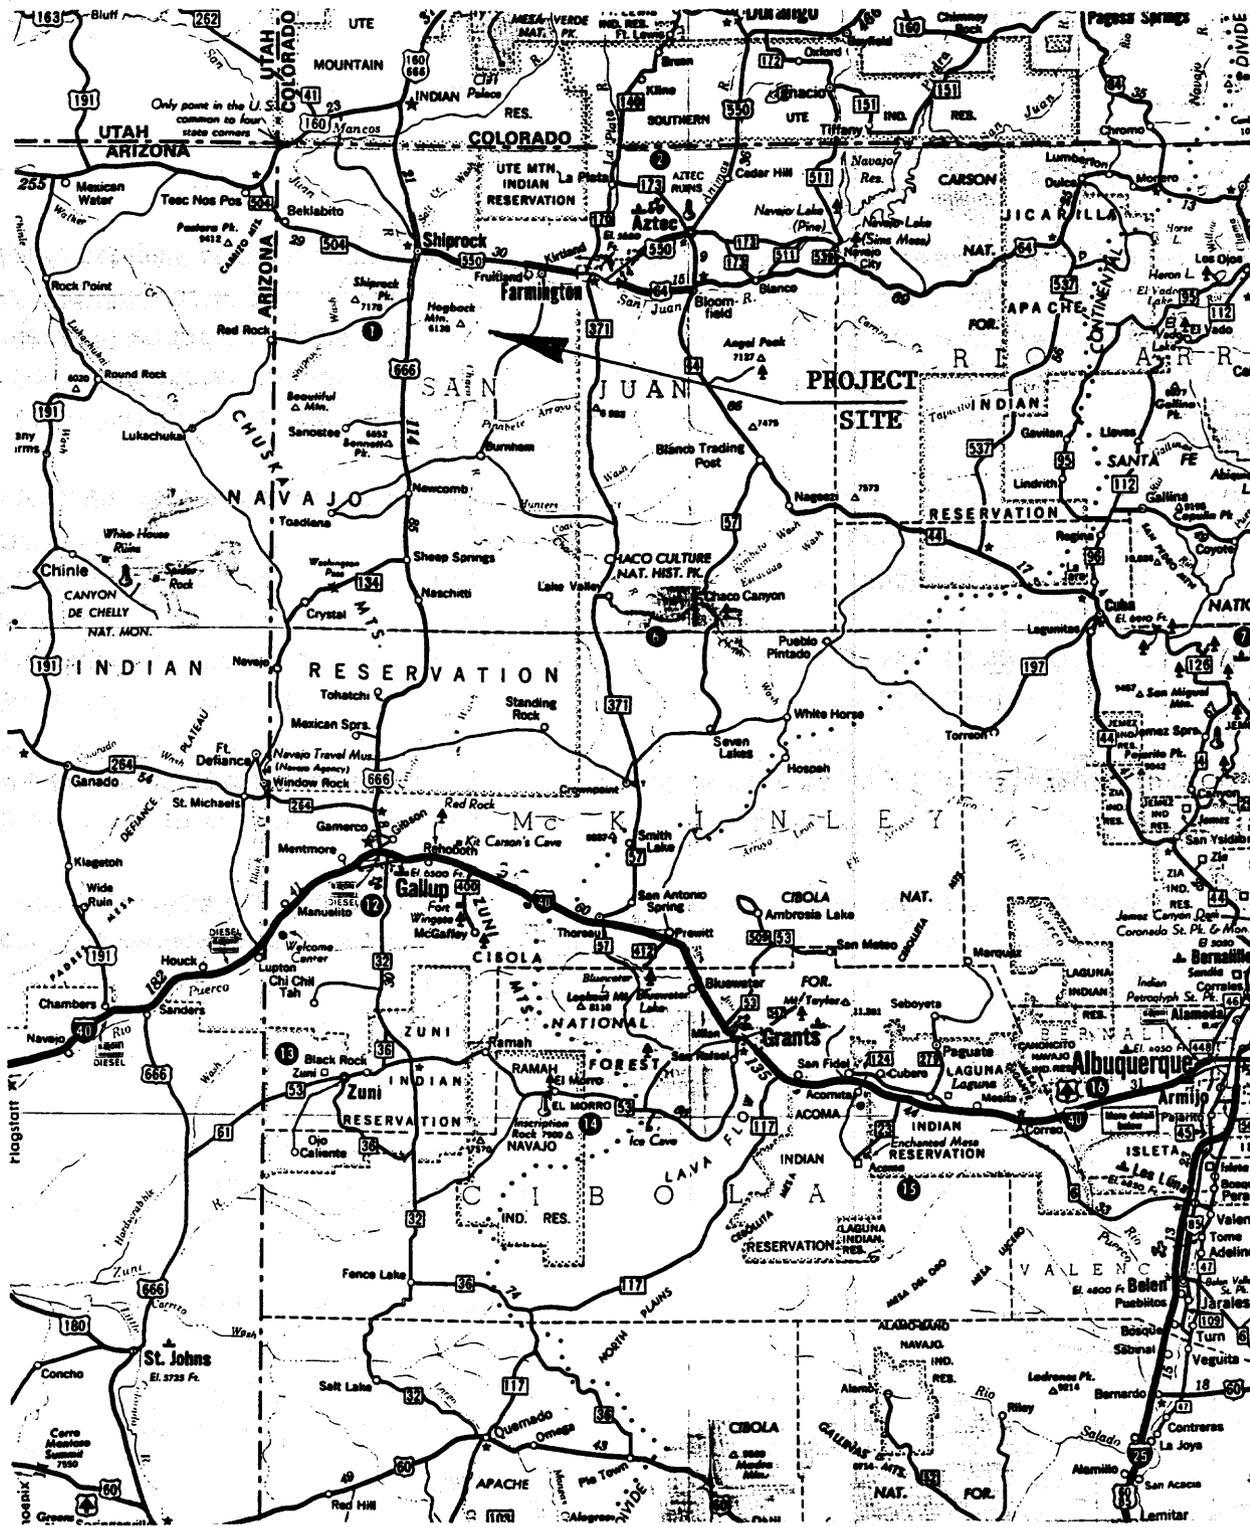

<b>LOWE RAILROAD EMBANKMENT I</b>	
Vicinity Map	
<b>Western Technologies Inc.</b>	
Job No.: 3127JC127	Plate: 1

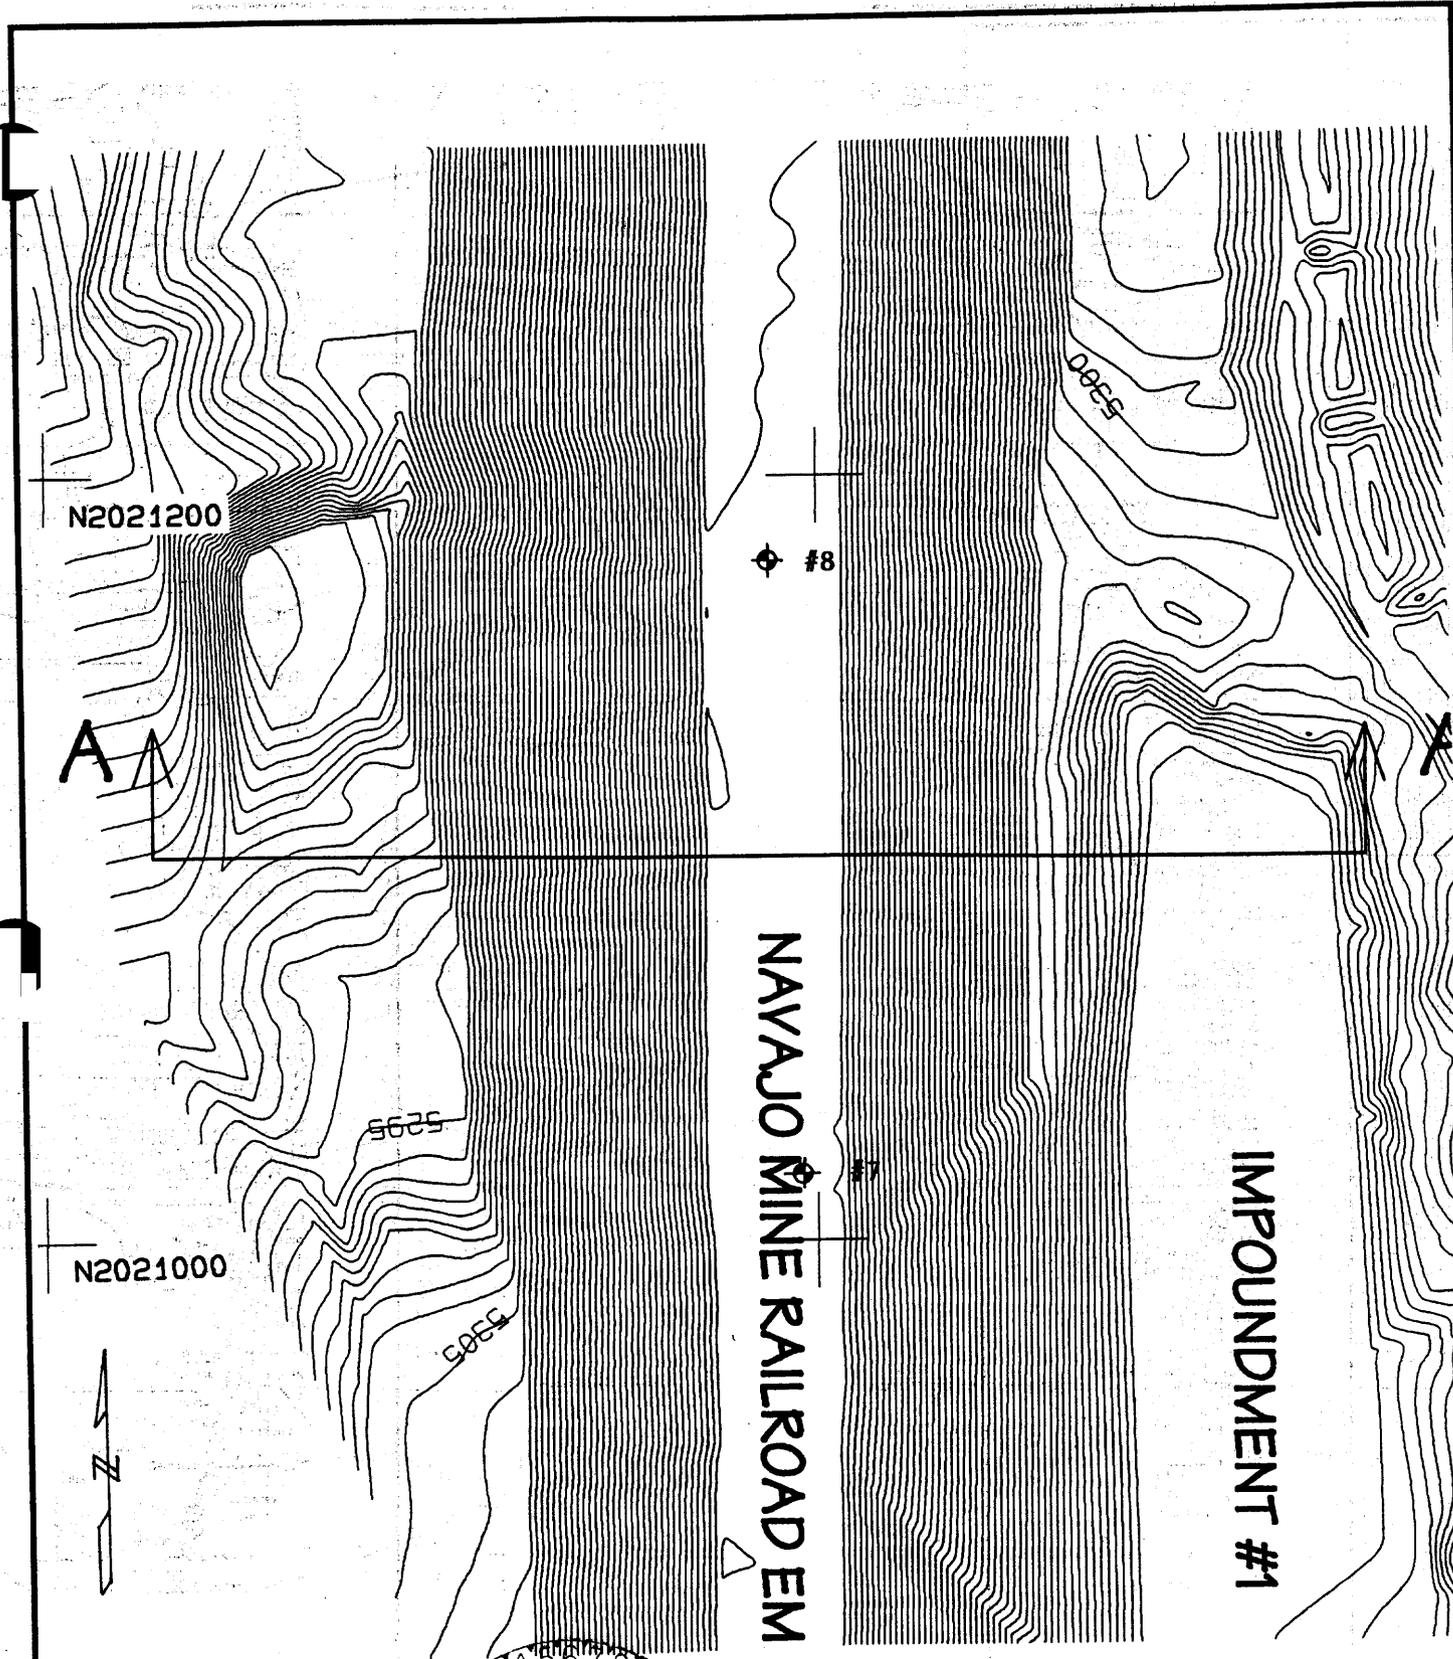


N2021200

N2021000

#8


NAVAJO MINE RAILROAD EM

IMPOUNDMENT #1

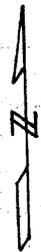


**LEGEND**

⊕ BORING

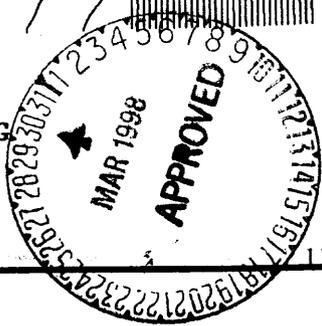


LOWE RAILROAD EMBANKMENT I	
Boring Location Diagram	
Western Technologies Inc.	
Job No.: 3127JC127	Plate: 2

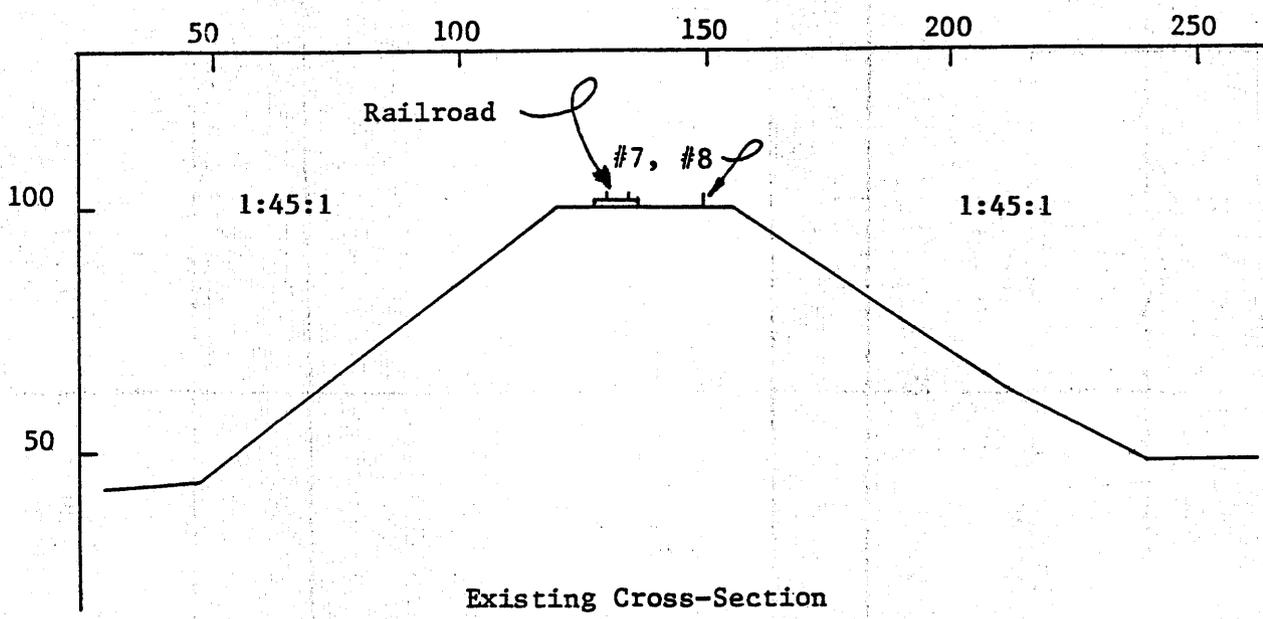

Existing Cross-Section


Slopes are shown as horizontal to vertical

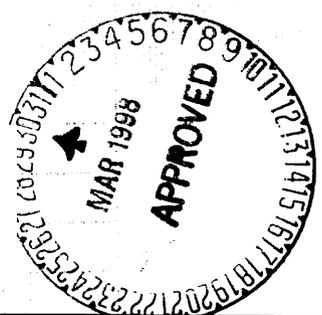

LOWE RAILROAD EMBANKMENT I	
Slope Profile	
Western Technologies Inc.	
Job No.: 3127JC127	Plate: 3

11 Q 39

<b>Allowable Soil Bearing Capacity</b>	The recommended maximum contact stress developed at the interface of the foundation element and the supporting material.
<b>Backfill</b>	A specified material placed and compacted in a confined area.
<b>Base Course</b>	A layer of specified material placed on a subgrade or subbase.
<b>Base Course Grade</b>	Top of base course.
<b>Bench</b>	A horizontal surface in a sloped deposit.
<b>Caisson</b>	A concrete foundation element cast in a circular excavation which may have an enlarged base. Sometimes referred to as a cast-in-place pier.
<b>Concrete Slabs-on-Grade</b>	A concrete surface layer cast directly upon a base, subbase or subgrade.
<b>Crushed Rock Base Course</b>	A base course composed of crushed rock of a specified gradation.
<b>Differential Settlement</b>	Unequal settlement between or within foundation elements of a structure.
<b>Engineered Fill</b>	Specified material placed and compacted to specified density and/or moisture conditions under observations of a representative of a soil engineer.
<b>Existing Fill</b>	Materials deposited through the action of man prior to exploration of the site.
<b>Existing Grade</b>	The ground surface at the time of field exploration.
<b>Expansive Potential</b>	The potential of a soil to expand (increase in volume) due to absorption of moisture.
<b>Fill</b>	Materials deposited by the actions of man.
<b>Finished Grade</b>	The final grade created as a part of the project.
<b>Gravel Base Course</b>	A base course composed of naturally occurring gravel with a specified gradation.
<b>Heave</b>	Upward movement
<b>Native Grade</b>	The naturally occurring ground surface.
<b>Native Soil</b>	Naturally occurring on-site soil.
<b>Rock</b>	A natural aggregate of mineral grains connected by strong and permanent cohesive forces. Usually requires drilling, wedging, blasting or other methods of extraordinary force for excavation.
<b>Sand &amp; Gravel Base</b>	A base course of sand and gravel of a specified gradation.
<b>Sand Base Course</b>	A base course composed primarily of sand of a specified gradation.
<b>Scarify</b>	To mechanically loosen soil or break down existing soil structure.
<b>Settlement</b>	Downward movement.
<b>Soil</b>	Any unconsolidated material composed of discrete solid particles, derived from the physical and/or chemical disintegration of vegetable or mineral matter, which can be separated by gentle mechanical means such as agitation in water.
<b>Strip</b>	To remove from present location.
<b>Subbase</b>	A layer of specified material placed to form a layer between the subgrade and base course.
<b>Subbase Grade</b>	Top of subbase.
<b>Subgrade</b>	Prepared native soil surface.

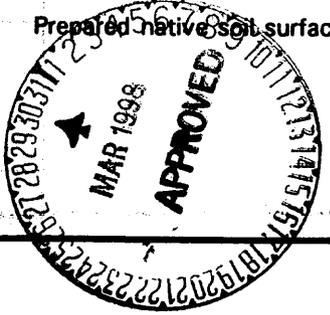

11-Q-40

<b>LOWE RAILROAD EMBANKMENT I</b>	
Definition of Terminology	
<b>Western Technologies Inc.</b>	
Job No.: 3127JC127	Plate: A-1

**COARSE-GRAINED SOILS**  
LESS THAN 50% FINES\*

GROUP SYMBOLS	DESCRIPTION	MAJOR DIVISIONS
GW	WELL-GRADED GRAVELS OR GRAVEL-SAND MIXTURES, LESS THAN 5% FINES	GRAVELS More than half of coarse fraction is larger than No. 4 sieve size
GP	POORLY-GRADED GRAVELS OR GRAVEL-SAND MIXTURES LESS THAN 5% FINES	
GM	SILTY GRAVELS, GRAVEL-SAND-SILT MIXTURES, MORE THAN 12% FINES	
GC	CLAYEY GRAVELS, GRAVEL-SAND-CLAY MIXTURES, MORE THAN 12% FINES	
SW	WELL-GRADED SANDS OR GRAVELLY SANDS, LESS THAN 5% FINES	SANDS More than half of coarse fraction is smaller than No. 4 sieve size
SP	POORLY-GRADED SANDS OR GRAVELLY SANDS, LESS THAN 5% FINES	
SM	SILTY SANDS, SAND-SILT MIXTURES, MORE THAN 12% FINES	
SC	CLAYEY SANDS, SAND-CLAY MIXTURES, MORE THAN 12% FINES	

NOTE: Coarse-grained soils receive dual symbols if they contain 5 to 12% fines (e.g. SW-SM, GP-GC, etc.)

**FINE-GRAINED SOILS**  
MORE THAN 50% FINES

GROUP SYMBOLS	DESCRIPTION	MAJOR DIVISIONS
ML	INORGANIC SILTS, VERY FINE SANDS, ROCK FLOUR, SILTY OR CLAYEY FINE SANDS	SILTS AND CLAYS Liquid limits less than 50
CL	INORGANIC CLAYS OF LOW TO MEDIUM PLASTICITY, GRAVELLY CLAYS, SANDY CLAYS, SILTY CLAYS, LEAN CLAYS	
OL	ORGANIC SILTS OR ORGANIC SILT-CLAYS OF LOW PLASTICITY	
MH	INORGANIC SILTS, MICACEOUS OR DIATOMACEOUS FINE SANDS OR SILTS, ELASTIC SILTS	SILTS AND CLAYS Liquid limit more than 50
CH	INORGANIC CLAYS OF HIGH PLASTICITY, FAT CLAYS	
OH	ORGANIC CLAYS OF MEDIUM TO HIGH PLASTICITY	
PT	PEAT, MUCK, AND OTHER HIGHLY ORGANIC SOILS	HIGHLY ORGANIC SOILS

NOTE: Fine-grained soils may receive dual classification based upon plasticity characteristics

**SOIL SIZES**

COMPONENT	SIZE RANGE
BOULDERS	ABOVE 12 in.
COBBLES	3 in. to 12 in.
GRAVEL	No. 4 to 3 in.
Coarse	3/4 in. to 3 in.
Fine	No. 4 to 3/4 in.
SAND	No. 200 to No. 4
Coarse	No. 10 to No. 4
Medium	No. 40 to No. 10
Fine	No. 200 to No.40
*Fines (Silt or Clay)	BELOW No. 200

NOTE: Only sizes smaller than three inches are used to classify soils

**CONSISTENCY**

CLAYS & SILTS	BLOWS/FOOT*
VERY SOFT	0-2
SOFT	2-4
FIRM	4-8
STIFF	8-16
VERY STIFF	16-32
HARD	Over 32

**RELATIVE DENSITY**

SANDS & GRAVELS	BLOWS/FOOT*
VERY LOOSE	0-4
LOOSE	4-10
MEDIUM DENSE	10-30
DENSE	30-50
VERY DENSE	Over 50


\*Number of blows of 140 pound hammer falling 30 inches to drive a 2 inch O.D. (1 3/8" ID) split spoon (ASTM D1586)

**PLASTICITY OF FINE GRAINED SOILS**

PLASTICITY INDEX	TERM
0	Non-Plastic
1 - 7	Low
8 - 25	Medium
Over 25	High

**DEFINITION OF MOISTURE CONTENT**

DRY
SLIGHTLY DAMP
DAMP
MOIST
WET
SATURATED

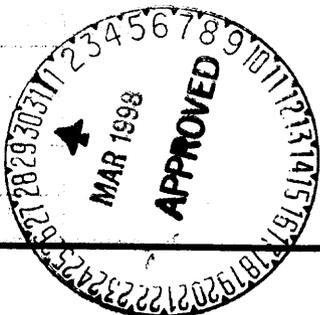

11-Q-41

LOWE RAILROAD EMBANKMENT I	
Method of Soil Classification	
Western Technologies Inc.	
Job No.: 3127JC127	Plate: A-2

The number shown in "BORING NO." refers to the approximate location of the same number indicated on the "Boring Location Diagram" as positioned in the field by measurements from existing features.

"ELEVATION" refers to ground surface elevation at the boring location established by the client.

"TYPE SIZE BORING" refers to the exploratory equipment used in the boring wherein HSA = hollow stem auger.

"N" in Blows/Foot" refers to the number of blows of a 140-pound weight, dropped 30 inches, required to advance a two-inch-outside-diameter split-barrel sampler a distance of 1 foot, Standard Penetration Test (ASTM D1586). Refusal to penetration is defined as more than 100 blows per foot.

"R" in Blows/Foot" refers to the number of blows of a 140-pound weight, dropped 30 inches, required to advance a 2.42-inch-inside-diameter ring sampler a distance of 1 foot. Refusal to penetration is considered more than 50 blows per foot.

"Sample Type" refers to the form of sample recovery, in which N = Split-barrel sample, R = Ring sample, G = Grab Sample.

"Dry Density, pcf" refers to the laboratory-determined dry density in pounds per cubic foot. The symbol "NR" indicates that no sample was recovered.

"Water Content, %" refers to the laboratory-determined moisture content in percent (ASTM D2216).

"Unified Classification" refers to the soil type as defined by "Method of Soil Classification". The soils were classified visually in the field and, where appropriate, classifications were modified by visual examination of samples in the laboratory and/or by appropriate tests.

These notes and boring logs are intended for use in conjunction with the purposes of our services defined in the text. Boring log data should not be construed as part of the construction plans nor as defining construction conditions.

Boring logs depict our interpretations of subsurface conditions at the locations and on the date(s) noted. Variations in subsurface conditions and soil characteristics may occur between borings. Groundwater levels may fluctuate due to seasonal variations and other factors.

The stratification lines shown on the boring logs represent our interpretation of the approximate boundary between soil types based upon visual field classification. The transition between materials is approximate and may be far more or less gradual than indicated.



LOWE RAILROAD EMBANKMENT I	
Boring Log Notes	
Western Technologies Inc.	
Job No.: 3127JC127	Plate: A-3

DATE DRILLED: 11-25-1987

LOCATION: See Boring Location Diagram

DRILL RIG TYPE: CME-55

# BORING NO. 7


ELEVATION: 5338 Feet

BORING TYPE/SIZE: HSA/7"

FIELD ENGR: S. Wood

PRIMARY APPLIES ONLY AT THIS LOCATION AND AT THE TIME OF LOGGING. CONDITIONS MAY CHANGE AT THIS LOCATION WITH TIME. DATA PRESENTED IS

WATER CONTENT (%)	DRY DENSITY (LBS/CU.FT)	SAMPLE TYPE	BLOWS/FT.		DEPTH	USCS	GRAPHIC	SOIL DESCRIPTION
			N	C				
12.8	101	G	60/11"	49	5			FILL 0 TO 34.5 FEET SANDY CLAY; tan, damp to slightly damp, stiff to very stiff, some lumps of weather shale, some scattered pieces of sandstone, some gravel top 3 inches of surface, sandstone boulder 15 to 16.5 feet, brown carbonaceous shale below 29 feet.
		N			10			
7.5	110	R	60/6"	60/6.5"	15			
		N			20			
	NR	R	60/6"	51	25			
		N			30			
		N			35			SHALE; brown to orange, slightly damp, claystone, weathered.
		N	60/4"		40			SHALE; tan, slightly damp, fine sand and claystone, moderate cementation.
					45			Auger Refusal 42 Feet
					50			
					55			
					60			

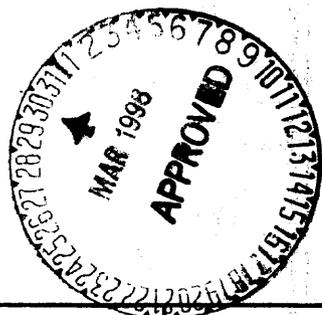

GROUNDWATER ENCOUNTERED NO: X YES: \_\_\_\_\_ DEPTH: \_\_\_\_\_ DATE: 11-25-1987

NOTES

LOWE RAILROAD EMBANKMENT I

Boring Log

**Western Technologies Inc.**

Job No.: 3127JC127 Plate: A-4

DATE DRILLED: 11-25-1987

LOCATION: See Boring Location Diagram

DRILL RIG TYPE: CME-55

# BORING NO. 8

ELEVATION: 5338 Feet

BORING TYPE/SIZE: HSA/7"

FIELD ENGR: S. Wood

OTHER LOCATIONS AND MAY CHANGE AT THIS LOCATION WITH TIME. DATA PRESENTED IS

WATER CONTENT (%)	DRY DENSITY (LBS/CU.FT)	SAMPLE TYPE	SAMPLE	BLOWS/FT.		DEPTH	USCS	GRAPHIC	SOIL DESCRIPTION		
				Z	C						
10.3	111	G				5			FILL 0 TO 34.5 FEET SANDY CLAY; tan, very stiff, damp to slightly damp, some pieces of weathered shale and sandstone, sandstone boulder from 7.5 to 8 feet, some gravel on surface.		
11.5 10.5	109 103	R R	50/5" 50"			10					
11.0	106	R Z	50/5" 49"			15					
		N	46"			20					
		N	66"			25					
7	107	R Z	50/5" 44"			30					
		N	81"			35				SHALE; brown, black to orange, stiff to hard, slightly damp to damp, carbonaceous, some coal, some claystone.	
		N	57"			40					
Auger Refusal At 41 Feet											



GROUNDWATER ENCOUNTERED NO: **X** YES: \_\_\_\_\_ DEPTH: \_\_\_\_\_ DATE: 11-25-1987

NOTES

LOWE RAILROAD EMBANKMENT I

Boring Log

**Western Technologies Inc.**

Job No.: 3127JC127 Plate: A-5

# SOIL PROPERTIES


Boring No.	Depth (ft)	Soil Class.	Soil Property		Shear Strength		Perm. K (Cm/Sec)	Specific Gravity	Water Soluble Matter (ppm)		Remarks
			Initial Dry Density (pcf)	Initial Water Content (%)	C (ksf)	φ (Deg)			Salts	Sulfates	
7	9-14.5	CL	107	11.0	0.3	20					DS
8	0-20	CL	107	10.8	1.4	37					DS
8	29-31.5	CL	107	11.0	1.5	32					DS

**NOTE:** Initial Dry Density and Initial Water Content are in-situ values unless otherwise noted.

**LEGEND**

Shear Strength Test Method

- DS Direct Shear
- DS Direct Shear (Saturated)
- UC Unconfined Compression
- UU Unconsolidated Undrained
- CU Consolidated Undrained w/pore pressure
- CU Consolidated Undrained
- CD Consolidated Drained

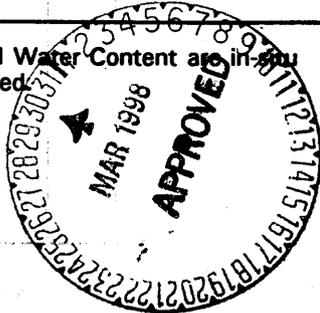

**REMARKS**

1. Compacted density (approximately 95% of ASTM D698 at moisture value slightly below optimum)
2. Visual Classification
3. Constant head
4. Falling head

<b>LOWE RAILROAD EMBANKMENT I</b>
<b>Soil Properties</b>
<b>Western Technologies Inc.</b>
Job No.: 3127JC127
Plate: B-1

11-O-45

# SOLOPE

## Simplified Bishop Slope Stability Analysis

PROJECT: Lowe Railroad embankment I


LOCATION: Fruitland, NM

FILE: LOMEIII


COMPLETE SLOPE CROSS SECTION

SOIL*	DENSITY	COHESION	PHI
1	95.0	300.0	20.0
2	107.0	1400.0	32.0
3	110.0	10000.0	0.0

CIRCLE	X	Y	RADIUS	FS
1	95.0	380.0	80.0	3.75

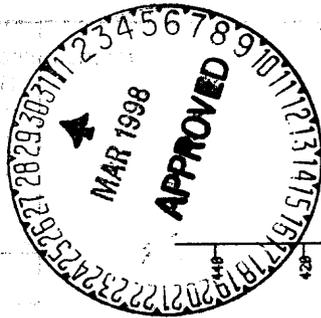

CIRCLE 1

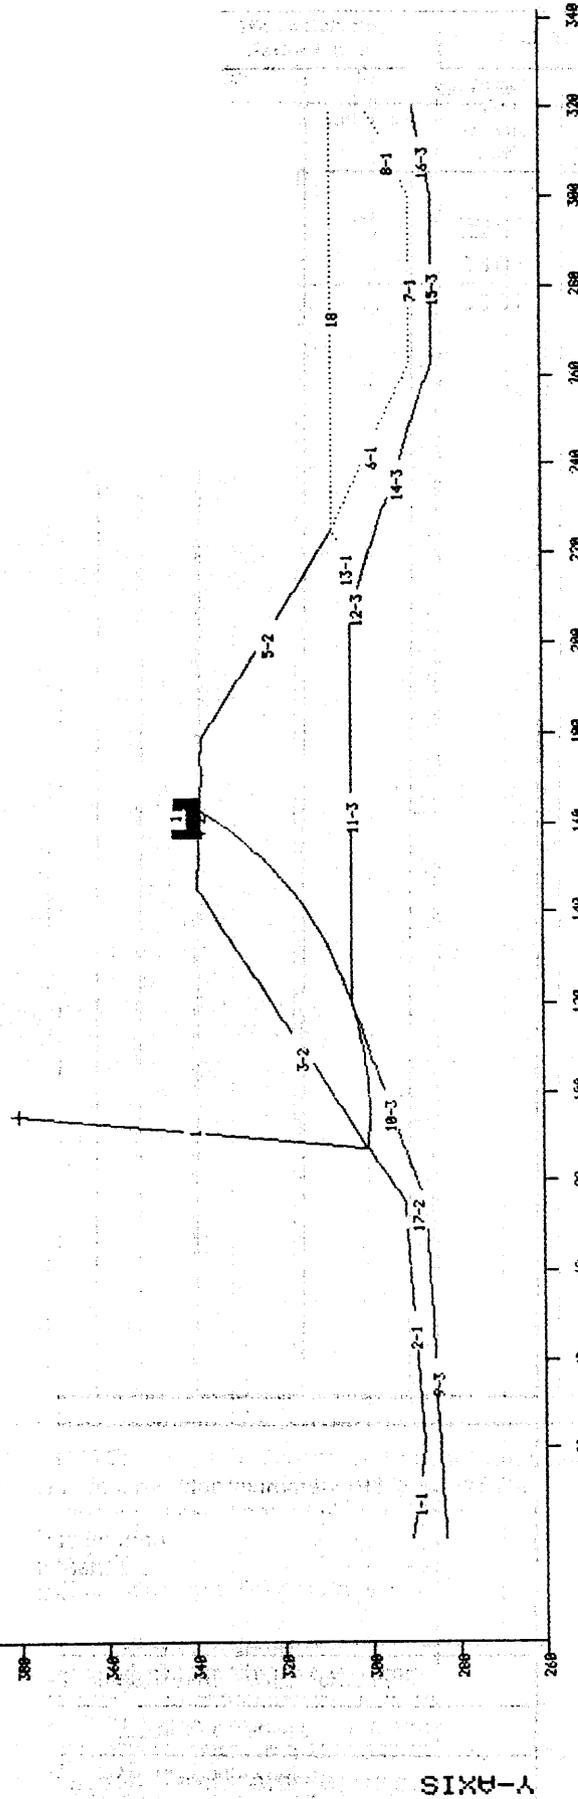

\* Number after hyphen('-') is Soil Type

Western Technologies Inc. - Phoenix, AZ

# SCOPE

## Simplified Bishop Slope Stability Analysis

**PROJECT:**


LOCATION: Fruitland, NM

FILE: LOWEIV

**COMPLETE SLOPE CROSS SECTION**

SOIL*	DENSITY	COHESION	PHI
1	95.0	300.0	20.0
2	107.0	1400.0	32.0
3	110.0	10000.0	0.0

CIRCLE	X	Y	RADIUS	FS
1	240.0	390.0	92.0	3.13

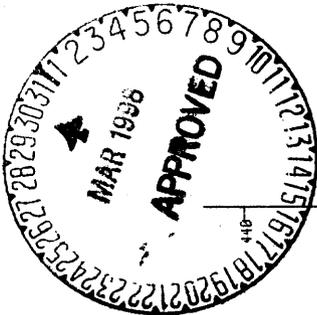


11-Q-47

CIRCLE 2

Y-AXIS

X-AXIS \* Number after hyphen(‘-’) is Soil Type

Western Technologies Inc. - Phoenix, AZ

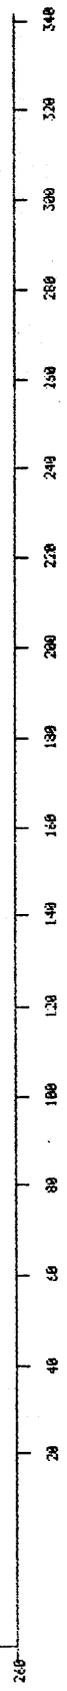



11-Q-48

**APPENDIX 26.B**

NAVAJO MINE RAILROAD  
SEDIMENT AND DRAINAGE CONTROL STRUCTURES

DESIGN DATA

MAY 1998

Appendix 26.B  
Navajo Mine Railroad Sediment and Drainage Control Structures

Due to reformatting of the Navajo Mine PAP, the following references in this appendix have been changed, deleted, or renumbered:

---

<u>NM-0003F Paper Permit</u>	<u>NM-0003F Electronic Permit</u>
Appendix 11-V	Appendix 23.A
Chapter 11 Sediment Ponds 11.5.6.2.2	Part 4 Section 26.1.5

## **NAVAJO MINE RAILROAD SEDIMENT AND DRAINAGE CONTROL STRUCTURES**

To comply with the EPA Storm Water Regulation, BHP has verified the performance of all drainage control structures along the railroad. In cases where the flow velocity exceeded the erosive velocity and erosion was visible, structures were designed to control and minimize the contribution of sediment to surface runoff outside the permit area.

The drainage control structures along the railroad were evaluated per the procedure and criteria outlined in Chapter 11, Section 11.5.6.2.2 of the mine permit. All watersheds and existing drainage control structures were surveyed to identify the following; the locations of structures, watershed areas and structure dimensions (see Table A attached) for all drainage structures. After completing the field survey, the watersheds and structures were modeled with SEDCAD+ computer software to determine the adequacy of the existing structures and where new structures need to be placed. There are numerous small watershed areas ranging from 0.1 to 8 acres. Instead of making a separate analysis for each individual watershed, a worst case hydrology analysis was done for 0.5, 1.0, 2.0, 4.0, 6.0 and 8.0 acres watersheds. The peak discharges from the worst case hydrology analysis were used in the hydraulic analysis of ditches/channels having watersheds of equivalent or smaller size. For the worst case hydrology runs, the time of concentration ( $T_c$ ) was assumed to be zero, giving conservative peak discharges which will be used to design the drainage/erosion control structures. Utilizing the data from the worst case runs, all structures were modeled with the SEDCAD+ channel utility. If the watershed for any structure was larger than 8.0 acres, the watershed was modeled separately.

The constructed flow paths associated with the railroad, including side ditches, berms/ditch combinations and relief ditches were hydraulically evaluated. The SEDCAD+ channel design utility was used to check the flow velocities in the ditches or channels. The procedures and criteria outlined in Chapter 11, Section 11.5.6.2.2 of the mine permit were followed to determine the type of structure or BMP to be applied. Table A "Drainage Control Structures" summarizes the type of BMP's applied or needed to be installed.

At the north end of the Big Fill, on the west side, there are five straw bale barriers (check dams) placed in series in the ditch along the toe of the embankment. The watershed area for the ditch is small, approximately 1.7 acres. The straw bale barriers appear to be functioning effectively. The section of ditch containing the straw bale barriers does not receive water from the railroad side ditch immediately upstream. The surface runoff collected by the side ditch is diverted into a downdrain pipe, which runs along the toe of the embankment parallel to the ditch. The downdrain pipe terminates and releases the flow into the ditch downstream of the straw bale barriers at a point where the ditch grade shallows out. These straw bale barriers will be retained and maintained. No technical evaluation was done on the straw bale barriers.

The railroad utilizes a large number of downdrains, several of which are fed by lengthy drainage paths running along the side of the railroad access route. During the survey, three downdrain pipes and four culverts were found that were not included in Appendix 11-V for culverts and

downdrains. A downdrain pipe was also added on the Barber Stockpile Spur. The designs for these are included in this submittal package and the appropriate exhibits and tables were updated.

The surface runoff at the coal preparation plant and the North Facilities which includes the section of railroad within that vicinity, is collected and retained in either the North Cells (Cells A, A2, B, and C) or Pond 5. The surface runoff from these areas is primary sheet flow on flat surfaces with low grades. The runoff is collected in low gradient swales that divert the runoff into culverts going to Cell A or Pond 5. No erosion was observed in this area during the survey. Not all ditches were checked in this area, since the runoff and sediment is retained.

Three surface disturbances along the railroad were identified during the surveys. It appears that the disturbance was made in efforts to maintain the berms and silt fences nearby. These areas will be seeded, mulched and crimped to stabilize the surface and improve hydrologic conditions.

During the survey several storage areas for the railroad track maintenance supplies were noted and are shown on Exhibits 11-14K through 11-14T. These storage areas contain rails, rail ties, and railroad ballast.

## **Appendix 26.C**

Sediment Ponds Impoundments Hydrology Calculations

---

Appendix 26.C

Sediment Ponds Impoundments Hydrology Calculations

Due to reformatting of the Navajo Mine PAP, the following references in this appendix have been changed, deleted or renumbered:

<u>NM-0003F Paper</u>	<u>NM-0003F Electronic</u>
Text 11.5.4.3	Section 26.2.3
Exhibit 11-1	Exhibit 26-19
Exhibit 11-2	Exhibit 26-20
Exhibit 11-4	Exhibit 26-21
Exhibit 11-5	Exhibit 26-22
Exhibit 11-6	Exhibit 26-23
Exhibit 11-13C	Exhibit 26-10
Exhibit 11-13D	Exhibit 26-11
Exhibit 11-13E	Exhibit 26-12
Exhibit 11-13F	Exhibit 26-25
Exhibit 11-50	Exhibit 26-39
Exhibit 11-88	Exhibit 26-86
Exhibit 11-106	Exhibit 26-13
Exhibit 11-105A	Deleted
Exhibit 11-110	Exhibit 26-76
Exhibit 11-111	Exhibit 26-44
Exhibit 11-113B	Deleted
Exhibit 11-115	Exhibit 26-46
Exhibit 11-118	Exhibit 26-50
Exhibit 11-127D	Exhibit 26-55
Exhibit 11-132	Deleted
Exhibit 11-136	Exhibit 26-80
Exhibit 11-139	Exhibit 26-26
Exhibit 11-150	Deleted
Exhibit 11-151	As-built folder
Exhibit 11-152	Exhibit 26-82
Exhibit 11-156	Exhibit 26-64
Exhibit 11-157	Exhibit 26-65

---

*Navajo Mine Permit Application Package*

---

Exhibit 11-158	Exhibit 26-66
Exhibit 11-159	Exhibit 26-68
Exhibit 11-161	Exhibit 26-70
Exhibit 11-162	Exhibit 26-72 (Pond 301) Exhibit 26-73 (Pond 302)
Exhibit 11-169	Exhibit 26-85
Exhibit 11-171	Exhibit 22-18
Exhibit 11-172	Exhibit 26-87
Exhibit 11-173	Exhibit 26-88
Exhibit 11-178	Exhibit 26-92
Exhibit 11-179	Exhibit 26-93

APPENDIX 26.C

TABLE OF CONTENTS

TOPIC	PAGE NO.
<b>Sediment Ponds/Impoundments Hydrology Calculations:</b>	
North Cells Modification North Cell A, B, & C.....	1
Barber Loadout .....	11
Area III Shop Pond .....	14
Area III Sewer Pond.....	20
Lowe Loadout .....	23
Northwest Dixon Pond.....	26
Barber Stockpile Pond 1 .....	29
Barber Stockpile Pond 2 .....	39
Barber Stockpile Pond 3 .....	47
Hosteen Stockpile Pond 1 .....	56
Hosteen Stockpile Pond 2 .....	69
Hosteen Stockpile Pond 3 .....	79
Lowe Railroad Impoundment 1 .....	89
Lowe Railroad Impoundment 2 .....	92
Lowe Stockpile Pond .....	95
Southwest Dixon Pond.....	105
Vinnel Pond. ....	115
Lowe Impoundment 1 .....	126
Lowe Hole 3 Pond 2 .....	139
Lowe Hole 3 Pond 3 As-built .....	150
Employee Coal Dump Modification .....	158
Block C Pond 1 .....	161
Block C Pond 2 .....	169
Block C Pond 3 .....	177
Block C Pond 4.....	185
Mason Pond Modification.....	211
CR Pond 4.....	217
South Dixon Pond 4.....	229

APPENDIX 26.C

TABLE OF CONTENTS

TOPIC	PAGE NO.
<b>Sediment Ponds/Impoundments Hydrology Calculations Cont:</b>	
Area 4 North Pond 3 .....	303
Area 4 North Pond 4 .....	309
South Barber Pond – Ramp 5.....	350
Lowe-Dixon Diversion (LDD) Pond A .....	355
Lowe-Dixon Diversion (LDD) Pond A .....	367
North Fork Pond .....	377
Area 4 North Pond 401 .....	383
Area 4 North Pond 402 .....	389
OPEN .....	401
OPEN .....	407
OPEN .....	413
Area 4 North Pond 406 .....	423
Area 4 North Pond 407 .....	429
Area 4 North Pond 408 .....	435
Area 4 North Pond 409 .....	441
Area 4 North Pond 410 .....	447
Area 4 North Pond 411 .....	453
Area 4 North Pond 412 .....	459
Area 4 North Pond 413 .....	480
Pond 301 .....	504
Pond 302 .....	516
Pond 5 &Cell A2.....	530
Pond 306 .....	555
Pond 309A .....	562
Pond 309B.....	569
Pond 414 .....	576
OPEN .....	594
Pond 201 .....	612
Pond 202 .....	630
Pond 310 .....	650
Pond 311 .....	671

# **NORTH CELLS MODIFICATION** **NORTH CELL A, B, & C**

***The watershed area is presented on Exhibit 11-113B and the pond design is presented on Exhibit 11-106. The hydrology model is presented on the attach sheet.***

***Revised June 2010***

LR

BHP Navajo Coal Company  
P.O. Box 1717  
Fruitland, NM 87416

Phone: 505-598-4200

CIVIL SOFTWARE DESIGN

SEDCAD+ Version 3

NORTH SEWER POND 100 YEAR, 6 HOUR, HYDROLOGY CALCULATION

by

Name: Brian Sambirsky

Company Name: BHP MINERALS  
File Name: C:\BRIAN\NSEWER

Date: 02-13-1996

Company Name: BHP MINERALS  
 Filename: C:\BRIAN\NSEWER User: Brian Sambirsky  
 Date: 02-13-1996 Time: 12:23:16  
 North Sewer Pond 100 Year, 6 Hour, Hydrology Calculation  
 Storm: 2.10 inches, 100 year- 6 hour, type II-65  
 Hydrograph Convolution Interval: 0.1 hr

=====

SUBWATERSHED/STRUCTURE INPUT/OUTPUT TABLE

=====

-Hydrology-

JBS	SWS	Area (ac)	CN	UHS	Tc (hrs)	K (hrs)	X	Base- Flow (cfs)	Runoff Volume (ac-ft)	Peak Discharge (cfs)	
111	1	2.20	100	M	0.001	0.000	0.000	0.0	0.38	6.43	
		Type: Null		Label: N. Sewer Pond							
111	Structure	2.20									
111	Total IN/OUT	2.20								0.38	6.43

Civil Software Design -- SEDCAD+ Version 3.1  
Copyright (C) 1987-1992. Pamela J. Schwab. All rights reserved.

Company Name: BHP MINERALS

Filename: C:\BRIAN\NSEWER User: Brian Sambirsky

Date: 02-13-1996 Time: 12:23:16

North Sewer Pond 100 Year, 6 Hour, Hydrology Calculation

Storm: 2.10 inches, 100 year- 6 hour, type II-65

Hydrograph Convolution Interval: 0.1 hr

=====

DETAILED SUBWATERSHED INPUT/OUTPUT TABLE

=====

J	B	S	SWS	Seg. #	Land Flow Condition	Distance (ft)	Slope (%)	Velocity (fps)	Segment Time (hr)	Time Conc. (hr)	Muskingum K (hr)	X
1	1	1	1	-a	5	25.00	20.00	4.47	0.00	0.001		

---


***General Information***

***Storm Information:***

Storm Type:	NM TYPE II 70
Design Storm:	100 yr - 6 hr
Rainfall Depth:	1.960 inches

### Structure Networking:

Type	Stru #	(flows into)	Stru #	Musk. K (hrs)	Musk. X	Description
Null	#1	==>	#2	0.120	0.305	
Null	#2	==>	#4	0.008	0.406	INLET TO CELL A
Null	#3	==>	#4	0.028	0.372	INLET TO CELL A
Null	#4	==>	End	0.000	0.000	

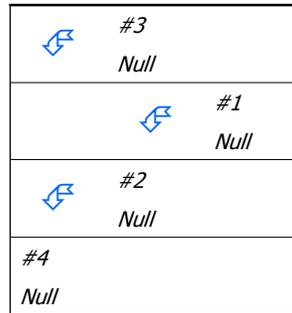

### Structure Routing Details:

Stru #	Land Flow Condition	Slope (%)	Vert. Dist. (ft)	Horiz. Dist. (ft)	Velocity (fps)	Time (hrs)
#1	8. Large gullies, diversions, and low flowing streams	0.78	9.00	1,153.00	2.65	0.120
<b>#1</b>	<b>Muskingum K:</b>					<b>0.120</b>
#2	8. Large gullies, diversions, and low flowing streams	5.98	14.00	234.00	7.33	0.008
<b>#2</b>	<b>Muskingum K:</b>					<b>0.008</b>
#3	8. Large gullies, diversions, and low flowing streams	2.73	14.00	513.00	4.95	0.028
<b>#3</b>	<b>Muskingum K:</b>					<b>0.028</b>

***Structure Summary:***

	Immediate Contributing Area (ac)	Total Contributing Area (ac)	Peak Discharge (cfs)	Total Runoff Volume (ac-ft)
#3	56.100	56.100	70.73	4.22
#1	93.200	93.200	50.07	3.34
#2	55.600	148.800	79.04	6.23
#4	10.000	214.900	138.41	11.39

## ***Structure Detail:***

*Structure #3 (Null)*

*INLET TO CELL A*

*Structure #1 (Null)*

*Structure #2 (Null)*

*INLET TO CELL A*


*Structure #4 (Null)*

### ***Subwatershed Hydrology Detail:***

Stru #	SWS #	SWS Area (ac)	Time of Conc (hrs)	Musk K (hrs)	Musk X	Curve Number	UHS	Peak Discharge (cfs)	Runoff Volume (ac-ft)
#3	1	56.100	0.346	0.000	0.000	91.000	M	70.73	4.223
<b>Σ</b>		<b>56.100</b>						<b>70.73</b>	<b>4.223</b>
#1	1	93.200	0.433	0.000	0.000	80.000	M	50.07	3.337
<b>Σ</b>		<b>93.200</b>						<b>50.07</b>	<b>3.337</b>
#2	1	55.600	0.415	0.000	0.000	88.000	S	32.12	2.893
<b>Σ</b>		<b>148.800</b>						<b>79.04</b>	<b>6.230</b>
#4	1	10.000	0.005	0.000	0.000	91.000	M	23.92	0.939
<b>Σ</b>		<b>214.900</b>						<b>138.41</b>	<b>11.392</b>

### ***Subwatershed Time of Concentration Details:***

Stru #	SWS #	Land Flow Condition	Slope (%)	Vert. Dist. (ft)	Horiz. Dist. (ft)	Velocity (fps)	Time (hrs)
#1	1	5. Nearly bare and untilled, and alluvial valley fans	2.26	22.00	973.00	1.500	0.180
		8. Large gullies, diversions, and low flowing streams	1.50	50.00	3,344.00	3.660	0.253
<b>#1</b>	<b>1</b>	<b>Time of Concentration:</b>					<b>0.433</b>
#2	1	5. Nearly bare and untilled, and alluvial valley fans	2.15	33.00	1,534.00	1.460	0.291
		8. Large gullies, diversions, and low flowing streams	1.31	20.00	1,532.00	3.420	0.124
<b>#2</b>	<b>1</b>	<b>Time of Concentration:</b>					<b>0.415</b>
#3	1	5. Nearly bare and untilled, and alluvial valley fans	3.71	17.00	458.00	1.920	0.066
		8. Large gullies, diversions, and low flowing streams	1.12	36.00	3,206.00	3.170	0.280
<b>#3</b>	<b>1</b>	<b>Time of Concentration:</b>					<b>0.346</b>

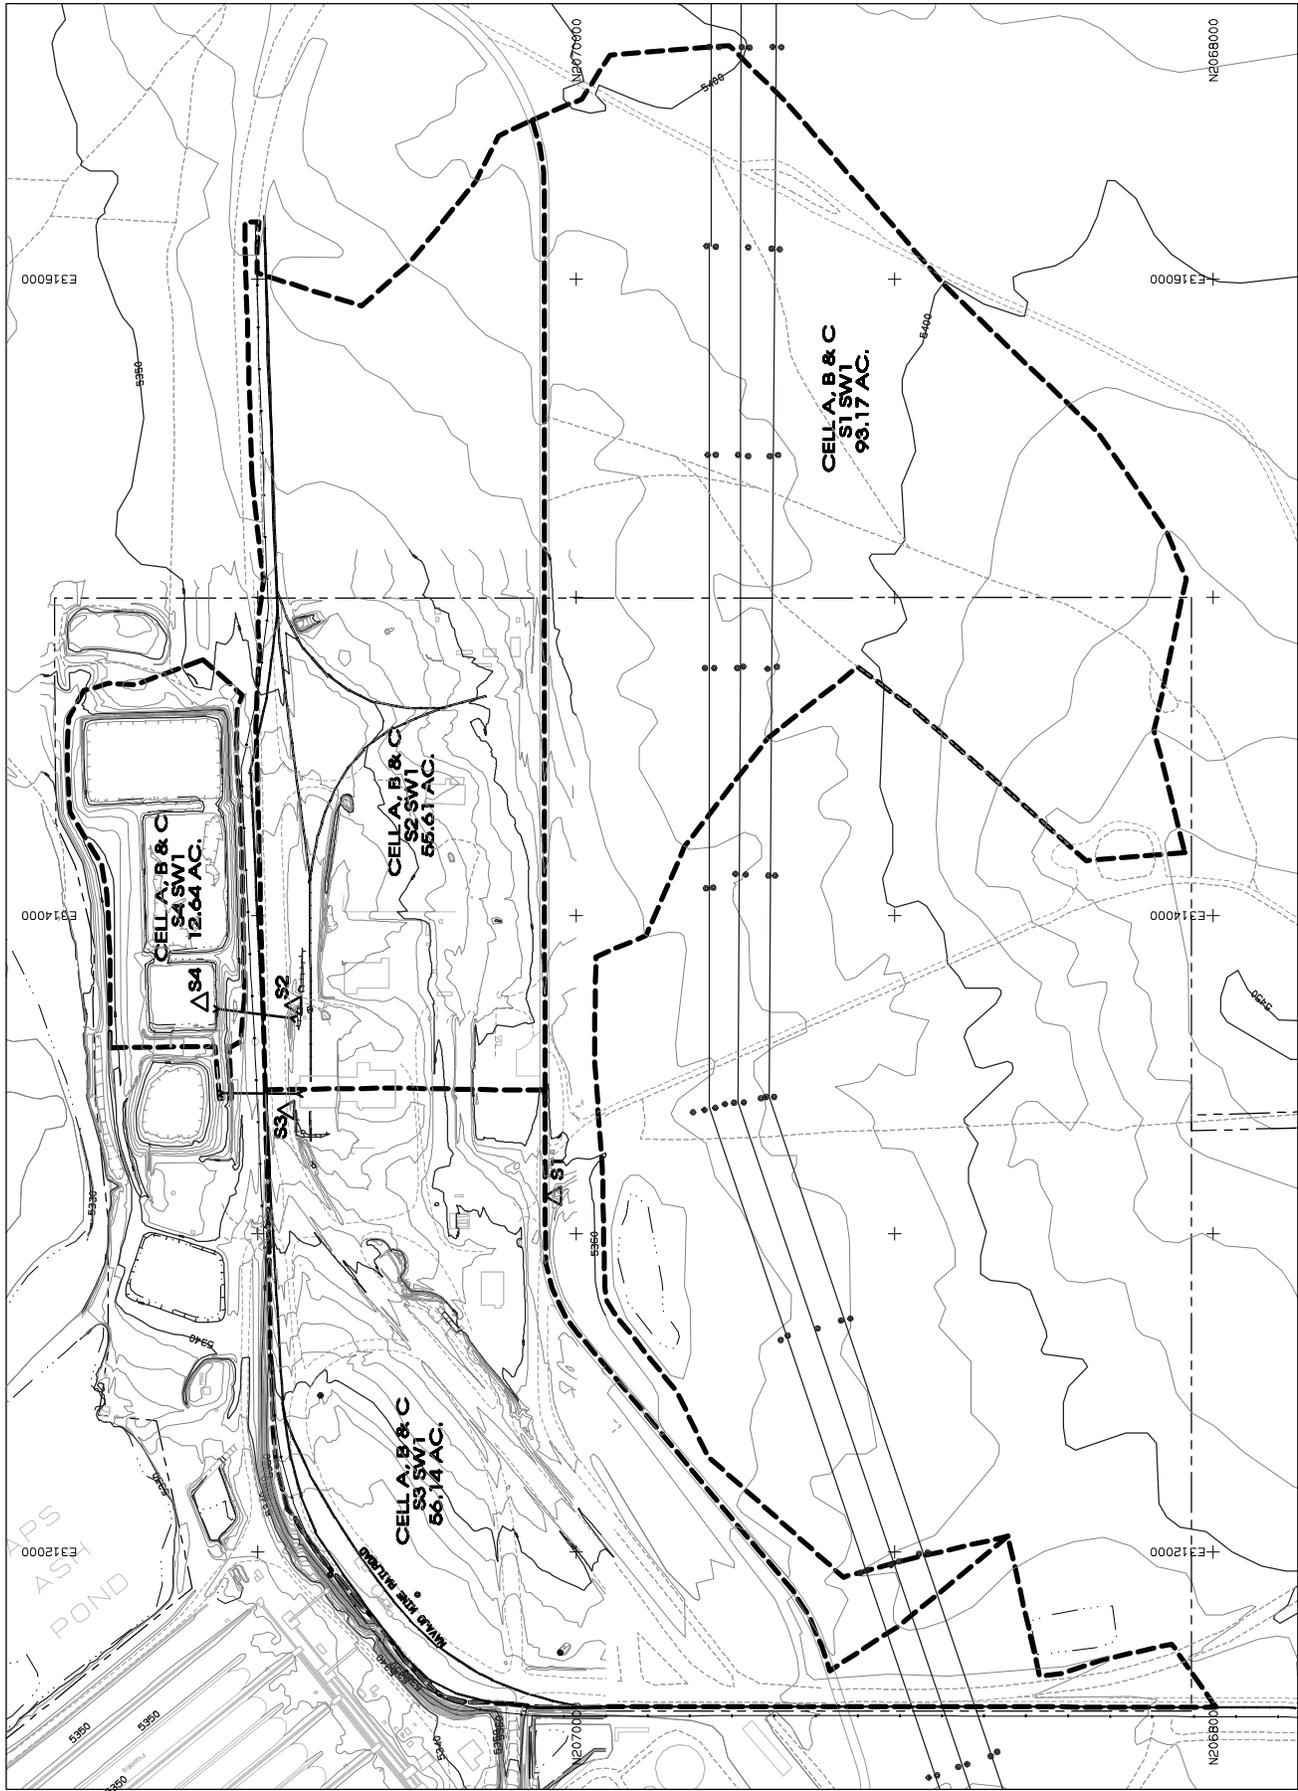

NORTH CELL A, B & C  
HYDROLOGY MODEL

CIVIL SOFTWARE DESIGN

SEDCAD- Version 3

POND 5 PUMP SIMULATION WITH LIFT STATIONS #2, 3 AND 4

by


Name: LR

Company Name: BHP MINERALS  
File Name: G:\USER\kfraylr\PD5\PD5HYD.doc

Date: 06-29-1998

N 2,072,000

5351.4

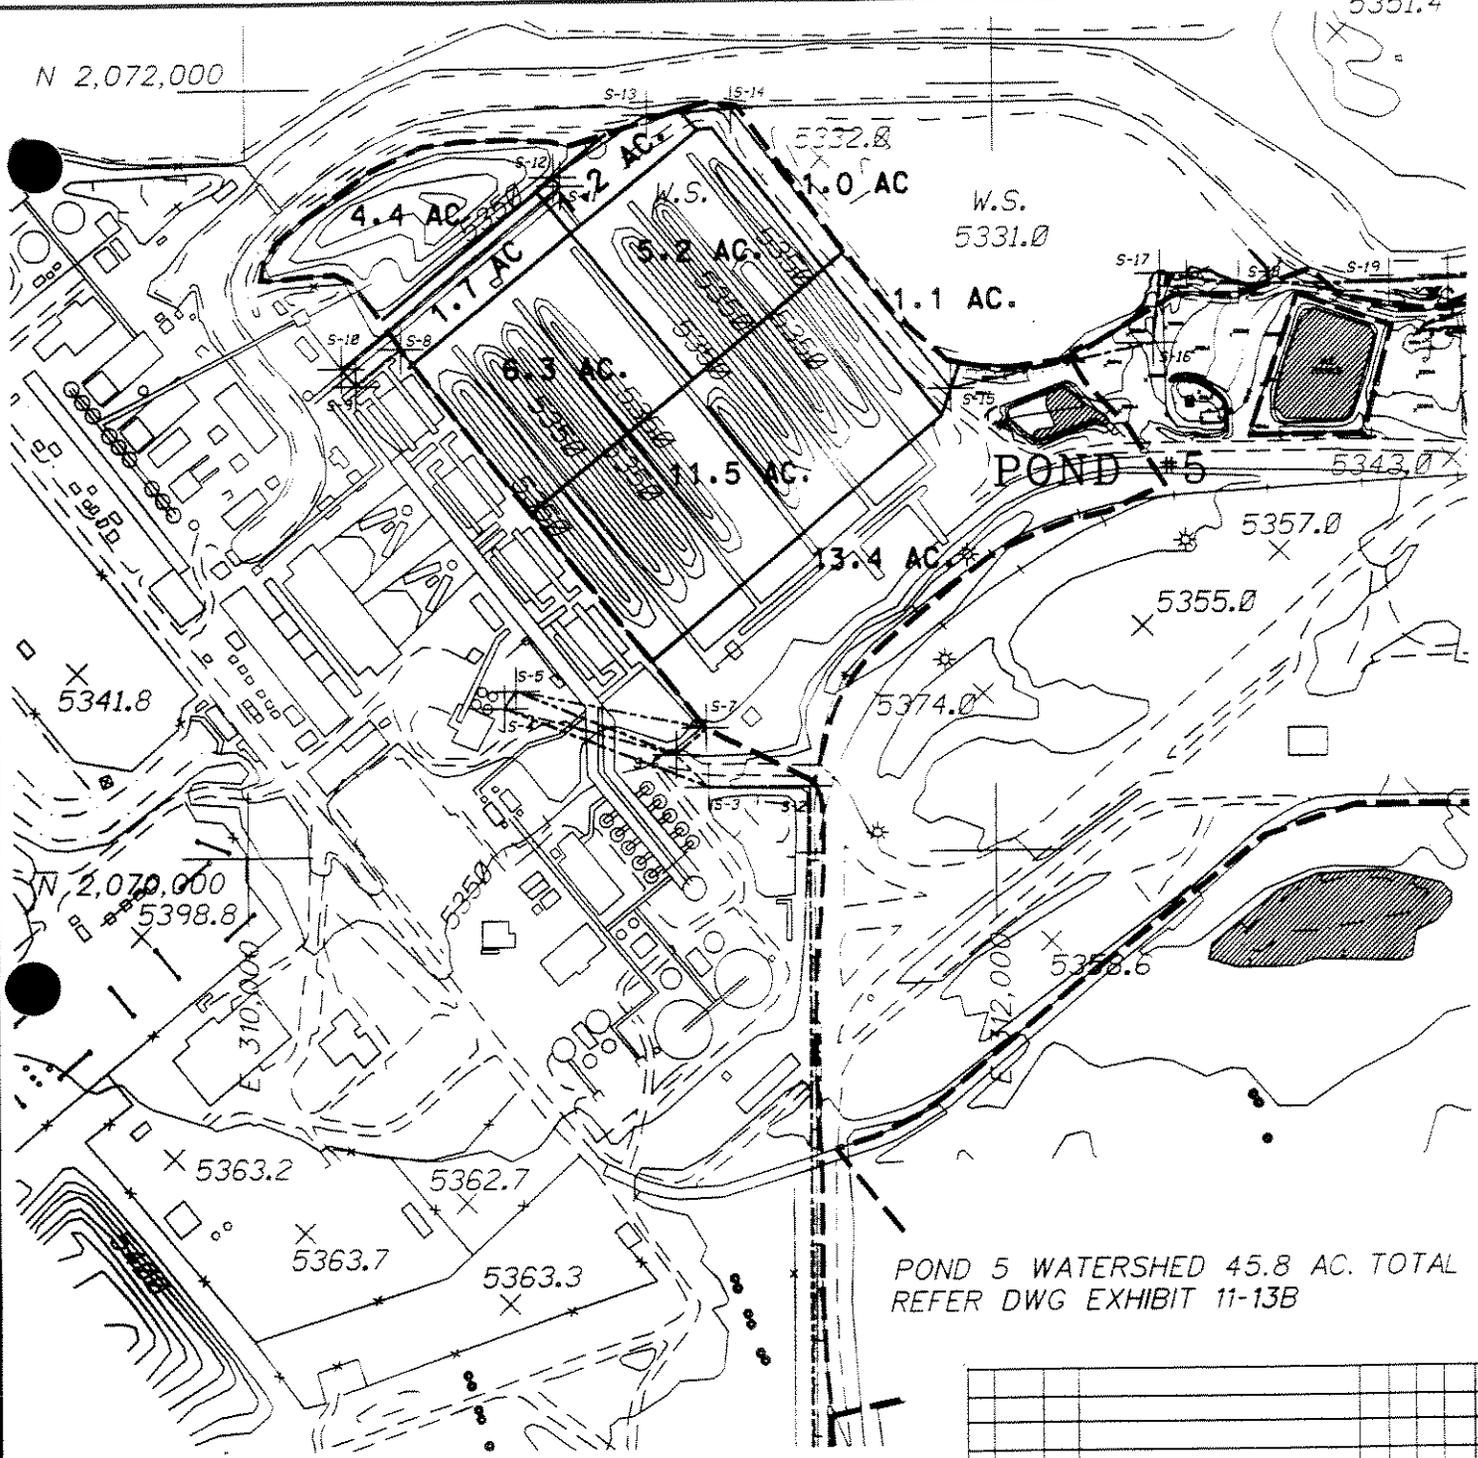

POND 5 WATERSHED 45.8 AC. TOTAL  
REFER DWG EXHIBIT 11-13B


### CERTIFICATION STATEMENT

I, Leonard Raymond, hereby certify that this drawing was reviewed by me and that the information shown is accurate and complete to the best of my knowledge.



A		5-14-97	PJF	SUBMITTED TO OSM FOR APPROVAL	ENG. S.D.P.E. P.E. CHIEF
REV. NO.	DATE	DRAWN BY	REVISION DESCRIPTION	APPROVALS	
<b>BHP NAVAJO COAL COMPANY</b> NAVAJO MINE P.O. BOX 155 FRUITLAND, NEW MEXICO 87416					
<b>POND 5</b> <b>WATERSHED SUB-DIVISIONS</b>					
PREPARED BY		PJF		DRAWN BY	PJF
APPROVED BY		DATE		MAY 13, 1997	
PATH:		ISCALE		1" = 500'	
IDWG		LOC			

# POND 5 SEDCAD MODELING SCHEMATIC

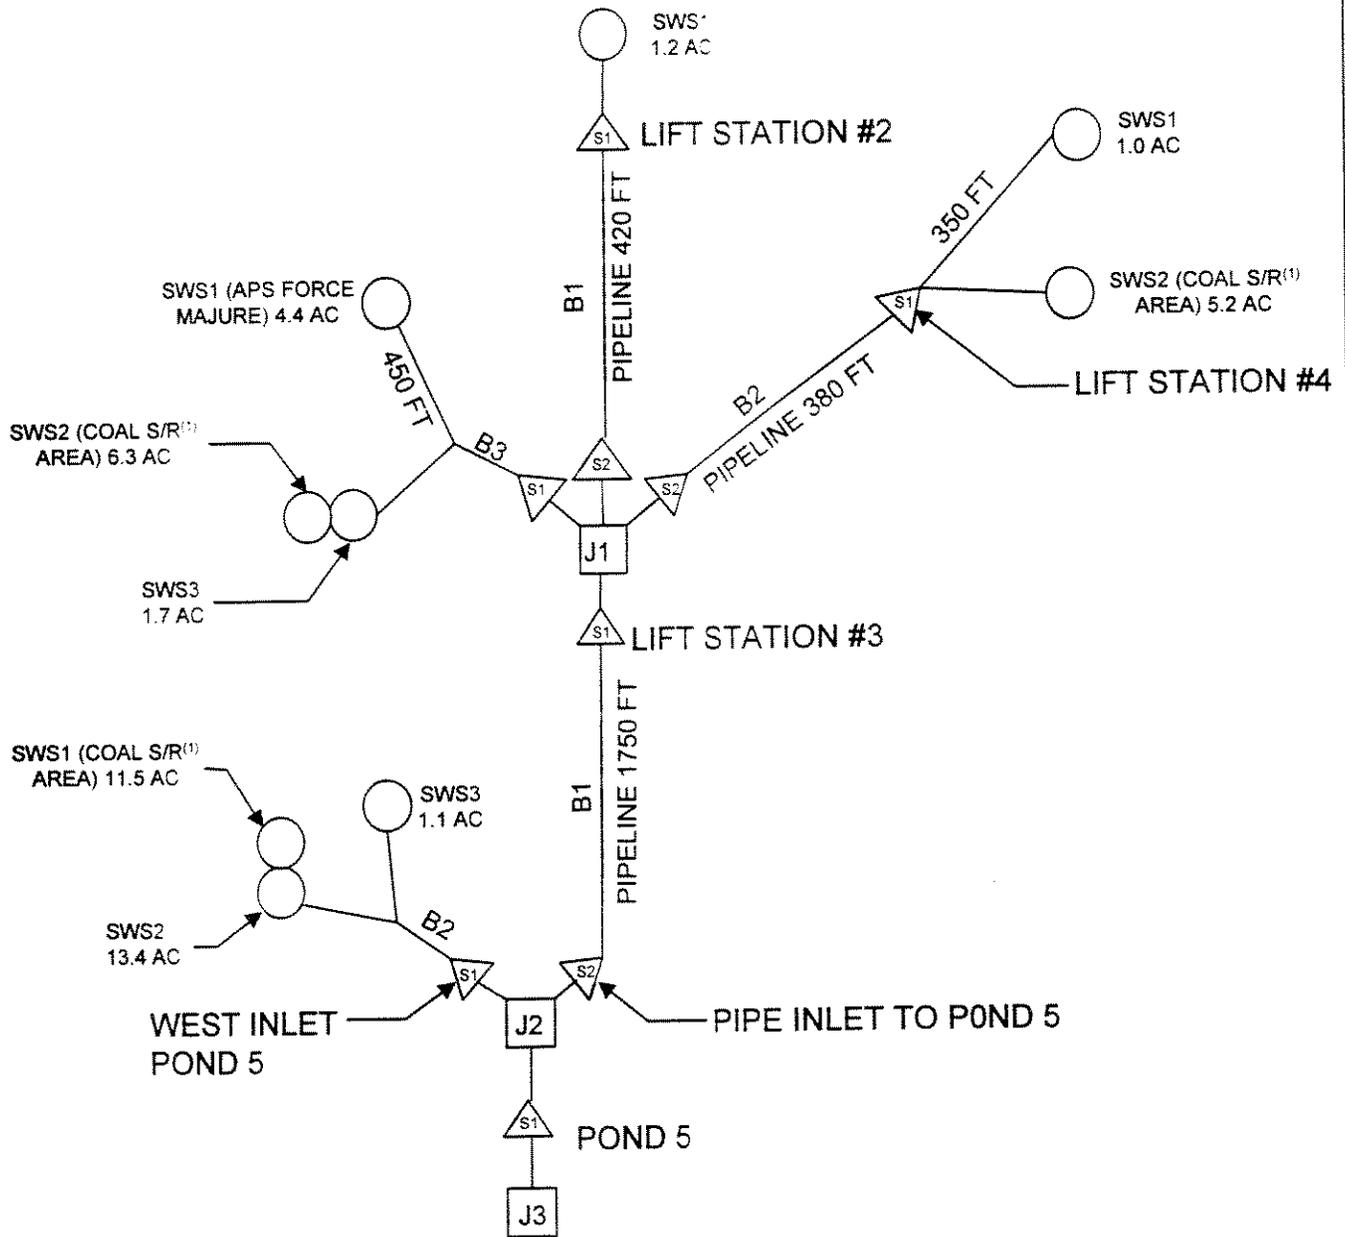

(1) S/R = STACKOUT/RECLAIM

## LEGEND

- J1 JUNCTION
- S1 STRUCTURE
- SUB-WATERSHEDS

Civil Software Design -- SEDCAD+ Version 3.1  
 Copyright (C) 1987-1992. Pamela J. Schwab. All rights reserved.

Company Name: BHP MINERALS  
 Filename: A:\PD5HYD User: LR  
 Date: 06-29-1998 Time: 08:26:25  
 POND 5 PUMP SIMULATION WITH LIFT STATIONS #2, 3 AND 4  
 Storm: 2.00 inches, 100 year- 6 hour, type II-65  
 Hydrograph Convolution Interval: 0.1 hr

=====  
 SUBWATERSHED/STRUCTURE INPUT/OUTPUT TABLE  
 =====

-Hydrology-

JBS SWS	Area (ac)	CN	UHS	To (hrs)	K (hrs)	X	Base- Flow (cfs)	Runoff Volume (ac-ft)	Peak Discharge (cfs)
111 1	1.20	91	M	0.137	0.000	0.000	0.0	0.12	2.15
	Type: Null		Label: LIFT STATION #2						
111 Structure	1.20							0.12	
111 Total IN/OUT	1.20							0.12	2.15
112 1	0.00	0	M	0.000	0.000	0.000	0.0	0.00	0.00
	Type: Null		Label: PIPE LIFT STA 2 TO 3						
112 Structure	0.00							0.12	
112 Total IN/OUT	1.20							0.12	2.02
111 to 112 Routing					0.054	0.277			
121 1	1.00	91	M	0.196	0.045	0.277	0.0	0.10	1.68
121 2	5.20	60	M	0.074	0.000	0.000	0.0	0.03	0.58
	Type: Null		Label: LIFT STATION #4						
121 Structure	6.20							0.12	
121 Total IN/OUT	6.20							0.12	2.12
122 1	0.00	0	M	0.000	0.000	0.000	0.0	0.00	0.00
	Type: Null		Label: PIPE LIFT STA 4 TO 3						
122 Structure	0.00							0.12	
122 Total IN/OUT	6.20							0.12	2.12
121 to 122 Routing					0.049	0.277			
131 1	4.40	60	M	0.035	0.058	0.277	0.0	0.02	0.49
131 2	6.30	60	M	0.065	0.000	0.000	0.0	0.03	0.71
131 3	1.70	91	M	0.117	0.000	0.000	0.0	0.16	3.83
	Type: Null		Label: WATERSHEDS TO LS #3						
131 Structure	12.40							0.21	
131 Total IN/OUT	12.40							0.21	4.76

211 1	0.00	0	M	0.000	0.000	0.000	0.0	0.00	0.00
	Type: Null		Label: LIFT STATION #3						
211 Structure	0.00							0.46	
211 Total IN/OUT	19.80							0.46	8.58
112 to 211 Routing				0.001	0.319				
212 1	0.00	0	M	0.000	0.000	0.000	0.0	0.00	0.00
	Type: Null		Label: NORTH INLET TO PD 5						
212 Structure	0.00							0.46	
212 Total IN/OUT	19.80							0.46	6.72
211 to 212 Routing				0.229	0.277				
221 1	11.50	60	M	0.176	0.000	0.000	0.0	0.06	0.59
221 2	13.40	91	M	0.205	0.000	0.000	0.0	1.30	22.11
221 3	1.10	91	M	0.196	0.000	0.000	0.0	0.11	1.85
	Type: Null		Label: WEST INLET TO PD 5						
221 Structure	26.00							1.46	
221 Total IN/OUT	26.00							1.46	23.99
311 1	0.00	0	M	0.000	0.000	0.000	0.0	0.00	0.00
	Type: Pond		Label: POND 5						
311 Structure	0.00							1.92	
311 Total IN	45.80							1.92	28.26
311 Total OUT								1.92	3.12
212 to 311 Routing				0.001	0.319				

Civil Software Design -- SEDCAD+ Version 3.1  
 Copyright (C) 1987-1992. Pamela J. Schwab. All rights reserved.

Company Name: BHP MINERALS  
 Filename: A:\PD5HYD User: LR  
 Date: 06-29-1998 Time: 08:26:25  
 POND 5 PUMP SIMULATION WITH LIFT STATIONS #2, 3 AND 4  
 Storm: 2.00 inches, 100 year- 6 hour, type II-65  
 Hydrograph Convolution Interval: 0.1 hr

=====

DETAILED SUBWATERSHED INPUT/OUTPUT TABLE

=====

J	B	S	SWS	Seg. #	Land Flow Condition	Distance (ft)	Slope (%)	Velocity (fps)	Segment Time (hr)	Time Conc. (hr)	Muskingum K (hr)	X
1	1	1	1	-a	5	350.00	0.50	0.71	0.14	0.137		
1	2	1	1	-a	5	500.00	0.50	0.71	0.20	0.196		
1	2	1	1	-1	8	350.00	0.50	2.12	0.05		0.045	0.277
1	2	1	2	-a	5	600.00	5.00	2.24	0.07	0.074		
1	3	1	1	-a	5	400.00	10.00	3.16	0.04	0.035		
1	3	1	1	-1	8	450.01	0.50	2.12	0.06		0.058	0.277
1	3	1	2	-a	5	550.00	5.45	2.34	0.07	0.065		
1	3	1	3	-a	5	300.00	0.50	0.71	0.12	0.117		
2	2	1	1	-a	5	1100.00	3.00	1.73	0.18	0.176		
2	2	1	2	-a	5	1300.00	3.08	1.75	0.21	0.205		
2	2	1	3	-a	5	500.00	0.50	0.71	0.20	0.196		

Civil Software Design -- SEDCAD+ Version 3.1  
Copyright (C) 1987-1992. Pamela J. Schwab. All rights reserved.

Company Name: BHP MINERALS  
Filename: A:\PD5HYD User: LR  
Date: 06-29-1998 Time: 08:26:25  
POND 5 PUMP SIMULATION WITH LIFT STATIONS #2, 3 AND 4  
Storm: 2.00 inches, 100 year- 6 hour, type II-65  
Hydrograph Convolution Interval: 0.1 hr

=====  
LAST POND ONLY TABLE  
=====

J3, B1, S1  
POND 5

Drainage Area from J3, B1, S1, SWS's 1: 0.0 acres  
Total Contributing Drainage Area: 45.8 acres

DISCHARGE OPTIONS:

Input a Known Discharge

POND RESULTS:

Permanent  
Pool  
(ac-ft)  
=====  
0.0

	Runoff Volume (ac-ft)	Peak Discharge (cfs)
IN	1.92	28.26
OUT	1.92	3.12

Peak Elevation	Hydrograph Detention Time (hrs)
5331.3	3.09

\*\*\*\*\*

Civil Software Design -- SEDCAD+ Version 3.1  
 Copyright (C) 1987-1992. Pamela J. Schwab. All rights reserved.

Company Name: BHP MINERALS  
 Filename: A:\PD5HYD User: LR  
 Date: 06-29-1998 Time: 08:26:25  
 POND 5 PUMP SIMULATION WITH LIFT STATIONS #2, 3 AND 4  
 Storm: 2.00 inches, 100 year- 6 hour, type II-65  
 Hydrograph Convolution Interval: 0.1 hr

=====  
 ELEVATION-AREA-CAPACITY-DISCHARGE TABLE  
 =====

J3, B1, S1  
 POND 5

Drainage Area from J3, B1, S1, SWS(s)1: 0.0 acres  
 Total Contributing Drainage Area: 45.8 acres

SW#1: Input Discharge

Elev	Stage (ft)	Area (ac)	Capacity (ac-ft)	Discharge (cfs)	
5328.40	0.00	0.39	0.00	0.00	
5328.41	0.01	0.39	0.00	0.00	
5328.90	0.50	0.42	0.20	3.12	
5329.00	0.60	0.43	0.25	3.12	
5329.40	1.00	0.45	0.42	3.12	
5329.90	1.50	0.47	0.65	3.12	
5330.00	1.60	0.47	0.70	3.12	
5330.40	2.00	0.49	0.89	3.12	
5330.90	2.50	0.51	1.13	3.12	
5331.00	2.60	0.51	1.19	3.12	
5331.26	2.86	0.52	1.32	3.12	Peak Stage
5331.40	3.00	0.53	1.39	3.12	
5331.90	3.50	0.55	1.66	3.12	
5332.40	4.00	0.57	1.94	3.12	
5332.90	4.50	0.59	2.23	3.12	
5333.00	4.60	0.60	2.29	3.12	

\*\*\*\*\*

CIVIL SOFTWARE DESIGN

SEDCAD+ Version 3

BARBER LOADOUT 100 YEAR, 6HOUR HYDROLOGY CALCULATION

by

Name: Brian Sambirsky

Company Name: BHP MINERALS  
File Name: A:\SEDCAD\BARBER-6

Date: 09-29-1995

Company Name: BHP MINERALS  
 Filename: A:\SEDCAD\BARBER-6 User: Brian Sambirsky  
 Date: 09-29-1995 Time: 09:34:57  
 Barber Loadout 100 year, 6hour Hydrology Calculation  
 Storm: 2.10 inches, 100 year- 6 hour, type II-65  
 Hydrograph Convolution Interval: 0.1 hr

=====  
 SUBWATERSHED/STRUCTURE INPUT/OUTPUT TABLE  
 =====

-Hydrology-

BS	SWS	Area (ac)	CN	UHS	Tc (hrs)	K (hrs)	X	Base- Flow (cfs)	Runoff Volume (ac-ft)	Peak Discharge (cfs)
11	1	3.60	89	M	0.010	0.000	0.000	0.0	0.33	8.01
		Type: Null		Label: Barber Loadout						
11	Structure	3.60							0.33	
11	Total IN/OUT	3.60							0.33	8.01

Company Name: BHP MINERALS

Filename: A:\SEDCAD\BARBER-6 User: Brian Sambirsky

Date: 09-29-1995 Time: 09:34:57

Barber Loadout 100 year, 6hour Hydrology Calculation

Storm: 2.10 inches, 100 year- 6 hour, type II-65

Hydrograph Convolution Interval: 0.1 hr

=====

DETAILED SUBWATERSHED INPUT/OUTPUT TABLE

=====

B	S	SWS	Seg. #	Land Flow Condition	Distance (ft)	Slope (%)	Velocity (fps)	Segment Time (hr)	Time Conc. (hr)	Muskingum K	X
1	1	1	-a	5	140.00	14.29	3.78	0.01	0.010		

CIVIL SOFTWARE DESIGN

SEDCAD+ Version 3 .

AREA III SHOP POND 100 YEAR, 6 HOUR HYDROLOGY CALCULATION

by

Name: Brian Sambirsky

Company Name: BHP MINERALS  
File Name: C:\BRIAN\A3SHOP

Date: 03-08-1996

Company Name: BHP MINERALS  
 Filename: C:\BRIAN\A3SHOP User: Brian Sambirsky  
 Date: 03-08-1996 Time: 12:29:30  
 Area III Shop Pond 100 Year, 6 Hour Hydrology Calculation  
 Storm: 2.10 inches, 100 year- 6 hour, type II-65  
 Hydrograph Convolution Interval: 0.1 hr

=====

SUBWATERSHED/STRUCTURE INPUT/OUTPUT TABLE

=====

-Hydrology-

JBS	SWS	Area (ac)	CN	UHS	Tc (hrs)	K (hrs)	X	Base- Flow (cfs)	Runoff Volume (ac-ft)	Peak Discharge (cfs)
111	1	33.15	88	M	0.299	0.000	0.000	0.0	2.82	42.26
111	Structure	33.15	Type: Null		Label: Area III Shop Pond				2.82	
111	Total IN/OUT	33.15							2.82	42.26

Company Name: BHP MINERALS  
 Filename: C:\BRIAN\A3SHOP User: Brian Sambirsky  
 Date: 03-08-1996 Time: 12:29:30  
 Area III Shop Pond 100 Year, 6 Hour Hydrology Calculation  
 Storm: 2.10 inches, 100 year- 6 hour, type II-65  
 Hydrograph Convolution Interval: 0.1 hr

=====

DETAILED SUBWATERSHED INPUT/OUTPUT TABLE

=====

J	B	S	SWS	Seg. #	Land Flow Condition	Distance (ft)	Slope (%)	Velocity (fps)	Segment Time (hr)	Time Conc. (hr)	Muskingum K (hr)	X
1	1	1	1	-a	5	1800.00	2.78	1.67	0.30	0.299		

CIVIL SOFTWARE DESIGN

SEDCAD+ Version 3

AREA III SEWER POND 100 YEAR, 6 HOUR HYDROLOGY CALCULATION

by

Name: Brian Sambirsky

Company Name: BHP MINERALS  
File Name: A:\SEDCAD\A3SEWE-6

Date: 09-29-1995

Company Name: BHP MINERALS  
 Filename: A:\SEDCAD\A3SEWE-6 User: Brian Sambirsky  
 Date: 09-29-1995 Time: 09:35:47  
 Area III Sewer Pond 100 year, 6 hour Hydrology Calculation  
 Storm: 2.10 inches, 100 year- 6 hour, type II-65  
 Hydrograph Convolution Interval: 0.1 hr

=====  
 SUBWATERSHED/STRUCTURE INPUT/OUTPUT TABLE  
 =====

-Hydrology-

BS	SWS	Area (ac)	CN	UHS	Tc (hrs)	K (hrs)	X	Base- Flow (cfs)	Runoff Volume (ac-ft)	Peak Discharge (cfs)	
01	1	1.20	89	M	0.000	0.000	0.000	0.0	0.11	2.67	
		Type: Null		Label: Area III Sewer							
.1	Structure	1.20									
-----											
.1	Total IN/OUT	1.20								0.11	2.67
=====											

Company Name: BHP MINERALS

Filename: A:\SEDCAD\A3SEWE-6 User: Brian Sambirsky

Date: 09-29-1995 Time: 09:35:47

Area III Sewer Pond 100 year, 6 hour Hydrology Calculation

Storm: 2.10 inches, 100 year- 6 hour, type II-65

Hydrograph Convolution Interval: 0.1 hr

=====  
 DETAILED SUBWATERSHED INPUT/OUTPUT TABLE  
 =====

I	B	S	SWS	Seg. #	Land Flow Condition	Distance (ft)	Slope (%)	Velocity (fps)	Segment	Time	Muskingum	
									Time (hr)	Conc. (hr)	K	X
.	1	1	1	-a	5	15.00	33.33	5.77	0.00	0.000		

CIVIL SOFTWARE DESIGN

SEDCAD+ Version 3

LOWE LOADOUT 100 YEAR, 6 HOUR HYDROLOGY CALCULATION

by

Name: Brian Sambirsky

Company Name: BHP MINERALS  
File Name: A:\SEDCAD\LOWE-6

Date: 09-29-1995

Company Name: BHP MINERALS  
 Filename: A:\SEDCAD\LOWE-6 User: Brian Sambirsky  
 Date: 09-29-1995 Time: 09:36:37  
 Low Loadout 100 year, 6 hour Hydrology Calculation  
 Storm: 2.10 inches, 100 year- 6 hour, type II-65  
 Hydrograph Convolution Interval: 0.1 hr

=====

SUBWATERSHED/STRUCTURE INPUT/OUTPUT TABLE

=====

-Hydrology-

BS	SWS	Area (ac)	CN	UHS	Tc (hrs)	K (hrs)	X	Base- Flow (cfs)	Runoff Volume (ac-ft)	Peak Discharge (cfs)
11	1	3.40	89	M	0.001	0.000	0.000	0.0	0.31	7.57
			Type: Null		Label: Low Loadout					
11	Structure	3.40							0.31	
11	Total IN/OUT	3.40							0.31	7.57

Company Name: BHP MINERALS

Filename: A:\SEDCAD\LOWE-6 User: Brian Sambirsky

Date: 09-29-1995 Time: 09:36:37

Low Loadout 100 year, 6 hour Hydrology Calculation

Storm: 2.10 inches, 100 year- 6 hour, type II-65

Hydrograph Convolution Interval: 0.1 hr

=====

DETAILED SUBWATERSHED INPUT/OUTPUT TABLE

=====

B	S	SWS	Seg. #	Land Flow Condition	Distance (ft)	Slope (%)	Velocity (fps)	Segment Time (hr)	Time Conc. (hr)	Muskingum K (hr)	X
1	1	1	-a	5	30.00	40.00	6.32	0.00	0.001		

CIVIL SOFTWARE DESIGN

SEDCAD+ Version 3

NORTHWEST DIXON POND HYDROLOGY - 100 YR 6 HR STORM EVENT

by

Name: BEN HOSKIE

Company Name: BHP MINERALS  
File Name: C:\BEN\PONDS\NWDXPND

Date: 07-05-1998

Civil Software Design -- SEDCAD+ Version 3.1  
 Copyright (C) 1987-1992. Pamela J. Schwab. All rights reserved.

Company Name: BHP MINERALS  
 Filename: C:\BEN\PONDS\NWDXPND User: BEN HOSKIE  
 Date: 07-15-1998 Time: 16:05:04  
 NORTHWEST DIXON POND HYDROLOGY - 100 YR 6 HR STORM EVENT  
 Storm: 2.10 inches, 100 year- 6 hour, type II-65  
 Hydrograph Convolution Interval: 0.1 hr

=====

SUBWATERSHED/STRUCTURE INPUT/OUTPUT TABLE

=====

-Hydrology-

JBS SWS	Area (ac)	CN	UHS	Tc (hrs)	K (hrs)	X	Base- Flow (cfs)	Runoff Volume (ac-ft)	Peak Discharge (cfs)
111 1	62.20	33	M	0.452	0.000	0.000	0.0	3.96	47.84
		Type: Null		Label: NW DIXON POND				3.96	
111 Structure	62.20								
111 Total IN/OUT	62.20							3.96	47.84

Civil Software Design -- SEDCAD+ Version 3.1  
 Copyright (C) 1987-1992. Pamela J. Schwab. All rights reserved.

Company Name: BHP MINERALS  
 Filename: C:\BEN\PONDS\NWDKFND User: BEN HOSKIE  
 Date: 07-05-1998 Time: 16:05:04  
 NORTHWEST DIXON POND HYDROLOGY - 100 YR 6 HR STORM EVENT  
 Storm: 2.10 inches, 100 year- 6 hour, type II-65  
 Hydrograph Convolution Interval: 0.1 hr

=====

DETAILED SUBWATERSHED INPUT/OUTPUT TABLE

=====

J	B	S	SWS	Seg. #	Land Flow Condition	Distance (ft)	Slope (%)	Velocity (fps)	Segment Time (hr)	Time Conc. (hr)	Muskingum K (hr)	X
1	1	1	1	-a	5	2162.00	1.76	1.33	0.45	0.452		

CIVIL SOFTWARE DESIGN

SEDCAD+ Version 3

AS BUILT DESIGN HYDROLOGY CALCULATION - BARBER STOCKPILE POND #1

by

Name: Brian Sambirsky

Company Name: BHP MINERALS  
File Name: C:\BRIAN\BARBER1

Date: 06-13-1996

Company Name: BHP MINERALS

Filename: C:\BRIAN\BARBER1 User: Brian Sambirsky

Date: 06-13-1996 Time: 07:55:44

As built design hydrology calculation - barber stockpile pond #1  
 Storm: 1.58 inches, 10 year-24 hour, Type II-65  
 Hydrograph Convolution Interval: 0.1 hr

=====

SUBWATERSHED/STRUCTURE INPUT/OUTPUT TABLE

=====

-Hydrology-

JBS	SWS	Area (ac)	CN	UHS	Tc (hrs)	K (hrs)	X	Base- Flow (cfs)	Runoff Volume (ac-ft)	Peak Discharge (cfs)
111	1	146.60	82	M	0.905	0.000	0.000	0.0	4.81	25.37
		Type: Null		Label: Barber Stockpile #1						
111	Structure	146.60							4.81	
111	Total IN/OUT	146.60							4.81	25.37

Company Name: BHP MINERALS

Filename: C:\BRIAN\BARBER1 User: Brian Sambirsky

Date: 06-13-1996 Time: 07:55:44

As built design hydrology calculation - barber stockpile pond #1  
 Storm: 1.58 inches, 10 year-24 hour, Type II-65

Hydrograph Convolution Interval: 0.1 hr

=====

DETAILED SUBWATERSHED INPUT/OUTPUT TABLE

=====

J	B	S	SWS	Seg. #	Land Flow Condition	Distance (ft)	Slope (%)	Velocity (fps)	Segment Time (hr)	Time Conc. (hr)	Muskingum K (hr)	X
1	1	1	1	-a	5	4575.00	1.97	1.40	0.91	0.905		

CIVIL SOFTWARE DESIGN

SEDCAD+ Version 3

AS BUILT DESIGN HYDROLOGY CALCULATION - BARBER STOCKPILE #1 SPILLWAY

by

Name: Brian Sambirsky

Company Name: BHP MINERALS  
File Name: C:\BRIAN\BARBER1

Date: 06-19-1996

Company Name: BHP MINERALS

Filename: C:\BRIAN\BARBER1

User: Brian Sambirsky

Date: 06-19-1996 Time: 12:27:04

As built design hydrology calculation - barber stockpile #1 spillway  
 Storm: 1.60 inches, 25 year- 6 hour, Type II-65

Hydrograph Convolution Interval: 0.1 hr

=====

SUBWATERSHED/STRUCTURE INPUT/OUTPUT TABLE

=====

-Hydrology-

JBS	SWS	Area (ac)	CN	UHS	Tc (hrs)	K (hrs)	X	Base- Flow (cfs)	Runoff Volume (ac-ft)	Peak Discharge (cfs)
111	1	146.60	82	M	0.905	0.000	0.000	0.0	4.95	36.56
		Type: Pond		Label: Barber Stockpile #1						
111	Structure	146.60							4.95	
-----										
111	Total IN	146.60							4.95	36.56
111	Total OUT								4.95	26.52
=====										

Company Name: BHP MINERALS

Filename: C:\BRIAN\BARBER1

User: Brian Sambirsky

Date: 06-19-1996 Time: 12:27:04

As built design hydrology calculation - barber stockpile #1 spillway

Storm: 1.60 inches, 25 year- 6 hour, Type II-65

Hydrograph Convolution Interval: 0.1 hr

=====

DETAILED SUBWATERSHED INPUT/OUTPUT TABLE

=====

J	B	S	SWS	Seg. #	Land Flow Condition	Distance (ft)	Slope (%)	Velocity (fps)	Segment Time (hr)	Time Conc. (hr)	Muskingum K (hr)	X
1	1	1	1	-a	5	4575.00	1.97	1.40	0.91	0.905		

Company Name: BHP MINERALS

Filename: C:\BRIAN\BARBER1

User: Brian Sambirsky

Date: 06-19-1996 Time: 12:27:04

As built design hydrology calculation - barber stockpile #1 spillway

Storm: 1.60 inches, 25 year- 6 hour, Type II-65

Hydrograph Convolution Interval: 0.1 hr

=====  
 POND INPUT/OUTPUT TABLE  
 =====

J1, B1, S1  
 Barber Stockpile #1

Drainage Area from J1, B1, S1, SWS(s)1: 146.6 acres  
 Total Contributing Drainage Area: 146.6 acres

DISCHARGE OPTIONS:

Emergency  
 Spillway

Riser Diameter (in)	----
Riser Height (ft)	----
Barrel Diameter (in)	----
Barrel Length (ft)	----
Barrel Slope (%)	----
Manning's n of Pipe	----
Spillway Elevation	----
Lowest Elevation of Holes	----
# of Holes/Elevation	----
Entrance Loss Coefficient	----
Tailwater Depth (ft)	----
Notch Angle (degrees)	----
Weir Width (ft)	----
Siphon Crest Elevation	----
Siphon Tube Diameter (in)	----
Siphon Tube Length (ft)	----
Manning's n of Siphon	----
Siphon Inlet Elevation	----
Siphon Outlet Elevation	----
Emergency Spillway Elevation	5289.6
Crest Length (ft)	20.0
Z:1 (Left and Right)	5.0 4.0
Bottom Width (ft)	20.0

POD RESULTS:

Permanent  
 Pool  
 (ac-ft)

=====  
 9.9 35

Company Name: BHP MINERALS  
 Filename: C:\BRIAN\BARBER1 User: Brian Sambirsky  
 Date: 06-19-1996 Time: 12:27:04  
 As built design hydrology calculation - barber stockpile #1 spillway  
 Storm: 1.60 inches, 25 year- 6 hour, Type II-65  
 Hydrograph Convolution Interval: 0.1 hr

=====  
 ELEVATION-DISCHARGE TABLE  
 =====

J1, B1, S1  
 Barber Stockpile #1

Drainage Area from J1, B1, S1, SWS(s)1: 146.6 acres  
 Total Contributing Drainage Area: 146.6 acres

Elevation	Emergency Spillway (cfs)	Total Discharge (cfs)
5280.00	0.0	0.0
5281.00	0.0	0.0
5282.00	0.0	0.0
5283.00	0.0	0.0
5284.00	0.0	0.0
5285.00	0.0	0.0
5286.00	0.0	0.0
5287.00	0.0	0.0
5288.00	0.0	0.0
5289.00	0.0	0.0
5289.60	0.0	0.0
5290.00	13.3	13.3
5290.20	19.9	19.9
5290.30	25.8	25.8
5290.40	33.9	33.9
5290.50	41.9	41.9
5290.60	51.6	51.6
5291.00	96.7	96.7
5291.10	109.9	109.9
5291.60	190.8	190.8
5292.00	270.6	270.6

\*\*\*\*\*

Company Name: BHP MINERALS  
 Filename: C:\BRIAN\BARBER1 User: Brian Sambirsky  
 Date: 06-19-1996 Time: 12:27:04  
 As built design hydrology calculation - barber stockpile #1 spillway  
 Storm: 1.60 inches, 25 year- 6 hour, Type II-65  
 Hydrograph Convolution Interval: 0.1 hr

=====

ELEVATION-AREA-CAPACITY-DISCHARGE TABLE

=====

J1, B1, S1  
 Barber Stockpile #1

Drainage Area from J1, B1, S1, SWS(s)1: 146.6 acres  
 Total Contributing Drainage Area: 146.6 acres

SW#1: Emergency Spillway

Elev	Stage (ft)	Area (ac)	Capacity (ac-ft)	Discharge (cfs)	
5280.00	0.00	0.58	0.00	0.00	
5281.00	1.00	0.66	0.62	0.00	
5282.00	2.00	0.75	1.32	0.00	
5283.00	3.00	0.83	2.11	0.00	
5284.00	4.00	0.94	3.00	0.00	
5285.00	5.00	1.03	3.98	0.00	
5286.00	6.00	1.14	5.07	0.00	
5287.00	7.00	1.25	6.26	0.00	
5288.00	8.00	1.38	7.58	0.00	
5289.00	9.00	1.50	9.02	0.00	
5289.60	9.60	1.58	9.94	0.00	Stage of SW#1
5290.00	10.00	1.64	10.59	13.28	
5290.20	10.20	1.66	10.92	19.92	
5290.30	10.30	1.67	11.08	25.75	
5290.31	10.31	1.67	11.10	26.52	Peak Stage
5290.40	10.40	1.68	11.25	33.85	
5290.50	10.50	1.68	11.42	41.88	
5290.60	10.60	1.69	11.59	51.61	
5291.00	11.00	1.73	12.27	96.71	
5291.10	11.10	1.74	12.44	109.88	
5291.60	11.60	1.77	13.32	190.79	
5292.00	12.00	1.80	14.04	270.63	

\*\*\*\*\*

	Runoff Volume (ac-ft)	Peak Discharge (cfs)
IN	4.95	36.56
OUT	4.95	26.52

Peak Elevation	Hydrograph Detention Time (hrs)
5290.3	0.00

\*\*\*\*\*

## **Barber Stockpile Pond 2**

***This pond has a single closed spillway. It is re-evaluated as a total containment structure for the 100 year-6 hour storm. The curve number was adjusted to account for the reclaimed lands. Refer to Section 11.5.4.3 of the mine permit for discussion on ponds with a single closed spillway. The pond location and watershed areas are presented on Exhibit 11-13 C & D.***

LR

BHP Navajo Coal Company  
PO Box 1717  
Fruitland, NM  
87416

***General Information***

***Storm Information:***

Storm Type:	Type II-60
Design Storm:	100 yr - 6 hr
Rainfall Depth:	2.000 inches

**Structure Networking:**

Type	Stru #	(flows into)	Stru #	Musk. K (hrs)	Musk. X	Description
Pond	#1	==>	End	0.000	0.000	Barber #2

#1  
Pond

**Structure Summary:**

		Immediate Contributing Area (ac)	Total Contributing Area (ac)	Peak Discharge (cfs)	Total Runoff Volume (ac-ft)
#1	In	106.600	106.600	82.12	5.72
	Out			0.00	0.00

### Structure Detail:

Structure #1 (Pond)

Barber #2

Pond Inputs:

Initial Pool Elev:	5,273.10
Initial Pool:	0.00 ac-ft

Drop Inlet

Riser Diameter (in)	Riser Height (ft)	Barrel Diameter (in)	Barrel Length (ft)	Barrel Slope (%)	Manning's n	Spillway Elev
48.00	8.30	48.00	145.00	2.21	0.0160	5,287.10

Drop Inlet

Riser Diameter (in)	Riser Height (ft)	Barrel Diameter (in)	Barrel Length (ft)	Barrel Slope (%)	Manning's n	Spillway Elev
48.00	8.30	42.00	145.00	2.21	0.0160	5,287.10

Pond Results:

Peak Elevation:	<del>5,283.28</del> 5,284.65
Dewater Time:	0.00 days

*Dewatering time is calculated from peak stage to lowest spillway*

Elevation-Capacity-Discharge Table

Elevation	Area (ac)	Capacity (ac-ft)	Discharge (cfs)	Dewater Time (hrs)
5,273.00	0.000	0.000	0.000	
5,273.10	0.004	0.000	0.000	
5,273.50	0.023	0.005	0.000	
5,274.00	0.070	0.027	0.000	
5,274.50	0.110	0.072	0.000	
5,275.00	0.160	0.139	0.000	
5,275.50	0.211	0.232	0.000	
5,276.00	0.270	0.352	0.000	
5,276.50	0.336	0.503	0.000	
5,277.00	0.410	0.689	0.000	

# SEDCAD 4 for Windows

Copyright 1998 Pamela J. Schwab

Elevation	Area (ac)	Capacity (ac-ft)	Discharge (cfs)	Dewater Time (hrs)
5,277.50	0.454	0.905	0.000	
5,278.00	0.500	1.143	0.000	
5,278.50	0.530	1.401	0.000	
5,279.00	0.560	1.673	0.000	
5,279.50	0.585	1.959	0.000	
5,280.00	0.610	2.258	0.000	
5,280.50	0.640	2.570	0.000	
5,281.00	0.670	2.898	0.000	
5,281.50	0.695	3.239	0.000	
5,282.00	0.720	3.593	0.000	
5,282.50	0.750	3.960	0.000	
5,283.00	0.780	4.342	0.000	
5,283.28	0.793	4.567	0.000	0.00 Peak Stage
5,283.50	0.805	4.739	0.000	
5,284.00	0.830	5.147	0.000	
5,284.50	0.860	5.570	0.000	<i>Elev. 5284.65 Peak Stage</i>
5,285.00	0.890	6.007	0.000	
5,285.50	0.915	6.458	0.000	
5,286.00	0.940	6.922	0.000	
5,286.50	0.972	7.400	0.000	
5,287.00	1.004	7.894	0.000	
5,287.10	1.010	7.994	0.000	Spillway #1 Spillway #2
5,287.50	1.032	8.403	19.703	
5,288.00	1.060	8.926	66.511	
5,288.50	1.110	9.468	129.047	
5,288.80	1.140	9.805	157.769	

Detailed Discharge Table

Elevation	Drop Inlet (cfs)	Drop Inlet (cfs)	Combined Total Discharge (cfs)
5,273.00	0.000	0.000	0.000
5,273.10	0.000	0.000	0.000
5,273.50	0.000	0.000	0.000
5,274.00	0.000	0.000	0.000
5,274.50	0.000	0.000	0.000
5,275.00	0.000	0.000	0.000
5,275.50	0.000	0.000	0.000

# SEDCAD 4 for Windows

Copyright 1998 Pamela I. Schwab

Elevation	Drop Inlet (cfs)	Drop Inlet (cfs)	Combined Total Discharge (cfs)
5,276.00	0.000	0.000	0.000
5,276.50	0.000	0.000	0.000
5,277.00	0.000	0.000	0.000
5,277.50	0.000	0.000	0.000
5,278.00	0.000	0.000	0.000
5,278.50	0.000	0.000	0.000
5,279.00	0.000	0.000	0.000
5,279.50	0.000	0.000	0.000
5,280.00	0.000	0.000	0.000
5,280.50	0.000	0.000	0.000
5,281.00	0.000	0.000	0.000
5,281.50	0.000	0.000	0.000
5,282.00	0.000	0.000	0.000
5,282.50	0.000	0.000	0.000
5,283.00	0.000	0.000	0.000
5,283.50	0.000	0.000	0.000
5,284.00	0.000	0.000	0.000
5,284.50	0.000	0.000	0.000
5,285.00	0.000	0.000	0.000
5,285.50	0.000	0.000	0.000
5,286.00	0.000	0.000	0.000
5,286.50	0.000	0.000	0.000
5,287.00	0.000	0.000	0.000
5,287.10	0.000	0.000	0.000
5,287.50	9.852	9.852	19.703
5,288.00	33.256	33.256	66.511
5,288.50	64.524	64.524	129.047
5,288.80	78.884	78.884	157.769

***Subwatershed Hydrology Detail:***

Stru #	SWS #	SWS Area (ac)	Time of Conc (hrs)	Musk K (hrs)	Musk X	Curve Number	UHS	Peak Discharge (cfs)	Runoff Volume (ac-ft)
#1	1	106.600	0.202	0.000	0.000	81.900	M	82.12	5.723
<b>Σ</b>		<b>106.600</b>						<b>82.12</b>	<b>5.723</b>

***Subwatershed Time of Concentration Details:***

Stru #	SWS #	Land Flow Condition	Slope (%)	Vert. Dist. (ft)	Horiz. Dist. (ft)	Velocity (fps)	Time (hrs)
#1	1	5. Nearly bare and untilled, and alluvial valley fans	11.07	30.00	271.00	3.320	0.022
		8. Large gullies, diversions, and low flowing streams	2.35	70.00	2,978.08	4.590	0.180
<b>#1</b>	<b>1</b>	<b>Time of Concentration:</b>					<b>0.202</b>

## **Barber Stockpile Pond 3**

*The curve number was adjusted to account for the reclaimed lands. The pond location and watershed area are presented on Exhibit 11-13 C & D.*

LR

BHP Navajo Coal Company  
PO Box 1717  
Fruitland, NM  
87416

***General Information***

***Storm Information:***

Storm Type:	Type II-60
Design Storm:	10 yr - 24 hr
Rainfall Depth:	1.600 inches

### ***Structure Networking:***

Type	Stru #	(flows into)	Stru #	Musk. K (hrs)	Musk. X	Description
Pond	#1	==>	End	0.000	0.000	Barber Stkp Pd 3

#1  
Pond

**Structure Summary:**

		Immediate Contributing Area (ac)	Total Contributing Area (ac)	Peak Discharge (cfs)	Total Runoff Volume (ac-ft)
#1	In	59.770	59.770	4.28	1.13
	Out			0.35	0.98

**Subwatershed Hydrology Detail:**

Stru #	SWS #	SWS Area (ac)	Time of Conc (hrs)	Musk K (hrs)	Musk X	Curve Number	UHS	Peak Discharge (cfs)	Runoff Volume (ac-ft)
#1	1	59.770	0.734	0.000	0.000	76.000	M	4.28	1.132
	$\Sigma$	<b>59.770</b>						<b>4.28</b>	<b>1.132</b>

**Subwatershed Time of Concentration Details:**

Stru #	SWS #	Land Flow Condition	Slope (%)	Vert. Dist. (ft)	Horiz. Dist. (ft)	Velocity (fps)	Time (hrs)
#1	1	5. Nearly bare and untilled, and alluvial valley fans	1.73	60.00	3,464.00	1.310	0.734
<b>#1</b>	<b>1</b>	<b>Time of Concentration:</b>					<b>0.734</b>

## ***General Information***

### ***Storm Information:***

Storm Type:	Type II-60
Design Storm:	25 yr - 6 hr
Rainfall Depth:	1.600 inches

## ***Structure Summary:***

		Immediate Contributing Area (ac)	Total Contributing Area (ac)	Peak Discharge (cfs)	Total Runoff Volume (ac-ft)
#1	In	59.770	59.770	7.51	1.13
	Out			0.63	1.03

### Structure Detail:

Structure #1 (Pond)

*Barber Stkp Pd 3*

Pond Inputs:

Initial Pool Elev:	5,348.30
Initial Pool:	3.65 ac-ft

Straight Pipe

Barrel Diameter (in)	Barrel Length (ft)	Barrel Slope (%)	Manning's n	Spillway Elev	Entrance Loss Coefficient	Tailwater Depth (ft)
12.00	250.00	2.00	0.0180	5,348.30	0.90	0.00

Emergency Spillway

Spillway Elev	Crest Length (ft)	Left Sideslope	Right Sideslope	Bottom Width (ft)
5,350.10	30.00	2.00:1	2.00:1	16.00

Pond Results:

Peak Elevation:	5,348.71
Dewater Time:	1.38 days

*Dewatering time is calculated from peak stage to lowest spillway*

Elevation-Capacity-Discharge Table

Elevation	Area (ac)	Capacity (ac-ft)	Discharge (cfs)	Dewater Time (hrs)
5,342.00	0.000	0.000	0.000	
5,342.50	0.013	0.002	0.000	
5,343.00	0.050	0.017	0.000	
5,343.50	0.085	0.050	0.000	
5,344.00	0.130	0.104	0.000	
5,344.50	0.135	0.170	0.000	
5,345.00	0.140	0.239	0.000	
5,345.50	0.409	0.370	0.000	
5,346.00	0.820	0.671	0.000	
5,346.50	1.042	1.136	0.000	

# SEDCAD 4 for Windows

Copyright 1998 Pamela I. Schwab

Elevation	Area (ac)	Capacity (ac-ft)	Discharge (cfs)	Dewater Time (hrs)
5,347.00	1.290	1.718	0.000	
5,347.50	1.436	2.399	0.000	
5,348.00	1.590	3.155	0.000	
5,348.30	1.724	3.652	0.000	Spillway #1
5,348.50	1.815	4.006	0.213	20.11*
5,348.71	1.913	4.403	0.632	13.00 Peak Stage
5,349.00	2.050	4.971	1.233	
5,349.50	2.284	6.054	2.716	
5,350.00	2.530	7.257	3.646	
5,350.10	2.557	7.512	3.681	Spillway #2
5,350.50	2.664	8.555	16.839	
5,351.00	2.800	9.921	33.291	

\*Designates time(s) to dewater have been extrapolated beyond the 50 hour hydrograph limit.

## Detailed Discharge Table

Elevation	Straight Pipe (cfs)	Emergency Spillway (cfs)	Combined Total Discharge (cfs)
5,342.00	0.000	0.000	0.000
5,342.50	0.000	0.000	0.000
5,343.00	0.000	0.000	0.000
5,343.50	0.000	0.000	0.000
5,344.00	0.000	0.000	0.000
5,344.50	0.000	0.000	0.000
5,345.00	0.000	0.000	0.000
5,345.50	0.000	0.000	0.000
5,346.00	0.000	0.000	0.000
5,346.50	0.000	0.000	0.000
5,347.00	0.000	0.000	0.000
5,347.50	0.000	0.000	0.000
5,348.00	0.000	0.000	0.000
5,348.30	0.000	0.000	0.000
5,348.50	(3)>0.213	0.000	0.213
5,349.00	(3)>1.233	0.000	1.233
5,349.50	(3)>2.716	0.000	2.716
5,350.00	(5)>3.646	0.000	3.646
5,350.10	(5)>3.681	0.000	3.681
5,350.50	(5)>3.820	13.019	16.839
5,351.00	(6)>3.995	29.296	33.291

# **Hosteen Stockpile Pond 1**

***The curve number was adjusted to account for the reclaimed lands. The pond location and watershed area are presented on Exhibit 11-13 C & D.***

LR

BHP Navajo Coal Company  
PO Box 1717  
Fruitland, NM  
87416

***General Information***

***Storm Information:***

Storm Type:	Type II-60
Design Storm:	10 yr - 24 hr
Rainfall Depth:	1.600 inches

**Structure Networking:**

Type	Stru #	(flows into)	Stru #	Musk. K (hrs)	Musk. X	Description
Pond	#1	==>	End	0.000	0.000	Hosteen Stkp Pd 1

#1  
Pond

**Structure Summary:**

	Immediate Contributing Area (ac)	Total Contributing Area (ac)	Peak Discharge (cfs)	Total Runoff Volume (ac-ft)
#1 In			22.17	4.01
Out	155.540	155.540	10.73	4.01

***Subwatershed Hydrology Detail:***

Stru #	SWS #	SWS Area (ac)	Time of Conc (hrs)	Musk K (hrs)	Musk X	Curve Number	UHS	Peak Discharge (cfs)	Runoff Volume (ac-ft)
#1	1	155.540	0.507	0.000	0.000	79.100	M	22.17	4.008
<b>Σ</b>		<b>155.540</b>						<b>22.17</b>	<b>4.008</b>

***Subwatershed Time of Concentration Details:***

Stru #	SWS #	Land Flow Condition	Slope (%)	Vert. Dist. (ft)	Horiz. Dist. (ft)	Velocity (fps)	Time (hrs)
#1	1	5. Nearly bare and untilled, and alluvial valley fans	3.97	68.00	1,712.00	1.990	0.238
		8. Large gullies, diversions, and low flowing streams	1.88	75.00	3,990.00	4.110	0.269
<b>#1</b>	<b>1</b>	<b>Time of Concentration:</b>					<b>0.507</b>

***General Information***

***Storm Information:***

Storm Type:	Type II-60
Design Storm:	25 yr - 6 hr
Rainfall Depth:	1.600 inches

**Structure Summary:**

		Immediate Contributing Area (ac)	Total Contributing Area (ac)	Peak Discharge (cfs)	Total Runoff Volume (ac-ft)
#1	In			35.34	4.01
	Out	155.540	155.540	16.02	4.01

### Structure Detail:

Structure #1 (Pond)

Hosteen Stkp Pd 1

Pond Inputs:

Initial Pool Elev:	5,272.20
Initial Pool:	10.63 ac-ft

#### Emergency Spillway

Spillway Elev	Crest Length (ft)	Left Sideslope	Right Sideslope	Bottom Width (ft)
5,272.20	30.00	11.60:1	9.30:1	8.00

Pond Results:

Peak Elevation:	5,272.94
Dewater Time:	0.35 days

*Dewatering time is calculated from peak stage to lowest spillway*

#### Elevation-Capacity-Discharge Table

Elevation	Area (ac)	Capacity (ac-ft)	Discharge (cfs)	Dewater Time (hrs)
5,258.00	0.080	0.000	0.000	
5,258.50	0.112	0.048	0.000	
5,259.00	0.150	0.113	0.000	
5,259.50	0.183	0.196	0.000	
5,260.00	0.220	0.297	0.000	
5,260.50	0.254	0.415	0.000	
5,261.00	0.290	0.551	0.000	
5,261.50	0.333	0.707	0.000	
5,262.00	0.380	0.885	0.000	
5,262.50	0.424	1.086	0.000	
5,263.00	0.470	1.309	0.000	
5,263.50	0.514	1.555	0.000	
5,264.00	0.560	1.824	0.000	
5,264.50	0.609	2.116	0.000	
5,265.00	0.660	2.433	0.000	
5,265.50	0.780	2.793	0.000	
5,266.00	0.910	3.215	0.000	

# SEDCAD 4 for Windows

Copyright 1998 Pamela I. Schwab

Elevation	Area (ac)	Capacity (ac-ft)	Discharge (cfs)	Dewater Time (hrs)
5,266.50	0.984	3.688	0.000	
5,267.00	1.060	4.199	0.000	
5,267.50	1.090	4.736	0.000	
5,268.00	1.120	5.289	0.000	
5,268.50	1.155	5.857	0.000	
5,269.00	1.190	6.444	0.000	
5,269.50	1.225	7.047	0.000	
5,270.00	1.260	7.668	0.000	
5,270.50	1.300	8.308	0.000	
5,271.00	1.340	8.968	0.000	
5,271.50	1.380	9.648	0.000	
5,272.00	1.420	10.348	0.000	
5,272.20	1.438	10.634	0.000	Spillway #1
5,272.50	1.465	11.069	6.463	6.40
5,272.94	1.505	11.729	16.022	1.90 Peak Stage
5,273.00	1.510	11.813	17.241	
5,273.50	1.565	12.581	54.572	
5,274.00	1.620	13.377	115.502	
5,274.50	1.689	14.205	203.538	
5,275.00	1.760	15.067	328.686	

## Detailed Discharge Table

Elevation	Emergency Spillway (cfs)	Combined Total Discharge (cfs)
5,258.00	0.000	0.000
5,258.50	0.000	0.000
5,259.00	0.000	0.000
5,259.50	0.000	0.000
5,260.00	0.000	0.000
5,260.50	0.000	0.000
5,261.00	0.000	0.000
5,261.50	0.000	0.000
5,262.00	0.000	0.000
5,262.50	0.000	0.000
5,263.00	0.000	0.000
5,263.50	0.000	0.000
5,264.00	0.000	0.000
5,264.50	0.000	0.000

# SEDCAD 4 for Windows

Copyright 1998 Pamela J. Schwab

Elevation	Emergency Spillway (cfs)	Combined Total Discharge (cfs)
5,265.00	0.000	0.000
5,265.50	0.000	0.000
5,266.00	0.000	0.000
5,266.50	0.000	0.000
5,267.00	0.000	0.000
5,267.50	0.000	0.000
5,268.00	0.000	0.000
5,268.50	0.000	0.000
5,269.00	0.000	0.000
5,269.50	0.000	0.000
5,270.00	0.000	0.000
5,270.50	0.000	0.000
5,271.00	0.000	0.000
5,271.50	0.000	0.000
5,272.00	0.000	0.000
5,272.20	0.000	0.000
5,272.50	6.463	6.463
5,273.00	17.241	17.241
5,273.50	54.572	54.572
5,274.00	115.502	115.502
5,274.50	203.538	203.538
5,275.00	328.686	328.686

CIVIL SOFTWARE DESIGN

SEDCAD+ Version 3

AS BUILT DESIGN HYDROLOGY CALCULATION FOR BARBER STOCKPILE #2 POND

by

Name: Brian Sambirsky

Company Name: BHP MINERALS

File Name: C:\BRIAN\HOSTEEN2

Date: 12-21-1995

Company Name: BHP MINERALS

Filename: C:\BRIAN\HOSTEEN2

User: Brian Sambirsky

Date: 12-21-1995 Time: 10:03:16

As built design hydrology calculation - Hosteen Stockpile #2 Pond  
 Storm: 1.58 inches, 10 year-24 hour, type II-65

Hydrograph Convolution Interval: 0.1 hr

=====

SUBWATERSHED/STRUCTURE INPUT/OUTPUT TABLE

=====

-Hydrology-

JBS	SWS	Area (ac)	CN	UHS	Tc (hrs)	K (hrs)	X	Base- Flow (cfs)	Runoff Volume (ac-ft)	Peak Discharge (cfs)
111	1	122.80	83	M	0.754	0.000	0.000	0.0	4.36	26.55
		Type: Null		Label: Hosteen #2 Pond						
111	Structure	122.80							4.36	
111	Total IN/OUT	122.80							4.36	26.55

Company Name: BHP MINERALS

Filename: C:\BRIAN\HOSTEEN2

User: Brian Sambirsky

Date: 12-21-1995 Time: 10:03:16

As built design hydrology calculation - Hosteen Stockpile #2 Pond  
 Storm: 1.58 inches, 10 year-24 hour, type II-65

Hydrograph Convolution Interval: 0.1 hr

=====

DETAILED SUBWATERSHED INPUT/OUTPUT TABLE

=====

J	B	S	SWS	Seg. #	Land Flow Condition	Distance (ft)	Slope (%)	Velocity (fps)	Segment Time (hr)	Time Conc. (hr)	Muskingum K (hr)	X
1	1	1	1	-a	5	4330.00	2.54	1.59	0.75	0.754		

CIVIL SOFTWARE DESIGN

SEDCAD+ Version 3

AS BUILT DESIGN HYDROLOGY CALCULATION - HOSTEEN STOCKPILE #2 SPILLWAY

by

Name: Brian Sambirsky

Company Name: BHP MINERALS  
File Name: C:\BRIAN\HOSTEEN2

Date: 12-21-1995

Company Name: BHP MINERALS

Filename: C:\BRIAN\HOSTEEN2

User: Brian Sambirsky

Date: 12-21-1995 Time: 10:01:46

As built design hydrology calculation - Hosteen Stockpile #2 Spillway

Storm: 1.60 inches, 25 year- 6 hour, type II-65

Hydrograph Convolution Interval: 0.1 hr

=====

SUBWATERSHED/STRUCTURE INPUT/OUTPUT TABLE

=====

-Hydrology-

JBS SWS	Area (ac)	CN UHS	Tc (hrs)	K (hrs)	X	Base- Flow (cfs)	Runoff Volume (ac-ft)	Peak Discharge (cfs)
111 1	122.80	83 M	0.754	0.000	0.000	0.0	4.48	37.71
		Type: Pond		Label: Hosteen #2 Pond				
111 Structure	122.80						4.48	
111 Total IN	122.80						4.48	37.71
111 Total OUT							3.96	2.23

Company Name: BHP MINERALS

Filename: C:\BRIAN\HOSTEEN2

User: Brian Sambirsky

Date: 12-21-1995 Time: 10:01:46

As built design hydrology calculation - Hosteen Stockpile #2 Spillway

Storm: 1.60 inches, 25 year- 6 hour, type II-65

Hydrograph Convolution Interval: 0.1 hr

=====

DETAILED SUBWATERSHED INPUT/OUTPUT TABLE

=====

J	B	S	SWS	Seg. #	Land Flow Condition	Distance (ft)	Slope (%)	Velocity (fps)	Segment Time (hr)	Time Conc. (hr)	Muskingum K (hr)	X
1	1	1	1	-a	5	4330.00	2.54	1.59	0.75	0.754		

Company Name: BHP MINERALS

Filename: C:\BRIAN\HOSTEEN2

User: Brian Sambirsky

Date: 12-21-1995 Time: 10:01:46

As built design hydrology calculation - Hosteen Stockpile #2 Spillway  
 Storm: 1.60 inches, 25 year- 6 hour, type II-65

Hydrograph Convolution Interval: 0.1 hr

=====  
 POND INPUT/OUTPUT TABLE  
 =====

J1, B1, S1  
 Hosteen #2 Pond

Drainage Area from J1, B1, S1, SWS(s)1: 122.8 acres  
 Total Contributing Drainage Area: 122.8 acres

DISCHARGE OPTIONS:

	Trickle Tube	Emergency Spillway
Riser Diameter (in)	----	----
Riser Height (ft)	----	----
Barrel Diameter (in)	12.0	----
Barrel Length (ft)	80.00	----
Barrel Slope (%)	2.25	----
Manning's n of Pipe	0.012	----
Spillway Elevation	5302.1	----
Lowest Elevation of Holes	----	----
# of Holes/Elevation	----	----
Entrance Loss Coefficient	0.9	----
Tailwater Depth (ft)	0.0	----
Notch Angle (degrees)	----	----
Weir Width (ft)	----	----
Siphon Crest Elevation	----	----
Siphon Tube Diameter (in)	----	----
Siphon Tube Length (ft)	----	----
Manning's n of Siphon	----	----
Siphon Inlet Elevation	----	----
Siphon Outlet Elevation	----	----
Emergency Spillway Elevation	----	5305.4
Crest Length (ft)	----	20.0
Z:1 (Left and Right)	-- --	3.0 3.0
Bottom Width (ft)	----	8.0

POND RESULTS:

Permanent  
 Pool  
 (ac-ft)  
 =====  
 14.6

	Runoff Volume (ac-ft)	Peak Discharge (cfs)
IN	4.48	37.71
OUT	3.96	2.23

Peak Elevation	Hydrograph Detention Time (hrs)
5303.2	0.00

\*\*\*\*\*

Company Name: BHP MINERALS  
 Filename: C:\BRIAN\HOSTEEN2 User: Brian Sambirsky

Date: 12-21-1995 Time: 10:01:46

As built design hydrology calculation - Hosteen Stockpile #2 Spillway  
 Storm: 1.60 inches, 25 year- 6 hour, type II-65

Hydrograph Convolution Interval: 0.1 hr

=====

ELEVATION-DISCHARGE TABLE

=====

J1, B1, S1  
 Hosteen #2 Pond

Drainage Area from J1, B1, S1, SWS(s)1: 122.8 acres  
 Total Contributing Drainage Area: 122.8 acres

Elevation	Trickle Tube (cfs)	Emergency Spillway (cfs)	Total Discharge (cfs)
5291.00	0.0	0.0	
5292.00	0.0	0.0	0.0
5293.00	0.0	0.0	0.0
5294.00	0.0	0.0	0.0
5295.00	0.0	0.0	0.0
5296.00	0.0	0.0	0.0
5297.00	0.0	0.0	0.0
5298.00	0.0	0.0	0.0
5299.00	0.0	0.0	0.0
5300.00	0.0	0.0	0.0
5301.00	0.0	0.0	0.0
5302.00	0.0	0.0	0.0
5302.10	0.0	0.0	0.0
5303.00	1.8	0.0	1.8
5304.00	4.2	0.0	4.2
5305.00	5.8	0.0	5.8
5305.40	6.2	0.0	6.2
5306.00	6.9	8.3	15.2
5306.10	6.9	10.8	17.8
5306.20	7.0	14.3	21.4
5306.30	7.1	17.9	25.0
5306.40	7.1	22.2	29.4
5306.90	7.5	49.0	56.5
5307.00	7.6	55.8	63.4

\*\*\*\*\*

Company Name: BHP MINERALS  
 Filename: C:\BRIAN\HOSTEEN2 User: Brian Sambirsky  
 Date: 12-21-1995 Time: 10:01:46

As built design hydrology calculation - Hosteen Stockpile #2 Spillway  
 Storm: 1.60 inches, 25 year- 6 hour, type II-65  
 Hydrograph Convolution Interval: 0.1 hr

=====

ELEVATION-AREA-CAPACITY-DISCHARGE TABLE

=====

J1, B1, S1  
 Hosteen #2 Pond

Drainage Area from J1, B1, S1, SWS(s)1: 122.8 acres  
 Total Contributing Drainage Area: 122.8 acres

SW#1: Trickle Tube  
 SW#2: Emergency Spillway

Elev	Stage (ft)	Area (ac)	Capacity (ac-ft)	Discharge (cfs)	
5291.00	0.00	0.00	0.00	0.00	
5292.00	1.00	0.26	0.09	0.00	
5293.00	2.00	0.45	0.44	0.00	
5294.00	3.00	0.69	1.00	0.00	
5295.00	4.00	0.86	1.78	0.00	
5296.00	5.00	1.05	2.73	0.00	
5297.00	6.00	1.27	3.89	0.00	
5298.00	7.00	1.51	5.28	0.00	
5299.00	8.00	1.82	6.94	0.00	
5300.00	9.00	2.16	8.93	0.00	
5301.00	10.00	2.66	11.33	0.00	
5302.00	11.00	3.21	14.26	0.00	
5302.10	11.10	3.27	14.59	0.00	
5303.00	12.00	3.77	17.75	1.81	Stage of SW#1
5303.18	12.18	3.89	18.47	2.23	Peak Stage
5304.00	13.00	4.37	21.82	4.22	
5305.00	14.00	4.90	26.45	5.75	
5305.40	14.40	5.13	28.46	6.23	Stage of SW#2
5306.00	15.00	5.47	31.64	15.18	
5306.10	15.10	5.54	32.19	17.76	
5306.20	15.20	5.61	32.75	21.35	
5306.30	15.30	5.68	33.31	24.96	
5306.40	15.40	5.75	33.88	29.36	
5306.90	15.90	6.09	36.84	56.48	
5307.00	16.00	6.16	37.46	63.40	

\*\*\*\*\*

## **Hosteen Stockpile Pond 3**

***This pond has a single closed spillway. It is re-evaluated as a total containment structure for the 100 year-6 hour storm. The curve number was adjusted to account for the reclaimed lands. Refer to Section 11.5.4.3 of the mine permit for discussion on ponds with a single closed spillway. The pond location and watershed areas are presented on Exhibit 11-13 C & D.***

LR

BHP Navajo Coal Company  
PO Box 1717  
Fruitland, NM  
87416

***General Information***

***Storm Information:***

Storm Type:	Type II-60
Design Storm:	100 yr - 6 hr
Rainfall Depth:	2.000 inches

**Structure Networking:**

Type	Stru #	(flows into)	Stru #	Musk. K (hrs)	Musk. X	Description
Pond	#1	==>	End	0.000	0.000	Hosteen #3

#1  
Pond

***Structure Summary:***

		Immediate Contributing Area (ac)	Total Contributing Area (ac)	Peak Discharge (cfs)	Total Runoff Volume (ac-ft)
#1	In	135.210	135.210	68.03	6.76
	Out			0.00	0.00

### Structure Detail:

Structure #1 (Pond)

Hosteen #3

Pond Inputs:

Initial Pool Elev:	5,263.10
Initial Pool:	0.00 ac-ft

Straight Pipe

Barrel Diameter (in)	Barrel Length (ft)	Barrel Slope (%)	Manning's n	Spillway Elev	Entrance Loss Coefficient	Tailwater Depth (ft)
24.00	140.00	0.93	0.0160	5,274.80	0.90	0.00

Pond Results:

Peak Elevation:	5,273.01
Dewater Time:	0.00 days

*Dewatering time is calculated from peak stage to lowest spillway*

Elevation-Capacity-Discharge Table

Elevation	Area (ac)	Capacity (ac-ft)	Discharge (cfs)	Dewater Time (hrs)
5,263.00	0.000	0.000	0.000	
5,263.10	0.002	0.000	0.000	
5,263.50	0.010	0.002	0.000	
5,264.00	0.030	0.012	0.000	
5,264.50	0.095	0.041	0.000	
5,265.00	0.197	0.113	0.000	
5,265.50	0.335	0.244	0.000	
5,266.00	0.510	0.454	0.000	
5,266.50	0.535	0.715	0.000	
5,267.00	0.561	0.989	0.000	
5,267.50	0.588	1.277	0.000	
5,268.00	0.615	1.577	0.000	
5,268.50	0.643	1.892	0.000	
5,269.00	0.671	2.220	0.000	
5,269.50	0.700	2.563	0.000	
5,270.00	0.730	2.921	0.000	

Elevation	Area (ac)	Capacity (ac-ft)	Discharge (cfs)	Dewater Time (hrs)
5,270.50	0.757	3.293	0.000	
5,271.00	0.784	3.678	0.000	
5,271.50	0.812	4.077	0.000	
5,272.00	0.840	4.490	0.000	
5,272.50	0.889	4.922	0.000	
5,273.00	0.940	5.379	0.000	
5,273.01	0.940	5.387	0.000	0.00 Peak Stage
5,273.50	0.989	5.861	0.000	
5,274.00	1.040	6.369	0.000	
5,274.50	1.104	6.905	0.000	
5,274.80	1.144	7.242	0.000	Spillway #1
5,275.00	1.170	7.473	0.575	
5,275.50	1.239	8.075	2.457	
5,276.00	1.310	8.713	5.509	
5,276.50	1.384	9.386	9.288	
5,277.00	1.460	10.097	13.620	
5,277.50	1.539	10.847	17.484	
5,278.00	1.620	11.636	19.790	

### Detailed Discharge Table

Elevation	Straight Pipe (cfs)	Combined Total Discharge (cfs)
5,263.00	0.000	0.000
5,263.10	0.000	0.000
5,263.50	0.000	0.000
5,264.00	0.000	0.000
5,264.50	0.000	0.000
5,265.00	0.000	0.000
5,265.50	0.000	0.000
5,266.00	0.000	0.000
5,266.50	0.000	0.000
5,267.00	0.000	0.000
5,267.50	0.000	0.000
5,268.00	0.000	0.000
5,268.50	0.000	0.000
5,269.00	0.000	0.000
5,269.50	0.000	0.000
5,270.00	0.000	0.000

# SEDCAD 4 for Windows

Copyright 1998 Pamela I. Schwab

Elevation	Straight Pipe (cfs)	Combined Total Discharge (cfs)
5,270.50	0.000	0.000
5,271.00	0.000	0.000
5,271.50	0.000	0.000
5,272.00	0.000	0.000
5,272.50	0.000	0.000
5,273.00	0.000	0.000
5,273.50	0.000	0.000
5,274.00	0.000	0.000
5,274.50	0.000	0.000
5,274.80	0.000	0.000
5,275.00	(3)>0.575	0.575
5,275.50	(3)>2.457	2.457
5,276.00	(3)>5.509	5.509
5,276.50	(3)>9.288	9.288
5,277.00	(3)>13.620	13.620
5,277.50	(5)>17.484	17.484
5,278.00	(6)>19.790	19.790

***Subwatershed Hydrology Detail:***

Stru #	SWS #	SWS Area (ac)	Time of Conc (hrs)	Musk K (hrs)	Musk X	Curve Number	UHS	Peak Discharge (cfs)	Runoff Volume (ac-ft)
#1	1	135.210	0.452	0.000	0.000	80.900	M	68.03	6.763
		<b>Σ 135.210</b>						<b>68.03</b>	<b>6.763</b>

***Subwatershed Time of Concentration Details:***

Stru #	SWS #	Land Flow Condition	Slope (%)	Vert. Dist. (ft)	Horiz. Dist. (ft)	Velocity (fps)	Time (hrs)
#1	1	5. Nearly bare and untilled, and alluvial valley fans	7.29	45.00	617.00	2.700	0.063
		8. Large gullies, diversions, and low flowing streams	1.60	85.00	5,318.00	3.790	0.389
<b>#1</b>	<b>1</b>	<b>Time of Concentration:</b>					<b>0.452</b>

Pages 87 – 88 blank due to text changes

---

# **Lowe Railroad Impoundment #1**

*Impoundment has a watershed of 105.73 acres and designed to contain the 100 year-6 hour storm event (Total Containment); therefore, no spillway is required.*

Shawn Smith

Navajo Coal Company  
P.O. Box 1717  
Fruitland, NM 87414

Phone: (505) 598-3376  
Email: shawn.smith@bhpbilliton.com

## ***General Information***

### ***Storm Information:***

Storm Type:	Type II-70
Design Storm:	100 yr - 6 hr
Rainfall Depth:	2.000 inches

***Structure Networking:***

Type	Stru #	(flows into)	Stru #	Musk. K (hrs)	Musk. X	Description
Null	#1	==>	End	0.000	0.000	Lowe Railroad Impoundment #1

#1
Null

***Structure Summary:***

	Immediate Contributing Area (ac)	Total Contributing Area (ac)	Peak Discharge (cfs)	Total Runoff Volume (ac-ft)
#1	105.730	105.730	89.73	6.84

***Structure Detail:***

*Structure #1 (Null)*

*Lowe Railroad Impoundment #1*

### Subwatershed Hydrology Detail:

Stru #	SWS #	SWS Area (ac)	Time of Conc (hrs)	Musk K (hrs)	Musk X	Curve Number	UHS	Peak Discharge (cfs)	Runoff Volume (ac-ft)
#1	1	85.180	0.500	0.000	0.000	89.000	M	81.66	5.820
	2	9.850	0.180	0.000	0.000	84.200	F	14.06	0.594
	3	10.700	0.061	0.000	0.000	78.000	M	14.67	0.431
	<b>Σ</b>	<b>105.730</b>						<b>89.73</b>	<b>6.845</b>

### Subwatershed Time of Concentration Details:

Stru #	SWS #	Land Flow Condition	Slope (%)	Vert. Dist. (ft)	Horiz. Dist. (ft)	Velocity (fps)	Time (hrs)
#1	1	8. Large gullies, diversions, and low flowing streams	0.82	40.00	4,878.00	2.710	0.500
#1	1	<b>Time of Concentration:</b>					<b>0.500</b>
#1	2	8. Large gullies, diversions, and low flowing streams	2.98	100.00	3,357.00	5.170	0.180
#1	2	<b>Time of Concentration:</b>					<b>0.180</b>
#1	3	5. Nearly bare and untilled, and alluvial valley fans	5.71	30.00	525.00	2.390	0.061
#1	3	<b>Time of Concentration:</b>					<b>0.061</b>

---

## **Lowe Railroad Impoundment #2**

***Impoundment has a watershed of 133.27 acres and designed to contain the 100 year-6 hour storm event (Total Containment); therefore, no spillway is required.***

Shawn Smith

Navajo Coal Company  
P.O. Box 1717  
Fruitland, NM 87414

Phone: (505) 598-3376  
Email: shawn.smith@bhpbilliton.com

## ***General Information***

### ***Storm Information:***

Storm Type:	Type II-70
Design Storm:	100 yr - 6 hr
Rainfall Depth:	2.000 inches

***Structure Networking:***

Type	Stru #	(flows into)	Stru #	Musk. K (hrs)	Musk. X	Description
Null	#1	==>	End	0.000	0.000	Lowe Railroad Impoundment #2

#1
Null

***Structure Summary:***

	Immediate Contributing Area (ac)	Total Contributing Area (ac)	Peak Discharge (cfs)	Total Runoff Volume (ac-ft)
#1	133.270	133.270	103.69	6.65

***Structure Detail:***

*Structure #1 (Null)*

*Lowe Railroad Impoundment #2*

### Subwatershed Hydrology Detail:

Stru #	SWS #	SWS Area (ac)	Time of Conc (hrs)	Musk K (hrs)	Musk X	Curve Number	UHS	Peak Discharge (cfs)	Runoff Volume (ac-ft)
#1	1	129.020	0.500	0.000	0.000	81.800	F	102.97	6.483
	2	4.250	0.064	0.000	0.000	78.000	M	5.83	0.171
	<b>Σ</b>	<b>133.270</b>						<b>103.69</b>	<b>6.654</b>

### Subwatershed Time of Concentration Details:

Stru #	SWS #	Land Flow Condition	Slope (%)	Vert. Dist. (ft)	Horiz. Dist. (ft)	Velocity (fps)	Time (hrs)
#1	1	8. Large gullies, diversions, and low flowing streams	0.82	40.00	4,878.04	2.710	0.500
<b>#1</b>	<b>1</b>	<b>Time of Concentration:</b>					<b>0.500</b>
#1	2	5. Nearly bare and untilled, and alluvial valley fans	6.14	35.00	570.00	2.470	0.064
<b>#1</b>	<b>2</b>	<b>Time of Concentration:</b>					<b>0.064</b>

CIVIL SOFTWARE DESIGN

SEDCAD+ Version 3

AS BUILT DESIGN HYDROLOGY CALCULATION FOR LOWE STOCKPILE POND

by

Name: Brian Sambirsky

Company Name: BHP MINERALS  
File Name: C:\BRIAN\LCOALSP

Date: 12-21-1995

Company Name: BHP MINERALS  
 Filename: C:\BRIAN\LCOALSP User: Brian Sambirsky  
 Date: 12-21-1995 Time: 10:09:35  
 As built design hydrology calculation for Lowe Stockpile Pond  
 Storm: 1.58 inches, 10 year-24 hour, type II-65  
 Hydrograph Convolution Interval: 0.1 hr

=====

SUBWATERSHED/STRUCTURE INPUT/OUTPUT TABLE

=====

-Hydrology-

JBS	SWS	Area (ac)	CN	UHS	Tc (hrs)	K (hrs)	X	Base- Flow (cfs)	Runoff Volume (ac-ft)	Peak Discharge (cfs)
111	1	51.80	89	M	1.365	0.000	0.000	0.0	2.99	13.35
111	Structure	51.80							2.99	
111	Total IN/OUT	51.80							2.99	13.35

Civil Software Design -- SEDCAD+ Version 3.1  
 Copyright (C) 1987-1992. Pamela J. Schwab. All rights reserved.

Company Name: BHP MINERALS  
 Filename: C:\BRIAN\LCOALSP User: Brian Sambirsky  
 Date: 12-21-1995 Time: 10:09:35  
 As built design hydrology calculation for Lowe Stockpile Pond  
 Storm: 1.58 inches, 10 year-24 hour, type II-65  
 Hydrograph Convolution Interval: 0.1 hr

=====

DETAILED SUBWATERSHED INPUT/OUTPUT TABLE

=====

J	B	S	SWS	Seg. #	Land Flow Condition	Distance (ft)	Slope (%)	Velocity (fps)	Segment Time (hr)	Time Conc. (hr)	Muskingum K (hr)	X
1	1	1	1	-a	5	3924.00	0.64	0.80	1.37	1.365		

CIVIL SOFTWARE DESIGN

SEDCAD+ Version 3

AS BUILT DESIGN HYDROLOGY CALCULATION FOR LOWE STOCKPILE POND SPILLWAY

by

Name: Brian Sambirsky

Company Name: BHP MINERALS  
File Name: C:\BRIAN\LCOALSP

Date: 12-21-1995

Company Name: BHP MINERALS

Filename: C:\BRIAN\LCOALSP

User: Brian Sambirsky

Date: 12-21-1995 Time: 10:07:50

As built design hydrology calculation for Lowe Stockpile Pond Spillway

Storm: 1.60 inches, 25 year- 6 hour, type II-65

Hydrograph Convolution Interval: 0.1 hr

=====

SUBWATERSHED/STRUCTURE INPUT/OUTPUT TABLE

=====

-Hydrology-

JBS	SWS	Area (ac)	CN	UHS	Tc (hrs)	K (hrs)	X	Base- Flow (cfs)	Runoff Volume (ac-ft)	Peak Discharge (cfs)
111	1	51.80	89	M	1.365	0.000	0.000	0.0	3.05	17.52
111	Structure	51.80							3.05	
111	Total IN	51.80							3.05	17.52
111	Total OUT								3.05	15.28

Company Name: BHP MINERALS  
 Filename: C:\BRIAN\LCOALSP User: Brian Sambirsky

Date: 12-21-1995 Time: 10:07:50

As built design hydrology calculation for Lowe Stockpile Pond Spillway

Storm: 1.60 inches, 25 year- 6 hour, type II-65

Hydrograph Convolution Interval: 0.1 hr

=====

DETAILED SUBWATERSHED INPUT/OUTPUT TABLE

=====

J	B	S	SWS	Seg. #	Land Flow Condition	Distance (ft)	Slope (%)	Velocity (fps)	Segment Time (hr)	Time Conc. (hr)	Muskingum K (hr)	X
1	1	1	1	-a	5	3924.00	0.64	0.80	1.37	1.365		

Company Name: BHP MINERALS

Filename: C:\BRIAN\LCOALSP

User: Brian Sambirsky

Date: 12-21-1995 Time: 10:07:50

As built design hydrology calculation for Low Stockpile Pond Spillway

Storm: 1.60 inches, 25 year- 6 hour, type II-65

Hydrograph Convolution Interval: 0.1 hr

=====  
 POND INPUT/OUTPUT TABLE  
 =====

J1, B1, S1  
 Low Stockpile Pond

Drainage Area from J1, B1, S1, SWS(s)1: 51.8 acres  
 Total Contributing Drainage Area: 51.8 acres

DISCHARGE OPTIONS:

Emergency  
 Spillway

Riser Diameter (in)	----
Riser Height (ft)	----
Barrel Diameter (in)	----
Barrel Length (ft)	----
Barrel Slope (%)	----
Manning's n of Pipe	----
Spillway Elevation	----
Lowest Elevation of Holes	----
# of Holes/Elevation	----
Entrance Loss Coefficient	----
Tailwater Depth (ft)	----
Notch Angle (degrees)	----
Weir Width (ft)	----
Siphon Crest Elevation	----
Siphon Tube Diameter (in)	----
Siphon Tube Length (ft)	----
Manning's n of Siphon	----
Siphon Inlet Elevation	----
Siphon Outlet Elevation	----
Emergency Spillway Elevation	5313.6
Crest Length (ft)	26.0
Z:1 (Left and Right)	4.0 2.7
Bottom Width (ft)	16.0

POND RESULTS:

Permanent  
 Pool  
 (ac-ft)

=====  
 5.6

	Runoff Volume (ac-ft)	Peak Discharge (cfs)
IN	3.05	17.52
OUT	3.05	15.28

Peak Elevation	Hydrograph Detention Time (hrs)
5314.2	0.00

\*\*\*\*\*

Company Name: BHP MINERALS

Filename: C:\BRIAN\LCOALSP

User: Brian Sambirsky

Date: 12-21-1995 Time: 10:07:50

As built design hydrology calculation for Lowe Stockpile Pond Spillway

Storm: 1.60 inches, 25 year- 6 hour, type II-65

Hydrograph Convolution Interval: 0.1 hr

=====

ELEVATION-DISCHARGE TABLE

=====

J1, B1, S1  
 Lowe Stockpile Pond

Drainage Area from J1, B1, S1, SWS(s)1:  
 Total Contributing Drainage Area:

51.8 acres  
 51.8 acres

Elevation	Emergency Spillway (cfs)	Total Discharge (cfs)
5300.80	0.0	
5301.00	0.0	0.0
5301.80	0.0	0.0
5302.00	0.0	0.0
5302.80	0.0	0.0
5303.00	0.0	0.0
5303.80	0.0	0.0
5304.00	0.0	0.0
5304.80	0.0	0.0
5305.00	0.0	0.0
5305.80	0.0	0.0
5306.00	0.0	0.0
5306.80	0.0	0.0
5307.00	0.0	0.0
5307.80	0.0	0.0
5308.80	0.0	0.0
5309.80	0.0	0.0
5310.80	0.0	0.0
5311.80	0.0	0.0
5312.80	0.0	0.0
5313.60	0.0	0.0
5313.80	5.5	5.5
5314.30	19.4	19.4
5314.40	25.3	25.3
5314.50	31.5	31.5

\*\*\*\*\*

Company Name: BHP MINERALS  
 Filename: C:\BRIAN\LCOALSP User: Brian Sambirsky

Date: 12-21-1995 Time: 10:07:50  
 As built design hydrology calculation for Lowe Stockpile Pond Spillway  
 Storm: 1.60 inches, 25 year- 6 hour, type II-65  
 Hydrograph Convolution Interval: 0.1 hr

=====

ELEVATION-AREA-CAPACITY-DISCHARGE TABLE

=====

J1, B1, S1  
 Lowe Stockpile Pond

Drainage Area from J1, B1, S1, SWS(s)1: 51.8 acres  
 Total Contributing Drainage Area: 51.8 acres

SW#1: Emergency Spillway

Elev	Stage (ft)	Area (ac)	Capacity (ac-ft)	Discharge (cfs)	
5300.80	0.00	0.00	0.00	0.00	
5301.00	0.20	0.01	0.00	0.00	
5301.80	1.00	0.08	0.03	0.00	
5302.00	1.20	0.11	0.05	0.00	
5302.80	2.00	0.20	0.18	0.00	
5303.00	2.20	0.23	0.22	0.00	
5303.80	3.00	0.32	0.44	0.00	
5304.00	3.20	0.35	0.51	0.00	
5304.80	4.00	0.39	0.80	0.00	
5305.00	4.20	0.40	0.88	0.00	
5305.80	5.00	0.43	1.22	0.00	
5306.00	5.20	0.44	1.30	0.00	
5306.80	6.00	0.46	1.66	0.00	
5307.00	6.20	0.47	1.76	0.00	
5307.80	7.00	0.49	2.14	0.00	
5308.80	8.00	0.52	2.65	0.00	
5309.80	9.00	0.56	3.20	0.00	
5310.80	10.00	0.59	3.77	0.00	
5311.80	11.00	0.63	4.39	0.00	
5312.80	12.00	0.67	5.04	0.00	
5313.60	12.80	0.70	5.59	0.00	
5313.80	13.00	0.70	5.73	5.54	Stage of SW#1
5314.15	13.35	0.74	5.98	15.28	Peak Stage
5314.30	13.50	0.75	6.09	19.41	
5314.40	13.60	0.76	6.17	25.30	
5314.50	13.70	0.77	6.24	31.51	

\*\*\*\*\*

CIVIL SOFTWARE DESIGN

SEDCAD+ Version 3

SOUTHWEST DIXON POND HYDROLOGY - 100 YR 6 HR STORM EVENT

by

Name: BEN HOSKIE

Company Name: BHP MINERALS  
File Name: C:\BEN\PONDS\SWDXPND

Date: 07-05-1998

Company Name: BHP MINERALS  
 Filename: C:\BEN\PONDS\SWDXPND User: BEN HOSKIE  
 Date: 07-05-1998 Time: 15:58:23  
 SOUTHWEST DIXON POND HYDROLOGY - 100 YR 6 HR STORM EVENT  
 Storm: 2.10 inches, 100 year- 6 hour, type II-65  
 Hydrograph Convolution Interval: 0.1 hr

=====  
 GENERAL INPUT TABLE  
 =====

STORM #1:

User-Defined Distribution

Label: type II-65

	Accumulated Time (hrs)	Accumulated Dimensionless Depth
1	0.0	0.000
2	0.5	0.006
3	1.0	0.012
4	1.5	0.019
5	2.0	0.026
6	2.5	0.034
7	3.0	0.043
8	3.5	0.055
9	4.0	0.067
10	4.5	0.083
11	5.0	0.105
12	5.5	0.139
13	6.0	0.711
14	6.5	0.789
15	7.0	0.819
16	7.5	0.837
17	8.0	0.851
18	8.5	0.861
19	9.0	0.872
20	9.5	0.880
21	10.0	0.888
22	10.5	0.894
23	11.0	0.900
24	11.5	0.905
25	12.0	0.910
26	12.5	0.915
27	13.0	0.920
28	13.5	0.925
29	14.0	0.930
30	14.5	0.934
31	15.0	0.938
32	15.5	0.943
33	16.0	0.947

34	16.5	0.951
35	17.0	0.954
36	17.5	0.958
37	18.0	0.962
38	18.5	0.966
39	19.0	0.969
40	19.5	0.973
41	20.0	0.976
42	20.5	0.979
43	21.0	0.982
44	21.5	0.985
45	22.0	0.988
46	22.5	0.991
47	23.0	0.994
48	23.5	0.997
49	24.0	1.000

\*\*\*\*\*

Civil Software Design -- SEDCAD+ Version 3.1  
 Copyright (C) 1987-1992. Pamela J. Schwab. All rights reserved.

Company Name: BHP MINERALS  
 Filename: C:\BEN\PCNDS\SWEXPND User: BEN HOSKIE  
 Date: 07-05-1998 Time: 15:58:23  
 SOUTHWEST DIXON POND HYDROLOGY - 100 YR 6 HR STORM EVENT  
 Storm: 2.10 inches, 100 year- 6 hour, type II-65  
 Hydrograph Convolution Interval: 0.1 hr

=====

SUBWATERSHED/STRUCTURE INPUT/OUTPUT TABLE

=====

-Hydrology-

JBS SWS	Area (ac)	CN	UHS	Tc (hrs)	K (hrs)	X	Base- Flow (cfs)	Runoff Volume (ac-ft)	Peak Discharge (cfs)	
111 1	37.80	80	F	0.355	0.000	0.000	0.0	2.01	33.73	
		Type: Null		Label: SOUTHWEST DIXON POND						
111 Structure	37.80								2.01	
111 Total IN/OUT	37.80								2.01	33.73

Civil Software Design -- SEDCAD+ Version 3.1  
 Copyright (C) 1987-1992. Pamela J. Schwab. All rights reserved.

Company Name: BHP MINERALS  
 Filename: C:\BEN\PONDS\SWENEND User: BEN ROSKIE  
 Date: 07-05-1998 Time: 15:58:23  
 SOUTHWEST DIXON POND HYDROLOGY - 100 YR 6 HR STORM EVENT  
 Storm: 2.10 inches, 100 year- 6 hour, type II-65  
 Hydrograph Convolution Interval: 0.1 hr

=====

DETAILED SUBWATERSHED INPUT/OUTPUT TABLE

=====

J	B	S	SWS	Seg. #	Land Flow Condition	Distance (ft)	Slope (%)	Velocity (fps)	Segment Time (hr)	Time Conc. (hr)	Muskingum K (hr)	X
1	1	1	1	-a	5	872.52	7.45	2.73	0.09			
				-b	5	872.52	7.45	2.73	0.09			
				-c	5	872.52	7.45	2.73	0.09			
				-d	5	872.52	7.45	2.73	0.09	0.355		

**Pages 110-114 Left Blank For Formatting Purposes**

CIVIL SOFTWARE DESIGN

SEDCAD+ Version 3

VINNEL POND HYDROLOGY

by

Name: BEN HOSKIE

Company Name: BHP MINERALS  
File Name: C:\BEN\VINNEL\VINNEL

Date: 04-23-1998

Company Name: BHP MINERALS  
 Filename: C:\BEN\VINNEL\VINNEL User: BEN HOSKIE  
 Date: 04-23-1998 Time: 12:17:53  
 VINNEL POND HYDROLOGY  
 Storm: 1.58 inches, 10 year-24 hour, type II-60  
 Hydrograph Convolution Interval: 0.1 hr

=====

SUBWATERSHED/STRUCTURE INPUT/OUTPUT TABLE

=====

-Hydrology-

JBS SWS	Area (ac)	CN	URS	Tc (hrs)	K (hrs)	X	Base- Flow (cfs)	Runoff Volume (ac-ft)	Peak Discharge (cfs)	
111 1	19.10	76	M	0.194	0.000	0.000	0.0	3.33	2.84	
111 2	70.00	76	M	0.754	0.061	0.352	0.0	1.21	4.68	
		Type: Null		Label: J1B1S1						
111 Structure	89.10								1.54	
111 Total IN/OUT	89.10								1.54	6.00
121 1	187.40	76	M	1.829	0.000	0.000	0.0	3.24	7.23	
		Type: Culvert		Label: CP-123						
121 Structure	187.40								3.24	
121 Total IN/OUT	187.40								3.24	7.23
211 1	0.00	0	M	0.000	0.000	0.000	0.0	0.00	0.00	
		Type: Pond		Label: VINNEL POND						
211 Structure	0.00								4.78	
211 Total IN	276.50								4.78	11.06
211 Total OUT									4.78	10.05
111 to 211 Routing						0.021	0.387			

Company Name: BHP MINERALS  
 Filename: C:\BEN\VINNEL\VINNEL User: BEN HOSKIE  
 Date: 04-23-1998 Time: 12:17:53  
 VINNEL POND HYDROLOGY  
 Storm: 1.58 inches, 10 year-24 hour, type II-60  
 Hydrograph Convolution Interval: 0.1 hr

=====

DETAILED SUBWATERSHED INPUT/OUTPUT TABLE

=====

J	B	S	SWS	Seg. #	Land Flow Condition	Distance (ft)	Slope (%)	Velocity (fps)	Segment Time (hr)	Time Conc. (hr)	Muskingum K (hr)	X
1	1	1	1	-a	5	1315.00	3.54	1.88	0.19	0.194		
1	1	1	2	-a	5	2850.00	1.10	1.05	0.75	0.754		
1	1	1	2	-1	8	900.15	1.83	4.06	0.06		0.061	0.352
1	2	1	1	-a	5	6785.00	1.06	1.03	1.83	1.829		
2	1	1	1	-a	8	455.00	3.85	5.88	0.02	0.000		

CIVIL SOFTWARE DESIGN

SEDCAD+ Version 3

VINNEL POND HYDROLOGY - SPILLWAY

by

Name: BEN HOSKIE

Company Name: BHP MINERALS  
File Name: C:\BEN\VINNEL\SPILL\SPILL

Date: 04-23-1998

Company Name: BHP MINERALS  
 Filename: C:\BEN\VINNEL\SPILL\SPILL User: BEN HOSKIE  
 Date: 04-23-1998 Time: 07:52:14  
 VINNEL POND HYDROLOGY - SPILLWAY  
 Storm: 1.60 inches, 25 year- 6 hour, type II-60  
 Hydrograph Convolution Interval: 0.1 hr

=====

SUBWATERSHED/STRUCTURE INPUT/OUTPUT TABLE

=====

-Hydrology-

JBS SWS	Area (ac)	CN	UHS	Tc (hrs)	K (hrs)	X	Base- Flow (cfs)	Runoff Volume (ac-ft)	Peak Discharge (cfs)	
111 1	19.10	76	M	0.194	0.000	0.000	0.0	0.34	5.24	
111 2	70.00	76	M	0.754	0.061	0.352	0.0	1.26	8.79	
		Type: Null		Label: J1B1S1						
111 Structure	89.10								1.60	
111 Total IN/OUT	89.10								1.60	11.04
121 1	187.40	76	M	1.829	0.000	0.000	0.0	3.37	13.14	
		Type: Culvert		Label: CP-123						
121 Structure	187.40								3.37	
121 Total IN/OUT	187.40								3.37	13.14
211 1	0.00	0	M	0.000	0.000	0.000	0.0	0.00	0.00	
		Type: Pond		Label: VINNEL POND						
211 Structure	0.00								4.97	
211 Total IN	276.50								4.97	19.60
211 Total OUT									4.97	17.95
111 to 211 Routing					0.021	0.387				

Company Name: BHP MINERALS  
 Filename: C:\BEN\VINNEL\SPILLASPILL User: BEN HOSKIE  
 Date: 04-23-1998 Time: 07:52:14  
 VINNEL POND HYDROLOGY - SPILLWAY  
 Storm: 1.60 inches, 25 year- 6 hour, type II-60  
 Hydrograph Convolution Interval: 0.1 hr

=====

DETAILED SUBWATERSHED INPUT/OUTPUT TABLE

=====

J	B	S	SWS	Seg. #	Land Flow Condition	Distance (ft)	Slope (%)	Velocity (fps)	Segment Time (hr)	Time Conc. (hr)	Muskingum K	X
1	1	1	1	-a	5	1315.00	3.54	1.88	0.19	0.194		
1	1	1	2	-a	5	2850.00	1.10	1.05	0.75	0.754		
1	1	1	2	-1	8	900.15	1.83	4.06	0.06		0.061	0.352
1	2	1	1	-a	5	6785.00	1.06	1.03	1.83	1.829		
2	1	1	1	-a	8	455.00	3.85	5.88	0.02	0.001		

Company Name: BHP MINERALS  
 Filename: C:\BEN\VINNEL\SPILL\SPILL User: BEN ROSKIE  
 Date: 04-23-1998 Time: 07:52:14  
 VINNEL POND HYDROLOGY - SPILLWAY  
 Storm: 1.60 inches, 25 year- 6 hour, type II-60  
 Hydrograph Convolution Interval: 0.1 hr

=====  
 POND INPUT/OUTPUT TABLE  
 =====

J2, B1, S1  
 VINNEL POND

Drainage Area from J2, B1, S1, SWS(s)1: 0.0 acres  
 Total Contributing Drainage Area: 276.5 acres

DISCHARGE OPTIONS:

Emergency  
 Spillway

Riser Diameter (in)	----
Riser Height (ft)	----
Barrel Diameter (in)	----
Barrel Length (ft)	----
Barrel Slope (%)	----
Manning's n of Pipe	----
Spillway Elevation	----
Lowest Elevation of Holes	----
# of Holes/Elevation	----
Entrance Loss Coefficient	----
Tailwater Depth (ft)	----
Notch Angle (degrees)	----
Weir Width (ft)	----
Siphon Crest Elevation	----
Siphon Tube Diameter (in)	----
Siphon Tube Length (ft)	----
Manning's n of Siphon	----
Siphon Inlet Elevation	----
Siphon Outlet Elevation	----
Emergency Spillway Elevation	5369.1
Crest Length (ft)	20.0
Z:1 (Left and Right)	3.0 3.0
Bottom Width (ft)	26.7



Company Name: BHP MINERALS  
 Filename: C:\BEN\VINNEL\SPILL\SPILL User: BEN HOSKIE  
 Date: 04-23-1998 Time: 07:52:14  
 VINNEL POND HYDROLOGY - SPILLWAY  
 Storm: 1.60 inches, 25 year- 6 hour, type\_II-60  
 Hydrograph Convolution Interval: 0.1 hr

=====  
 ELEVATION-DISCHARGE TABLE  
 =====

J2, B1, S1  
 VINNEL POND

Drainage Area from J2, B1, S1, SWS(s)1: 0.0 acres  
 Total Contributing Drainage Area: 276.5 acres

Elevation	Emergency Spillway (cfs)	Total Discharge (cfs)
5356.00	0.0	0.0
5356.50	0.0	0.0
5357.00	0.0	0.0
5369.10	0.0	0.0
5369.50	17.2	17.2
5369.70	25.7	25.7
5369.80	33.1	33.1
5369.90	43.2	43.2
5370.00	53.1	53.1

\*\*\*\*\*

Company Name: BHP MINERALS  
 Filename: C:\BEN\VINNEL\SPILL\SPILL User: BEN HOSKIE  
 Date: 04-23-1998 Time: 07:52:14  
 VINNEL POND HYDROLOGY - SPILLWAY  
 Storm: 1.50 inches, 25 year- 6 hour, type\_II-60  
 Hydrograph Convolution Interval: 0.1 hr

=====  
 ELEVATION-AREA-CAPACITY-DISCHARGE TABLE  
 =====

J2, B1, S1  
 VINNEL POND

Drainage Area from J2, B1, S1, SWS(s)1: 0.0 acres  
 Total Contributing Drainage Area: 276.5 acres

SW#1: Emergency Spillway

Elev	Stage (ft)	Area (ac)	Capacity (ac-ft)	Discharge (cfs)	
5356.00	0.00	0.00	0.00	0.00	
5356.50	0.50	0.07	0.01	0.00	
5357.00	1.00	0.26	0.09	0.00	
5357.50	1.50	0.37	0.25	0.00	
5358.00	2.00	0.50	0.46	0.00	
5358.50	2.50	0.56	0.73	0.00	
5359.00	3.00	0.63	1.03	0.00	
5359.50	3.50	0.66	1.35	0.00	
5360.00	4.00	0.69	1.69	0.00	
5360.50	4.50	0.71	2.04	0.00	
5361.00	5.00	0.74	2.40	0.00	
5361.50	5.50	0.77	2.78	0.00	
5362.00	6.00	0.80	3.17	0.00	
5362.50	6.50	0.82	3.57	0.00	
5363.00	7.00	0.85	3.99	0.00	
5363.50	7.50	0.88	4.42	0.00	
5364.00	8.00	0.91	4.87	0.00	
5364.50	8.50	0.94	5.33	0.00	
5365.00	9.00	0.97	5.81	0.00	
5365.50	9.50	1.00	6.31	0.00	
5366.00	10.00	1.04	6.82	0.00	
5366.50	10.50	1.09	7.35	0.00	
5367.00	11.00	1.14	7.90	0.00	
5367.50	11.50	1.19	8.48	0.00	
5368.00	12.00	1.23	9.09	0.00	
5368.50	12.50	1.29	9.72	0.00	
5369.00	13.00	1.34	10.37	0.00	
5369.10	13.10	1.35	10.51	0.00	Stage of SW#1
5369.50	13.50	1.41	11.06	17.16	
5369.52	13.52	1.41	11.09	17.95	Peak Stage
5369.70	13.70	1.44	11.35	25.74	
5369.80	13.80	1.45	11.49	33.09	
5369.90	13.90	1.47	11.64	43.20	
5370.00	14.00	1.48	11.78	53.12	

\*\*\*\*\*

SEDCAD+ RIPRAP CHANNEL DESIGN

VINNEL POND INLET

INPUT VALUES:

Shape	TRAPEZOIDAL	
Discharge	19.60 cfs	
Slope	8.60 %	
Sideslopes (L and R)	4.20:1	4.20:1
Bottom Width	14.00 feet	
Freeboard	.3 ft	

RESULTS:

Steep Slope Design - Simons/OSM Method

Depth	0.17 ft
with Freeboard	0.47 ft
Top Width	15.43 ft
with Freeboard	17.95 ft
Velocity	7.85 fps
Cross Sectional Area	2.50 sq ft
Hydraulic Radius	0.16 ft
Manning's n	0.031
Froude Number	3.44
Dmax	0.313 ft ( 3.75 in)
D50	0.250 ft ( 3.00 in)
D10	0.083 ft ( 1.00 in)

CIVIL SOFTWARE DESIGN

SEDCAD+ Version 3

VINNEL POND HYDROLOGY - EAST SIDE DITCH

by

Name: BEN HOSKIE

Company Name: BHP MINERALS  
File Name: C:\BEN\VINNEL\SDITCH\SD

Date: 04-23-1998

Company Name: BHP MINERALS  
 Filename: C:\BEN\VINNEL\SDITCH\SD User: BEN HOSKIE  
 Date: 04-23-1998 Time: 10:43:28  
 VINNEL POND HYDROLOGY - EAST SIDE DITCH  
 Storm: 1.80 inches, 2 year- 6 hour, type II-60  
 Hydrograph Convolution Interval: 0.1 hr

=====

SUBWATERSHED/STRUCTURE INPUT/OUTPUT TABLE

=====

-Hydrology-

JBS SWS	Area (ac)	CN UHS	Tc (hrs)	K (hrs)	X	Base- Flow (cfs)	Runoff Volume (ac-ft)	Peak Discharge (cfs)	
111 1	19.10	76 M	0.194	0.000	0.000	0.0	0.01	0.06	
111 2	70.00	76 M	0.754	0.061	0.352	0.0	0.04	0.16	
		Type: Null	Label: J1B1S1						
111 Structure	89.10							0.05	
111 Total IN/OUT	89.10							0.05	0.21
121 1	187.40	76 M	1.829	0.000	0.000	0.0	0.10	0.34	
		Type: Culvert	Label: CP-123						
121 Structure	187.40							0.10	
121 Total IN/OUT	187.40							0.10	0.34
211 1	0.00	0 M	0.000	0.000	0.000	0.0	0.00	0.00	
		Type: Pond	Label: VINNEL POND						
211 Structure	0.00							0.15	
211 Total IN	276.50							0.15	0.53
211 Total OUT								0.16	0.52
111 to 211 Routing				0.021	0.387				

Company Name: BHP MINERALS  
 Filename: C:\BEN\VINNEL\SDITCH\SD User: BEN HOSKIE  
 Date: 04-23-1998 Time: 10:43:28  
 VINNEL POND HYDROLOGY - EAST SIDE DITCH  
 Storm: 0.80 inches, 2 year- 6 hour, type II-60  
 Hydrograph Convolution Interval: 0.1 hr

=====

DETAILED SUBWATERSHED INPUT/OUTPUT TABLE

=====

J	B	S	SWS	Seq. #	Land Flow Condition	Distance (ft)	Slope (%)	Velocity (fps)	Segment Time (hr)	Time Conc. (hr)	Muskingum K (hr)	X
1	1	1	1	-a	5	1315.00	3.54	1.88	0.19	0.194		
1	1	1	2	-a	5	2850.00	1.10	1.05	0.75	0.754		
1	1	1	2	-1	8	900.15	1.83	4.06	0.06		0.061	0.352
1	2	1	1	-a	5	6785.00	1.06	1.03	1.83	1.829		
2	1	1	1	-a	8	455.00	3.85	5.88	0.02	0.000		

SEDCAD+ ERODIBLE CHANNEL DESIGN

---

BIGHAN RECLAIM RUNOFF - EAST SIDE DITCH

Limiting Velocity Technique  
Sediment-laden Water

INPUT VALUES:

Shape	TRIANGULAR	
Discharge	0.34 cfs	
Slope	4.20 %	
Sideslopes	3.00:1 (L)	2.00:1 (R)
Manning's n	0.025	
Max. Velocity	5.00 fps	
Material	SPOIL	
Freeboard	None	

RESULTS:

Actual Discharge	0.34 cfs
Depth	0.22 ft
with Freeboard	0.00 ft
Top Width	1.12 ft
with Freeboard	0.00 ft
Velocity	2.70 fps
Cross Sectional Area	0.13 sq ft
Hydraulic Radius	0.10 ft
Froude Number	1.42

## **Lowe Impoundment #1**

***Lowe Permanent Impoundment was changed to Lowe Impoundment #1. No max. sediment or water level because this structure is not considered a sediment structure. Spillway will be designed for a 25 yr- 6hr storm event.***

Shawn Smith

Navajo Coal Company  
P.O. Box 1717  
Fruitland, NM 87414

Phone: (505) 598-3376  
Email: shawn.smith@bhpbilliton.com


***General Information***

***Storm Information:***

Storm Type:	Type II-70
Design Storm:	25 yr - 6 hr
Rainfall Depth:	1.600 inches

***Structure Networking:***

Type	Stru #	(flows into)	Stru #	Musk. K (hrs)	Musk. X	Description
Null	#1	==>	#3	0.052	0.343	North Inlet - Structure 2
Null	#2	==>	#3	0.000	0.453	East Inlet - Structure 3
Pond	#3	==>	End	0.000	0.000	Pond - Structure 14

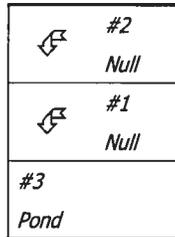

***Structure Routing Details:***

Stru #	Land Flow Condition	Slope (%)	Vert. Dist. (ft)	Horiz. Dist. (ft)	Velocity (fps)	Time (hrs)
#1	8. Large gullies, diversions, and low flowing streams	1.55	11.00	710.00	3.73	0.052
<b>#1</b>	<b>Muskingum K:</b>					<b>0.052</b>
#2	8. Large gullies, diversions, and low flowing streams	30.00	3.00	10.00	16.43	0.000
<b>#2</b>	<b>Muskingum K:</b>					<b>0.000</b>

***Structure Summary:***

	Immediate Contributing Area (ac)	Total Contributing Area (ac)	Peak Discharge (cfs)	Total Runoff Volume (ac-ft)
#2	804.310	804.310	189.79	24.43
#1	838.460	838.460	125.79	25.61
#3 In	0.000	1,642.770	279.19	50.04
Out			241.91	50.04

***Structure Detail:***

*Structure #2 (Null)*

*East Inlet - Structure 3*

*Structure #1 (Null)*

*North Inlet - Structure 2*

*Structure #3 (Pond)*

*Pond - Structure 14*

Pond Inputs:

Initial Pool Elev:	5,346.00 ft
Initial Pool:	12.73 ac-ft

Emergency Spillway

Spillway Elev	Crest Length (ft)	Left Sideslope	Right Sideslope	Bottom Width (ft)
5,346.00	50.00	4.50:1	4.50:1	50.00

Pond Results:

Peak Elevation:	5,347.56 ft
Dewater Time:	0.61 days

*Dewatering time is calculated from peak stage to lowest spillway*

Elevation-Capacity-Discharge Table

Elevation	Area (ac)	Capacity (ac-ft)	Discharge (cfs)	Dewater Time (hrs)
5,340.00	0.920	0.000	0.000	
5,341.00	1.520	1.208	0.000	
5,342.00	1.760	2.846	0.000	
5,343.00	2.010	4.730	0.000	
5,344.00	2.350	6.907	0.000	
5,345.00	2.860	9.508	0.000	
5,346.00	3.600	12.731	0.000	Spillway #1
5,346.50	3.915	14.609	47.137	11.20
5,347.00	4.230	16.645	94.274	1.25
5,347.56	4.594	19.172	241.908	2.30 Peak Stage
5,348.00	4.880	21.196	360.209	

## Detailed Discharge Table

Elevation (ft)	Emergency Spillway (cfs)	Combined Total Discharge (cfs)
5,340.00	0.000	0.000
5,341.00	0.000	0.000
5,342.00	0.000	0.000
5,343.00	0.000	0.000
5,344.00	0.000	0.000
5,345.00	0.000	0.000
5,346.00	0.000	0.000
5,346.50	47.137	47.137
5,347.00	94.274	94.274
5,348.00	360.209	360.209

**Subwatershed Hydrology Detail:**

Stru #	SWS #	SWS Area (ac)	Time of Conc (hrs)	Musk K (hrs)	Musk X	Curve Number	UHS	Peak Discharge (cfs)	Runoff Volume (ac-ft)
#2	1	256.850	2.055	0.510	0.336	83.500	M	37.90	7.774
	2	138.830	0.315	0.510	0.336	83.500	M	75.09	4.219
	3	54.830	0.221	0.510	0.336	83.500	M	34.64	1.674
	4	98.180	0.277	0.176	0.362	83.500	M	56.37	2.989
	5	111.920	0.466	0.176	0.362	83.500	M	48.73	3.393
	6	37.910	0.159	0.418	0.309	83.500	M	26.65	1.172
	7	105.790	0.386	0.000	0.000	83.500	M	51.46	3.206
	<b>Σ</b>	<b>804.310</b>						<b>189.79</b>	<b>24.427</b>
#1	1	549.140	2.696	0.436	0.369	83.600	M	65.42	16.758
	2	191.140	0.472	0.000	0.000	83.600	M	83.31	5.848
	3	98.180	0.205	0.000	0.000	83.600	M	64.19	3.005
	<b>Σ</b>	<b>838.460</b>						<b>125.79</b>	<b>25.611</b>
#3	<b>Σ</b>	<b>1,642.770</b>						<b>279.19</b>	<b>50.038</b>

**Subwatershed Time of Concentration Details:**

Stru #	SWS #	Land Flow Condition	Slope (%)	Vert. Dist. (ft)	Horiz. Dist. (ft)	Velocity (fps)	Time (hrs)
#1	1	5. Nearly bare and untilled, and alluvial valley fans	0.77	60.00	7,840.00	0.870	2.503
		8. Large gullies, diversions, and low flowing streams	1.22	28.00	2,301.00	3.300	0.193
#1	<b>1</b>	<b>Time of Concentration:</b>					<b>2.696</b>
#1	2	5. Nearly bare and untilled, and alluvial valley fans	3.97	23.00	580.00	1.990	0.080
		8. Large gullies, diversions, and low flowing streams	2.60	178.00	6,838.00	4.840	0.392
#1	<b>2</b>	<b>Time of Concentration:</b>					<b>0.472</b>
#1	3	5. Nearly bare and untilled, and alluvial valley fans	13.68	45.00	329.00	3.690	0.024
		8. Large gullies, diversions, and low flowing streams	3.12	108.00	3,466.00	5.290	0.181
#1	<b>3</b>	<b>Time of Concentration:</b>					<b>0.205</b>
#2	1	5. Nearly bare and untilled, and alluvial valley fans	0.79	46.00	5,799.00	0.890	1.809
		8. Large gullies, diversions, and low flowing streams	3.31	160.00	4,837.00	5.450	0.246
#2	<b>1</b>	<b>Time of Concentration:</b>					<b>2.055</b>
#2	2	5. Nearly bare and untilled, and alluvial valley fans	4.93	75.00	1,521.00	2.220	0.190

# SEDCAD 4 for Windows

Copyright 1998-2007 Pamela J. Schwab

Stru #	SWS #	Land Flow Condition	Slope (%)	Vert. Dist. (ft)	Horiz. Dist. (ft)	Velocity (fps)	Time (hrs)
		8. Large gullies, diversions, and low flowing streams	2.98	70.00	2,345.00	5.180	0.125
<b>#2</b>	<b>2</b>	<b>Time of Concentration:</b>					<b>0.315</b>
#2	3	5. Nearly bare and untilled, and alluvial valley fans	6.42	83.00	1,293.00	2.530	0.141
		8. Large gullies, diversions, and low flowing streams	3.21	50.00	1,559.00	5.370	0.080
<b>#2</b>	<b>3</b>	<b>Time of Concentration:</b>					<b>0.221</b>
#2	4	5. Nearly bare and untilled, and alluvial valley fans	8.98	60.00	668.00	2.990	0.062
		8. Large gullies, diversions, and low flowing streams	2.82	110.00	3,900.00	5.030	0.215
<b>#2</b>	<b>4</b>	<b>Time of Concentration:</b>					<b>0.277</b>
#2	5	5. Nearly bare and untilled, and alluvial valley fans	4.11	50.00	1,216.00	2.020	0.167
		8. Large gullies, diversions, and low flowing streams	1.86	82.00	4,404.00	4.090	0.299
<b>#2</b>	<b>5</b>	<b>Time of Concentration:</b>					<b>0.466</b>
#2	6	5. Nearly bare and untilled, and alluvial valley fans	9.01	53.00	588.00	3.000	0.054
		8. Large gullies, diversions, and low flowing streams	1.64	24.00	1,463.05	3.840	0.105
<b>#2</b>	<b>6</b>	<b>Time of Concentration:</b>					<b>0.159</b>
#2	7	5. Nearly bare and untilled, and alluvial valley fans	3.83	50.00	1,304.00	1.950	0.185
		8. Large gullies, diversions, and low flowing streams	1.42	37.00	2,598.13	3.580	0.201
<b>#2</b>	<b>7</b>	<b>Time of Concentration:</b>					<b>0.386</b>

## *Subwatershed Muskingum Routing Details:*

Stru #	SWS #	Land Flow Condition	Slope (%)	Vert. Dist. (ft)	Horiz. Dist. (ft)	Velocity (fps)	Time (hrs)
#2	1	8. Large gullies, diversions, and low flowing streams	1.36	87.00	6,414.00	3.490	0.510
<b>#2</b>	<b>1</b>	<b>Muskingum K:</b>					<b>0.510</b>
#2	2	8. Large gullies, diversions, and low flowing streams	1.36	87.00	6,414.00	3.490	0.510
<b>#2</b>	<b>2</b>	<b>Muskingum K:</b>					<b>0.510</b>
#2	3	8. Large gullies, diversions, and low flowing streams	1.36	87.00	6,414.03	3.490	0.510
<b>#2</b>	<b>3</b>	<b>Muskingum K:</b>					<b>0.510</b>
#2	4	8. Large gullies, diversions, and low flowing streams	2.20	62.00	2,822.00	4.440	0.176
<b>#2</b>	<b>4</b>	<b>Muskingum K:</b>					<b>0.176</b>
#2	5	8. Large gullies, diversions, and low flowing streams	2.20	62.00	2,822.03	4.440	0.176
<b>#2</b>	<b>5</b>	<b>Muskingum K:</b>					<b>0.176</b>

# SEDCAD 4 for Windows

Copyright 1998-2007 Pamela I. Schwab

---

Stru #	SWS #	Land Flow Condition	Slope (%)	Vert. Dist. (ft)	Horiz. Dist. (ft)	Velocity (fps)	Time (hrs)
#2	6	8. Large gullies, diversions, and low flowing streams	0.84	35.00	4,143.48	2.750	0.418
<b>#2</b>	<b>6</b>	<b>Muskingum K:</b>					<b>0.418</b>

**Blank pages due to text reformat**

**Page 135 to 138**

## **Lowe Hole 3 Pond 2**

***The watershed area is presented on Exhibit 11-13D&E. The as-built is presented on Exhibit 127D. This run reflects the reconstruction of the spillway in February 2003.***

LR

BHP Navajo Coal Company  
Navajo Mine  
PO Box 1717  
Fruitland, NM 87415

Phone: 505-598-5861

***General Information***

***Storm Information:***

Storm Type:	NRCS Type II-60
Design Storm:	25 yr - 6 hr
Rainfall Depth:	1.600 inches

***Structure Networking:***

Type	Stru #	(flows into)	Stru #	Musk. K (hrs)	Musk. X	Description
Pond	#1	==>	End	0.000	0.000	Lowe Hole 3 Pond 2

#1  
Pond

***Structure Summary:***

		Immediate Contributing Area (ac)	Total Contributing Area (ac)	Peak Discharge (cfs)	Total Runoff Volume (ac-ft)
#1	In	628.700	628.700	113.71	34.30
	Out			109.09	34.20

## *Structure Detail:*

### Structure #1 (Pond)

*Low Hole 3 Pond 2*

Pond Inputs:

Initial Pool Elev:	5,352.50
Initial Pool:	9.79 ac-ft

### Emergency Spillway

Spillway Elev	Crest Length (ft)	Left Sideslope	Right Sideslope	Bottom Width (ft)
5,352.50	25.00	8.00:1	9.50:1	10.80

Pond Results:

Peak Elevation:	5,354.17
Dewater Time:	1.00 days

*Dewatering time is calculated from peak stage to lowest spillway*

### Elevation-Capacity-Discharge Table

Elevation	Area (ac)	Capacity (ac-ft)	Discharge (cfs)	Dewater Time (hrs)
5,343.50	0.038	0.000	0.000	
5,344.00	0.171	0.048	0.000	
5,344.50	0.373	0.181	0.000	
5,345.00	0.652	0.434	0.000	
5,345.50	0.829	0.803	0.000	
5,346.00	1.028	1.267	0.000	
5,346.50	1.069	1.791	0.000	
5,347.00	1.110	2.336	0.000	
5,347.50	1.147	2.900	0.000	
5,348.00	1.184	3.482	0.000	
5,348.50	1.223	4.084	0.000	
5,349.00	1.262	4.705	0.000	
5,349.50	1.302	5.346	0.000	
5,350.00	1.342	6.007	0.000	
5,350.50	1.402	6.693	0.000	
5,351.00	1.463	7.409	0.000	
5,351.50	1.545	8.161	0.000	

# SEDCAD 4 for Windows

Copyright 1998 Pamela J. Schwab  
Civil Software Design

Elevation	Area (ac)	Capacity (ac-ft)	Discharge (cfs)	Dewater Time (hrs)
5,352.00	1.630	8.955	0.000	
5,352.50	1.725	9.793	0.000	Spillway #1
5,353.00	1.820	10.680	0.713	15.04*
5,353.50	2.010	11.637	34.257	6.90
5,353.60	2.049	11.840	42.386	0.35
5,354.00	2.207	12.690	84.318	0.95
5,354.17	2.369	13.095	109.087	0.85 Peak Stage
5,354.50	2.554	13.880	157.028	
5,355.00	2.926	15.248	259.761	

\*Designates time(s) to dewater have been extrapolated beyond the 50 hour hydrograph limit.

## Detailed Discharge Table

Elevation	Emergency Spillway (cfs)	Combined Total Discharge (cfs)
5,343.50	0.000	0.000
5,344.00	0.000	0.000
5,344.50	0.000	0.000
5,345.00	0.000	0.000
5,345.50	0.000	0.000
5,346.00	0.000	0.000
5,346.50	0.000	0.000
5,347.00	0.000	0.000
5,347.50	0.000	0.000
5,348.00	0.000	0.000
5,348.50	0.000	0.000
5,349.00	0.000	0.000
5,349.50	0.000	0.000
5,350.00	0.000	0.000
5,350.50	0.000	0.000
5,351.00	0.000	0.000
5,351.50	0.000	0.000
5,352.00	0.000	0.000
5,352.50	0.000	0.000
5,353.00	0.713	0.713
5,353.50	34.257	34.257
5,353.60	42.386	42.386
5,354.00	84.318	84.318

# SEDCAD 4 for Windows

Copyright 1998 Pamela J. Schwab  
Civil Software Design

Elevation	Emergency Spillway (cfs)	Combined Total Discharge (cfs)
5,354.50	157.028	157.028
5,355.00	259.761	259.761

***Subwatershed Hydrology Detail:***

Stru #	SWS #	SWS Area (ac)	Time of Conc (hrs)	Musk K (hrs)	Musk X	Curve Number	UHS	Peak Discharge (cfs)	Runoff Volume (ac-ft)
#1	1	628.700	2.360	0.000	0.000	88.000	M	113.71	34.299
<b>Σ</b>		<b>628.700</b>						<b>113.71</b>	<b>34.299</b>

***Subwatershed Time of Concentration Details:***

Stru #	SWS #	Land Flow Condition	Slope (%)	Vert. Dist. (ft)	Horiz. Dist. (ft)	Velocity (fps)	Time (hrs)
#1	1	5. Nearly bare and untilled, and alluvial valley fans	2.06	250.00	12,150.00	1.430	2.360
<b>#1</b>	<b>1</b>	<b>Time of Concentration:</b>					<b>2.360</b>

***General Information***

***Storm Information:***

Storm Type:	NRCS Type II-60
Design Storm:	2 yr - 6 hr
Rainfall Depth:	0.800 inches

***Structure Summary:***

		Immediate Contributing Area (ac)	Total Contributing Area (ac)	Peak Discharge (cfs)	Total Runoff Volume (ac-ft)
#1	In			23.79	7.70
	Out	628.700	628.700	21.51	7.61

Blank page due to text reformat

# **Lowehole-3, Pond-3 As Built**

PJF

BHP Coal Company - Navajo Mine  
PO Box 1717  
Fruitland, NM 87416

Phone: (505) 598-3206

***General Information***

***Storm Information:***

Storm Type:	Type II-65
Design Storm:	100 yr - 6 hr
Rainfall Depth:	2.100 inches

### Structure Networking:

Type	Stru #	(flows into)	Stru #	Musk. K (hrs)	Musk. X	Description
Null	#1	==>	End	0.000	0.000	lowehole-3 pond

#1  
*Null*

***Subwatershed Hydrology Detail:***

Stru #	SWS #	SWS Area (ac)	Time of Conc (hrs)	Musk K (hrs)	Musk X	Curve Number	UHS	Peak Discharge (cfs)	Runoff Volume (ac-ft)
#1	1	39.610	0.191	0.000	0.000	79.670	M	32.45	2.01
	$\Sigma$	<b>39.610</b>						<b>32.45</b>	<b>2.01</b>

***Subwatershed Time of Concentration Details:***

Stru #	SWS #	Land Flow Condition	Slope (%)	Vert. Dist. (ft)	Horiz. Dist. (ft)	Velocity (fps)	Time (hrs)
#1	1	5. Nearly bare and untilled, and alluvial valley fans	5.89	98.00	1,665.00	2.420	0.191
<b>#1</b>	<b>1</b>	<b>Time of Concentration:</b>					<b>0.191</b>

CIVIL SOFTWARE DESIGN

SEDCAD+ Version 3

LOWE HOLE 3 POND 3 INLET HYDROLOGY

by

Name: RUSSELL HARRIS

Company Name: BHP MINERALS  
File Name: C:\RUSSWORK\LOWE\_PON\LH3\_PD3I

Date: 09-03-1997

Company Name: BHP MINERALS  
 Filename: C:\RUSSWORK\LOWE\_PON\LH3\_PD3I User: RUSSELL HARRIS  
 Date: 09-03-1997 Time: 12:50:53  
 LOWE HOLE 3 POND 3 INLET HYDROLOGY  
 Storm: 1.30 inches, 10 year- 6 hour, type II-65  
 Hydrograph Convolution Interval: 0.1 hr

=====  
 SUBWATERSHED/STRUCTURE INPUT/OUTPUT TABLE  
 =====

-Hydrology-

JBS	SWS	Area (ac)	CN	UHS	Tc (hrs)	K (hrs)	X	Base- Flow (cfs)	Runoff Volume (ac-ft)	Peak Discharge (cfs)	
L11	1	11.70	80	M	0.116	0.000	0.000	0.0	0.19	6.03	
					Type: Null	Label: LH3PD3INLET					
L11	Structure	11.70									
									0.19		
L11	Total IN/OUT	11.70								0.19	6.03

SEDCAD+ ERODIBLE CHANNEL DESIGN

LH3 POND 3 INLET DESIGN

Limiting Velocity Technique  
Sediment-laden Water


INPUT VALUES:

Shape	TRAPEZOIDAL
Discharge	6.03 cfs
Slope	4.00 %
Sideslopes	3.00:1 (L)      3.00:1 (R)
Bottom Width	8.00 ft
Manning's n	0.020
Max. Velocity	5.00 fps
Material	SPOIL, SHALE/SANDSTONE COBBLES
Freeboard	1 ft

RESULTS:


Actual Discharge	6.03 cfs
Depth	0.17 ft
with Freeboard	1.17 ft
Top Width	8.99 ft
with Freeboard	14.99 ft
Velocity	4.30 fps
Cross Sectional Area	1.40 sq ft
Hydraulic Radius	0.16 ft
Froude Number	1.92

SEDCAD+ CHANNEL DESIGN  
 LH3 POND 3 INLET DESIGN

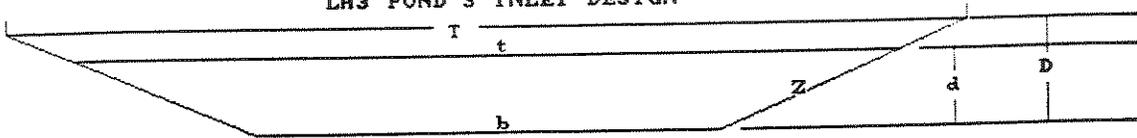

MATERIAL: SPOIL, SHALE/SANDSTONE COBBLES  
 Limiting Variable: Velocity = 5.000 fps  
 Sediment-laden Water

Discharge	==	6.03 cfs	Depth (d)	==	0.17 (D = 1.17) ft
Bottom (b)	==	8.00 ft	Top width (t)	==	8.99 (T = 14.99) ft
Side slopes (Z)	==	3.0:1(L) 3.0:1(R)	Velocity	==	4.30 fps
Bed Slope	==	4.00 %	Hydraulic Radius	==	0.16 ft
Manning's n	==	0.020	Froude number	==	1.92

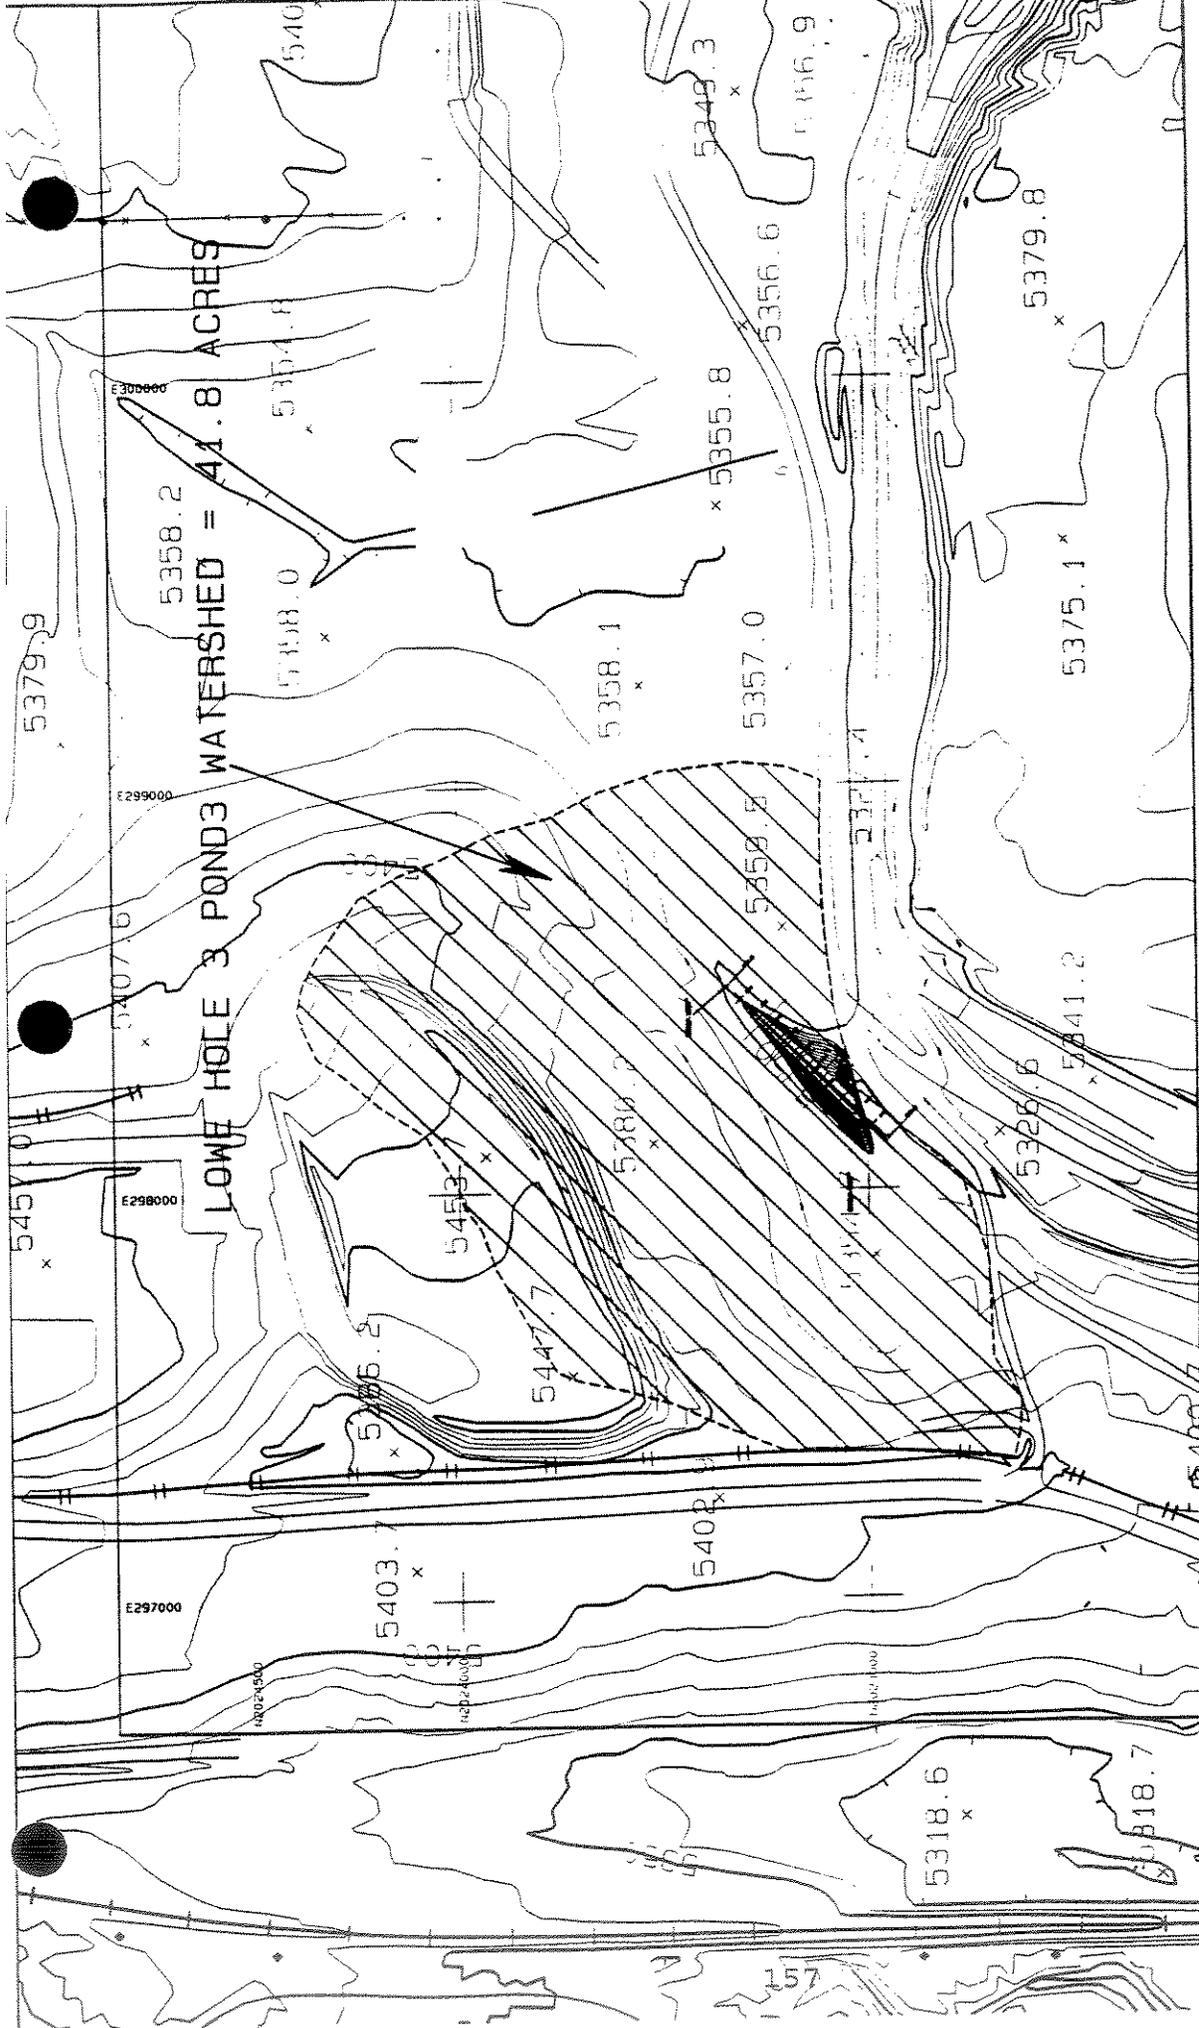

---

# **EMPLOYEE COAL DUMP**

***100YR-6HR STORM EVENT, NO SPILLWAY REQUIRED.***

***UPDATED AS-BUILT WITH THE A3 BYPASS ROAD RE-ALIGNED.  
REFER TO EXHIBIT 11-132 FOR UPDATED AS-BUILT DATA.***

R. Yazzie

BHP Navajo Coal Company  
PO Box 1717  
Fruitland, NM 87416

Phone: (505) 598-3317

---

## ***General Information***

### ***Storm Information:***

Storm Type:	NM TYPE II 70
Design Storm:	100 yr - 6 hr
Rainfall Depth:	2.210 inches

**Structure Networking:**

Type	Stru #	(flows into)	Stru #	Musk. K (hrs)	Musk. X	Description
Null	#1	==>	End	0.000	0.000	EMCD POND



***Structure Summary:***

	Immediate Contributing Area (ac)	Total Contributing Area (ac)	Peak Discharge (cfs)	Total Runoff Volume (ac-ft)
#1	6.730	6.730	11.42	0.55

***Structure Detail:***

*Structure #1 (Null)*

*EMCD POND*

***Subwatershed Hydrology Detail:***

Stru #	SWS #	SWS Area (ac)	Time of Conc (hrs)	Musk K (hrs)	Musk X	Curve Number	UHS	Peak Discharge (cfs)	Runoff Volume (ac-ft)
#1	1	6.730	0.151	0.000	0.000	89.000	M	11.42	0.549
<b>Σ</b>		<b>6.730</b>						<b>11.42</b>	<b>0.549</b>

***Subwatershed Time of Concentration Details:***

Stru #	SWS #	Land Flow Condition	Slope (%)	Vert. Dist. (ft)	Horiz. Dist. (ft)	Velocity (fps)	Time (hrs)
#1	1	5. Nearly bare and untilled, and alluvial valley fans	2.05	6.15	299.74	1.430	0.058
		8. Large gullies, diversions, and low flowing streams	2.41	37.66	1,564.98	4.650	0.093
<b>#1</b>	<b>1</b>	<b>Time of Concentration:</b>					<b>0.151</b>

## **Block C Pond 1**

***This pond has a single closed spillway. It is re-evaluated as a total containment structure for the 100 year-6 hour storm. The curve number was adjusted to account for the reclaimed lands. Refer to Section 11.5.4.3 of the mine permit for discussion on ponds with a single closed spillway. The pond location and watershed areas are presented on Exhibit 11-13 C & D.***

LR

BHP Navajo Coal Company  
PO Box 1717  
Fruitland, NM  
87416

***General Information***

***Storm Information:***

Storm Type:	Type II-60
Design Storm:	100 yr - 6 hr
Rainfall Depth:	2.000 inches

**Structure Networking:**

Type	Stru #	(flows into)	Stru #	Musk. K (hrs)	Musk. X	Description
Pond	#1	==>	End	0.000	0.000	BC POND 1

#1  
Pond

***Structure Summary:***

		Immediate Contributing Area (ac)	Total Contributing Area (ac)	Peak Discharge (cfs)	Total Runoff Volume (ac-ft)
#1	In	49.480	49.480	38.54	2.49
	Out			0.00	0.00

### Structure Detail:

Structure #1 (Pond)

BC POND 1

Pond Inputs:

Initial Pool Elev:	5,296.25
Initial Pool:	0.00 ac-ft

Straight Pipe

Barrel Diameter (in)	Barrel Length (ft)	Barrel Slope (%)	Manning's n	Spillway Elev	Entrance Loss Coefficient	Tailwater Depth (ft)
24.00	120.00	4.16	0.0160	5,312.30	0.50	0.00

Pond Results:

Peak Elevation:	<del>5,305.23</del> 5306.53
Dewater Time:	0.00 days

*Dewatering time is calculated from peak stage to lowest spillway*

Elevation-Capacity-Discharge Table

Elevation	Area (ac)	Capacity (ac-ft)	Discharge (cfs)	Dewater Time (hrs)
5,296.00	0.000	0.000	0.000	
5,296.25	0.008	0.001	0.000	
5,296.50	0.022	0.004	0.000	
5,297.00	0.064	0.025	0.000	
5,297.50	0.113	0.069	0.000	
5,298.00	0.177	0.141	0.000	
5,298.50	0.195	0.234	0.000	
5,299.00	0.215	0.336	0.000	
5,299.50	0.224	0.446	0.000	
5,300.00	0.233	0.560	0.000	
5,300.50	0.241	0.679	0.000	
5,301.00	0.249	0.801	0.000	
5,301.50	0.258	0.928	0.000	
5,302.00	0.267	1.059	0.000	
5,302.50	0.276	1.195	0.000	
5,303.00	0.286	1.336	0.000	

# SEDCAD 4 for Windows

Copyright 1998 Pamela J. Schwab

Elevation	Area (ac)	Capacity (ac-ft)	Discharge (cfs)	Dewater Time (hrs)
5,303.50	0.296	1.481	0.000	
5,304.00	0.307	1.632	0.000	
5,304.50	0.317	1.788	0.000	
5,305.00	0.328	1.949	0.000	
5,305.23	0.333	2.025	0.000	<del>0.00</del> Peak Stage
5,305.50	0.338	2.116	0.000	
5,306.00	0.349	2.288	0.000	
5,306.50	0.362	2.465	0.000	<i> Elev 5306.53 Peak Stage</i>
5,307.00	0.374	2.649	0.000	
5,307.50	0.387	2.840	0.000	
5,308.00	0.401	3.037	0.000	
5,308.50	0.415	3.241	0.000	
5,309.00	0.430	3.452	0.000	
5,309.50	0.444	3.671	0.000	
5,310.00	0.458	3.896	0.000	
5,310.50	0.472	4.129	0.000	
5,311.00	0.486	4.368	0.000	
5,311.50	0.500	4.614	0.000	
5,312.00	0.514	4.868	0.000	
5,312.30	0.524	5.023	0.000	Spillway #1
5,312.50	0.530	5.129	0.407	
5,313.00	0.545	5.398	2.457	
5,313.50	0.562	5.674	5.509	
5,314.00	0.579	5.960	9.288	
5,314.50	0.600	6.254	13.667	
5,315.00	0.622	6.560	17.519	

## Detailed Discharge Table

Elevation	Straight Pipe (cfs)	Combined Total Discharge (cfs)
5,296.00	0.000	0.000
5,296.25	0.000	0.000
5,296.50	0.000	0.000
5,297.00	0.000	0.000
5,297.50	0.000	0.000
5,298.00	0.000	0.000
5,298.50	0.000	0.000
5,299.00	0.000	0.000

# SEDCAD 4 for Windows

Copyright 1998 Pamela I. Schwab

Elevation	Straight Pipe (cfs)	Combined Total Discharge (cfs)
5,299.50	0.000	0.000
5,300.00	0.000	0.000
5,300.50	0.000	0.000
5,301.00	0.000	0.000
5,301.50	0.000	0.000
5,302.00	0.000	0.000
5,302.50	0.000	0.000
5,303.00	0.000	0.000
5,303.50	0.000	0.000
5,304.00	0.000	0.000
5,304.50	0.000	0.000
5,305.00	0.000	0.000
5,305.50	0.000	0.000
5,306.00	0.000	0.000
5,306.50	0.000	0.000
5,307.00	0.000	0.000
5,307.50	0.000	0.000
5,308.00	0.000	0.000
5,308.50	0.000	0.000
5,309.00	0.000	0.000
5,309.50	0.000	0.000
5,310.00	0.000	0.000
5,310.50	0.000	0.000
5,311.00	0.000	0.000
5,311.50	0.000	0.000
5,312.00	0.000	0.000
5,312.30	0.000	0.000
5,312.50	(3)>0.407	0.407
5,313.00	(3)>2.457	2.457
5,313.50	(3)>5.509	5.509
5,314.00	(3)>9.288	9.288
5,314.50	(3)>13.667	13.667
5,315.00	(5)>17.519	17.519

***Subwatershed Hydrology Detail:***

Stru #	SWS #	SWS Area (ac)	Time of Conc (hrs)	Musk K (hrs)	Musk X	Curve Number	UHS	Peak Discharge (cfs)	Runoff Volume (ac-ft)
#1	1	49.480	0.160	0.000	0.000	81.000	M	38.54	2.493
	$\Sigma$	<b>49.480</b>						<b>38.54</b>	<b>2.493</b>

***Subwatershed Time of Concentration Details:***

Stru #	SWS #	Land Flow Condition	Slope (%)	Vert. Dist. (ft)	Horiz. Dist. (ft)	Velocity (fps)	Time (hrs)
#1	1	5. Nearly bare and untilled, and alluvial valley fans	5.68	23.00	405.00	2.380	0.047
		8. Large gullies, diversions, and low flowing streams	3.96	97.00	2,449.00	5.970	0.113
<b>#1</b>	<b>1</b>	<b>Time of Concentration:</b>					<b>0.160</b>

## **Block C Pond 2**

***This pond has a single closed spillway. It is re-evaluated as a total containment structure for the 100 year-6 hour storm. The curve number was adjusted to account for the reclaimed lands. Refer to Section 11.5.4.3 of the mine permit for discussion on ponds with a single closed spillway. The pond location and watershed areas are presented on Exhibit 11-13***

Pages 87 – 88 ~~blank~~ due to text changes

**C & D.**

LR

BHP Navajo Coal Company  
PO Box 1717  
Fruitland, NM  
87416

***General Information***

***Storm Information:***

Storm Type:	Type II-60
Design Storm:	100 yr - 6 hr
Rainfall Depth:	2.000 inches

### Structure Networking:

Type	Stru #	(flows into)	Stru #	Musk. K (hrs)	Musk. X	Description
Pond	#1	==>	End	0.000	0.000	Block C Pd 2



***Structure Summary:***

		Immediate Contributing Area (ac)	Total Contributing Area (ac)	Peak Discharge (cfs)	Total Runoff Volume (ac-ft)
#1	In	66.640	66.640	62.07	4.42
	Out			0.00	0.00

### Structure Detail:

Structure #1 (Pond)

Block C Pd 2

Pond Inputs:

Initial Pool Elev:	5,300.20
Initial Pool:	0.00 ac-ft

Straight Pipe

Barrel Diameter (in)	Barrel Length (ft)	Barrel Slope (%)	Manning's n	Spillway Elev	Entrance Loss Coefficient	Tailwater Depth (ft)
24.00	120.00	3.00	0.0160	5,308.90	0.50	0.00

Pond Results:

Peak Elevation:	<del>5,306.42</del> 5307.41
Dewater Time:	0.00 days

*Dewatering time is calculated from peak stage to lowest spillway*

Elevation-Capacity-Discharge Table

Elevation	Area (ac)	Capacity (ac-ft)	Discharge (cfs)	Dewater Time (hrs)
5,300.00	0.359	0.000	0.000	
5,300.20	0.378	0.074	0.000	
5,300.50	0.407	0.191	0.000	
5,301.00	0.458	0.408	0.000	
5,301.50	0.482	0.643	0.000	
5,302.00	0.507	0.890	0.000	
5,302.50	0.528	1.149	0.000	
5,303.00	0.549	1.418	0.000	
5,303.50	0.571	1.698	0.000	
5,304.00	0.594	1.989	0.000	
5,304.50	0.618	2.292	0.000	
5,305.00	0.643	2.607	0.000	
5,305.50	0.676	2.937	0.000	
5,306.00	0.710	3.284	0.000	
5,306.42	0.760	3.595	0.000	<del>0.00</del> Peak Stage
5,306.50	0.767	3.653	0.000	

# SEDCAD 4 for Windows

Copyright 1998 Pamela J. Schwab

Elevation	Area (ac)	Capacity (ac-ft)	Discharge (cfs)	Dewater Time (hrs)
5,307.00	0.827	4.051	0.000	<i>Elev 5307.91 Peak Stage</i>
5,307.50	0.897	4.482	0.000	
5,308.00	0.970	4.949	0.000	
5,308.50	1.068	5.458	0.000	
5,308.90	1.149	5.902	0.000	Spillway #1
5,309.00	1.169	6.018	0.145	
5,309.50	1.338	6.644	1.951	
5,310.00	1.518	7.358	4.838	
5,310.50	1.740	8.171	8.478	
5,311.00	1.978	9.100	12.746	

## Detailed Discharge Table

Elevation	Straight Pipe (cfs)	Combined Total Discharge (cfs)
5,300.00	0.000	0.000
5,300.20	0.000	0.000
5,300.50	0.000	0.000
5,301.00	0.000	0.000
5,301.50	0.000	0.000
5,302.00	0.000	0.000
5,302.50	0.000	0.000
5,303.00	0.000	0.000
5,303.50	0.000	0.000
5,304.00	0.000	0.000
5,304.50	0.000	0.000
5,305.00	0.000	0.000
5,305.50	0.000	0.000
5,306.00	0.000	0.000
5,306.50	0.000	0.000
5,307.00	0.000	0.000
5,307.50	0.000	0.000
5,308.00	0.000	0.000
5,308.50	0.000	0.000
5,308.90	0.000	0.000
5,309.00	(3)>0.145	0.145
5,309.50	(3)>1.951	1.951
5,310.00	(3)>4.838	4.838
5,310.50	(3)>8.478	8.478

# SEDCAD 4 for Windows

Copyright 1998 Pamela L. Schwab

Elevation	Straight Pipe (cfs)	Combined Total Discharge (cfs)
5,311.00	(3)>12.746	12.746

***Subwatershed Hydrology Detail:***

Stru #	SWS #	SWS Area (ac)	Time of Conc (hrs)	Musk K (hrs)	Musk X	Curve Number	UHS	Peak Discharge (cfs)	Runoff Volume (ac-ft)
#1	1	66.640	0.208	0.000	0.000	85.000	M	62.07	4.416
		<b>Σ 66.640</b>						<b>62.07</b>	<b>4.416</b>

***Subwatershed Time of Concentration Details:***

Stru #	SWS #	Land Flow Condition	Slope (%)	Vert. Dist. (ft)	Horiz. Dist. (ft)	Velocity (fps)	Time (hrs)
#1	1	5. Nearly bare and untilled, and alluvial valley fans	8.27	67.00	810.00	2.870	0.078
		8. Large gullies, diversions, and low flowing streams	2.54	57.00	2,242.00	4.780	0.130
<b>#1</b>	<b>1</b>	<b>Time of Concentration:</b>					<b>0.208</b>

## **BLOCK C POND 3**

***This Pond is evaluated as a total containment structure for the 100 year-6 hour storm. The curve number was adjusted to account for the reclaimed lands. This pond location and watershed areas are presented on Exhibit 11-13 C&D.***

Shawn Smith

Navajo Coal Company  
P.O. Box 1717  
Fruitland, NM 87416

Phone: (505) 598-3376  
Email: shawn.smith@bhpbilliton.com

---


## ***General Information***

### ***Storm Information:***

Storm Type:	Type II-70
Design Storm:	100 yr - 6 hr
Rainfall Depth:	2.000 inches

**Structure Networking:**

Type	Stru #	(flows into)	Stru #	Musk. K (hrs)	Musk. X	Description
Pond	#1	==>	End	0.000	0.000	BLOCK C POND 3
Null	#2	==>	#1	0.257	0.346	

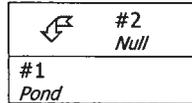

**Structure Routing Details:**

Stru #	Land Flow Condition	Slope (%)	Vert. Dist. (ft)	Horiz. Dist. (ft)	Velocity (fps)	Time (hrs)
#2	8. Large gullies, diversions, and low flowing streams	1.62	57.00	3,527.00	3.81	0.257
<b>#2</b>	<b>Muskingum K:</b>					<b>0.257</b>

***Structure Summary:***

	Immediate Contributing Area (ac)	Total Contributing Area (ac)	Peak Discharge (cfs)	Total Runoff Volume (ac-ft)	
#2	137.510	137.510	90.84	8.89	
#1	In Out	36.910	174.420	98.09 44.92	14.69 14.69

### Structure Detail:

Structure #2 (Null)

Structure #1 (Pond)

**BLOCK C POND 3**

Pond Inputs:

Permanent Pool Elev:	5,273.00
Permanent Pool:	16.72 ac-ft

#### Emergency Spillway

Spillway Elev	Crest Length (ft)	Left Sideslope	Right Sideslope	Bottom Width (ft)
5,273.00	30.00	3.00:1	3.00:1	25.00

Pond Results:

Peak Elevation:	5,273.81
H'graph Detention Time:	1.01 hrs
Dewater Time:	0.43 days

*Dewatering time is calculated from peak stage to lowest spillway*

#### Elevation-Capacity-Discharge Table

Elevation	Area (ac)	Capacity (ac-ft)	Discharge (cfs)	Dewater Time (hrs)
5,266.00	1.460	0.000	0.000	
5,266.50	1.554	0.753	0.000	
5,267.00	1.650	1.554	0.000	
5,267.50	1.758	2.406	0.000	
5,268.00	1.870	3.313	0.000	
5,268.50	1.983	4.276	0.000	
5,269.00	2.100	5.297	0.000	
5,269.50	2.223	6.377	0.000	
5,270.00	2.350	7.521	0.000	
5,270.50	2.536	8.742	0.000	
5,271.00	2.730	10.058	0.000	
5,271.50	2.960	11.480	0.000	
5,272.00	3.200	13.020	0.000	
5,272.50	3.697	14.743	0.000	
5,273.00	4.230	16.723	0.000	Spillway #1
5,273.50	4.797	18.978	27.710	9.10

# SEDCAD 4 for Windows

Copyright 1998 Pamela J. Schwab

Elevation	Area (ac)	Capacity (ac-ft)	Discharge (cfs)	Dewater Time (hrs)	
5,273.81	5.178	20.561	44.919	1.20	Peak Stage
5,274.00	5.400	21.526	55.420		
5,274.50	5.937	24.360	121.915		
5,275.00	6.500	27.468	198.623		

## Detailed Discharge Table

Elevation	Emergency Spillway (cfs)	Combined Total Discharge (cfs)
5,266.00	0.000	0.000
5,266.50	0.000	0.000
5,267.00	0.000	0.000
5,267.50	0.000	0.000
5,268.00	0.000	0.000
5,268.50	0.000	0.000
5,269.00	0.000	0.000
5,269.50	0.000	0.000
5,270.00	0.000	0.000
5,270.50	0.000	0.000
5,271.00	0.000	0.000
5,271.50	0.000	0.000
5,272.00	0.000	0.000
5,272.50	0.000	0.000
5,273.00	0.000	0.000
5,273.50	27.710	27.710
5,274.00	55.420	55.420
5,274.50	121.915	121.915
5,275.00	198.623	198.623

***Subwatershed Hydrology Detail:***

Stru #	SWS #	SWS Area (ac)	Time of Conc (hrs)	Musk K (hrs)	Musk X	Curve Number	UHS	Peak Discharge (cfs)	Runoff Volume (ac-ft)
#2	1	137.510	0.569	0.000	0.000	84.630	M	90.84	8.89
<b>S</b>		<b>137.510</b>						<b>90.84</b>	<b>8.89</b>
#1	1	36.910	0.267	0.000	0.000	84.380	M	35.45	2.35
<b>S</b>		<b>174.420</b>						<b>98.09</b>	<b>14.69</b>

***Subwatershed Time of Concentration Details:***

Stru #	SWS #	Land Flow Condition	Slope (%)	Vert. Dist. (ft)	Horiz. Dist. (ft)	Velocity (fps)	Time (hrs)
#1	1	8. Large gullies, diversions, and low flowing streams	1.56	53.00	3,398.59	3.740	0.252
		8. Large gullies, diversions, and low flowing streams	3.06	9.00	294.50	5.240	0.015
<b>#1</b>	<b>1</b>	<b>Time of Concentration:</b>					<b>0.267</b>
#2	1	5. Nearly bare and untilled, and alluvial valley fans	5.60	146.00	2,606.25	2.360	0.306
		8. Large gullies, diversions, and low flowing streams	1.01	29.00	2,859.50	3.020	0.263
<b>#2</b>	<b>1</b>	<b>Time of Concentration:</b>					<b>0.569</b>



## **Block-C Pond 4**

*The watershed for the impoundment is presented on Exhibit 11-13D. The detail design is presented on Exhibit 11-136.*

*The pond is design to retain the runoff from the 100 year-6 hour storm event, therefore no spillway required.*

Shawn Smith

Navajo Coal Company  
P.O. Box 1717  
Fruitland, NM 87416

Phone: (505) 598-3376  
Email: shawn.smith@bhpbilliton.com


## *General Information*

### *Storm Information:*

Storm Type:	TYPE II-60
Design Storm:	100 yr - 6 hr
Rainfall Depth:	2.000 inches

## *Structure Networking:*

Type	Stru #	(flows into)	Stru #	Musk. K (hrs)	Musk. X	Description
Channel	#1	==>	#4	0.000	0.000	
Channel	#2	==>	#4	0.014	0.368	
Null	#3	==>	#2	0.231	0.344	
Null	#4	==>	End	0.000	0.000	Block-C Pond 4

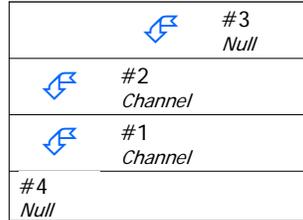

## *Structure Routing Details:*

Stru #	Land Flow Condition	Slope (%)	Vert. Dist. (ft)	Horiz. Dist. (ft)	Velocity (fps)	Time (hrs)
#2	8. Large gullies, diversions, and low flowing streams	2.48	6.00	241.76	4.72	0.014
<b>#2</b>	<b>Muskingum K:</b>					<b>0.014</b>
#3	8. Large gullies, diversions, and low flowing streams	1.57	49.00	3,121.63	3.75	0.231
<b>#3</b>	<b>Muskingum K:</b>					<b>0.231</b>

## ***Structure Summary:***

	Immediate Contributing Area (ac)	Total Contributing Area (ac)	Peak Discharge (cfs)	Total Runoff Volume (ac-ft)
#3	122.150	122.150	83.98	7.26
#2	60.020	182.170	106.02	10.43
#1	80.470	80.470	22.32	2.76
#4	0.000	262.640	128.27	13.19

***Structure Detail:***

*Structure #3 (Null)*

*Structure #2 (Riprap Channel)*

Trapezoidal Riprap Channel Inputs:

Material: Riprap

Bottom Width (ft)	Left Sideslope Ratio	Right Sideslope Ratio	Slope (%)	Freeboard Depth (ft)	Freeboard % of Depth	Freeboard Mult. x (VxD)
12.00	3.0:1	3.0:1	8.0	1.00		

Riprap Channel Results:

**Simons/OSM Method - Steep Slope Design**

	w/o Freeboard	w/ Freeboard
Depth:	0.73 ft	1.73 ft
Top Width:	16.39 ft	22.39 ft
Velocity*:		
X-Section Area:	10.38 sq ft	
Hydraulic Radius:	0.624	
Froude Number*:		
Manning's n*:		
Dmin:	3.00 in	
D50:	9.00 in	
Dmax:	11.25 in	

Velocity and Manning's n calculations may not apply for this method.

*Structure #1 (Riprap Channel)*

Trapezoidal Riprap Channel Inputs:

Material: Riprap

Bottom Width (ft)	Left Sideslope Ratio	Right Sideslope Ratio	Slope (%)	Freeboard Depth (ft)	Freeboard % of Depth	Freeboard Mult. x (VxD)
8.00	3.0:1	3.0:1	20.0			

Riprap Channel Results:

**Simons/OSM Method - Steep Slope Design**

	w/o Freeboard	w/ Freeboard
Depth:	0.20 ft	0.00 ft

---

	w/o Freeboard	w/ Freeboard
Top Width:	9.17 ft	0.00 ft
Velocity*:		
X-Section Area:	1.68 sq ft	
Hydraulic Radius:	0.182	
Froude Number*:		
Manning's n*:		
Dmin:	3.00 in	
D50:	9.00 in	
Dmax:	11.25 in	

Velocity and Manning's n calculations may not apply for this method.

## Structure #4 (Null)


*Block-C Pond 4*

***Subwatershed Hydrology Detail:***

Stru #	SWS #	SWS Area (ac)	Time of Conc (hrs)	Musk K (hrs)	Musk X	Curve Number	UHS	Peak Discharge (cfs)	Runoff Volume (ac-ft)
#3	1	122.150	0.349	0.000	0.000	83.380	M	83.98	7.26
	<b>S</b>	<b>122.150</b>						<b>83.98</b>	<b>7.26</b>
#2	1	60.020	0.416	0.000	0.000	81.650	M	33.48	3.17
	<b>S</b>	<b>182.170</b>						<b>106.02</b>	<b>10.43</b>
#1	1	80.470	0.595	0.000	0.000	75.940	M	22.32	2.76
	<b>S</b>	<b>80.470</b>						<b>22.32</b>	<b>2.76</b>
#4	<b>S</b>	<b>262.640</b>						<b>128.27</b>	<b>13.19</b>

***Subwatershed Time of Concentration Details:***

Stru #	SWS #	Land Flow Condition	Slope (%)	Vert. Dist. (ft)	Horiz. Dist. (ft)	Velocity (fps)	Time (hrs)
#1	1	3. Short grass pasture	6.44	35.00	543.36	2.030	0.074
		5. Nearly bare and untilled, and alluvial valley fans	3.06	100.00	3,269.04	1.740	0.521
<b>#1</b>	<b>1</b>	<b>Time of Concentration:</b>					<b>0.595</b>
#2	1	8. Large gullies, diversions, and low flowing streams	2.61	90.00	3,445.87	4.840	0.197
		8. Large gullies, diversions, and low flowing streams	1.54	45.00	2,926.82	3.710	0.219
<b>#2</b>	<b>1</b>	<b>Time of Concentration:</b>					<b>0.416</b>
#3	1	5. Nearly bare and untilled, and alluvial valley fans	1.70	10.00	586.99	1.300	0.125
		8. Large gullies, diversions, and low flowing streams	3.08	131.00	4,259.27	5.260	0.224
<b>#3</b>	<b>1</b>	<b>Time of Concentration:</b>					<b>0.349</b>

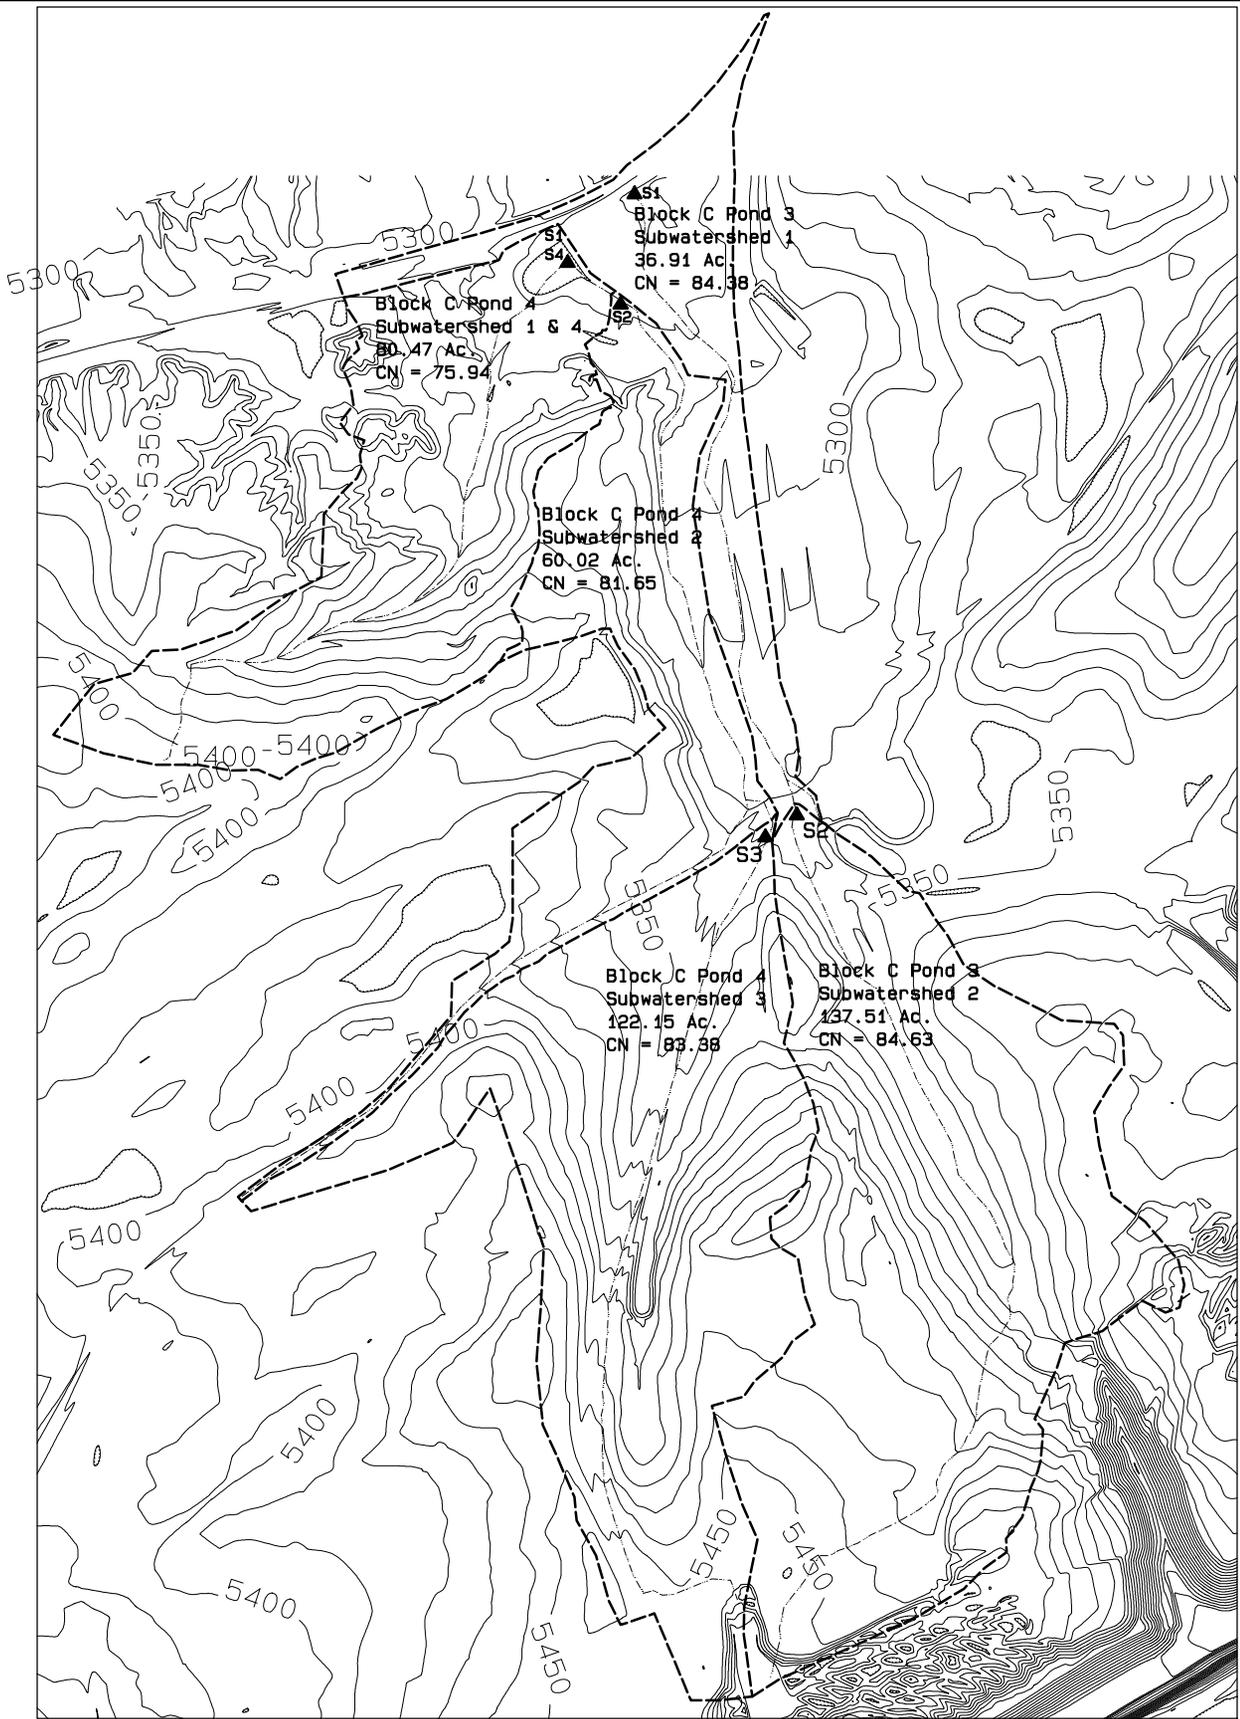

REV.	DATE	BY	DESCRIPTION	DES.	CHECKED	DATE	BY
A	7/16/07	SS	BLOCK-C POND 3 WATERSHED MODIFIED AND POND 4 ADDED.	SS	KJ	LR	SS
REVISION DESCRIPTION				ENG.	F.R.	RE	APP


**EXHIBIT 11-13D**  
**BHP NAVAJO COAL COMPANY**

  
 P.O. BOX 1717  
 FRUITLAND, NEW MEXICO 87416

**STRUCTURE NETWORKING  
 BLOCK-C POND 3 AND POND 4  
 SUBWATERSHED  
 MAP**

PREPARED BY	SS:est	DRAWN BY	PJF	SCALE	1"=1000'
APPROVED BY		DATE	7-16-07		

© Unearthed/VeriCOR/SD/PER/PRO/D/L/1/MP EXHIBIT 11-13D-BLOCK-C POND-1/Use-est/Structure Netw

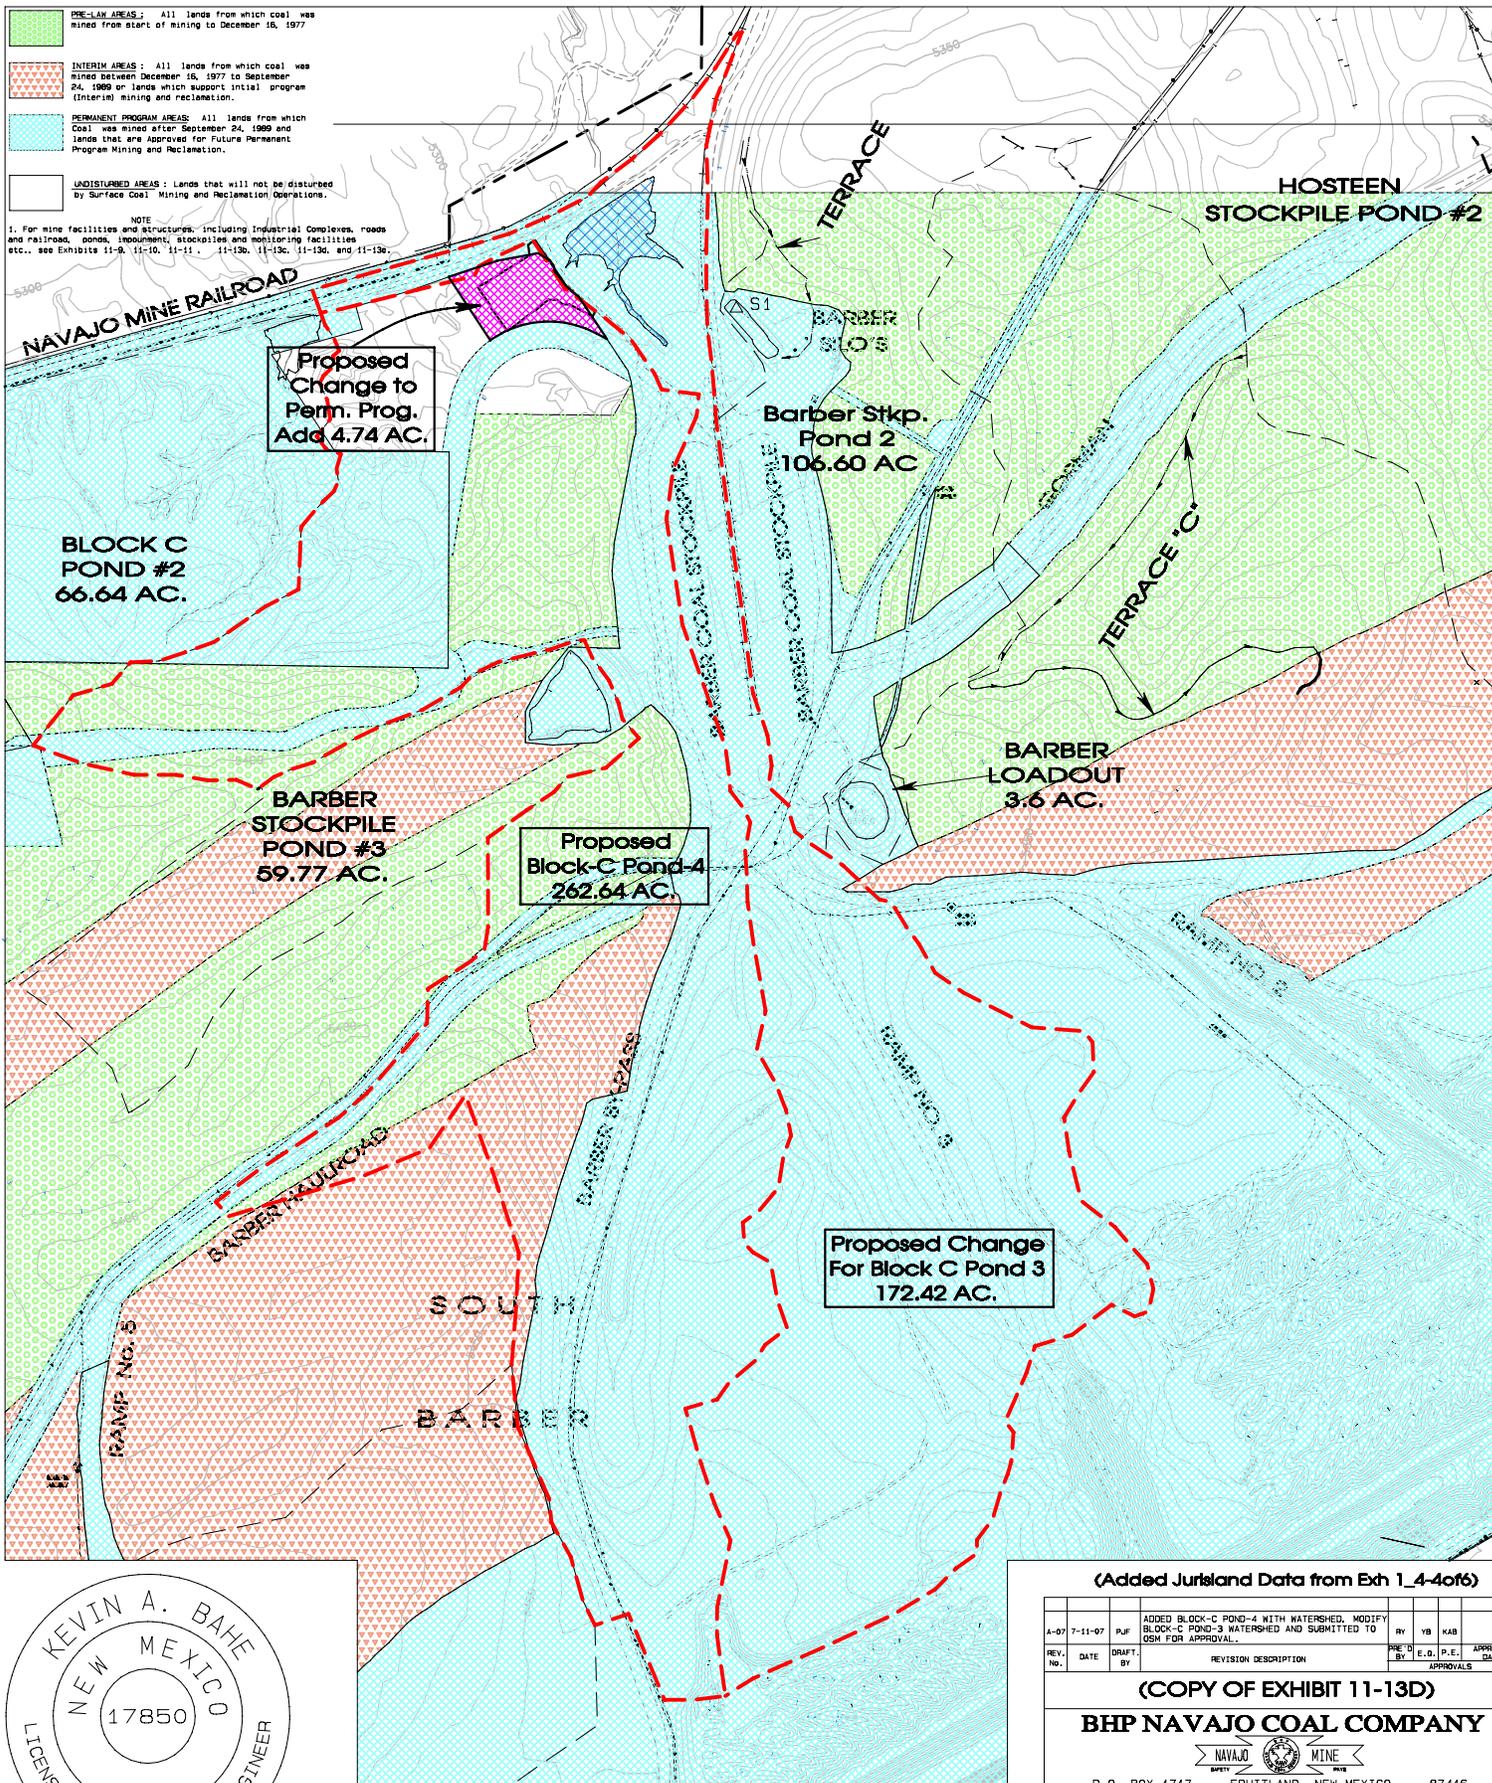

**CERTIFICATION STATEMENT**

I, Kevin A. Bahe, hereby certify that this drawing was reviewed by me and that the information shown is complete and accurate to the best of my knowledge.

(Added Jurisdiction Data from Exh 1\_4-4of6)

REV. No.	DATE	DRAFT BY	REVISION DESCRIPTION	REV. BY	YB	KAB	APPROVED DATE
A-07	7-11-07	PJF	ADDED BLOCK-C POND-4 WITH WATERSHED, MODIFY BLOCK-C POND-3 WATERSHED AND SUBMITTED TO USM FOR APPROVAL.				

(COPY OF EXHIBIT 11-13D)

**BHP NAVAJO COAL COMPANY**



P.O. BOX 1717 FRUITLAND, NEW MEXICO 87416

**AREA-II  
IMPONDMENT AND  
POND LOCATIONS/  
WATERSHED AREAS**

PREPARED BY	BS/PJF	DRAWN BY	PJF	SCALE	1" = 500'
APPROVED BY		DATE	Nov. 26, 1995		

MAP LOCATION: (See Lower Left Corner)

Pages 194-210 Blank due to text edits.

# **Mason Pond Modification** **10 yr - 6 hr Storm Event**

***The location and watershed area are presented on Exhibit 11-13D. The pond modification is presented on Exhibit 11-139. The culverts (CP-120 & 140) and the inlet structures to the pond are design for the 10 yr - 6 hr storm event.***

***The hydrology model is presented on the attach sheet.***

LR

BHP Navajo Coal Company  
P.O. Box 1717  
Fruitland, NM 87416

Phone: 505-598-4200


## ***General Information***

### ***Storm Information:***

Storm Type:	NM TYPE II 70
Design Storm:	10 yr - 6 hr
Rainfall Depth:	1.230 inches

### Structure Networking:

Type	Stru #	(flows into)	Stru #	Musk. K (hrs)	Musk. X	Description
Culvert	#1	==>	#2	0.178	0.289	CULVERT CP-120
Channel	#2	==>	#3	0.000	0.000	SO CHAN TO MASON PD
Channel	#3	==>	#7	0.000	0.000	SO INLET
Culvert	#4	==>	#5	0.007	0.399	CULVERT CP-140
Channel	#5	==>	#7	0.000	0.000	EAST INLET
Channel	#6	==>	#7	0.000	0.000	NORTH INLET NORTH INLET
Null	#7	==>	End	0.000	0.000	MASON POND

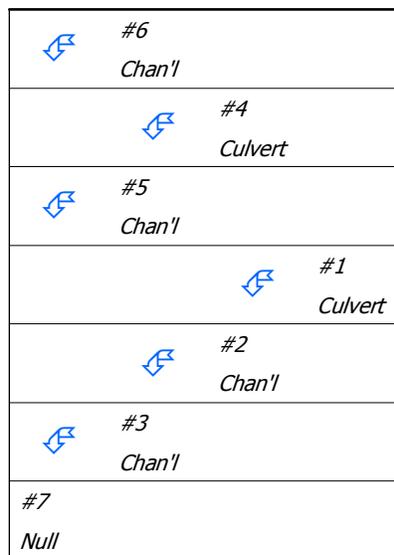

### Structure Routing Details:

Stru #	Land Flow Condition	Slope (%)	Vert. Dist. (ft)	Horiz. Dist. (ft)	Velocity (fps)	Time (hrs)
#1	8. Large gullies, diversions, and low flowing streams	0.60	9.00	1,492.00	2.32	0.178
<b>#1</b>	<b>Muskingum K:</b>					<b>0.178</b>
#4	8. Large gullies, diversions, and low flowing streams	5.03	9.20	183.00	6.72	0.007
<b>#4</b>	<b>Muskingum K:</b>					<b>0.007</b>

***Structure Summary:***

	Immediate Contributing Area (ac)	Total Contributing Area (ac)	Peak Discharge (cfs)	Total Runoff Volume (ac-ft)
#6	4.800	4.800	2.72	0.07
#4	19.300	19.300	14.35	0.40
#5	5.600	24.900	20.54	0.60
#1	95.200	95.200	35.03	1.83
#2	6.600	101.800	34.10	2.02
#3	0.000	101.800	34.10	2.02
#7	1.700	133.200	37.20	2.76

## ***Structure Detail:***

### ***Structure #6 (Riprap Channel)***

*NORTH INLET*

*NORTH INLET*

Trapezoidal Riprap Channel Inputs:

Material: Riprap

Bottom Width (ft)	Left Sideslope Ratio	Right Sideslope Ratio	Slope (%)	Freeboard Depth (ft)	Freeboard % of Depth	Freeboard Mult. x (VxD)
1.00	3.0:1	3.0:1	6.0	1.00		

Riprap Channel Results:

### Simons/OSM Method - Steep Slope Design

	w/o Freeboard	w/ Freeboard
Design Discharge:	2.72 cfs	
Depth:	0.28 ft	1.28 ft
Top Width:	2.67 ft	8.67 ft
Velocity*:		
X-Section Area:	0.51 sq ft	
Hydraulic Radius:	0.185 ft	
Froude Number*:		
Manning's n*:		
Dmin:	3.00 in	
D50:	9.00 in	
Dmax:	11.25 in	

Velocity and Manning's n calculations may not apply for this method.

### ***Structure #4 (Culvert)***

*CULVERT CP-140*

Culvert Inputs:

Length (ft)	Slope (%)	Manning's n	Max. Headwater (ft)	Tailwater (ft)	Entrance Loss Coef. (Ke)
100.00	1.50	0.0160	4.00	0.00	0.90

Culvert Results:

Design Discharge = 14.35 cfs

Minimum pipe diameter: 1 - 21 inch pipe(s) required

Structure #5 (Riprap Channel)

*EAST INLET*

Trapezoidal Riprap Channel Inputs:

Material: Riprap

Bottom Width (ft)	Left Sideslope Ratio	Right Sideslope Ratio	Slope (%)	Freeboard Depth (ft)	Freeboard % of Depth	Freeboard Mult. x (VxD)
4.00	3.0:1	3.0:1	21.3	1.00		

Riprap Channel Results:

**PADER Method - Steep Slope Design**

	w/o Freeboard	w/ Freeboard
Design Discharge:	20.54 cfs	
Depth:	0.56 ft	1.56 ft
Top Width:	7.33 ft	13.33 ft
Velocity:	6.53 fps	
X-Section Area:	3.15 sq ft	
Hydraulic Radius:	0.419 ft	
Froude Number:	1.76	
Manning's n:	0.0590	
Dmin:	3.00 in	
D50:	6.00 in	
Dmax:	9.00 in	

Structure #1 (Culvert)

*CULVERT CP-120*

Culvert Inputs:

Length (ft)	Slope (%)	Manning's n	Max. Headwater (ft)	Tailwater (ft)	Entrance Loss Coef. (Ke)
80.00	1.90	0.0160	5.00	0.00	0.90

Culvert Results:

Design Discharge = 35.03 cfs

Minimum pipe diameter: 1 - 30 inch pipe(s) required

Structure #2 (Erodible Channel)

*SO CHAN TO MASON PD*

Trapezoidal Erodible Channel Inputs:

Material: Spoils & Sandstone Cobbles

Bottom Width (ft)	Left Sideslope Ratio	Right Sideslope Ratio	Slope (%)	Manning's n	Freeboard Depth (ft)	Freeboard % of Depth	Freeboard Mult. x (VxD)	Limiting Velocity (fps)
8.00	3.0:1	3.0:1	0.6	0.0280	1.00			5.0

Erodible Channel Results:

	w/o Freeboard	w/ Freeboard
Design Discharge:	34.10 cfs	
Depth:	0.94 ft	1.94 ft
Top Width:	13.65 ft	19.65 ft
Velocity:	3.34 fps	
X-Section Area:	10.20 sq ft	
Hydraulic Radius:	0.731 ft	
Froude Number:	0.68	

Structure #3 (Riprap Channel)

*SO INLET*

Trapezoidal Riprap Channel Inputs:

Material: Riprap

Bottom Width (ft)	Left Sideslope Ratio	Right Sideslope Ratio	Slope (%)	Freeboard Depth (ft)	Freeboard % of Depth	Freeboard Mult. x (VxD)
7.50	3.0:1	3.0:1	8.0	1.00		

Riprap Channel Results:

Simons/OSM Method - Steep Slope Design

	w/o Freeboard	w/ Freeboard
Design Discharge:	34.10 cfs	
Depth:	0.41 ft	1.41 ft
Top Width:	9.94 ft	15.94 ft
Velocity*:		
X-Section Area:	3.55 sq ft	
Hydraulic Radius:	0.352 ft	
Froude Number*:		
Manning's n*:		
Dmin:	3.00 in	
D50:	9.00 in	
Dmax:	11.25 in	

Velocity and Manning's n calculations may not apply for this method.

---

*Structure #7 (Null)*

*MASON POND*

### ***Subwatershed Hydrology Detail:***

Stru #	SWS #	SWS Area (ac)	Time of Conc (hrs)	Musk K (hrs)	Musk X	Curve Number	UHS	Peak Discharge (cfs)	Runoff Volume (ac-ft)
#6	1	4.800	0.050	0.000	0.000	80.500	M	2.72	0.070
	<b>Σ</b>	<b>4.800</b>						<b>2.72</b>	<b>0.070</b>
#4	1	19.300	0.103	0.000	0.000	83.600	M	14.35	0.402
	<b>Σ</b>	<b>19.300</b>						<b>14.35</b>	<b>0.402</b>
#5	1	5.600	0.075	0.000	0.000	89.000	M	6.19	0.203
	<b>Σ</b>	<b>24.900</b>						<b>20.54</b>	<b>0.605</b>
#1	1	95.200	0.272	0.000	0.000	84.900	M	35.03	1.831
	<b>Σ</b>	<b>95.200</b>						<b>35.03</b>	<b>1.831</b>
#2	1	6.600	0.270	0.000	0.000	89.000	M	3.61	0.192
	<b>Σ</b>	<b>101.800</b>						<b>34.10</b>	<b>2.022</b>
<b>#3</b>	<b>Σ</b>	<b>101.800</b>						<b>34.10</b>	<b>2.022</b>
#7	1	1.700	0.020	0.000	0.000	89.000	M	1.88	0.062
	<b>Σ</b>	<b>133.200</b>						<b>37.20</b>	<b>2.759</b>

### ***Subwatershed Time of Concentration Details:***

Stru #	SWS #	Land Flow Condition	Slope (%)	Vert. Dist. (ft)	Horiz. Dist. (ft)	Velocity (fps)	Time (hrs)
#1	1	5. Nearly bare and untilled, and alluvial valley fans	6.06	14.00	231.00	2.460	0.026
		8. Large gullies, diversions, and low flowing streams	1.46	47.00	3,216.00	3.620	0.246
<b>#1</b>	<b>1</b>	<b>Time of Concentration:</b>					<b>0.272</b>
#2	1	8. Large gullies, diversions, and low flowing streams	0.88	24.00	2,732.00	2.810	0.270
<b>#2</b>	<b>1</b>	<b>Time of Concentration:</b>					<b>0.270</b>
#4	1	5. Nearly bare and untilled, and alluvial valley fans	9.42	42.00	446.00	3.060	0.040
		8. Large gullies, diversions, and low flowing streams	1.69	15.00	888.00	3.890	0.063
<b>#4</b>	<b>1</b>	<b>Time of Concentration:</b>					<b>0.103</b>
#5	1	5. Nearly bare and untilled, and alluvial valley fans	10.58	11.00	104.00	3.250	0.008
		8. Large gullies, diversions, and low flowing streams	2.39	27.00	1,132.00	4.630	0.067
<b>#5</b>	<b>1</b>	<b>Time of Concentration:</b>					<b>0.075</b>
#6	1	5. Nearly bare and untilled, and alluvial valley fans	7.41	14.00	189.00	2.720	0.019

Stru #	SWS #	Land Flow Condition	Slope (%)	Vert. Dist. (ft)	Horiz. Dist. (ft)	Velocity (fps)	Time (hrs)
		8. Large gullies, diversions, and low flowing streams	5.48	43.00	785.00	7.020	0.031
<b>#6</b>	<b>1</b>	<b>Time of Concentration:</b>					<b>0.050</b>

# **Mason Pond Modification** **100 yr - 6 hr Storm Event**

***The location and watershed area are presented on Exhibit 11-13D. The pond modification is presented on Exhibit 11-139. The culverts (CP-120 & 140) and the inlet structures to the pond are design for the 10 yr - 6 hr storm event.***

***The hydrology model is presented on the attach sheet.***

LR

BHP Navajo Coal Company  
P.O. Box 1717  
Fruitland, NM 87416

Phone: 505-598-4200

## ***General Information***

### ***Storm Information:***

Storm Type:	NM TYPE II 70
Design Storm:	100 yr - 6 hr
Rainfall Depth:	1.960 inches

### Structure Networking:

Type	Stru #	(flows into)	Stru #	Musk. K (hrs)	Musk. X	Description
Culvert	#1	==>	#2	0.178	0.289	CULVERT CP-120
Channel	#2	==>	#3	0.000	0.000	SO CHAN TO MASON PD
Channel	#3	==>	#7	0.000	0.000	SO INLET
Culvert	#4	==>	#5	0.007	0.399	CULVERT CP-140
Channel	#5	==>	#7	0.000	0.000	EAST INLET
Channel	#6	==>	#7	0.000	0.000	NORTH INLET NORTH INLET
Null	#7	==>	End	0.000	0.000	MASON POND



### Structure Routing Details:

Stru #	Land Flow Condition	Slope (%)	Vert. Dist. (ft)	Horiz. Dist. (ft)	Velocity (fps)	Time (hrs)
#1	8. Large gullies, diversions, and low flowing streams	0.60	9.00	1,492.00	2.32	0.178
<b>#1</b>	<b>Muskingum K:</b>					<b>0.178</b>
#4	8. Large gullies, diversions, and low flowing streams	5.03	9.20	183.00	6.72	0.007
<b>#4</b>	<b>Muskingum K:</b>					<b>0.007</b>

***Structure Summary:***

	Immediate Contributing Area (ac)	Total Contributing Area (ac)	Peak Discharge (cfs)	Total Runoff Volume (ac-ft)
#6	4.800	4.800	7.26	0.22
#4	19.300	19.300	34.06	1.12
#5	5.600	24.900	46.50	1.58
#1	95.200	95.200	90.66	4.83
#2	6.600	101.800	89.57	5.27
#3	0.000	101.800	89.57	5.27
#7	1.700	133.200	96.40	7.22

## ***Structure Detail:***

### ***Structure #6 (Riprap Channel)***

*NORTH INLET*

*NORTH INLET*

Trapezoidal Riprap Channel Inputs:

Material: Riprap

Bottom Width (ft)	Left Sideslope Ratio	Right Sideslope Ratio	Slope (%)	Freeboard Depth (ft)	Freeboard % of Depth	Freeboard Mult. x (VxD)
1.00	3.0:1	3.0:1	6.0	1.00		

Riprap Channel Results:

### Simons/OSM Method - Steep Slope Design

	w/o Freeboard	w/ Freeboard
Design Discharge:	7.26 cfs	
Depth:	0.35 ft	1.35 ft
Top Width:	3.11 ft	9.11 ft
Velocity*:		
X-Section Area:	0.72 sq ft	
Hydraulic Radius:	0.224 ft	
Froude Number*:		
Manning's n*:		
Dmin:	4.00 in	
D50:	12.00 in	
Dmax:	15.00 in	

Velocity and Manning's n calculations may not apply for this method.

### ***Structure #4 (Culvert)***

*CULVERT CP-140*

Culvert Inputs:

Length (ft)	Slope (%)	Manning's n	Max. Headwater (ft)	Tailwater (ft)	Entrance Loss Coef. (Ke)
100.00	1.50	0.0160	4.00	0.00	0.90

Culvert Results:

Design Discharge = 34.06 cfs

Minimum pipe diameter: 1 - 30 inch pipe(s) required

Structure #5 (Riprap Channel)

*EAST INLET*

Trapezoidal Riprap Channel Inputs:

Material: Riprap

Bottom Width (ft)	Left Sideslope Ratio	Right Sideslope Ratio	Slope (%)	Freeboard Depth (ft)	Freeboard % of Depth	Freeboard Mult. x (VxD)
4.00	3.0:1	3.0:1	21.3	1.00		

Riprap Channel Results:

**PADER Method - Steep Slope Design**

	w/o Freeboard	w/ Freeboard
Design Discharge:	46.50 cfs	
Depth:	0.81 ft	1.81 ft
Top Width:	8.86 ft	14.86 ft
Velocity:	8.93 fps	
X-Section Area:	5.21 sq ft	
Hydraulic Radius:	0.571 ft	
Froude Number:	2.05	
Manning's n:	0.0530	
Dmin:	3.00 in	
D50:	6.00 in	
Dmax:	9.00 in	

Structure #1 (Culvert)

*CULVERT CP-120*

Culvert Inputs:

Length (ft)	Slope (%)	Manning's n	Max. Headwater (ft)	Tailwater (ft)	Entrance Loss Coef. (Ke)
80.00	1.90	0.0160	5.00	0.00	0.90

Culvert Results:

Design Discharge = 90.66 cfs

Minimum pipe diameter: 1 - 48 inch pipe(s) required

Structure #2 (Erodible Channel)

*SO CHAN TO MASON PD*

Trapezoidal Erodible Channel Inputs:

Material: Spoils & Sandstone Cobbles

Bottom Width (ft)	Left Sideslope Ratio	Right Sideslope Ratio	Slope (%)	Manning's n	Freeboard Depth (ft)	Freeboard % of Depth	Freeboard Mult. x (VxD)	Limiting Velocity (fps)
8.00	3.0:1	3.0:1	0.6	0.0280	1.00			5.0

Erodible Channel Results:

	w/o Freeboard	w/ Freeboard
Design Discharge:	89.57 cfs	
Depth:	1.58 ft	2.58 ft
Top Width:	17.49 ft	23.49 ft
Velocity:	4.44 fps	
X-Section Area:	20.15 sq ft	
Hydraulic Radius:	1.120 ft	
Froude Number:	0.73	

Structure #3 (Riprap Channel)

*SO INLET*

Trapezoidal Riprap Channel Inputs:

Material: Riprap

Bottom Width (ft)	Left Sideslope Ratio	Right Sideslope Ratio	Slope (%)	Freeboard Depth (ft)	Freeboard % of Depth	Freeboard Mult. x (VxD)
7.50	3.0:1	3.0:1	8.0	1.00		

Riprap Channel Results:

Simons/OSM Method - Steep Slope Design

	w/o Freeboard	w/ Freeboard
Design Discharge:	89.57 cfs	
Depth:	0.79 ft	1.79 ft
Top Width:	12.25 ft	18.25 ft
Velocity*:		
X-Section Area:	7.81 sq ft	
Hydraulic Radius:	0.625 ft	
Froude Number*:		
Manning's n*:		
Dmin:	4.00 in	
D50:	12.00 in	
Dmax:	15.00 in	

Velocity and Manning's n calculations may not apply for this method.

---

*Structure #7 (Null)*

*MASON POND*


### ***Subwatershed Hydrology Detail:***

Stru #	SWS #	SWS Area (ac)	Time of Conc (hrs)	Musk K (hrs)	Musk X	Curve Number	UHS	Peak Discharge (cfs)	Runoff Volume (ac-ft)
#6	1	4.800	0.050	0.000	0.000	80.500	M	7.26	0.223
	<b>Σ</b>	<b>4.800</b>						<b>7.26</b>	<b>0.223</b>
#4	1	19.300	0.103	0.000	0.000	83.600	M	34.06	1.118
	<b>Σ</b>	<b>19.300</b>						<b>34.06</b>	<b>1.118</b>
#5	1	5.600	0.075	0.000	0.000	89.000	M	12.45	0.464
	<b>Σ</b>	<b>24.900</b>						<b>46.50</b>	<b>1.581</b>
#1	1	95.200	0.272	0.000	0.000	84.900	M	90.66	4.834
	<b>Σ</b>	<b>95.200</b>						<b>90.66</b>	<b>4.834</b>
#2	1	6.600	0.270	0.000	0.000	89.000	M	8.13	0.438
	<b>Σ</b>	<b>101.800</b>						<b>89.57</b>	<b>5.272</b>
<b>#3</b>	<b>Σ</b>	<b>101.800</b>						<b>89.57</b>	<b>5.272</b>
#7	1	1.700	0.020	0.000	0.000	89.000	M	3.78	0.141
	<b>Σ</b>	<b>133.200</b>						<b>96.40</b>	<b>7.217</b>

### ***Subwatershed Time of Concentration Details:***

Stru #	SWS #	Land Flow Condition	Slope (%)	Vert. Dist. (ft)	Horiz. Dist. (ft)	Velocity (fps)	Time (hrs)
#1	1	5. Nearly bare and untilled, and alluvial valley fans	6.06	14.00	231.00	2.460	0.026
		8. Large gullies, diversions, and low flowing streams	1.46	47.00	3,216.00	3.620	0.246
<b>#1</b>	<b>1</b>	<b>Time of Concentration:</b>					<b>0.272</b>
#2	1	8. Large gullies, diversions, and low flowing streams	0.88	24.00	2,732.00	2.810	0.270
<b>#2</b>	<b>1</b>	<b>Time of Concentration:</b>					<b>0.270</b>
#4	1	5. Nearly bare and untilled, and alluvial valley fans	9.42	42.00	446.00	3.060	0.040
		8. Large gullies, diversions, and low flowing streams	1.69	15.00	888.00	3.890	0.063
<b>#4</b>	<b>1</b>	<b>Time of Concentration:</b>					<b>0.103</b>
#5	1	5. Nearly bare and untilled, and alluvial valley fans	10.58	11.00	104.00	3.250	0.008
		8. Large gullies, diversions, and low flowing streams	2.39	27.00	1,132.00	4.630	0.067
<b>#5</b>	<b>1</b>	<b>Time of Concentration:</b>					<b>0.075</b>
#6	1	5. Nearly bare and untilled, and alluvial valley fans	7.41	14.00	189.00	2.720	0.019

Stru #	SWS #	Land Flow Condition	Slope (%)	Vert. Dist. (ft)	Horiz. Dist. (ft)	Velocity (fps)	Time (hrs)
		8. Large gullies, diversions, and low flowing streams	5.48	43.00	785.00	7.020	0.031
<b>#6</b>	<b>1</b>	<b>Time of Concentration:</b>					<b>0.050</b>

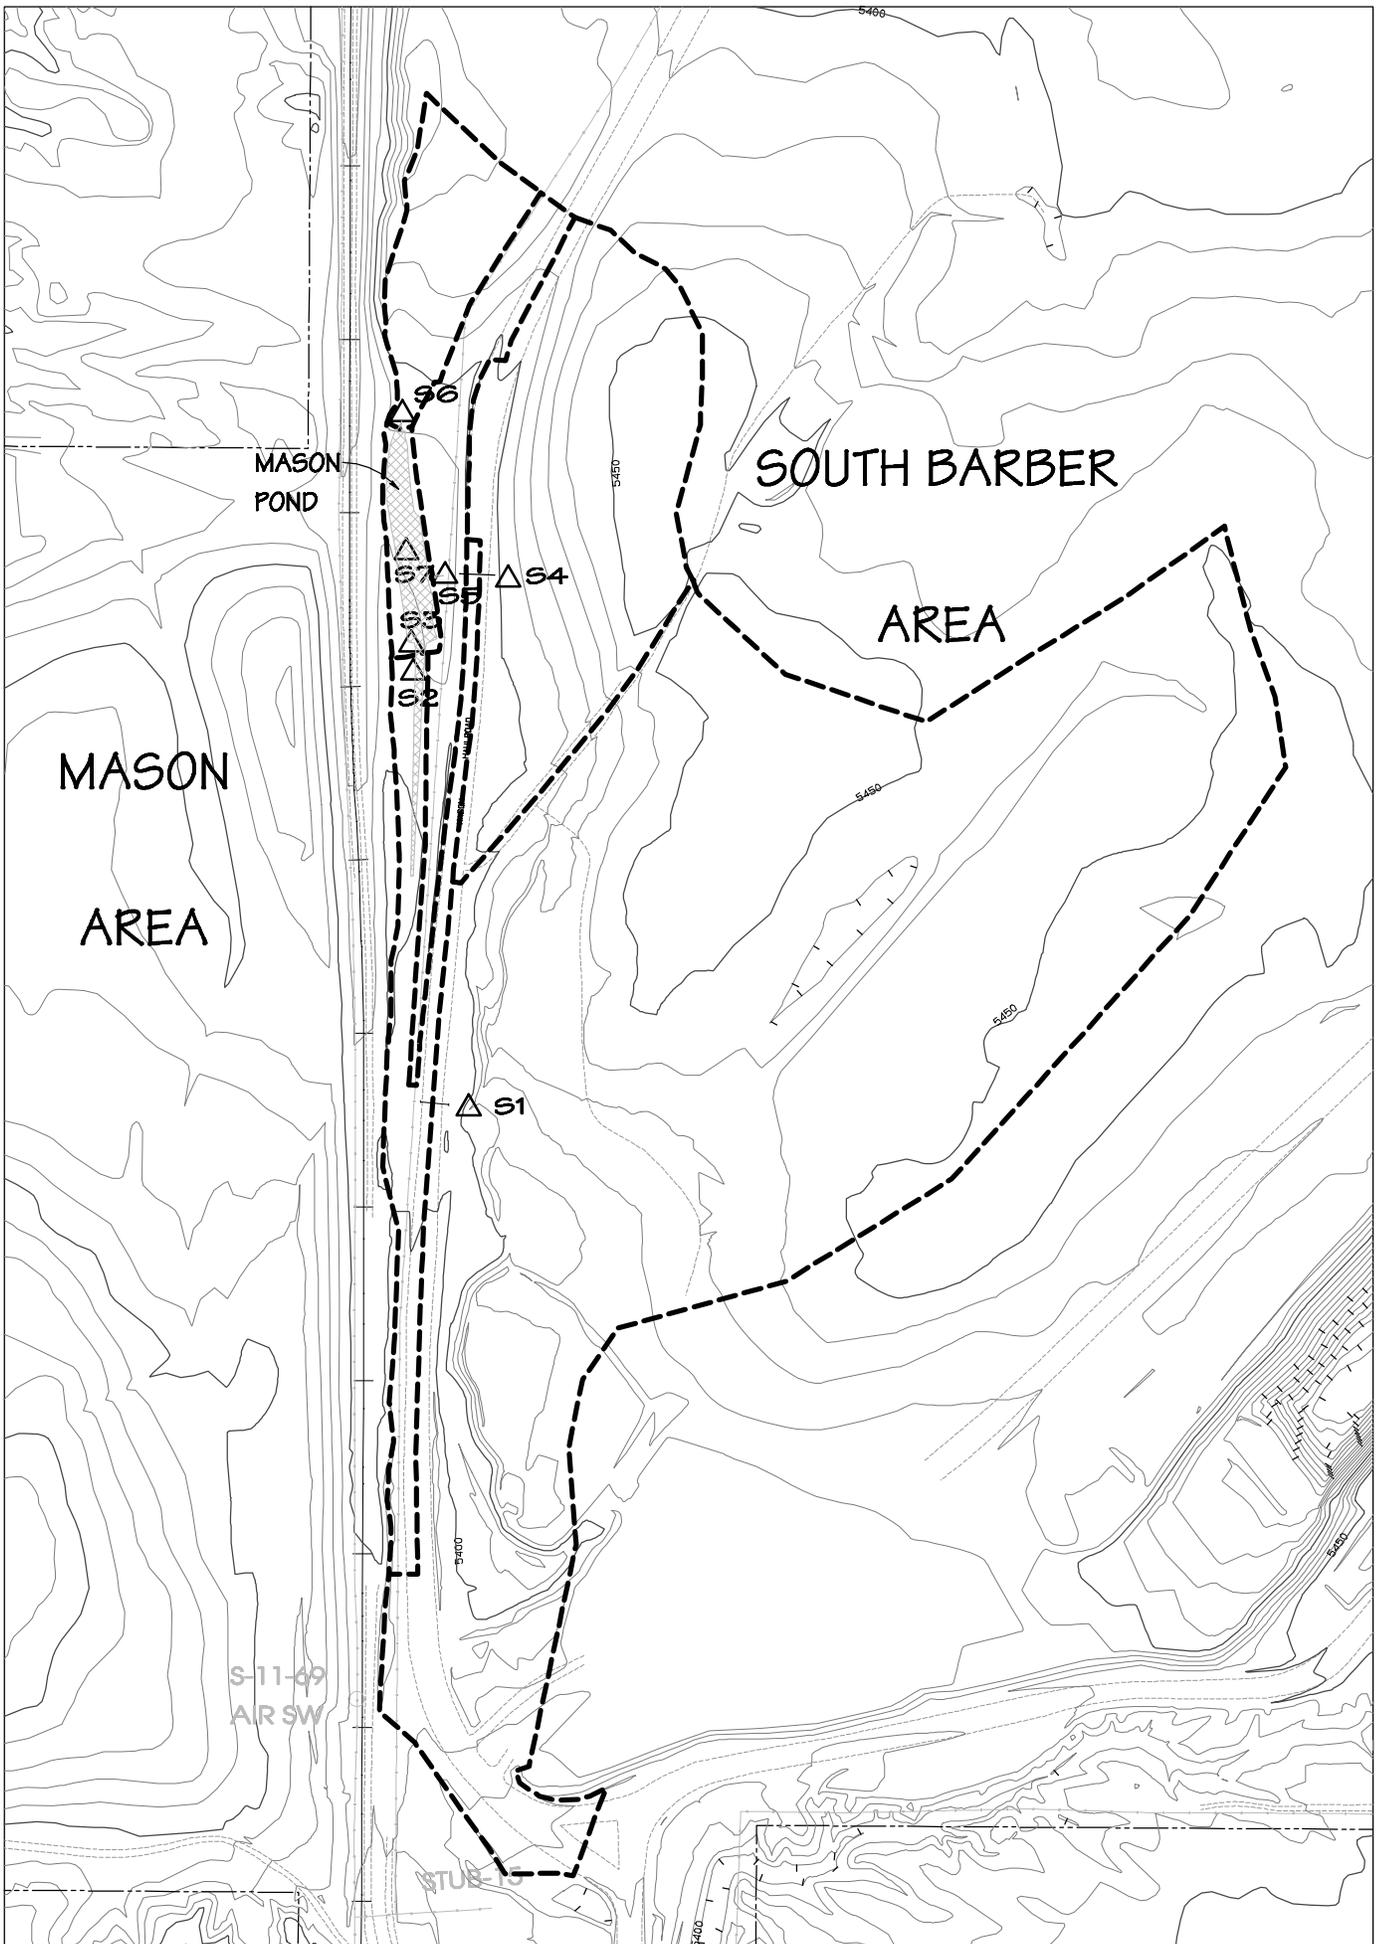

MASON POND  
HYDROLOGY MODEL 2160

# **CR Pond 4**

## ***Worst Case Runoff Volume - AOC Topo***

Ron Van Valkenburg, PE

BHP Billiton  
Navajo Mine  
PO Box 1717  
Fruitland, NM 87416

Phone: 505 598 2007

---

## ***General Information***

### ***Storm Information:***

Storm Type:	NRCS TYPE II-70
Design Storm:	100 yr - 6 hr
Rainfall Depth:	2.000 inches

## *Structure Networking:*

Type	Stru #	(flows into)	Stru #	Musk. K (hrs)	Musk. X	Description
Channel	#1	==>	End	0.000	0.000	Embk. to CR Pond 4

#1  
*Channel*

## *Structure Summary:*

	Immediate Contributing Area (ac)	Total Contributing Area (ac)	Peak Discharge (cfs)	Total Runoff Volume (ac-ft)
#1	142.100	142.100	81.91	10.05

### Structure Detail:

Structure #1 (Erodible Channel)

Embk. to CR Pond 4

Trapezoidal Erodible Channel Inputs:

Material: Alluvial silts colloidal

Bottom Width (ft)	Left Sideslope Ratio	Right Sideslope Ratio	Slope (%)	Manning's n	Freeboard Depth (ft)	Freeboard % of Depth	Freeboard Mult. x (VxD)	Limiting Velocity (fps)
7.00	2.0:1	2.0:1	1.3	0.0300	1.00			5.0

Erodible Channel Results:

	w/o Freeboard	w/ Freeboard
Depth:	1.42 ft	2.42 ft
Top Width:	12.69 ft	16.69 ft
Velocity:	5.84 fps	
X-Section Area:	14.01 sq ft	
Hydraulic Radius:	1.049	
Froude Number:	0.98	

***Subwatershed Hydrology Detail:***

Stru #	SWS #	SWS Area (ac)	Time of Conc (hrs)	Musk K (hrs)	Musk X	Curve Number	UHS	Peak Discharge (cfs)	Runoff Volume (ac-ft)
#1	1	142.100	0.804	0.000	0.000	86.000	M	81.91	10.05
<b>S</b>								<b>81.91</b>	<b>10.05</b>

***Subwatershed Time of Concentration Details:***

Stru #	SWS #	Land Flow Condition	Slope (%)	Vert. Dist. (ft)	Horiz. Dist. (ft)	Velocity (fps)	Time (hrs)
#1	1	5. Nearly bare and untilled, and alluvial valley fans	2.74	131.00	4,778.00	1.650	0.804
<b>#1</b>	<b>1</b>	<b>Time of Concentration:</b>					<b>0.804</b>

## **CR Pond 4**

***As-built for CR Pond 4. Modified the east channel during the construction of Cottonwood Crossing and Staging Area.***

Shawn Smith

BHP Billiton  
Navajo Mine  
PO Box 1717  
Fruitland, NM 87416

Phone: 505 598 2007

---

## ***General Information***

### ***Storm Information:***

Storm Type:	NRCS TYPE II-70
Design Storm:	100 yr - 6 hr
Rainfall Depth:	2.000 inches

**Structure Networking:**

Type	Stru #	(flows into)	Stru #	Musk. K (hrs)	Musk. X	Description
Null	#1	==>	End	0.000	0.000	CR Pond 4

#1 Null
------------

## *Structure Summary:*

	Immediate Contributing Area (ac)	Total Contributing Area (ac)	Peak Discharge (cfs)	Total Runoff Volume (ac-ft)
#1	45.800	45.800	40.10	2.38

***Structure Detail:***

*Structure #1 (Null)*


*CR Pond 4*

***Subwatershed Hydrology Detail:***

Stru #	SWS #	SWS Area (ac)	Time of Conc (hrs)	Musk K (hrs)	Musk X	Curve Number	UHS	Peak Discharge (cfs)	Runoff Volume (ac-ft)
#1	1	28.200	0.141	0.000	0.000	78.000	M	21.30	1.14
	2	17.600	0.265	0.000	0.000	86.000	M	18.80	1.25
<b>S</b>		<b>45.800</b>						<b>40.10</b>	<b>2.38</b>


***Subwatershed Time of Concentration Details:***

Stru #	SWS #	Land Flow Condition	Slope (%)	Vert. Dist. (ft)	Horiz. Dist. (ft)	Velocity (fps)	Time (hrs)
#1	1	5. Nearly bare and untilled, and alluvial valley fans	7.69	25.00	325.00	2.770	0.032
		8. Large gullies, diversions, and low flowing streams	1.64	25.00	1,520.00	3.840	0.109
<b>#1</b>	<b>1</b>	<b>Time of Concentration:</b>					<b>0.141</b>
#1	2	8. Large gullies, diversions, and low flowing streams	0.50	10.00	2,020.20	2.110	0.265
<b>#1</b>	<b>2</b>	<b>Time of Concentration:</b>					<b>0.265</b>

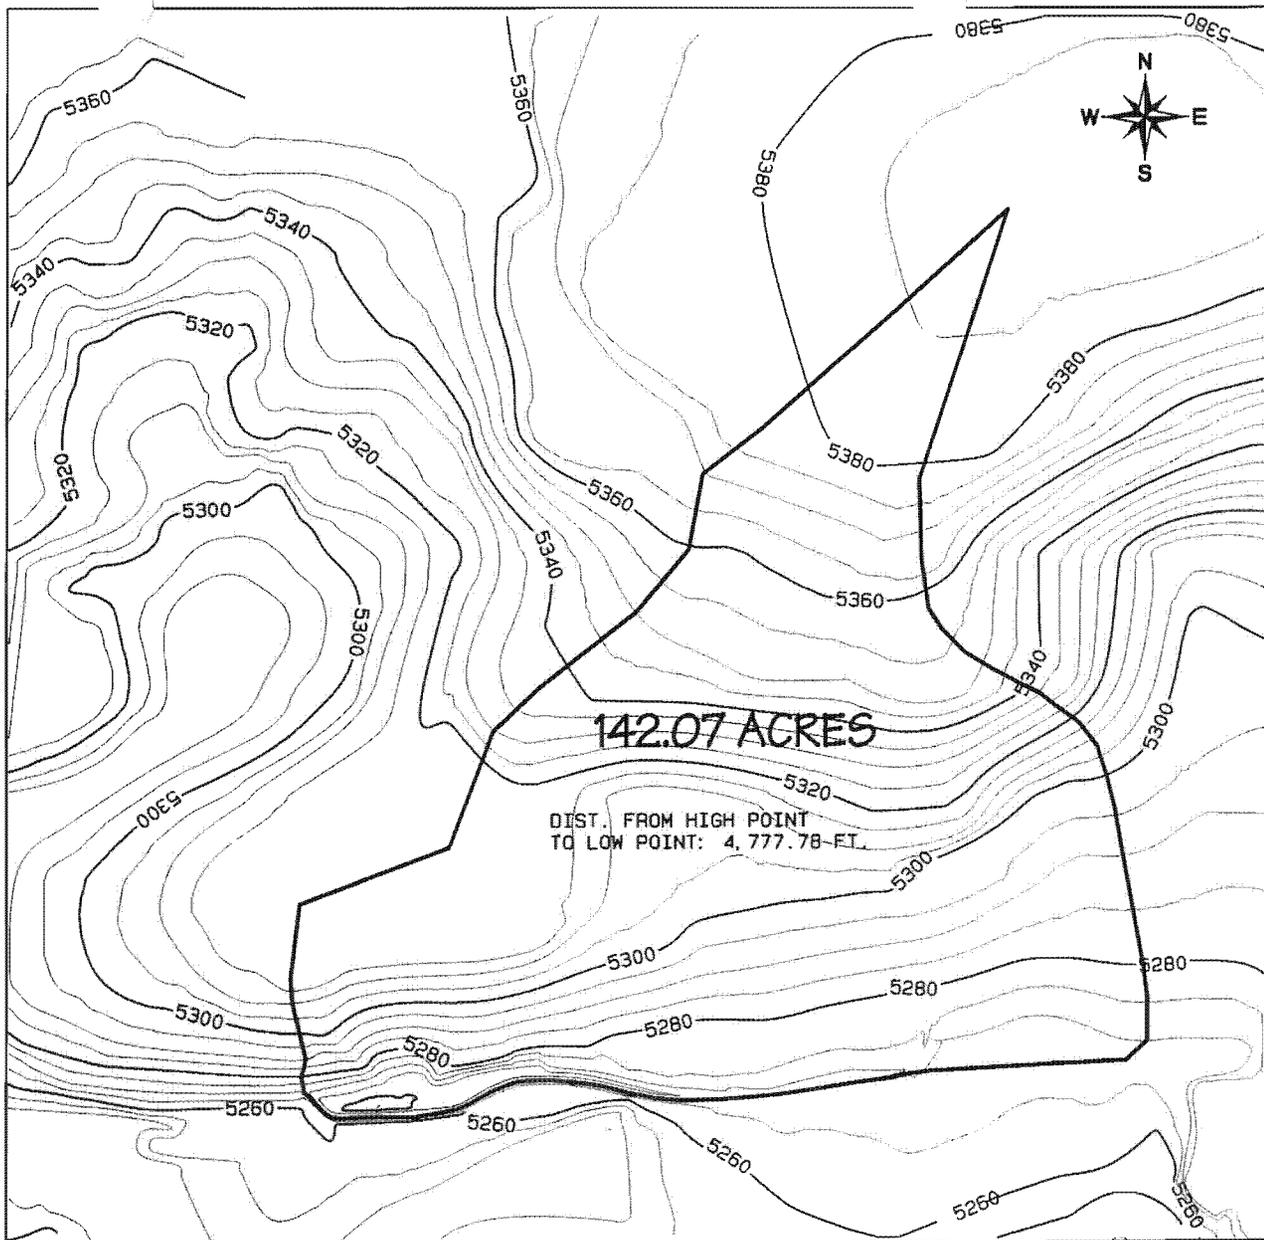

LEGEND

- PAVED ROAD
- BUILDING
- FENCE
- IRRIGATION LINE
- CULVERT
- RAILROAD
- TREES
- POWERLINE
- SPOT ELEVATION
- INDEX CONTOUR
- INTERMEDIATE CONTOUR
- WATERSHED

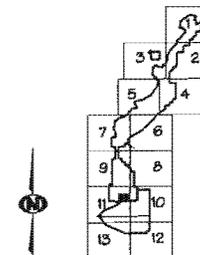

B	8-07-00	PJF	Revised Interim Study for CR Pond 4	LR	MC	LR		
A	10-20-98	RY	Generated Watershed for CR4 Pond based on AOC surface.					
REV. NO.	DATE	DRAWN BY	DESCRIPTION	ENG.	C.D.	P.E.	IN S.	EXPER. ENG.
		RY	WATERSHED DESCRIPTION					

NAVAJO COAL COMPANY



P.O. BOX 155 FRUITLAND, NEW MEXICO 87418

AREA 3  
SOUTH DIXON  
COLLYER ROAD POND 4

PREPARED BY RY	DRAWN BY RY	SCALE 1" = 800'
APPROVED BY LR	DATE 10-20-98	REF DWG
DWG LOC D:\LOWE-DIXON\AREA3-TOPO-PTS.pro		

## **South Dixon Pond 4**

***The watershed is shown on Exhibit 11-13E and the pond design is presented on Exhibit 11-118.***

LR

BHP Navajo Coal Company  
Navajo Mine  
PO Box 1717  
Fruitland, NM 87415

Phone: 505-598-5861

## ***General Information***

### ***Storm Information:***

Storm Type:	NRCS Type II-60
Design Storm:	100 yr - 6 hr
Rainfall Depth:	2.000 inches

# SEDCAD 4 for Windows

Copyright 1998 Pamela J. Schwab  
Civil Software Design

## ***Structure Networking:***

Type	Stru #	(flows into)	Stru #	Musk. K (hrs)	Musk. X	Description
Null	#1	==>	End	0.000	0.000	

#1 <i>Null</i>
-------------------

# SEDCAD 4 for Windows

Copyright 1998 Pamela J. Schwab  
Civil Software Design

## *Structure Summary:*

	Immediate Contributing Area (ac)	Total Contributing Area (ac)	Peak Discharge (cfs)	Total Runoff Volume (ac-ft)
#1	44.900	44.900	52.81	4.35

# SEDCAD 4 for Windows

Copyright 1998 Pamela J. Schwab  
Civil Software Design

## *Subwatershed Hydrology Detail:*

Stru #	SWS #	SWS Area (ac)	Time of Conc (hrs)	Musk K (hrs)	Musk X	Curve Number	UHS	Peak Discharge (cfs)	Runoff Volume (ac-ft)
#1	1	44.900	0.315	0.000	0.000	91.000	M	52.81	4.35
<b>S</b>		<b>44.900</b>						<b>52.81</b>	<b>4.35</b>

## *Subwatershed Time of Concentration Details:*

Stru #	SWS #	Land Flow Condition	Slope (%)	Vert. Dist. (ft)	Horiz. Dist. (ft)	Velocity (fps)	Time (hrs)
#1	1	5. Nearly bare and untilled, and alluvial valley fans	4.23	98.50	2,330.03	2.050	0.315
<b>#1</b>	<b>1</b>	<b>Time of Concentration:</b>					<b>0.315</b>

PAGES 234 THROUGH 259 BLANK  
DUE TO SOUTH DIXON PONDS 5 AND 6 REMOVAL

# **North Fork Highwall Impoundment** **As-built**

LR

BHP Navajo Coal Company  
Navajo Mine  
PO Box 1717  
Fruitland, NM 87415

Phone: 505-598-5861

***General Information***

***Storm Information:***


Storm Type:	NRCS Type II-60
Design Storm:	25 yr - 6 hr
Rainfall Depth:	1.600 inches

# SEDCAD 4 for Windows

Copyright 1998 Pamela J. Schwab  
Civil Software Design

## ***Structure Networking:***

Type	Stru #	(flows into)	Stru #	Musk. K (hrs)	Musk. X	Description
Pond	#1	==>	#2	0.000	0.000	NF Highwll Imp.
Channel	#2	==>	End	0.000	0.000	Riprapped out flow chan

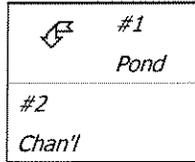

***Structure Summary:***

		Immediate Contributing Area (ac)	Total Contributing Area (ac)	Peak Discharge (cfs)	Total Runoff Volume (ac-ft)
#1	In	73.400	73.400	59.19	5.03
	Out			17.13	5.03
#2		0.000	73.400	17.13	5.03

***Structure Detail:***

Structure #1 (Pond)

*NF Highwall Imp.*

Pond Inputs:

Initial Pool Elev:	5,288.10
Initial Pool:	7.82 ac-ft

Emergency Spillway

Spillway Elev	Crest Length (ft)	Left Sideslope	Right Sideslope	Bottom Width (ft)
5,288.10	32.00	3.00:1	3.00:1	14.50

Pond Results:

Peak Elevation:	5,288.67
Dewater Time:	0.53 days

*Dewatering time is calculated from peak stage to lowest spillway*

Elevation-Capacity-Discharge Table

Elevation	Area (ac)	Capacity (ac-ft)	Discharge (cfs)	Dewater Time (hrs)
5,280.00	0.000	0.000	0.000	
5,281.00	0.010	0.004	0.000	
5,282.00	0.050	0.031	0.000	
5,283.00	0.140	0.122	0.000	
5,284.00	0.340	0.355	0.000	
5,285.00	0.730	0.878	0.000	
5,286.00	1.680	2.050	0.000	
5,287.00	3.000	4.359	0.000	
5,288.00	3.260	7.488	0.000	
5,288.10	3.310	7.817	0.000	Spillway #1
5,288.67	3.594	9.824	17.127	12.60 Peak Stage
5,289.00	3.760	10.996	27.118	
5,289.70	4.800	13.985	83.947	

Detailed Discharge Table

# SEDCAD 4 for Windows

Copyright 1998 Pamela J. Schwab  
Civil Software Design

Elevation	Emergency Spillway (cfs)	Combined Total Discharge (cfs)
5,280.00	0.000	0.000
5,281.00	0.000	0.000
5,282.00	0.000	0.000
5,283.00	0.000	0.000
5,284.00	0.000	0.000
5,285.00	0.000	0.000
5,286.00	0.000	0.000
5,287.00	0.000	0.000
5,288.00	0.000	0.000
5,288.10	0.000	0.000
5,289.00	27.118	27.118
5,289.70	83.947	83.947

## Structure #2 (Riprap Channel)

*Riprapped out flow chan*

Trapezoidal Riprap Channel Inputs:

### Material: Riprap

Bottom Width (ft)}	Left Sideslope Ratio	Right Sideslope Ratio	Slope (%)	Freeboard Depth (ft)	Freeboard % of Depth	Freeboard Mult. x (VxD)
13.00	2.5:1	2.5:1	5.7	1.00		

Riprap Channel Results:

### Simons/OSM Method - Steep Slope Design

	w/o Freeboard	w/ Freeboard
Design Discharge:	17.13 cfs	
Depth:	0.21 ft	1.21 ft
Top Width:	14.04 ft	19.04 ft
Velocity*:		
X-Section Area:	2.82 sq ft	
Hydraulic Radius:	0.199	
Froude Number*:		
Manning's n*:		
Dmin:	1.00 in	
D50:	3.00 in	
Dmax:	3.75 in	

Velocity and Manning's n calculations may not apply for this method.

# SEDCAD 4 for Windows

Copyright 1998 Pamela J. Schwab  
Civil Software Design

## *Subwatershed Hydrology Detail:*

Stru #	SWS #	SWS Area (ac)	Time of Conc (hrs)	Musk K (hrs)	Musk X	Curve Number	UHS	Peak Discharge (cfs)	Runoff Volume (ac-ft)
#1	1	73.400	0.346	0.000	0.000	91.000	M	59.19	5.029
	$\Sigma$	<b>73.400</b>						<b>59.19</b>	<b>5.029</b>
#2	$\Sigma$	<b>73.400</b>						<b>17.13</b>	<b>5.029</b>

## *Subwatershed Time of Concentration Details:*

Stru #	SWS #	Land Flow Condition	Slope (%)	Vert. Dist. (ft)	Horiz. Dist. (ft)	Velocity (fps)	Time (hrs)
#1	1	5. Nearly bare and untilled, and alluvial valley fans	6.75	27.00	400.00	2.590	0.042
		8. Large gullies, diversions, and low flowing streams	5.50	55.00	1,000.00	7.030	0.039
		5. Nearly bare and untilled, and alluvial valley fans	2.50	30.00	1,200.00	1.580	0.210
		8. Large gullies, diversions, and low flowing streams	1.00	6.00	600.00	3.000	0.055
#1	1	<b>Time of Concentration:</b>					<b>0.346</b>

## **Area 4 North Pond 1**

***The watershed for the impoundment is presented on Exhibit 11-13F. The detail design is presented on Exhibit 11-110.***

***The pond is design to retain the runoff from the 100 year-6 hour storm event, therefore no spillway required.***

***The inlet structure to the pond is design to be stable for the 25 year- 6 hour storm event and the capacity design is for the 100 year-6 hour storm.***

LR

BHP Navajo Coal Company  
PO Box 1717  
Fruitland, NM 87416

Phone: 505-598-5861

***General Information***

***Storm Information:***

Storm Type:	NRCS Type II - 60
Design Storm:	25 yr - 6 hr
Rainfall Depth:	1.600 inches

# SEDCAD 4 for Windows

Copyright 1998 Pamela J. Schwab  
Civil Software Design

## *Structure Networking:*

Type	Stru #	(flows into)	Stru #	Musk. K (hrs)	Musk. X	Description
Channel	#1	==>	End	0.000	0.000	Area 4 North Pd 1 & ripraped inlet str.

#1  
Chan'l

# SEDCAD 4 for Windows

Copyright 1998 Pamela J. Schwab  
Civil Software Design

---

## *Structure Summary:*

	Immediate Contributing Area (ac)	Total Contributing Area (ac)	Peak Discharge (cfs)	Total Runoff Volume (ac-ft)
#1	40.400	40.400	31.13	2.77

***Structure Detail:***

***Structure #1 (Riprap Channel)***

*Area 4 North Pd 1 & ripraped inlet str.*

Trapezoidal Riprap Channel Inputs:

Material: Riprap

Bottom Width (ft)	Left Sideslope Ratio	Right Sideslope Ratio	Slope (%)	Freeboard Depth (ft)	Freeboard % of Depth	Freeboard Mult. x (VxD)
8.00	3.0:1	3.0:1	12.0	1.00		

Riprap Channel Results:

**Simons/OSM Method - Steep Slope Design**

	w/o Freeboard	w/ Freeboard
Design Discharge:	31.13 cfs	
Depth:	0.33 ft	1.33 ft
Top Width:	9.99 ft	15.99 ft
Velocity*:		
X-Section Area:	2.98 sq ft	
Hydraulic Radius:	0.295	
Froude Number*:		
Manning's n*:		
Dmin:	3.00 in	
D50:	9.00 in	
Dmax:	11.25 in	

Velocity and Manning's n calculations may not apply for this method.

***Subwatershed Hydrology Detail:***

Stru #	SWS #	SWS Area (ac)	Time of Conc (hrs)	Musk K (hrs)	Musk X	Curve Number	UHS	Peak Discharge (cfs)	Runoff Volume (ac-ft)
#1	1	40.400	0.385	0.000	0.000	91.000	M	31.13	2.768
<b>Σ</b>		<b>40.400</b>						<b>31.13</b>	<b>2.768</b>

***Subwatershed Time of Concentration Details:***

Stru #	SWS #	Land Flow Condition	Slope (%)	Vert. Dist. (ft)	Horiz. Dist. (ft)	Velocity (fps)	Time (hrs)
#1	1	5. Nearly bare and untilled, and alluvial valley fans	0.59	5.00	853.00	0.760	0.311
		8. Large gullies, diversions, and low flowing streams	3.16	45.00	1,423.00	5.330	0.074
<b>#1</b>	<b>1</b>	<b>Time of Concentration:</b>					<b>0.385</b>

***General Information***

***Storm Information:***

Storm Type:	NRCS Type II - 60
Design Storm:	100 yr - 6 hr
Rainfall Depth:	2.000 inches

# SEDCAD 4 for Windows

Copyright 1998 Pamela J. Schwab  
Civil Software Design

## ***Structure Summary:***

	Immediate Contributing Area (ac)	Total Contributing Area (ac)	Peak Discharge (cfs)	Total Runoff Volume (ac-ft)
#1	40.400	40.400	44.00	3.92

***Structure Detail:***

Structure #1 (Riprap Channel)

*Area 4 North Pd 1*

Trapezoidal Riprap Channel Inputs:

Material: Riprap

Bottom Width (ft)}	Left Sideslope Ratio	Right Sideslope Ratio	Slope (%)	Freeboard Depth (ft)	Freeboard % of Depth	Freeboard Mult. x (VxD)
8.00	3.0:1	3.0:1	12.0	1.00		

Riprap Channel Results:

**Simons/OSM Method - Steep Slope Design**

	w/o Freeboard	w/ Freeboard
Design Discharge:	44.00 cfs	
Depth:	0.43 ft	1.43 ft
Top Width:	10.57 ft	16.57 ft
Velocity*:		
X-Section Area:	3.98 sq ft	
Hydraulic Radius:	0.372	
Froude Number*:		
Manning's n*:		
Dmin:	3.00 in	
D50:	9.00 in	
Dmax:	11.25 in	

Velocity and Manning's n calculations may not apply for this method.

## **Area 4 North Pond 3**

***The watershed for the impoundment is presented on Exhibit 11-13F. The detail design is presented on Exhibit 11-115.***

***The pond is designed to retain the runoff from the 100 year-6 hour storm event, therefore no spillway required.***

Ron Van Valkenburg, PE

BHP Billiton  
Navajo Mine  
PO Box 1717  
Fruitland, NM 87416

Phone: 505 598 2007

---

## ***General Information***

### ***Storm Information:***

Storm Type:	NRCS TYPE II-70
Design Storm:	100 yr - 6 hr
Rainfall Depth:	2.000 inches

**Structure Networking:**

Type	Stru #	(flows into)	Stru #	Musk. K (hrs)	Musk. X	Description
Null	#1	==>	End	0.000	0.000	Area 4 North Pond 3



***Structure Summary:***

	Immediate Contributing Area (ac)	Total Contributing Area (ac)	Peak Discharge (cfs)	Total Runoff Volume (ac-ft)
#1	8.600	8.600	21.09	0.83

## ***Structure Detail:***

*Structure #1 (Null)*

*Area 4 North Pond 3*

***Subwatershed Hydrology Detail:***

Stru #	SWS #	SWS Area (ac)	Time of Conc (hrs)	Musk K (hrs)	Musk X	Curve Number	UHS	Peak Discharge (cfs)	Runoff Volume (ac-ft)
#1	1	8.600	0.019	0.000	0.000	91.000	M	21.09	0.833
<b>Σ</b>		<b>8.600</b>						<b>21.09</b>	<b>0.833</b>

***Subwatershed Time of Concentration Details:***

Stru #	SWS #	Land Flow Condition	Slope (%)	Vert. Dist. (ft)	Horiz. Dist. (ft)	Velocity (fps)	Time (hrs)
#1	1	5. Nearly bare and untilled, and alluvial valley fans	6.00	6.00	100.00	2.440	0.011
		8. Large gullies, diversions, and low flowing streams	20.95	88.00	420.00	13.730	0.008
<b>#1</b>	<b>1</b>	<b>Time of Concentration:</b>					<b>0.019</b>

## **Area 4 North Pond 4**

*The watershed for the impoundment is presented on Exhibit 11-13F. The detail design is presented on Exhibit 11-118.*

*The pond is designed to retain the runoff from the 100 year-6 hour storm event, therefore no spillway required.*

Ron Van Valkenburg, PE

BHP Billiton  
Navajo Mine  
PO Box 1717  
Fruitland, NM 87416

Phone: 505 598 2007


## ***General Information***

### ***Storm Information:***

Storm Type:	NRCS TYPE II-70
Design Storm:	100 yr - 6 hr
Rainfall Depth:	2.000 inches

### Structure Networking:

Type	Stru #	(flows into)	Stru #	Musk. K (hrs)	Musk. X	Description
Null	#1	==>	End	0.000	0.000	A4N Pond 4
Channel	#2	==>	#1	0.013	0.443	Southwest Berm to Pond 4
Channel	#3	==>	#1	0.006	0.452	Northeast Berm to Pond 4

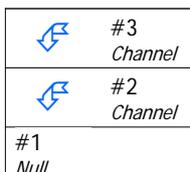

### Structure Routing Details:

Stru #	Land Flow Condition	Slope (%)	Vert. Dist. (ft)	Horiz. Dist. (ft)	Velocity (fps)	Time (hrs)
#2	8. Large gullies, diversions, and low flowing streams	19.68	124.00	630.00	13.30	0.013
<b>#2</b>	<b>Muskingum K:</b>					<b>0.013</b>
#3	8. Large gullies, diversions, and low flowing streams	28.57	100.00	350.00	16.03	0.006
<b>#3</b>	<b>Muskingum K:</b>					<b>0.006</b>

***Structure Summary:***

	Immediate Contributing Area (ac)	Total Contributing Area (ac)	Peak Discharge (cfs)	Total Runoff Volume (ac-ft)
#3	0.200	0.200	0.49	0.02
#2	6.600	6.600	16.19	0.64
#1	39.500	46.300	75.64	4.49

### Structure Detail:

Structure #3 (Erodible Channel)

Northeast Berm to Pond 4

Triangular Erodible Channel Inputs:

Material: Alluvial silts colloidal

Left Sideslope Ratio	Right Sideslope Ratio	Slope (%)	Manning's n	Freeboard Depth (ft)	Freeboard % of Depth	Freeboard Mult. x (VxD)	Limiting Velocity (fps)
2.0:1	2.0:1	1.3	0.0250	1.00			5.0

Erodible Channel Results:

	w/o Freeboard	w/ Freeboard
Depth:	0.35 ft	1.35 ft
Top Width:	1.41 ft	5.41 ft
Velocity:	1.98 fps	
X-Section Area:	0.25 sq ft	
Hydraulic Radius:	0.157	
Froude Number:	0.83	

Structure #2 (Erodible Channel)

Southwest Berm to Pond 4

Trapezoidal Erodible Channel Inputs:

Material: Alluvial silts colloidal

Bottom Width (ft)	Left Sideslope Ratio	Right Sideslope Ratio	Slope (%)	Manning's n	Freeboard Depth (ft)	Freeboard % of Depth	Freeboard Mult. x (VxD)	Limiting Velocity (fps)
6.00	1.5:1	3.0:1	0.2	0.0250	1.00			5.0

Erodible Channel Results:

	w/o Freeboard	w/ Freeboard
Depth:	0.94 ft	1.94 ft
Top Width:	10.21 ft	14.71 ft
Velocity:	2.13 fps	
X-Section Area:	7.59 sq ft	
Hydraulic Radius:	0.715	
Froude Number:	0.44	

**Structure #1 (Null) Area 4N Pond**

### Subwatershed Hydrology Detail:

Stru #	SWS #	SWS Area (ac)	Time of Conc (hrs)	Musk K (hrs)	Musk X	Curve Number	UHS	Peak Discharge (cfs)	Runoff Volume (ac-ft)
#3	1	0.200	0.033	0.000	0.000	91.000	M	0.49	0.02
	<b>S</b>	<b>0.200</b>						<b>0.49</b>	<b>0.02</b>
#2	1	6.600	0.084	0.000	0.000	91.000	M	16.19	0.64
	<b>S</b>	<b>6.600</b>						<b>16.19</b>	<b>0.64</b>
#1	1	39.500	0.133	0.000	0.000	91.000	M	63.76	3.83
	<b>S</b>	<b>46.300</b>						<b>75.64</b>	<b>4.49</b>

### Subwatershed Time of Concentration Details:

Stru #	SWS #	Land Flow Condition	Slope (%)	Vert. Dist. (ft)	Horiz. Dist. (ft)	Velocity (fps)	Time (hrs)
#1	1	5. Nearly bare and untilled, and alluvial valley fans	2.62	15.00	572.01	1.610	0.098
		8. Large gullies, diversions, and low flowing streams	9.89	120.00	1,213.00	9.430	0.035
<b>#1</b>	<b>1</b>	<b>Time of Concentration:</b>					<b>0.133</b>
#2	1	5. Nearly bare and untilled, and alluvial valley fans	6.45	10.00	155.00	2.540	0.016
		8. Large gullies, diversions, and low flowing streams	2.25	25.00	1,110.00	4.500	0.068
<b>#2</b>	<b>1</b>	<b>Time of Concentration:</b>					<b>0.084</b>
#3	1	5. Nearly bare and untilled, and alluvial valley fans	2.22	4.00	180.00	1.490	0.033
<b>#3</b>	<b>1</b>	<b>Time of Concentration:</b>					<b>0.033</b>

---

## **Area 4 North Pond 4**

*The watershed for the impoundment is presented on Exhibit 11-13F. The detail design is presented on Exhibit 11-118.*

*The pond is designed to retain the runoff from the 100 year-6 hour storm event, therefore no spillway required.*

Ron Van Valkenburg, PE

BHP Billiton  
Navajo Mine  
PO Box 1717  
Fruitland, NM 87416

Phone: 505 598 2007


## *General Information*

### *Storm Information:*

Storm Type:	NRCS TYPE II-70
Design Storm:	10 yr - 6 hr
Rainfall Depth:	1.300 inches

### Structure Networking:

Type	Stru #	(flows into)	Stru #	Musk. K (hrs)	Musk. X	Description
Null	#1	==>	End	0.000	0.000	A4N Pond 4
Channel	#2	==>	#1	0.013	0.443	Southwest Berm to Pond 4
Channel	#3	==>	#1	0.006	0.452	Northeast Berm to Pond 4

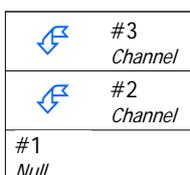

### Structure Routing Details:

Stru #	Land Flow Condition	Slope (%)	Vert. Dist. (ft)	Horiz. Dist. (ft)	Velocity (fps)	Time (hrs)
#2	8. Large gullies, diversions, and low flowing streams	19.68	124.00	630.00	13.30	0.013
<b>#2</b>	<b>Muskingum K:</b>					<b>0.013</b>
#3	8. Large gullies, diversions, and low flowing streams	28.57	100.00	350.00	16.03	0.006
<b>#3</b>	<b>Muskingum K:</b>					<b>0.006</b>

***Structure Summary:***

	Immediate Contributing Area (ac)	Total Contributing Area (ac)	Peak Discharge (cfs)	Total Runoff Volume (ac-ft)
#3	0.200	0.200	0.27	0.01
#2	6.600	6.600	8.98	0.32
#1	39.500	46.300	38.57	2.57

### Structure Detail:

#### Structure #3 (Erodible Channel)

Northeast Berm to Pond 4

Triangular Erodible Channel Inputs:

Material: Alluvial silts colloidal

Left Sideslope Ratio	Right Sideslope Ratio	Slope (%)	Manning's n	Freeboard Depth (ft)	Freeboard % of Depth	Freeboard Mult. x (VxD)	Limiting Velocity (fps)
2.0:1	2.0:1	1.3	0.0250	1.00			5.0

Erodible Channel Results:

	w/o Freeboard	w/ Freeboard
Depth:	0.28 ft	1.28 ft
Top Width:	1.13 ft	5.13 ft
Velocity:	1.72 fps	
X-Section Area:	0.16 sq ft	
Hydraulic Radius:	0.127	
Froude Number:	0.80	

#### Structure #2 (Erodible Channel)

Southwest Berm to Pond 4

Trapezoidal Erodible Channel Inputs:

Material: Alluvial silts colloidal

Bottom Width (ft)	Left Sideslope Ratio	Right Sideslope Ratio	Slope (%)	Manning's n	Freeboard Depth (ft)	Freeboard % of Depth	Freeboard Mult. x (VxD)	Limiting Velocity (fps)
6.00	1.5:1	3.0:1	0.2	0.0250	1.00			5.0

Erodible Channel Results:

	w/o Freeboard	w/ Freeboard
Depth:	0.67 ft	1.67 ft
Top Width:	9.03 ft	13.53 ft
Velocity:	1.77 fps	
X-Section Area:	5.06 sq ft	
Hydraulic Radius:	0.543	
Froude Number:	0.42	

#### Structure #1 (Null) Area 4N Pond

***Subwatershed Hydrology Detail:***

Stru #	SWS #	SWS Area (ac)	Time of Conc (hrs)	Musk K (hrs)	Musk X	Curve Number	UHS	Peak Discharge (cfs)	Runoff Volume (ac-ft)
#3	1	0.200	0.033	0.000	0.000	91.000	M	0.27	0.01
	<b>S</b>	<b>0.200</b>						<b>0.27</b>	<b>0.01</b>
#2	1	6.600	0.084	0.000	0.000	91.000	M	8.98	0.32
	<b>S</b>	<b>6.600</b>						<b>8.98</b>	<b>0.32</b>
#1	1	39.500	0.133	0.000	0.000	91.000	M	33.48	1.91
	<b>S</b>	<b>46.300</b>						<b>38.57</b>	<b>2.57</b>

***Subwatershed Time of Concentration Details:***

Stru #	SWS #	Land Flow Condition	Slope (%)	Vert. Dist. (ft)	Horiz. Dist. (ft)	Velocity (fps)	Time (hrs)
#1	1	5. Nearly bare and untilled, and alluvial valley fans	2.62	15.00	572.01	1.610	0.098
		8. Large gullies, diversions, and low flowing streams	9.89	120.00	1,213.00	9.430	0.035
<b>#1</b>	<b>1</b>	<b>Time of Concentration:</b>					<b>0.133</b>
#2	1	5. Nearly bare and untilled, and alluvial valley fans	6.45	10.00	155.00	2.540	0.016
		8. Large gullies, diversions, and low flowing streams	2.25	25.00	1,110.00	4.500	0.068
<b>#2</b>	<b>1</b>	<b>Time of Concentration:</b>					<b>0.084</b>
#3	1	5. Nearly bare and untilled, and alluvial valley fans	2.22	4.00	180.00	1.490	0.033
<b>#3</b>	<b>1</b>	<b>Time of Concentration:</b>					<b>0.033</b>

## **South Barber Pond - Ramp 5**

***Pond design is presented on Exhibit 11-050. The watershed area is shown on Exhibit 11-13D.***

W. Napoleon

BHP Navajo Coal Company  
Box 1717  
Fruitland, NM 87416

***General Information***

***Storm Information:***

Storm Type:	Type II-60
Design Storm:	100 yr - 6 hr
Rainfall Depth:	2.000 inches

**Structure Networking:**

Type	Stru #	(flows into)	Stru #	Musk. K (hrs)	Musk. X	Description
Null	#1	==>	End	0.000	0.000	Barber R5 Pond

#1  
Null

***Structure Summary:***

	Immediate Contributing Area (ac)	Total Contributing Area (ac)	Peak Discharge (cfs)	Total Runoff Volume (ac-ft)
#1	157.400	157.400	70.00	5.43

***Subwatershed Hydrology Detail:***

Stru #	SWS #	SWS Area (ac)	Time of Conc (hrs)	Musk K (hrs)	Musk X	Curve Number	UHS	Peak Discharge (cfs)	Runoff Volume (ac-ft)
#1	1	106.190	0.281	0.000	0.000	76.000	M	45.55	3.661
	2	51.210	0.221	0.000	0.000	76.000	M	24.44	1.766
	<b>Σ</b>	<b>157.400</b>						<b>70.00</b>	<b>5.426</b>

***Subwatershed Time of Concentration Details:***

Stru #	SWS #	Land Flow Condition	Slope (%)	Vert. Dist. (ft)	Horiz. Dist. (ft)	Velocity (fps)	Time (hrs)
#1	1	5. Nearly bare and untilled, and alluvial valley fans	1.79	13.56	756.94	1.330	0.158
		8. Large gullies, diversions, and low flowing streams	2.61	56.24	2,155.83	4.840	0.123
<b>#1</b>	<b>1</b>	<b>Time of Concentration:</b>					<b>0.281</b>
#1	2	5. Nearly bare and untilled, and alluvial valley fans	2.31	10.00	432.56	1.520	0.079
		8. Large gullies, diversions, and low flowing streams	2.38	56.40	2,374.73	4.620	0.142
<b>#1</b>	<b>2</b>	<b>Time of Concentration:</b>					<b>0.221</b>

# **Lowe-Dixon Diversion Pond** **Lowe-Dixon Diversion North Pond A**

*These impoundments are for stormwater control of surface water runoff from undisturbed areas upstream of Lowe Pit. There is no minimum storage containment requirement. A spillway for the Lowe-Dixon Diversion Pond is designed for a 25 yr - 6 hr storm event shown in this hydrology model.*

*The watershed subdivisions for the model are presented on Exhibit 11-13E. The plan, profile and typical sections are presented on Exhibit 11-150 and 11-151.*

Ron Van Valkenburg, PE

BHP Billiton  
Navajo Mine  
PO Box 1717  
Fruitland, NM 87416

Phone: 505 598 2007

---


## ***General Information***

### ***Storm Information:***

Storm Type:	NRCS TYPE II-70
Design Storm:	25 yr - 6 hr
Rainfall Depth:	1.600 inches

### Structure Networking:

Type	Stru #	(flows into)	Stru #	Musk. K (hrs)	Musk. X	Description
Null	#4	==>	#7	0.000	0.000	North inlet to LDD Pond
Null	#5	==>	#7	0.000	0.000	East inlet to LDD Pond
Null	#6	==>	#7	0.000	0.000	South inlet to LDD Pond
Pond	#7	==>	#8	0.000	0.000	Lowe-Dixon Diversion (LDD) Pond
Null	#8	==>	#9	0.000	0.000	LDD North Pond A
Null	#9	==>	End	0.000	0.000	Low Pit

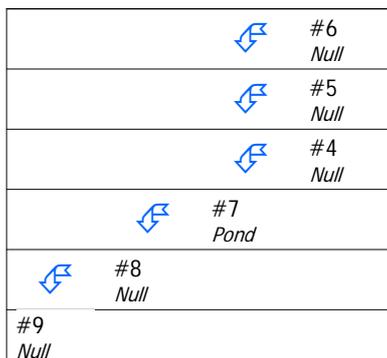

***Structure Summary:***

	Immediate Contributing Area (ac)	Total Contributing Area (ac)	Peak Discharge (cfs)	Total Runoff Volume (ac-ft)
#6	86.260	86.260	28.88	4.05
#5	25.510	25.510	15.97	1.20
#4	1,450.720	1,450.720	486.18	78.49
#7 In Out	40.670	1,603.160	537.50 423.69	85.72 85.72
#8	11.100	1,614.260	425.99	86.38
#9	0.000	1,614.260	425.99	86.38

### Structure Detail:

Structure #6 (Null)

South inlet to LDD Pond

Structure #5 (Null)

East inlet to LDD Pond

Structure #4 (Null)

North inlet to LDD Pond

Structure #7 (Pond)

Lowe-Dixon Diversion (LDD) Pond

Pond Inputs:

Permanent Pool Elev:	5,387.70
Permanent Pool:	16.89 ac-ft

#### Emergency Spillway

Spillway Elev	Crest Length (ft)	Left Sideslope	Right Sideslope	Bottom Width (ft)
5,387.70	40.00	5.00:1	4.00:1	52.00

Pond Results:

Peak Elevation:	5,389.77
H'graph Detention Time:	0.37 hrs
Dewater Time:	0.38 days

*Dewatering time is calculated from peak stage to lowest spillway*

#### Elevation-Capacity-Discharge Table

Elevation	Area (ac)	Capacity (ac-ft)	Discharge (cfs)	Dewater Time (hrs)
5,376.00	0.000	0.000	0.000	
5,377.00	0.055	0.018	0.000	
5,378.00	0.220	0.147	0.000	
5,379.00	0.406	0.455	0.000	
5,380.00	0.648	0.977	0.000	
5,381.00	0.898	1.747	0.000	
5,382.00	1.188	2.786	0.000	
5,383.00	1.520	4.136	0.000	

Elevation	Area (ac)	Capacity (ac-ft)	Discharge (cfs)	Dewater Time (hrs)	
5,384.00	1.892	5.839	0.000		
5,385.00	2.448	8.003	0.000		
5,386.00	3.076	10.759	0.000		
5,387.00	3.700	14.142	0.000		
5,387.70	4.166	16.895	0.000		Spillway #1
5,387.80	4.230	17.313	13.721	4.80	
5,388.00	4.358	18.172	41.297	1.10	
5,389.00	5.970	23.315	179.045	2.00	
5,389.77	7.441	28.637	423.693	1.30	Peak Stage
5,390.00	7.835	30.197	495.419		
5,391.00	9.254	38.731	955.522		
5,392.00	10.790	48.743	1,564.630		

Detailed Discharge Table

Elevation	Emergency Spillway (cfs)	Combined Total Discharge (cfs)
5,376.00	0.000	0.000
5,377.00	0.000	0.000
5,378.00	0.000	0.000
5,379.00	0.000	0.000
5,380.00	0.000	0.000
5,381.00	0.000	0.000
5,382.00	0.000	0.000
5,383.00	0.000	0.000
5,384.00	0.000	0.000
5,385.00	0.000	0.000
5,386.00	0.000	0.000
5,387.00	0.000	0.000
5,387.70	0.000	0.000
5,387.80	13.721	13.721
5,388.00	41.297	41.297
5,389.00	179.045	179.045
5,390.00	495.419	495.419
5,391.00	955.522	955.522
5,392.00	1,564.630	1,564.630

Structure #8 (Null)

LDD North Pond A

Structure #9 (Null)

Low Pit

### *Subwatershed Hydrology Detail:*

Stru #	SWS #	SWS Area (ac)	Time of Conc (hrs)	Musk K (hrs)	Musk X	Curve Number	UHS	Peak Discharge (cfs)	Runoff Volume (ac-ft)
#6	1	86.260	0.958	0.000	0.000	86.100	M	28.88	4.05
<b>S</b>		<b>86.260</b>						<b>28.88</b>	<b>4.05</b>
#5	1	25.510	0.356	0.000	0.000	86.100	M	15.97	1.20
<b>S</b>		<b>25.510</b>						<b>15.97</b>	<b>1.20</b>
#4	1	470.600	1.257	0.387	0.350	87.000	M	138.69	23.75
	2	166.700	1.396	0.534	0.354	81.100	M	26.77	5.16
	3	66.500	0.818	0.534	0.354	82.600	M	18.27	2.34
	4	96.300	0.766	0.389	0.341	90.200	M	52.64	6.21
	5	54.100	0.199	0.389	0.341	93.000	M	68.18	4.30
	6	112.200	0.398	0.332	0.342	92.700	M	109.83	8.72
	7	56.900	0.238	0.183	0.333	93.000	M	68.75	4.52
	8	89.500	0.413	0.183	0.333	91.900	M	81.35	6.56
	9	226.200	0.610	0.000	0.000	87.500	M	116.05	11.87
	10	78.400	0.397	0.000	0.000	85.400	M	43.92	3.48
	11	33.320	0.591	0.000	0.000	86.100	M	15.57	1.57
<b>S</b>		<b>1,450.720</b>						<b>486.18</b>	<b>78.49</b>
#7	1	35.270	0.650	0.000	0.000	86.100	M	15.48	1.66
	2	5.400	0.000	0.000	0.000	89.000	M	8.98	0.32
<b>S</b>		<b>1,603.160</b>						<b>537.50</b>	<b>85.72</b>
#8	1	11.100	0.258	0.000	0.000	89.000	M	9.95	0.65
<b>S</b>		<b>1,614.260</b>						<b>425.99</b>	<b>86.38</b>
#9	<b>S</b>	<b>1,614.260</b>						<b>425.99</b>	<b>86.38</b>

### *Subwatershed Time of Concentration Details:*

Stru #	SWS #	Land Flow Condition	Slope (%)	Vert. Dist. (ft)	Horiz. Dist. (ft)	Velocity (fps)	Time (hrs)
#4	1	5. Nearly bare and untilled, and alluvial valley fans	1.08	35.00	3,237.00	1.030	0.872
		8. Large gullies, diversions, and low flowing streams	2.41	155.00	6,442.00	4.650	0.384
<b>#4</b>	<b>1</b>	<b>Time of Concentration:</b>					<b>1.257</b>
#4	2	5. Nearly bare and untilled, and alluvial valley fans	0.86	37.00	4,286.00	0.920	1.294
		8. Large gullies, diversions, and low flowing streams	4.10	92.00	2,243.00	6.070	0.102
<b>#4</b>	<b>2</b>	<b>Time of Concentration:</b>					<b>1.396</b>
#4	3	5. Nearly bare and untilled, and alluvial valley fans	0.93	23.00	2,478.00	0.960	0.717

Stru #	SWS #	Land Flow Condition	Slope (%)	Vert. Dist. (ft)	Horiz. Dist. (ft)	Velocity (fps)	Time (hrs)
		8. Large gullies, diversions, and low flowing streams	3.83	82.00	2,141.00	5.870	0.101
<b>#4</b>	<b>3</b>	<b>Time of Concentration:</b>					<b>0.818</b>
#4	4	5. Nearly bare and untilled, and alluvial valley fans	0.63	10.00	1,582.00	0.790	0.556
		8. Large gullies, diversions, and low flowing streams	3.62	157.00	4,332.00	5.710	0.210
<b>#4</b>	<b>4</b>	<b>Time of Concentration:</b>					<b>0.766</b>
#4	5	5. Nearly bare and untilled, and alluvial valley fans	8.38	73.00	871.00	2.890	0.083
		8. Large gullies, diversions, and low flowing streams	2.64	54.00	2,043.00	4.870	0.116
<b>#4</b>	<b>5</b>	<b>Time of Concentration:</b>					<b>0.199</b>
#4	6	5. Nearly bare and untilled, and alluvial valley fans	4.90	80.00	1,632.02	2.210	0.205
		8. Large gullies, diversions, and low flowing streams	2.57	86.00	3,346.04	4.800	0.193
<b>#4</b>	<b>6</b>	<b>Time of Concentration:</b>					<b>0.398</b>
#4	7	5. Nearly bare and untilled, and alluvial valley fans	12.89	70.00	543.00	3.590	0.042
		8. Large gullies, diversions, and low flowing streams	1.40	35.00	2,508.00	3.540	0.196
<b>#4</b>	<b>7</b>	<b>Time of Concentration:</b>					<b>0.238</b>
#4	8	5. Nearly bare and untilled, and alluvial valley fans	3.98	30.00	754.00	1.990	0.105
		8. Large gullies, diversions, and low flowing streams	1.87	85.00	4,548.00	4.100	0.308
<b>#4</b>	<b>8</b>	<b>Time of Concentration:</b>					<b>0.413</b>
#4	9	5. Nearly bare and untilled, and alluvial valley fans	2.53	40.00	1,584.00	1.580	0.278
		8. Large gullies, diversions, and low flowing streams	1.61	73.00	4,546.00	3.800	0.332
<b>#4</b>	<b>9</b>	<b>Time of Concentration:</b>					<b>0.610</b>
#4	10	5. Nearly bare and untilled, and alluvial valley fans	3.26	50.00	1,536.00	1.800	0.237
		8. Large gullies, diversions, and low flowing streams	1.21	23.00	1,901.00	3.290	0.160
<b>#4</b>	<b>10</b>	<b>Time of Concentration:</b>					<b>0.397</b>
#4	11	5. Nearly bare and untilled, and alluvial valley fans	2.00	60.00	3,000.00	1.410	0.591
<b>#4</b>	<b>11</b>	<b>Time of Concentration:</b>					<b>0.591</b>
#5	1	5. Nearly bare and untilled, and alluvial valley fans	2.21	42.00	1,900.02	1.480	0.356
<b>#5</b>	<b>1</b>	<b>Time of Concentration:</b>					<b>0.356</b>
#6	1	5. Nearly bare and untilled, and alluvial valley fans	1.45	60.00	4,140.21	1.200	0.958
<b>#6</b>	<b>1</b>	<b>Time of Concentration:</b>					<b>0.958</b>
#7	1	5. Nearly bare and untilled, and alluvial valley fans	1.43	40.00	2,788.03	1.190	0.650

Stru #	SWS #	Land Flow Condition	Slope (%)	Vert. Dist. (ft)	Horiz. Dist. (ft)	Velocity (fps)	Time (hrs)
<b>#7</b>	<b>1</b>	<b>Time of Concentration:</b>					<b>0.650</b>
#8	1	5. Nearly bare and untilled, and alluvial valley fans	1.88	24.00	1,275.03	1.370	0.258
<b>#8</b>	<b>1</b>	<b>Time of Concentration:</b>					<b>0.258</b>

## *Subwatershed Muskingum Routing Details:*

Stru #	SWS #	Land Flow Condition	Slope (%)	Vert. Dist. (ft)	Horiz. Dist. (ft)	Velocity (fps)	Time (hrs)
#4	1	8. Large gullies, diversions, and low flowing streams	1.76	98.00	5,553.03	3.980	0.387
<b>#4</b>	<b>1</b>	<b>Muskingum K:</b>					<b>0.387</b>
#4	2	8. Large gullies, diversions, and low flowing streams	1.90	151.00	7,950.00	4.130	0.534
<b>#4</b>	<b>2</b>	<b>Muskingum K:</b>					<b>0.534</b>
#4	3	8. Large gullies, diversions, and low flowing streams	1.90	151.00	7,950.00	4.130	0.534
<b>#4</b>	<b>3</b>	<b>Muskingum K:</b>					<b>0.534</b>
#4	4	8. Large gullies, diversions, and low flowing streams	1.49	76.00	5,117.00	3.650	0.389
<b>#4</b>	<b>4</b>	<b>Muskingum K:</b>					<b>0.389</b>
#4	5	8. Large gullies, diversions, and low flowing streams	1.49	76.00	5,117.00	3.650	0.389
<b>#4</b>	<b>5</b>	<b>Muskingum K:</b>					<b>0.389</b>
#4	6	8. Large gullies, diversions, and low flowing streams	1.50	66.00	4,388.00	3.670	0.332
<b>#4</b>	<b>6</b>	<b>Muskingum K:</b>					<b>0.332</b>
#4	7	8. Large gullies, diversions, and low flowing streams	1.29	29.00	2,252.00	3.400	0.183
<b>#4</b>	<b>7</b>	<b>Muskingum K:</b>					<b>0.183</b>
#4	8	8. Large gullies, diversions, and low flowing streams	1.29	29.00	2,252.00	3.400	0.183
<b>#4</b>	<b>8</b>	<b>Muskingum K:</b>					<b>0.183</b>

Pages 364 through 376 removed by Rev 1002 submitted to OSM 1-13-10

---

## **North Fork Pond**

***This highwall pond is designed to contain the 100 yr - 6 hr storm event, therefore no spillway is required.***

***The watershed detail is presented on Exhibit 11-13E. The design plan, profile and typical sections are presented on Exhibit 11-152.***

Ron Van Valkenburg, PE

BHP Billiton  
Navajo Mine  
PO Box 1717  
Fruitland, NM 87416

Phone: 505 598 2007

---

## ***General Information***

### ***Storm Information:***

Storm Type:	Type II 70
Design Storm:	100 yr - 6 hr
Rainfall Depth:	2.000 inches

## Structure Networking:

Type	Stru #	(flows into)	Stru #	Musk. K (hrs)	Musk. X	Description
Null	#1	==>	End	0.000	0.000	North Fork Pond

#1 Null
------------

## *Structure Summary:*

	Immediate Contributing Area (ac)	Total Contributing Area (ac)	Peak Discharge (cfs)	Total Runoff Volume (ac-ft)
#1	198.700	198.700	117.98	18.12

***Structure Detail:***

*Structure #1 (Null)*

*North Fork Pond*

***Subwatershed Hydrology Detail:***

Stru #	SWS #	SWS Area (ac)	Time of Conc (hrs)	Musk K (hrs)	Musk X	Curve Number	UHS	Peak Discharge (cfs)	Runoff Volume (ac-ft)
#1	1	198.700	1.083	0.299	0.298	90.000	M	120.71	18.12
<b>S</b>								<b>117.98</b>	<b>18.12</b>

***Subwatershed Time of Concentration Details:***

Stru #	SWS #	Land Flow Condition	Slope (%)	Vert. Dist. (ft)	Horiz. Dist. (ft)	Velocity (fps)	Time (hrs)
#1	1	5. Nearly bare and untilled, and alluvial valley fans	1.02	10.00	980.00	1.010	0.269
		5. Nearly bare and untilled, and alluvial valley fans	2.28	101.00	4,425.36	1.510	0.814
#1	1	<b>Time of Concentration:</b>					<b>1.083</b>

***Subwatershed Muskingum Routing Details:***

Stru #	SWS #	Land Flow Condition	Slope (%)	Vert. Dist. (ft)	Horiz. Dist. (ft)	Velocity (fps)	Time (hrs)
#1	1	8. Large gullies, diversions, and low flowing streams	0.70	19.00	2,702.00	2.510	0.299
#1	1	<b>Muskingum K:</b>					<b>0.299</b>

## **Area 4 North**

# **Perimeter Road Pond 401**

*The watershed for the impoundment is presented on Exhibit 11-13F. The detail design is presented on Exhibit 11-01.*

*The pond is designed to retain the runoff from the 100 year-6 hour storm event, therefore no spillway required.*

Ron Van Valkenburg, PE

BHP Billiton  
Navajo Mine  
PO Box 1717  
Fruitland, NM 87416

Phone: 505 598 2007

## ***General Information***

### ***Storm Information:***

Storm Type:	NRCS TYPE II-70
Design Storm:	100 yr - 6 hr
Rainfall Depth:	2.000 inches

**Structure Networking:**

Type	Stru #	(flows into)	Stru #	Musk. K (hrs)	Musk. X	Description
Null	#1	==>	End	0.000	0.000	Perimeter Road Pond 401

#1 Null
------------

***Structure Summary:***

	Immediate Contributing Area (ac)	Total Contributing Area (ac)	Peak Discharge (cfs)	Total Runoff Volume (ac-ft)
#1	21.400	21.400	42.07	1.45

---

***Structure Detail:***

*Structure #1 (Null)*

*Perimeter Road Pond 401*

***Subwatershed Hydrology Detail:***

Stru #	SWS #	SWS Area (ac)	Time of Conc (hrs)	Musk K (hrs)	Musk X	Curve Number	UHS	Peak Discharge (cfs)	Runoff Volume (ac-ft)
#1	1	21.400	0.059	0.000	0.000	85.300	M	42.07	1.45
<b>S</b>		<b>21.400</b>						<b>42.07</b>	<b>1.45</b>

***Subwatershed Time of Concentration Details:***

Stru #	SWS #	Land Flow Condition	Slope (%)	Vert. Dist. (ft)	Horiz. Dist. (ft)	Velocity (fps)	Time (hrs)
#1	1	8. Large gullies, diversions, and low flowing streams	4.56	62.00	1,360.00	6.400	0.059
<b>#1</b>	<b>1</b>	<b>Time of Concentration:</b>					<b>0.059</b>

# Area 4 North Perimeter Road Pond 402

*The watershed for the impoundment is presented on Exhibit 11-13F. The detail design is presented on Exhibit 11-02.*

*The pond is designed to retain the runoff from the 100 year-6 hour storm event, therefore no spillway required.*

Ron Van Valkenburg, PE

BHP Billiton  
Navajo Mine  
PO Box 1717  
Fruitland, NM 87416

Phone: 505 598 2007

---


## ***General Information***

### ***Storm Information:***

Storm Type:	NRCS TYPE II-70
Design Storm:	100 yr - 6 hr
Rainfall Depth:	2.000 inches

## Structure Networking:

Type	Stru #	(flows into)	Stru #	Musk. K (hrs)	Musk. X	Description
Null	#1	==>	End	0.000	0.000	Perimeter Road Pond 402
Channel	#2	==>	#1	0.000	0.000	Road Channel-East

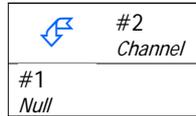

***Structure Summary:***

	Immediate Contributing Area (ac)	Total Contributing Area (ac)	Peak Discharge (cfs)	Total Runoff Volume (ac-ft)
#2	60.800	60.800	88.97	5.21
#1	17.900	78.700	121.10	1.53

### Structure Detail:

Structure #2 (Erodible Channel)

Road Channel-East

Trapezoidal Erodible Channel Inputs:

Material: Shales and hardpans

Bottom Width (ft)	Left Sideslope Ratio	Right Sideslope Ratio	Slope (%)	Manning's n	Freeboard Depth (ft)	Freeboard % of Depth	Freeboard Mult. x (VxD)	Limiting Velocity (fps)
8.00	3.0:1	1.5:1	0.8	0.0250	1.00			6.0

Erodible Channel Results:

	w/o Freeboard	w/ Freeboard
Depth:	1.43 ft	2.43 ft
Top Width:	14.42 ft	18.92 ft
Velocity:	5.56 fps	
X-Section Area:	16.00 sq ft	
Hydraulic Radius:	1.065	
Froude Number:	0.93	

Structure #1 (Null)

Perimeter Road Pond 402

***Subwatershed Hydrology Detail:***

Stru #	SWS #	SWS Area (ac)	Time of Conc (hrs)	Musk K (hrs)	Musk X	Curve Number	UHS	Peak Discharge (cfs)	Runoff Volume (ac-ft)
#2	1	60.800	0.139	0.000	0.000	89.000	M	88.97	5.21
<b>S</b>		<b>60.800</b>						<b>88.97</b>	<b>5.21</b>
#1	1	17.900	0.015	0.000	0.000	89.000	M	40.87	1.53
<b>S</b>		<b>78.700</b>						<b>121.10</b>	<b>1.53</b>

***Subwatershed Time of Concentration Details:***

Stru #	SWS #	Land Flow Condition	Slope (%)	Vert. Dist. (ft)	Horiz. Dist. (ft)	Velocity (fps)	Time (hrs)
#1	1	5. Nearly bare and untilled, and alluvial valley fans	15.00	6.00	40.00	3.870	0.002
		8. Large gullies, diversions, and low flowing streams	15.00	84.00	560.00	11.610	0.013
<b>#1</b>	<b>1</b>	<b>Time of Concentration:</b>					<b>0.015</b>
#2	1	5. Nearly bare and untilled, and alluvial valley fans	6.67	10.00	150.00	2.580	0.016
		8. Large gullies, diversions, and low flowing streams	3.90	103.00	2,640.01	5.920	0.123
<b>#2</b>	<b>1</b>	<b>Time of Concentration:</b>					<b>0.139</b>


## ***General Information***

### ***Storm Information:***

Storm Type:	NRCS TYPE II-70
Design Storm:	10 yr - 24 hr
Rainfall Depth:	1.600 inches

### Structure Networking:

Type	Stru #	(flows into)	Stru #	Musk. K (hrs)	Musk. X	Description
Null	#1	==>	End	0.000	0.000	Perimeter Road Pond 402
Channel	#2	==>	#1	0.000	0.000	Road Channel-East

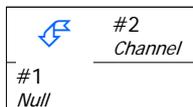

***Structure Summary:***

	Immediate Contributing Area (ac)	Total Contributing Area (ac)	Peak Discharge (cfs)	Total Runoff Volume (ac-ft)
#2	60.800	60.800	50.91	3.58
#1	17.900	78.700	68.56	6.26

**Structure Detail:**

Structure #2 (Erodible Channel)

Road Channel-East

Trapezoidal Erodible Channel Inputs:

Material: Shales and hardpans

Bottom Width (ft)	Left Sideslope Ratio	Right Sideslope Ratio	Slope (%)	Manning's n	Freeboard Depth (ft)	Freeboard % of Depth	Freeboard Mult. x (VxD)	Limiting Velocity (fps)
8.00	3.0:1	1.5:1	0.8	0.0250	1.00			6.0

Erodible Channel Results:

	w/o Freeboard	w/ Freeboard
Depth:	1.05 ft	2.05 ft
Top Width:	12.72 ft	17.22 ft
Velocity:	4.69 fps	
X-Section Area:	10.86 sq ft	
Hydraulic Radius:	0.825	
Froude Number:	0.89	

Structure #1 (Null)

Perimeter Road Pond 402

**Subwatershed Hydrology Detail:**

Stru #	SWS #	SWS Area (ac)	Time of Conc (hrs)	Musk K (hrs)	Musk X	Curve Number	UHS	Peak Discharge (cfs)	Runoff Volume (ac-ft)
#2	1	60.800	0.139	0.000	0.000	89.000	M	50.91	3.58
	<b>S</b>	<b>60.800</b>						<b>50.91</b>	<b>3.58</b>
#1	1	17.900	0.015	0.000	0.000	89.000	M	24.18	1.05
	<b>S</b>	<b>78.700</b>						<b>68.56</b>	<b>6.26</b>

**Subwatershed Time of Concentration Details:**

Stru #	SWS #	Land Flow Condition	Slope (%)	Vert. Dist. (ft)	Horiz. Dist. (ft)	Velocity (fps)	Time (hrs)
#1	1	5. Nearly bare and untilled, and alluvial valley fans	15.00	6.00	40.00	3.870	0.002
		8. Large gullies, diversions, and low flowing streams	15.00	84.00	560.00	11.610	0.013
<b>#1</b>	<b>1</b>	<b>Time of Concentration:</b>					<b>0.015</b>
#2	1	5. Nearly bare and untilled, and alluvial valley fans	6.67	10.00	150.00	2.580	0.016
		8. Large gullies, diversions, and low flowing streams	3.90	103.00	2,640.01	5.920	0.123
<b>#2</b>	<b>1</b>	<b>Time of Concentration:</b>					<b>0.139</b>

Material: Riprap

Bottom Width (ft)	Left Sideslope Ratio	Right Sideslope Ratio	Slope (%)	Freeboard Depth (ft)	Freeboard % of Depth	Freeboard Mult. x (VxD)
8.00	3.0:1	3.0:1	12.0	1.00		

Simons/OSM Method - Steep Slope Design

	w/o Freeboard	w/ Freeboard
Depth:	0.48 ft	1.48 ft
Top Width:	10.86 ft	16.86 ft
Velocity*:		
X-Section Area:	4.49 sq ft	
Hydraulic Radius:	0.408	
Froude Number*:		
Manning's n*:		
Dmin:	3.00 in	
D50:	9.00 in	
Dmax:	11.25 in	

Velocity and Manning's n calculations may not apply for this method.

# **Area 4 North**

## **Perimeter Road Pond 404**

*The watershed for the impoundment is presented on Exhibit 11-13F. The detail design is presented on Exhibit 11-04.*

*The pond is designed to retain the runoff from the 100 year-6 hour storm event, therefore no spillway required.*

Ron Van Valkenburg, PE

BHP Billiton  
Navajo Mine  
PO Box 1717  
Fruitland, NM 87416

Phone: 505 598 2007

## ***General Information***

### ***Storm Information:***

Storm Type:	NRCS TYPE II-70
Design Storm:	100 yr - 6 hr
Rainfall Depth:	2.000 inches

**Structure Networking:**

Type	Stru #	(flows into)	Stru #	Musk. K (hrs)	Musk. X	Description
Null	#1	==>	End	0.000	0.000	Perimeter Road Pond 404

#1
Null

***Structure Summary:***

	Immediate Contributing Area (ac)	Total Contributing Area (ac)	Peak Discharge (cfs)	Total Runoff Volume (ac-ft)
#1	9.800	9.800	22.38	0.84

---

***Structure Detail:***

*Structure #1 (Null)*

*Perimeter Road Pond 404*

***Subwatershed Hydrology Detail:***

Stru #	SWS #	SWS Area (ac)	Time of Conc (hrs)	Musk K (hrs)	Musk X	Curve Number	UHS	Peak Discharge (cfs)	Runoff Volume (ac-ft)
#1	1	9.800	0.012	0.000	0.000	89.000	M	22.38	0.84
<b>S</b>		<b>9.800</b>						<b>22.38</b>	<b>0.84</b>

***Subwatershed Time of Concentration Details:***

Stru #	SWS #	Land Flow Condition	Slope (%)	Vert. Dist. (ft)	Horiz. Dist. (ft)	Velocity (fps)	Time (hrs)
#1	1	8. Large gullies, diversions, and low flowing streams	10.48	44.00	420.00	9.710	0.012
<b>#1</b>	<b>1</b>	<b>Time of Concentration:</b>					<b>0.012</b>

## **Area 4 North Pond 405**

***The watershed for the impoundment is presented on Exhibit 11-13F. The detail design is presented on Exhibit 11-5.***

***The pond is design to retain the 100 yr-6 hr storm event. No spillway is required.***

Ron Van Valkenburg, PE

BHP Billiton  
Navajo Mine  
PO Box 1717  
Fruitland, NM 87416

Phone: 505 598 2007

---


## *General Information*

### *Storm Information:*

Storm Type:	NRCS TYPE II-70
Design Storm:	100 yr - 6 hr
Rainfall Depth:	2.000 inches

## Structure Networking:

Type	Stru #	(flows into)	Stru #	Musk. K (hrs)	Musk. X	Description
Null	#2	==>	#5	0.000	0.000	A4N Pond 405
Culvert	#5	==>	End	0.000	0.000	CP-189 Culvert under road

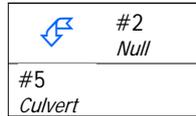

***Structure Summary:***

	Immediate Contributing Area (ac)	Total Contributing Area (ac)	Peak Discharge (cfs)	Total Runoff Volume (ac-ft)
#2	89.700	89.700	131.26	7.68
#5	0.000	89.700	131.26	7.68

***Subwatershed Hydrology Detail:***

Stru #	SWS #	SWS Area (ac)	Time of Conc (hrs)	Musk K (hrs)	Musk X	Curve Number	UHS	Peak Discharge (cfs)	Runoff Volume (ac-ft)
#2	1	89.700	0.146	0.000	0.000	89.000	M	131.26	7.68
	<b>S</b>	<b>89.700</b>						<b>131.26</b>	<b>7.68</b>
#5	<b>S</b>	<b>89.700</b>						<b>131.26</b>	<b>7.68</b>

***Subwatershed Time of Concentration Details:***

Stru #	SWS #	Land Flow Condition	Slope (%)	Vert. Dist. (ft)	Horiz. Dist. (ft)	Velocity (fps)	Time (hrs)
#2	1	8. Large gullies, diversions, and low flowing streams	4.59	155.00	3,380.07	6.420	0.146
<b>#2</b>	<b>1</b>	<b>Time of Concentration:</b>					<b>0.146</b>


## ***General Information***

### ***Storm Information:***

Storm Type:	NRCS TYPE II-70
Design Storm:	10 yr - 6 hr
Rainfall Depth:	1.300 inches

### Structure Networking:

Type	Stru #	(flows into)	Stru #	Musk. K (hrs)	Musk. X	Description
Null	#2	==>	#5	0.000	0.000	A4N Pond 405
Culvert	#5	==>	End	0.000	0.000	CP-189 Culvert under road

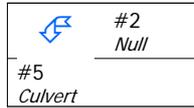

***Structure Summary:***

	Immediate Contributing Area (ac)	Total Contributing Area (ac)	Peak Discharge (cfs)	Total Runoff Volume (ac-ft)
#2	89.700	89.700	84.63	3.62
#5	0.000	89.700	84.63	3.62

**Structure Detail:**

Structure #2 (Null)

A4N Pond 405

Structure #5 (Culvert)

CP-189 Culvert under road

Culvert Inputs:

Length (ft)	Slope (%)	Manning's n	Max. Headwater (ft)	Tailwater (ft)	Entrance Loss Coef. (Ke)
280.00	5.70	0.0150	23.00	0.00	0.90

Culvert Results:

Minimum pipe diameter required: 30 inches

***Subwatershed Hydrology Detail:***

Stru #	SWS #	SWS Area (ac)	Time of Conc (hrs)	Musk K (hrs)	Musk X	Curve Number	UHS	Peak Discharge (cfs)	Runoff Volume (ac-ft)
#2	1	89.700	0.146	0.000	0.000	89.000	F	84.63	3.62
	<b>S</b>	<b>89.700</b>						<b>84.63</b>	<b>3.62</b>
#5	<b>S</b>	<b>89.700</b>						<b>84.63</b>	<b>3.62</b>

***Subwatershed Time of Concentration Details:***

Stru #	SWS #	Land Flow Condition	Slope (%)	Vert. Dist. (ft)	Horiz. Dist. (ft)	Velocity (fps)	Time (hrs)
#2	1	8. Large gullies, diversions, and low flowing streams	4.59	155.00	3,380.07	6.420	0.146
#2	1	<b>Time of Concentration:</b>					<b>0.146</b>

## **Area 4 North Pond 406**

***The watershed for the impoundment is presented on Exhibit 11-13F. The detail design is presented on Exhibit 11-156.***

***The pond is designed to retain the 100-yr 6-hr storm event, therefore a spillway is not required.***

Ron Van Valkenburg, PE

BHP Billiton  
Navajo Mine  
PO Box 1717  
Fruitland, NM 87416

Phone: 505 598 2007

## ***General Information***

### ***Storm Information:***

Storm Type:	NRCS TYPE II-70
Design Storm:	100 yr - 6 hr
Rainfall Depth:	2.000 inches

**Structure Networking:**

Type	Stru #	(flows into)	Stru #	Musk. K (hrs)	Musk. X	Description
Null	#1	==>	End	0.000	0.000	A4N Pond 406

#1 Null
------------

***Structure Summary:***

	Immediate Contributing Area (ac)	Total Contributing Area (ac)	Peak Discharge (cfs)	Total Runoff Volume (ac-ft)
#1	238.100	238.100	97.07	9.83

***Structure Detail:***

*Structure #1 (Null)*

*A4N Pond 406*

***Subwatershed Hydrology Detail:***

Stru #	SWS #	SWS Area (ac)	Time of Conc (hrs)	Musk K (hrs)	Musk X	Curve Number	UHS	Peak Discharge (cfs)	Runoff Volume (ac-ft)
#1	1	238.100	0.578	0.000	0.000	78.300	M	97.07	9.83
<b>S</b>		<b>238.100</b>						<b>97.07</b>	<b>9.83</b>

***Subwatershed Time of Concentration Details:***

Stru #	SWS #	Land Flow Condition	Slope (%)	Vert. Dist. (ft)	Horiz. Dist. (ft)	Velocity (fps)	Time (hrs)
#1	1	5. Nearly bare and untilled, and alluvial valley fans	1.87	20.00	1,070.03	1.360	0.218
		8. Large gullies, diversions, and low flowing streams	1.00	39.00	3,890.00	3.000	0.360
<b>#1</b>	<b>1</b>	<b>Time of Concentration:</b>					<b>0.578</b>

## **Area 4 North Pond 407**

***The watershed for the impoundment is presented on Exhibit 11-13F. The detail design is presented on Exhibit 11-157.***

***The pond is designed to retain the 100-yr 6-hr storm event, therefore a spillway is not required.***

Ron Van Valkenburg, PE

BHP Billiton  
Navajo Mine  
PO Box 1717  
Fruitland, NM 87416

Phone: 505 598 2007

---

## ***General Information***

### ***Storm Information:***

Storm Type:	NRCS TYPE II-70
Design Storm:	100 yr - 6 hr
Rainfall Depth:	2.000 inches

## Structure Networking:

Type	Stru #	(flows into)	Stru #	Musk. K (hrs)	Musk. X	Description
Null	#1	==>	End	0.000	0.000	A4N Pond 407

#1 Null
------------

## *Structure Summary:*

	Immediate Contributing Area (ac)	Total Contributing Area (ac)	Peak Discharge (cfs)	Total Runoff Volume (ac-ft)
#1	124.800	124.800	142.00	9.98

***Structure Detail:***

*Structure #1 (Null)*

*A4N Pond 407*

***Subwatershed Hydrology Detail:***

Stru #	SWS #	SWS Area (ac)	Time of Conc (hrs)	Musk K (hrs)	Musk X	Curve Number	UHS	Peak Discharge (cfs)	Runoff Volume (ac-ft)
#1	1	124.800	0.306	0.000	0.000	87.900	M	142.00	9.98
<b>S</b>		<b>124.800</b>						<b>142.00</b>	<b>9.98</b>

***Subwatershed Time of Concentration Details:***

Stru #	SWS #	Land Flow Condition	Slope (%)	Vert. Dist. (ft)	Horiz. Dist. (ft)	Velocity (fps)	Time (hrs)
#1	1	5. Nearly bare and untilled, and alluvial valley fans	0.79	6.00	760.00	0.880	0.239
		8. Large gullies, diversions, and low flowing streams	6.41	118.00	1,840.00	7.590	0.067
<b>#1</b>	<b>1</b>	<b>Time of Concentration:</b>					<b>0.306</b>

## **Area 4 North Pond 408**

*The watershed for the impoundment is presented on Exhibit 11-13F. The detail design is presented on Exhibit 11-158.*

*The pond is designed to retain the runoff from the 100 year-6 hour storm event, therefore no spillway required.*

RYazzie

BHP Billiton  
Navajo Mine  
PO Box 1717  
Fruitland, NM 87416

Phone: 505 598 2007

---

## ***General Information***

### ***Storm Information:***

Storm Type:	NRCS TYPE II-70
Design Storm:	100 yr - 6 hr
Rainfall Depth:	2.000 inches

## Structure Networking:

Type	Stru #	(flows into)	Stru #	Musk. K (hrs)	Musk. X	Description
Null	#1	==>	End	0.000	0.000	A4N Pond 408

#1 Null
------------

## *Structure Summary:*

	Immediate Contributing Area (ac)	Total Contributing Area (ac)	Peak Discharge (cfs)	Total Runoff Volume (ac-ft)
#1	6.180	6.180	12.52	0.44

***Structure Detail:***

*Structure #1 (Null)*

*A4N Pond 408*

***Subwatershed Hydrology Detail:***

Stru #	SWS #	SWS Area (ac)	Time of Conc (hrs)	Musk K (hrs)	Musk X	Curve Number	UHS	Peak Discharge (cfs)	Runoff Volume (ac-ft)
#1	1	6.180	0.105	0.000	0.000	86.000	M	12.52	0.44
<b>S</b>		<b>6.180</b>						<b>12.52</b>	<b>0.44</b>

***Subwatershed Time of Concentration Details:***

Stru #	SWS #	Land Flow Condition	Slope (%)	Vert. Dist. (ft)	Horiz. Dist. (ft)	Velocity (fps)	Time (hrs)
#1	1	5. Nearly bare and untilled, and alluvial valley fans	1.33	1.00	75.00	1.150	0.018
		8. Large gullies, diversions, and low flowing streams	0.66	5.10	767.60	2.440	0.087
<b>#1</b>	<b>1</b>	<b>Time of Concentration:</b>					<b>0.105</b>

## **Area 4 North Pond 3**

***The watershed for the impoundment is presented on Exhibit 11-13F. The detail design is presented on Exhibit 11-115.***

***The pond is designed to retain the runoff from the 100 year-6 hour storm event, therefore no spillway required.***

Ron Van Valkenburg, PE

BHP Billiton  
Navajo Mine  
PO Box 1717  
Fruitland, NM 87416

Phone: 505 598 2007

---

## ***General Information***

### ***Storm Information:***

Storm Type:	NRCS TYPE II-70
Design Storm:	100 yr - 6 hr
Rainfall Depth:	2.000 inches

**Structure Networking:**

Type	Stru #	(flows into)	Stru #	Musk. K (hrs)	Musk. X	Description
Null	#1	==>	End	0.000	0.000	Area 4 North Pond 3



***Structure Summary:***

	Immediate Contributing Area (ac)	Total Contributing Area (ac)	Peak Discharge (cfs)	Total Runoff Volume (ac-ft)
#1	8.600	8.600	21.09	0.83

***Structure Detail:***

*Structure #1 (Null)*

*Area 4 North Pond 3*

***Subwatershed Hydrology Detail:***

Stru #	SWS #	SWS Area (ac)	Time of Conc (hrs)	Musk K (hrs)	Musk X	Curve Number	UHS	Peak Discharge (cfs)	Runoff Volume (ac-ft)
#1	1	8.600	0.019	0.000	0.000	91.000	M	21.09	0.833
	<b>Σ</b>	<b>8.600</b>						<b>21.09</b>	<b>0.833</b>

***Subwatershed Time of Concentration Details:***

Stru #	SWS #	Land Flow Condition	Slope (%)	Vert. Dist. (ft)	Horiz. Dist. (ft)	Velocity (fps)	Time (hrs)
#1	1	5. Nearly bare and untilled, and alluvial valley fans	6.00	6.00	100.00	2.440	0.011
		8. Large gullies, diversions, and low flowing streams	20.95	88.00	420.00	13.730	0.008
<b>#1</b>	<b>1</b>	<b>Time of Concentration:</b>					<b>0.019</b>

---

## **Area 4 North Pond 4**

*The watershed for the impoundment is presented on Exhibit 11-13F. The detail design is presented on Exhibit 11-118.*

*The pond is designed to retain the runoff from the 100 year-6 hour storm event, therefore no spillway required.*

Ron Van Valkenburg, PE

BHP Billiton  
Navajo Mine  
PO Box 1717  
Fruitland, NM 87416

Phone: 505 598 2007


## ***General Information***

### ***Storm Information:***

Storm Type:	NRCS TYPE II-70
Design Storm:	100 yr - 6 hr
Rainfall Depth:	2.000 inches

### Structure Networking:

Type	Stru #	(flows into)	Stru #	Musk. K (hrs)	Musk. X	Description
Null	#1	==>	End	0.000	0.000	A4N Pond 4
Channel	#2	==>	#1	0.013	0.443	Southwest Berm to Pond 4
Channel	#3	==>	#1	0.006	0.452	Northeast Berm to Pond 4

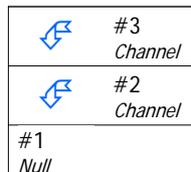

### Structure Routing Details:

Stru #	Land Flow Condition	Slope (%)	Vert. Dist. (ft)	Horiz. Dist. (ft)	Velocity (fps)	Time (hrs)
#2	8. Large gullies, diversions, and low flowing streams	19.68	124.00	630.00	13.30	0.013
<b>#2</b>	<b>Muskingum K:</b>					<b>0.013</b>
#3	8. Large gullies, diversions, and low flowing streams	28.57	100.00	350.00	16.03	0.006
<b>#3</b>	<b>Muskingum K:</b>					<b>0.006</b>

***Structure Summary:***

	Immediate Contributing Area (ac)	Total Contributing Area (ac)	Peak Discharge (cfs)	Total Runoff Volume (ac-ft)
#3	0.200	0.200	0.49	0.02
#2	6.600	6.600	16.19	0.64
#1	39.500	46.300	75.64	4.49

### Structure Detail:

Structure #3 (Erodible Channel)

Northeast Berm to Pond 4

Triangular Erodible Channel Inputs:

Material: Alluvial silts colloidal

Left Sideslope Ratio	Right Sideslope Ratio	Slope (%)	Manning's n	Freeboard Depth (ft)	Freeboard % of Depth	Freeboard Mult. x (VxD)	Limiting Velocity (fps)
2.0:1	2.0:1	1.3	0.0250	1.00			5.0

Erodible Channel Results:

	w/o Freeboard	w/ Freeboard
Depth:	0.35 ft	1.35 ft
Top Width:	1.41 ft	5.41 ft
Velocity:	1.98 fps	
X-Section Area:	0.25 sq ft	
Hydraulic Radius:	0.157	
Froude Number:	0.83	

Structure #2 (Erodible Channel)

Southwest Berm to Pond 4

Trapezoidal Erodible Channel Inputs:

Material: Alluvial silts colloidal

Bottom Width (ft)	Left Sideslope Ratio	Right Sideslope Ratio	Slope (%)	Manning's n	Freeboard Depth (ft)	Freeboard % of Depth	Freeboard Mult. x (VxD)	Limiting Velocity (fps)
6.00	1.5:1	3.0:1	0.2	0.0250	1.00			5.0

Erodible Channel Results:

	w/o Freeboard	w/ Freeboard
Depth:	0.94 ft	1.94 ft
Top Width:	10.21 ft	14.71 ft
Velocity:	2.13 fps	
X-Section Area:	7.59 sq ft	
Hydraulic Radius:	0.715	
Froude Number:	0.44	

**Structure #1 (Null) Area 4N Pond**

### Subwatershed Hydrology Detail:

Stru #	SWS #	SWS Area (ac)	Time of Conc (hrs)	Musk K (hrs)	Musk X	Curve Number	UHS	Peak Discharge (cfs)	Runoff Volume (ac-ft)
#3	1	0.200	0.033	0.000	0.000	91.000	M	0.49	0.02
	<b>S</b>	<b>0.200</b>						<b>0.49</b>	<b>0.02</b>
#2	1	6.600	0.084	0.000	0.000	91.000	M	16.19	0.64
	<b>S</b>	<b>6.600</b>						<b>16.19</b>	<b>0.64</b>
#1	1	39.500	0.133	0.000	0.000	91.000	M	63.76	3.83
	<b>S</b>	<b>46.300</b>						<b>75.64</b>	<b>4.49</b>

### Subwatershed Time of Concentration Details:

Stru #	SWS #	Land Flow Condition	Slope (%)	Vert. Dist. (ft)	Horiz. Dist. (ft)	Velocity (fps)	Time (hrs)
#1	1	5. Nearly bare and untilled, and alluvial valley fans	2.62	15.00	572.01	1.610	0.098
		8. Large gullies, diversions, and low flowing streams	9.89	120.00	1,213.00	9.430	0.035
<b>#1</b>	<b>1</b>	<b>Time of Concentration:</b>					<b>0.133</b>
#2	1	5. Nearly bare and untilled, and alluvial valley fans	6.45	10.00	155.00	2.540	0.016
		8. Large gullies, diversions, and low flowing streams	2.25	25.00	1,110.00	4.500	0.068
<b>#2</b>	<b>1</b>	<b>Time of Concentration:</b>					<b>0.084</b>
#3	1	5. Nearly bare and untilled, and alluvial valley fans	2.22	4.00	180.00	1.490	0.033
<b>#3</b>	<b>1</b>	<b>Time of Concentration:</b>					<b>0.033</b>

---

## **Area 4 North Pond 4**

*The watershed for the impoundment is presented on Exhibit 11-13F. The detail design is presented on Exhibit 11-118.*

*The pond is designed to retain the runoff from the 100 year-6 hour storm event, therefore no spillway required.*

Ron Van Valkenburg, PE

BHP Billiton  
Navajo Mine  
PO Box 1717  
Fruitland, NM 87416

Phone: 505 598 2007


## ***General Information***

### ***Storm Information:***

Storm Type:	NRCS TYPE II-70
Design Storm:	10 yr - 6 hr
Rainfall Depth:	1.300 inches

### Structure Networking:

Type	Stru #	(flows into)	Stru #	Musk. K (hrs)	Musk. X	Description
Null	#1	==>	End	0.000	0.000	A4N Pond 4
Channel	#2	==>	#1	0.013	0.443	Southwest Berm to Pond 4
Channel	#3	==>	#1	0.006	0.452	Northeast Berm to Pond 4

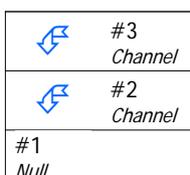

### Structure Routing Details:

Stru #	Land Flow Condition	Slope (%)	Vert. Dist. (ft)	Horiz. Dist. (ft)	Velocity (fps)	Time (hrs)
#2	8. Large gullies, diversions, and low flowing streams	19.68	124.00	630.00	13.30	0.013
<b>#2</b>	<b>Muskingum K:</b>					<b>0.013</b>
#3	8. Large gullies, diversions, and low flowing streams	28.57	100.00	350.00	16.03	0.006
<b>#3</b>	<b>Muskingum K:</b>					<b>0.006</b>

***Structure Summary:***

	Immediate Contributing Area (ac)	Total Contributing Area (ac)	Peak Discharge (cfs)	Total Runoff Volume (ac-ft)
#3	0.200	0.200	0.27	0.01
#2	6.600	6.600	8.98	0.32
#1	39.500	46.300	38.57	2.57

### Structure Detail:

#### Structure #3 (Erodible Channel)

Northeast Berm to Pond 4

Triangular Erodible Channel Inputs:

Material: Alluvial silts colloidal

Left Sideslope Ratio	Right Sideslope Ratio	Slope (%)	Manning's n	Freeboard Depth (ft)	Freeboard % of Depth	Freeboard Mult. x (VxD)	Limiting Velocity (fps)
2.0:1	2.0:1	1.3	0.0250	1.00			5.0

Erodible Channel Results:

	w/o Freeboard	w/ Freeboard
Depth:	0.28 ft	1.28 ft
Top Width:	1.13 ft	5.13 ft
Velocity:	1.72 fps	
X-Section Area:	0.16 sq ft	
Hydraulic Radius:	0.127	
Froude Number:	0.80	

#### Structure #2 (Erodible Channel)

Southwest Berm to Pond 4

Trapezoidal Erodible Channel Inputs:

Material: Alluvial silts colloidal

Bottom Width (ft)	Left Sideslope Ratio	Right Sideslope Ratio	Slope (%)	Manning's n	Freeboard Depth (ft)	Freeboard % of Depth	Freeboard Mult. x (VxD)	Limiting Velocity (fps)
6.00	1.5:1	3.0:1	0.2	0.0250	1.00			5.0

Erodible Channel Results:

	w/o Freeboard	w/ Freeboard
Depth:	0.67 ft	1.67 ft
Top Width:	9.03 ft	13.53 ft
Velocity:	1.77 fps	
X-Section Area:	5.06 sq ft	
Hydraulic Radius:	0.543	
Froude Number:	0.42	

#### Structure #1 (Null) Area 4N Pond

***Subwatershed Hydrology Detail:***

Stru #	SWS #	SWS Area (ac)	Time of Conc (hrs)	Musk K (hrs)	Musk X	Curve Number	UHS	Peak Discharge (cfs)	Runoff Volume (ac-ft)
#3	1	0.200	0.033	0.000	0.000	91.000	M	0.27	0.01
	<b>S</b>	<b>0.200</b>						<b>0.27</b>	<b>0.01</b>
#2	1	6.600	0.084	0.000	0.000	91.000	M	8.98	0.32
	<b>S</b>	<b>6.600</b>						<b>8.98</b>	<b>0.32</b>
#1	1	39.500	0.133	0.000	0.000	91.000	M	33.48	1.91
	<b>S</b>	<b>46.300</b>						<b>38.57</b>	<b>2.57</b>

***Subwatershed Time of Concentration Details:***

Stru #	SWS #	Land Flow Condition	Slope (%)	Vert. Dist. (ft)	Horiz. Dist. (ft)	Velocity (fps)	Time (hrs)
#1	1	5. Nearly bare and untilled, and alluvial valley fans	2.62	15.00	572.01	1.610	0.098
		8. Large gullies, diversions, and low flowing streams	9.89	120.00	1,213.00	9.430	0.035
<b>#1</b>	<b>1</b>	<b>Time of Concentration:</b>					<b>0.133</b>
#2	1	5. Nearly bare and untilled, and alluvial valley fans	6.45	10.00	155.00	2.540	0.016
		8. Large gullies, diversions, and low flowing streams	2.25	25.00	1,110.00	4.500	0.068
<b>#2</b>	<b>1</b>	<b>Time of Concentration:</b>					<b>0.084</b>
#3	1	5. Nearly bare and untilled, and alluvial valley fans	2.22	4.00	180.00	1.490	0.033
<b>#3</b>	<b>1</b>	<b>Time of Concentration:</b>					<b>0.033</b>

# **Area 4 North**

## **Perimeter Road Pond 401**

*The watershed for the impoundment is presented on Exhibit 11-13F. The detail design is presented on Exhibit 11-01.*

*The pond is designed to retain the runoff from the 100 year-6 hour storm event, therefore no spillway required.*

Ron Van Valkenburg, PE

BHP Billiton  
Navajo Mine  
PO Box 1717  
Fruitland, NM 87416

Phone: 505 598 2007

## ***General Information***

### ***Storm Information:***

Storm Type:	NRCS TYPE II-70
Design Storm:	100 yr - 6 hr
Rainfall Depth:	2.000 inches

**Structure Networking:**

Type	Stru #	(flows into)	Stru #	Musk. K (hrs)	Musk. X	Description
Null	#1	==>	End	0.000	0.000	Perimeter Road Pond 401

#1 Null
------------

***Structure Summary:***

	Immediate Contributing Area (ac)	Total Contributing Area (ac)	Peak Discharge (cfs)	Total Runoff Volume (ac-ft)
#1	21.400	21.400	42.07	1.45

---

***Structure Detail:***

*Structure #1 (Null)*

*Perimeter Road Pond 401*

***Subwatershed Hydrology Detail:***

Stru #	SWS #	SWS Area (ac)	Time of Conc (hrs)	Musk K (hrs)	Musk X	Curve Number	UHS	Peak Discharge (cfs)	Runoff Volume (ac-ft)
#1	1	21.400	0.059	0.000	0.000	85.300	M	42.07	1.45
<b>S</b>		<b>21.400</b>						<b>42.07</b>	<b>1.45</b>

***Subwatershed Time of Concentration Details:***

Stru #	SWS #	Land Flow Condition	Slope (%)	Vert. Dist. (ft)	Horiz. Dist. (ft)	Velocity (fps)	Time (hrs)
#1	1	8. Large gullies, diversions, and low flowing streams	4.56	62.00	1,360.00	6.400	0.059
<b>#1</b>	<b>1</b>	<b>Time of Concentration:</b>					<b>0.059</b>

# Area 4 North Perimeter Road Pond 402

*The watershed for the impoundment is presented on Exhibit 11-13F. The detail design is presented on Exhibit 11-02.*

*The pond is designed to retain the runoff from the 100 year-6 hour storm event, therefore no spillway required.*

Ron Van Valkenburg, PE

BHP Billiton  
Navajo Mine  
PO Box 1717  
Fruitland, NM 87416

Phone: 505 598 2007

---


## ***General Information***

### ***Storm Information:***

Storm Type:	NRCS TYPE II-70
Design Storm:	100 yr - 6 hr
Rainfall Depth:	2.000 inches

## Structure Networking:

Type	Stru #	(flows into)	Stru #	Musk. K (hrs)	Musk. X	Description
Null	#1	==>	End	0.000	0.000	Perimeter Road Pond 402
Channel	#2	==>	#1	0.000	0.000	Road Channel-East

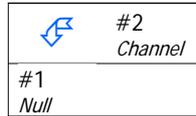

***Structure Summary:***

	Immediate Contributing Area (ac)	Total Contributing Area (ac)	Peak Discharge (cfs)	Total Runoff Volume (ac-ft)
#2	60.800	60.800	88.97	5.21
#1	17.900	78.700	121.10	1.53

### Structure Detail:

Structure #2 (Erodible Channel)

Road Channel-East

Trapezoidal Erodible Channel Inputs:

Material: Shales and hardpans

Bottom Width (ft)	Left Sideslope Ratio	Right Sideslope Ratio	Slope (%)	Manning's n	Freeboard Depth (ft)	Freeboard % of Depth	Freeboard Mult. x (VxD)	Limiting Velocity (fps)
8.00	3.0:1	1.5:1	0.8	0.0250	1.00			6.0

Erodible Channel Results:

	w/o Freeboard	w/ Freeboard
Depth:	1.43 ft	2.43 ft
Top Width:	14.42 ft	18.92 ft
Velocity:	5.56 fps	
X-Section Area:	16.00 sq ft	
Hydraulic Radius:	1.065	
Froude Number:	0.93	

Structure #1 (Null)

Perimeter Road Pond 402

***Subwatershed Hydrology Detail:***

Stru #	SWS #	SWS Area (ac)	Time of Conc (hrs)	Musk K (hrs)	Musk X	Curve Number	UHS	Peak Discharge (cfs)	Runoff Volume (ac-ft)
#2	1	60.800	0.139	0.000	0.000	89.000	M	88.97	5.21
<b>S</b>		<b>60.800</b>						<b>88.97</b>	<b>5.21</b>
#1	1	17.900	0.015	0.000	0.000	89.000	M	40.87	1.53
<b>S</b>		<b>78.700</b>						<b>121.10</b>	<b>1.53</b>

***Subwatershed Time of Concentration Details:***

Stru #	SWS #	Land Flow Condition	Slope (%)	Vert. Dist. (ft)	Horiz. Dist. (ft)	Velocity (fps)	Time (hrs)
#1	1	5. Nearly bare and untilled, and alluvial valley fans	15.00	6.00	40.00	3.870	0.002
		8. Large gullies, diversions, and low flowing streams	15.00	84.00	560.00	11.610	0.013
<b>#1</b>	<b>1</b>	<b>Time of Concentration:</b>					<b>0.015</b>
#2	1	5. Nearly bare and untilled, and alluvial valley fans	6.67	10.00	150.00	2.580	0.016
		8. Large gullies, diversions, and low flowing streams	3.90	103.00	2,640.01	5.920	0.123
<b>#2</b>	<b>1</b>	<b>Time of Concentration:</b>					<b>0.139</b>

## ***General Information***

### ***Storm Information:***

Storm Type:	NRCS TYPE II-70
Design Storm:	10 yr - 24 hr
Rainfall Depth:	1.600 inches

### Structure Networking:

Type	Stru #	(flows into)	Stru #	Musk. K (hrs)	Musk. X	Description
Null	#1	==>	End	0.000	0.000	Perimeter Road Pond 402
Channel	#2	==>	#1	0.000	0.000	Road Channel-East



***Structure Summary:***

	Immediate Contributing Area (ac)	Total Contributing Area (ac)	Peak Discharge (cfs)	Total Runoff Volume (ac-ft)
#2	60.800	60.800	50.91	3.58
#1	17.900	78.700	68.56	6.26

**Structure Detail:**

Structure #2 (Erodible Channel)

*Road Channel-East*

Trapezoidal Erodible Channel Inputs:

Material: Shales and hardpans

Bottom Width (ft)	Left Sideslope Ratio	Right Sideslope Ratio	Slope (%)	Manning's n	Freeboard Depth (ft)	Freeboard % of Depth	Freeboard Mult. x (VxD)	Limiting Velocity (fps)
8.00	3.0:1	1.5:1	0.8	0.0250	1.00			6.0

Erodible Channel Results:

	w/o Freeboard	w/ Freeboard
Depth:	1.05 ft	2.05 ft
Top Width:	12.72 ft	17.22 ft
Velocity:	4.69 fps	
X-Section Area:	10.86 sq ft	
Hydraulic Radius:	0.825	
Froude Number:	0.89	

Structure #1 (Null)

*Perimeter Road Pond 402*

**Subwatershed Hydrology Detail:**

Stru #	SWS #	SWS Area (ac)	Time of Conc (hrs)	Musk K (hrs)	Musk X	Curve Number	UHS	Peak Discharge (cfs)	Runoff Volume (ac-ft)
#2	1	60.800	0.139	0.000	0.000	89.000	M	50.91	3.58
	<b>S</b>	<b>60.800</b>						<b>50.91</b>	<b>3.58</b>
#1	1	17.900	0.015	0.000	0.000	89.000	M	24.18	1.05
	<b>S</b>	<b>78.700</b>						<b>68.56</b>	<b>6.26</b>

**Subwatershed Time of Concentration Details:**

Stru #	SWS #	Land Flow Condition	Slope (%)	Vert. Dist. (ft)	Horiz. Dist. (ft)	Velocity (fps)	Time (hrs)
#1	1	5. Nearly bare and untilled, and alluvial valley fans	15.00	6.00	40.00	3.870	0.002
		8. Large gullies, diversions, and low flowing streams	15.00	84.00	560.00	11.610	0.013
<b>#1</b>	<b>1</b>	<b>Time of Concentration:</b>					<b>0.015</b>
#2	1	5. Nearly bare and untilled, and alluvial valley fans	6.67	10.00	150.00	2.580	0.016
		8. Large gullies, diversions, and low flowing streams	3.90	103.00	2,640.01	5.920	0.123
<b>#2</b>	<b>1</b>	<b>Time of Concentration:</b>					<b>0.139</b>

Material: Riprap

Bottom Width (ft)	Left Sideslope Ratio	Right Sideslope Ratio	Slope (%)	Freeboard Depth (ft)	Freeboard % of Depth	Freeboard Mult. x (VxD)
8.00	3.0:1	3.0:1	12.0	1.00		

Simons/OSM Method - Steep Slope Design

	w/o Freeboard	w/ Freeboard
Depth:	0.48 ft	1.48 ft
Top Width:	10.86 ft	16.86 ft
Velocity*:		
X-Section Area:	4.49 sq ft	
Hydraulic Radius:	0.408	
Froude Number*:		
Manning's n*:		
Dmin:	3.00 in	
D50:	9.00 in	
Dmax:	11.25 in	

Velocity and Manning's n calculations may not apply for this method.

This page is intentionally left blank due to page reformatting

Area 4N Pond 403

REV 1105

Pages 401 through 406

This page is intentionally left blank due to page reformatting

Area 4N Pond 404 and 405

REV 1306

Pages 407 through 422

## **Area 4 North Pond 406**

***The watershed for the impoundment is presented on Exhibit 11-13F. The detail design is presented on Exhibit 11-156.***

***The pond is designed to retain the 100-yr 6-hr storm event, therefore a spillway is not required.***

Ron Van Valkenburg, PE

BHP Billiton  
Navajo Mine  
PO Box 1717  
Fruitland, NM 87416

Phone: 505 598 2007

## ***General Information***

### ***Storm Information:***

Storm Type:	NRCS TYPE II-70
Design Storm:	100 yr - 6 hr
Rainfall Depth:	2.000 inches

**Structure Networking:**

Type	Stru #	(flows into)	Stru #	Musk. K (hrs)	Musk. X	Description
Null	#1	==>	End	0.000	0.000	A4N Pond 406

#1 Null
------------

***Structure Summary:***

	Immediate Contributing Area (ac)	Total Contributing Area (ac)	Peak Discharge (cfs)	Total Runoff Volume (ac-ft)
#1	238.100	238.100	97.07	9.83

---

***Structure Detail:***

*Structure #1 (Null)*

*A4N Pond 406*

**Subwatershed Hydrology Detail:**

Stru #	SWS #	SWS Area (ac)	Time of Conc (hrs)	Musk K (hrs)	Musk X	Curve Number	UHS	Peak Discharge (cfs)	Runoff Volume (ac-ft)
#1	1	238.100	0.578	0.000	0.000	78.300	M	97.07	9.83
<b>S</b>		<b>238.100</b>						<b>97.07</b>	<b>9.83</b>

**Subwatershed Time of Concentration Details:**

Stru #	SWS #	Land Flow Condition	Slope (%)	Vert. Dist. (ft)	Horiz. Dist. (ft)	Velocity (fps)	Time (hrs)
#1	1	5. Nearly bare and untilled, and alluvial valley fans	1.87	20.00	1,070.03	1.360	0.218
		8. Large gullies, diversions, and low flowing streams	1.00	39.00	3,890.00	3.000	0.360
<b>#1</b>	<b>1</b>	<b>Time of Concentration:</b>					<b>0.578</b>

## **Area 4 North Pond 407**

***The watershed for the impoundment is presented on Exhibit 11-13F. The detail design is presented on Exhibit 11-157.***

***The pond is designed to retain the 100-yr 6-hr storm event, therefore a spillway is not required.***

Ron Van Valkenburg, PE

BHP Billiton  
Navajo Mine  
PO Box 1717  
Fruitland, NM 87416

Phone: 505 598 2007

---

## ***General Information***

### ***Storm Information:***

Storm Type:	NRCS TYPE II-70
Design Storm:	100 yr - 6 hr
Rainfall Depth:	2.000 inches

## Structure Networking:

Type	Stru #	(flows into)	Stru #	Musk. K (hrs)	Musk. X	Description
Null	#1	==>	End	0.000	0.000	A4N Pond 407

#1 Null
------------

## *Structure Summary:*

	Immediate Contributing Area (ac)	Total Contributing Area (ac)	Peak Discharge (cfs)	Total Runoff Volume (ac-ft)
#1	124.800	124.800	142.00	9.98

***Structure Detail:***

*Structure #1 (Null)*

*A4N Pond 407*

***Subwatershed Hydrology Detail:***

Stru #	SWS #	SWS Area (ac)	Time of Conc (hrs)	Musk K (hrs)	Musk X	Curve Number	UHS	Peak Discharge (cfs)	Runoff Volume (ac-ft)
#1	1	124.800	0.306	0.000	0.000	87.900	M	142.00	9.98
<b>S</b>		<b>124.800</b>						<b>142.00</b>	<b>9.98</b>

***Subwatershed Time of Concentration Details:***

Stru #	SWS #	Land Flow Condition	Slope (%)	Vert. Dist. (ft)	Horiz. Dist. (ft)	Velocity (fps)	Time (hrs)
#1	1	5. Nearly bare and untilled, and alluvial valley fans	0.79	6.00	760.00	0.880	0.239
		8. Large gullies, diversions, and low flowing streams	6.41	118.00	1,840.00	7.590	0.067
<b>#1</b>	<b>1</b>	<b>Time of Concentration:</b>					<b>0.306</b>

## **Area 4 North Pond 408**

*The watershed for the impoundment is presented on Exhibit 11-13F. The detail design is presented on Exhibit 11-158.*

*The pond is designed to retain the runoff from the 100 year-6 hour storm event, therefore no spillway required.*

RYazzie

BHP Billiton  
Navajo Mine  
PO Box 1717  
Fruitland, NM 87416

Phone: 505 598 2007

---

## ***General Information***

### ***Storm Information:***

Storm Type:	NRCS TYPE II-70
Design Storm:	100 yr - 6 hr
Rainfall Depth:	2.000 inches

## Structure Networking:

Type	Stru #	(flows into)	Stru #	Musk. K (hrs)	Musk. X	Description
Null	#1	==>	End	0.000	0.000	A4N Pond 408

#1 Null
------------

## *Structure Summary:*

	Immediate Contributing Area (ac)	Total Contributing Area (ac)	Peak Discharge (cfs)	Total Runoff Volume (ac-ft)
#1	6.180	6.180	12.52	0.44

***Structure Detail:***

*Structure #1 (Null)*

*A4N Pond 408*

***Subwatershed Hydrology Detail:***

Stru #	SWS #	SWS Area (ac)	Time of Conc (hrs)	Musk K (hrs)	Musk X	Curve Number	UHS	Peak Discharge (cfs)	Runoff Volume (ac-ft)
#1	1	6.180	0.105	0.000	0.000	86.000	M	12.52	0.44
<b>S</b>		<b>6.180</b>						<b>12.52</b>	<b>0.44</b>

***Subwatershed Time of Concentration Details:***

Stru #	SWS #	Land Flow Condition	Slope (%)	Vert. Dist. (ft)	Horiz. Dist. (ft)	Velocity (fps)	Time (hrs)
#1	1	5. Nearly bare and untilled, and alluvial valley fans	1.33	1.00	75.00	1.150	0.018
		8. Large gullies, diversions, and low flowing streams	0.66	5.10	767.60	2.440	0.087
<b>#1</b>	<b>1</b>	<b>Time of Concentration:</b>					<b>0.105</b>

## **Area 4 North Pond 409**

***The watershed for the impoundment is presented on Exhibit 11-13F. The detail design is presented on Exhibit 11-159***

***The pond is designed to retain the runoff from the 100 year-6 hour storm event, therefore no spillway required.***

RYazzie

BHP Billiton  
Navajo Mine  
PO Box 1717  
Fruitland, NM 87416

Phone: 505 598 2007

---

## ***General Information***

### ***Storm Information:***

Storm Type:	NRCS TYPE II-70
Design Storm:	100 yr - 6 hr
Rainfall Depth:	2.000 inches

## Structure Networking:

Type	Stru #	(flows into)	Stru #	Musk. K (hrs)	Musk. X	Description
Null	#1	==>	End	0.000	0.000	A4N Pond 409

#1 Null
------------

## *Structure Summary:*

	Immediate Contributing Area (ac)	Total Contributing Area (ac)	Peak Discharge (cfs)	Total Runoff Volume (ac-ft)
#1	2.830	2.830	5.73	0.20

***Structure Detail:***

*Structure #1 (Null)*

*A4N Pond 409*

***Subwatershed Hydrology Detail:***

Stru #	SWS #	SWS Area (ac)	Time of Conc (hrs)	Musk K (hrs)	Musk X	Curve Number	UHS	Peak Discharge (cfs)	Runoff Volume (ac-ft)
#1	1	2.830	0.044	0.000	0.000	86.000	M	5.73	0.20
<b>S</b>		<b>2.830</b>						<b>5.73</b>	<b>0.20</b>

***Subwatershed Time of Concentration Details:***

Stru #	SWS #	Land Flow Condition	Slope (%)	Vert. Dist. (ft)	Horiz. Dist. (ft)	Velocity (fps)	Time (hrs)
#1	1	5. Nearly bare and untilled, and alluvial valley fans	5.12	2.90	56.60	2.260	0.006
		8. Large gullies, diversions, and low flowing streams	2.24	13.80	614.75	4.490	0.038
<b>#1</b>	<b>1</b>	<b>Time of Concentration:</b>					<b>0.044</b>

## **Area 4 North Pond 410**

*The watershed for the impoundment is presented on Exhibit 11-13F. The detail design is presented on Exhibit 11-159*

*The pond is design to retain the runoff from the 100 year-6 hour storm event, therefore no spillway required.*

RYazzie

BHP Billiton  
Navajo Mine  
PO Box 1717  
Fruitland, NM 87416

Phone: 505 598 2007

---

## ***General Information***

### ***Storm Information:***

Storm Type:	NRCS TYPE II-70
Design Storm:	100 yr - 6 hr
Rainfall Depth:	2.000 inches

## Structure Networking:

Type	Stru #	(flows into)	Stru #	Musk. K (hrs)	Musk. X	Description
Null	#1	==>	End	0.000	0.000	A4N Pond 410

#1 Null
------------

## *Structure Summary:*

	Immediate Contributing Area (ac)	Total Contributing Area (ac)	Peak Discharge (cfs)	Total Runoff Volume (ac-ft)
#1	2.370	2.370	4.80	0.17

***Structure Detail:***

*Structure #1 (Null)*

*A4N Pond 410*

***Subwatershed Hydrology Detail:***

Stru #	SWS #	SWS Area (ac)	Time of Conc (hrs)	Musk K (hrs)	Musk X	Curve Number	UHS	Peak Discharge (cfs)	Runoff Volume (ac-ft)
#1	1	2.370	0.059	0.000	0.000	86.000	M	4.80	0.17
<b>S</b>		<b>2.370</b>						<b>4.80</b>	<b>0.17</b>

***Subwatershed Time of Concentration Details:***

Stru #	SWS #	Land Flow Condition	Slope (%)	Vert. Dist. (ft)	Horiz. Dist. (ft)	Velocity (fps)	Time (hrs)
#1	1	5. Nearly bare and untilled, and alluvial valley fans	1.67	1.90	113.50	1.290	0.024
		8. Large gullies, diversions, and low flowing streams	1.76	9.00	510.00	3.980	0.035
<b>#1</b>	<b>1</b>	<b>Time of Concentration:</b>					<b>0.059</b>

---

## **Area 4 North Pond 411**

***The watershed for the impoundment is presented on Exhibit 11-13F. The detail design is presented on Exhibit 11-161***

***The pond is designed to retain the runoff from the 100 year-6 hour storm event, therefore no spillway required.***

Ron Van Valkenburg, PE

BHP Billiton  
Navajo Mine  
PO Box 1717  
Fruitland, NM 87416

Phone: 505 598 2007

---

## ***General Information***

### ***Storm Information:***

Storm Type:	NRCS TYPE II-70
Design Storm:	100 yr - 6 hr
Rainfall Depth:	2.000 inches

**Structure Networking:**

Type	Stru #	(flows into)	Stru #	Musk. K (hrs)	Musk. X	Description
Null	#1	==>	End	0.000	0.000	A4N Pond 411



***Structure Summary:***

	Immediate Contributing Area (ac)	Total Contributing Area (ac)	Peak Discharge (cfs)	Total Runoff Volume (ac-ft)
#1	12.500	12.500	30.66	1.21

***Structure Detail:***

*Structure #1 (Null)*

*A4N Pond 411*

***Subwatershed Hydrology Detail:***

Stru #	SWS #	SWS Area (ac)	Time of Conc (hrs)	Musk K (hrs)	Musk X	Curve Number	UHS	Peak Discharge (cfs)	Runoff Volume (ac-ft)
#1	1	12.500	0.077	0.000	0.000	91.000	M	30.66	1.210
	<b>Σ</b>	<b>12.500</b>						<b>30.66</b>	<b>1.210</b>

***Subwatershed Time of Concentration Details:***

Stru #	SWS #	Land Flow Condition	Slope (%)	Vert. Dist. (ft)	Horiz. Dist. (ft)	Velocity (fps)	Time (hrs)
#1	1	5. Nearly bare and untilled, and alluvial valley fans	1.79	5.00	280.00	1.330	0.058
		8. Large gullies, diversions, and low flowing streams	9.85	65.00	660.00	9.410	0.019
<b>#1</b>	<b>1</b>	<b>Time of Concentration:</b>					<b>0.077</b>

## **Area 4 North Pond 412**

***The watershed for the impoundment is presented on Exhibit 11-13F. The detail design is presented on Exhibit 11-111.***

***The pond is designed to retain the runoff from the 100 yr-6 hr storm event, therefore no spillway required.***

***The ditch that diverts the flows to the pond and the inlet structures are designed to be stable for the 10 yr- 6 hr and 25 yr- 6 hr storm events, respectively.***

Ron Van Valkenburg, PE

BHP Billiton  
Navajo Mine  
PO Box 1717  
Fruitland, NM 87416

Phone: 505 598 2007

---


***General Information***

***Storm Information:***

Storm Type:	NRCS TYPE II-70
Design Storm:	100 yr - 6 hr
Rainfall Depth:	2.000 inches

### Structure Networking:

Type	Stru #	(flows into)	Stru #	Musk. K (hrs)	Musk. X	Description
Channel	#1	==>	#3	0.002	0.454	Drainage Ditch
Null	#2	==>	End	0.000	0.000	A4N Pond 412
Channel	#3	==>	#2	0.004	0.423	Inlet B (West)
Channel	#4	==>	#2	0.002	0.441	Inlet A (South)

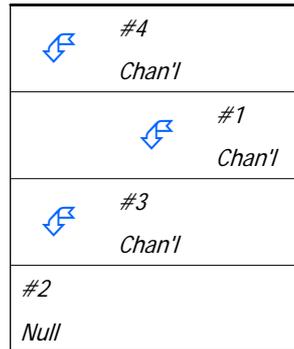

### Structure Routing Details:

Stru #	Land Flow Condition	Slope (%)	Vert. Dist. (ft)	Horiz. Dist. (ft)	Velocity (fps)	Time (hrs)
#1	8. Large gullies, diversions, and low flowing streams	31.72	46.00	145.00	16.89	0.002
<b>#1</b>	<b>Muskingum K:</b>					<b>0.002</b>
#3	8. Large gullies, diversions, and low flowing streams	9.55	15.00	157.00	9.27	0.004
<b>#3</b>	<b>Muskingum K:</b>					<b>0.004</b>
#4	8. Large gullies, diversions, and low flowing streams	18.09	17.00	94.00	12.75	0.002
<b>#4</b>	<b>Muskingum K:</b>					<b>0.002</b>

***Structure Summary:***

	Immediate Contributing Area (ac)	Total Contributing Area (ac)	Peak Discharge (cfs)	Total Runoff Volume (ac-ft)
#4	10.900	10.900	26.73	1.06
#1	5.300	5.300	13.00	0.51
#3	3.400	8.700	21.34	0.84
#2	11.000	30.600	75.05	2.96

### Structure Detail:

Structure #4 (Riprap Channel)

*Inlet A (South)*

Trapezoidal Riprap Channel Inputs:

Material: Riprap

Bottom Width (ft)	Left Sideslope Ratio	Right Sideslope Ratio	Slope (%)	Freeboard Depth (ft)	Freeboard % of Depth	Freeboard Mult. x (VxD)
10.00	3.0:1	3.0:1	18.0	1.00		

Riprap Channel Results:

#### Simons/OSM Method - Steep Slope Design

	w/o Freeboard	w/ Freeboard
Design Discharge:	26.73 cfs	
Depth:	0.21 ft	1.21 ft
Top Width:	11.26 ft	17.26 ft
Velocity*:		
X-Section Area:	2.24 sq ft	
Hydraulic Radius:	0.197 ft	
Froude Number*:		
Manning's n*:		
Dmin:	3.00 in	
D50:	9.00 in	
Dmax:	11.25 in	

Velocity and Manning's n calculations may not apply for this method.

Structure #1 (Erodible Channel)

*Drainage Ditch*

Trapezoidal Erodible Channel Inputs:

Material: Stiff clay very colloidal

Bottom Width (ft)	Left Sideslope Ratio	Right Sideslope Ratio	Slope (%)	Manning's n	Freeboard Depth (ft)	Freeboard % of Depth	Freeboard Mult. x (VxD)	Limiting Velocity (fps)
4.00	3.0:1	3.0:1	3.2	0.0280	1.00			5.0

Erodible Channel Results:

	w/o Freeboard	w/ Freeboard
Design Discharge:	13.00 cfs	
Depth:	0.48 ft	1.48 ft
Top Width:	6.90 ft	12.90 ft
Velocity:	4.94 fps	
X-Section Area:	2.63 sq ft	
Hydraulic Radius:	0.373 ft	
Froude Number:	1.41	

Structure #3 (Riprap Channel)

*Inlet B (West)*

Trapezoidal Riprap Channel Inputs:

Material: Riprap

Bottom Width (ft)	Left Sideslope Ratio	Right Sideslope Ratio	Slope (%)	Freeboard Depth (ft)	Freeboard % of Depth	Freeboard Mult. x (VxD)
6.00	3.0:1	3.0:1	10.0	1.00		

Riprap Channel Results:

Simons/OSM Method - Steep Slope Design

	w/o Freeboard	w/ Freeboard
Design Discharge:	21.34 cfs	
Depth:	0.30 ft	1.30 ft
Top Width:	7.81 ft	13.81 ft
Velocity*:		
X-Section Area:	2.08 sq ft	
Hydraulic Radius:	0.263 ft	
Froude Number*:		
Manning's n*:		
Dmin:	2.00 in	
D50:	6.00 in	
Dmax:	7.50 in	

Velocity and Manning's n calculations may not apply for this method.

Structure #2 (Null)

*A4N Pond 412*

### Subwatershed Hydrology Detail:

Stru #	SWS #	SWS Area (ac)	Time of Conc (hrs)	Musk K (hrs)	Musk X	Curve Number	UHS	Peak Discharge (cfs)	Runoff Volume (ac-ft)
#4	1	10.900	0.108	0.000	0.000	91.000	M	26.73	1.055
	<b>Σ</b>	<b>10.900</b>						<b>26.73</b>	<b>1.055</b>
#1	1	5.300	0.064	0.000	0.000	91.000	M	13.00	0.513
	<b>Σ</b>	<b>5.300</b>						<b>13.00</b>	<b>0.513</b>
#3	1	3.400	0.031	0.000	0.000	91.000	M	8.34	0.329
	<b>Σ</b>	<b>8.700</b>						<b>21.34</b>	<b>0.842</b>
#2	1	11.000	0.082	0.000	0.000	91.000	M	26.98	1.065
	<b>Σ</b>	<b>30.600</b>						<b>75.05</b>	<b>2.963</b>

### Subwatershed Time of Concentration Details:

Stru #	SWS #	Land Flow Condition	Slope (%)	Vert. Dist. (ft)	Horiz. Dist. (ft)	Velocity (fps)	Time (hrs)
#1	1	5. Nearly bare and untilled, and alluvial valley fans	2.00	2.00	100.00	1.410	0.019
		8. Large gullies, diversions, and low flowing streams	4.69	50.00	1,065.00	6.500	0.045
<b>#1</b>	<b>1</b>	<b>Time of Concentration:</b>					<b>0.064</b>
#2	1	5. Nearly bare and untilled, and alluvial valley fans	2.50	10.00	400.00	1.580	0.070
		8. Large gullies, diversions, and low flowing streams	17.86	100.00	560.00	12.670	0.012
<b>#2</b>	<b>1</b>	<b>Time of Concentration:</b>					<b>0.082</b>
#3	1	5. Nearly bare and untilled, and alluvial valley fans	4.00	4.00	100.00	2.000	0.013
		8. Large gullies, diversions, and low flowing streams	13.24	94.00	710.00	10.910	0.018
<b>#3</b>	<b>1</b>	<b>Time of Concentration:</b>					<b>0.031</b>
#4	1	5. Nearly bare and untilled, and alluvial valley fans	2.44	10.00	410.00	1.560	0.073
		8. Large gullies, diversions, and low flowing streams	8.51	94.00	1,105.00	8.740	0.035
<b>#4</b>	<b>1</b>	<b>Time of Concentration:</b>					<b>0.108</b>

## **Area 4 North Pond 412**

***The watershed for the impoundment is presented on Exhibit 11-13F. The detail design is presented on Exhibit 11-111.***

***The pond is designed to retain the runoff from the 100 yr-6 hr storm event, therefore no spillway required.***

***The ditch that diverts the flows to the pond and the inlet structures are designed to be stable for the 10 yr- 6 hr and 25 yr- 6 hr storm events, respectively.***

Ron Van Valkenburg, PE

BHP Billiton  
Navajo Mine  
PO Box 1717  
Fruitland, NM 87416

Phone: 505 598 2007

## ***General Information***

### ***Storm Information:***

Storm Type:	NRCS TYPE II-70
Design Storm:	10 yr - 6 hr
Rainfall Depth:	1.300 inches

### Structure Networking:

Type	Stru #	(flows into)	Stru #	Musk. K (hrs)	Musk. X	Description
Channel	#1	==>	#3	0.002	0.454	Drainage Ditch
Null	#2	==>	End	0.000	0.000	A4N Pond 412
Channel	#3	==>	#2	0.004	0.423	Inlet B (West)
Channel	#4	==>	#2	0.002	0.441	Inlet A (South)



### Structure Routing Details:

Stru #	Land Flow Condition	Slope (%)	Vert. Dist. (ft)	Horiz. Dist. (ft)	Velocity (fps)	Time (hrs)
#1	8. Large gullies, diversions, and low flowing streams	31.72	46.00	145.00	16.89	0.002
<b>#1</b>	<b>Muskingum K:</b>					<b>0.002</b>
#3	8. Large gullies, diversions, and low flowing streams	9.55	15.00	157.00	9.27	0.004
<b>#3</b>	<b>Muskingum K:</b>					<b>0.004</b>
#4	8. Large gullies, diversions, and low flowing streams	18.09	17.00	94.00	12.75	0.002
<b>#4</b>	<b>Muskingum K:</b>					<b>0.002</b>

***Structure Summary:***

	Immediate Contributing Area (ac)	Total Contributing Area (ac)	Peak Discharge (cfs)	Total Runoff Volume (ac-ft)
#4	10.900	10.900	14.83	0.53
#1	5.300	5.300	7.21	0.26
#3	3.400	8.700	11.84	0.42
#2	11.000	30.600	41.64	1.48

### Structure Detail:

#### Structure #4 (Riprap Channel)

##### Inlet A (South)

Trapezoidal Riprap Channel Inputs:

##### Material: Riprap

Bottom Width (ft)	Left Sideslope Ratio	Right Sideslope Ratio	Slope (%)	Freeboard Depth (ft)	Freeboard % of Depth	Freeboard Mult. x (VxD)
10.00	3.0:1	3.0:1	18.0	1.00		

Riprap Channel Results:

##### Simons/OSM Method - Steep Slope Design

	w/o Freeboard	w/ Freeboard
Design Discharge:	14.83 cfs	
Depth:	0.13 ft	1.13 ft
Top Width:	10.79 ft	16.79 ft
Velocity*:		
X-Section Area:	1.38 sq ft	
Hydraulic Radius:	0.127 ft	
Froude Number*:		
Manning's n*:		
Dmin:	2.00 in	
D50:	6.00 in	
Dmax:	7.50 in	

Velocity and Manning's n calculations may not apply for this method.

#### Structure #1 (Erodible Channel)

##### Drainage Ditch

Triangular Erodible Channel Inputs:

##### Material: Stiff clay very colloidal

Left Sideslope Ratio	Right Sideslope Ratio	Slope (%)	Manning's n	Freeboard Depth (ft)	Freeboard % of Depth	Freeboard Mult. x (VxD)	Limiting Velocity (fps)
2.0:1	2.0:1	3.2	0.0280	1.00			5.0

Erodible Channel Results:

	w/o Freeboard	w/ Freeboard
Design Discharge:	7.21 cfs	
Depth:	0.85 ft	1.85 ft
Top Width:	3.40 ft	7.40 ft

	w/o Freeboard	w/ Freeboard
Velocity:	4.99 fps	
X-Section Area:	1.44 sq ft	
Hydraulic Radius:	0.380 ft	
Froude Number:	1.35	

Structure #3 (Riprap Channel)

*Inlet B (West)*

Trapezoidal Riprap Channel Inputs:

Material: Riprap

Bottom Width (ft)	Left Sideslope Ratio	Right Sideslope Ratio	Slope (%)	Freeboard Depth (ft)	Freeboard % of Depth	Freeboard Mult. x (VxD)
6.00	3.0:1	3.0:1	10.0	1.00		

Riprap Channel Results:

Simons/OSM Method - Steep Slope Design

	w/o Freeboard	w/ Freeboard
Design Discharge:	11.84 cfs	
Depth:	0.19 ft	1.19 ft
Top Width:	7.15 ft	13.15 ft
Velocity*:		
X-Section Area:	1.26 sq ft	
Hydraulic Radius:	0.175 ft	
Froude Number*:		
Manning's n*:		
Dmin:	2.00 in	
D50:	6.00 in	
Dmax:	7.50 in	

Velocity and Manning's n calculations may not apply for this method.

Structure #2 (Null)

*A4N Pond 412*

### Subwatershed Hydrology Detail:

Stru #	SWS #	SWS Area (ac)	Time of Conc (hrs)	Musk K (hrs)	Musk X	Curve Number	UHS	Peak Discharge (cfs)	Runoff Volume (ac-ft)
#4	1	10.900	0.108	0.000	0.000	91.000	M	14.83	0.527
	<b>Σ</b>	<b>10.900</b>						<b>14.83</b>	<b>0.527</b>
#1	1	5.300	0.064	0.000	0.000	91.000	M	7.21	0.256
	<b>Σ</b>	<b>5.300</b>						<b>7.21</b>	<b>0.256</b>
#3	1	3.400	0.031	0.000	0.000	91.000	M	4.63	0.164
	<b>Σ</b>	<b>8.700</b>						<b>11.84</b>	<b>0.420</b>
#2	1	11.000	0.082	0.000	0.000	91.000	M	14.97	0.532
	<b>Σ</b>	<b>30.600</b>						<b>41.64</b>	<b>1.479</b>

### Subwatershed Time of Concentration Details:

Stru #	SWS #	Land Flow Condition	Slope (%)	Vert. Dist. (ft)	Horiz. Dist. (ft)	Velocity (fps)	Time (hrs)
#1	1	5. Nearly bare and untilled, and alluvial valley fans	2.00	2.00	100.00	1.410	0.019
		8. Large gullies, diversions, and low flowing streams	4.69	50.00	1,065.00	6.500	0.045
<b>#1</b>	<b>1</b>	<b>Time of Concentration:</b>					<b>0.064</b>
#2	1	5. Nearly bare and untilled, and alluvial valley fans	2.50	10.00	400.00	1.580	0.070
		8. Large gullies, diversions, and low flowing streams	17.86	100.00	560.00	12.670	0.012
<b>#2</b>	<b>1</b>	<b>Time of Concentration:</b>					<b>0.082</b>
#3	1	5. Nearly bare and untilled, and alluvial valley fans	4.00	4.00	100.00	2.000	0.013
		8. Large gullies, diversions, and low flowing streams	13.24	94.00	710.00	10.910	0.018
<b>#3</b>	<b>1</b>	<b>Time of Concentration:</b>					<b>0.031</b>
#4	1	5. Nearly bare and untilled, and alluvial valley fans	2.44	10.00	410.00	1.560	0.073
		8. Large gullies, diversions, and low flowing streams	8.51	94.00	1,105.00	8.740	0.035
<b>#4</b>	<b>1</b>	<b>Time of Concentration:</b>					<b>0.108</b>

## **Area 4 North Pond 412**

***The watershed for the impoundment is presented on Exhibit 11-13F. The detail design is presented on Exhibit 11-111.***

***The pond is designed to retain the runoff from the 100 yr-6 hr storm event, therefore no spillway required.***

***The ditch that diverts the flows to the pond and the inlet structures are designed to be stable for the 10 yr- 6 hr and 25 yr- 6 hr storm events, respectively.***

Ron Van Valkenburg, PE

BHP Billiton  
Navajo Mine  
PO Box 1717  
Fruitland, NM 87416

Phone: 505 598 2007

---

## ***General Information***

### ***Storm Information:***

Storm Type:	NRCS TYPE II-70
Design Storm:	25 yr - 6 hr
Rainfall Depth:	1.600 inches

### Structure Networking:

Type	Stru #	(flows into)	Stru #	Musk. K (hrs)	Musk. X	Description
Channel	#1	==>	#3	0.002	0.454	Drainage Ditch
Null	#2	==>	End	0.000	0.000	A4N Pond 412
Channel	#3	==>	#2	0.004	0.423	Inlet B (West)
Channel	#4	==>	#2	0.002	0.441	Inlet A (South)



### Structure Routing Details:

Stru #	Land Flow Condition	Slope (%)	Vert. Dist. (ft)	Horiz. Dist. (ft)	Velocity (fps)	Time (hrs)
#1	8. Large gullies, diversions, and low flowing streams	31.72	46.00	145.00	16.89	0.002
<b>#1</b>	<b>Muskingum K:</b>					<b>0.002</b>
#3	8. Large gullies, diversions, and low flowing streams	9.55	15.00	157.00	9.27	0.004
<b>#3</b>	<b>Muskingum K:</b>					<b>0.004</b>
#4	8. Large gullies, diversions, and low flowing streams	18.09	17.00	94.00	12.75	0.002
<b>#4</b>	<b>Muskingum K:</b>					<b>0.002</b>

***Structure Summary:***

	Immediate Contributing Area (ac)	Total Contributing Area (ac)	Peak Discharge (cfs)	Total Runoff Volume (ac-ft)
#4	10.900	10.900	19.91	0.75
#1	5.300	5.300	9.68	0.36
#3	3.400	8.700	15.89	0.60
#2	11.000	30.600	55.89	2.09

### Structure Detail:

Structure #4 (Riprap Channel)

Inlet A (South)

Trapezoidal Riprap Channel Inputs:

Material: Riprap

Bottom Width (ft)	Left Sideslope Ratio	Right Sideslope Ratio	Slope (%)	Freeboard Depth (ft)	Freeboard % of Depth	Freeboard Mult. x (VxD)
10.00	3.0:1	3.0:1	18.0	1.00		

Riprap Channel Results:

Simons/OSM Method - Steep Slope Design

	w/o Freeboard	w/ Freeboard
Design Discharge:	19.91 cfs	
Depth:	0.17 ft	1.17 ft
Top Width:	11.00 ft	17.00 ft
Velocity*:		
X-Section Area:	1.75 sq ft	
Hydraulic Radius:	0.158 ft	
Froude Number*:		
Manning's n*:		
Dmin:	2.00 in	
D50:	6.00 in	
Dmax:	7.50 in	

Velocity and Manning's n calculations may not apply for this method.

Structure #1 (Erodible Channel)

Drainage Ditch

Trapezoidal Erodible Channel Inputs:

Material: Stiff clay very colloidal

Bottom Width (ft)	Left Sideslope Ratio	Right Sideslope Ratio	Slope (%)	Manning's n	Freeboard Depth (ft)	Freeboard % of Depth	Freeboard Mult. x (VxD)	Limiting Velocity (fps)
4.00	3.0:1	3.0:1	3.2	0.0280	1.00			5.0

Erodible Channel Results:

	w/o Freeboard	w/ Freeboard
Design Discharge:	9.68 cfs	
Depth:	0.41 ft	1.41 ft
Top Width:	6.46 ft	12.46 ft
Velocity:	4.50 fps	
X-Section Area:	2.15 sq ft	
Hydraulic Radius:	0.326 ft	
Froude Number:	1.38	

Structure #3 (Riprap Channel)

*Inlet B (West)*

Trapezoidal Riprap Channel Inputs:

Material: Riprap

Bottom Width (ft)	Left Sideslope Ratio	Right Sideslope Ratio	Slope (%)	Freeboard Depth (ft)	Freeboard % of Depth	Freeboard Mult. x (VxD)
6.00	3.0:1	3.0:1	10.0	1.00		

Riprap Channel Results:

Simons/OSM Method - Steep Slope Design

	w/o Freeboard	w/ Freeboard
Design Discharge:	15.89 cfs	
Depth:	0.24 ft	1.24 ft
Top Width:	7.44 ft	13.44 ft
Velocity*:		
X-Section Area:	1.61 sq ft	
Hydraulic Radius:	0.214 ft	
Froude Number*:		
Manning's n*:		
Dmin:	2.00 in	
D50:	6.00 in	
Dmax:	7.50 in	

Velocity and Manning's n calculations may not apply for this method.

Structure #2 (Null)

*A4N Pond 412*

### *Subwatershed Hydrology Detail:*

Stru #	SWS #	SWS Area (ac)	Time of Conc (hrs)	Musk K (hrs)	Musk X	Curve Number	UHS	Peak Discharge (cfs)	Runoff Volume (ac-ft)
#4	1	10.900	0.108	0.000	0.000	91.000	M	19.91	0.746
	<b>Σ</b>	<b>10.900</b>						<b>19.91</b>	<b>0.746</b>
#1	1	5.300	0.064	0.000	0.000	91.000	M	9.68	0.363
	<b>Σ</b>	<b>5.300</b>						<b>9.68</b>	<b>0.363</b>
#3	1	3.400	0.031	0.000	0.000	91.000	M	6.21	0.233
	<b>Σ</b>	<b>8.700</b>						<b>15.89</b>	<b>0.595</b>
#2	1	11.000	0.082	0.000	0.000	91.000	M	20.09	0.753
	<b>Σ</b>	<b>30.600</b>						<b>55.89</b>	<b>2.093</b>

### *Subwatershed Time of Concentration Details:*

Stru #	SWS #	Land Flow Condition	Slope (%)	Vert. Dist. (ft)	Horiz. Dist. (ft)	Velocity (fps)	Time (hrs)
#1	1	5. Nearly bare and untilled, and alluvial valley fans	2.00	2.00	100.00	1.410	0.019
		8. Large gullies, diversions, and low flowing streams	4.69	50.00	1,065.00	6.500	0.045
<b>#1</b>	<b>1</b>	<b>Time of Concentration:</b>					<b>0.064</b>
#2	1	5. Nearly bare and untilled, and alluvial valley fans	2.50	10.00	400.00	1.580	0.070
		8. Large gullies, diversions, and low flowing streams	17.86	100.00	560.00	12.670	0.012
<b>#2</b>	<b>1</b>	<b>Time of Concentration:</b>					<b>0.082</b>
#3	1	5. Nearly bare and untilled, and alluvial valley fans	4.00	4.00	100.00	2.000	0.013
		8. Large gullies, diversions, and low flowing streams	13.24	94.00	710.00	10.910	0.018
<b>#3</b>	<b>1</b>	<b>Time of Concentration:</b>					<b>0.031</b>
#4	1	5. Nearly bare and untilled, and alluvial valley fans	2.44	10.00	410.00	1.560	0.073
		8. Large gullies, diversions, and low flowing streams	8.51	94.00	1,105.00	8.740	0.035
<b>#4</b>	<b>1</b>	<b>Time of Concentration:</b>					<b>0.108</b>

## **Area 4 North Pond 413**

***The watershed for the impoundment is presented on Exhibit 11-13F. The detail design is presented on Exhibit 11-6.***

***The pond is designed to retain the runoff from the 100 yr-6 hr storm event, therefore no spillway required.***

***The ditch that diverts the flows to the pond and the inlet structures are designed to be stable for the 10 yr- 6 hr and 25 yr- 6 hr storm events, respectively.***

Ron Van Valkenburg, PE

BHP Billiton  
Navajo Mine  
PO Box 1717  
Fruitland, NM 87416

Phone: 505 598 2007

---

## ***General Information***

### ***Storm Information:***

Storm Type:	NRCS TYPE II-70
Design Storm:	100 yr - 6 hr
Rainfall Depth:	2.000 inches

### Structure Networking:

Type	Stru #	(flows into)	Stru #	Musk. K (hrs)	Musk. X	Description
Channel	#1	==>	#3	0.003	0.458	Berm V-ditch
Null	#2	==>	End	0.000	0.000	A4N Pond 413
Channel	#3	==>	#2	0.000	0.000	Inlet B (West)
Channel	#4	==>	#2	0.000	0.000	Inlet A (East)



### Structure Routing Details:

Stru #	Land Flow Condition	Slope (%)	Vert. Dist. (ft)	Horiz. Dist. (ft)	Velocity (fps)	Time (hrs)
#1	8. Large gullies, diversions, and low flowing streams	37.73	83.00	220.00	18.42	0.003
<b>#1</b>	<b>Muskingum K:</b>					<b>0.003</b>
#4	8. Large gullies, diversions, and low flowing streams	0.00	0.00	0.00	0.00	0.000
<b>#4</b>	<b>Muskingum K:</b>					<b>0.000</b>

***Structure Summary:***

	Immediate Contributing Area (ac)	Total Contributing Area (ac)	Peak Discharge (cfs)	Total Runoff Volume (ac-ft)
#4	5.500	5.500	13.49	0.53
#1	1.300	1.300	2.10	0.10
#3	0.500	1.800	3.17	0.15
#2	3.000	10.300	24.02	0.97

**Structure Detail:**

Structure #4 (Riprap Channel)

*Inlet A (East)*

Trapezoidal Riprap Channel Inputs:

Material: Riprap

Bottom Width (ft)	Left Sideslope Ratio	Right Sideslope Ratio	Slope (%)	Freeboard Depth (ft)	Freeboard % of Depth	Freeboard Mult. x (VxD)
6.00	3.0:1	3.0:1	15.2	1.00		

Riprap Channel Results:

Simons/OSM Method - Steep Slope Design

	w/o Freeboard	w/ Freeboard
Design Discharge:	13.49 cfs	
Depth:	0.18 ft	1.18 ft
Top Width:	7.07 ft	13.07 ft
Velocity*:		
X-Section Area:	1.16 sq ft	
Hydraulic Radius:	0.163 ft	
Froude Number*:		
Manning's n*:		
Dmin:	3.00 in	
D50:	9.00 in	
Dmax:	11.25 in	

Velocity and Manning's n calculations may not apply for this method.

Structure #1 (Erodible Channel)

*Berm V-ditch*

Triangular Erodible Channel Inputs:

Material: Stiff clay very colloidal

Left Sideslope Ratio	Right Sideslope Ratio	Slope (%)	Manning's n	Freeboard Depth (ft)	Freeboard % of Depth	Freeboard Mult. x (VxD)	Limiting Velocity (fps)
1.5:1	1.5:1	2.0	0.0280	1.00			5.0

Erodible Channel Results:

	w/o Freeboard	w/ Freeboard
Design Discharge:	2.10 cfs	
Depth:	0.66 ft	1.66 ft
Top Width:	1.99 ft	4.99 ft
Velocity:	3.19 fps	
X-Section Area:	0.66 sq ft	
Hydraulic Radius:	0.276 ft	
Froude Number:	0.98	

Structure #3 (Riprap Channel)

*Inlet B (West)*

Trapezoidal Riprap Channel Inputs:

Material: Riprap

Bottom Width (ft)	Left Sideslope Ratio	Right Sideslope Ratio	Slope (%)	Freeboard Depth (ft)	Freeboard % of Depth	Freeboard Mult. x (VxD)
4.00	3.0:1	3.0:1	32.0	1.00		

Riprap Channel Results:

Simons/OSM Method - Steep Slope Design

	w/o Freeboard	w/ Freeboard
Design Discharge:	3.17 cfs	
Depth:	0.05 ft	1.05 ft
Top Width:	4.27 ft	10.27 ft
Velocity*:		
X-Section Area:	0.19 sq ft	
Hydraulic Radius:	0.044 ft	
Froude Number*:		
Manning's n*:		
Dmin:	4.00 in	
D50:	12.00 in	
Dmax:	15.00 in	

Velocity and Manning's n calculations may not apply for this method.

Structure #2 (Null)

*A4N Pond 413*

### Subwatershed Hydrology Detail:

Stru #	SWS #	SWS Area (ac)	Time of Conc (hrs)	Musk K (hrs)	Musk X	Curve Number	UHS	Peak Discharge (cfs)	Runoff Volume (ac-ft)
#4	1	5.500	0.120	0.002	0.431	91.000	M	13.49	0.533
	<b>Σ</b>	<b>5.500</b>						<b>13.49</b>	<b>0.533</b>
#1	1	1.300	0.156	0.000	0.000	91.000	M	2.10	0.102
	<b>Σ</b>	<b>1.300</b>						<b>2.10</b>	<b>0.102</b>
#3	1	0.500	0.011	0.000	0.455	91.000	M	1.23	0.048
	<b>Σ</b>	<b>1.800</b>						<b>3.17</b>	<b>0.151</b>
#2	1	3.000	0.030	0.000	0.000	91.000	M	7.36	0.290
	<b>Σ</b>	<b>10.300</b>						<b>24.02</b>	<b>0.974</b>

### Subwatershed Time of Concentration Details:

Stru #	SWS #	Land Flow Condition	Slope (%)	Vert. Dist. (ft)	Horiz. Dist. (ft)	Velocity (fps)	Time (hrs)
#1	1	5. Nearly bare and untilled, and alluvial valley fans	1.84	14.00	760.00	1.350	0.156
<b>#1</b>	<b>1</b>	<b>Time of Concentration:</b>					<b>0.156</b>
#2	1	5. Nearly bare and untilled, and alluvial valley fans	3.75	6.00	160.00	1.930	0.023
		8. Large gullies, diversions, and low flowing streams	23.68	90.00	380.00	14.590	0.007
<b>#2</b>	<b>1</b>	<b>Time of Concentration:</b>					<b>0.030</b>
#3	1	5. Nearly bare and untilled, and alluvial valley fans	5.00	4.00	80.00	2.230	0.009
		8. Large gullies, diversions, and low flowing streams	43.75	70.00	160.00	19.840	0.002
<b>#3</b>	<b>1</b>	<b>Time of Concentration:</b>					<b>0.011</b>
#4	1	5. Nearly bare and untilled, and alluvial valley fans	1.11	4.00	360.00	1.050	0.095
		8. Large gullies, diversions, and low flowing streams	9.76	83.00	850.00	9.370	0.025
<b>#4</b>	<b>1</b>	<b>Time of Concentration:</b>					<b>0.120</b>

### Subwatershed Muskingum Routing Details:

Stru #	SWS #	Land Flow Condition	Slope (%)	Vert. Dist. (ft)	Horiz. Dist. (ft)	Velocity (fps)	Time (hrs)
#3	1	8. Large gullies, diversions, and low flowing streams	33.33	15.00	45.00	17.320	0.000

Stru #	SWS #	Land Flow Condition	Slope (%)	Vert. Dist. (ft)	Horiz. Dist. (ft)	Velocity (fps)	Time (hrs)
<b>#3</b>	<b>1</b>	<b>Muskingum K:</b>					<b>0.000</b>
#4	1	8. Large gullies, diversions, and low flowing streams	12.38	13.00	105.00	10.550	0.002
<b>#4</b>	<b>1</b>	<b>Muskingum K:</b>					<b>0.002</b>

## **Area 4 North Pond 413**

***The watershed for the impoundment is presented on Exhibit 11-13F. The detail design is presented on Exhibit 11-6.***

***The pond is designed to retain the runoff from the 100 yr-6 hr storm event, therefore no spillway required.***

***The ditch that diverts the flows to the pond and the inlet structures are designed to be stable for the 10 yr- 6 hr and 25 yr- 6 hr storm events, respectively.***

Ron Van Valkenburg, PE

BHP Billiton  
Navajo Mine  
PO Box 1717  
Fruitland, NM 87416

Phone: 505 598 2007

---

## ***General Information***

### ***Storm Information:***

Storm Type:	NRCS TYPE II-70
Design Storm:	10 yr - 6 hr
Rainfall Depth:	1.300 inches

### Structure Networking:

Type	Stru #	(flows into)	Stru #	Musk. K (hrs)	Musk. X	Description
Channel	#1	==>	#3	0.003	0.458	Berm V-ditch
Null	#2	==>	End	0.000	0.000	A4N Pond 413
Channel	#3	==>	#2	0.000	0.000	Inlet B (West)
Channel	#4	==>	#2	0.000	0.000	Inlet A (East)



### Structure Routing Details:

Stru #	Land Flow Condition	Slope (%)	Vert. Dist. (ft)	Horiz. Dist. (ft)	Velocity (fps)	Time (hrs)
#1	8. Large gullies, diversions, and low flowing streams	37.73	83.00	220.00	18.42	0.003
<b>#1</b>	<b>Muskingum K:</b>					<b>0.003</b>
#4	8. Large gullies, diversions, and low flowing streams	0.00	0.00	0.00	0.00	0.000
<b>#4</b>	<b>Muskingum K:</b>					<b>0.000</b>

***Structure Summary:***

	Immediate Contributing Area (ac)	Total Contributing Area (ac)	Peak Discharge (cfs)	Total Runoff Volume (ac-ft)
#4	5.500	5.500	7.49	0.27
#1	1.300	1.300	1.10	0.05
#3	0.500	1.800	1.65	0.08
#2	3.000	10.300	13.21	0.49

### Structure Detail:

Structure #4 (Riprap Channel)

*Inlet A (East)*

Trapezoidal Riprap Channel Inputs:

Material: Riprap

Bottom Width (ft)	Left Sideslope Ratio	Right Sideslope Ratio	Slope (%)	Freeboard Depth (ft)	Freeboard % of Depth	Freeboard Mult. x (VxD)
6.00	3.0:1	3.0:1	15.2	1.00		

Riprap Channel Results:

Simons/OSM Method - Steep Slope Design

	w/o Freeboard	w/ Freeboard
Design Discharge:	7.49 cfs	
Depth:	0.11 ft	1.11 ft
Top Width:	6.68 ft	12.68 ft
Velocity*:		
X-Section Area:	0.72 sq ft	
Hydraulic Radius:	0.107 ft	
Froude Number*:		
Manning's n*:		
Dmin:	2.00 in	
D50:	6.00 in	
Dmax:	7.50 in	

Velocity and Manning's n calculations may not apply for this method.

Structure #1 (Erodible Channel)

*Berm V-ditch*

Triangular Erodible Channel Inputs:

Material: Stiff clay very colloidal

Left Sideslope Ratio	Right Sideslope Ratio	Slope (%)	Manning's n	Freeboard Depth (ft)	Freeboard % of Depth	Freeboard Mult. x (VxD)	Limiting Velocity (fps)
1.5:1	1.5:1	2.0	0.0280	1.00			5.0

Erodible Channel Results:

	w/o Freeboard	w/ Freeboard
Design Discharge:	1.10 cfs	
Depth:	0.52 ft	1.52 ft
Top Width:	1.56 ft	4.56 ft
Velocity:	2.71 fps	
X-Section Area:	0.41 sq ft	
Hydraulic Radius:	0.216 ft	
Froude Number:	0.94	

Structure #3 (Riprap Channel)

*Inlet B (West)*

Trapezoidal Riprap Channel Inputs:

Material: Riprap

Bottom Width (ft)	Left Sideslope Ratio	Right Sideslope Ratio	Slope (%)	Freeboard Depth (ft)	Freeboard % of Depth	Freeboard Mult. x (VxD)
4.00	3.0:1	3.0:1	32.0	1.00		

Riprap Channel Results:

Simons/OSM Method - Steep Slope Design

	w/o Freeboard	w/ Freeboard
Design Discharge:	1.65 cfs	
Depth:	0.03 ft	1.03 ft
Top Width:	4.19 ft	10.19 ft
Velocity*:		
X-Section Area:	0.13 sq ft	
Hydraulic Radius:	0.031 ft	
Froude Number*:		
Manning's n*:		
Dmin:	3.00 in	
D50:	9.00 in	
Dmax:	11.25 in	

Velocity and Manning's n calculations may not apply for this method.

Structure #2 (Null)

*A4N Pond 413*

### Subwatershed Hydrology Detail:

Stru #	SWS #	SWS Area (ac)	Time of Conc (hrs)	Musk K (hrs)	Musk X	Curve Number	UHS	Peak Discharge (cfs)	Runoff Volume (ac-ft)
#4	1	5.500	0.120	0.002	0.431	91.000	M	7.49	0.266
	<b>Σ</b>	<b>5.500</b>						<b>7.49</b>	<b>0.266</b>
#1	1	1.300	0.156	0.000	0.000	91.000	M	1.10	0.051
	<b>Σ</b>	<b>1.300</b>						<b>1.10</b>	<b>0.051</b>
#3	1	0.500	0.011	0.000	0.455	91.000	M	0.68	0.024
	<b>Σ</b>	<b>1.800</b>						<b>1.65</b>	<b>0.075</b>
#2	1	3.000	0.030	0.000	0.000	91.000	M	4.08	0.145
	<b>Σ</b>	<b>10.300</b>						<b>13.21</b>	<b>0.486</b>

### Subwatershed Time of Concentration Details:

Stru #	SWS #	Land Flow Condition	Slope (%)	Vert. Dist. (ft)	Horiz. Dist. (ft)	Velocity (fps)	Time (hrs)
#1	1	5. Nearly bare and untilled, and alluvial valley fans	1.84	14.00	760.00	1.350	0.156
<b>#1</b>	<b>1</b>	<b>Time of Concentration:</b>					<b>0.156</b>
#2	1	5. Nearly bare and untilled, and alluvial valley fans	3.75	6.00	160.00	1.930	0.023
		8. Large gullies, diversions, and low flowing streams	23.68	90.00	380.00	14.590	0.007
<b>#2</b>	<b>1</b>	<b>Time of Concentration:</b>					<b>0.030</b>
#3	1	5. Nearly bare and untilled, and alluvial valley fans	5.00	4.00	80.00	2.230	0.009
		8. Large gullies, diversions, and low flowing streams	43.75	70.00	160.00	19.840	0.002
<b>#3</b>	<b>1</b>	<b>Time of Concentration:</b>					<b>0.011</b>
#4	1	5. Nearly bare and untilled, and alluvial valley fans	1.11	4.00	360.00	1.050	0.095
		8. Large gullies, diversions, and low flowing streams	9.76	83.00	850.00	9.370	0.025
<b>#4</b>	<b>1</b>	<b>Time of Concentration:</b>					<b>0.120</b>

### Subwatershed Muskingum Routing Details:

Stru #	SWS #	Land Flow Condition	Slope (%)	Vert. Dist. (ft)	Horiz. Dist. (ft)	Velocity (fps)	Time (hrs)
#3	1	8. Large gullies, diversions, and low flowing streams	33.33	15.00	45.00	17.320	0.000

Stru #	SWS #	Land Flow Condition	Slope (%)	Vert. Dist. (ft)	Horiz. Dist. (ft)	Velocity (fps)	Time (hrs)
<b>#3</b>	<b>1</b>	<b>Muskingum K:</b>					<b>0.000</b>
#4	1	8. Large gullies, diversions, and low flowing streams	12.38	13.00	105.00	10.550	0.002
<b>#4</b>	<b>1</b>	<b>Muskingum K:</b>					<b>0.002</b>

## **Area 4 North Pond 413**

***The watershed for the impoundment is presented on Exhibit 11-13F. The detail design is presented on Exhibit 11-6.***

***The pond is designed to retain the runoff from the 100 yr-6 hr storm event, therefore no spillway required.***

***The ditch that diverts the flows to the pond and the inlet structures are designed to be stable for the 10 yr- 6 hr and 25 yr- 6 hr storm events, respectively.***

Ron Van Valkenburg, PE

BHP Billiton  
Navajo Mine  
PO Box 1717  
Fruitland, NM 87416

Phone: 505 598 2007

---

## ***General Information***

### ***Storm Information:***

Storm Type:	NRCS TYPE II-70
Design Storm:	25 yr - 6 hr
Rainfall Depth:	1.600 inches

### Structure Networking:

Type	Stru #	(flows into)	Stru #	Musk. K (hrs)	Musk. X	Description
Channel	#1	==>	#3	0.003	0.458	Berm V-ditch
Null	#2	==>	End	0.000	0.000	A4N Pond 413
Channel	#3	==>	#2	0.000	0.000	Inlet B (West)
Channel	#4	==>	#2	0.000	0.000	Inlet A (East)



### Structure Routing Details:

Stru #	Land Flow Condition	Slope (%)	Vert. Dist. (ft)	Horiz. Dist. (ft)	Velocity (fps)	Time (hrs)
#1	8. Large gullies, diversions, and low flowing streams	37.73	83.00	220.00	18.42	0.003
<b>#1</b>	<b>Muskingum K:</b>					<b>0.003</b>
#4	8. Large gullies, diversions, and low flowing streams	0.00	0.00	0.00	0.00	0.000
<b>#4</b>	<b>Muskingum K:</b>					<b>0.000</b>

***Structure Summary:***

	Immediate Contributing Area (ac)	Total Contributing Area (ac)	Peak Discharge (cfs)	Total Runoff Volume (ac-ft)
#4	5.500	5.500	10.05	0.38
#1	1.300	1.300	1.52	0.07
#3	0.500	1.800	2.29	0.11
#2	3.000	10.300	17.81	0.69

### Structure Detail:

Structure #4 (Riprap Channel)

*Inlet A (East)*

Trapezoidal Riprap Channel Inputs:

Material: Riprap

Bottom Width (ft)	Left Sideslope Ratio	Right Sideslope Ratio	Slope (%)	Freeboard Depth (ft)	Freeboard % of Depth	Freeboard Mult. x (VxD)
6.00	3.0:1	3.0:1	15.2	1.00		

Riprap Channel Results:

Simons/OSM Method - Steep Slope Design

	w/o Freeboard	w/ Freeboard
Design Discharge:	10.05 cfs	
Depth:	0.14 ft	1.14 ft
Top Width:	6.85 ft	12.85 ft
Velocity*:		
X-Section Area:	0.91 sq ft	
Hydraulic Radius:	0.132 ft	
Froude Number*:		
Manning's n*:		
Dmin:	2.00 in	
D50:	6.00 in	
Dmax:	7.50 in	

Velocity and Manning's n calculations may not apply for this method.

Structure #1 (Erodible Channel)

*Berm V-ditch*

Triangular Erodible Channel Inputs:

Material: Stiff clay very colloidal

Left Sideslope Ratio	Right Sideslope Ratio	Slope (%)	Manning's n	Freeboard Depth (ft)	Freeboard % of Depth	Freeboard Mult. x (VxD)	Limiting Velocity (fps)
1.5:1	1.5:1	2.0	0.0280	1.00			5.0

Erodible Channel Results:

	w/o Freeboard	w/ Freeboard
Design Discharge:	1.52 cfs	
Depth:	0.59 ft	1.59 ft
Top Width:	1.76 ft	4.76 ft
Velocity:	2.94 fps	
X-Section Area:	0.52 sq ft	
Hydraulic Radius:	0.244 ft	
Froude Number:	0.96	

Structure #3 (Riprap Channel)

*Inlet B (West)*

Trapezoidal Riprap Channel Inputs:

Material: Riprap

Bottom Width (ft)	Left Sideslope Ratio	Right Sideslope Ratio	Slope (%)	Freeboard Depth (ft)	Freeboard % of Depth	Freeboard Mult. x (VxD)
6.00	3.0:1	3.0:1	32.0	1.00		

Riprap Channel Results:

Simons/OSM Method - Mild Slope Design

	w/o Freeboard	w/ Freeboard
Design Discharge:	2.29 cfs	
Depth:	0.00 ft	
Top Width:	0.00 ft	
Velocity:	0.00 fps	
X-Section Area:	0.00 sq ft	
Hydraulic Radius:	0.000 ft	
Froude Number:	0.00	
Manning's n:	0.0000	
Dmin:	0.00 in	
D50:	0.00 in	
Dmax:	0.00 in	

Structure #2 (Null)

*A4N Pond 413*

### Subwatershed Hydrology Detail:

Stru #	SWS #	SWS Area (ac)	Time of Conc (hrs)	Musk K (hrs)	Musk X	Curve Number	UHS	Peak Discharge (cfs)	Runoff Volume (ac-ft)
#4	1	5.500	0.120	0.002	0.431	91.000	M	10.05	0.376
	<b>Σ</b>	<b>5.500</b>						<b>10.05</b>	<b>0.376</b>
#1	1	1.300	0.156	0.000	0.000	91.000	M	1.52	0.072
	<b>Σ</b>	<b>1.300</b>						<b>1.52</b>	<b>0.072</b>
#3	1	0.500	0.011	0.000	0.455	91.000	M	0.91	0.034
	<b>Σ</b>	<b>1.800</b>						<b>2.29</b>	<b>0.107</b>
#2	1	3.000	0.030	0.000	0.000	91.000	M	5.48	0.205
	<b>Σ</b>	<b>10.300</b>						<b>17.81</b>	<b>0.688</b>

### Subwatershed Time of Concentration Details:

Stru #	SWS #	Land Flow Condition	Slope (%)	Vert. Dist. (ft)	Horiz. Dist. (ft)	Velocity (fps)	Time (hrs)
#1	1	5. Nearly bare and untilled, and alluvial valley fans	1.84	14.00	760.00	1.350	0.156
<b>#1</b>	<b>1</b>	<b>Time of Concentration:</b>					<b>0.156</b>
#2	1	5. Nearly bare and untilled, and alluvial valley fans	3.75	6.00	160.00	1.930	0.023
		8. Large gullies, diversions, and low flowing streams	23.68	90.00	380.00	14.590	0.007
<b>#2</b>	<b>1</b>	<b>Time of Concentration:</b>					<b>0.030</b>
#3	1	5. Nearly bare and untilled, and alluvial valley fans	5.00	4.00	80.00	2.230	0.009
		8. Large gullies, diversions, and low flowing streams	43.75	70.00	160.00	19.840	0.002
<b>#3</b>	<b>1</b>	<b>Time of Concentration:</b>					<b>0.011</b>
#4	1	5. Nearly bare and untilled, and alluvial valley fans	1.11	4.00	360.00	1.050	0.095
		8. Large gullies, diversions, and low flowing streams	9.76	83.00	850.00	9.370	0.025
<b>#4</b>	<b>1</b>	<b>Time of Concentration:</b>					<b>0.120</b>

### Subwatershed Muskingum Routing Details:

Stru #	SWS #	Land Flow Condition	Slope (%)	Vert. Dist. (ft)	Horiz. Dist. (ft)	Velocity (fps)	Time (hrs)
#3	1	8. Large gullies, diversions, and low flowing streams	33.33	15.00	45.00	17.320	0.000

Stru #	SWS #	Land Flow Condition	Slope (%)	Vert. Dist. (ft)	Horiz. Dist. (ft)	Velocity (fps)	Time (hrs)
<b>#3</b>	<b>1</b>	<b>Muskingum K:</b>					<b>0.000</b>
#4	1	8. Large gullies, diversions, and low flowing streams	12.38	13.00	105.00	10.550	0.002
<b>#4</b>	<b>1</b>	<b>Muskingum K:</b>					<b>0.002</b>

## **Area 4 North Pond 410**

***The watershed for the impoundment is presented on Exhibit 11-13F. The detail design is presented on Exhibit 11-159***

***The pond is design to retain the runoff from the 100 year-6 hour storm event, therefore no spillway required.***

RYazzie

BHP Billiton  
Navajo Mine  
PO Box 1717  
Fruitland, NM 87416

Phone: 505 598 2007

---

***General Information***

***Storm Information:***

Storm Type:	NRCS TYPE II-70
Design Storm:	100 yr - 6 hr
Rainfall Depth:	2.000 inches

## Structure Networking:

Type	Stru #	(flows into)	Stru #	Musk. K (hrs)	Musk. X	Description
Null	#1	==>	End	0.000	0.000	A4N Pond 410

#1 Null
------------

## *Structure Summary:*

	Immediate Contributing Area (ac)	Total Contributing Area (ac)	Peak Discharge (cfs)	Total Runoff Volume (ac-ft)
#1	2.370	2.370	4.80	0.17

***Structure Detail:***

*Structure #1 (Null)*

*A4N Pond 410*

***Subwatershed Hydrology Detail:***

Stru #	SWS #	SWS Area (ac)	Time of Conc (hrs)	Musk K (hrs)	Musk X	Curve Number	UHS	Peak Discharge (cfs)	Runoff Volume (ac-ft)
#1	1	2.370	0.059	0.000	0.000	86.000	M	4.80	0.17
<b>S</b>		<b>2.370</b>						<b>4.80</b>	<b>0.17</b>

***Subwatershed Time of Concentration Details:***

Stru #	SWS #	Land Flow Condition	Slope (%)	Vert. Dist. (ft)	Horiz. Dist. (ft)	Velocity (fps)	Time (hrs)
#1	1	5. Nearly bare and untilled, and alluvial valley fans	1.67	1.90	113.50	1.290	0.024
		8. Large gullies, diversions, and low flowing streams	1.76	9.00	510.00	3.980	0.035
<b>#1</b>	<b>1</b>	<b>Time of Concentration:</b>					<b>0.059</b>

---

## **Area 4 North Pond 411**

***The watershed for the impoundment is presented on Exhibit 11-13F. The detail design is presented on Exhibit 11-161***

***The pond is designed to retain the runoff from the 100 year-6 hour storm event, therefore no spillway required.***

Ron Van Valkenburg, PE

BHP Billiton  
Navajo Mine  
PO Box 1717  
Fruitland, NM 87416

Phone: 505 598 2007

---

## ***General Information***

### ***Storm Information:***

Storm Type:	NRCS TYPE II-70
Design Storm:	100 yr - 6 hr
Rainfall Depth:	2.000 inches

**Structure Networking:**

Type	Stru #	(flows into)	Stru #	Musk. K (hrs)	Musk. X	Description
Null	#1	==>	End	0.000	0.000	A4N Pond 411



***Structure Summary:***

	Immediate Contributing Area (ac)	Total Contributing Area (ac)	Peak Discharge (cfs)	Total Runoff Volume (ac-ft)
#1	12.500	12.500	30.66	1.21

***Structure Detail:***

*Structure #1 (Null)*

*A4N Pond 411*

***Subwatershed Hydrology Detail:***

Stru #	SWS #	SWS Area (ac)	Time of Conc (hrs)	Musk K (hrs)	Musk X	Curve Number	UHS	Peak Discharge (cfs)	Runoff Volume (ac-ft)
#1	1	12.500	0.077	0.000	0.000	91.000	M	30.66	1.210
<b>Σ</b>		<b>12.500</b>						<b>30.66</b>	<b>1.210</b>

***Subwatershed Time of Concentration Details:***

Stru #	SWS #	Land Flow Condition	Slope (%)	Vert. Dist. (ft)	Horiz. Dist. (ft)	Velocity (fps)	Time (hrs)
#1	1	5. Nearly bare and untilled, and alluvial valley fans	1.79	5.00	280.00	1.330	0.058
		8. Large gullies, diversions, and low flowing streams	9.85	65.00	660.00	9.410	0.019
<b>#1</b>	<b>1</b>	<b>Time of Concentration:</b>					<b>0.077</b>

## **Area 4 North Pond 412**

***The watershed for the impoundment is presented on Exhibit 11-13F. The detail design is presented on Exhibit 11-111.***

***The pond is designed to retain the runoff from the 100 yr-6 hr storm event, therefore no spillway required.***

***The ditch that diverts the flows to the pond and the inlet structures are designed to be stable for the 10 yr- 6 hr and 25 yr- 6 hr storm events, respectively.***

Ron Van Valkenburg, PE

BHP Billiton  
Navajo Mine  
PO Box 1717  
Fruitland, NM 87416

Phone: 505 598 2007

---

***General Information***

***Storm Information:***

Storm Type:	NRCS TYPE II-70
Design Storm:	100 yr - 6 hr
Rainfall Depth:	2.000 inches

### Structure Networking:

Type	Stru #	(flows into)	Stru #	Musk. K (hrs)	Musk. X	Description
Channel	#1	==>	#3	0.002	0.454	Drainage Ditch
Null	#2	==>	End	0.000	0.000	A4N Pond 412
Channel	#3	==>	#2	0.004	0.423	Inlet B (West)
Channel	#4	==>	#2	0.002	0.441	Inlet A (South)



### Structure Routing Details:

Stru #	Land Flow Condition	Slope (%)	Vert. Dist. (ft)	Horiz. Dist. (ft)	Velocity (fps)	Time (hrs)
#1	8. Large gullies, diversions, and low flowing streams	31.72	46.00	145.00	16.89	0.002
<b>#1</b>	<b>Muskingum K:</b>					<b>0.002</b>
#3	8. Large gullies, diversions, and low flowing streams	9.55	15.00	157.00	9.27	0.004
<b>#3</b>	<b>Muskingum K:</b>					<b>0.004</b>
#4	8. Large gullies, diversions, and low flowing streams	18.09	17.00	94.00	12.75	0.002
<b>#4</b>	<b>Muskingum K:</b>					<b>0.002</b>

***Structure Summary:***

	Immediate Contributing Area (ac)	Total Contributing Area (ac)	Peak Discharge (cfs)	Total Runoff Volume (ac-ft)
#4	10.900	10.900	26.73	1.06
#1	5.300	5.300	13.00	0.51
#3	3.400	8.700	21.34	0.84
#2	11.000	30.600	75.05	2.96

### Structure Detail:

#### Structure #4 (Riprap Channel)

Inlet A (South)

Trapezoidal Riprap Channel Inputs:

Material: Riprap

Bottom Width (ft)	Left Sideslope Ratio	Right Sideslope Ratio	Slope (%)	Freeboard Depth (ft)	Freeboard % of Depth	Freeboard Mult. x (VxD)
10.00	3.0:1	3.0:1	18.0	1.00		

Riprap Channel Results:

#### Simons/OSM Method - Steep Slope Design

	w/o Freeboard	w/ Freeboard
Design Discharge:	26.73 cfs	
Depth:	0.21 ft	1.21 ft
Top Width:	11.26 ft	17.26 ft
Velocity*:		
X-Section Area:	2.24 sq ft	
Hydraulic Radius:	0.197 ft	
Froude Number*:		
Manning's n*:		
Dmin:	3.00 in	
D50:	9.00 in	
Dmax:	11.25 in	

Velocity and Manning's n calculations may not apply for this method.

#### Structure #1 (Erodible Channel)

Drainage Ditch

Trapezoidal Erodible Channel Inputs:

Material: Stiff clay very colloidal

Bottom Width (ft)	Left Sideslope Ratio	Right Sideslope Ratio	Slope (%)	Manning's n	Freeboard Depth (ft)	Freeboard % of Depth	Freeboard Mult. x (VxD)	Limiting Velocity (fps)
4.00	3.0:1	3.0:1	3.2	0.0280	1.00			5.0

Erodible Channel Results:

	w/o Freeboard	w/ Freeboard
Design Discharge:	13.00 cfs	
Depth:	0.48 ft	1.48 ft
Top Width:	6.90 ft	12.90 ft
Velocity:	4.94 fps	
X-Section Area:	2.63 sq ft	
Hydraulic Radius:	0.373 ft	
Froude Number:	1.41	

Structure #3 (Riprap Channel)

*Inlet B (West)*

Trapezoidal Riprap Channel Inputs:

Material: Riprap

Bottom Width (ft)	Left Sideslope Ratio	Right Sideslope Ratio	Slope (%)	Freeboard Depth (ft)	Freeboard % of Depth	Freeboard Mult. x (VxD)
6.00	3.0:1	3.0:1	10.0	1.00		

Riprap Channel Results:

Simons/OSM Method - Steep Slope Design

	w/o Freeboard	w/ Freeboard
Design Discharge:	21.34 cfs	
Depth:	0.30 ft	1.30 ft
Top Width:	7.81 ft	13.81 ft
Velocity*:		
X-Section Area:	2.08 sq ft	
Hydraulic Radius:	0.263 ft	
Froude Number*:		
Manning's n*:		
Dmin:	2.00 in	
D50:	6.00 in	
Dmax:	7.50 in	

Velocity and Manning's n calculations may not apply for this method.

Structure #2 (Null)

*A4N Pond 412*

### Subwatershed Hydrology Detail:

Stru #	SWS #	SWS Area (ac)	Time of Conc (hrs)	Musk K (hrs)	Musk X	Curve Number	UHS	Peak Discharge (cfs)	Runoff Volume (ac-ft)
#4	1	10.900	0.108	0.000	0.000	91.000	M	26.73	1.055
	<b>Σ</b>	<b>10.900</b>						<b>26.73</b>	<b>1.055</b>
#1	1	5.300	0.064	0.000	0.000	91.000	M	13.00	0.513
	<b>Σ</b>	<b>5.300</b>						<b>13.00</b>	<b>0.513</b>
#3	1	3.400	0.031	0.000	0.000	91.000	M	8.34	0.329
	<b>Σ</b>	<b>8.700</b>						<b>21.34</b>	<b>0.842</b>
#2	1	11.000	0.082	0.000	0.000	91.000	M	26.98	1.065
	<b>Σ</b>	<b>30.600</b>						<b>75.05</b>	<b>2.963</b>

### Subwatershed Time of Concentration Details:

Stru #	SWS #	Land Flow Condition	Slope (%)	Vert. Dist. (ft)	Horiz. Dist. (ft)	Velocity (fps)	Time (hrs)
#1	1	5. Nearly bare and untilled, and alluvial valley fans	2.00	2.00	100.00	1.410	0.019
		8. Large gullies, diversions, and low flowing streams	4.69	50.00	1,065.00	6.500	0.045
<b>#1</b>	<b>1</b>	<b>Time of Concentration:</b>					<b>0.064</b>
#2	1	5. Nearly bare and untilled, and alluvial valley fans	2.50	10.00	400.00	1.580	0.070
		8. Large gullies, diversions, and low flowing streams	17.86	100.00	560.00	12.670	0.012
<b>#2</b>	<b>1</b>	<b>Time of Concentration:</b>					<b>0.082</b>
#3	1	5. Nearly bare and untilled, and alluvial valley fans	4.00	4.00	100.00	2.000	0.013
		8. Large gullies, diversions, and low flowing streams	13.24	94.00	710.00	10.910	0.018
<b>#3</b>	<b>1</b>	<b>Time of Concentration:</b>					<b>0.031</b>
#4	1	5. Nearly bare and untilled, and alluvial valley fans	2.44	10.00	410.00	1.560	0.073
		8. Large gullies, diversions, and low flowing streams	8.51	94.00	1,105.00	8.740	0.035
<b>#4</b>	<b>1</b>	<b>Time of Concentration:</b>					<b>0.108</b>

## **Area 4 North Pond 412**

***The watershed for the impoundment is presented on Exhibit 11-13F. The detail design is presented on Exhibit 11-111.***

***The pond is designed to retain the runoff from the 100 yr-6 hr storm event, therefore no spillway required.***

***The ditch that diverts the flows to the pond and the inlet structures are designed to be stable for the 10 yr- 6 hr and 25 yr- 6 hr storm events, respectively.***

Ron Van Valkenburg, PE

BHP Billiton  
Navajo Mine  
PO Box 1717  
Fruitland, NM 87416

Phone: 505 598 2007

## ***General Information***

### ***Storm Information:***

Storm Type:	NRCS TYPE II-70
Design Storm:	10 yr - 6 hr
Rainfall Depth:	1.300 inches

### Structure Networking:

Type	Stru #	(flows into)	Stru #	Musk. K (hrs)	Musk. X	Description
Channel	#1	==>	#3	0.002	0.454	Drainage Ditch
Null	#2	==>	End	0.000	0.000	A4N Pond 412
Channel	#3	==>	#2	0.004	0.423	Inlet B (West)
Channel	#4	==>	#2	0.002	0.441	Inlet A (South)



### Structure Routing Details:

Stru #	Land Flow Condition	Slope (%)	Vert. Dist. (ft)	Horiz. Dist. (ft)	Velocity (fps)	Time (hrs)
#1	8. Large gullies, diversions, and low flowing streams	31.72	46.00	145.00	16.89	0.002
<b>#1</b>	<b>Muskingum K:</b>					<b>0.002</b>
#3	8. Large gullies, diversions, and low flowing streams	9.55	15.00	157.00	9.27	0.004
<b>#3</b>	<b>Muskingum K:</b>					<b>0.004</b>
#4	8. Large gullies, diversions, and low flowing streams	18.09	17.00	94.00	12.75	0.002
<b>#4</b>	<b>Muskingum K:</b>					<b>0.002</b>

***Structure Summary:***

	Immediate Contributing Area (ac)	Total Contributing Area (ac)	Peak Discharge (cfs)	Total Runoff Volume (ac-ft)
#4	10.900	10.900	14.83	0.53
#1	5.300	5.300	7.21	0.26
#3	3.400	8.700	11.84	0.42
#2	11.000	30.600	41.64	1.48

### Structure Detail:

#### Structure #4 (Riprap Channel)

##### *Inlet A (South)*

Trapezoidal Riprap Channel Inputs:

#### Material: Riprap

Bottom Width (ft)	Left Sideslope Ratio	Right Sideslope Ratio	Slope (%)	Freeboard Depth (ft)	Freeboard % of Depth	Freeboard Mult. x (VxD)
10.00	3.0:1	3.0:1	18.0	1.00		

Riprap Channel Results:

#### Simons/OSM Method - Steep Slope Design

	w/o Freeboard	w/ Freeboard
Design Discharge:	14.83 cfs	
Depth:	0.13 ft	1.13 ft
Top Width:	10.79 ft	16.79 ft
Velocity*:		
X-Section Area:	1.38 sq ft	
Hydraulic Radius:	0.127 ft	
Froude Number*:		
Manning's n*:		
Dmin:	2.00 in	
D50:	6.00 in	
Dmax:	7.50 in	

Velocity and Manning's n calculations may not apply for this method.

#### Structure #1 (Erodible Channel)

##### *Drainage Ditch*

Triangular Erodible Channel Inputs:

#### Material: Stiff clay very colloidal

Left Sideslope Ratio	Right Sideslope Ratio	Slope (%)	Manning's n	Freeboard Depth (ft)	Freeboard % of Depth	Freeboard Mult. x (VxD)	Limiting Velocity (fps)
2.0:1	2.0:1	3.2	0.0280	1.00			5.0

Erodible Channel Results:

	w/o Freeboard	w/ Freeboard
Design Discharge:	7.21 cfs	
Depth:	0.85 ft	1.85 ft
Top Width:	3.40 ft	7.40 ft

	w/o Freeboard	w/ Freeboard
Velocity:	4.99 fps	
X-Section Area:	1.44 sq ft	
Hydraulic Radius:	0.380 ft	
Froude Number:	1.35	

Structure #3 (Riprap Channel)

*Inlet B (West)*

Trapezoidal Riprap Channel Inputs:

Material: Riprap

Bottom Width (ft)	Left Sideslope Ratio	Right Sideslope Ratio	Slope (%)	Freeboard Depth (ft)	Freeboard % of Depth	Freeboard Mult. x (VxD)
6.00	3.0:1	3.0:1	10.0	1.00		

Riprap Channel Results:

Simons/OSM Method - Steep Slope Design

	w/o Freeboard	w/ Freeboard
Design Discharge:	11.84 cfs	
Depth:	0.19 ft	1.19 ft
Top Width:	7.15 ft	13.15 ft
Velocity*:		
X-Section Area:	1.26 sq ft	
Hydraulic Radius:	0.175 ft	
Froude Number*:		
Manning's n*:		
Dmin:	2.00 in	
D50:	6.00 in	
Dmax:	7.50 in	

Velocity and Manning's n calculations may not apply for this method.

Structure #2 (Null)

*A4N Pond 412*

### *Subwatershed Hydrology Detail:*

Stru #	SWS #	SWS Area (ac)	Time of Conc (hrs)	Musk K (hrs)	Musk X	Curve Number	UHS	Peak Discharge (cfs)	Runoff Volume (ac-ft)
#4	1	10.900	0.108	0.000	0.000	91.000	M	14.83	0.527
	<b>Σ</b>	<b>10.900</b>						<b>14.83</b>	<b>0.527</b>
#1	1	5.300	0.064	0.000	0.000	91.000	M	7.21	0.256
	<b>Σ</b>	<b>5.300</b>						<b>7.21</b>	<b>0.256</b>
#3	1	3.400	0.031	0.000	0.000	91.000	M	4.63	0.164
	<b>Σ</b>	<b>8.700</b>						<b>11.84</b>	<b>0.420</b>
#2	1	11.000	0.082	0.000	0.000	91.000	M	14.97	0.532
	<b>Σ</b>	<b>30.600</b>						<b>41.64</b>	<b>1.479</b>

### *Subwatershed Time of Concentration Details:*

Stru #	SWS #	Land Flow Condition	Slope (%)	Vert. Dist. (ft)	Horiz. Dist. (ft)	Velocity (fps)	Time (hrs)
#1	1	5. Nearly bare and untilled, and alluvial valley fans	2.00	2.00	100.00	1.410	0.019
		8. Large gullies, diversions, and low flowing streams	4.69	50.00	1,065.00	6.500	0.045
<b>#1</b>	<b>1</b>	<b>Time of Concentration:</b>					<b>0.064</b>
#2	1	5. Nearly bare and untilled, and alluvial valley fans	2.50	10.00	400.00	1.580	0.070
		8. Large gullies, diversions, and low flowing streams	17.86	100.00	560.00	12.670	0.012
<b>#2</b>	<b>1</b>	<b>Time of Concentration:</b>					<b>0.082</b>
#3	1	5. Nearly bare and untilled, and alluvial valley fans	4.00	4.00	100.00	2.000	0.013
		8. Large gullies, diversions, and low flowing streams	13.24	94.00	710.00	10.910	0.018
<b>#3</b>	<b>1</b>	<b>Time of Concentration:</b>					<b>0.031</b>
#4	1	5. Nearly bare and untilled, and alluvial valley fans	2.44	10.00	410.00	1.560	0.073
		8. Large gullies, diversions, and low flowing streams	8.51	94.00	1,105.00	8.740	0.035
<b>#4</b>	<b>1</b>	<b>Time of Concentration:</b>					<b>0.108</b>

## **Area 4 North Pond 412**

***The watershed for the impoundment is presented on Exhibit 11-13F. The detail design is presented on Exhibit 11-111.***

***The pond is designed to retain the runoff from the 100 yr-6 hr storm event, therefore no spillway required.***

***The ditch that diverts the flows to the pond and the inlet structures are designed to be stable for the 10 yr- 6 hr and 25 yr- 6 hr storm events, respectively.***

Ron Van Valkenburg, PE

BHP Billiton  
Navajo Mine  
PO Box 1717  
Fruitland, NM 87416

Phone: 505 598 2007

---

## ***General Information***

### ***Storm Information:***

Storm Type:	NRCS TYPE II-70
Design Storm:	25 yr - 6 hr
Rainfall Depth:	1.600 inches

### Structure Networking:

Type	Stru #	(flows into)	Stru #	Musk. K (hrs)	Musk. X	Description
Channel	#1	==>	#3	0.002	0.454	Drainage Ditch
Null	#2	==>	End	0.000	0.000	A4N Pond 412
Channel	#3	==>	#2	0.004	0.423	Inlet B (West)
Channel	#4	==>	#2	0.002	0.441	Inlet A (South)



### Structure Routing Details:

Stru #	Land Flow Condition	Slope (%)	Vert. Dist. (ft)	Horiz. Dist. (ft)	Velocity (fps)	Time (hrs)
#1	8. Large gullies, diversions, and low flowing streams	31.72	46.00	145.00	16.89	0.002
<b>#1</b>	<b>Muskingum K:</b>					<b>0.002</b>
#3	8. Large gullies, diversions, and low flowing streams	9.55	15.00	157.00	9.27	0.004
<b>#3</b>	<b>Muskingum K:</b>					<b>0.004</b>
#4	8. Large gullies, diversions, and low flowing streams	18.09	17.00	94.00	12.75	0.002
<b>#4</b>	<b>Muskingum K:</b>					<b>0.002</b>

***Structure Summary:***

	Immediate Contributing Area (ac)	Total Contributing Area (ac)	Peak Discharge (cfs)	Total Runoff Volume (ac-ft)
#4	10.900	10.900	19.91	0.75
#1	5.300	5.300	9.68	0.36
#3	3.400	8.700	15.89	0.60
#2	11.000	30.600	55.89	2.09

### Structure Detail:

Structure #4 (Riprap Channel)

Inlet A (South)

Trapezoidal Riprap Channel Inputs:

Material: Riprap

Bottom Width (ft)	Left Sideslope Ratio	Right Sideslope Ratio	Slope (%)	Freeboard Depth (ft)	Freeboard % of Depth	Freeboard Mult. x (VxD)
10.00	3.0:1	3.0:1	18.0	1.00		

Riprap Channel Results:

#### Simons/OSM Method - Steep Slope Design

	w/o Freeboard	w/ Freeboard
Design Discharge:	19.91 cfs	
Depth:	0.17 ft	1.17 ft
Top Width:	11.00 ft	17.00 ft
Velocity*:		
X-Section Area:	1.75 sq ft	
Hydraulic Radius:	0.158 ft	
Froude Number*:		
Manning's n*:		
Dmin:	2.00 in	
D50:	6.00 in	
Dmax:	7.50 in	

Velocity and Manning's n calculations may not apply for this method.

Structure #1 (Erodible Channel)

Drainage Ditch

Trapezoidal Erodible Channel Inputs:

Material: Stiff clay very colloidal

Bottom Width (ft)	Left Sideslope Ratio	Right Sideslope Ratio	Slope (%)	Manning's n	Freeboard Depth (ft)	Freeboard % of Depth	Freeboard Mult. x (VxD)	Limiting Velocity (fps)
4.00	3.0:1	3.0:1	3.2	0.0280	1.00			5.0

Erodible Channel Results:

	w/o Freeboard	w/ Freeboard
Design Discharge:	9.68 cfs	
Depth:	0.41 ft	1.41 ft
Top Width:	6.46 ft	12.46 ft
Velocity:	4.50 fps	
X-Section Area:	2.15 sq ft	
Hydraulic Radius:	0.326 ft	
Froude Number:	1.38	

Structure #3 (Riprap Channel)

*Inlet B (West)*

Trapezoidal Riprap Channel Inputs:

Material: Riprap

Bottom Width (ft)	Left Sideslope Ratio	Right Sideslope Ratio	Slope (%)	Freeboard Depth (ft)	Freeboard % of Depth	Freeboard Mult. x (VxD)
6.00	3.0:1	3.0:1	10.0	1.00		

Riprap Channel Results:

Simons/OSM Method - Steep Slope Design

	w/o Freeboard	w/ Freeboard
Design Discharge:	15.89 cfs	
Depth:	0.24 ft	1.24 ft
Top Width:	7.44 ft	13.44 ft
Velocity*:		
X-Section Area:	1.61 sq ft	
Hydraulic Radius:	0.214 ft	
Froude Number*:		
Manning's n*:		
Dmin:	2.00 in	
D50:	6.00 in	
Dmax:	7.50 in	

Velocity and Manning's n calculations may not apply for this method.

Structure #2 (Null)

*A4N Pond 412*

### Subwatershed Hydrology Detail:

Stru #	SWS #	SWS Area (ac)	Time of Conc (hrs)	Musk K (hrs)	Musk X	Curve Number	UHS	Peak Discharge (cfs)	Runoff Volume (ac-ft)
#4	1	10.900	0.108	0.000	0.000	91.000	M	19.91	0.746
	<b>Σ</b>	<b>10.900</b>						<b>19.91</b>	<b>0.746</b>
#1	1	5.300	0.064	0.000	0.000	91.000	M	9.68	0.363
	<b>Σ</b>	<b>5.300</b>						<b>9.68</b>	<b>0.363</b>
#3	1	3.400	0.031	0.000	0.000	91.000	M	6.21	0.233
	<b>Σ</b>	<b>8.700</b>						<b>15.89</b>	<b>0.595</b>
#2	1	11.000	0.082	0.000	0.000	91.000	M	20.09	0.753
	<b>Σ</b>	<b>30.600</b>						<b>55.89</b>	<b>2.093</b>

### Subwatershed Time of Concentration Details:

Stru #	SWS #	Land Flow Condition	Slope (%)	Vert. Dist. (ft)	Horiz. Dist. (ft)	Velocity (fps)	Time (hrs)
#1	1	5. Nearly bare and untilled, and alluvial valley fans	2.00	2.00	100.00	1.410	0.019
		8. Large gullies, diversions, and low flowing streams	4.69	50.00	1,065.00	6.500	0.045
<b>#1</b>	<b>1</b>	<b>Time of Concentration:</b>					<b>0.064</b>
#2	1	5. Nearly bare and untilled, and alluvial valley fans	2.50	10.00	400.00	1.580	0.070
		8. Large gullies, diversions, and low flowing streams	17.86	100.00	560.00	12.670	0.012
<b>#2</b>	<b>1</b>	<b>Time of Concentration:</b>					<b>0.082</b>
#3	1	5. Nearly bare and untilled, and alluvial valley fans	4.00	4.00	100.00	2.000	0.013
		8. Large gullies, diversions, and low flowing streams	13.24	94.00	710.00	10.910	0.018
<b>#3</b>	<b>1</b>	<b>Time of Concentration:</b>					<b>0.031</b>
#4	1	5. Nearly bare and untilled, and alluvial valley fans	2.44	10.00	410.00	1.560	0.073
		8. Large gullies, diversions, and low flowing streams	8.51	94.00	1,105.00	8.740	0.035
<b>#4</b>	<b>1</b>	<b>Time of Concentration:</b>					<b>0.108</b>

## **Area 4 North Pond 413**

***The watershed for the impoundment is presented on Exhibit 11-13F. The detail design is presented on Exhibit 11-6.***

***The pond is designed to retain the runoff from the 100 yr-6 hr storm event, therefore no spillway required.***

***The ditch that diverts the flows to the pond and the inlet structures are designed to be stable for the 10 yr- 6 hr and 25 yr- 6 hr storm events, respectively.***

Ron Van Valkenburg, PE

BHP Billiton  
Navajo Mine  
PO Box 1717  
Fruitland, NM 87416

Phone: 505 598 2007

---

***General Information***

***Storm Information:***

Storm Type:	NRCS TYPE II-70
Design Storm:	100 yr - 6 hr
Rainfall Depth:	2.000 inches

### Structure Networking:

Type	Stru #	(flows into)	Stru #	Musk. K (hrs)	Musk. X	Description
Channel	#1	==>	#3	0.003	0.458	Berm V-ditch
Null	#2	==>	End	0.000	0.000	A4N Pond 413
Channel	#3	==>	#2	0.000	0.000	Inlet B (West)
Channel	#4	==>	#2	0.000	0.000	Inlet A (East)



### Structure Routing Details:

Stru #	Land Flow Condition	Slope (%)	Vert. Dist. (ft)	Horiz. Dist. (ft)	Velocity (fps)	Time (hrs)
#1	8. Large gullies, diversions, and low flowing streams	37.73	83.00	220.00	18.42	0.003
<b>#1</b>	<b>Muskingum K:</b>					<b>0.003</b>
#4	8. Large gullies, diversions, and low flowing streams	0.00	0.00	0.00	0.00	0.000
<b>#4</b>	<b>Muskingum K:</b>					<b>0.000</b>

***Structure Summary:***

	Immediate Contributing Area (ac)	Total Contributing Area (ac)	Peak Discharge (cfs)	Total Runoff Volume (ac-ft)
#4	5.500	5.500	13.49	0.53
#1	1.300	1.300	2.10	0.10
#3	0.500	1.800	3.17	0.15
#2	3.000	10.300	24.02	0.97

### Structure Detail:

Structure #4 (Riprap Channel)

Inlet A (East)

Trapezoidal Riprap Channel Inputs:

Material: Riprap

Bottom Width (ft)	Left Sideslope Ratio	Right Sideslope Ratio	Slope (%)	Freeboard Depth (ft)	Freeboard % of Depth	Freeboard Mult. x (VxD)
6.00	3.0:1	3.0:1	15.2	1.00		

Riprap Channel Results:

#### Simons/OSM Method - Steep Slope Design

	w/o Freeboard	w/ Freeboard
Design Discharge:	13.49 cfs	
Depth:	0.18 ft	1.18 ft
Top Width:	7.07 ft	13.07 ft
Velocity*:		
X-Section Area:	1.16 sq ft	
Hydraulic Radius:	0.163 ft	
Froude Number*:		
Manning's n*:		
Dmin:	3.00 in	
D50:	9.00 in	
Dmax:	11.25 in	

Velocity and Manning's n calculations may not apply for this method.

Structure #1 (Erodible Channel)

Berm V-ditch

Triangular Erodible Channel Inputs:

Material: Stiff clay very colloidal

Left Sideslope Ratio	Right Sideslope Ratio	Slope (%)	Manning's n	Freeboard Depth (ft)	Freeboard % of Depth	Freeboard Mult. x (VxD)	Limiting Velocity (fps)
1.5:1	1.5:1	2.0	0.0280	1.00			5.0

Erodible Channel Results:

	w/o Freeboard	w/ Freeboard
Design Discharge:	2.10 cfs	
Depth:	0.66 ft	1.66 ft
Top Width:	1.99 ft	4.99 ft
Velocity:	3.19 fps	
X-Section Area:	0.66 sq ft	
Hydraulic Radius:	0.276 ft	
Froude Number:	0.98	

Structure #3 (Riprap Channel)

*Inlet B (West)*

Trapezoidal Riprap Channel Inputs:

Material: Riprap

Bottom Width (ft)	Left Sideslope Ratio	Right Sideslope Ratio	Slope (%)	Freeboard Depth (ft)	Freeboard % of Depth	Freeboard Mult. x (VxD)
4.00	3.0:1	3.0:1	32.0	1.00		

Riprap Channel Results:

Simons/OSM Method - Steep Slope Design

	w/o Freeboard	w/ Freeboard
Design Discharge:	3.17 cfs	
Depth:	0.05 ft	1.05 ft
Top Width:	4.27 ft	10.27 ft
Velocity*:		
X-Section Area:	0.19 sq ft	
Hydraulic Radius:	0.044 ft	
Froude Number*:		
Manning's n*:		
Dmin:	4.00 in	
D50:	12.00 in	
Dmax:	15.00 in	

Velocity and Manning's n calculations may not apply for this method.

Structure #2 (Null)

*A4N Pond 413*

### Subwatershed Hydrology Detail:

Stru #	SWS #	SWS Area (ac)	Time of Conc (hrs)	Musk K (hrs)	Musk X	Curve Number	UHS	Peak Discharge (cfs)	Runoff Volume (ac-ft)
#4	1	5.500	0.120	0.002	0.431	91.000	M	13.49	0.533
	<b>Σ</b>	<b>5.500</b>						<b>13.49</b>	<b>0.533</b>
#1	1	1.300	0.156	0.000	0.000	91.000	M	2.10	0.102
	<b>Σ</b>	<b>1.300</b>						<b>2.10</b>	<b>0.102</b>
#3	1	0.500	0.011	0.000	0.455	91.000	M	1.23	0.048
	<b>Σ</b>	<b>1.800</b>						<b>3.17</b>	<b>0.151</b>
#2	1	3.000	0.030	0.000	0.000	91.000	M	7.36	0.290
	<b>Σ</b>	<b>10.300</b>						<b>24.02</b>	<b>0.974</b>

### Subwatershed Time of Concentration Details:

Stru #	SWS #	Land Flow Condition	Slope (%)	Vert. Dist. (ft)	Horiz. Dist. (ft)	Velocity (fps)	Time (hrs)
#1	1	5. Nearly bare and untilled, and alluvial valley fans	1.84	14.00	760.00	1.350	0.156
<b>#1</b>	<b>1</b>	<b>Time of Concentration:</b>					<b>0.156</b>
#2	1	5. Nearly bare and untilled, and alluvial valley fans	3.75	6.00	160.00	1.930	0.023
		8. Large gullies, diversions, and low flowing streams	23.68	90.00	380.00	14.590	0.007
<b>#2</b>	<b>1</b>	<b>Time of Concentration:</b>					<b>0.030</b>
#3	1	5. Nearly bare and untilled, and alluvial valley fans	5.00	4.00	80.00	2.230	0.009
		8. Large gullies, diversions, and low flowing streams	43.75	70.00	160.00	19.840	0.002
<b>#3</b>	<b>1</b>	<b>Time of Concentration:</b>					<b>0.011</b>
#4	1	5. Nearly bare and untilled, and alluvial valley fans	1.11	4.00	360.00	1.050	0.095
		8. Large gullies, diversions, and low flowing streams	9.76	83.00	850.00	9.370	0.025
<b>#4</b>	<b>1</b>	<b>Time of Concentration:</b>					<b>0.120</b>

### Subwatershed Muskingum Routing Details:

Stru #	SWS #	Land Flow Condition	Slope (%)	Vert. Dist. (ft)	Horiz. Dist. (ft)	Velocity (fps)	Time (hrs)
#3	1	8. Large gullies, diversions, and low flowing streams	33.33	15.00	45.00	17.320	0.000

Stru #	SWS #	Land Flow Condition	Slope (%)	Vert. Dist. (ft)	Horiz. Dist. (ft)	Velocity (fps)	Time (hrs)
<b>#3</b>	<b>1</b>	<b>Muskingum K:</b>					<b>0.000</b>
#4	1	8. Large gullies, diversions, and low flowing streams	12.38	13.00	105.00	10.550	0.002
<b>#4</b>	<b>1</b>	<b>Muskingum K:</b>					<b>0.002</b>

## **Area 4 North Pond 413**

***The watershed for the impoundment is presented on Exhibit 11-13F. The detail design is presented on Exhibit 11-6.***

***The pond is designed to retain the runoff from the 100 yr-6 hr storm event, therefore no spillway required.***

***The ditch that diverts the flows to the pond and the inlet structures are designed to be stable for the 10 yr- 6 hr and 25 yr- 6 hr storm events, respectively.***

Ron Van Valkenburg, PE

BHP Billiton  
Navajo Mine  
PO Box 1717  
Fruitland, NM 87416

Phone: 505 598 2007

---

## ***General Information***

### ***Storm Information:***

Storm Type:	NRCS TYPE II-70
Design Storm:	10 yr - 6 hr
Rainfall Depth:	1.300 inches

### Structure Networking:

Type	Stru #	(flows into)	Stru #	Musk. K (hrs)	Musk. X	Description
Channel	#1	==>	#3	0.003	0.458	Berm V-ditch
Null	#2	==>	End	0.000	0.000	A4N Pond 413
Channel	#3	==>	#2	0.000	0.000	Inlet B (West)
Channel	#4	==>	#2	0.000	0.000	Inlet A (East)



### Structure Routing Details:

Stru #	Land Flow Condition	Slope (%)	Vert. Dist. (ft)	Horiz. Dist. (ft)	Velocity (fps)	Time (hrs)
#1	8. Large gullies, diversions, and low flowing streams	37.73	83.00	220.00	18.42	0.003
<b>#1</b>	<b>Muskingum K:</b>					<b>0.003</b>
#4	8. Large gullies, diversions, and low flowing streams	0.00	0.00	0.00	0.00	0.000
<b>#4</b>	<b>Muskingum K:</b>					<b>0.000</b>

***Structure Summary:***

	Immediate Contributing Area (ac)	Total Contributing Area (ac)	Peak Discharge (cfs)	Total Runoff Volume (ac-ft)
#4	5.500	5.500	7.49	0.27
#1	1.300	1.300	1.10	0.05
#3	0.500	1.800	1.65	0.08
#2	3.000	10.300	13.21	0.49

### Structure Detail:

Structure #4 (Riprap Channel)

*Inlet A (East)*

Trapezoidal Riprap Channel Inputs:

Material: Riprap

Bottom Width (ft)	Left Sideslope Ratio	Right Sideslope Ratio	Slope (%)	Freeboard Depth (ft)	Freeboard % of Depth	Freeboard Mult. x (VxD)
6.00	3.0:1	3.0:1	15.2	1.00		

Riprap Channel Results:

Simons/OSM Method - Steep Slope Design

	w/o Freeboard	w/ Freeboard
Design Discharge:	7.49 cfs	
Depth:	0.11 ft	1.11 ft
Top Width:	6.68 ft	12.68 ft
Velocity*:		
X-Section Area:	0.72 sq ft	
Hydraulic Radius:	0.107 ft	
Froude Number*:		
Manning's n*:		
Dmin:	2.00 in	
D50:	6.00 in	
Dmax:	7.50 in	

Velocity and Manning's n calculations may not apply for this method.

Structure #1 (Erodible Channel)

*Berm V-ditch*

Triangular Erodible Channel Inputs:

Material: Stiff clay very colloidal

Left Sideslope Ratio	Right Sideslope Ratio	Slope (%)	Manning's n	Freeboard Depth (ft)	Freeboard % of Depth	Freeboard Mult. x (VxD)	Limiting Velocity (fps)
1.5:1	1.5:1	2.0	0.0280	1.00			5.0

Erodible Channel Results:

	w/o Freeboard	w/ Freeboard
Design Discharge:	1.10 cfs	
Depth:	0.52 ft	1.52 ft
Top Width:	1.56 ft	4.56 ft
Velocity:	2.71 fps	
X-Section Area:	0.41 sq ft	
Hydraulic Radius:	0.216 ft	
Froude Number:	0.94	

Structure #3 (Riprap Channel)

*Inlet B (West)*

Trapezoidal Riprap Channel Inputs:

Material: Riprap

Bottom Width (ft)	Left Sideslope Ratio	Right Sideslope Ratio	Slope (%)	Freeboard Depth (ft)	Freeboard % of Depth	Freeboard Mult. x (VxD)
4.00	3.0:1	3.0:1	32.0	1.00		

Riprap Channel Results:

Simons/OSM Method - Steep Slope Design

	w/o Freeboard	w/ Freeboard
Design Discharge:	1.65 cfs	
Depth:	0.03 ft	1.03 ft
Top Width:	4.19 ft	10.19 ft
Velocity*:		
X-Section Area:	0.13 sq ft	
Hydraulic Radius:	0.031 ft	
Froude Number*:		
Manning's n*:		
Dmin:	3.00 in	
D50:	9.00 in	
Dmax:	11.25 in	

Velocity and Manning's n calculations may not apply for this method.

Structure #2 (Null)

*A4N Pond 413*

### Subwatershed Hydrology Detail:

Stru #	SWS #	SWS Area (ac)	Time of Conc (hrs)	Musk K (hrs)	Musk X	Curve Number	UHS	Peak Discharge (cfs)	Runoff Volume (ac-ft)
#4	1	5.500	0.120	0.002	0.431	91.000	M	7.49	0.266
	<b>Σ</b>	<b>5.500</b>						<b>7.49</b>	<b>0.266</b>
#1	1	1.300	0.156	0.000	0.000	91.000	M	1.10	0.051
	<b>Σ</b>	<b>1.300</b>						<b>1.10</b>	<b>0.051</b>
#3	1	0.500	0.011	0.000	0.455	91.000	M	0.68	0.024
	<b>Σ</b>	<b>1.800</b>						<b>1.65</b>	<b>0.075</b>
#2	1	3.000	0.030	0.000	0.000	91.000	M	4.08	0.145
	<b>Σ</b>	<b>10.300</b>						<b>13.21</b>	<b>0.486</b>

### Subwatershed Time of Concentration Details:

Stru #	SWS #	Land Flow Condition	Slope (%)	Vert. Dist. (ft)	Horiz. Dist. (ft)	Velocity (fps)	Time (hrs)
#1	1	5. Nearly bare and untilled, and alluvial valley fans	1.84	14.00	760.00	1.350	0.156
<b>#1</b>	<b>1</b>	<b>Time of Concentration:</b>					<b>0.156</b>
#2	1	5. Nearly bare and untilled, and alluvial valley fans	3.75	6.00	160.00	1.930	0.023
		8. Large gullies, diversions, and low flowing streams	23.68	90.00	380.00	14.590	0.007
<b>#2</b>	<b>1</b>	<b>Time of Concentration:</b>					<b>0.030</b>
#3	1	5. Nearly bare and untilled, and alluvial valley fans	5.00	4.00	80.00	2.230	0.009
		8. Large gullies, diversions, and low flowing streams	43.75	70.00	160.00	19.840	0.002
<b>#3</b>	<b>1</b>	<b>Time of Concentration:</b>					<b>0.011</b>
#4	1	5. Nearly bare and untilled, and alluvial valley fans	1.11	4.00	360.00	1.050	0.095
		8. Large gullies, diversions, and low flowing streams	9.76	83.00	850.00	9.370	0.025
<b>#4</b>	<b>1</b>	<b>Time of Concentration:</b>					<b>0.120</b>

### Subwatershed Muskingum Routing Details:

Stru #	SWS #	Land Flow Condition	Slope (%)	Vert. Dist. (ft)	Horiz. Dist. (ft)	Velocity (fps)	Time (hrs)
#3	1	8. Large gullies, diversions, and low flowing streams	33.33	15.00	45.00	17.320	0.000

Stru #	SWS #	Land Flow Condition	Slope (%)	Vert. Dist. (ft)	Horiz. Dist. (ft)	Velocity (fps)	Time (hrs)
<b>#3</b>	<b>1</b>	<b>Muskingum K:</b>					<b>0.000</b>
#4	1	8. Large gullies, diversions, and low flowing streams	12.38	13.00	105.00	10.550	0.002
<b>#4</b>	<b>1</b>	<b>Muskingum K:</b>					<b>0.002</b>

## **Area 4 North Pond 413**

***The watershed for the impoundment is presented on Exhibit 11-13F. The detail design is presented on Exhibit 11-6.***

***The pond is designed to retain the runoff from the 100 yr-6 hr storm event, therefore no spillway required.***

***The ditch that diverts the flows to the pond and the inlet structures are designed to be stable for the 10 yr- 6 hr and 25 yr- 6 hr storm events, respectively.***

Ron Van Valkenburg, PE

BHP Billiton  
Navajo Mine  
PO Box 1717  
Fruitland, NM 87416

Phone: 505 598 2007

## ***General Information***

### ***Storm Information:***

Storm Type:	NRCS TYPE II-70
Design Storm:	25 yr - 6 hr
Rainfall Depth:	1.600 inches

### Structure Networking:

Type	Stru #	(flows into)	Stru #	Musk. K (hrs)	Musk. X	Description
Channel	#1	==>	#3	0.003	0.458	Berm V-ditch
Null	#2	==>	End	0.000	0.000	A4N Pond 413
Channel	#3	==>	#2	0.000	0.000	Inlet B (West)
Channel	#4	==>	#2	0.000	0.000	Inlet A (East)



### Structure Routing Details:

Stru #	Land Flow Condition	Slope (%)	Vert. Dist. (ft)	Horiz. Dist. (ft)	Velocity (fps)	Time (hrs)
#1	8. Large gullies, diversions, and low flowing streams	37.73	83.00	220.00	18.42	0.003
<b>#1</b>	<b>Muskingum K:</b>					<b>0.003</b>
#4	8. Large gullies, diversions, and low flowing streams	0.00	0.00	0.00	0.00	0.000
<b>#4</b>	<b>Muskingum K:</b>					<b>0.000</b>

***Structure Summary:***

	Immediate Contributing Area (ac)	Total Contributing Area (ac)	Peak Discharge (cfs)	Total Runoff Volume (ac-ft)
#4	5.500	5.500	10.05	0.38
#1	1.300	1.300	1.52	0.07
#3	0.500	1.800	2.29	0.11
#2	3.000	10.300	17.81	0.69

**Structure Detail:**

**Structure #4 (Riprap Channel)**

*Inlet A (East)*

Trapezoidal Riprap Channel Inputs:

Material: Riprap

Bottom Width (ft)	Left Sideslope Ratio	Right Sideslope Ratio	Slope (%)	Freeboard Depth (ft)	Freeboard % of Depth	Freeboard Mult. x (VxD)
6.00	3.0:1	3.0:1	15.2	1.00		

Riprap Channel Results:

**Simons/OSM Method - Steep Slope Design**

	w/o Freeboard	w/ Freeboard
Design Discharge:	10.05 cfs	
Depth:	0.14 ft	1.14 ft
Top Width:	6.85 ft	12.85 ft
Velocity*:		
X-Section Area:	0.91 sq ft	
Hydraulic Radius:	0.132 ft	
Froude Number*:		
Manning's n*:		
Dmin:	2.00 in	
D50:	6.00 in	
Dmax:	7.50 in	

Velocity and Manning's n calculations may not apply for this method.

**Structure #1 (Erodible Channel)**

*Berm V-ditch*

Triangular Erodible Channel Inputs:

Material: Stiff clay very colloidal

Left Sideslope Ratio	Right Sideslope Ratio	Slope (%)	Manning's n	Freeboard Depth (ft)	Freeboard % of Depth	Freeboard Mult. x (VxD)	Limiting Velocity (fps)
1.5:1	1.5:1	2.0	0.0280	1.00			5.0

Erodible Channel Results:

	w/o Freeboard	w/ Freeboard
Design Discharge:	1.52 cfs	
Depth:	0.59 ft	1.59 ft
Top Width:	1.76 ft	4.76 ft
Velocity:	2.94 fps	
X-Section Area:	0.52 sq ft	
Hydraulic Radius:	0.244 ft	
Froude Number:	0.96	

Structure #3 (Riprap Channel)

*Inlet B (West)*

Trapezoidal Riprap Channel Inputs:

Material: Riprap

Bottom Width (ft)	Left Sideslope Ratio	Right Sideslope Ratio	Slope (%)	Freeboard Depth (ft)	Freeboard % of Depth	Freeboard Mult. x (VxD)
6.00	3.0:1	3.0:1	32.0	1.00		

Riprap Channel Results:

Simons/OSM Method - Mild Slope Design

	w/o Freeboard	w/ Freeboard
Design Discharge:	2.29 cfs	
Depth:	0.00 ft	
Top Width:	0.00 ft	
Velocity:	0.00 fps	
X-Section Area:	0.00 sq ft	
Hydraulic Radius:	0.000 ft	
Froude Number:	0.00	
Manning's n:	0.0000	
Dmin:	0.00 in	
D50:	0.00 in	
Dmax:	0.00 in	

Structure #2 (Null)

*A4N Pond 413*

### Subwatershed Hydrology Detail:

Stru #	SWS #	SWS Area (ac)	Time of Conc (hrs)	Musk K (hrs)	Musk X	Curve Number	UHS	Peak Discharge (cfs)	Runoff Volume (ac-ft)
#4	1	5.500	0.120	0.002	0.431	91.000	M	10.05	0.376
	<b>Σ</b>	<b>5.500</b>						<b>10.05</b>	<b>0.376</b>
#1	1	1.300	0.156	0.000	0.000	91.000	M	1.52	0.072
	<b>Σ</b>	<b>1.300</b>						<b>1.52</b>	<b>0.072</b>
#3	1	0.500	0.011	0.000	0.455	91.000	M	0.91	0.034
	<b>Σ</b>	<b>1.800</b>						<b>2.29</b>	<b>0.107</b>
#2	1	3.000	0.030	0.000	0.000	91.000	M	5.48	0.205
	<b>Σ</b>	<b>10.300</b>						<b>17.81</b>	<b>0.688</b>

### Subwatershed Time of Concentration Details:

Stru #	SWS #	Land Flow Condition	Slope (%)	Vert. Dist. (ft)	Horiz. Dist. (ft)	Velocity (fps)	Time (hrs)
#1	1	5. Nearly bare and untilled, and alluvial valley fans	1.84	14.00	760.00	1.350	0.156
<b>#1</b>	<b>1</b>	<b>Time of Concentration:</b>					<b>0.156</b>
#2	1	5. Nearly bare and untilled, and alluvial valley fans	3.75	6.00	160.00	1.930	0.023
		8. Large gullies, diversions, and low flowing streams	23.68	90.00	380.00	14.590	0.007
<b>#2</b>	<b>1</b>	<b>Time of Concentration:</b>					<b>0.030</b>
#3	1	5. Nearly bare and untilled, and alluvial valley fans	5.00	4.00	80.00	2.230	0.009
		8. Large gullies, diversions, and low flowing streams	43.75	70.00	160.00	19.840	0.002
<b>#3</b>	<b>1</b>	<b>Time of Concentration:</b>					<b>0.011</b>
#4	1	5. Nearly bare and untilled, and alluvial valley fans	1.11	4.00	360.00	1.050	0.095
		8. Large gullies, diversions, and low flowing streams	9.76	83.00	850.00	9.370	0.025
<b>#4</b>	<b>1</b>	<b>Time of Concentration:</b>					<b>0.120</b>

### Subwatershed Muskingum Routing Details:

Stru #	SWS #	Land Flow Condition	Slope (%)	Vert. Dist. (ft)	Horiz. Dist. (ft)	Velocity (fps)	Time (hrs)
#3	1	8. Large gullies, diversions, and low flowing streams	33.33	15.00	45.00	17.320	0.000

Stru #	SWS #	Land Flow Condition	Slope (%)	Vert. Dist. (ft)	Horiz. Dist. (ft)	Velocity (fps)	Time (hrs)
<b>#3</b>	<b>1</b>	<b>Muskingum K:</b>					<b>0.000</b>
#4	1	8. Large gullies, diversions, and low flowing streams	12.38	13.00	105.00	10.550	0.002
<b>#4</b>	<b>1</b>	<b>Muskingum K:</b>					<b>0.002</b>

## **Pond 301**

*The watershed for Pond 301 is shown on Exhibit 11-13E. The detail design is on Exhibit 11-162.*

*This pond is designed to retain the 100 yr-6 hr storm event, therefore no spillway is required.*

R. Yazzie

BHP Billiton  
Navajo Mine  
PO Box 1717  
Fruitland, NM 87416

Phone: 505 598 2007

## *General Information*

### *Storm Information:*

Storm Type:	NRCS TYPE II-70
Design Storm:	100 yr - 6 hr
Rainfall Depth:	2.000 inches

**Structure Networking:**

Type	Stru #	(flows into)	Stru #	Musk. K (hrs)	Musk. X	Description
Null	#1	==>	End	0.000	0.000	POND 301
Channel	#2	==>	#1	0.000	0.000	Inlet Channel



***Structure Summary:***

	Immediate Contributing Area (ac)	Total Contributing Area (ac)	Peak Discharge (cfs)	Total Runoff Volume (ac-ft)
#2	32.900	32.900	50.60	2.44
#1	0.000	32.900	50.60	2.44

### Structure Detail:

Structure #2 (Riprap Channel)

*Inlet Channel*

Trapezoidal Riprap Channel Inputs:

Material: Riprap

Bottom Width (ft)	Left Sideslope Ratio	Right Sideslope Ratio	Slope (%)	Freeboard Depth (ft)	Freeboard % of Depth	Freeboard Mult. x (VxD)
18.00	2.0:1	2.0:1	10.0	1.00		

Riprap Channel Results:

#### Simons/OSM Method - Steep Slope Design

	w/o Freeboard	w/ Freeboard
Design Discharge:	50.60 cfs	
Depth:	0.32 ft	1.32 ft
Top Width:	19.27 ft	23.27 ft
Velocity*:		
X-Section Area:	5.90 sq ft	
Hydraulic Radius:	0.304 ft	
Froude Number*:		
Manning's n*:		
Dmin:	2.00 in	
D50:	6.00 in	
Dmax:	7.50 in	

Velocity and Manning's n calculations may not apply for this method.

Structure #1 (Null)

*POND 301*

***Subwatershed Hydrology Detail:***

Stru #	SWS #	SWS Area (ac)	Time of Conc (hrs)	Musk K (hrs)	Musk X	Curve Number	UHS	Peak Discharge (cfs)	Runoff Volume (ac-ft)
#2	1	32.900	0.154	0.000	0.000	90.000	M	50.60	2.437
	<b>Σ</b>	<b>32.900</b>						<b>50.60</b>	<b>2.437</b>
<b>#1</b>	<b>Σ</b>	<b>32.900</b>						<b>50.60</b>	<b>2.437</b>

***Subwatershed Time of Concentration Details:***

Stru #	SWS #	Land Flow Condition	Slope (%)	Vert. Dist. (ft)	Horiz. Dist. (ft)	Velocity (fps)	Time (hrs)
#2	1	5. Nearly bare and untilled, and alluvial valley fans	4.29	6.00	140.00	2.070	0.018
		8. Large gullies, diversions, and low flowing streams	2.55	60.00	2,353.00	4.790	0.136
<b>#2</b>	<b>1</b>	<b>Time of Concentration:</b>					<b>0.154</b>

## **Pond 301**

***The watershed for Pond 301 is shown on Exhibit 11-13E. The detail design is on Exhibit 11-162.***

***The inlet channel is designed to be stable for the 10 yr-6 hr storm event.***

***Nov 2010***

LR

BHP Navajo Coal Company  
P.O. Box 1717  
Fruitland, NM 87416

Phone: 505-598-4200


## ***General Information***

### ***Storm Information:***

Storm Type:	NM TYPE II 70
Design Storm:	10 yr - 6 hr
Rainfall Depth:	1.230 inches

### ***Structure Networking:***

Type	Stru #	(flows into)	Stru #	Musk. K (hrs)	Musk. X	Description
Null	#1	==>	End	0.000	0.000	POND 301
Channel	#2	==>	#1	0.000	0.000	Inlet Channel

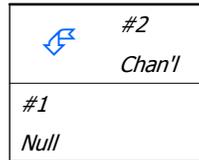

***Structure Summary:***

	Immediate Contributing Area (ac)	Total Contributing Area (ac)	Peak Discharge (cfs)	Total Runoff Volume (ac-ft)
#2	32.900	32.900	23.50	1.07
#1	0.000	32.900	23.50	1.07

## ***Structure Detail:***

### ***Structure #2 (Riprap Channel)***

#### ***Inlet Channel***

Trapezoidal Riprap Channel Inputs:

#### Material: Riprap

Bottom Width (ft)	Left Sideslope Ratio	Right Sideslope Ratio	Slope (%)	Freeboard Depth (ft)	Freeboard % of Depth	Freeboard Mult. x (VxD)
6.00	2.0:1	2.0:1	10.0	0.70		

Riprap Channel Results:

#### Simons/OSM Method - Steep Slope Design

	w/o Freeboard	w/ Freeboard
Design Discharge:	23.50 cfs	
Depth:	0.32 ft	1.02 ft
Top Width:	7.30 ft	10.10 ft
Velocity*:		
X-Section Area:	2.15 sq ft	
Hydraulic Radius:	0.289 ft	
Froude Number*:		
Manning's n*:		
Dmin:	3.00 in	
D50:	9.00 in	
Dmax:	11.25 in	

Velocity and Manning's n calculations may not apply for this method.

### ***Structure #1 (Null)***

#### ***POND 301***

### ***Subwatershed Hydrology Detail:***

Stru #	SWS #	SWS Area (ac)	Time of Conc (hrs)	Musk K (hrs)	Musk X	Curve Number	UHS	Peak Discharge (cfs)	Runoff Volume (ac-ft)
#2	1	32.900	0.154	0.000	0.000	90.000	M	23.50	1.068
	<b>Σ</b>	<b>32.900</b>						<b>23.50</b>	<b>1.068</b>
<b>#1</b>	<b>Σ</b>	<b>32.900</b>						<b>23.50</b>	<b>1.068</b>

### ***Subwatershed Time of Concentration Details:***

Stru #	SWS #	Land Flow Condition	Slope (%)	Vert. Dist. (ft)	Horiz. Dist. (ft)	Velocity (fps)	Time (hrs)
#2	1	5. Nearly bare and untilled, and alluvial valley fans	4.29	6.00	140.00	2.070	0.018
		8. Large gullies, diversions, and low flowing streams	2.55	60.00	2,353.00	4.790	0.136
<b>#2</b>	<b>1</b>	<b>Time of Concentration:</b>					<b>0.154</b>

## **Pond 302**

*The watershed for this impoundment is shown on Exhibit 11-13E.  
The impoundment design is on Exhibit 11-162.*

*The pond is designed to retain the runoff from the 100-yr 6-hr  
storm event, therefore no spillway is required.*

R. Yazzie

BHP Billiton  
Navajo Mine  
PO Box 1717  
Fruitland, NM 87416

Phone: 505 598 2007


## *General Information*

### *Storm Information:*

Storm Type:	NRCS TYPE II-70
Design Storm:	100 yr - 6 hr
Rainfall Depth:	2.000 inches

### Structure Networking:

Type	Stru #	(flows into)	Stru #	Musk. K (hrs)	Musk. X	Description
Null	#1	==>	End	0.000	0.000	POND 302
Channel	#2	==>	#1	0.000	0.000	West Inlet
Channel	#3	==>	#1	0.000	0.000	East Inlet

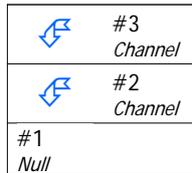

***Structure Summary:***

	Immediate Contributing Area (ac)	Total Contributing Area (ac)	Peak Discharge (cfs)	Total Runoff Volume (ac-ft)
#3	9.940	9.940	23.54	0.91
#2	28.400	28.400	67.27	2.59
#1	3.400	41.740	98.87	3.81

### Structure Detail:

#### Structure #3 (Riprap Channel)

East Inlet

Trapezoidal Riprap Channel Inputs:

Material: Riprap

Bottom Width (ft)	Left Sideslope Ratio	Right Sideslope Ratio	Slope (%)	Freeboard Depth (ft)	Freeboard % of Depth	Freeboard Mult. x (VxD)
10.00	2.0:1	2.0:1	25.0	1.00		

Riprap Channel Results:

#### Simons/OSM Method - Steep Slope Design

	w/o Freeboard	w/ Freeboard
Depth:	0.14 ft	1.14 ft
Top Width:	10.58 ft	14.58 ft
Velocity*:		
X-Section Area:	1.48 sq ft	
Hydraulic Radius:	0.139	
Froude Number*:		
Manning's n*:		
Dmin:	3.00 in	
D50:	9.00 in	
Dmax:	11.25 in	

Velocity and Manning's n calculations may not apply for this method.

#### Structure #2 (Riprap Channel)

West Inlet

Trapezoidal Riprap Channel Inputs:

Material: Riprap

Bottom Width (ft)	Left Sideslope Ratio	Right Sideslope Ratio	Slope (%)	Freeboard Depth (ft)	Freeboard % of Depth	Freeboard Mult. x (VxD)
12.00	2.0:1	2.0:1	20.0	1.00		

Riprap Channel Results:

#### Simons/OSM Method - Steep Slope Design

	w/o Freeboard	w/ Freeboard
Depth:	0.35 ft	1.35 ft
Top Width:	13.40 ft	17.40 ft
Velocity*:		
X-Section Area:	4.45 sq ft	
Hydraulic Radius:	0.328	
Froude Number*:		
Manning's n*:		
Dmin:	4.00 in	
D50:	12.00 in	
Dmax:	15.00 in	

Velocity and Manning's n calculations may not apply for this method.

## Structure #1 (Null)

*POND 302*

### Subwatershed Hydrology Detail:

Stru #	SWS #	SWS Area (ac)	Time of Conc (hrs)	Musk K (hrs)	Musk X	Curve Number	UHS	Peak Discharge (cfs)	Runoff Volume (ac-ft)
#3	1	9.940	0.029	0.000	0.000	90.000	M	23.54	0.91
	<b>S</b>	<b>9.940</b>						<b>23.54</b>	<b>0.91</b>
#2	1	28.400	0.121	0.000	0.000	90.000	M	67.27	2.59
	<b>S</b>	<b>28.400</b>						<b>67.27</b>	<b>2.59</b>
#1	1	3.400	0.017	0.000	0.000	90.000	M	8.05	0.31
	<b>S</b>	<b>41.740</b>						<b>98.87</b>	<b>3.81</b>

### Subwatershed Time of Concentration Details:

Stru #	SWS #	Land Flow Condition	Slope (%)	Vert. Dist. (ft)	Horiz. Dist. (ft)	Velocity (fps)	Time (hrs)
#1	1	5. Nearly bare and untilled, and alluvial valley fans	3.48	4.16	119.64	1.860	0.017
<b>#1</b>	<b>1</b>	<b>Time of Concentration:</b>					<b>0.017</b>
#2	1	5. Nearly bare and untilled, and alluvial valley fans	3.33	4.00	120.00	1.820	0.018
		8. Large gullies, diversions, and low flowing streams	3.20	64.00	2,000.00	5.360	0.103
<b>#2</b>	<b>1</b>	<b>Time of Concentration:</b>					<b>0.121</b>
#3	1	5. Nearly bare and untilled, and alluvial valley fans	25.00	20.00	80.00	5.000	0.004
		8. Large gullies, diversions, and low flowing streams	5.97	40.00	670.00	7.330	0.025
<b>#3</b>	<b>1</b>	<b>Time of Concentration:</b>					<b>0.029</b>

## **Pond 302**

***The watershed for this impoundment is shown on Exhibit 11-13E. The impoundment design is on Exhibit 11-162.***

***The inlets to the pond are design to be stable for 10 yr -6 hr storm event.***

LR

BHP Navajo Coal Company  
Navajo Mine  
PO Box 1717  
Fruitland, NM 87416  
Phone: 505 598 2007

## ***General Information***

### ***Storm Information:***

Storm Type:	NM TYPE II 70
Design Storm:	25 yr - 6 hr
Rainfall Depth:	1.500 inches

***Structure Summary:***

	Immediate Contributing Area (ac)	Total Contributing Area (ac)	Peak Discharge (cfs)	Total Runoff Volume (ac-ft)
#3	9.940	9.940	15.82	0.57
#2	28.400	28.400	45.19	1.61
#1	3.400	41.740	66.42	2.37

### ***Structure Networking:***

Type	Stru #	(flows into)	Stru #	Musk. K (hrs)	Musk. X	Description
Null	#1	==>	End	0.000	0.000	POND 302
Channel	#2	==>	#1	0.000	0.000	West Inlet
Channel	#3	==>	#1	0.000	0.000	East Inlet



## ***Structure Detail:***

### *Structure #3 (Riprap Channel)*

#### *East Inlet*

Trapezoidal Riprap Channel Inputs:

#### Material: Riprap

Bottom Width (ft)	Left Sideslope Ratio	Right Sideslope Ratio	Slope (%)	Freeboard Depth (ft)	Freeboard % of Depth	Freeboard Mult. x (VxD)
12.00	4.0:1	4.0:1	19.0	1.00		

Riprap Channel Results:

#### Simons/OSM Method - Steep Slope Design

	w/o Freeboard	w/ Freeboard
Design Discharge:	15.82 cfs	
Depth:	0.11 ft	1.11 ft
Top Width:	12.88 ft	20.88 ft
Velocity*:		
X-Section Area:	1.37 sq ft	
Hydraulic Radius:	0.106 ft	
Froude Number*:		
Manning's n*:		
Dmin:	2.00 in	
D50:	6.00 in	
Dmax:	7.50 in	

Velocity and Manning's n calculations may not apply for this method.

### *Structure #2 (Riprap Channel)*

#### *West Inlet*

Trapezoidal Riprap Channel Inputs:

#### Material: Riprap

Bottom Width (ft)	Left Sideslope Ratio	Right Sideslope Ratio	Slope (%)	Freeboard Depth (ft)	Freeboard % of Depth	Freeboard Mult. x (VxD)
12.00	4.0:1	4.0:1	20.0	1.00		

Riprap Channel Results:

#### Simons/OSM Method - Steep Slope Design

	w/o Freeboard	w/ Freeboard
Design Discharge:	45.19 cfs	
Depth:	0.26 ft	1.26 ft
Top Width:	14.04 ft	22.04 ft
Velocity*:		
X-Section Area:	3.32 sq ft	
Hydraulic Radius:	0.236 ft	
Froude Number*:		
Manning's n*:		
Dmin:	3.00 in	
D50:	9.00 in	
Dmax:	11.25 in	

Velocity and Manning's n calculations may not apply for this method.

## Structure #1 (Null)

*POND 302*

### ***Subwatershed Hydrology Detail:***

Stru #	SWS #	SWS Area (ac)	Time of Conc (hrs)	Musk K (hrs)	Musk X	Curve Number	UHS	Peak Discharge (cfs)	Runoff Volume (ac-ft)
#3	1	9.940	0.029	0.000	0.000	90.000	M	15.82	0.565
	<b>Σ</b>	<b>9.940</b>						<b>15.82</b>	<b>0.565</b>
#2	1	28.400	0.121	0.000	0.000	90.000	M	45.19	1.615
	<b>Σ</b>	<b>28.400</b>						<b>45.19</b>	<b>1.615</b>
#1	1	3.400	0.017	0.000	0.000	90.000	M	5.41	0.193
	<b>Σ</b>	<b>41.740</b>						<b>66.42</b>	<b>2.373</b>

### ***Subwatershed Time of Concentration Details:***

Stru #	SWS #	Land Flow Condition	Slope (%)	Vert. Dist. (ft)	Horiz. Dist. (ft)	Velocity (fps)	Time (hrs)
#1	1	5. Nearly bare and untilled, and alluvial valley fans	3.48	4.16	119.64	1.860	0.017
<b>#1</b>	<b>1</b>	<b>Time of Concentration:</b>					<b>0.017</b>
#2	1	5. Nearly bare and untilled, and alluvial valley fans	3.33	4.00	120.00	1.820	0.018
		8. Large gullies, diversions, and low flowing streams	3.20	64.00	2,000.00	5.360	0.103
<b>#2</b>	<b>1</b>	<b>Time of Concentration:</b>					<b>0.121</b>
#3	1	5. Nearly bare and untilled, and alluvial valley fans	25.00	20.00	80.00	5.000	0.004
		8. Large gullies, diversions, and low flowing streams	5.97	40.00	670.00	7.330	0.025
<b>#3</b>	<b>1</b>	<b>Time of Concentration:</b>					<b>0.029</b>

## **POND 5 & CELL A2**

***The watershed areas for the ponds are presented on Exhibit 11-13B. The design for Pond 5 and Cell A2 are presented on Exhibits 11-105A and 11-106, respectively. The hydrology for Pond 5 was updated in conjunction with the North Cells design modification. The hydrology model for Pond 5 and Cell A2 is attach.***

***Updated June 2010***

LR

BHP Navajo Coal Company  
P.O. Box 1717  
Fruitland, NM 87416

Phone: 505-598-4200


## ***General Information***

### ***Storm Information:***

Storm Type:	NM TYPE II 70
Design Storm:	100 yr - 6 hr
Rainfall Depth:	1.960 inches

### Structure Networking:

Type	Stru #	(flows into)	Stru #	Musk. K (hrs)	Musk. X	Description
Null	#1	==>	#3	0.054	0.277	LIFT STATION 2
Null	#2	==>	#3	0.049	0.277	LIFT STATION 4
Null	#3	==>	#4	0.229	0.277	LIFT STATION 3
Null	#4	==>	#6	0.000	0.000	
Null	#5	==>	#6	0.000	0.000	
Pond	#6	==>	#7	0.000	0.000	POND 5
Null	#7	==>	End	0.000	0.000	CELL A2

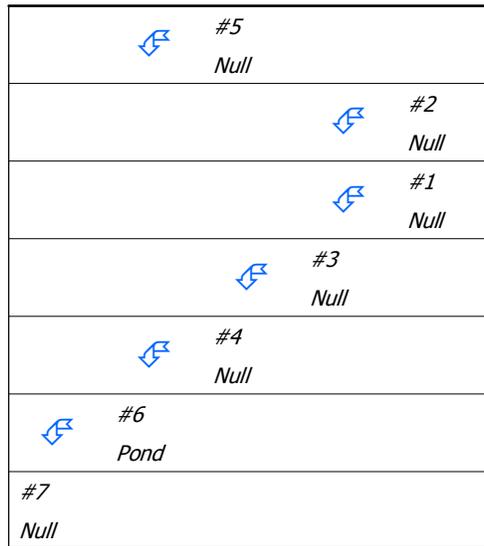

**Structure Summary:**

	Immediate Contributing Area (ac)	Total Contributing Area (ac)	Peak Discharge (cfs)	Total Runoff Volume (ac-ft)
#5	13.100	13.100	5.16	0.24
#2	6.600	6.600	2.45	0.13
#1	1.200	1.200	1.88	0.09
#3	9.500	17.300	10.59	0.60
#4	0.000	17.300	9.10	0.60
#6 In	11.500	41.900	36.53	1.92
Out			2.25	1.92
#7	10.000	51.900	16.28	2.67

### Structure Detail:

Structure #5 (Null)

Structure #2 (Null)

LIFT STATION 4

Structure #1 (Null)

LIFT STATION 2

Structure #3 (Null)

LIFT STATION 3

Structure #4 (Null)

Structure #6 (Pond)

POND 5

Pond Inputs:

Initial Pool Elev:	5,328.75 ft
Initial Pool:	0.14 ac-ft

Pond Results:

Peak Elevation:	5,331.72 ft
Dewater Time:	0.14 days

*Dewatering time is calculated from peak stage to lowest spillway*

### Elevation-Capacity-Discharge Table

Elevation	Area (ac)	Capacity (ac-ft)	Discharge (cfs)	Dewater Time (hrs)
5,328.40	0.390	0.000	0.000	
5,328.41	0.391	0.004	0.000	
5,328.60	0.403	0.079	0.000	
5,328.75	0.413	0.141	0.000	
5,329.00	0.430	0.246	2.250	
5,329.40	0.446	0.421	2.250	
5,330.00	0.470	0.696	2.250	
5,330.40	0.486	0.887	2.250	
5,331.00	0.510	1.186	2.250	
5,331.40	0.526	1.393	2.250	

Elevation	Area (ac)	Capacity (ac-ft)	Discharge (cfs)	Dewater Time (hrs)
5,331.72	0.539	1.565	2.250	3.45 Peak Stage
5,332.00	0.550	1.716	2.250	
5,332.40	0.570	1.939	2.250	
5,333.00	0.600	2.290	2.250	

Detailed Discharge Table

Elevation (ft)	User- input discharge (cfs)	Combined Total Discharge (cfs)
5,328.40	0.000	0.000
5,328.41	0.000	0.000
5,328.60	0.000	0.000
5,328.75	0.000	0.000
5,329.00	2.250	2.250
5,329.40	2.250	2.250
5,330.00	2.250	2.250
5,330.40	2.250	2.250
5,331.00	2.250	2.250
5,331.40	2.250	2.250
5,332.00	2.250	2.250
5,332.40	2.250	2.250
5,333.00	2.250	2.250

Structure #7 (Null)

CELL A2

### ***Subwatershed Hydrology Detail:***

Stru #	SWS #	SWS Area (ac)	Time of Conc (hrs)	Musk K (hrs)	Musk X	Curve Number	UHS	Peak Discharge (cfs)	Runoff Volume (ac-ft)
#5	1	12.500	0.176	0.000	0.000	70.000	M	4.27	0.191
	2	0.600	0.198	0.000	0.000	91.000	M	0.90	0.045
	<b>Σ</b>	<b>13.100</b>						<b>5.16</b>	<b>0.236</b>
#2	1	0.500	0.198	0.045	0.277	91.000	M	0.75	0.038
	2	6.100	0.238	0.000	0.000	70.000	M	1.80	0.092
	<b>Σ</b>	<b>6.600</b>						<b>2.45</b>	<b>0.130</b>
#1	1	1.200	0.138	0.000	0.000	91.000	M	1.88	0.092
	<b>Σ</b>	<b>1.200</b>						<b>1.88</b>	<b>0.092</b>
#3	1	1.700	0.055	0.058	0.277	91.000	M	4.07	0.160
	2	1.300	0.119	0.000	0.000	91.000	M	3.11	0.122
	3	6.500	0.218	0.000	0.000	70.000	M	2.00	0.098
	<b>Σ</b>	<b>17.300</b>						<b>10.59</b>	<b>0.601</b>
<b>#4</b>	<b>Σ</b>	<b>17.300</b>						<b>9.10</b>	<b>0.601</b>
#6	1	11.500	0.069	0.000	0.000	91.000	M	27.51	1.080
	<b>Σ</b>	<b>41.900</b>						<b>36.53</b>	<b>1.917</b>
#7	1	10.000	0.256	0.000	0.000	91.000	M	14.03	0.754
	<b>Σ</b>	<b>51.900</b>						<b>16.28</b>	<b>2.671</b>


### ***Subwatershed Time of Concentration Details:***

Stru #	SWS #	Land Flow Condition	Slope (%)	Vert. Dist. (ft)	Horiz. Dist. (ft)	Velocity (fps)	Time (hrs)
#1	1	5. Nearly bare and untilled, and alluvial valley fans	0.50	1.75	350.00	0.700	0.138
<b>#1</b>	<b>1</b>	<b>Time of Concentration:</b>					<b>0.138</b>
#2	1	5. Nearly bare and untilled, and alluvial valley fans	0.50	2.50	500.00	0.700	0.198
<b>#2</b>	<b>1</b>	<b>Time of Concentration:</b>					<b>0.198</b>
#2	2	5. Nearly bare and untilled, and alluvial valley fans	0.50	3.00	600.00	0.700	0.238
<b>#2</b>	<b>2</b>	<b>Time of Concentration:</b>					<b>0.238</b>
#3	1	5. Nearly bare and untilled, and alluvial valley fans	4.00	16.00	400.00	2.000	0.055
<b>#3</b>	<b>1</b>	<b>Time of Concentration:</b>					<b>0.055</b>
#3	2	5. Nearly bare and untilled, and alluvial valley fans	0.50	1.50	300.00	0.700	0.119
<b>#3</b>	<b>2</b>	<b>Time of Concentration:</b>					<b>0.119</b>

Stru #	SWS #	Land Flow Condition	Slope (%)	Vert. Dist. (ft)	Horiz. Dist. (ft)	Velocity (fps)	Time (hrs)
#3	3	5. Nearly bare and untilled, and alluvial valley fans	0.50	2.75	550.00	0.700	0.218
<b>#3</b>	<b>3</b>	<b>Time of Concentration:</b>					<b>0.218</b>
#5	1	5. Nearly bare and untilled, and alluvial valley fans	3.00	33.00	1,100.00	1.730	0.176
<b>#5</b>	<b>1</b>	<b>Time of Concentration:</b>					<b>0.176</b>
#5	2	5. Nearly bare and untilled, and alluvial valley fans	0.50	2.50	500.00	0.700	0.198
<b>#5</b>	<b>2</b>	<b>Time of Concentration:</b>					<b>0.198</b>
#6	1	8. Large gullies, diversions, and low flowing streams	3.00	39.00	1,300.00	5.190	0.069
<b>#6</b>	<b>1</b>	<b>Time of Concentration:</b>					<b>0.069</b>
#7	1	5. Nearly bare and untilled, and alluvial valley fans	1.24	3.00	242.00	1.110	0.060
		8. Large gullies, diversions, and low flowing streams	1.15	26.00	2,266.00	3.210	0.196
<b>#7</b>	<b>1</b>	<b>Time of Concentration:</b>					<b>0.256</b>


### ***Subwatershed Muskingum Routing Details:***

Stru #	SWS #	Land Flow Condition	Slope (%)	Vert. Dist. (ft)	Horiz. Dist. (ft)	Velocity (fps)	Time (hrs)
#2	1	8. Large gullies, diversions, and low flowing streams	0.50	1.75	350.00	2.120	0.045
<b>#2</b>	<b>1</b>	<b>Muskingum K:</b>					<b>0.045</b>
#3	1	8. Large gullies, diversions, and low flowing streams	0.50	2.25	450.00	2.120	0.058
<b>#3</b>	<b>1</b>	<b>Muskingum K:</b>					<b>0.058</b>

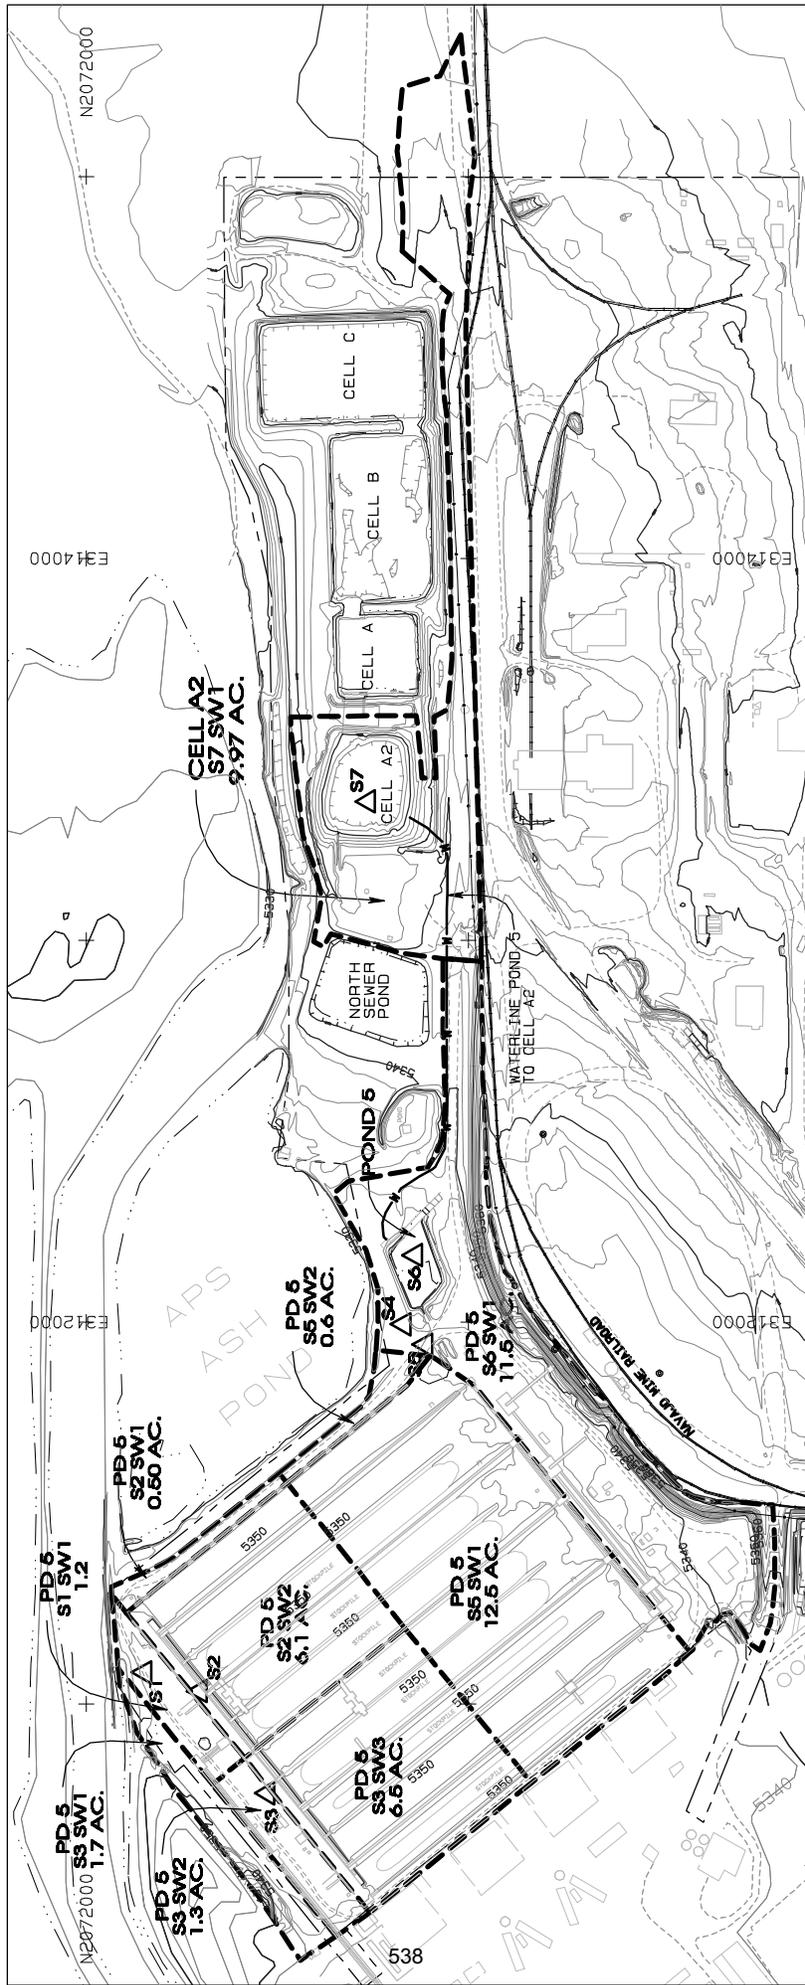

POND 5 & CELL A2  
HYDROLOGY MODEL

# POND 5 & CELL A2 SEDCAD MODELING SCHEMATIC

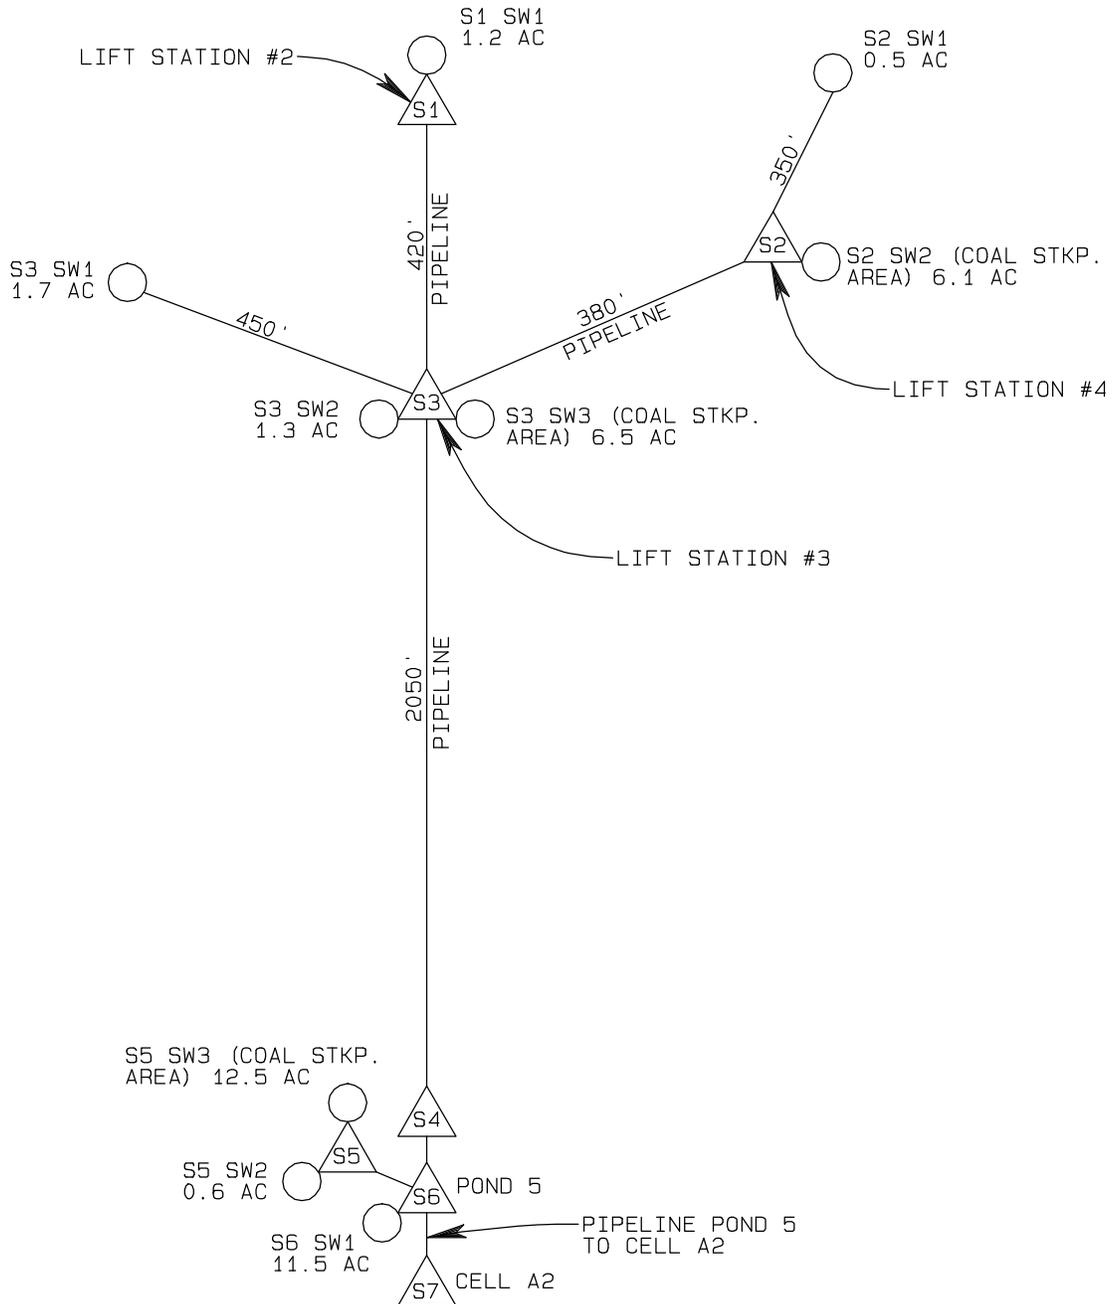

## LEGEND

- STRUCTURE
- SUB- WATERSHEDS

FOR MORE DETAILS SEE EXHIBIT 11-15

This page is intentionally left blank due to Permit Modification

Pages 540 through 554

## **DIXON POND-306**

***The watershed for this impoundment is shown on exhibit 11-13E.  
The impoundment design on Exhibit 11-169***

***The Pond is designed to retain the runoff from the 100 yr - 6 hr  
storm event, therefore no spillway is required.***

R. Yazzie

---

## ***General Information***

### ***Storm Information:***

Storm Type:	TYPE 11-70_RY
Design Storm:	100 yr - 6 hr
Rainfall Depth:	2.000 inches

### Structure Networking:

Type	Stru #	(flows into)	Stru #	Musk. K (hrs)	Musk. X	Description
Channel	#1	==>	#4	0.000	0.000	SOUTH INLET
Channel	#2	==>	#1	0.002	0.399	DRAIN INTO SOUTH INLET
Channel	#3	==>	#4	0.000	0.000	NORTH INLET
Null	#4	==>	End	0.000	0.000	DIXON POND-306



### Structure Routing Details:

Stru #	Land Flow Condition	Slope (%)	Vert. Dist. (ft)	Horiz. Dist. (ft)	Velocity (fps)	Time (hrs)
#2	8. Large gullies, diversions, and low flowing streams	5.04	3.38	67.00	6.73	0.002
<b>#2</b>	<b>Muskingum K:</b>					<b>0.002</b>

***Structure Summary:***

	Immediate Contributing Area (ac)	Total Contributing Area (ac)	Peak Discharge (cfs)	Total Runoff Volume (ac-ft)
#3	58.230	58.230	70.67	3.33
#2	0.730	0.730	1.67	0.06
#1	0.850	1.580	3.61	0.14
#4	1.860	61.670	71.53	3.60

### Structure Detail:

Structure #3 (Riprap Channel)

*NORTH INLET*

Trapezoidal Riprap Channel Inputs:

Material: Riprap

Bottom Width (ft)	Left Sideslope Ratio	Right Sideslope Ratio	Slope (%)	Freeboard Depth (ft)	Freeboard % of Depth	Freeboard Mult. x (VxD)
8.00	2.0:1	2.0:1	12.6			

Riprap Channel Results:

**PADER Method - Steep Slope Design**

	w/o Freeboard	w/ Freeboard
Design Discharge:	70.67 cfs	
Depth:	0.88 ft	
Top Width:	11.53 ft	
Velocity:	8.19 fps	
X-Section Area:	8.63 sq ft	
Hydraulic Radius:	0.722 ft	
Froude Number:	1.67	
Manning's n:	0.0520	
Dmin:	3.00 in	
D50:	6.00 in	
Dmax:	9.00 in	

Structure #2 (Riprap Channel)

*DRAIN INTO SOUTH INLET*

Trapezoidal Riprap Channel Inputs:

Material: Riprap

Bottom Width (ft)	Left Sideslope Ratio	Right Sideslope Ratio	Slope (%)	Freeboard Depth (ft)	Freeboard % of Depth	Freeboard Mult. x (VxD)
6.00	2.0:1	2.0:1	6.7			

Riprap Channel Results:

**Simons/OSM Method - Steep Slope Design**

	w/o Freeboard	w/ Freeboard
Design Discharge:	1.67 cfs	
Depth:	0.07 ft	
Top Width:	6.29 ft	
Velocity*:		
X-Section Area:	0.45 sq ft	
Hydraulic Radius:	0.072 ft	
Froude Number*:		
Manning's n*:		
Dmin:	1.00 in	
D50:	3.00 in	
Dmax:	3.75 in	

Velocity and Manning's n calculations may not apply for this method.

Structure #1 (Riprap Channel)

*SOUTH INLET*

Trapezoidal Riprap Channel Inputs:

Material: Riprap

Bottom Width (ft)	Left Sideslope Ratio	Right Sideslope Ratio	Slope (%)	Freeboard Depth (ft)	Freeboard % of Depth	Freeboard Mult. x (VxD)
6.00	2.0:1	2.0:1	17.7			

Riprap Channel Results:

Simons/OSM Method - Steep Slope Design

	w/o Freeboard	w/ Freeboard
Design Discharge:	3.61 cfs	
Depth:	0.06 ft	
Top Width:	6.24 ft	
Velocity*:		
X-Section Area:	0.37 sq ft	
Hydraulic Radius:	0.058 ft	
Froude Number*:		
Manning's n*:		
Dmin:	2.00 in	
D50:	6.00 in	
Dmax:	7.50 in	

Velocity and Manning's n calculations may not apply for this method.

Structure #4 (Null)

*DIXON POND-306*

### ***Subwatershed Hydrology Detail:***

Stru #	SWS #	SWS Area (ac)	Time of Conc (hrs)	Musk K (hrs)	Musk X	Curve Number	UHS	Peak Discharge (cfs)	Runoff Volume (ac-ft)
#3	1	58.230	0.181	0.000	0.000	86.000	M	70.67	3.332
	<b>Σ</b>	<b>58.230</b>						<b>70.67</b>	<b>3.332</b>
#2	1	0.730	0.013	0.000	0.461	89.000	M	1.67	0.062
	<b>Σ</b>	<b>0.730</b>						<b>1.67</b>	<b>0.062</b>
#1	1	0.850	0.015	0.000	0.000	89.000	M	1.94	0.073
	<b>Σ</b>	<b>1.580</b>						<b>3.61</b>	<b>0.135</b>
#4	1	1.860	0.012	0.000	0.000	86.000	M	3.77	0.131
	<b>Σ</b>	<b>61.670</b>						<b>71.53</b>	<b>3.599</b>

### ***Subwatershed Time of Concentration Details:***

Stru #	SWS #	Land Flow Condition	Slope (%)	Vert. Dist. (ft)	Horiz. Dist. (ft)	Velocity (fps)	Time (hrs)
#1	1	5. Nearly bare and untilled, and alluvial valley fans	14.10	1.10	7.80	3.750	0.000
		8. Large gullies, diversions, and low flowing streams	5.67	22.70	400.30	7.140	0.015
<b>#1</b>	<b>1</b>	<b>Time of Concentration:</b>					<b>0.015</b>
#2	1	5. Nearly bare and untilled, and alluvial valley fans	6.12	2.40	39.23	2.470	0.004
		8. Large gullies, diversions, and low flowing streams	7.10	19.00	267.53	7.990	0.009
<b>#2</b>	<b>1</b>	<b>Time of Concentration:</b>					<b>0.013</b>
#3	1	5. Nearly bare and untilled, and alluvial valley fans	5.72	20.00	349.88	2.390	0.040
		8. Large gullies, diversions, and low flowing streams	1.61	31.19	1,937.83	3.800	0.141
<b>#3</b>	<b>1</b>	<b>Time of Concentration:</b>					<b>0.181</b>
#4	1	5. Nearly bare and untilled, and alluvial valley fans	11.92	1.58	13.25	3.450	0.001
		8. Large gullies, diversions, and low flowing streams	2.48	4.73	190.66	4.720	0.011
<b>#4</b>	<b>1</b>	<b>Time of Concentration:</b>					<b>0.012</b>

### ***Subwatershed Muskingum Routing Details:***

Stru #	SWS #	Land Flow Condition	Slope (%)	Vert. Dist. (ft)	Horiz. Dist. (ft)	Velocity (fps)	Time (hrs)
#2	1	9. Small streams flowing bankfull	5.04	3.38	67.00	20.210	0.000
<b>#2</b>	<b>1</b>	<b>Muskingum K:</b>					<b>0.000</b>

# **GILMORE SILOS** **POND 309A**

*For pond location and watershed refer to Exhibit 11-13E. The pond design is presented on Exhibit 11-171. Hydrology model is presented on the attach sheet.*

LR

BHP Navajo Coal Company  
PO Box 1717  
Fruitland, NM 87416

Phone: (505) 598-3317

## ***General Information***

### ***Storm Information:***

Storm Type:	NM TYPE II 70
Design Storm:	100 yr - 6 hr
Rainfall Depth:	1.970 inches

***Structure Networking:***

Type	Stru #	(flows into)	Stru #	Musk. K (hrs)	Musk. X	Description
Null	#1	==>	End	0.000	0.000	Pond 309A

#1
Null

***Structure Summary:***

	Immediate Contributing Area (ac)	Total Contributing Area (ac)	Peak Discharge (cfs)	Total Runoff Volume (ac-ft)
#1	2.800	2.800	7.19	0.30

---

***Structure Detail:***

*Structure #1 (Null)*


*Pond 309A*

### *Subwatershed Hydrology Detail:*

Stru #	SWS #	SWS Area (ac)	Time of Conc (hrs)	Musk K (hrs)	Musk X	Curve Number	UHS	Peak Discharge (cfs)	Runoff Volume (ac-ft)
#1	1	2.800	0.065	0.000	0.000	93.000	M	7.19	0.300
	<b>Σ</b>	<b>2.800</b>						<b>7.19</b>	<b>0.300</b>

### *Subwatershed Time of Concentration Details:*

Stru #	SWS #	Land Flow Condition	Slope (%)	Vert. Dist. (ft)	Horiz. Dist. (ft)	Velocity (fps)	Time (hrs)
#1	1	5. Nearly bare and untilled, and alluvial valley fans	3.29	14.00	426.00	1.810	0.065
<b>#1</b>	<b>1</b>	<b>Time of Concentration:</b>					<b>0.065</b>

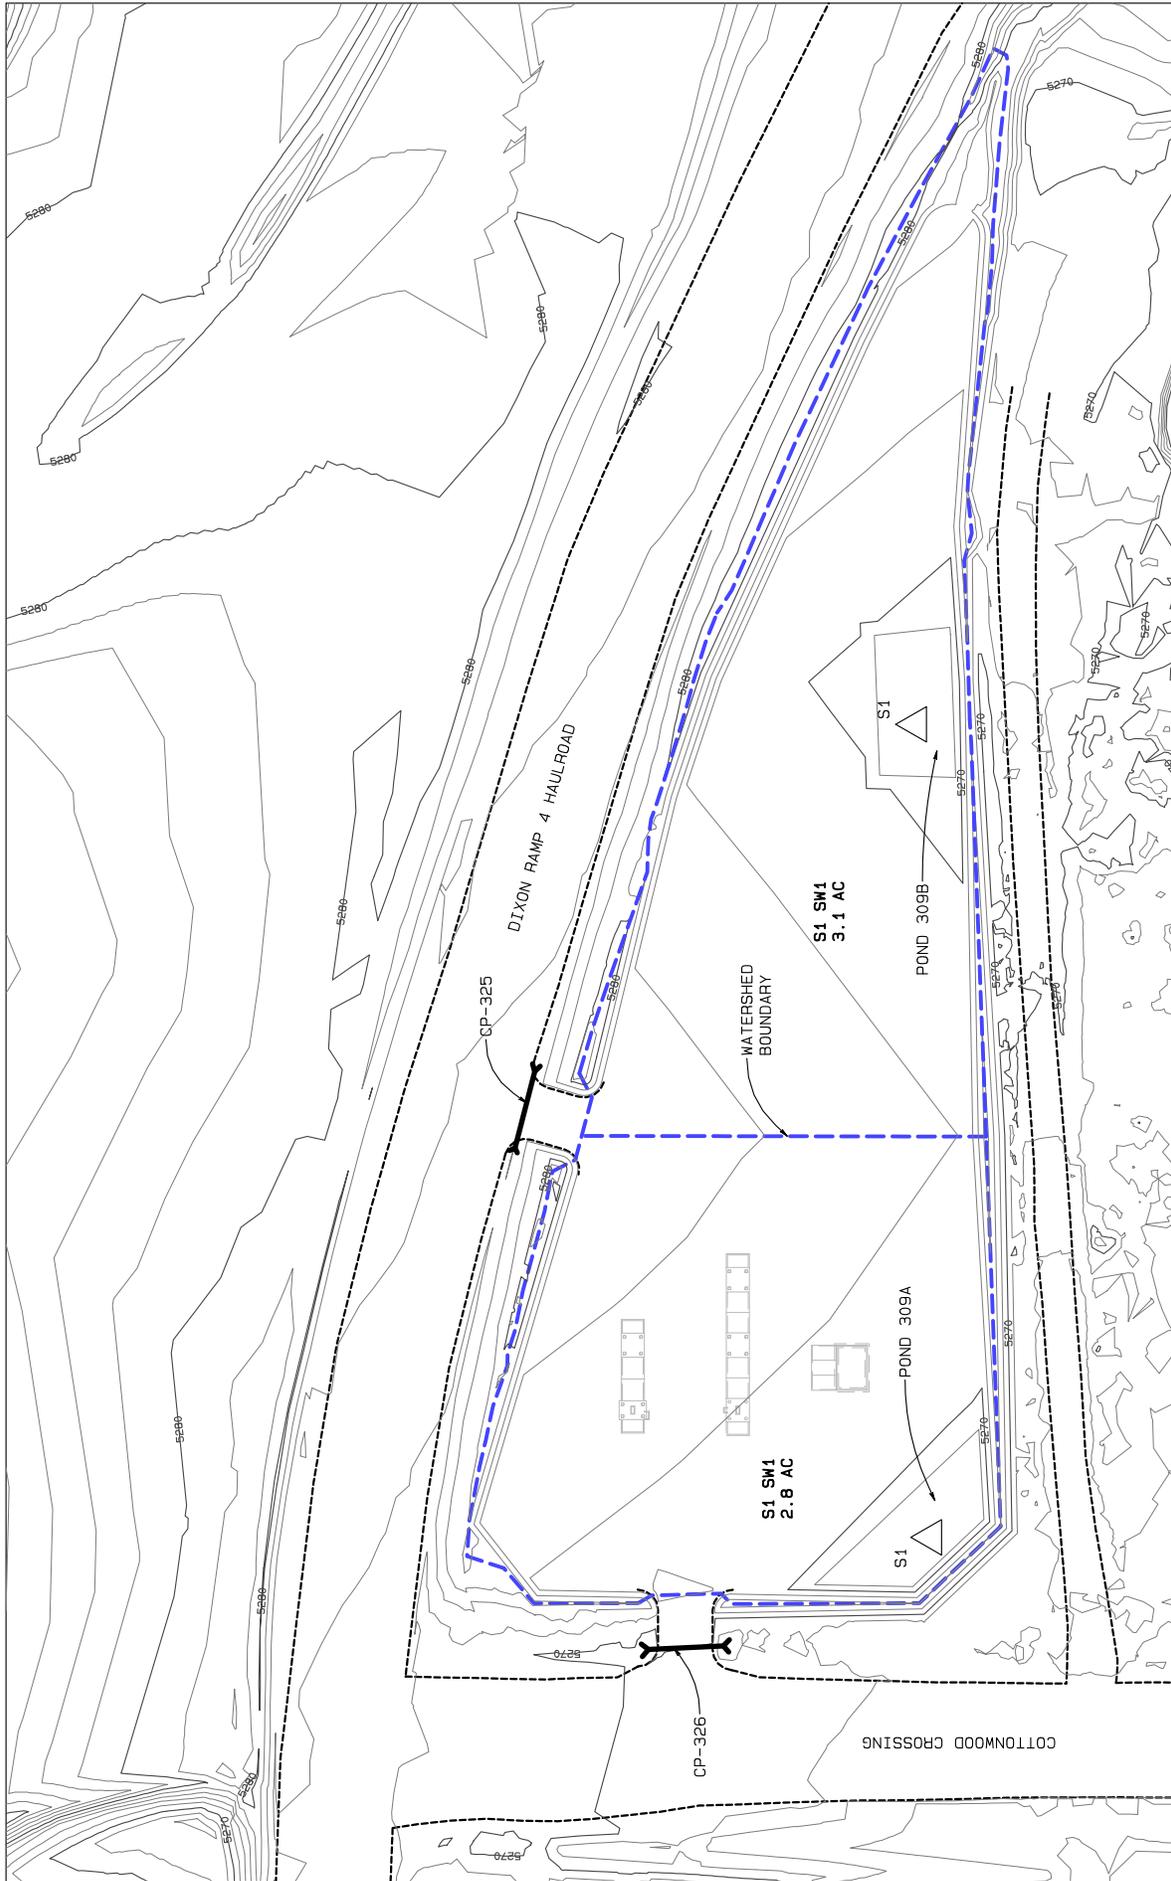

GILMORE SILOS (AN & HEF)  
 WATER & SEDIMENT CONTROL STRUCTURES (PONDS)  
 HYDROLOGY MODEL

# **GILMORE SILOS**

## **POND 309B**

*For pond location and watershed refer to Exhibit 11-13E. The pond design is presented on Exhibit 11-171. The hydrology model is presented on the attach sheet.*

LR

BHP Navajo Coal Company  
PO Box 1717  
Fruitland, NM 87416

Phone: (505) 598-3317

## ***General Information***

### ***Storm Information:***

Storm Type:	NM TYPE II 70
Design Storm:	100 yr - 6 hr
Rainfall Depth:	1.970 inches

### *Structure Networking:*

Type	Stru #	(flows into)	Stru #	Musk. K (hrs)	Musk. X	Description
Null	#1	==>	End	0.000	0.000	Pond 309B

#1
<i>Null</i>

***Structure Summary:***

	Immediate Contributing Area (ac)	Total Contributing Area (ac)	Peak Discharge (cfs)	Total Runoff Volume (ac-ft)
#1	3.080	3.080	7.91	0.33

---

***Structure Detail:***

*Structure #1 (Null)*


*Pond 309B*

***Subwatershed Hydrology Detail:***

Stru #	SWS #	SWS Area (ac)	Time of Conc (hrs)	Musk K (hrs)	Musk X	Curve Number	UHS	Peak Discharge (cfs)	Runoff Volume (ac-ft)
#1	1	3.080	0.049	0.000	0.000	93.000	M	7.91	0.330
	<b>Σ</b>	<b>3.080</b>						<b>7.91</b>	<b>0.330</b>

***Subwatershed Time of Concentration Details:***

Stru #	SWS #	Land Flow Condition	Slope (%)	Vert. Dist. (ft)	Horiz. Dist. (ft)	Velocity (fps)	Time (hrs)
#1	1	5. Nearly bare and untilled, and alluvial valley fans	3.98	14.00	352.00	1.990	0.049
<b>#1</b>	<b>1</b>	<b>Time of Concentration:</b>					<b>0.049</b>

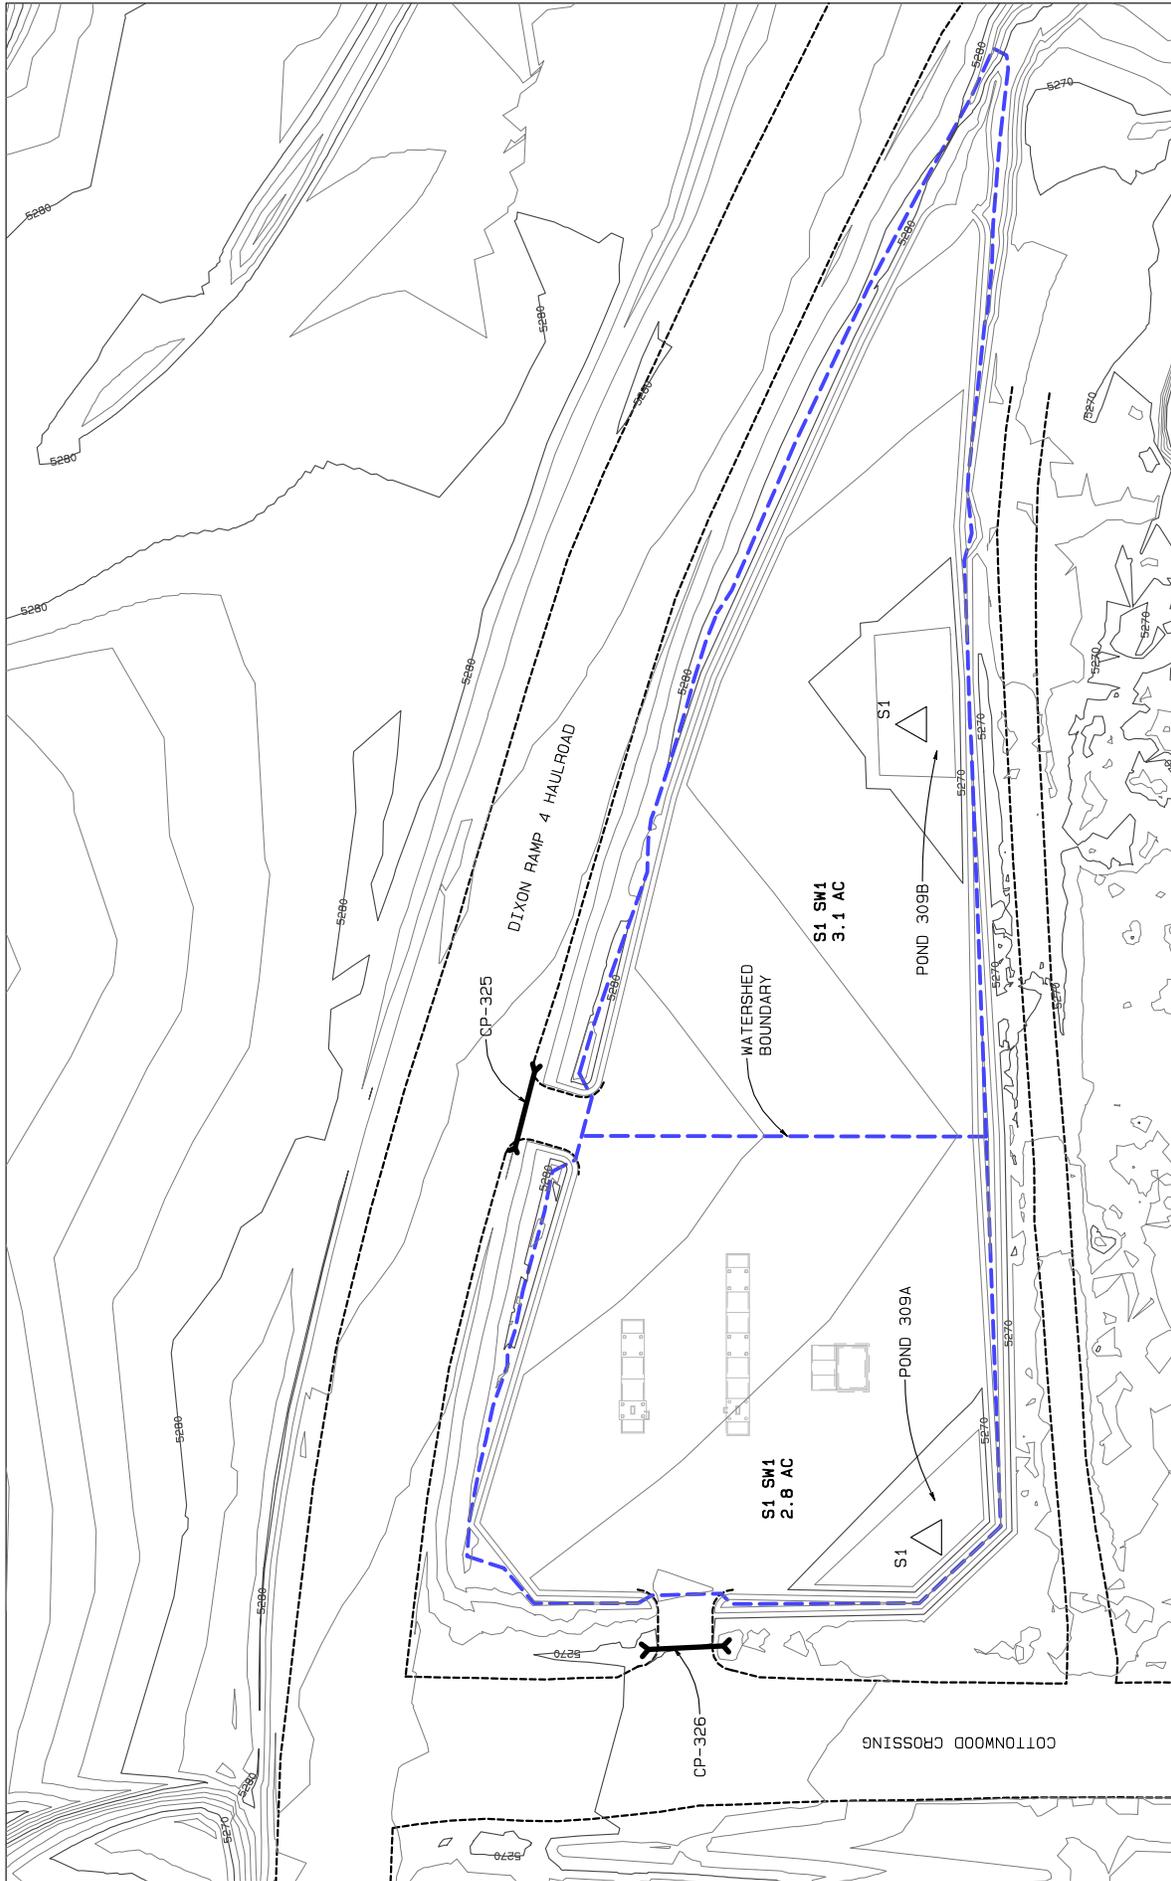

GILMORE SILOS (AN & HEF)  
WATER & SEDIMENT CONTROL STRUCTURES (PONDS)  
HYDROLOGY MODEL

# **POND 414 AND DIVERSION CHANNEL** **10-YEAR 6-HOUR**

*The pond is design to retain the surface runoff from the 100-yr 6-hr storm event.*

*The diversion channel and inlet structures to the pond are design to be stable for the 10-yr 6-hr storm event.*

*The watershed area for the pond is presented on Exh. 11-13F.*

*The designs for the pond and diversion channel are presented on Exh. 11-88 Sheet 1 & 2.*

*The gabion design for the South Inlet is attach.*

*The schematic of the hydrology model is shown on the attach sheet.*

LR

BHP Navajo Coal Company

Fruitland, NM 87416

## ***General Information***

### ***Storm Information:***

Storm Type:	NM TYPE II 70
Design Storm:	10 yr - 6 hr
Rainfall Depth:	1.230 inches

### Structure Networking:

Type	Stru #	(flows into)	Stru #	Musk. K (hrs)	Musk. X	Description
Null	#1	==>	#3	0.264	0.328	
Channel	#2	==>	#4	0.000	0.000	DIVERSION CHANNEL
Null	#3	==>	#5	0.000	0.000	SOUTH INLET (GABIONS)
Channel	#4	==>	#5	0.000	0.000	EAST INLET
Null	#5	==>	End	0.000	0.000	POND 414



### Structure Routing Details:

Stru #	Land Flow Condition	Slope (%)	Vert. Dist. (ft)	Horiz. Dist. (ft)	Velocity (fps)	Time (hrs)
#1	8. Large gullies, diversions, and low flowing streams	1.17	36.00	3,080.00	3.24	0.264
#1	<b>Muskingum K:</b>					<b>0.264</b>

***Structure Summary:***

	Immediate Contributing Area (ac)	Total Contributing Area (ac)	Peak Discharge (cfs)	Total Runoff Volume (ac-ft)
#2	61.330	61.330	24.79	1.46
#4	0.000	61.330	24.79	1.46
#1	292.100	292.100	116.78	8.45
#3	123.390	415.490	133.47	11.38
#5	0.000	476.820	142.92	12.84

### Structure Detail:

Structure #2 (Erodible Channel)

*DIVERSION CHANNEL*

Trapezoidal Erodible Channel Inputs:

Material: Alluvial silts colloidal

Bottom Width (ft)	Left Sideslope Ratio	Right Sideslope Ratio	Slope (%)	Manning's n	Freeboard Depth (ft)	Freeboard % of Depth	Freeboard Mult. x (VxD)	Limiting Velocity (fps)
8.00	2.0:1	2.0:1	1.7	0.0270	1.00			5.0

Erodible Channel Results:

	w/o Freeboard	w/ Freeboard
Design Discharge:	24.79 cfs	
Depth:	0.59 ft	1.59 ft
Top Width:	10.34 ft	14.34 ft
Velocity:	4.61 fps	
X-Section Area:	5.38 sq ft	
Hydraulic Radius:	0.506 ft	
Froude Number:	1.13	

Structure #4 (Riprap Channel)

*EAST INLET*

Trapezoidal Riprap Channel Inputs:

Material: Riprap

Bottom Width (ft)	Left Sideslope Ratio	Right Sideslope Ratio	Slope (%)	Freeboard Depth (ft)	Freeboard % of Depth	Freeboard Mult. x (VxD)
9.00	3.0:1	3.0:1	12.0			

Riprap Channel Results:

Simons/OSM Method - Steep Slope Design

	w/o Freeboard	w/ Freeboard
Design Discharge:	24.79 cfs	
Depth:	0.26 ft	
Top Width:	10.55 ft	
Velocity*:		
X-Section Area:	2.53 sq ft	

	w/o Freeboard	w/ Freeboard
Hydraulic Radius:	0.238 ft	
Froude Number*:		
Manning's n*:		
Dmin:	2.00 in	
D50:	6.00 in	
Dmax:	7.50 in	

Velocity and Manning's n calculations may not apply for this method.

Structure #1 (Null)

Structure #3 (Null)

*SOUTH INLET (GABIONS)*

Structure #5 (Null)

*POND 414*

**Subwatershed Hydrology Detail:**

Stru #	SWS #	SWS Area (ac)	Time of Conc (hrs)	Musk K (hrs)	Musk X	Curve Number	UHS	Peak Discharge (cfs)	Runoff Volume (ac-ft)
#2	1	61.330	0.347	0.000	0.000	87.000	M	24.79	1.462
	<b>Σ</b>	<b>61.330</b>						<b>24.79</b>	<b>1.462</b>
<b>#4</b>	<b>Σ</b>	<b>61.330</b>						<b>24.79</b>	<b>1.462</b>
#1	1	292.100	0.503	0.000	0.000	89.000	M	116.78	8.449
	<b>Σ</b>	<b>292.100</b>						<b>116.78</b>	<b>8.449</b>
#3	1	123.390	0.379	0.000	0.000	87.000	M	47.57	2.928
	<b>Σ</b>	<b>415.490</b>						<b>133.47</b>	<b>11.377</b>
<b>#5</b>	<b>Σ</b>	<b>476.820</b>						<b>142.92</b>	<b>12.839</b>

**Subwatershed Time of Concentration Details:**

Stru #	SWS #	Land Flow Condition	Slope (%)	Vert. Dist. (ft)	Horiz. Dist. (ft)	Velocity (fps)	Time (hrs)
#1	1	5. Nearly bare and untilled, and alluvial valley fans	3.82	47.00	1,230.01	1.950	0.175
		8. Large gullies, diversions, and low flowing streams	1.75	82.00	4,685.17	3.960	0.328
<b>#1</b>	<b>1</b>	<b>Time of Concentration:</b>					<b>0.503</b>
#2	1	5. Nearly bare and untilled, and alluvial valley fans	4.44	11.00	248.00	2.100	0.032
		8. Large gullies, diversions, and low flowing streams	5.49	65.00	1,183.00	7.030	0.046
		5. Nearly bare and untilled, and alluvial valley fans	2.03	28.00	1,380.00	1.420	0.269
<b>#2</b>	<b>1</b>	<b>Time of Concentration:</b>					<b>0.347</b>
#3	1	5. Nearly bare and untilled, and alluvial valley fans	1.84	17.00	923.00	1.350	0.189
		8. Large gullies, diversions, and low flowing streams	3.21	118.00	3,680.00	5.370	0.190
<b>#3</b>	<b>1</b>	<b>Time of Concentration:</b>					<b>0.379</b>

# **POND 414 AND DIVERSION CHANNEL** **100-YEAR 6-HOUR**

*The pond is design to retain the surface runoff from the 100-yr 6-hr storm event.*

*The diversion channel and inlet structures to the pond are design to be stable for the 10-yr 6-hr storm event.*

*The watershed area for the pond is presented on Exh. 11-13F.*

*The designs for the pond and diversion channel are presented on Exh. 11-88 Sheet 1 & 2.*

*The gabion design for the South Inlet is attach.*

*The schematic of the hydrology model is shown on the attach sheet.*

LR

BHP Navajo Coal Company

Fruitland, NM 87416

## ***General Information***

### ***Storm Information:***

Storm Type:	NM TYPE II 70
Design Storm:	100 yr - 6 hr
Rainfall Depth:	1.970 inches

### Structure Networking:

Type	Stru #	(flows into)	Stru #	Musk. K (hrs)	Musk. X	Description
Null	#1	==>	#3	0.264	0.328	
Channel	#2	==>	#4	0.000	0.000	DIVERSION CHANNEL
Null	#3	==>	#5	0.000	0.000	SOUTH INLET (GABIONS)
Channel	#4	==>	#5	0.000	0.000	EAST INLET
Null	#5	==>	End	0.000	0.000	POND 414



### Structure Routing Details:

Stru #	Land Flow Condition	Slope (%)	Vert. Dist. (ft)	Horiz. Dist. (ft)	Velocity (fps)	Time (hrs)
#1	8. Large gullies, diversions, and low flowing streams	1.17	36.00	3,080.00	3.24	0.264
#1	<b>Muskingum K:</b>					<b>0.264</b>

***Structure Summary:***

	Immediate Contributing Area (ac)	Total Contributing Area (ac)	Peak Discharge (cfs)	Total Runoff Volume (ac-ft)
#2	61.330	61.330	61.10	3.61
#4	0.000	61.330	61.10	3.61
#1	292.100	292.100	272.58	19.47
#3	123.390	415.490	316.18	26.70
#5	0.000	476.820	341.91	30.30

### Structure Detail:

Structure #2 (Erodible Channel)

*DIVERSION CHANNEL*

Trapezoidal Erodible Channel Inputs:

Material: Alluvial silts colloidal

Bottom Width (ft)	Left Sideslope Ratio	Right Sideslope Ratio	Slope (%)	Manning's n	Freeboard Depth (ft)	Freeboard % of Depth	Freeboard Mult. x (VxD)	Limiting Velocity (fps)
8.00	2.0:1	2.0:1	1.7	0.0270	1.00			5.0

Erodible Channel Results:

	w/o Freeboard	w/ Freeboard
Design Discharge:	61.10 cfs	
Depth:	0.99 ft	1.99 ft
Top Width:	11.94 ft	15.94 ft
Velocity:	6.21 fps	
X-Section Area:	9.83 sq ft	
Hydraulic Radius:	0.792 ft	
Froude Number:	1.21	

Structure #4 (Riprap Channel)

*EAST INLET*

Trapezoidal Riprap Channel Inputs:

Material: Riprap

Bottom Width (ft)	Left Sideslope Ratio	Right Sideslope Ratio	Slope (%)	Freeboard Depth (ft)	Freeboard % of Depth	Freeboard Mult. x (VxD)
9.00	3.0:1	3.0:1	12.0			

Riprap Channel Results:

Simons/OSM Method - Steep Slope Design

	w/o Freeboard	w/ Freeboard
Design Discharge:	61.10 cfs	
Depth:	0.51 ft	
Top Width:	12.05 ft	
Velocity*:		
X-Section Area:	5.35 sq ft	

	w/o Freeboard	w/ Freeboard
Hydraulic Radius:	0.438 ft	
Froude Number*:		
Manning's n*:		
Dmin:	3.00 in	
D50:	9.00 in	
Dmax:	11.25 in	

Velocity and Manning's n calculations may not apply for this method.

Structure #1 (Null)

Structure #3 (Null)

*SOUTH INLET (GABIONS)*

Structure #5 (Null)

*POND 414*

**Subwatershed Hydrology Detail:**

Stru #	SWS #	SWS Area (ac)	Time of Conc (hrs)	Musk K (hrs)	Musk X	Curve Number	UHS	Peak Discharge (cfs)	Runoff Volume (ac-ft)
#2	1	61.330	0.347	0.000	0.000	87.000	M	61.10	3.609
	<b>Σ</b>	<b>61.330</b>						<b>61.10</b>	<b>3.609</b>
<b>#4</b>	<b>Σ</b>	<b>61.330</b>						<b>61.10</b>	<b>3.609</b>
#1	1	292.100	0.503	0.000	0.000	89.000	M	272.58	19.469
	<b>Σ</b>	<b>292.100</b>						<b>272.58</b>	<b>19.469</b>
#3	1	123.390	0.379	0.000	0.000	87.000	M	117.85	7.226
	<b>Σ</b>	<b>415.490</b>						<b>316.18</b>	<b>26.695</b>
<b>#5</b>	<b>Σ</b>	<b>476.820</b>						<b>341.91</b>	<b>30.304</b>

**Subwatershed Time of Concentration Details:**

Stru #	SWS #	Land Flow Condition	Slope (%)	Vert. Dist. (ft)	Horiz. Dist. (ft)	Velocity (fps)	Time (hrs)
#1	1	5. Nearly bare and untilled, and alluvial valley fans	3.82	47.00	1,230.01	1.950	0.175
		8. Large gullies, diversions, and low flowing streams	1.75	82.00	4,685.17	3.960	0.328
<b>#1</b>	<b>1</b>	<b>Time of Concentration:</b>					<b>0.503</b>
#2	1	5. Nearly bare and untilled, and alluvial valley fans	4.44	11.00	248.00	2.100	0.032
		8. Large gullies, diversions, and low flowing streams	5.49	65.00	1,183.00	7.030	0.046
		5. Nearly bare and untilled, and alluvial valley fans	2.03	28.00	1,380.00	1.420	0.269
<b>#2</b>	<b>1</b>	<b>Time of Concentration:</b>					<b>0.347</b>
#3	1	5. Nearly bare and untilled, and alluvial valley fans	1.84	17.00	923.00	1.350	0.189
		8. Large gullies, diversions, and low flowing streams	3.21	118.00	3,680.00	5.370	0.190
<b>#3</b>	<b>1</b>	<b>Time of Concentration:</b>					<b>0.379</b>

Title: Pond 414  
 Description: South Inlet Structure

Folder:  
 Date: 3/18/2013

**Notice**  
 Maccaferri is not responsible for the drawings and the calculations transmitted, since they should be intended as general design outlines and advice, aiming only to the best use of the products.

**Run n.1**

Stretch	Length [ft]	Discharge [ft <sup>3</sup> /s]	Gradient [%]	V	K	Vadm [ft/s]	Vb Material [ft/s]	V	tau max [lb/ft <sup>2</sup> ]	tau adm [lb/ft <sup>2</sup> ]	GeoFil
		Water level [ft]	15.00								
		Average velocity [ft/s]	133.50								
			0.65								
			14.73								
			Froude number								
			Cross section [ft <sup>2</sup> ]								
			Wetted perimeter [ft]								
			Hydraulic radius [ft]								
1	6.33			9.48	1.00	5.00	3.25 Reno mattress 9"	N	4.73	5.23	Y
1.1	6.33			15.58	1.00	5.00	3.76 Reno mattress 12"	N	6.20	7.01	Y
4	12.00			9.48	1.00	5.00	3.25 Reno mattress 9"	N	4.73	5.23	Y
4.1	12.00										
7	6.33										
7.1	6.33										

Title: Pond 414  
 Description: South Inlet Structure

Folder:  
 Date: 3/18/2013


**Notice**  
 Maccaferri is not responsible for the drawings and the calculations transmitted, since they should be intended as general design outlines and advice, aiming only to the best use of the products.


Materials used Description	Roughness	Allow. shear stress [lb/ft <sup>2</sup> ]	V	Rock d50 [inch]	Thickness [ft]	Rockfill unit wt [lb/ft <sup>3</sup> ]	unit wt [h]	C Shields
Reno mattress 9"	0.0277	5.62	N	4.73	0.76	165.51		0.140
Reno mattress 12"	0.0277	7.01	N	5.90	0.82	165.51		0.140

**Macra1 2006**  
Maccaferri River Analysis  
Bank Protections

Title: Pond 414  
Description: South Inlet Structure

Folder:  
Date: 3/18/2013

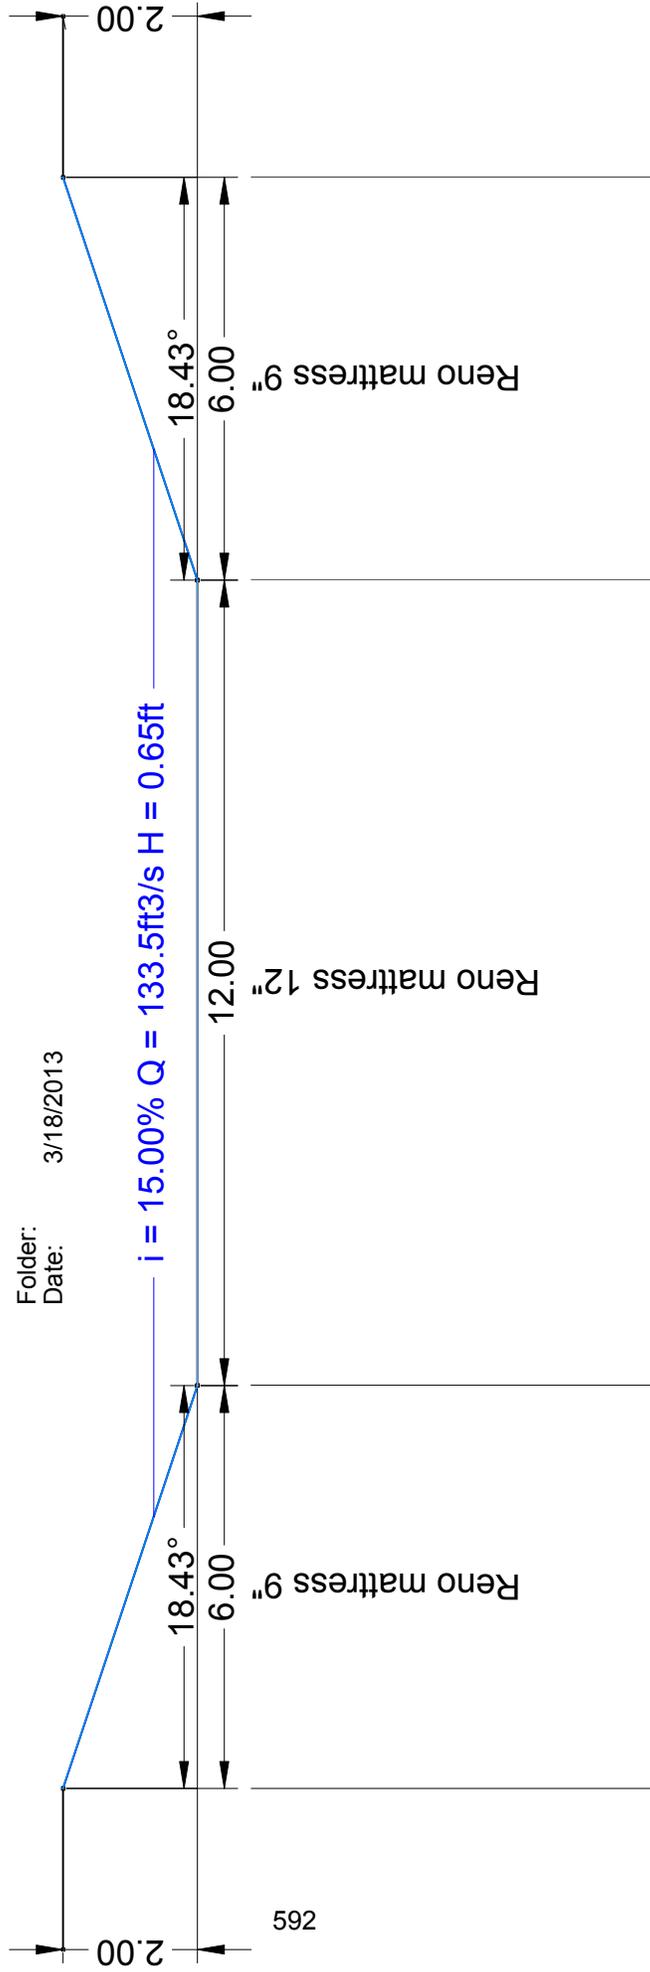

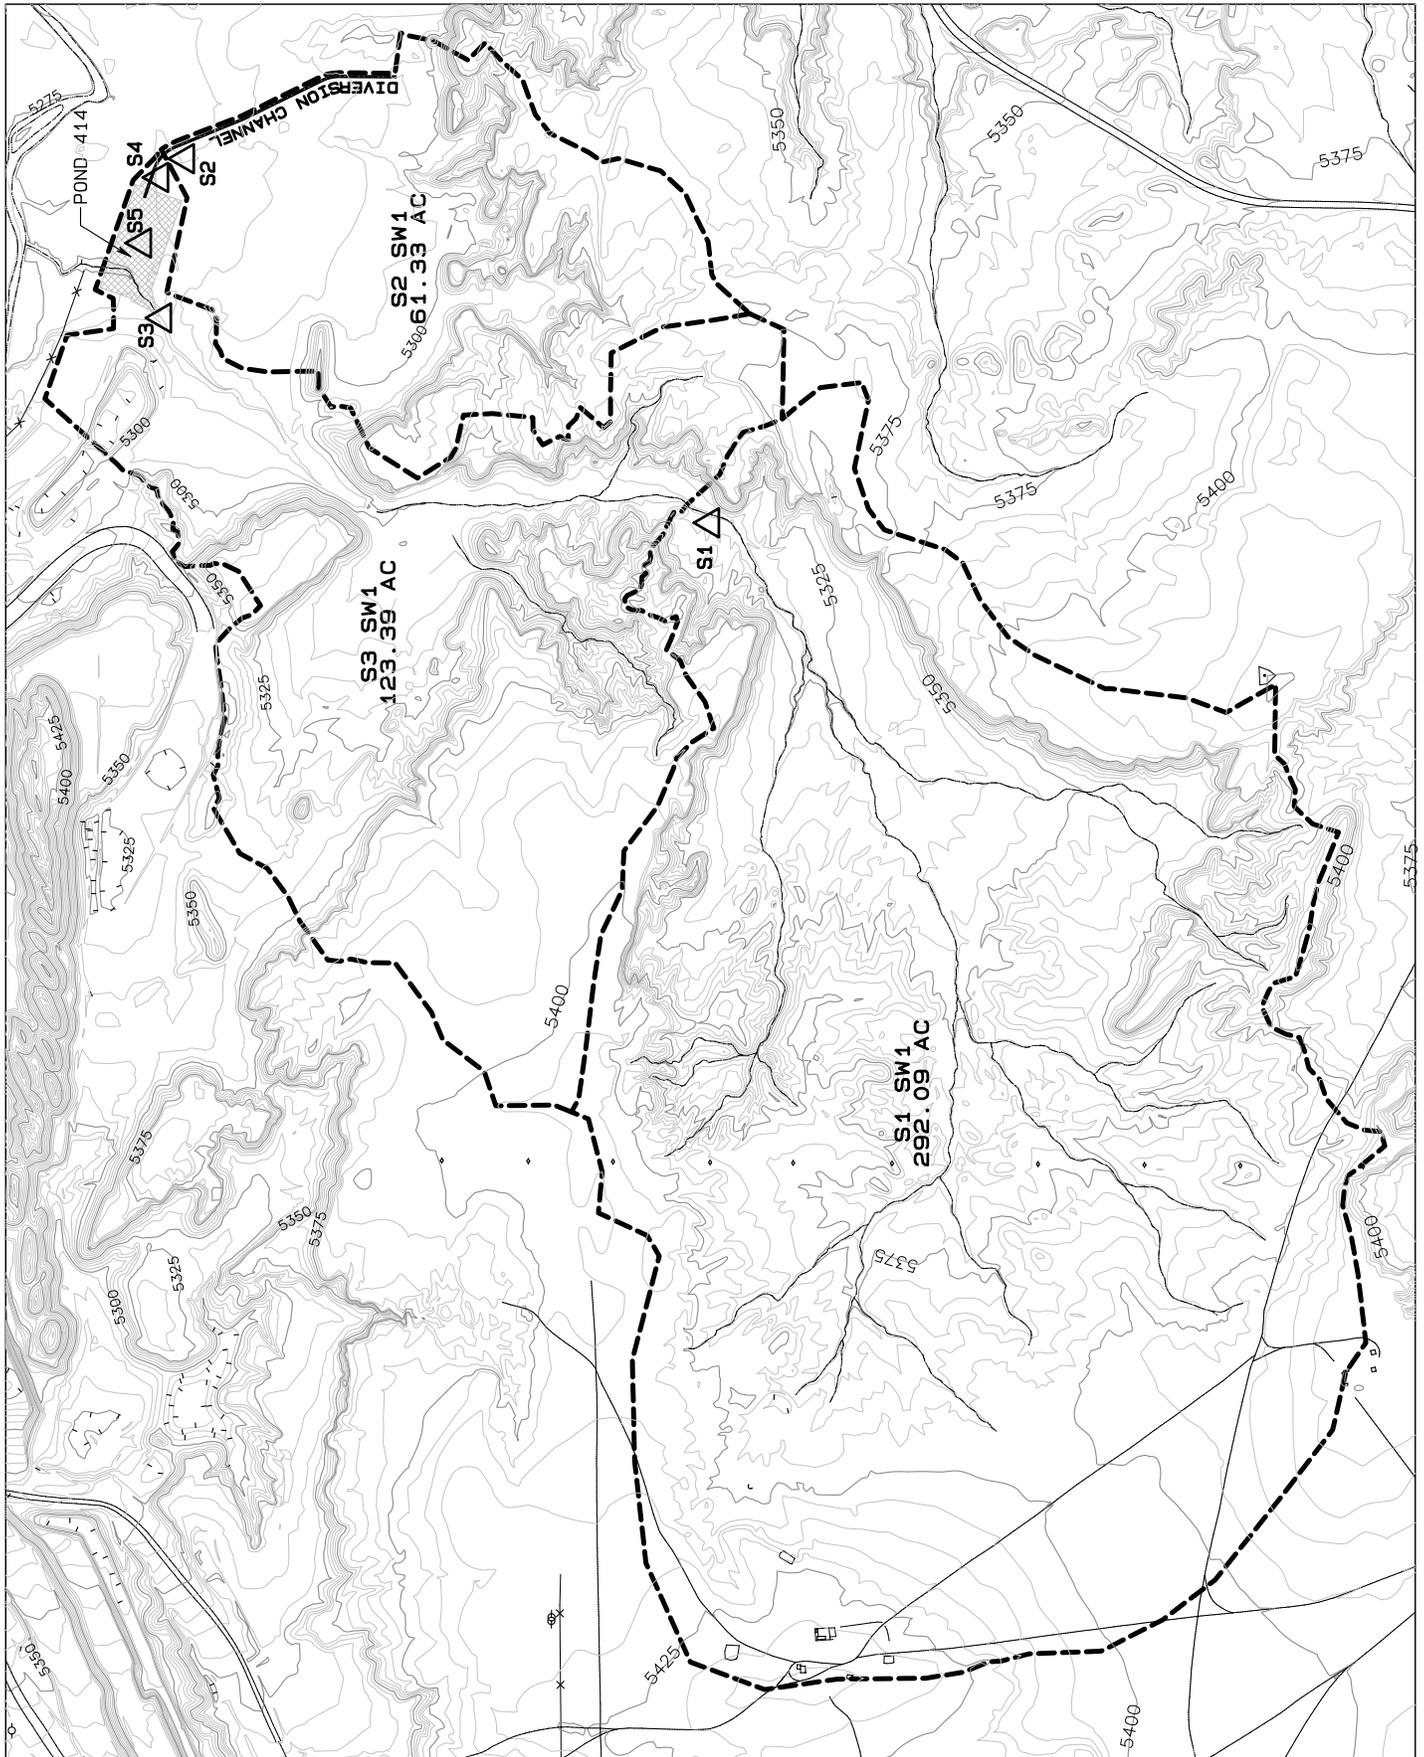

HYDROLOGY MODEL SCHEMATIC  
POND 414

This page is intentionally left blank due to Permit Modification

Area 4N Pond 415

REV 1212

Pages 594 through 611

## **A2 Pond 201**

***The watershed for pond 201 is shown on Exhibit 11-13D. The detail design is on Exhibit 172.***

***The pond is designed to retain a 100 yr- 6 hr storm event. No spillway is required.***

***The channels and inlets to the pond are designed to be stable for a 10 yr-6 hr storm event.***

***The schematic of the structure networking for pond 201 is attached.***

Ramsey R. Yazzie

BHP Billiton  
POBox 1717  
Fruitland, NM 87416

Phone: 505-598-3282  
Email: Ramsey.R.Yazzie@bhpbilliton.com

## ***General Information***

### ***Storm Information:***

Storm Type:	TYPE II-70
Design Storm:	100 yr - 6 hr
Rainfall Depth:	1.970 inches

### Structure Networking:

Type	Stru #	(flows into)	Stru #	Musk. K (hrs)	Musk. X	Description
Channel	#6	==>	#13	0.000	0.000	South Channel Diversion
Channel	#11	==>	#14	0.000	0.000	North Channel Diversion
Null	#12	==>	End	0.000	0.000	Pond 201
Channel	#13	==>	#12	0.000	0.000	South Channel Rip Rap
Channel	#14	==>	#12	0.000	0.000	North Channel Rip Rap



***Structure Summary:***

	Immediate Contributing Area (ac)	Total Contributing Area (ac)	Peak Discharge (cfs)	Total Runoff Volume (ac-ft)
#11	6.100	6.100	6.72	0.34
#14	0.000	6.100	6.72	0.34
#6	20.500	20.500	11.18	1.61
#13	0.000	20.500	11.18	1.61
#12	0.000	26.600	11.80	1.95

## **Structure Detail:**

### Structure #11 (Erodible Channel)

#### *North Channel Diversion*

Trapezoidal Erodible Channel Inputs:

#### Material: Spoils - Shale and Sandstone Cobbles

Bottom Width (ft)	Left Sideslope Ratio	Right Sideslope Ratio	Slope (%)	Manning's n	Freeboard Depth (ft)	Freeboard % of Depth	Freeboard Mult. x (VxD)	Limiting Velocity (fps)
6.00	3.0:1	3.0:1	1.3	0.0290	1.00			5.0

Erodible Channel Results:

	w/o Freeboard	w/ Freeboard
Design Discharge:	6.72 cfs	
Depth:	0.36 ft	1.36 ft
Top Width:	8.16 ft	14.16 ft
Velocity:	2.64 fps	
X-Section Area:	2.55 sq ft	
Hydraulic Radius:	0.308 ft	
Froude Number:	0.83	

### Structure #14 (Riprap Channel)

#### *North Channel Rip Rap*

Trapezoidal Riprap Channel Inputs:

#### Material: Riprap

Bottom Width (ft)	Left Sideslope Ratio	Right Sideslope Ratio	Slope (%)	Freeboard Depth (ft)	Freeboard % of Depth	Freeboard Mult. x (VxD)
6.00	3.0:1	3.0:1	7.1	1.00		

Riprap Channel Results:

#### Simons/OSM Method - Steep Slope Design

	w/o Freeboard	w/ Freeboard
Design Discharge:	6.72 cfs	
Depth:	0.14 ft	1.14 ft
Top Width:	6.86 ft	12.86 ft
Velocity*:		
X-Section Area:	0.92 sq ft	

	w/o Freeboard	w/ Freeboard
Hydraulic Radius:	0.133 ft	
Froude Number*:		
Manning's n*:		
Dmin:	1.00 in	
D50:	3.00 in	
Dmax:	3.75 in	

Velocity and Manning's n calculations may not apply for this method.

Structure #6 (Erodible Channel)

*South Channel Diversion*

Trapezoidal Erodible Channel Inputs:

Material: Spoils - Shale and Sandstone Cobbles

Bottom Width (ft)	Left Sideslope Ratio	Right Sideslope Ratio	Slope (%)	Manning's n	Freeboard Depth (ft)	Freeboard % of Depth	Freeboard Mult. x (VxD)	Limiting Velocity (fps)
6.00	3.0:1	3.0:1	0.7	0.0290	1.00			5.0

Erodible Channel Results:

	w/o Freeboard	w/ Freeboard
Design Discharge:	11.18 cfs	
Depth:	0.57 ft	1.57 ft
Top Width:	9.44 ft	15.44 ft
Velocity:	2.52 fps	
X-Section Area:	4.43 sq ft	
Hydraulic Radius:	0.460 ft	
Froude Number:	0.65	

Structure #13 (Riprap Channel)

*South Channel Rip Rap*

Trapezoidal Riprap Channel Inputs:

Material: Riprap

Bottom Width (ft)	Left Sideslope Ratio	Right Sideslope Ratio	Slope (%)	Freeboard Depth (ft)	Freeboard % of Depth	Freeboard Mult. x (VxD)
6.00	3.0:1	3.0:1	7.2	1.00		

Riprap Channel Results:

Simons/OSM Method - Steep Slope Design

	w/o Freeboard	w/ Freeboard
Design Discharge:	11.18 cfs	
Depth:	0.20 ft	1.20 ft
Top Width:	7.21 ft	13.21 ft
Velocity*:		
X-Section Area:	1.33 sq ft	
Hydraulic Radius:	0.183 ft	
Froude Number*:		
Manning's n*:		
Dmin:	2.00 in	
D50:	6.00 in	
Dmax:	7.50 in	

Velocity and Manning's n calculations may not apply for this method.

Structure #12 (Null)

Pond 201

**Subwatershed Hydrology Detail:**

Stru #	SWS #	SWS Area (ac)	Time of Conc (hrs)	Musk K (hrs)	Musk X	Curve Number	UHS	Peak Discharge (cfs)	Runoff Volume (ac-ft)
#11	1	6.100	0.223	0.000	0.000	86.000	M	6.72	0.337
	<b>Σ</b>	<b>6.100</b>						<b>6.72</b>	<b>0.337</b>
<b>#14</b>	<b>Σ</b>	<b>6.100</b>						<b>6.72</b>	<b>0.337</b>
#6	1	20.500	1.726	0.000	0.000	89.000	F	11.18	1.608
	<b>Σ</b>	<b>20.500</b>						<b>11.18</b>	<b>1.608</b>
<b>#13</b>	<b>Σ</b>	<b>20.500</b>						<b>11.18</b>	<b>1.608</b>
<b>#12</b>	<b>Σ</b>	<b>26.600</b>						<b>11.80</b>	<b>1.946</b>

**Subwatershed Time of Concentration Details:**

Stru #	SWS #	Land Flow Condition	Slope (%)	Vert. Dist. (ft)	Horiz. Dist. (ft)	Velocity (fps)	Time (hrs)
#6	1	5. Nearly bare and untilled, and alluvial valley fans	1.11	72.50	6,526.53	1.050	1.726
<b>#6</b>	<b>1</b>	<b>Time of Concentration:</b>					<b>1.726</b>
#11	1	5. Nearly bare and untilled, and alluvial valley fans	5.49	103.50	1,886.34	2.340	0.223
<b>#11</b>	<b>1</b>	<b>Time of Concentration:</b>					<b>0.223</b>

## **A2 Pond 201**

*The watershed for pond 201 is shown on Exhibit 11-13D. The detail design is on Exhibit 172.*

*The channels and inlets to the pond are designed to be stable for a 10 yr-6 hr storm event.*

*The schematic of the structure networking for pond 201 is attached.*

Ramsey R. Yazzie

BHP Billiton  
POBox 1717  
Fruitland, NM 87416

Phone: 505-598-3282  
Email: Ramsey.R.Yazzie@bhpbilliton.com

## ***General Information***

### ***Storm Information:***

Storm Type:	TYPE II-70
Design Storm:	10 yr - 6 hr
Rainfall Depth:	1.230 inches

### Structure Networking:

Type	Stru #	(flows into)	Stru #	Musk. K (hrs)	Musk. X	Description
Channel	#6	==>	#13	0.000	0.000	South Channel Diversion
Channel	#11	==>	#14	0.000	0.000	North Channel Diversion
Null	#12	==>	End	0.000	0.000	Pond 201
Channel	#13	==>	#12	0.000	0.000	South Channel Rip Rap
Channel	#14	==>	#12	0.000	0.000	North Channel Rip Rap



***Structure Summary:***

	Immediate Contributing Area (ac)	Total Contributing Area (ac)	Peak Discharge (cfs)	Total Runoff Volume (ac-ft)
#11	6.100	6.100	2.73	0.13
#14	0.000	6.100	2.73	0.13
#6	20.500	20.500	4.76	0.70
#13	0.000	20.500	4.76	0.70
#12	0.000	26.600	5.03	0.83

## Structure Detail:

### Structure #11 (Erodible Channel)

#### *North Channel Diversion*

Trapezoidal Erodible Channel Inputs:

#### Material: Spoils - Shale and Sandstone Cobbles

Bottom Width (ft)	Left Sideslope Ratio	Right Sideslope Ratio	Slope (%)	Manning's n	Freeboard Depth (ft)	Freeboard % of Depth	Freeboard Mult. x (VxD)	Limiting Velocity (fps)
6.00	3.0:1	3.0:1	1.3	0.0290	1.00			5.0

Erodible Channel Results:

	w/o Freeboard	w/ Freeboard
Design Discharge:	2.73 cfs	
Depth:	0.21 ft	1.21 ft
Top Width:	7.28 ft	13.28 ft
Velocity:	1.93 fps	
X-Section Area:	1.42 sq ft	
Hydraulic Radius:	0.193 ft	
Froude Number:	0.77	

### Structure #14 (Riprap Channel)

#### *North Channel Rip Rap*

Trapezoidal Riprap Channel Inputs:

#### Material: Riprap

Bottom Width (ft)	Left Sideslope Ratio	Right Sideslope Ratio	Slope (%)	Freeboard Depth (ft)	Freeboard % of Depth	Freeboard Mult. x (VxD)
6.00	3.0:1	3.0:1	7.1	1.00		

Riprap Channel Results:

#### Simons/OSM Method - Steep Slope Design

	w/o Freeboard	w/ Freeboard
Design Discharge:	2.73 cfs	
Depth:	0.09 ft	1.09 ft
Top Width:	6.52 ft	12.52 ft
Velocity*:		
X-Section Area:	0.55 sq ft	

	w/o Freeboard	w/ Freeboard
Hydraulic Radius:	0.083 ft	
Froude Number*:		
Manning's n*:		
Dmin:	1.00 in	
D50:	3.00 in	
Dmax:	3.75 in	

Velocity and Manning's n calculations may not apply for this method.

Structure #6 (Erodible Channel)

*South Channel Diversion*

Trapezoidal Erodible Channel Inputs:

Material: Spoils - Shale and Sandstone Cobbles

Bottom Width (ft)	Left Sideslope Ratio	Right Sideslope Ratio	Slope (%)	Manning's n	Freeboard Depth (ft)	Freeboard % of Depth	Freeboard Mult. x (VxD)	Limiting Velocity (fps)
6.00	3.0:1	3.0:1	0.7	0.0290	1.00			5.0

Erodible Channel Results:

	w/o Freeboard	w/ Freeboard
Design Discharge:	4.76 cfs	
Depth:	0.35 ft	1.35 ft
Top Width:	8.12 ft	14.12 ft
Velocity:	1.91 fps	
X-Section Area:	2.49 sq ft	
Hydraulic Radius:	0.303 ft	
Froude Number:	0.61	

Structure #13 (Riprap Channel)

*South Channel Rip Rap*

Trapezoidal Riprap Channel Inputs:

Material: Riprap

Bottom Width (ft)	Left Sideslope Ratio	Right Sideslope Ratio	Slope (%)	Freeboard Depth (ft)	Freeboard % of Depth	Freeboard Mult. x (VxD)
6.00	3.0:1	3.0:1	7.2	1.00		

Riprap Channel Results:

Simons/OSM Method - Steep Slope Design

	w/o Freeboard	w/ Freeboard
Design Discharge:	4.76 cfs	
Depth:	0.12 ft	1.12 ft
Top Width:	6.69 ft	12.69 ft
Velocity*:		
X-Section Area:	0.73 sq ft	
Hydraulic Radius:	0.109 ft	
Froude Number*:		
Manning's n*:		
Dmin:	1.00 in	
D50:	3.00 in	
Dmax:	3.75 in	

Velocity and Manning's n calculations may not apply for this method.

Structure #12 (Null)

Pond 201

**Subwatershed Hydrology Detail:**

Stru #	SWS #	SWS Area (ac)	Time of Conc (hrs)	Musk K (hrs)	Musk X	Curve Number	UHS	Peak Discharge (cfs)	Runoff Volume (ac-ft)
#11	1	6.100	0.223	0.000	0.000	86.000	M	2.73	0.132
	<b>Σ</b>	<b>6.100</b>						<b>2.73</b>	<b>0.132</b>
<b>#14</b>	<b>Σ</b>	<b>6.100</b>						<b>2.73</b>	<b>0.132</b>
#6	1	20.500	1.726	0.000	0.000	89.000	F	4.76	0.698
	<b>Σ</b>	<b>20.500</b>						<b>4.76</b>	<b>0.698</b>
<b>#13</b>	<b>Σ</b>	<b>20.500</b>						<b>4.76</b>	<b>0.698</b>
<b>#12</b>	<b>Σ</b>	<b>26.600</b>						<b>5.03</b>	<b>0.830</b>

**Subwatershed Time of Concentration Details:**

Stru #	SWS #	Land Flow Condition	Slope (%)	Vert. Dist. (ft)	Horiz. Dist. (ft)	Velocity (fps)	Time (hrs)
#6	1	5. Nearly bare and untilled, and alluvial valley fans	1.11	72.50	6,526.53	1.050	1.726
<b>#6</b>	<b>1</b>	<b>Time of Concentration:</b>					<b>1.726</b>
#11	1	5. Nearly bare and untilled, and alluvial valley fans	5.49	103.50	1,886.34	2.340	0.223
<b>#11</b>	<b>1</b>	<b>Time of Concentration:</b>					<b>0.223</b>






**LEGEND**

	ROAD
	WATERWAY
	BUILDING
	FENCE
	IRRIGATION LINE
	CULVERT
	DIRT
	OPEN SPACE
	BOUNDARY
	FENCE
	POWER LINE
	SPOT ELEVATION
	WIDE X RAMP (PA)
	WIDE RAMP (CAUTION)
	LEASE CORNER
	LEASE POINT (BOUNDARY)

- NOTES**
- FOR HYDROLOGY INFORMATION REFER TO APPENDIX 11-AA IN THE APPROVED MAP.
  - THE WATERSHED INFORMATION FOR PONDS 201 AND 202 ARE SHOWN IN EXHIBIT 11-13D.

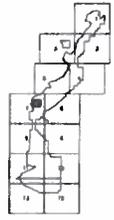

**bhpbilWton**

**BHP Navajo Coal Company**  
 P.O. Box 1717 Phone: 505-885-6200  
 Fruitedale, New Mexico 88510 Fax: 505-299-1091

**AREA 2**  
**POND 201 AND 202**  
**HYDROLOGY MODEL**

PREPARED BY: BWT / CHECKED BY: AWL / SCALE: 1" = 100'  
 APPROVED BY: LR / DATE: 05/06/2010

## **A2 Pond 202**

***The watershed for the impoundment is presented on Exhibit 11-13D. The detail design is presented on Exhibit 173.***

***The pond is designed to retain a 100 yr-6 hr storm event. No spillway is required.***

***The channels and inlets to the pond are designed to be stable for the 10 yr-6 hr storm event.***

***The schematic of the structure networking for Pond 202 is attached.***

Ramsey R. Yazzie

BHP Billiton  
POBox 1717  
Fruitland, NM 87416

Phone: 505-598-3282  
Email: Ramsey.R.Yazzie@bhpbilliton.com

## ***General Information***

### ***Storm Information:***

Storm Type:	TYPE II-70
Design Storm:	100 yr - 6 hr
Rainfall Depth:	1.970 inches

### Structure Networking:

Type	Stru #	(flows into)	Stru #	Musk. K (hrs)	Musk. X	Description
Channel	#7	==>	#11	0.000	0.000	South Channel Diversion
Channel	#8	==>	#10	0.000	0.000	East Channel
Channel	#9	==>	#12	0.000	0.000	North Channel Diversion
Null	#10	==>	End	0.000	0.000	Pond 202
Channel	#11	==>	#10	0.000	0.000	South Channel Rip Rap
Channel	#12	==>	#10	0.000	0.000	North Channel Rip Rap



***Structure Summary:***

	Immediate Contributing Area (ac)	Total Contributing Area (ac)	Peak Discharge (cfs)	Total Runoff Volume (ac-ft)
#9	20.300	20.300	24.00	0.67
#12	0.000	20.300	24.00	0.67
#7	299.780	299.780	124.88	7.93
#11	0.000	299.780	124.88	7.93
#8	84.500	84.500	52.94	2.28
#10	0.000	404.580	157.94	10.89

## **Structure Detail:**

### Structure #9 (Erodible Channel)

#### *North Channel Diversion*

Trapezoidal Erodible Channel Inputs:

#### Material: Spoils-Shale and Sandstone Cobbles

Bottom Width (ft)	Left Sideslope Ratio	Right Sideslope Ratio	Slope (%)	Manning's n	Freeboard Depth (ft)	Freeboard % of Depth	Freeboard Mult. x (VxD)	Limiting Velocity (fps)
6.00	3.0:1	3.0:1	1.4	0.0290	1.00			5.0

Erodible Channel Results:

	w/o Freeboard	w/ Freeboard
Design Discharge:	24.00 cfs	
Depth:	0.71 ft	1.71 ft
Top Width:	10.27 ft	16.27 ft
Velocity:	4.15 fps	
X-Section Area:	5.79 sq ft	
Hydraulic Radius:	0.551 ft	
Froude Number:	0.97	

### Structure #12 (Riprap Channel)

#### *North Channel Rip Rap*

Trapezoidal Riprap Channel Inputs:

#### Material: Riprap

Bottom Width (ft)	Left Sideslope Ratio	Right Sideslope Ratio	Slope (%)	Freeboard Depth (ft)	Freeboard % of Depth	Freeboard Mult. x (VxD)
6.00	3.0:1	3.0:1	7.7	1.00		

Riprap Channel Results:

#### Simons/OSM Method - Steep Slope Design

	w/o Freeboard	w/ Freeboard
Design Discharge:	24.00 cfs	
Depth:	0.35 ft	1.35 ft
Top Width:	8.11 ft	14.11 ft
Velocity*:		
X-Section Area:	2.48 sq ft	

	w/o Freeboard	w/ Freeboard
Hydraulic Radius:	0.302 ft	
Froude Number*:		
Manning's n*:		
Dmin:	2.00 in	
D50:	6.00 in	
Dmax:	7.50 in	

Velocity and Manning's n calculations may not apply for this method.

Structure #7 (Erodible Channel)

*South Channel Diversion*

Trapezoidal Erodible Channel Inputs:

Material: Spoils-Shale and Sandstone Cobbles

Bottom Width (ft)	Left Sideslope Ratio	Right Sideslope Ratio	Slope (%)	Manning's n	Freeboard Depth (ft)	Freeboard % of Depth	Freeboard Mult. x (VxD)	Limiting Velocity (fps)
6.00	3.0:1	3.0:1	0.8	0.0290	1.00			5.0

Erodible Channel Results:

	w/o Freeboard	w/ Freeboard
Design Discharge:	124.88 cfs	
Depth:	1.97 ft	2.97 ft
Top Width:	17.82 ft	23.82 ft
Velocity:	5.32 fps	
X-Section Area:	23.46 sq ft	
Hydraulic Radius:	1.271 ft	
Froude Number:	0.82	

Structure #11 (Riprap Channel)

*South Channel Rip Rap*

Trapezoidal Riprap Channel Inputs:

Material: Riprap

Bottom Width (ft)	Left Sideslope Ratio	Right Sideslope Ratio	Slope (%)	Freeboard Depth (ft)	Freeboard % of Depth	Freeboard Mult. x (VxD)
6.00	3.0:1	3.0:1	8.1	1.00		

Riprap Channel Results:

Simons/OSM Method - Steep Slope Design

	w/o Freeboard	w/ Freeboard
Design Discharge:	124.88 cfs	
Depth:	0.99 ft	1.99 ft
Top Width:	11.96 ft	17.96 ft
Velocity*:		
X-Section Area:	8.92 sq ft	
Hydraulic Radius:	0.726 ft	
Froude Number*:		
Manning's n*:		
Dmin:	6.00 in	
D50:	18.00 in	
Dmax:	22.50 in	

Velocity and Manning's n calculations may not apply for this method.

Structure #8 (Riprap Channel)

*East Channel*

Trapezoidal Riprap Channel Inputs:

Material: Riprap

Bottom Width (ft)	Left Sideslope Ratio	Right Sideslope Ratio	Slope (%)	Freeboard Depth (ft)	Freeboard % of Depth	Freeboard Mult. x (VxD)
6.00	3.0:1	3.0:1	8.4	1.00		

Riprap Channel Results:

Simons/OSM Method - Steep Slope Design

	w/o Freeboard	w/ Freeboard
Design Discharge:	52.94 cfs	
Depth:	0.61 ft	1.61 ft
Top Width:	9.68 ft	15.68 ft
Velocity*:		
X-Section Area:	4.81 sq ft	
Hydraulic Radius:	0.487 ft	
Froude Number*:		
Manning's n*:		
Dmin:	4.00 in	
D50:	12.00 in	
Dmax:	15.00 in	

Velocity and Manning's n calculations may not apply for this method.

Structure #10 (Null)

---

*Pond 202*

**Subwatershed Hydrology Detail:**

Stru #	SWS #	SWS Area (ac)	Time of Conc (hrs)	Musk K (hrs)	Musk X	Curve Number	UHS	Peak Discharge (cfs)	Runoff Volume (ac-ft)
#9	1	20.300	0.121	0.000	0.000	76.000	M	24.00	0.672
	<b>Σ</b>	<b>20.300</b>						<b>24.00</b>	<b>0.672</b>
<b>#12</b>	<b>Σ</b>	<b>20.300</b>						<b>24.00</b>	<b>0.672</b>
#7	1	299.780	0.388	0.000	0.000	76.000	M	124.88	7.934
	<b>Σ</b>	<b>299.780</b>						<b>124.88</b>	<b>7.934</b>
<b>#11</b>	<b>Σ</b>	<b>299.780</b>						<b>124.88</b>	<b>7.934</b>
#8	1	84.500	0.160	0.000	0.000	76.000	M	52.94	2.280
	<b>Σ</b>	<b>84.500</b>						<b>52.94</b>	<b>2.280</b>
<b>#10</b>	<b>Σ</b>	<b>404.580</b>						<b>157.94</b>	<b>10.886</b>

**Subwatershed Time of Concentration Details:**

Stru #	SWS #	Land Flow Condition	Slope (%)	Vert. Dist. (ft)	Horiz. Dist. (ft)	Velocity (fps)	Time (hrs)
#7	1	8. Large gullies, diversions, and low flowing streams	1.56	82.00	5,248.00	3.750	0.388
<b>#7</b>	<b>1</b>	<b>Time of Concentration:</b>					<b>0.388</b>
#8	1	8. Large gullies, diversions, and low flowing streams	2.19	56.00	2,559.18	4.430	0.160
<b>#8</b>	<b>1</b>	<b>Time of Concentration:</b>					<b>0.160</b>
#9	1	8. Large gullies, diversions, and low flowing streams	2.75	60.00	2,178.01	4.970	0.121
<b>#9</b>	<b>1</b>	<b>Time of Concentration:</b>					<b>0.121</b>

## **A2 Pond 202**

***The watershed for the impoundment is presented on Exhibit 11-13D. The detail design is presented on Exhibit 173.***

***The channels and inlets to the pond are designed to be stable for the 10 yr-6 hr storm event.***

***The schematic of the structure networking for Pond 202 is attached.***

Ramsey R. Yazzie

BHP Billiton  
POBox 1717  
Fruitland, NM 87416

Phone: 505-598-3282  
Email: Ramsey.R.Yazzie@bhpbilliton.com

## ***General Information***

### ***Storm Information:***

Storm Type:	TYPE II-70
Design Storm:	10 yr - 6 hr
Rainfall Depth:	1.230 inches

### Structure Networking:

Type	Stru #	(flows into)	Stru #	Musk. K (hrs)	Musk. X	Description
Channel	#7	==>	#11	0.000	0.000	South Channel Diversion
Channel	#8	==>	#10	0.000	0.000	East Channel
Channel	#9	==>	#12	0.000	0.000	North Channel Diversion
Null	#10	==>	End	0.000	0.000	Pond 202
Channel	#11	==>	#10	0.000	0.000	South Channel Rip Rap
Channel	#12	==>	#10	0.000	0.000	North Channel Rip Rap



***Structure Summary:***

	Immediate Contributing Area (ac)	Total Contributing Area (ac)	Peak Discharge (cfs)	Total Runoff Volume (ac-ft)
#9	20.300	20.300	6.97	0.16
#12	0.000	20.300	6.97	0.16
#7	299.780	299.780	26.00	1.90
#11	0.000	299.780	26.00	1.90
#8	84.500	84.500	12.00	0.55
#10	0.000	404.580	32.33	2.60

## **Structure Detail:**

### Structure #9 (Erodible Channel)

#### *North Channel Diversion*

Trapezoidal Erodible Channel Inputs:

#### Material: Spoils-Shale and Sandstone Cobbles

Bottom Width (ft)	Left Sideslope Ratio	Right Sideslope Ratio	Slope (%)	Manning's n	Freeboard Depth (ft)	Freeboard % of Depth	Freeboard Mult. x (VxD)	Limiting Velocity (fps)
6.00	3.0:1	3.0:1	1.4	0.0290	1.00			5.0

Erodible Channel Results:

	w/o Freeboard	w/ Freeboard
Design Discharge:	6.97 cfs	
Depth:	0.35 ft	1.35 ft
Top Width:	8.13 ft	14.13 ft
Velocity:	2.79 fps	
X-Section Area:	2.50 sq ft	
Hydraulic Radius:	0.304 ft	
Froude Number:	0.88	

### Structure #12 (Riprap Channel)

#### *North Channel Rip Rap*

Trapezoidal Riprap Channel Inputs:

#### Material: Riprap

Bottom Width (ft)	Left Sideslope Ratio	Right Sideslope Ratio	Slope (%)	Freeboard Depth (ft)	Freeboard % of Depth	Freeboard Mult. x (VxD)
6.00	3.0:1	3.0:1	7.7	1.00		

Riprap Channel Results:

#### Simons/OSM Method - Steep Slope Design

	w/o Freeboard	w/ Freeboard
Design Discharge:	6.97 cfs	
Depth:	0.14 ft	1.14 ft
Top Width:	6.86 ft	12.86 ft
Velocity*:		
X-Section Area:	0.92 sq ft	

	w/o Freeboard	w/ Freeboard
Hydraulic Radius:	0.133 ft	
Froude Number*:		
Manning's n*:		
Dmin:	1.00 in	
D50:	3.00 in	
Dmax:	3.75 in	

Velocity and Manning's n calculations may not apply for this method.

Structure #7 (Erodible Channel)

*South Channel Diversion*

Trapezoidal Erodible Channel Inputs:

Material: Spoils-Shale and Sandstone Cobbles

Bottom Width (ft)	Left Sideslope Ratio	Right Sideslope Ratio	Slope (%)	Manning's n	Freeboard Depth (ft)	Freeboard % of Depth	Freeboard Mult. x (VxD)	Limiting Velocity (fps)
6.00	3.0:1	3.0:1	0.8	0.0290	1.00			5.0

Erodible Channel Results:

	w/o Freeboard	w/ Freeboard
Design Discharge:	26.00 cfs	
Depth:	0.88 ft	1.88 ft
Top Width:	11.27 ft	17.27 ft
Velocity:	3.43 fps	
X-Section Area:	7.59 sq ft	
Hydraulic Radius:	0.656 ft	
Froude Number:	0.74	

Structure #11 (Riprap Channel)

*South Channel Rip Rap*

Trapezoidal Riprap Channel Inputs:

Material: Riprap

Bottom Width (ft)	Left Sideslope Ratio	Right Sideslope Ratio	Slope (%)	Freeboard Depth (ft)	Freeboard % of Depth	Freeboard Mult. x (VxD)
6.00	3.0:1	3.0:1	8.1	1.00		

Riprap Channel Results:

Simons/OSM Method - Steep Slope Design

	w/o Freeboard	w/ Freeboard
Design Discharge:	26.00 cfs	
Depth:	0.37 ft	1.37 ft
Top Width:	8.22 ft	14.22 ft
Velocity*:		
X-Section Area:	2.63 sq ft	
Hydraulic Radius:	0.315 ft	
Froude Number*:		
Manning's n*:		
Dmin:	2.00 in	
D50:	6.00 in	
Dmax:	7.50 in	

Velocity and Manning's n calculations may not apply for this method.

Structure #8 (Riprap Channel)

*East Channel*

Trapezoidal Riprap Channel Inputs:

Material: Riprap

Bottom Width (ft)	Left Sideslope Ratio	Right Sideslope Ratio	Slope (%)	Freeboard Depth (ft)	Freeboard % of Depth	Freeboard Mult. x (VxD)
6.00	3.0:1	3.0:1	8.4	1.00		

Riprap Channel Results:

Simons/OSM Method - Steep Slope Design

	w/o Freeboard	w/ Freeboard
Design Discharge:	12.00 cfs	
Depth:	0.20 ft	1.20 ft
Top Width:	7.22 ft	13.22 ft
Velocity*:		
X-Section Area:	1.35 sq ft	
Hydraulic Radius:	0.185 ft	
Froude Number*:		
Manning's n*:		
Dmin:	2.00 in	
D50:	6.00 in	
Dmax:	7.50 in	

Velocity and Manning's n calculations may not apply for this method.

Structure #10 (Null)

---


*Pond 202*

**Subwatershed Hydrology Detail:**

Stru #	SWS #	SWS Area (ac)	Time of Conc (hrs)	Musk K (hrs)	Musk X	Curve Number	UHS	Peak Discharge (cfs)	Runoff Volume (ac-ft)
#9	1	20.300	0.121	0.000	0.000	76.000	M	6.97	0.161
	<b>Σ</b>	<b>20.300</b>						<b>6.97</b>	<b>0.161</b>
<b>#12</b>	<b>Σ</b>	<b>20.300</b>						<b>6.97</b>	<b>0.161</b>
#7	1	299.780	0.388	0.000	0.000	76.000	M	26.00	1.899
	<b>Σ</b>	<b>299.780</b>						<b>26.00</b>	<b>1.899</b>
<b>#11</b>	<b>Σ</b>	<b>299.780</b>						<b>26.00</b>	<b>1.899</b>
#8	1	84.500	0.160	0.000	0.000	76.000	M	12.00	0.546
	<b>Σ</b>	<b>84.500</b>						<b>12.00</b>	<b>0.546</b>
<b>#10</b>	<b>Σ</b>	<b>404.580</b>						<b>32.33</b>	<b>2.605</b>

**Subwatershed Time of Concentration Details:**

Stru #	SWS #	Land Flow Condition	Slope (%)	Vert. Dist. (ft)	Horiz. Dist. (ft)	Velocity (fps)	Time (hrs)
#7	1	8. Large gullies, diversions, and low flowing streams	1.56	82.00	5,248.00	3.750	0.388
<b>#7</b>	<b>1</b>	<b>Time of Concentration:</b>					<b>0.388</b>
#8	1	8. Large gullies, diversions, and low flowing streams	2.19	56.00	2,559.18	4.430	0.160
<b>#8</b>	<b>1</b>	<b>Time of Concentration:</b>					<b>0.160</b>
#9	1	8. Large gullies, diversions, and low flowing streams	2.75	60.00	2,178.01	4.970	0.121
<b>#9</b>	<b>1</b>	<b>Time of Concentration:</b>					<b>0.121</b>

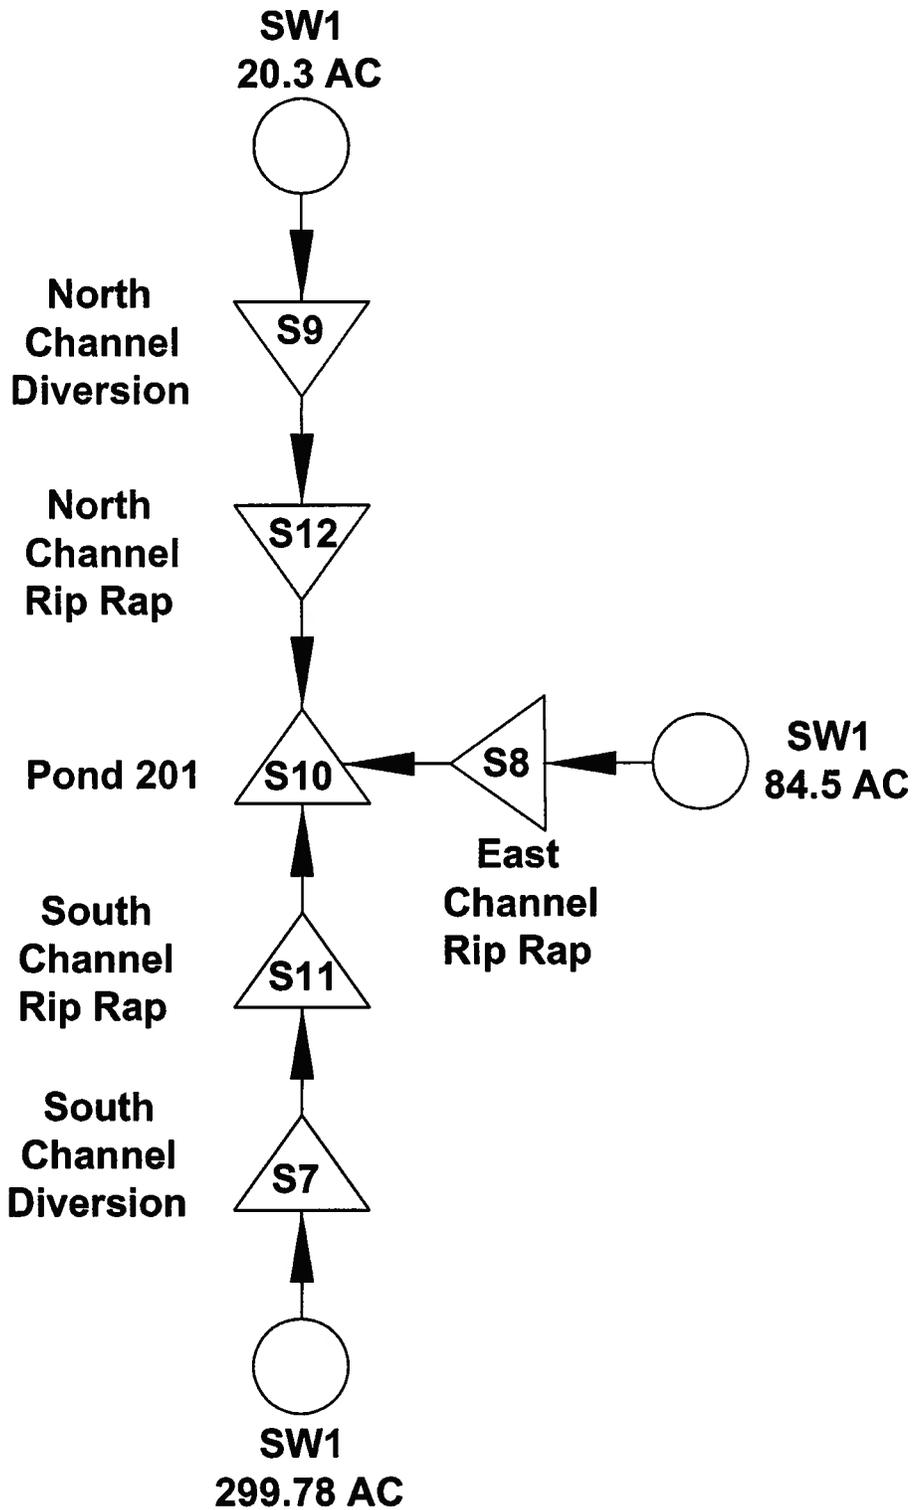

# POND 202 SEDCAD MODELING SCHEMATIC

648

**LEGEND**

- STRUCTURE
- WATERSHED
- FLOWS INTO

**NOTES**

1. FOR HYDROLOGY INFORMATION REFER TO APPENDIX 11-AA IN THE APPROVED PMS.
2. THE WATERSHED INFORMATION FOR POND 202 IS SHOWN IN EXHIBIT 11-13D.

**BHP Navajo Coal Company**  
P.O. Box 1717, Phone 505-689-0000  
 Fruitland New Mexico 87416 Fax 505-689-3981

**AREA 2  
POND 202  
MODELING SCHEMATIC**


PREPARED BY	REV	DESIGNED BY	REV	SCALE	NO. 1009
APPROVED BY	LN	DATE	08.13.2010		



**LEGEND**

	ROAD
	WATERWAY
	BUILDING
	FENCE
	IRRIGATION LINE
	CULVERT
	DIRT
	OPEN SPACE
	BOUNDARY
	WELLS
	POWER LINE
	SPOT ELEVATION
	WIDE X RAMP (PA)
	WELLS/DATE CANTON
	LEASE CENTER
	LEASE PERMIT BOUNDARY

- NOTES**
- FOR HYDROLOGY INFORMATION REFER TO APPENDIX 11-AA IN THE APPROVED MAP.
  - THE WATERSHED INFORMATION FOR PONDS 201 AND 202 ARE SHOWN IN EXHIBIT 11-13D.

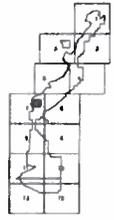

**bhpbiluton**

**BHP Navajo Coal Company**  
 P.O. Box 1717 Phone: 505-865-6200  
 Fruitedale, New Mexico 88510 Fax: 505-299-1091

**AREA 2**  
**POND 201 AND 202**  
**HYDROLOGY MODEL**

PREPARED BY: BWT / CHECKED BY: AWL / DATE: 05/06/2010  
 APPROVED BY: LR / DATE: 05/06/2010

# **POND 310** **100 YEAR-6 HOUR**

*The watershed for Pond 310 is shown on Exhibit 11-13E. The design is presented on Exhibit 11-178. The pond is designed to retain a 100 yr- 6 hr storm event. No spillway is required. The channels and inlets to the pond are designed to be stable for a 10 yr- 6 hr storm event. A schematic of the hydrology model is attached.*

R. Yazzie

BHP Navajo Coal Company

Fruitland, NM 87416

## ***General Information***

### ***Storm Information:***

Storm Type:	NRCS TYPE II-70
Design Storm:	100 yr - 6 hr
Rainfall Depth:	1.970 inches

### Structure Networking:

Type	Stru #	(flows into)	Stru #	Musk. K (hrs)	Musk. X	Description
Null	#1	==>	End	0.000	0.000	Pond 310
Channel	#2	==>	#1	0.000	0.000	West Channel
Channel	#3	==>	#1	0.000	0.000	South Channel
Channel	#4	==>	#1	0.000	0.000	East Channel
Channel	#5	==>	#1	0.000	0.000	North Channel
Culvert	#6	==>	#2	0.000	0.000	CP-171
Culvert	#7	==>	#4	0.000	0.000	CP-327



***Structure Summary:***

	Immediate Contributing Area (ac)	Total Contributing Area (ac)	Peak Discharge (cfs)	Total Runoff Volume (ac-ft)
#5	24.130	24.130	24.45	1.33
#7	71.130	71.130	46.71	2.59
#4	161.830	232.960	111.47	8.44
#3	34.520	34.520	29.02	1.27
#6	19.480	19.480	27.87	1.32
#2	14.120	33.600	46.06	1.96
#1	6.760	331.970	141.08	13.38

## Structure Detail:

### Structure #5 (Riprap Channel)

#### North Channel

Trapezoidal Riprap Channel Inputs:

#### Material: Riprap

Bottom Width (ft)	Left Sideslope Ratio	Right Sideslope Ratio	Slope (%)	Freeboard Depth (ft)	Freeboard % of Depth	Freeboard Mult. x (VxD)
8.00	3.0:1	3.0:1	16.0	1.00		

Riprap Channel Results:

#### Simons/OSM Method - Steep Slope Design

	w/o Freeboard	w/ Freeboard
Design Discharge:	24.45 cfs	
Depth:	0.24 ft	1.24 ft
Top Width:	9.46 ft	15.46 ft
Velocity*:		
X-Section Area:	2.12 sq ft	
Hydraulic Radius:	0.223 ft	
Froude Number*:		
Manning's n*:		
Dmin:	3.00 in	
D50:	9.00 in	
Dmax:	11.25 in	

Velocity and Manning's n calculations may not apply for this method.

### Structure #7 (Culvert)

#### CP-327

Culvert Inputs:

Length (ft)	Slope (%)	Manning's n	Max. Headwater (ft)	Tailwater (ft)	Entrance Loss Coef. (Ke)
142.00	2.00	0.0150	3.00	0.00	0.90

Culvert Results:

Design Discharge = 46.71 cfs

Minimum pipe diameter: 1 - 54 inch pipe(s) required

### Structure #4 (Riprap Channel)

*East Channel*

Trapezoidal Riprap Channel Inputs:

Material: Riprap

Bottom Width (ft)	Left Sideslope Ratio	Right Sideslope Ratio	Slope (%)	Freeboard Depth (ft)	Freeboard % of Depth	Freeboard Mult. x (VxD)
14.00	3.0:1	3.0:1	17.0	1.00		

Riprap Channel Results:

Simons/OSM Method - Steep Slope Design

	w/o Freeboard	w/ Freeboard
Design Discharge:	111.47 cfs	
Depth:	0.52 ft	1.52 ft
Top Width:	17.10 ft	23.10 ft
Velocity*:		
X-Section Area:	8.03 sq ft	
Hydraulic Radius:	0.465 ft	
Froude Number*:		
Manning's n*:		
Dmin:	4.00 in	
D50:	12.00 in	
Dmax:	15.00 in	

Velocity and Manning's n calculations may not apply for this method.

Structure #3 (Riprap Channel)

*South Channel*

Trapezoidal Riprap Channel Inputs:

Material: Riprap

Bottom Width (ft)	Left Sideslope Ratio	Right Sideslope Ratio	Slope (%)	Freeboard Depth (ft)	Freeboard % of Depth	Freeboard Mult. x (VxD)
8.00	3.0:1	3.0:1	18.0	1.00		

Riprap Channel Results:

Simons/OSM Method - Steep Slope Design

	w/o Freeboard	w/ Freeboard
Design Discharge:	29.02 cfs	
Depth:	0.26 ft	1.26 ft
Top Width:	9.56 ft	15.56 ft
Velocity*:		

	w/o Freeboard	w/ Freeboard
X-Section Area:	2.28 sq ft	
Hydraulic Radius:	0.236 ft	
Froude Number*:		
Manning's n*:		
Dmin:	3.00 in	
D50:	9.00 in	
Dmax:	11.25 in	

Velocity and Manning's n calculations may not apply for this method.

Structure #6 (Culvert)

CP-171

Culvert Inputs:

Length (ft)	Slope (%)	Manning's n	Max. Headwater (ft)	Tailwater (ft)	Entrance Loss Coef. (Ke)
91.00	1.88	0.0150	6.00	0.00	0.90

Culvert Results:

Design Discharge = 27.87 cfs

Minimum pipe diameter: 1 - 24 inch pipe(s) required

Structure #2 (Riprap Channel)

West Channel

Trapezoidal Riprap Channel Inputs:

Material: Riprap

Bottom Width (ft)	Left Sideslope Ratio	Right Sideslope Ratio	Slope (%)	Freeboard Depth (ft)	Freeboard % of Depth	Freeboard Mult. x (VxD)
8.00	3.0:1	3.0:1	14.0	1.00		

Riprap Channel Results:

Simons/OSM Method - Steep Slope Design

	w/o Freeboard	w/ Freeboard
Design Discharge:	46.06 cfs	
Depth:	0.42 ft	1.42 ft
Top Width:	10.51 ft	16.51 ft
Velocity*:		
X-Section Area:	3.87 sq ft	
Hydraulic Radius:	0.364 ft	
Froude Number*:		
Manning's n*:		

---

	w/o Freeboard	w/ Freeboard
Dmin:	4.00 in	
D50:	12.00 in	
Dmax:	15.00 in	

Velocity and Manning's n calculations may not apply for this method.

*Structure #1 (Null)*

*Pond 310*

### *Subwatershed Hydrology Detail:*

Stru #	SWS #	SWS Area (ac)	Time of Conc (hrs)	Musk K (hrs)	Musk X	Curve Number	UHS	Peak Discharge (cfs)	Runoff Volume (ac-ft)
#5	1	24.130	0.285	0.000	0.000	86.000	M	24.45	1.329
	<b>Σ</b>	<b>24.130</b>						<b>24.45</b>	<b>1.329</b>
#7	1	71.130	0.231	0.300	0.303	80.000	M	52.80	2.593
	<b>Σ</b>	<b>71.130</b>						<b>46.71</b>	<b>2.593</b>
#4	1	161.830	0.679	0.000	0.000	80.000	M	65.48	5.849
	<b>Σ</b>	<b>232.960</b>						<b>111.47</b>	<b>8.442</b>
#3	1	34.520	0.162	0.000	0.000	80.000	M	29.02	1.272
	<b>Σ</b>	<b>34.520</b>						<b>29.02</b>	<b>1.272</b>
#6	1	19.480	0.125	0.028	0.302	89.000	M	27.87	1.323
	<b>Σ</b>	<b>19.480</b>						<b>27.87</b>	<b>1.323</b>
#2	1	14.120	0.084	0.000	0.000	80.000	M	20.98	0.639
	<b>Σ</b>	<b>33.600</b>						<b>46.06</b>	<b>1.962</b>
#1	1	6.760	0.130	0.000	0.000	86.000	M	8.23	0.378
	<b>Σ</b>	<b>331.970</b>						<b>141.08</b>	<b>13.384</b>


### *Subwatershed Time of Concentration Details:*

Stru #	SWS #	Land Flow Condition	Slope (%)	Vert. Dist. (ft)	Horiz. Dist. (ft)	Velocity (fps)	Time (hrs)
#1	1	5. Nearly bare and untilled, and alluvial valley fans	2.26	16.00	706.43	1.500	0.130
<b>#1</b>	<b>1</b>	<b>Time of Concentration:</b>					<b>0.130</b>
#2	1	5. Nearly bare and untilled, and alluvial valley fans	1.64	2.00	122.29	1.270	0.026
		8. Large gullies, diversions, and low flowing streams	3.42	40.00	1,170.72	5.540	0.058
<b>#2</b>	<b>1</b>	<b>Time of Concentration:</b>					<b>0.084</b>
#3	1	5. Nearly bare and untilled, and alluvial valley fans	3.71	8.00	215.91	1.920	0.031
		8. Large gullies, diversions, and low flowing streams	1.79	34.00	1,896.47	4.010	0.131
<b>#3</b>	<b>1</b>	<b>Time of Concentration:</b>					<b>0.162</b>
#4	1	5. Nearly bare and untilled, and alluvial valley fans	0.91	11.94	1,308.06	0.950	0.382
		8. Large gullies, diversions, and low flowing streams	0.71	19.35	2,709.32	2.530	0.297
<b>#4</b>	<b>1</b>	<b>Time of Concentration:</b>					<b>0.679</b>
#5	1	5. Nearly bare and untilled, and alluvial valley fans	1.15	2.00	173.39	1.070	0.045

Stru #	SWS #	Land Flow Condition	Slope (%)	Vert. Dist. (ft)	Horiz. Dist. (ft)	Velocity (fps)	Time (hrs)
		8. Large gullies, diversions, and low flowing streams	0.95	24.00	2,528.44	2.920	0.240
<b>#5</b>	<b>1</b>	<b>Time of Concentration:</b>					<b>0.285</b>
#6	1	5. Nearly bare and untilled, and alluvial valley fans	3.82	10.00	261.87	1.950	0.037
		8. Large gullies, diversions, and low flowing streams	2.14	30.00	1,399.05	4.390	0.088
<b>#6</b>	<b>1</b>	<b>Time of Concentration:</b>					<b>0.125</b>
#7	1	5. Nearly bare and untilled, and alluvial valley fans	0.79	2.50	315.05	0.890	0.098
		8. Large gullies, diversions, and low flowing streams	1.84	36.00	1,956.41	4.060	0.133
<b>#7</b>	<b>1</b>	<b>Time of Concentration:</b>					<b>0.231</b>


***Subwatershed Muskingum Routing Details:***

Stru #	SWS #	Land Flow Condition	Slope (%)	Vert. Dist. (ft)	Horiz. Dist. (ft)	Velocity (fps)	Time (hrs)
#6	1	8. Large gullies, diversions, and low flowing streams	0.75	2.00	266.31	2.590	0.028
<b>#6</b>	<b>1</b>	<b>Muskingum K:</b>					<b>0.028</b>
#7	1	8. Large gullies, diversions, and low flowing streams	0.76	21.50	2,826.34	2.610	0.300
<b>#7</b>	<b>1</b>	<b>Muskingum K:</b>					<b>0.300</b>

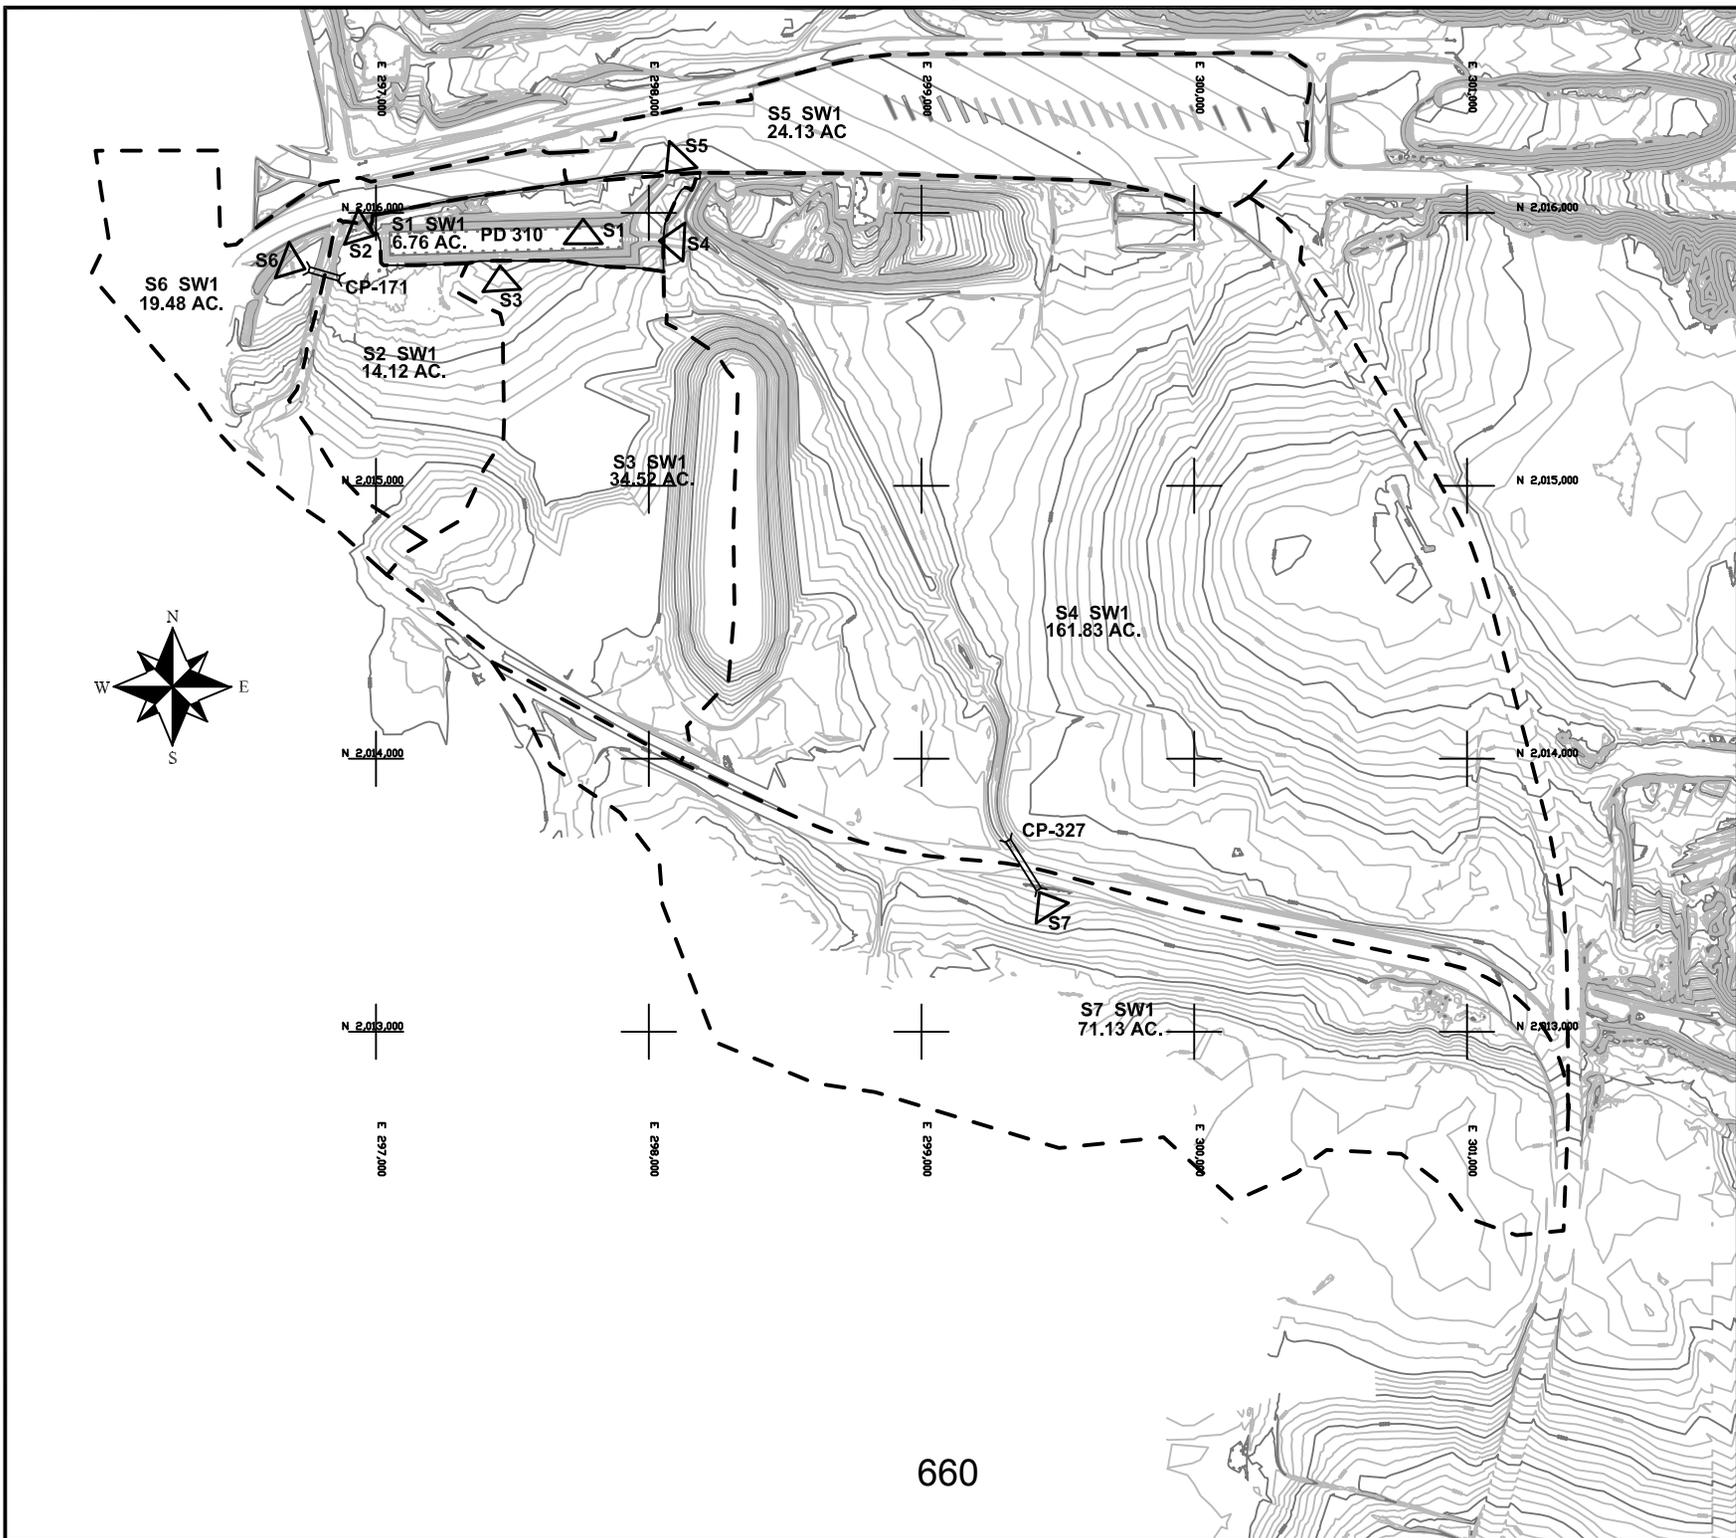

**LEGEND**

- ROAD
- WATERSHED
- BUILDING
- FENCE
- IRRIGATION LINE
- CULVERT
- DAM
- DRAINAGE
- RAILROAD
- TREES
- POWERLINE
- SPOT ELEVATION
- INDEX CONTOUR
- INTERMEDIATE CONTOUR
- LEASE CORNER
- LEASE/PERMIT BOUNDARY
- STRUCTURE

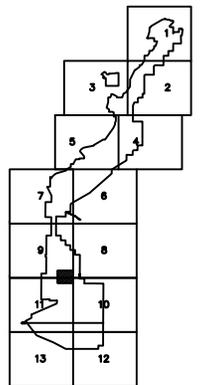

BHP Navajo Coal Company

P.O. Box 1777      Phone: 505-282-8700      Fax: 505-282-5397  
 Pinedale, Wyo. 82911

**POND 310  
 SCHEMATIC OF  
 HYDROLOGY MODEL**

Prepared By: RY      Drawn By: RRY      Scale: 1" = 700'  
 Approved By: JLR      Plot Date: 9/9/13      Layout: 8.5X11\_LLS

Drawing: D:\Bypass 20 Contours RRY 053113.dwg

# **POND 310**

## **10 YEAR-6 HOUR**

*The watershed for Pond 310 is shown on Exhibit 11-13E. The design is presented on Exhibit 11-178. The pond is designed to retain a 100 yr- 6 hr storm event. No spillway is required. The channels and inlets to the pond are designed to be stable for a 10 yr- 6 hr storm event. A schematic of the hydrology model is attached.*

R. Yazzie

BHP Navajo Coal Company

Fruitland, NM 87416

## ***General Information***

### ***Storm Information:***

Storm Type:	NRCS TYPE II-70
Design Storm:	10 yr - 6 hr
Rainfall Depth:	1.230 inches

### Structure Networking:

Type	Stru #	(flows into)	Stru #	Musk. K (hrs)	Musk. X	Description
Null	#1	==>	End	0.000	0.000	Pond 310
Channel	#2	==>	#1	0.000	0.000	West Channel
Channel	#3	==>	#1	0.000	0.000	South Channel
Channel	#4	==>	#1	0.000	0.000	East Channel
Channel	#5	==>	#1	0.000	0.000	North Channel
Culvert	#6	==>	#2	0.000	0.000	CP-171
Culvert	#7	==>	#4	0.000	0.000	CP-327



***Structure Summary:***

	Immediate Contributing Area (ac)	Total Contributing Area (ac)	Peak Discharge (cfs)	Total Runoff Volume (ac-ft)
#5	24.130	24.130	9.70	0.52
#7	71.130	71.130	13.57	0.79
#4	161.830	232.960	31.94	2.56
#3	34.520	34.520	8.91	0.39
#6	19.480	19.480	12.78	0.57
#2	14.120	33.600	18.23	0.77
#1	6.760	331.970	43.72	4.38

## Structure Detail:

### Structure #5 (Riprap Channel)

#### North Channel

Trapezoidal Riprap Channel Inputs:

#### Material: Riprap

Bottom Width (ft)	Left Sideslope Ratio	Right Sideslope Ratio	Slope (%)	Freeboard Depth (ft)	Freeboard % of Depth	Freeboard Mult. x (VxD)
8.00	3.0:1	3.0:1	16.0	1.00		

Riprap Channel Results:

#### Simons/OSM Method - Steep Slope Design

	w/o Freeboard	w/ Freeboard
Design Discharge:	9.70 cfs	
Depth:	0.12 ft	1.12 ft
Top Width:	8.71 ft	14.71 ft
Velocity*:		
X-Section Area:	0.99 sq ft	
Hydraulic Radius:	0.114 ft	
Froude Number*:		
Manning's n*:		
Dmin:	2.00 in	
D50:	6.00 in	
Dmax:	7.50 in	

Velocity and Manning's n calculations may not apply for this method.

### Structure #7 (Culvert)

#### CP-327

Culvert Inputs:

Length (ft)	Slope (%)	Manning's n	Max. Headwater (ft)	Tailwater (ft)	Entrance Loss Coef. (Ke)
142.00	2.00	0.0150	3.00	0.00	0.90

Culvert Results:

Design Discharge = 13.57 cfs

Minimum pipe diameter: 1 - 21 inch pipe(s) required

### Structure #4 (Riprap Channel)

*East Channel*

Trapezoidal Riprap Channel Inputs:

Material: Riprap

Bottom Width (ft)	Left Sideslope Ratio	Right Sideslope Ratio	Slope (%)	Freeboard Depth (ft)	Freeboard % of Depth	Freeboard Mult. x (VxD)
14.00	3.0:1	3.0:1	17.0	1.00		

Riprap Channel Results:

Simons/OSM Method - Steep Slope Design

	w/o Freeboard	w/ Freeboard
Design Discharge:	31.94 cfs	
Depth:	0.17 ft	1.17 ft
Top Width:	15.05 ft	21.05 ft
Velocity*:		
X-Section Area:	2.54 sq ft	
Hydraulic Radius:	0.168 ft	
Froude Number*:		
Manning's n*:		
Dmin:	2.00 in	
D50:	6.00 in	
Dmax:	7.50 in	

Velocity and Manning's n calculations may not apply for this method.

Structure #3 (Riprap Channel)

*South Channel*

Trapezoidal Riprap Channel Inputs:

Material: Riprap

Bottom Width (ft)	Left Sideslope Ratio	Right Sideslope Ratio	Slope (%)	Freeboard Depth (ft)	Freeboard % of Depth	Freeboard Mult. x (VxD)
8.00	3.0:1	3.0:1	18.0	1.00		

Riprap Channel Results:

Simons/OSM Method - Steep Slope Design

	w/o Freeboard	w/ Freeboard
Design Discharge:	8.91 cfs	
Depth:	0.10 ft	1.10 ft
Top Width:	8.61 ft	14.61 ft
Velocity*:		

	w/o Freeboard	w/ Freeboard
X-Section Area:	0.85 sq ft	
Hydraulic Radius:	0.098 ft	
Froude Number*:		
Manning's n*:		
Dmin:	2.00 in	
D50:	6.00 in	
Dmax:	7.50 in	

Velocity and Manning's n calculations may not apply for this method.

Structure #6 (Culvert)

CP-171

Culvert Inputs:

Length (ft)	Slope (%)	Manning's n	Max. Headwater (ft)	Tailwater (ft)	Entrance Loss Coef. (Ke)
91.00	1.88	0.0150	6.00	0.00	0.90

Culvert Results:

Design Discharge = 12.78 cfs

Minimum pipe diameter: 1 - 18 inch pipe(s) required

Structure #2 (Riprap Channel)

West Channel

Trapezoidal Riprap Channel Inputs:

Material: Riprap

Bottom Width (ft)	Left Sideslope Ratio	Right Sideslope Ratio	Slope (%)	Freeboard Depth (ft)	Freeboard % of Depth	Freeboard Mult. x (VxD)
8.00	3.0:1	3.0:1	14.0	1.00		

Riprap Channel Results:

Simons/OSM Method - Steep Slope Design

	w/o Freeboard	w/ Freeboard
Design Discharge:	18.23 cfs	
Depth:	0.21 ft	1.21 ft
Top Width:	9.24 ft	15.24 ft
Velocity*:		
X-Section Area:	1.78 sq ft	
Hydraulic Radius:	0.192 ft	
Froude Number*:		
Manning's n*:		

---

	w/o Freeboard	w/ Freeboard
Dmin:	2.00 in	
D50:	6.00 in	
Dmax:	7.50 in	

Velocity and Manning's n calculations may not apply for this method.

*Structure #1 (Null)*

*Pond 310*

### *Subwatershed Hydrology Detail:*

Stru #	SWS #	SWS Area (ac)	Time of Conc (hrs)	Musk K (hrs)	Musk X	Curve Number	UHS	Peak Discharge (cfs)	Runoff Volume (ac-ft)
#5	1	24.130	0.285	0.000	0.000	86.000	M	9.70	0.519
	<b>Σ</b>	<b>24.130</b>						<b>9.70</b>	<b>0.519</b>
#7	1	71.130	0.231	0.300	0.303	80.000	M	15.82	0.786
	<b>Σ</b>	<b>71.130</b>						<b>13.57</b>	<b>0.786</b>
#4	1	161.830	0.679	0.000	0.000	80.000	M	18.37	1.773
	<b>Σ</b>	<b>232.960</b>						<b>31.94</b>	<b>2.559</b>
#3	1	34.520	0.162	0.000	0.000	80.000	M	8.91	0.386
	<b>Σ</b>	<b>34.520</b>						<b>8.91</b>	<b>0.386</b>
#6	1	19.480	0.125	0.028	0.302	89.000	M	12.78	0.574
	<b>Σ</b>	<b>19.480</b>						<b>12.78</b>	<b>0.574</b>
#2	1	14.120	0.084	0.000	0.000	80.000	M	7.61	0.194
	<b>Σ</b>	<b>33.600</b>						<b>18.23</b>	<b>0.768</b>
#1	1	6.760	0.130	0.000	0.000	86.000	M	3.39	0.148
	<b>Σ</b>	<b>331.970</b>						<b>43.72</b>	<b>4.380</b>


### *Subwatershed Time of Concentration Details:*

Stru #	SWS #	Land Flow Condition	Slope (%)	Vert. Dist. (ft)	Horiz. Dist. (ft)	Velocity (fps)	Time (hrs)
#1	1	5. Nearly bare and untilled, and alluvial valley fans	2.26	16.00	706.43	1.500	0.130
<b>#1</b>	<b>1</b>	<b>Time of Concentration:</b>					<b>0.130</b>
#2	1	5. Nearly bare and untilled, and alluvial valley fans	1.64	2.00	122.29	1.270	0.026
		8. Large gullies, diversions, and low flowing streams	3.42	40.00	1,170.72	5.540	0.058
<b>#2</b>	<b>1</b>	<b>Time of Concentration:</b>					<b>0.084</b>
#3	1	5. Nearly bare and untilled, and alluvial valley fans	3.71	8.00	215.91	1.920	0.031
		8. Large gullies, diversions, and low flowing streams	1.79	34.00	1,896.47	4.010	0.131
<b>#3</b>	<b>1</b>	<b>Time of Concentration:</b>					<b>0.162</b>
#4	1	5. Nearly bare and untilled, and alluvial valley fans	0.91	11.94	1,308.06	0.950	0.382
		8. Large gullies, diversions, and low flowing streams	0.71	19.35	2,709.32	2.530	0.297
<b>#4</b>	<b>1</b>	<b>Time of Concentration:</b>					<b>0.679</b>
#5	1	5. Nearly bare and untilled, and alluvial valley fans	1.15	2.00	173.39	1.070	0.045

Stru #	SWS #	Land Flow Condition	Slope (%)	Vert. Dist. (ft)	Horiz. Dist. (ft)	Velocity (fps)	Time (hrs)
		8. Large gullies, diversions, and low flowing streams	0.95	24.00	2,528.44	2.920	0.240
<b>#5</b>	<b>1</b>	<b>Time of Concentration:</b>					<b>0.285</b>
#6	1	5. Nearly bare and untilled, and alluvial valley fans	3.82	10.00	261.87	1.950	0.037
		8. Large gullies, diversions, and low flowing streams	2.14	30.00	1,399.05	4.390	0.088
<b>#6</b>	<b>1</b>	<b>Time of Concentration:</b>					<b>0.125</b>
#7	1	5. Nearly bare and untilled, and alluvial valley fans	0.79	2.50	315.05	0.890	0.098
		8. Large gullies, diversions, and low flowing streams	1.84	36.00	1,956.41	4.060	0.133
<b>#7</b>	<b>1</b>	<b>Time of Concentration:</b>					<b>0.231</b>


***Subwatershed Muskingum Routing Details:***

Stru #	SWS #	Land Flow Condition	Slope (%)	Vert. Dist. (ft)	Horiz. Dist. (ft)	Velocity (fps)	Time (hrs)
#6	1	8. Large gullies, diversions, and low flowing streams	0.75	2.00	266.31	2.590	0.028
<b>#6</b>	<b>1</b>	<b>Muskingum K:</b>					<b>0.028</b>
#7	1	8. Large gullies, diversions, and low flowing streams	0.76	21.50	2,826.34	2.610	0.300
<b>#7</b>	<b>1</b>	<b>Muskingum K:</b>					<b>0.300</b>

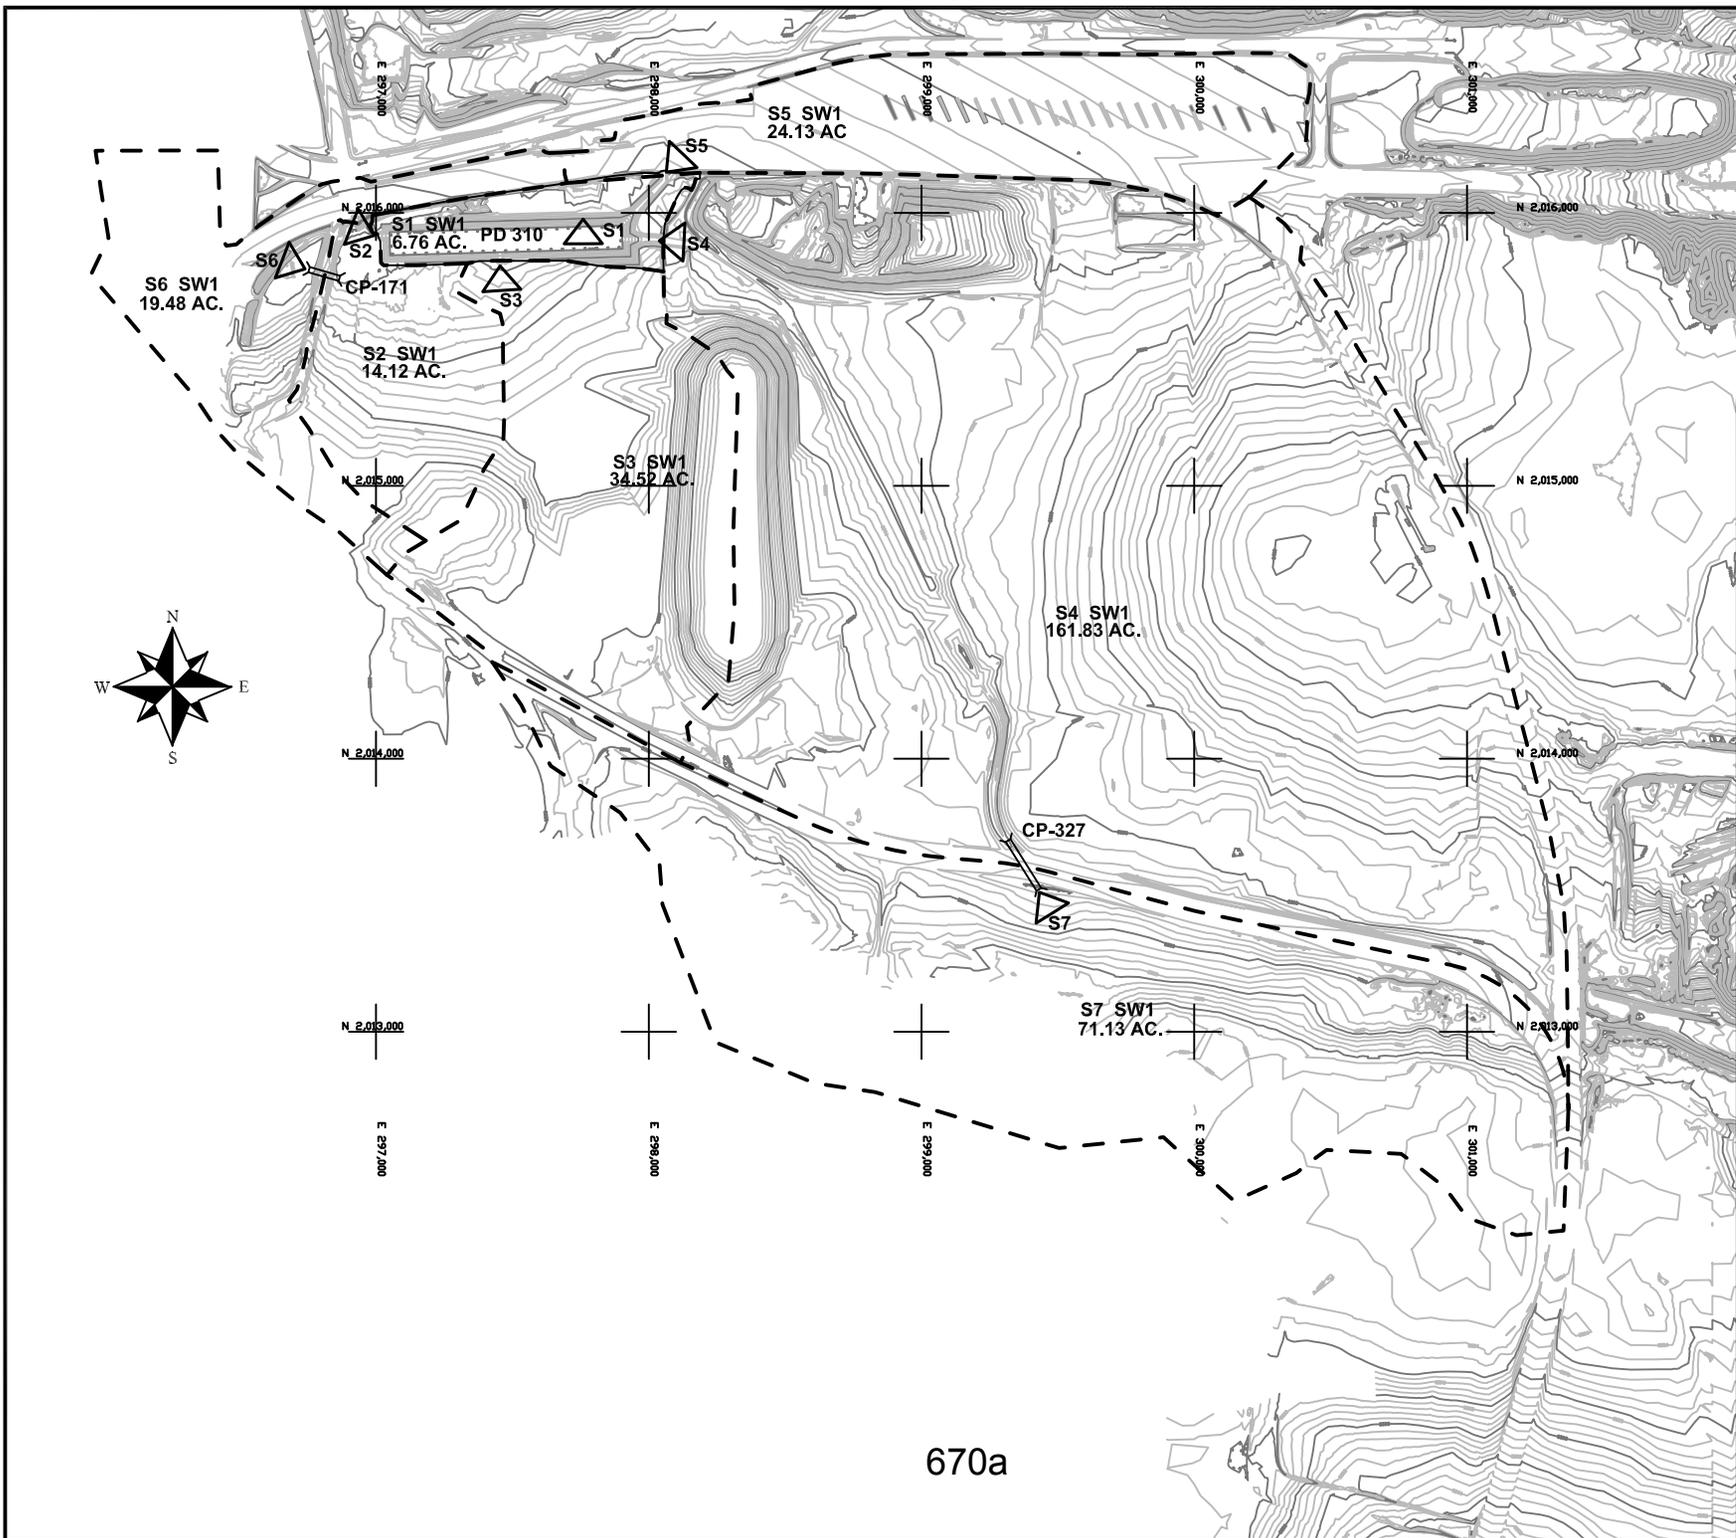

### LEGEND

- ROAD
- WATERSHED
- BUILDING
- FENCE
- IRRIGATION LINE
- CULVERT
- DAM
- DRAINAGE
- RAILROAD
- TREES
- POWERLINE
- SPOT ELEVATION
- INDEX CONTOUR
- INTERMEDIATE CONTOUR
- LEASE CORNER
- LEASE/PERMIT BOUNDARY
- STRUCTURE

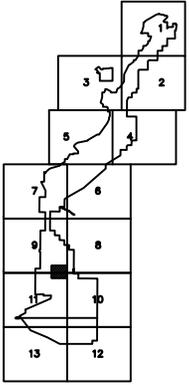

BHP Navajo Coal Company

P.O. Box 1777      Phone: 505-282-8700      Fax: 505-282-5107  
 P.O. Box 10000      Phone: 505-282-8700      Fax: 505-282-5107

### POND 310 SCHEMATIC OF HYDROLOGY MODEL

Prepared By: RY      Drawn By: RRY      Scale: 1" = 700'

Approved By: JLR      Plot Date: 8/9/13      Layout: 8.5X11\_LLS

Drawn By: Bypass 20 Contours RRY 053113.dwg

670a

## **Pond 311**

***The watershed for the impoundment is presented on Exhibit 11-13E. The detail design is presented on Exhibit 11-179.***

***The pond is designed to retain a 10 year 24 hour storm.***

***The spillway is designed for a 25 year 6 hour storm event.***

***The channel is designed to be stable during a 10 year 6 hour storm event.***

***The hydrology structure schematic for Pond 311 is attached.***

Ramsey R. Yazzie

BHP Billiton  
POBox 1717  
Fruitland, NM 87416


## ***General Information***

### ***Storm Information:***

Storm Type:	NM TYPE II 70
Design Storm:	10 yr - 24 hr
Rainfall Depth:	1.610 inches

### Structure Networking:

Type	Stru #	(flows into)	Stru #	Musk. K (hrs)	Musk. X	Description
Pond	#1	==>	#5	0.000	0.000	Pond 311
Culvert	#3	==>	#6	0.896	0.267	CP-45
Channel	#4	==>	#1	0.000	0.000	South Rip Rap Channel 2
Channel	#5	==>	End	0.000	0.000	Spillway Channel
Channel	#6	==>	#4	0.000	0.000	South Channel 2
Channel	#7	==>	#8	0.000	0.000	South Channel 1
Channel	#8	==>	#6	0.000	0.000	South Rip Rap Channel 1

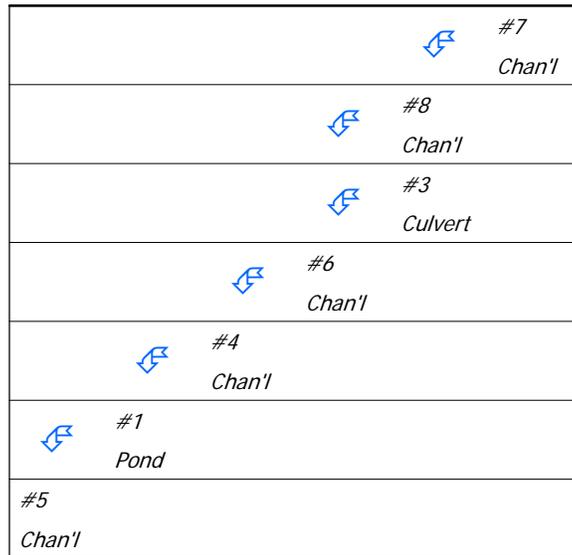

### Structure Routing Details:

Stru #	Land Flow Condition	Slope (%)	Vert. Dist. (ft)	Horiz. Dist. (ft)	Velocity (fps)	Time (hrs)
#3	5. Nearly bare and untilled, and alluvial valley fans	1.40	50.00	3,580.23	1.18	0.842
	8. Large gullies, diversions, and low flowing streams	2.62	25.00	954.52	4.85	0.054
<b>#3</b>	<b>Muskingum K:</b>					<b>0.896</b>

**Structure Summary:**

	Immediate Contributing Area (ac)	Total Contributing Area (ac)	Peak Discharge (cfs)	Total Runoff Volume (ac-ft)
#7	11.900	11.900	9.83	0.57
#8	0.100	12.000	9.85	0.58
#3	219.700	219.700	48.71	4.98
#6	26.600	258.300	42.67	6.82
#4	0.100	258.400	42.67	6.82
#1 In	1.400	259.800	42.71	6.90
Out			32.05	6.82
#5	0.000	259.800	32.05	6.82

## Structure Detail:

### Structure #7 (Erodible Channel)

#### South Channel 1

Trapezoidal Erodible Channel Inputs:

Material: Alluvial silts colloidal

Bottom Width (ft)	Left Sideslope Ratio	Right Sideslope Ratio	Slope (%)	Manning's n	Freeboard Depth (ft)	Freeboard % of Depth	Freeboard Mult. x (VxD)	Limiting Velocity (fps)
12.00	3.0:1	3.0:1	0.9	0.0250	1.00			5.0

Erodible Channel Results:

	w/o Freeboard	w/ Freeboard
Design Discharge:	9.83 cfs	
Depth:	0.31 ft	1.31 ft
Top Width:	13.85 ft	19.85 ft
Velocity:	2.47 fps	
X-Section Area:	3.99 sq ft	
Hydraulic Radius:	0.286 ft	
Froude Number:	0.81	

### Structure #8 (Riprap Channel)

#### South Rip Rap Channel 1

Trapezoidal Riprap Channel Inputs:

Material: Riprap

Bottom Width (ft)	Left Sideslope Ratio	Right Sideslope Ratio	Slope (%)	Freeboard Depth (ft)	Freeboard % of Depth	Freeboard Mult. x (VxD)
12.00	3.0:1	3.0:1	10.4	1.00		

Riprap Channel Results:

#### Simons/OSM Method - Steep Slope Design

	w/o Freeboard	w/ Freeboard
Design Discharge:	9.85 cfs	
Depth:	0.10 ft	1.10 ft
Top Width:	12.61 ft	18.61 ft
Velocity*:		
X-Section Area:	1.25 sq ft	

	w/o Freeboard	w/ Freeboard
Hydraulic Radius:	0.099 ft	
Froude Number*:		
Manning's n*:		
Dmin:	1.00 in	
D50:	3.00 in	
Dmax:	3.75 in	

Velocity and Manning's n calculations may not apply for this method.

Structure #3 (Culvert)

CP-45

Culvert Inputs:

Length (ft)	Slope (%)	Manning's n	Max. Headwater (ft)	Tailwater (ft)	Entrance Loss Coef. (Ke)
80.00	0.05	0.0150	5.00	0.00	0.90

Culvert Results:

Design Discharge = 48.71 cfs

Minimum pipe diameter: 1 - 36 inch pipe(s) required

Structure #6 (Erodible Channel)

South Channel 2

Trapezoidal Erodible Channel Inputs:

Material: Alluvial silts colloidal

Bottom Width (ft)	Left Sideslope Ratio	Right Sideslope Ratio	Slope (%)	Manning's n	Freeboard Depth (ft)	Freeboard % of Depth	Freeboard Mult. x (VxD)	Limiting Velocity (fps)
12.00	3.0:1	3.0:1	0.9	0.0250	1.00			5.0

Erodible Channel Results:

	w/o Freeboard	w/ Freeboard
Design Discharge:	42.67 cfs	
Depth:	0.72 ft	1.72 ft
Top Width:	16.33 ft	22.33 ft
Velocity:	4.17 fps	
X-Section Area:	10.24 sq ft	
Hydraulic Radius:	0.618 ft	
Froude Number:	0.93	

Structure #4 (Riprap Channel)

*South Rip Rap Channel 2*

Trapezoidal Riprap Channel Inputs:

Material: Riprap

Bottom Width (ft)	Left Sideslope Ratio	Right Sideslope Ratio	Slope (%)	Freeboard Depth (ft)	Freeboard % of Depth	Freeboard Mult. x (VxD)
12.00	3.0:1	3.0:1	11.5	1.00		

Riprap Channel Results:

Simons/OSM Method - Steep Slope Design

	w/o Freeboard	w/ Freeboard
Design Discharge:	42.67 cfs	
Depth:	0.32 ft	1.32 ft
Top Width:	13.91 ft	19.91 ft
Velocity*:		
X-Section Area:	4.13 sq ft	
Hydraulic Radius:	0.295 ft	
Froude Number*:		
Manning's n*:		
Dmin:	2.00 in	
D50:	6.00 in	
Dmax:	7.50 in	

Velocity and Manning's n calculations may not apply for this method.

Structure #1 (Pond)

*Pond 311*

Pond Inputs:

Initial Pool Elev:	5,333.00 ft
Initial Pool:	8.28 ac-ft

Emergency Spillway

Spillway Elev	Crest Length (ft)	Left Sideslope	Right Sideslope	Bottom Width (ft)
5,333.00	25.00	3.00:1	3.00:1	12.00

Pond Results:

Peak Elevation:	5,334.03 ft
Dewater Time:	1.19 days

*Dewatering time is calculated from peak stage to lowest spillway*

Elevation-Capacity-Discharge Table

Elevation	Area (ac)	Capacity (ac-ft)	Discharge (cfs)	Dewater Time (hrs)
5,325.50	0.934	0.000	0.000	
5,326.00	0.954	0.472	0.000	
5,326.50	0.974	0.954	0.000	
5,326.92	0.991	1.367	0.000	
5,327.00	0.994	1.446	0.000	
5,327.50	1.015	1.948	0.000	
5,328.00	1.036	2.461	0.000	
5,328.50	1.058	2.985	0.000	
5,329.00	1.079	3.519	0.000	
5,329.50	1.102	4.064	0.000	
5,330.00	1.124	4.621	0.000	
5,330.50	1.147	5.188	0.000	
5,331.00	1.177	5.769	0.000	
5,331.50	1.207	6.365	0.000	
5,332.00	1.251	6.980	0.000	
5,332.50	1.296	7.616	0.000	
5,333.00	1.371	8.283	0.000	Spillway #1
5,333.50	1.377	8.970	0.771	10.78*
5,334.00	1.634	9.721	29.820	17.70
5,334.03	1.602	9.774	32.048	0.15 Peak Stage
5,334.50	1.801	10.580	65.875	
5,335.00	1.975	11.524	112.817	

\*Designates time(s) to dewater have been extrapolated beyond the 50 hour hydrograph limit.

Detailed Discharge Table

Elevation (ft)	Emergency Spillway (cfs)	Combined Total Discharge (cfs)
5,325.50	0.000	0.000
5,326.00	0.000	0.000
5,326.50	0.000	0.000
5,326.92	0.000	0.000
5,327.00	0.000	0.000
5,327.50	0.000	0.000
5,328.00	0.000	0.000
5,328.50	0.000	0.000
5,329.00	0.000	0.000
5,329.50	0.000	0.000
5,330.00	0.000	0.000

Elevation (ft)	Emergency Spillway (cfs)	Combined Total Discharge (cfs)
5,330.50	0.000	0.000
5,331.00	0.000	0.000
5,331.50	0.000	0.000
5,332.00	0.000	0.000
5,332.50	0.000	0.000
5,333.00	0.000	0.000
5,333.50	0.771	0.771
5,334.00	29.820	29.820
5,334.50	65.875	65.875
5,335.00	112.817	112.817

Structure #5 (Erodible Channel)

*Spillway Channel*

Trapezoidal Erodible Channel Inputs:

Material: Alluvial silts colloidal

Bottom Width (ft)	Left Sideslope Ratio	Right Sideslope Ratio	Slope (%)	Manning's n	Freeboard Depth (ft)	Freeboard % of Depth	Freeboard Mult. x (VxD)	Limiting Velocity (fps)
12.00	3.0:1	3.0:1	0.5	0.0250	1.00			5.0

Erodible Channel Results:

	w/o Freeboard	w/ Freeboard
Design Discharge:	32.05 cfs	
Depth:	0.72 ft	1.72 ft
Top Width:	16.32 ft	22.32 ft
Velocity:	3.14 fps	
X-Section Area:	10.20 sq ft	
Hydraulic Radius:	0.616 ft	
Froude Number:	0.70	

**Subwatershed Hydrology Detail:**

Stru #	SWS #	SWS Area (ac)	Time of Conc (hrs)	Musk K (hrs)	Musk X	Curve Number	UHS	Peak Discharge (cfs)	Runoff Volume (ac-ft)
#7	1	11.900	0.179	0.000	0.000	89.000	M	9.83	0.574
	<b>Σ</b>	<b>11.900</b>						<b>9.83</b>	<b>0.574</b>
#8	1	0.100	0.009	0.000	0.000	89.000	M	0.14	0.004
	<b>Σ</b>	<b>12.000</b>						<b>9.85</b>	<b>0.578</b>
#3	1	219.700	0.444	0.444	0.324	80.000	M	53.76	4.980
	<b>Σ</b>	<b>219.700</b>						<b>48.71</b>	<b>4.980</b>
#6	1	26.600	5.410	0.000	0.000	89.000	M	2.25	1.261
	<b>Σ</b>	<b>258.300</b>						<b>42.67</b>	<b>6.819</b>
#4	1	0.100	0.010	0.000	0.000	89.000	M	0.14	0.004
	<b>Σ</b>	<b>258.400</b>						<b>42.67</b>	<b>6.823</b>
#1	1	1.400	0.001	0.000	0.000	89.000	M	1.91	0.080
	<b>Σ</b>	<b>259.800</b>						<b>42.71</b>	<b>6.903</b>
#5	<b>Σ</b>	<b>259.800</b>						<b>32.05</b>	<b>6.820</b>

**Subwatershed Time of Concentration Details:**

Stru #	SWS #	Land Flow Condition	Slope (%)	Vert. Dist. (ft)	Horiz. Dist. (ft)	Velocity (fps)	Time (hrs)
#1	1	8. Large gullies, diversions, and low flowing streams	3.98	0.10	2.50	5.980	0.000
		5. Nearly bare and untilled, and alluvial valley fans	48.08	12.50	26.00	6.930	0.001
<b>#1</b>	<b>1</b>	<b>Time of Concentration:</b>					<b>0.001</b>
#3	1	5. Nearly bare and untilled, and alluvial valley fans	2.62	25.00	954.52	1.610	0.164
		8. Large gullies, diversions, and low flowing streams	1.40	50.00	3,580.37	3.540	0.280
<b>#3</b>	<b>1</b>	<b>Time of Concentration:</b>					<b>0.444</b>
#4	1	5. Nearly bare and untilled, and alluvial valley fans	5.56	5.00	90.00	2.350	0.010
<b>#4</b>	<b>1</b>	<b>Time of Concentration:</b>					<b>0.010</b>
#6	1	5. Nearly bare and untilled, and alluvial valley fans	0.14	10.00	7,183.90	0.370	5.393
		8. Large gullies, diversions, and low flowing streams	0.65	1.00	155.01	2.400	0.017
<b>#6</b>	<b>1</b>	<b>Time of Concentration:</b>					<b>5.410</b>
#7	1	5. Nearly bare and untilled, and alluvial valley fans	1.13	2.00	177.00	1.060	0.046

Stru #	SWS #	Land Flow Condition	Slope (%)	Vert. Dist. (ft)	Horiz. Dist. (ft)	Velocity (fps)	Time (hrs)
		8. Large gullies, diversions, and low flowing streams	0.93	13.00	1,393.65	2.890	0.133
<b>#7</b>	<b>1</b>	<b>Time of Concentration:</b>					<b>0.179</b>
#8	1	5. Nearly bare and untilled, and alluvial valley fans	6.60	6.00	90.95	2.560	0.009
<b>#8</b>	<b>1</b>	<b>Time of Concentration:</b>					<b>0.009</b>

***Subwatershed Muskingum Routing Details:***

Stru #	SWS #	Land Flow Condition	Slope (%)	Vert. Dist. (ft)	Horiz. Dist. (ft)	Velocity (fps)	Time (hrs)
#3	1	5. Nearly bare and untilled, and alluvial valley fans	2.62	25.00	954.52	1.610	0.164
		8. Large gullies, diversions, and low flowing streams	1.40	50.00	3,580.37	3.540	0.280
<b>#3</b>	<b>1</b>	<b>Muskingum K:</b>					<b>0.444</b>

## **Pond 311**

***The watershed for the impoundment is presented on Exhibit 11-13E. The detail design is presented on Exhibit 11-179.***

***The pond is designed to retain a 10 year 24 hour storm.***

***The spillway is designed for a 25 year 6 hour storm event.***

***The channel is designed to be stable during a 10 year 6 hour storm event.***

***The hydrology structure schematic for Pond 311 is attached.***

Ramsey R. Yazzie

BHP Billiton  
POBox 1717  
Fruitland, NM 87416


## ***General Information***

### ***Storm Information:***

Storm Type:	NM TYPE II 70
Design Storm:	25 yr - 6 hr
Rainfall Depth:	1.500 inches

### Structure Networking:

Type	Stru #	(flows into)	Stru #	Musk. K (hrs)	Musk. X	Description
Pond	#1	==>	#5	0.000	0.000	Pond 311
Culvert	#3	==>	#6	0.896	0.267	CP-45
Channel	#4	==>	#1	0.000	0.000	South Rip Rap Channel 2
Channel	#5	==>	End	0.000	0.000	Spillway Channel
Channel	#6	==>	#4	0.000	0.000	South Channel 2
Channel	#7	==>	#8	0.000	0.000	South Channel 1
Channel	#8	==>	#6	0.000	0.000	South Rip Rap Channel 1

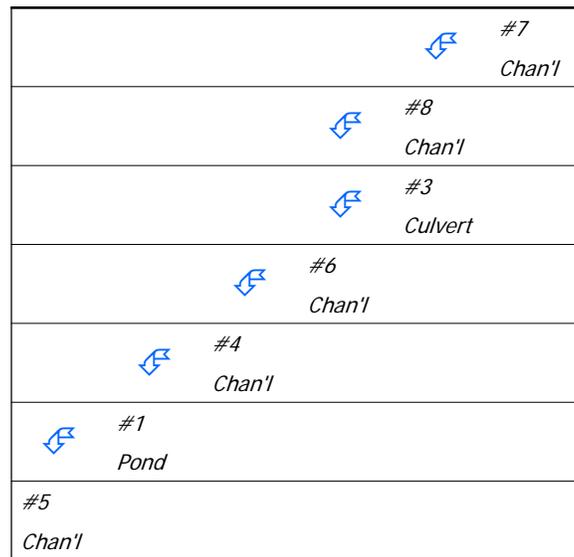

### Structure Routing Details:

Stru #	Land Flow Condition	Slope (%)	Vert. Dist. (ft)	Horiz. Dist. (ft)	Velocity (fps)	Time (hrs)
#3	5. Nearly bare and untilled, and alluvial valley fans	1.40	50.00	3,580.23	1.18	0.842
	8. Large gullies, diversions, and low flowing streams	2.62	25.00	954.52	4.85	0.054
<b>#3</b>	<b>Muskingum K:</b>					<b>0.896</b>

***Structure Summary:***

	Immediate Contributing Area (ac)	Total Contributing Area (ac)	Peak Discharge (cfs)	Total Runoff Volume (ac-ft)
#7	11.900	11.900	10.80	0.51
#8	0.100	12.000	10.82	0.51
#3	219.700	219.700	54.40	4.17
#6	26.600	258.300	47.56	5.79
#4	0.100	258.400	47.56	5.80
#1	In	259.800	47.60	5.87
	Out		36.20	5.84
#5	0.000	259.800	36.20	5.84

### Structure Detail:

Structure #7 (Erodible Channel)

*South Channel 1*

Trapezoidal Erodible Channel Inputs:

Material: Alluvial silts colloidal

Bottom Width (ft)	Left Sideslope Ratio	Right Sideslope Ratio	Slope (%)	Manning's n	Freeboard Depth (ft)	Freeboard % of Depth	Freeboard Mult. x (VxD)	Limiting Velocity (fps)
12.00	3.0:1	3.0:1	0.9	0.0250	1.00			5.0

Erodible Channel Results:

	w/o Freeboard	w/ Freeboard
Design Discharge:	10.80 cfs	
Depth:	0.33 ft	1.33 ft
Top Width:	13.96 ft	19.96 ft
Velocity:	2.55 fps	
X-Section Area:	4.23 sq ft	
Hydraulic Radius:	0.301 ft	
Froude Number:	0.82	

Structure #8 (Riprap Channel)

*South Rip Rap Channel 1*

Trapezoidal Riprap Channel Inputs:

Material: Riprap

Bottom Width (ft)	Left Sideslope Ratio	Right Sideslope Ratio	Slope (%)	Freeboard Depth (ft)	Freeboard % of Depth	Freeboard Mult. x (VxD)
12.00	3.0:1	3.0:1	10.4	1.00		

Riprap Channel Results:

Simons/OSM Method - Steep Slope Design

	w/o Freeboard	w/ Freeboard
Design Discharge:	10.82 cfs	
Depth:	0.11 ft	1.11 ft
Top Width:	12.65 ft	18.65 ft
Velocity*:		
X-Section Area:	1.34 sq ft	

	w/o Freeboard	w/ Freeboard
Hydraulic Radius:	0.106 ft	
Froude Number*:		
Manning's n*:		
Dmin:	2.00 in	
D50:	6.00 in	
Dmax:	7.50 in	

Velocity and Manning's n calculations may not apply for this method.

Structure #3 (Culvert)

CP-45

Culvert Inputs:

Length (ft)	Slope (%)	Manning's n	Max. Headwater (ft)	Tailwater (ft)	Entrance Loss Coef. (Ke)
80.00	0.05	0.0150	5.00	0.00	0.90

Culvert Results:

Design Discharge = 54.40 cfs

Minimum pipe diameter: 1 - 36 inch pipe(s) required

Structure #6 (Erodible Channel)

South Channel 2

Trapezoidal Erodible Channel Inputs:

Material: Alluvial silts colloidal

Bottom Width (ft)	Left Sideslope Ratio	Right Sideslope Ratio	Slope (%)	Manning's n	Freeboard Depth (ft)	Freeboard % of Depth	Freeboard Mult. x (VxD)	Limiting Velocity (fps)
12.00	3.0:1	3.0:1	0.9	0.0250	1.00			5.0

Erodible Channel Results:

	w/o Freeboard	w/ Freeboard
Design Discharge:	47.56 cfs	
Depth:	0.77 ft	1.77 ft
Top Width:	16.61 ft	22.61 ft
Velocity:	4.32 fps	
X-Section Area:	11.00 sq ft	
Hydraulic Radius:	0.652 ft	
Froude Number:	0.94	

Structure #4 (Riprap Channel)

*South Rip Rap Channel 2*

Trapezoidal Riprap Channel Inputs:

Material: Riprap

Bottom Width (ft)	Left Sideslope Ratio	Right Sideslope Ratio	Slope (%)	Freeboard Depth (ft)	Freeboard % of Depth	Freeboard Mult. x (VxD)
12.00	3.0:1	3.0:1	11.5	1.00		

Riprap Channel Results:

Simons/OSM Method - Steep Slope Design

	w/o Freeboard	w/ Freeboard
Design Discharge:	47.56 cfs	
Depth:	0.35 ft	1.35 ft
Top Width:	14.09 ft	20.09 ft
Velocity*:		
X-Section Area:	4.55 sq ft	
Hydraulic Radius:	0.320 ft	
Froude Number*:		
Manning's n*:		
Dmin:	2.00 in	
D50:	6.00 in	
Dmax:	7.50 in	

Velocity and Manning's n calculations may not apply for this method.

Structure #1 (Pond)

*Pond 311*

Pond Inputs:

Initial Pool Elev:	5,333.00 ft
Initial Pool:	8.28 ac-ft

Emergency Spillway

Spillway Elev	Crest Length (ft)	Left Sideslope	Right Sideslope	Bottom Width (ft)
5,333.00	25.00	3.00:1	3.00:1	12.00

Pond Results:

Peak Elevation:	5,334.09 ft
Dewater Time:	0.68 days

*Dewatering time is calculated from peak stage to lowest spillway*

Elevation-Capacity-Discharge Table

Elevation	Area (ac)	Capacity (ac-ft)	Discharge (cfs)	Dewater Time (hrs)
5,325.50	0.934	0.000	0.000	
5,326.00	0.954	0.472	0.000	
5,326.50	0.974	0.954	0.000	
5,326.92	0.991	1.367	0.000	
5,327.00	0.994	1.446	0.000	
5,327.50	1.015	1.948	0.000	
5,328.00	1.036	2.461	0.000	
5,328.50	1.058	2.985	0.000	
5,329.00	1.079	3.519	0.000	
5,329.50	1.102	4.064	0.000	
5,330.00	1.124	4.621	0.000	
5,330.50	1.147	5.188	0.000	
5,331.00	1.177	5.769	0.000	
5,331.50	1.207	6.365	0.000	
5,332.00	1.251	6.980	0.000	
5,332.50	1.296	7.616	0.000	
5,333.00	1.371	8.283	0.000	Spillway #1
5,333.50	1.377	8.970	0.771	10.78*
5,334.00	1.634	9.721	29.820	5.20
5,334.09	1.626	9.873	36.200	0.25 Peak Stage
5,334.50	1.801	10.580	65.875	
5,335.00	1.975	11.524	112.817	

\*Designates time(s) to dewater have been extrapolated beyond the 50 hour hydrograph limit.

Detailed Discharge Table

Elevation (ft)	Emergency Spillway (cfs)	Combined Total Discharge (cfs)
5,325.50	0.000	0.000
5,326.00	0.000	0.000
5,326.50	0.000	0.000
5,326.92	0.000	0.000
5,327.00	0.000	0.000
5,327.50	0.000	0.000
5,328.00	0.000	0.000
5,328.50	0.000	0.000
5,329.00	0.000	0.000
5,329.50	0.000	0.000
5,330.00	0.000	0.000

Elevation (ft)	Emergency Spillway (cfs)	Combined Total Discharge (cfs)
5,330.50	0.000	0.000
5,331.00	0.000	0.000
5,331.50	0.000	0.000
5,332.00	0.000	0.000
5,332.50	0.000	0.000
5,333.00	0.000	0.000
5,333.50	0.771	0.771
5,334.00	29.820	29.820
5,334.50	65.875	65.875
5,335.00	112.817	112.817

Structure #5 (Erodible Channel)

*Spillway Channel*

Trapezoidal Erodible Channel Inputs:

Material: Alluvial silts colloidal

Bottom Width (ft)	Left Sideslope Ratio	Right Sideslope Ratio	Slope (%)	Manning's n	Freeboard Depth (ft)	Freeboard % of Depth	Freeboard Mult. x (VxD)	Limiting Velocity (fps)
12.00	3.0:1	3.0:1	0.5	0.0250	1.00			5.0

Erodible Channel Results:

	w/o Freeboard	w/ Freeboard
Design Discharge:	36.20 cfs	
Depth:	0.77 ft	1.77 ft
Top Width:	16.64 ft	22.64 ft
Velocity:	3.27 fps	
X-Section Area:	11.06 sq ft	
Hydraulic Radius:	0.655 ft	
Froude Number:	0.71	

### Subwatershed Hydrology Detail:

Stru #	SWS #	SWS Area (ac)	Time of Conc (hrs)	Musk K (hrs)	Musk X	Curve Number	UHS	Peak Discharge (cfs)	Runoff Volume (ac-ft)
#7	1	11.900	0.179	0.000	0.000	89.000	M	10.80	0.506
	<b>Σ</b>	<b>11.900</b>						<b>10.80</b>	<b>0.506</b>
#8	1	0.100	0.009	0.000	0.000	89.000	M	0.15	0.004
	<b>Σ</b>	<b>12.000</b>						<b>10.82</b>	<b>0.511</b>
#3	1	219.700	0.444	0.444	0.324	80.000	M	60.07	4.169
	<b>Σ</b>	<b>219.700</b>						<b>54.40</b>	<b>4.169</b>
#6	1	26.600	5.410	0.000	0.000	89.000	M	2.43	1.112
	<b>Σ</b>	<b>258.300</b>						<b>47.56</b>	<b>5.792</b>
#4	1	0.100	0.010	0.000	0.000	89.000	M	0.15	0.004
	<b>Σ</b>	<b>258.400</b>						<b>47.56</b>	<b>5.797</b>
#1	1	1.400	0.001	0.000	0.000	89.000	M	2.12	0.073
	<b>Σ</b>	<b>259.800</b>						<b>47.60</b>	<b>5.870</b>
#5	<b>Σ</b>	<b>259.800</b>						<b>36.20</b>	<b>5.843</b>

### Subwatershed Time of Concentration Details:

Stru #	SWS #	Land Flow Condition	Slope (%)	Vert. Dist. (ft)	Horiz. Dist. (ft)	Velocity (fps)	Time (hrs)
#1	1	8. Large gullies, diversions, and low flowing streams	3.98	0.10	2.50	5.980	0.000
		5. Nearly bare and untilled, and alluvial valley fans	48.08	12.50	26.00	6.930	0.001
<b>#1</b>	<b>1</b>	<b>Time of Concentration:</b>					<b>0.001</b>
#3	1	5. Nearly bare and untilled, and alluvial valley fans	2.62	25.00	954.52	1.610	0.164
		8. Large gullies, diversions, and low flowing streams	1.40	50.00	3,580.37	3.540	0.280
<b>#3</b>	<b>1</b>	<b>Time of Concentration:</b>					<b>0.444</b>
#4	1	5. Nearly bare and untilled, and alluvial valley fans	5.56	5.00	90.00	2.350	0.010
<b>#4</b>	<b>1</b>	<b>Time of Concentration:</b>					<b>0.010</b>
#6	1	5. Nearly bare and untilled, and alluvial valley fans	0.14	10.00	7,183.90	0.370	5.393
		8. Large gullies, diversions, and low flowing streams	0.65	1.00	155.01	2.400	0.017
<b>#6</b>	<b>1</b>	<b>Time of Concentration:</b>					<b>5.410</b>
#7	1	5. Nearly bare and untilled, and alluvial valley fans	1.13	2.00	177.00	1.060	0.046

Stru #	SWS #	Land Flow Condition	Slope (%)	Vert. Dist. (ft)	Horiz. Dist. (ft)	Velocity (fps)	Time (hrs)
		8. Large gullies, diversions, and low flowing streams	0.93	13.00	1,393.65	2.890	0.133
<b>#7</b>	<b>1</b>	<b>Time of Concentration:</b>					<b>0.179</b>
#8	1	5. Nearly bare and untilled, and alluvial valley fans	6.60	6.00	90.95	2.560	0.009
<b>#8</b>	<b>1</b>	<b>Time of Concentration:</b>					<b>0.009</b>

***Subwatershed Muskingum Routing Details:***

Stru #	SWS #	Land Flow Condition	Slope (%)	Vert. Dist. (ft)	Horiz. Dist. (ft)	Velocity (fps)	Time (hrs)
#3	1	5. Nearly bare and untilled, and alluvial valley fans	2.62	25.00	954.52	1.610	0.164
		8. Large gullies, diversions, and low flowing streams	1.40	50.00	3,580.37	3.540	0.280
<b>#3</b>	<b>1</b>	<b>Muskingum K:</b>					<b>0.444</b>

## **Pond 311**

***The watershed for the impoundment is presented on Exhibit 11-13E. The detail design is presented on Exhibit 11-179.***

***The pond is designed to retain a 10 year 24 hour storm.***

***The spillway is designed for a 25 year 6 hour storm event.***

***The channel is designed to be stable during a 10 year 6 hour storm event.***

***The hydrology structure schematic for Pond 311 is attached.***

Ramsey R. Yazzie

BHP Billiton  
POBox 1717  
Fruitland, NM 87416


## ***General Information***

### ***Storm Information:***

Storm Type:	NM TYPE II 70
Design Storm:	10 yr - 6 hr
Rainfall Depth:	1.230 inches

### Structure Networking:

Type	Stru #	(flows into)	Stru #	Musk. K (hrs)	Musk. X	Description
Pond	#1	==>	#5	0.000	0.000	Pond 311
Culvert	#3	==>	#6	0.896	0.267	CP-45
Channel	#4	==>	#1	0.000	0.000	South Rip Rap Channel 2
Channel	#5	==>	End	0.000	0.000	Spillway Channel
Channel	#6	==>	#4	0.000	0.000	South Channel 2
Channel	#7	==>	#8	0.000	0.000	South Channel 1
Channel	#8	==>	#6	0.000	0.000	South Rip Rap Channel 1

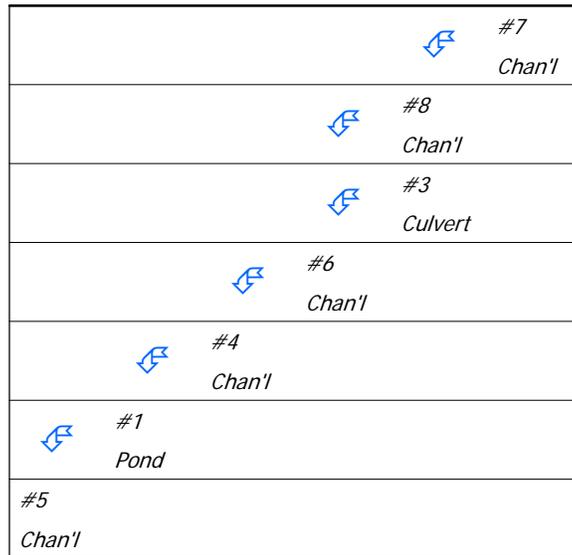

### Structure Routing Details:

Stru #	Land Flow Condition	Slope (%)	Vert. Dist. (ft)	Horiz. Dist. (ft)	Velocity (fps)	Time (hrs)
#3	5. Nearly bare and untilled, and alluvial valley fans	1.40	50.00	3,580.23	1.18	0.842
	8. Large gullies, diversions, and low flowing streams	2.62	25.00	954.52	4.85	0.054
<b>#3</b>	<b>Muskingum K:</b>					<b>0.896</b>

**Structure Summary:**

	Immediate Contributing Area (ac)	Total Contributing Area (ac)	Peak Discharge (cfs)	Total Runoff Volume (ac-ft)
#7	11.900	11.900	7.62	0.35
#8	0.100	12.000	7.64	0.35
#3	219.700	219.700	29.86	2.41
#6	26.600	258.300	26.63	3.53
#4	0.100	258.400	26.63	3.53
#1 In	1.400	259.800	26.66	3.58
Out			18.64	3.56
#5	0.000	259.800	18.64	3.56

### Structure Detail:

#### Structure #7 (Erodible Channel)

##### South Channel 1

Trapezoidal Erodible Channel Inputs:

Material: Alluvial silts colloidal

Bottom Width (ft)	Left Sideslope Ratio	Right Sideslope Ratio	Slope (%)	Manning's n	Freeboard Depth (ft)	Freeboard % of Depth	Freeboard Mult. x (VxD)	Limiting Velocity (fps)
12.00	3.0:1	3.0:1	0.9	0.0250	1.00			5.0

Erodible Channel Results:

	w/o Freeboard	w/ Freeboard
Design Discharge:	7.62 cfs	
Depth:	0.27 ft	1.27 ft
Top Width:	13.59 ft	19.59 ft
Velocity:	2.25 fps	
X-Section Area:	3.40 sq ft	
Hydraulic Radius:	0.248 ft	
Froude Number:	0.79	

#### Structure #8 (Riprap Channel)

##### South Rip Rap Channel 1

Trapezoidal Riprap Channel Inputs:

Material: Riprap

Bottom Width (ft)	Left Sideslope Ratio	Right Sideslope Ratio	Slope (%)	Freeboard Depth (ft)	Freeboard % of Depth	Freeboard Mult. x (VxD)
12.00	3.0:1	3.0:1	10.4	1.00		

Riprap Channel Results:

##### Simons/OSM Method - Steep Slope Design

	w/o Freeboard	w/ Freeboard
Design Discharge:	7.64 cfs	
Depth:	0.08 ft	1.08 ft
Top Width:	12.51 ft	18.51 ft
Velocity*:		
X-Section Area:	1.04 sq ft	

	w/o Freeboard	w/ Freeboard
Hydraulic Radius:	0.083 ft	
Froude Number*:		
Manning's n*:		
Dmin:	1.00 in	
D50:	3.00 in	
Dmax:	3.75 in	

Velocity and Manning's n calculations may not apply for this method.

Structure #3 (Culvert)

CP-45

Culvert Inputs:

Length (ft)	Slope (%)	Manning's n	Max. Headwater (ft)	Tailwater (ft)	Entrance Loss Coef. (Ke)
80.00	0.05	0.0150	5.00	0.00	0.90

Culvert Results:

Design Discharge = 29.86 cfs

Minimum pipe diameter: 1 - 30 inch pipe(s) required

Structure #6 (Erodible Channel)

South Channel 2

Trapezoidal Erodible Channel Inputs:

Material: Alluvial silts colloidal

Bottom Width (ft)	Left Sideslope Ratio	Right Sideslope Ratio	Slope (%)	Manning's n	Freeboard Depth (ft)	Freeboard % of Depth	Freeboard Mult. x (VxD)	Limiting Velocity (fps)
12.00	3.0:1	3.0:1	0.9	0.0250	1.00			5.0

Erodible Channel Results:

	w/o Freeboard	w/ Freeboard
Design Discharge:	26.63 cfs	
Depth:	0.55 ft	1.55 ft
Top Width:	15.30 ft	21.30 ft
Velocity:	3.55 fps	
X-Section Area:	7.51 sq ft	
Hydraulic Radius:	0.485 ft	
Froude Number:	0.89	

Structure #4 (Riprap Channel)

*South Rip Rap Channel 2*

Trapezoidal Riprap Channel Inputs:

Material: Riprap

Bottom Width (ft)	Left Sideslope Ratio	Right Sideslope Ratio	Slope (%)	Freeboard Depth (ft)	Freeboard % of Depth	Freeboard Mult. x (VxD)
12.00	3.0:1	3.0:1	11.5	1.00		

Riprap Channel Results:

Simons/OSM Method - Steep Slope Design

	w/o Freeboard	w/ Freeboard
Design Discharge:	26.63 cfs	
Depth:	0.22 ft	1.22 ft
Top Width:	13.30 ft	19.30 ft
Velocity*:		
X-Section Area:	2.73 sq ft	
Hydraulic Radius:	0.204 ft	
Froude Number*:		
Manning's n*:		
Dmin:	2.00 in	
D50:	6.00 in	
Dmax:	7.50 in	

Velocity and Manning's n calculations may not apply for this method.

Structure #1 (Pond)

*Pond 311*

Pond Inputs:

Initial Pool Elev:	5,333.00 ft
Initial Pool:	8.28 ac-ft

Emergency Spillway

Spillway Elev	Crest Length (ft)	Left Sideslope	Right Sideslope	Bottom Width (ft)
5,333.00	25.00	3.00:1	3.00:1	12.00

Pond Results:

Peak Elevation:	5,333.81 ft
Dewater Time:	0.65 days

*Dewatering time is calculated from peak stage to lowest spillway*

Elevation-Capacity-Discharge Table

Elevation	Area (ac)	Capacity (ac-ft)	Discharge (cfs)	Dewater Time (hrs)
5,325.50	0.934	0.000	0.000	
5,326.00	0.954	0.472	0.000	
5,326.50	0.974	0.954	0.000	
5,326.92	0.991	1.367	0.000	
5,327.00	0.994	1.446	0.000	
5,327.50	1.015	1.948	0.000	
5,328.00	1.036	2.461	0.000	
5,328.50	1.058	2.985	0.000	
5,329.00	1.079	3.519	0.000	
5,329.50	1.102	4.064	0.000	
5,330.00	1.124	4.621	0.000	
5,330.50	1.147	5.188	0.000	
5,331.00	1.177	5.769	0.000	
5,331.50	1.207	6.365	0.000	
5,332.00	1.251	6.980	0.000	
5,332.50	1.296	7.616	0.000	
5,333.00	1.371	8.283	0.000	Spillway #1
5,333.50	1.377	8.970	0.771	10.78*
5,333.81	1.584	9.432	18.637	4.85 Peak Stage
5,334.00	1.634	9.721	29.820	
5,334.50	1.801	10.580	65.875	
5,335.00	1.975	11.524	112.817	

\*Designates time(s) to dewater have been extrapolated beyond the 50 hour hydrograph limit.

Detailed Discharge Table

Elevation (ft)	Emergency Spillway (cfs)	Combined Total Discharge (cfs)
5,325.50	0.000	0.000
5,326.00	0.000	0.000
5,326.50	0.000	0.000
5,326.92	0.000	0.000
5,327.00	0.000	0.000
5,327.50	0.000	0.000
5,328.00	0.000	0.000
5,328.50	0.000	0.000
5,329.00	0.000	0.000
5,329.50	0.000	0.000
5,330.00	0.000	0.000

Elevation (ft)	Emergency Spillway (cfs)	Combined Total Discharge (cfs)
5,330.50	0.000	0.000
5,331.00	0.000	0.000
5,331.50	0.000	0.000
5,332.00	0.000	0.000
5,332.50	0.000	0.000
5,333.00	0.000	0.000
5,333.50	0.771	0.771
5,334.00	29.820	29.820
5,334.50	65.875	65.875
5,335.00	112.817	112.817

Structure #5 (Erodible Channel)

*Spillway Channel*

Trapezoidal Erodible Channel Inputs:

Material: Alluvial silts colloidal

Bottom Width (ft)	Left Sideslope Ratio	Right Sideslope Ratio	Slope (%)	Manning's n	Freeboard Depth (ft)	Freeboard % of Depth	Freeboard Mult. x (VxD)	Limiting Velocity (fps)
12.00	3.0:1	3.0:1	0.5	0.0250	1.00			5.0

Erodible Channel Results:

	w/o Freeboard	w/ Freeboard
Design Discharge:	18.64 cfs	
Depth:	0.53 ft	1.53 ft
Top Width:	15.16 ft	21.16 ft
Velocity:	2.61 fps	
X-Section Area:	7.14 sq ft	
Hydraulic Radius:	0.466 ft	
Froude Number:	0.67	

### Subwatershed Hydrology Detail:

Stru #	SWS #	SWS Area (ac)	Time of Conc (hrs)	Musk K (hrs)	Musk X	Curve Number	UHS	Peak Discharge (cfs)	Runoff Volume (ac-ft)
#7	1	11.900	0.179	0.000	0.000	89.000	M	7.62	0.350
	<b>Σ</b>	<b>11.900</b>						<b>7.62</b>	<b>0.350</b>
#8	1	0.100	0.009	0.000	0.000	89.000	M	0.11	0.003
	<b>Σ</b>	<b>12.000</b>						<b>7.64</b>	<b>0.353</b>
#3	1	219.700	0.444	0.444	0.324	80.000	M	33.14	2.407
	<b>Σ</b>	<b>219.700</b>						<b>29.86</b>	<b>2.407</b>
#6	1	26.600	5.410	0.000	0.000	89.000	M	1.67	0.768
	<b>Σ</b>	<b>258.300</b>						<b>26.63</b>	<b>3.528</b>
#4	1	0.100	0.010	0.000	0.000	89.000	M	0.11	0.003
	<b>Σ</b>	<b>258.400</b>						<b>26.63</b>	<b>3.531</b>
#1	1	1.400	0.001	0.000	0.000	89.000	M	1.55	0.051
	<b>Σ</b>	<b>259.800</b>						<b>26.66</b>	<b>3.581</b>
#5	<b>Σ</b>	<b>259.800</b>						<b>18.64</b>	<b>3.558</b>



### Subwatershed Time of Concentration Details:

Stru #	SWS #	Land Flow Condition	Slope (%)	Vert. Dist. (ft)	Horiz. Dist. (ft)	Velocity (fps)	Time (hrs)
#1	1	8. Large gullies, diversions, and low flowing streams	3.98	0.10	2.50	5.980	0.000
		5. Nearly bare and untilled, and alluvial valley fans	48.08	12.50	26.00	6.930	0.001
<b>#1</b>	<b>1</b>	<b>Time of Concentration:</b>					<b>0.001</b>
#3	1	5. Nearly bare and untilled, and alluvial valley fans	2.62	25.00	954.52	1.610	0.164
		8. Large gullies, diversions, and low flowing streams	1.40	50.00	3,580.37	3.540	0.280
<b>#3</b>	<b>1</b>	<b>Time of Concentration:</b>					<b>0.444</b>
#4	1	5. Nearly bare and untilled, and alluvial valley fans	5.56	5.00	90.00	2.350	0.010
<b>#4</b>	<b>1</b>	<b>Time of Concentration:</b>					<b>0.010</b>
#6	1	5. Nearly bare and untilled, and alluvial valley fans	0.14	10.00	7,183.90	0.370	5.393
		8. Large gullies, diversions, and low flowing streams	0.65	1.00	155.01	2.400	0.017
<b>#6</b>	<b>1</b>	<b>Time of Concentration:</b>					<b>5.410</b>
#7	1	5. Nearly bare and untilled, and alluvial valley fans	1.13	2.00	177.00	1.060	0.046

Stru #	SWS #	Land Flow Condition	Slope (%)	Vert. Dist. (ft)	Horiz. Dist. (ft)	Velocity (fps)	Time (hrs)
		8. Large gullies, diversions, and low flowing streams	0.93	13.00	1,393.65	2.890	0.133
<b>#7</b>	<b>1</b>	<b>Time of Concentration:</b>					<b>0.179</b>
#8	1	5. Nearly bare and untilled, and alluvial valley fans	6.60	6.00	90.95	2.560	0.009
<b>#8</b>	<b>1</b>	<b>Time of Concentration:</b>					<b>0.009</b>


***Subwatershed Muskingum Routing Details:***

Stru #	SWS #	Land Flow Condition	Slope (%)	Vert. Dist. (ft)	Horiz. Dist. (ft)	Velocity (fps)	Time (hrs)
#3	1	5. Nearly bare and untilled, and alluvial valley fans	2.62	25.00	954.52	1.610	0.164
		8. Large gullies, diversions, and low flowing streams	1.40	50.00	3,580.37	3.540	0.280
<b>#3</b>	<b>1</b>	<b>Muskingum K:</b>					<b>0.444</b>

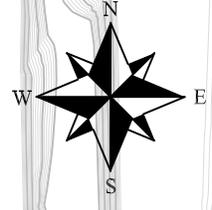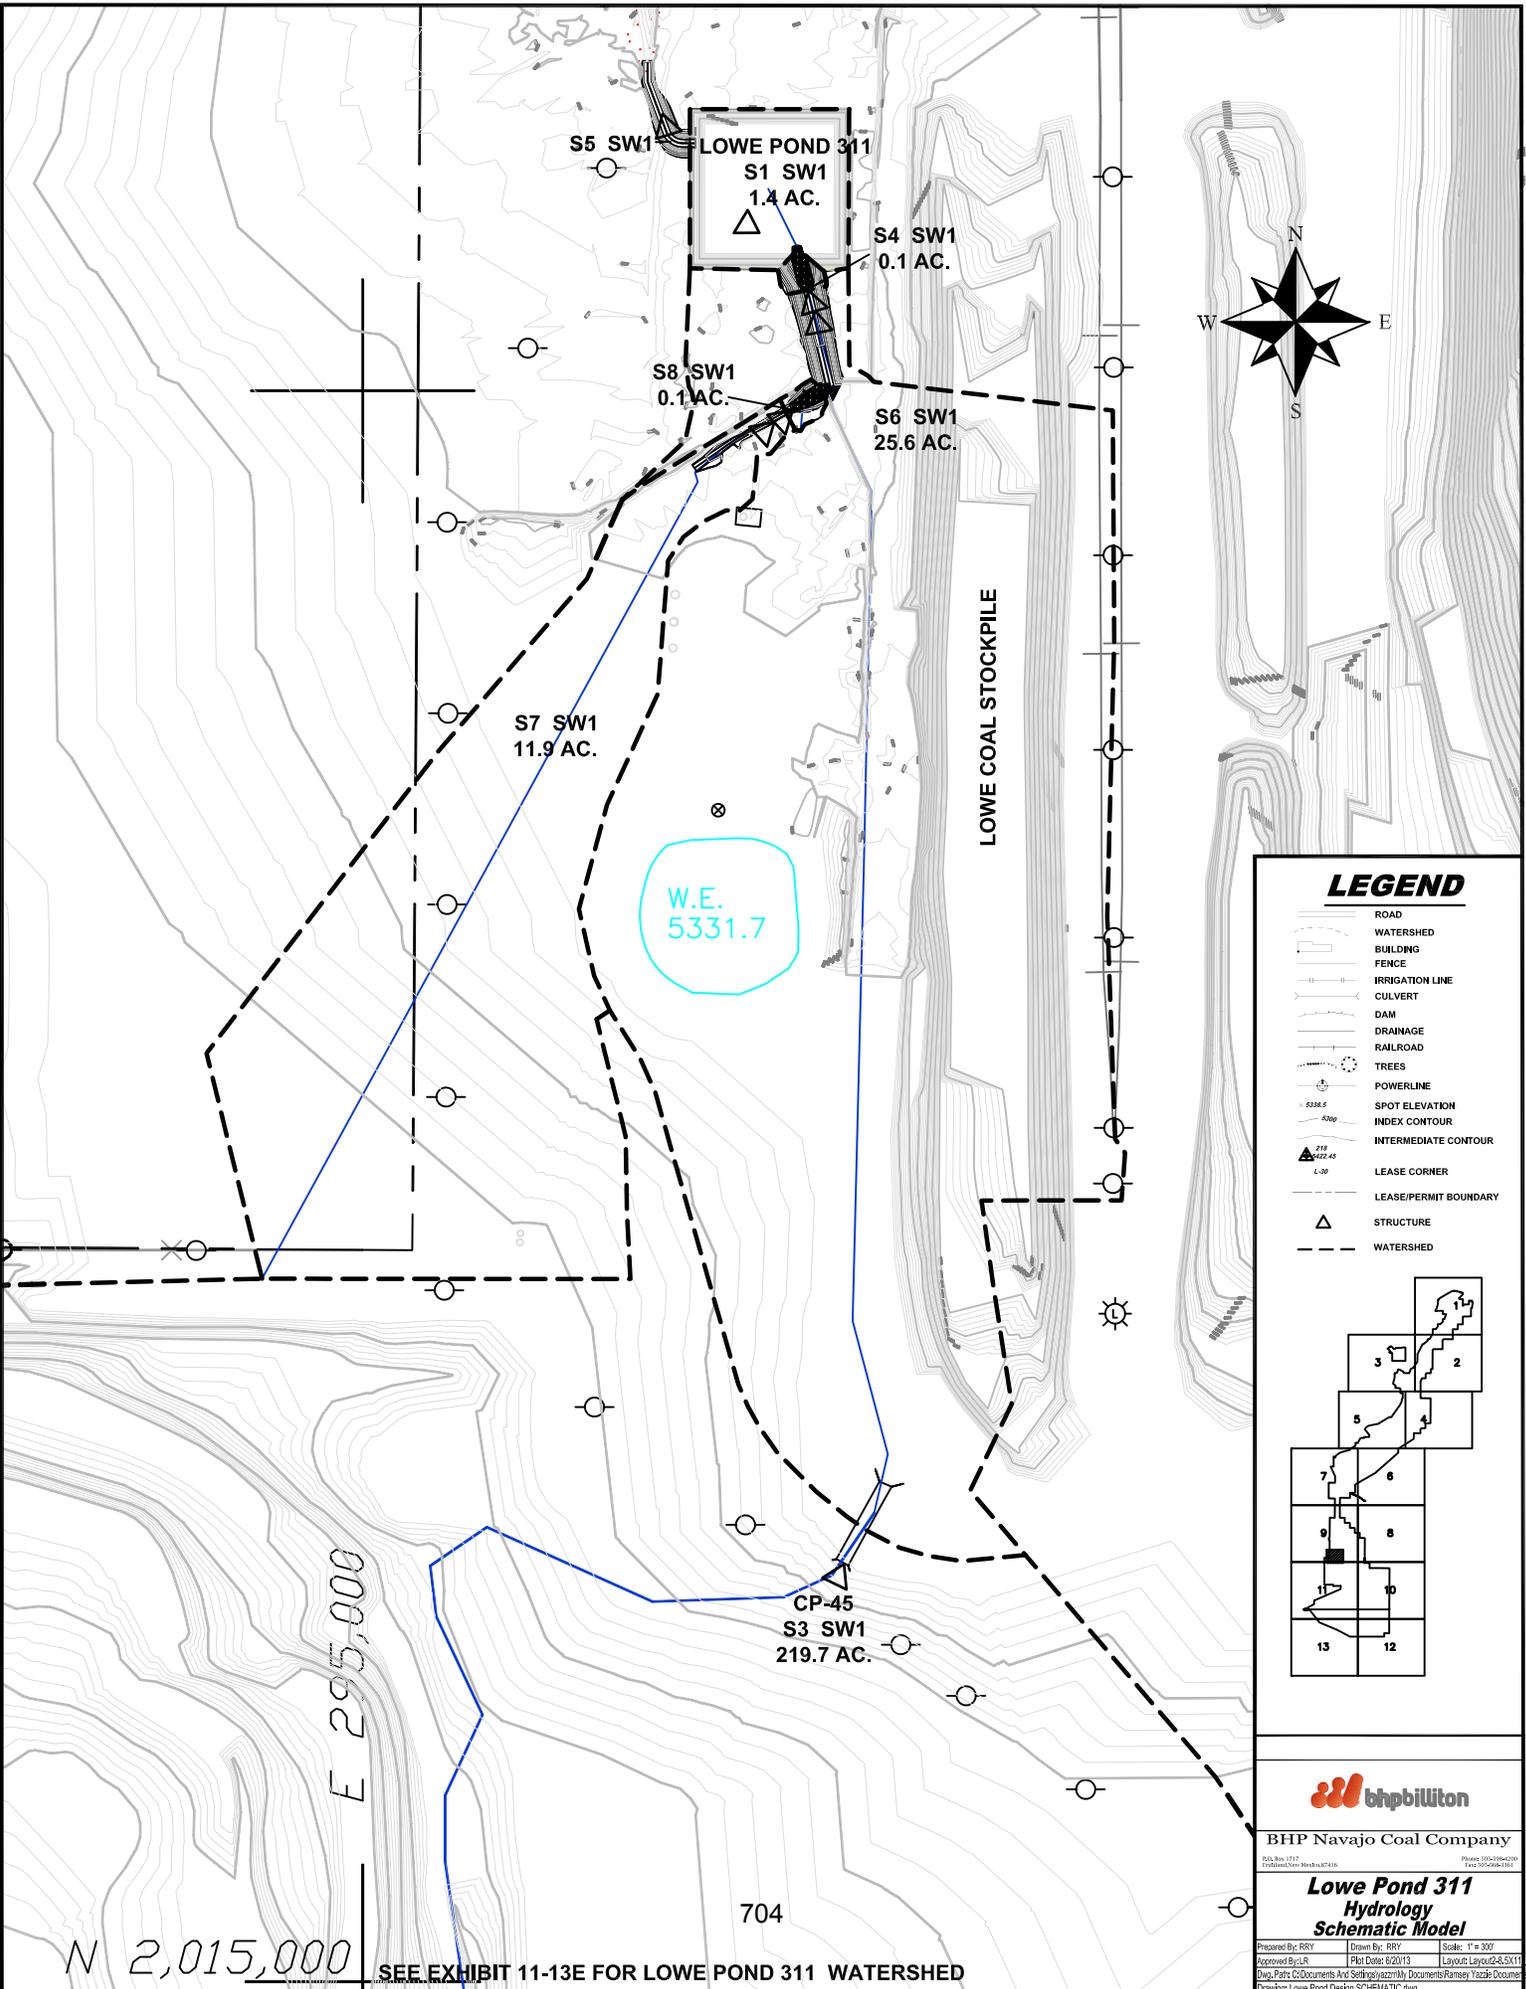

**LEGEND**

- ROAD
- WATERSHED
- BUILDING
- FENCE
- IRRIGATION LINE
- CULVERT
- DAM
- DRAINAGE
- RAILROAD
- TREES
- POWERLINE
- SPOT ELEVATION
- INDEX CONTOUR
- INTERMEDIATE CONTOUR
- LEASE CORNER
- LEASE/PERMIT BOUNDARY
- STRUCTURE
- WATERSHED

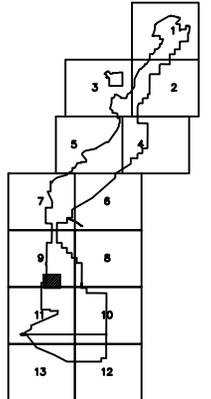

BHP Navajo Coal Company  
 200 West 17th  
 Flagstaff, AZ 86001  
 Phone: 908-526-4200  
 Fax: 908-526-2911

**Lowe Pond 311  
 Hydrology  
 Schematic Model**

Prepared By: RRY Drawn By: RRY Scale: 1" = 300'  
 Approved By: CLR Plot Date: 6/20/13 Layout: Layout2-35X11  
 C:\p\p\p\c\Documents And Settings\jazz\My Documents\Ramsay\Tzade\Documents\Projects\Comer\Lowe Pond Design\SCHEMATIC.dwg

SEE EXHIBIT 11-13E FOR LOWE POND 311 WATERSHED

## **Appendix 26.D**

Highwall Impoundment Design and As-Built Information

APPENDIX 26.D  
TABLE OF CONTENTS

---

Discussion and Design Criteria	1
SEDCAD Runs for Existing Impoundments Using Actual Conditions	9
SEDCAD Runs for Existing Impoundments Using the Criteria for Standard Design	40
Highwall Impoundments SEDCAD Runs for Existing Spillways	71
SEDCAD Runs for Standard Spillway Sizes	217
Highwall Impoundments SEDCAD Runs for As-built Spillways	254

*Drawings:*

Highwall Impoundments “As Built”

Highwall Impoundments Standard Design

# STANDARD DESIGN FOR HIGHWALL IMPOUNDMENTS

## Objective

The objective is to develop a standard design that would allow the mine to construct highwall impoundments without site specific designs, using an approved standard design. The standard design would be incorporated into the mine's approved PAP. It would address only the impoundments with spillways and would comply with the applicable parts of CFR 30 Part 816.46.

The impoundments without a spillway or those relying on storage capacity to totally retain the runoff from the design storm event would not be included in the standard design. Site specific designs for these would be developed and submitted for approval prior to construction.

## General Description

At Navajo Mine the mining pits are advancing in the upstream direction towards the east. The highwall impoundments are located upstream of the immediate mining area (IMA) on the highwall side of the pit. The primary function of these impoundments is to control or minimize the inflow of the surface runoff into the IMA. The intent is to retain all or a portion of the smaller intensity but more frequently occurring precipitation events, thereby enhancing the safety of the work areas in the IMA (i.e., topsoil removal, truck/shovel, blasting, and mining operations).

These impoundments although not intended to protect the environment will retain some sediment. In the event of a discharge, the water released along with any sediment generated will be retained in the pit downstream. The discharges from these impoundments have no chance of leaving the permit area. Discharge through the spillways would be very infrequent, since the annual rainfall for the area is 6 to 7 inches which generates infrequent surface runoff. The impoundment would be dry and empty a majority of the time.

The capacity of future highwall impoundments will be less than 10 acre-feet. The existing highwall impoundments are all less than 10 ac-ft, except for Sunflower #1 which has a capacity of 12.23 ac-ft. A watershed map and the stage storage tables for the existing impoundments are attached. These are small impoundments that will not constitute a hazard to the general public, mine employees, mine equipment and public transportation/utilities. The potential for loss of life and property damage is very low. They will all be classified as low hazard potential dams.

## Design Approach and Application

The primary step in the design approach would be to establish a design criteria that would not be too overly conservative, yet simplify and reduce the number of analysis required. This was done by evaluating watersheds of existing impoundments and using the data to establish the design criteria. To demonstrate that the design criteria and assumptions made will give conservative results, the results of the hydrological analysis using actual conditions were compared to those using the established design criteria. The design criteria established for the standard design gave conservative results in almost all cases except for one. For more details on the comparison see discussion under Comparison of Actual vs Criteria for Standard Design.

Two drawings have been developed, one for the as-builts (Highwall Impoundments As-builts) and the other for the standard design (Highwall Impoundments Standard Design). The Highwall Impoundments As-builts drawing shows the as-built dimensions of all the existing highwall impoundments. This drawing will be updated as additional highwall impoundments are constructed. The updates will be submitted to OSM for review.

The Highwall Impoundments Standard Design drawing will be used to construct future highwall impoundments needed to meet operational needs. This exhibit was developed using the design criteria outlined below. The Highwall Impoundments Standard Design drawing shows a typical section for the spillway and embankment, and also a spillway schedule.

The spillway schedule shows the watershed sizes, the associated CN's, peak discharges and the required spillway size. After determining the watershed size and the CN the spillway schedule will be used to determine the spillway size required.

### Design Criteria

The design criteria will address only impoundments with spillways. Site specific designs will be developed for impoundments without spillways and submitted to OSM for approval. To simplify and also narrow down the number of analysis required, conservative design parameters applicable to a range of conditions will be used. Listed below are the design criteria that would be used.

- The curve number (CN) will be selected based on the percentage of badlands (Ba) within the watershed. Refer to the discussion below on curve numbers. The criteria below will be used to select the curve number.
  - If Badlands  $\geq 80\%$ , CN = 93
  - If Badlands  $\geq 50\% < 80\%$ , CN = 90
  - If badlands  $> 0\% < 50\%$ , CN = 86
  - If Badlands = 0%, CN = 83
- The criteria below will be used to determine the parameters needed to calculate the time of concentration ( $t_c$ ). Refer to discussion below on the time of concentration.
  - ◇ The drainage length will be equal to 1.5 times the side distance of an equivalent square watershed area.
  - ◇ The slope of the drainage length will be equal to 4 percent.
  - ◇ The land use type/condition will be "nearly bare and untilled (overland flow) and alluvial valley fans".
- The spillway will safety pass the peak discharge from the 25 year - 6 hour precipitation event.
- The effect of routing the storm through the impoundment will not be considered for sizing the spillway (conservative).
- The spillway will have a one foot freeboard when flowing.
- The spillway will not have a protective lining for erosion. Refer to discussion below on spillway.
- Impoundment capacity will be less than 10 ac-ft.

## Curve Number

The approach outlined below to arrive at a curve number for the undisturbed lands upstream of the IMA is only for the purpose of developing a standard design for highwall impoundments. The approach is based on the assumption that the soils upstream of the IMA have similar properties and distribution as the soils that would be salvaged for topdressing. The soils upstream of the IMA and within the permit area if deemed suitable will be salvaged for topdressing. The suitable topdressing material upstream of the highwall impoundments have not yet been removed, but have been analyzed and are included in the topsoil balance calculations. A weighted curve number will be calculated by using the percentage of Badlands making-up the watershed. The percent of the watershed that is other than Badlands will be assigned a curve number of 80 which is the curve number calculated for the reclaimed lands. The portion that is Badlands will be assigned a curve number of 93.

The curve number selected will be based on the percentage of badlands within the watershed. To simplify and yet be conservative the criteria below will be used for selecting the curve number.

If Badlands $\geq$ 80%,	CN = 93
If Badlands $\geq$ 50% < 80%,	CN = 90
If Badlands >0% < 50%,	CN = 86
If Badlands = 0%,	CN = 83

## Time of Concentration

The time of concentration ( $t_c$ ) is a function of the land use type/condition, the configuration of the watershed, and the slope and length of the drainage length. The discharge rate from a watershed is dependent on the magnitude of the  $t_c$  value, smaller values give higher discharge rates. Watersheds with short drainage lengths or steep slopes have smaller  $t_c$  values. A square watershed will have the shortest drainage length, however actual watershed configurations are more elongated. To establish a simplified but conservative method for calculating the  $t_c$ , the watersheds for the existing highwall impoundments were evaluated. The watershed map of the existing impoundments is attached. The configuration of the watersheds were compared to an equivalent square watershed. The side distance of an equivalent square area was determined for each watershed. Then a ratio between the drainage length and the side distance of the square was determined. The slopes of the drainage lengths were also determined. See TABLE A below for the values determined. The ratio of the drainage length to the side distance of an equivalent square area ranged from 1.2 to 3.8 with an average of 2.1. The slope of the drainage length ranged from 0.8 to 6.4 percent with an average of 3.3 percent. Using the data from TABLE A the criteria below was established to determine the parameters that will be used to calculate the  $t_c$ .

- The ratio of the drainage length to the side distance of an equivalent square area will be equal to 1.5 or the drainage length will be equal to 1.5 times the side distance of an equivalent square area. This ratio is less than the average value and is less than all values in the table except for one. It will in most cases give conservative  $t_c$  values.

- The slope of the drainage length will be equal to 4 percent. This slope is steeper than the average slope and is less than four of the slope values in the table. This coupled with a short or conservative drainage length, will in almost all cases give conservative  $t_c$  values.
- The land use type/condition will be “nearly bare and untilled (overland flow) and alluvial valley fans”.

The procedure outlined above for determining the  $t_c$  is only for the purpose of developing a standard design for highwall impoundments.

TABLE A

Impoundment Id.	Watershed Area (acres)	Delta Elev. (ft)	Drainage Length (DL) (ft)	Side Dist. of Square (SS) (ft)	Ratio DL:SS	Slope of Drainage Length (%)
Yazzie Stockpond #1	125.5	210	5200	2338	2.2	4.0
Yazzie Stockpond #2	174.1	200	5652	2754	2.1	3.5
So. Hosten Stockpond #1	80.1	155	3750	1868	2.0	4.1
So. Hosten Stockpond #2	37.7	70	2250	1282	1.8	3.1
So. Hosten Stockpond #3	157.3	249	4300	2618	1.6	5.8
Stub 16 Impoundment #2	20.2	103	2150	938	2.3	4.8
Stub 16 Impoundment #3	10.6	87	1350	680	2.0	6.4
Stub 18 Impoundment	103.4	135	3850	2122	1.8	3.5
Sunflower #1	24.6	17	1250	1035	1.2	1.4
Area 3 Temp. Div. Imp. #2	69.9	31	4100	1745	2.3	0.8
Area 3 Temp. Div. Imp. #3	20.8	35	1600	952	1.7	2.2
Area 3 Temp. Div. Imp. #5	11.6	46	2700	711	3.8	1.7
Area 3 Temp. Div. Imp. #7	55.5	59	3600	1555	2.3	1.6
Average					2.1	3.3

### Comparison of Actual vs Criteria for Standard Design

To demonstrate that the design criteria established for the highwall impoundments will give conservative results in almost all cases, the values for  $t_c$ , CN, and Q were determined for the actual conditions and compared to the values determined by applying the design criteria established. The watersheds for the existing highwall impoundments were used to make this demonstration. The Sedcad+ computer software was utilized to determine the values. The Sedcad+ computer runs for the hydrological analysis for both cases are attached. The CN derived by applying the design criteria established is in-line with the actual CN values. See TABLE C for derivation of the actual CN values. The  $t_c$  and Q values derived from the design criteria are in most cases conservative, except for South Hosten Stockpond #3. See TABLE B for comparison of the derived values. The peak discharge (Q') for South Hosten Stockpond #3 derived by applying the design criteria established is less than the actual discharge. The difference is 5.7 cfs or 4.0 percent of actual discharge. This difference is insignificant since other conservative assumptions are made for the design of the spillway. Spillway will be designed to pass the peak discharge with a one foot freeboard without considering the effect of routing through the impoundment. The peak stage in the impoundment will never rise above the one foot freeboard for the design storm event (25 year - 6 hour).

## Spillway Design

The maximum discharge rate with one foot freeboard were determined for the standard spillway sizes shown on TABLE D. The Sedcad+ basin discharge utility was used to determine the maximum discharge rates. The Sedcad+ computer runs for the spillways are attached. TABLE D summarizes the maximum discharge rate for the standard spillway sizes. For watershed sizes ranging from 25 to 700 acres, TABLE D was used to select a spillway size that will pass the peak discharge from a 25 year - 6 hour storm event. Attached are the Sedcad+ computer runs or the hydrological analysis for determining the peak discharges for watershed sizes 25 to 700 acres. The design criteria established above was applied in the analysis. The Spillway Schedule on the Highwall Impoundments Standard Design drawing shows the spillway sizes that will pass the peak discharge (25 yr. - 6 hr) from selected watershed sizes ranging from 25 to 700 acres. The CN's associated with each watershed size are also shown. After determining the watershed size and the CN associated with the watershed, the Spillway Schedule on the Highwall Impoundments Standard Design drawing can be used to determine the spillway size required.

Discharge through the spillways are very infrequent since the annual rainfall for the area is only 6 to 7 inches. The existing spillways have no protective lining for erosion. Very minimal amount of erosion have occurred in the spillways during these overflows. The water discharged through the spillway and any sediment generated have been retained in the pits downstream. Adverse environmental impact to streamflow outside the permit area due to either discharge of pollutants or excessive sediment is not possible since the pit will intercept and retain the flow before it leaves the permit area. The spillways of the existing and future highwall impoundments will not be lined for erosion protection, since only minimal amount of erosion is anticipated and the potential of any water or sediment leaving the permit area is very unlikely. The spillway will be inspected, any damages identified will be repaired promptly.

The capacity of future highwall impoundments will be less than 10 ac-ft and classified as a low hazard potential dam. These impoundments are small, in the event of a failure they will not be an imminent danger to employees and equipment working in the pits. The potential for loss of life and property damage is very low.

## As-builts

The dimensions of the existing highwall impoundments are shown on the Highwall Impoundments As-builts drawing. The spillways for the existing impoundments were checked to insure that they would pass the design storm event. The Sedcad+ computer runs are attached. The Highwall Impoundments As-builts drawing will be updated as additional impoundments are constructed. Updates will be submitted to OSM for review.

## Inspection and Maintenance

The regular quarterly and annual inspections will be done for the highwall impoundments. Any maintenance items identified during these inspections will be corrected or repaired promptly.

## TABLE B

### HIGHWALL IMPOUNDMENTS COMPARISON OF HYDROLOGICAL ANALYSIS ACTUAL VS CRITERIA FOR STANDARD DESIGN

Impoundment Id:	Curve Number		Time of Concentration		Peak Discharge (25 yr - 6 hr)	
	CN <sup>(2)</sup>	CN' <sup>(1)</sup>	t <sub>c</sub>	t <sub>c</sub> ' <sup>(1)</sup>	Q	Q' <sup>(1)</sup>
Yazzie Stockpond #1	93.0	93.0	0.718	0.487	92.8	118.1
Yazzie Stockpond #2	91.9	93.0	0.834	0.573	106.6	148.9
South Hosteen Stockpond #1	92.4	93.0	0.512	0.389	70.0	84.7
South Hosteen Stockpond #2	92.7	93.0	0.354	0.266	85.6	98.4
South Hosteen Stockpond #3	92.8	93.0	0.496	0.545	144.3	138.6
Stub 16 Impoundment #2	93.0	93.0	0.272	0.195	24.9	27.8
Stub 16 Impoundment #3	93.0	93.0	0.147	0.141	15.5	15.5
Stub 18 Impoundment	82.0	83.0	0.571	0.442	34.9	45.2
Sunflower #1	82.0	83.0	0.297	0.215	12.3	15.6
Area 3 Temp. Div. Imp. #2	81.6/89.0	83.0	1.251	0.363	15.6	34.3
Area 3 Temp. Div. Imp. #3	82.0/89.0	83.0	0.257	0.198	17.6	32.1
Area 3 Temp. Div. Imp. #5	89.0	90.0	0.556	0.133	18.9	29.6
Area 3 Temp. Div. Imp. #7	86.4/89.0	86.0	0.781	0.322	29.8	37.4

- (1) CN', t<sub>c</sub>, and Q' were determined by applying the design criteria established for the standard design for highwall impoundment.
- (2) Two curve numbers are indicated when a subwatershed having a different CN was routed via a channel.

**TABLE C**

**CURVE NUMBERS  
FOR WATERSHEDS OF EXISTING IMPOUNDMENTS**

Impoundment Id	Watershed (ac)	Soil					Watershed CN
		Mapping Unit	Area (ac)	Hydrologic Group	CN	% of Watershed	
Yazzie Stockpond #1	125.5	Ba	125.5	D	93.0	100.0	93.0
Yazzie Stockpond #2	174.1	Ba	156.8	D	93.0	90.1	91.9
		Az	17.3	B	82.0	9.9	
South Hosteen Stockpond #1	80.1	Ba	75.2	D	93.0	93.8	92.4
		Fx	4.9	B	84.0	6.1	
South Hosteen Stockpond #2	37.7	Ba	36.7	D	93.0	97.3	92.7
		Az	1.0	B	82.0	2.7	
South Hosteen Stockpond #3	157.3	Ba	150.4	D	93.0	95.6	92.8
		Fx	3.5	B	84.0	2.2	
		Fa	3.4	D	93.0	2.2	
Stub 16 Impoundment #2	20.2	Ba	20.2	D	93.0	100.0	93.0
Stub 16 Impoundment #3	10.6	Ba	10.6	D	93.0	100.0	93.0
Stub 18 Impoundment	103.4	Da	103.4	B	82.0	100.0	82.0
Sunflower #1	24.6	Db	8.2	B	82.0	33.3	82.0
		Du	16.4	B	82.0	66.7	
Area 3 Temp. Div. Imp. #2	69.9	Db	14.4	B	82.0	20.5	81.6
		Du	36.2	B	82.0	51.8	
		Dw	12.4	B	80.0	17.7	
		Du	7.0	B (disturbed)	89.0	10.0	
Area 3 Temp. Div. Imp. #3	20.8	Du	9.7	B	82.0	46.6	82.0
		Du	11.1	B (disturbed)	89.0	53.4	89.0
Area 3 Temp. Div. Imp. #5	11.6	Bb	6.0	D (disturbed)	89.0	51.7	89.0
		Du	5.6	B (disturbed)	89.0	48.3	
Area 3 Temp. Div. Imp. #7	55.5	Bb	20.8	D	93.0	37.5	86.4
		Du	31.5	B	82.0	56.8	
		Du	3.2	B (disturbed)	89.0	5.8	

**TABLE D**

**HIGHWALL IMPOUNDMENT  
STANDARD SPILLWAY SIZES**

Depth <sup>(1)</sup> (ft)	Width <sup>(2)</sup> (ft)	Discharge <sup>(3)</sup> (cfs)	Depth <sup>(1)</sup> (ft)	Width <sup>(2)</sup> (ft)	Discharge <sup>(3)</sup> (cfs)
2.00	10.0	25.5	3.25	10.0	119.0
	15.0	36.4		15.0	160.9
	20.0	47.3		20.0	202.9
	25.0	58.3		25.0	245.0
				30.0	287.2
2.25	10.0	36.7	3.50	10.0	153.3
	15.0	51.9		15.0	204.9
	20.0	67.1		20.0	256.8
25.0	82.3	25.0		308.7	
2.50	10.0	56.9	3.75	10.0	179.3
	15.0	79.3		15.0	237.9
	20.0	101.8		20.0	296.7
	25.0	124.2	25.0	355.7	
2.75	10.0	72.2	3.00	30.0	414.7
	15.0	99.7			
	20.0	127.3			
	25.0	154.9			
3.00	10.0	98.5			
	15.0	134.3			
	20.0	170.2			
	25.0	206.2			
	30.0	242.2			

- (1) From top of embankment to bottom of spillway with 3:1 side slopes.
- (2) With a crest length of 25 feet.
- (3) Maximum discharge with a one foot freeboard.

**HIGHWALL IMPOUNDMENTS**

**SEDCAD+ COMPUTER RUNS**

**EXISTING IMPOUNDMENTS  
USING ACTUAL CONDITIONS**

CIVIL SOFTWARE DESIGN

SEDCAD+ Version 3

YAZZIE STOCKPOND #1

by

Name: LR

Company Name: BHP MINERALS  
File Name: C:\LR\HW\_IMP\HYD\YSPD1

Date: 03-13-1997

Company Name: BHP MINERALS  
 Filename: C:\LR\HW\_IMP\HYD\YSPD1 User: LR  
 Date: 03-13-1997 Time: 12:16:38  
 YAZZIE STOCKPOND #1  
 Storm: 1.60 inches, 25 year- 6 hour, Type II-65  
 Hydrograph Convolution Interval: 0.1 hr

=====  
 SUBWATERSHED/STRUCTURE INPUT/OUTPUT TABLE  
 =====

-Hydrology-

JBS SWS	Area (ac)	CN	UHS	Tc (hrs)	K (hrs)	X	Base- Flow (cfs)	Runoff Volume (ac-ft)	Peak Discharge (cfs)	
111 1	125.50	93	M	0.718	0.000	0.000	0.0	9.98	92.78	
		Type: Null		Label: POND						
111 Structure	125.50								9.98	
111 Total IN/OUT	125.50								9.98	92.78

Company Name: BHP MINERALS  
 Filename: C:\LR\HW\_IMP\HYD\YSPD1 User: LR  
 Date: 03-13-1997 Time: 12:16:38  
 YAZZIE STOCKPOND #1

Storm: 1.60 inches, 25 year- 6 hour, Type II-65  
 Hydrograph Convolution Interval: 0.1 hr

=====  
 DETAILED SUBWATERSHED INPUT/OUTPUT TABLE  
 =====

J	B	S	SWS	Seg. #	Land Flow Condition	Distance (ft)	Slope (%)	Velocity (fps)	Segment Time (hr)	Time Conc. (hr)	Muskingum K (hr)	X
1	1	1	1	-a	5	5200.00	4.04	2.01	0.72	0.718		

CIVIL SOFTWARE DESIGN

SEDCAD+ Version 3

YAZZIE STOCKPOND #2

by

Name: LR

Company Name: BHP MINERALS  
File Name: C:\LR\HW\_IMP\HYD\YSPD2

Date: 03-13-1997

Company Name: BHP MINERALS  
 Filename: C:\LR\HW\_IMP\HYD\YSPD2 User: LR  
 Date: 03-13-1997 Time: 12:22:14  
 YAZZIE STOCKPOND #2  
 Storm: 1.60 inches, 25 year- 6 hour, Type II-65  
 Hydrograph Convolution Interval: 0.1 hr

=====  
 SUBWATERSHED/STRUCTURE INPUT/OUTPUT TABLE  
 =====

-Hydrology-

JBS SWS	Area (ac)	CN UHS	Tc (hrs)	K (hrs)	X	Base- Flow (cfs)	Runoff Volume (ac-ft)	Peak Discharge (cfs)
111 1	174.10	92 M	0.834	0.000	0.000	0.0	12.76	106.64
		Type: Null		Label: POND				
111 Structure	174.10						12.76	
111 Total IN/OUT	174.10						12.76	106.64

Company Name: BHP MINERALS  
 Filename: C:\LR\HW\_IMP\HYD\YSPD2 User: LR  
 Date: 03-13-1997 Time: 12:22:14  
 YAZZIE STOCKPOND #2  
 Storm: 1.60 inches, 25 year- 6 hour, Type II-65  
 Hydrograph Convolution Interval: 0.1 hr

=====  
 DETAILED SUBWATERSHED INPUT/OUTPUT TABLE  
 =====

J	B	S	SWS	Seg. #	Land Flow Condition	Distance (ft)	Slope (%)	Velocity (fps)	Segment Time (hr)	Time Conc. (hr)	Muskingum K (hr)	X
1	1	1	1	-a	5	5650.00	3.54	1.88	0.83	0.834		

CIVIL SOFTWARE DESIGN

SEDCAD+ Version 3

SOUTH HOSTEEN STOCKPOND #1 AND 2

by

Name: LR

Company Name: BHP MINERALS  
File Name: C:\LR\HW\_IMP\HYD\SHSPD1

Date: 03-13-1997

Company Name: BHP MINERALS  
 Filename: C:\LR\HW\_IMP\HYD\SHSPD1 User: LR  
 Date: 03-13-1997 Time: 12:43:11  
 SOUTH HOSTEEN STOCKPOND #1 AND 2  
 Storm: 1.60 inches, 25 year- 6 hour, Type II-65  
 Hydrograph Convolution Interval: 0.1 hr

=====  
 SUBWATERSHED/STRUCTURE INPUT/OUTPUT TABLE  
 =====

-Hydrology-

JBS	SWS	Area (ac)	CN	UHS	Tc (hrs)	K (hrs)	X	Base- Flow (cfs)	Runoff Volume (ac-ft)	Peak Discharge (cfs)
111	1	80.10	92	M	0.512	0.000	0.000	0.0	6.09	69.97
		Type: Null		Label: SO HOSTEEN STKPD #1						
111	Structure	30.10							6.09	
111	Total IN/OUT	80.10							6.09	69.97
112	1	37.70	93	M	0.354	0.000	0.000	0.0	2.93	40.75
		Type: Null		Label: SO HOSTEEN STKPD #2						
112	Structure	37.70							9.02	
112	Total IN/OUT	117.80							9.02	85.64
111	to 112 Routing					0.245	0.316			

Company Name: BHP MINERALS  
 Filename: C:\LR\HW\_IMP\HYD\SHSPD1 User: LR  
 Date: 03-13-1997 Time: 12:43:11  
 SOUTH HOSTEEN STOCKPOND #1 AND 2  
 Storm: 1.60 inches, 25 year- 6 hour, Type II-65  
 Hydrograph Convolution Interval: 0.1 hr

=====

DETAILED SUBWATERSHED INPUT/OUTPUT TABLE

=====

J	B	S	SWS	Seg. #	Land Flow Condition	Distance (ft)	Slope (%)	Velocity (fps)	Segment Time (hr)	Time Conc. (hr)	Muskingum K (hr)	X
1	1	1	1	-a	5	3750.00	4.13	2.03	0.51	0.512		
1	1	2	1	-a	5	2250.00	3.11	1.76	0.35	0.354		

CIVIL SOFTWARE DESIGN

SEDCAD+ Version 3

SOUTH HOSTEEN STOCKPOND #3

by

Name: LR

Company Name: BHP MINERALS  
File Name: C:\LR\HW\_IMP\HYD\SHSPD3

Date: 03-13-1997

Company Name: BHP MINERALS

Filename: C:\LR\HW\_IMP\HYD\SHSPD3 User: LR

Date: 03-13-1997 Time: 12:16:45

SOUTH HOSTEEN STOCKPOND #3

Storm: 1.60 inches, 25 year- 6 hour, Type II-65

Hydrograph Convolution Interval: 0.1 hr

=====

SUBWATERSHED/STRUCTURE INPUT/OUTPUT TABLE

=====

-Hydrology-

JBS	SWS	Area (ac)	CN	UHS	Tc (hrs)	K (hrs)	X	Base- Flow (cfs)	Runoff Volume (ac-ft)	Peak Discharge (cfs)	
111	1	157.30	93	M	0.496	0.000	0.000	0.0	12.32	144.33	
					Type: Null		Label: POND				
111	Structure	157.30								12.32	
111	Total IN/OUT	157.30								12.32	144.33

Company Name: BHP MINERALS  
 Filename: C:\LR\HW\_IMP\HYD\SHSPD3 User: LR  
 Date: 03-13-1997 Time: 12:16:45  
 SOUTH HOSTEEN STOCKPOND #3  
 Storm: 1.60 inches, 25 year- 6 hour, Type II-65  
 Hydrograph Convolution Interval: 0.1 hr

=====  
 DETAILED SUBWATERSHED INPUT/OUTPUT TABLE  
 =====

J	B	S	SWS	Seg. #	Land Flow Condition	Distance (ft)	Slope (%)	Velocity (fps)	Segment Time (hr)	Time Conc. (hr)	Muskingum K (hr)	X
1	1	1	1	-a	5	4300.00	5.79	2.41	0.50	0.496		

CIVIL SOFTWARE DESIGN

SEDCAD+ Version 3

STUB 16 IMPOUNDMENT #2

by

Name: LR

Company Name: BHP MINERALS  
File Name: C:\LR\HW\_IMP\HYD\S16IMP2

Date: 03-13-1997

Company Name: BHP MINERALS  
 Filename: C:\LR\HW\_IMP\HYD\S16IMP2 User: LR  
 Date: 03-13-1997 Time: 12:31:58  
 STUB 16 IMPOUNDMENT #2  
 Storm: 1.60 inches, 25 year- 6 hour, Type II-65  
 Hydrograph Convolution Interval: 0.1 hr

=====  
 SUBWATERSHED/STRUCTURE INPUT/OUTPUT TABLE  
 =====

-Hydrology-

JBS SWS	Area (ac)	CN UHS	Tc (hrs)	K (hrs)	X	Base- Flow (cfs)	Runoff Volume (ac-ft)	Peak Discharge (cfs)
111 1	20.20	93 M	0.272	0.000	0.000	0.0	1.61	24.85
		Type: Null		Label: POND				
111 Structure	20.20						1.61	
111 Total IN/OUT	20.20						1.61	24.85

Company Name: BHP MINERALS  
 Filename: C:\LR\HW\_IMP\HYD\S16IMP2 User: LR  
 Date: 03-13-1997 Time: 12:31:58  
 STUB 16 IMPOUNDMENT #2  
 Storm: 1.60 inches, 25 year- 6 hour, Type II-65  
 Hydrograph Convolution Interval: 0.1 hr

=====

DETAILED SUBWATERSHED INPUT/OUTPUT TABLE

=====

J	B	S	SWS	Seg. #	Land Flow Condition	Distance (ft)	Slope (%)	Velocity (fps)	Segment Time (hr)	Time Conc. (hr)	Muskingum K (hr)	X
1	1	1	1	-a	5	2150.00	4.79	2.19	0.27	0.272		

CIVIL SOFTWARE DESIGN

SEDCAD+ Version 3

STUB 16 IMPOUNDMENT #3

by

Name: LR

Company Name: BHP MINERALS  
File Name: C:\LR\HW\_IMP\HYD\S16IMP3

Date: 03-13-1997

Company Name: BHP MINERALS  
 Filename: C:\LR\HW\_IMP\HYD\S16IMP3 User: LR  
 Date: 03-13-1997 Time: 13:11:43  
 STUB 16 IMPOUNDMENT #3  
 Storm: 1.60 inches, 25 year- 6 hour, Type II-65  
 Hydrograph Convolution Interval: 0.1 hr

=====  
 SUBWATERSHED/STRUCTURE INPUT/OUTPUT TABLE  
 =====

-Hydrology-

JBS SWS	Area (ac)	CN UHS	Tc (hrs)	K (hrs)	X	Base- Flow (cfs)	Runoff Volume (ac-ft)	Peak Discharge (cfs)
111 1	10.60	93 M	0.147	0.000	0.000	0.0	0.84	15.48
		Type: Null		Label: POND				
111 Structure	10.60						0.84	
111 Total IN/OUT	10.60						0.84	15.48

Company Name: BHP MINERALS  
 Filename: C:\LR\HW\_IMP\HYD\S16IMP3 User: LR  
 Date: 03-13-1997 Time: 13:11:43  
 STUB 16 IMPOUNDMENT #3  
 Storm: 1.60 inches, 25 year- 6 hour, Type II-65  
 Hydrograph Convolution Interval: 0.1 hr

=====  
 DETAILED SUBWATERSHED INPUT/OUTPUT TABLE  
 =====

J	B	S	SWS	Seg. #	Land Flow Condition	Distance (ft)	Slope (%)	Velocity (fps)	Segment Time (hr)	Time Conc. (hr)	Muskingum K (hr)	X
1	1	1	1	-a	5	1350.00	6.44	2.54	0.15	0.147		*

CIVIL SOFTWARE DESIGN

SEDCAD+ Version 3

STUB 18 IMPOUNDMENT

by

Name: LR

Company Name: BHP MINERALS  
File Name: C:\LR\HW\_IMP\HYD\S18IMP

Date: 03-13-1997

Company Name: BHP MINERALS  
 Filename: C:\LR\HW\_IMP\HYD\S18IMP User: LR  
 Date: 03-13-1997 Time: 12:22:01  
 STUB 18 IMPOUNDMENT

Storm: 1.60 inches, 25 year- 6 hour, Type II-65  
 Hydrograph Convolution Interval: 0.1 hr

=====  
 SUBWATERSHED/STRUCTURE INPUT/OUTPUT TABLE  
 =====

-Hydrology-

JBS	SWS	Area (ac)	CN	UHS	Tc (hrs)	K (hrs)	X	Base- Flow (cfs)	Runoff Volume (ac-ft)	Peak Discharge (cfs)
111	1	103.40	82	M	0.571	0.000	0.000	0.0	3.46	34.87
					Type: Null		Label: POND			
111	Structure	103.40							3.46	
111	Total IN/OUT	103.40							3.46	34.87

Company Name: BHP MINERALS  
 Filename: C:\LR\HW\_IMP\HYD\S18IMP User: LR  
 Date: 03-13-1997 Time: 12:22:01  
 STUB 18 IMPOUNDMENT

Storm: 1.60 inches, 25 year- 6 hour, Type II-65  
 Hydrograph Convolution Interval: 0.1 hr

=====  
 DETAILED SUBWATERSHED INPUT/OUTPUT TABLE  
 =====

J	B	S	SWS	Seg. #	Land Flow Condition	Distance (ft)	Slope (%)	Velocity (fps)	Segment Time (hr)	Time Conc. (hr)	Muskingum K (hr)	X
1	1	1	1	-a	5	3850.00	3.51	1.87	0.57	0.571		

CIVIL SOFTWARE DESIGN

SEDCAD+ Version 3

SUNFLOWER #1

by

Name: LR

Company Name: BHP MINERALS  
File Name: C:\LR\HW\_IMP\HYD\SUNFL1

Date: 03-13-1997

Company Name: BHP MINERALS  
 Filename: C:\LR\HW\_IMP\HYD\SUNFL1 User: LR  
 Date: 03-13-1997 Time: 12:16:43  
 SUNFLOWER #1

Storm: 1.60 inches, 25 year- 6 hour, Type II-65  
 Hydrograph Convolution Interval: 0.1 hr

=====  
 SUBWATERSHED/STRUCTURE INPUT/OUTPUT TABLE  
 =====

-Hydrology-

JBS	SWS	Area (ac)	CN	UHS	Tc (hrs)	K (hrs)	X	Base- Flow (cfs)	Runoff Volume (ac-ft)	Peak Discharge (cfs)		
111	1	24.60	82	M	0.297	0.000	0.000	0.0	0.82	12.29		
					Type: Null		Label: POND					
111	Structure	24.60									0.82	
111	Total IN/OUT	24.60									0.82	12.29

Company Name: BHP MINERALS  
 Filename: C:\LR\HW\_IMP\HYD\SUNFL1 User: LR  
 Date: 03-13-1997 Time: 12:16:43  
 SUNFLOWER #1  
 Storm: 1.60 inches, 25 year- 6 hour, Type II-65  
 Hydrograph Convolution Interval: 0.1 hr

=====  
 DETAILED SUBWATERSHED INPUT/OUTPUT TABLE  
 =====

J	B	S	SWS	Seg. #	Land Flow Condition	Distance (ft)	Slope (%)	Velocity (fps)	Segment Time (hr)	Time Conc. (hr)	Muskingum K (hr)	X
1	1	1	1	-a	5	1250.00	1.36	1.17	0.30	0.297		

CIVIL SOFTWARE DESIGN

SEDCAD+ Version 3

AREA 3 TEMPORARY DIVERSION IMPOUNDMENT #2, 3, AND 5

by

Name: LR

Company Name: BHP MINERALS  
File Name: C:\LR\HW\_IMP\HYD\A3TD235

Date: 03-13-1997

Company Name: BHP MINERALS  
 Filename: C:\LR\HW\_IMP\HYD\A3TD235 User: LR  
 Date: 03-13-1997 Time: 12:16:32  
 AREA 3 TEMPORARY DIVERSION IMPOUNDMENT #2, 3, AND 5  
 Storm: 1.60 inches, 25 year- 6 hour, Type II-65  
 Hydrograph Convolution Interval: 0.1 hr

=====  
 SUBWATERSHED/STRUCTURE INPUT/OUTPUT TABLE  
 =====

-Hydrology-

JBS	SWS	Area (ac)	CN	UHS	Tc (hrs)	K (hrs)	X	Base- Flow (cfs)	Runoff Volume (ac-ft)	Peak Discharge (cfs)
111	1	59.90	82	M	1.141	0.105	0.329	0.0	1.94	12.06
111	2	10.00	89	M	0.922	0.000	0.000	0.0	0.59	4.53
111 Structure		69.90	Type: Null		Label: A3 TEMP DIV IMP 2				2.53	
111 Total IN/OUT		69.90							2.53	15.61
112	1	10.00	82	M	0.187	0.070	0.359	0.0	0.33	6.18
112	2	10.80	89	M	0.453	0.000	0.000	0.0	0.64	7.72
112 Structure		20.80	Type: Null		Label: A3 TEMP DIV IMP 3				3.50	
112 Total IN/OUT		90.70							3.50	17.56
111 to 112 Routing					0.414	0.220				
113	1	11.60	89	M	0.556	0.000	0.000	0.0	0.68	7.35
113 Structure		11.60	Type: Null		Label: A3 TEMP DIV IMP 5				4.18	
113 Total IN/OUT		102.30							4.18	18.90
112 to 113 Routing					0.370	0.267				

Company Name: BHP MINERALS  
 Filename: C:\LR\HW\_IMP\HYD\A3TD235 User: LR  
 Date: 03-13-1997 Time: 12:16:32  
 AREA 3 TEMPORARY DIVERSION IMPOUNDMENT #2, 3, AND 5  
 Storm: 1.60 inches, 25 year- 6 hour, Type II-65  
 Hydrograph Convolution Interval: 0.1 hr

=====  
 DETAILED SUBWATERSHED INPUT/OUTPUT TABLE  
 =====

J	B	S	SWS	Seg. #	Land Flow Condition	Distance (ft)	Slope (%)	Velocity (fps)	Segment Time (hr)	Time Conc. (hr)	Muskingum K (hr)	X
1	1	1	1	-a	5	3000.00	0.53	0.73	1.14	1.141		
1	1	1	1	-1	8	1250.09	1.20	3.29	0.11		0.105	0.329
1	1	1	2	-a	5	2850.00	0.74	0.86	0.92	0.922		
1	1	2	1	-a	5	900.00	1.78	1.33	0.19	0.187		
1	1	2	1	-1	8	1100.24	2.09	4.34	0.07		0.070	0.359
1	1	2	2	-a	5	2000.00	1.50	1.22	0.45	0.453		
1	3	1	1	-a	5	2700.00	1.81	1.35	0.56	0.556		

CIVIL SOFTWARE DESIGN

SEDCAD+ Version 3

AREA 3 TEMPORARY DIVERSION IMPOUNDMENT #7

by

Name: LR

Company Name: BHP MINERALS  
File Name: C:\LR\HW\_IMP\HYD\A3TD7

Date: 03-13-1997

Company Name: BHP MINERALS  
 Filename: C:\LR\HW\_IMP\HYD\A3TD7 User: LR  
 Date: 03-13-1997 Time: 12:21:50  
 AREA 3 TEMPORARY DIVERSION IMPOUNDMENT #7  
 Storm: 1.60 inches, 25 year- 6 hour, Type II-65  
 Hydrograph Convolution Interval: 0.1 hr

=====  
 SUBWATERSHED/STRUCTURE INPUT/OUTPUT TABLE  
 =====

-Hydrology-

JBS SWS	Area (ac)	CN UHS	Tc (hrs)	K (hrs)	X	Base- Flow (cfs)	Runoff Volume (ac-ft)	Peak Discharge (cfs)
111 1	52.30	86 M	0.290	0.512	0.211	0.0	2.52	38.29
111 2	3.20	89 M	0.412	0.000	0.000	0.0	0.19	2.41
		Type: Null		Label: POND				
111 Structure	55.50						2.71	
111 Total IN/OUT	55.50						2.71	29.84

Company Name: BHP MINERALS  
 Filename: C:\LR\HW\_IMP\HYD\A3TD7 User: LR  
 Date: 03-13-1997 Time: 12:21:50  
 AREA 3 TEMPORARY DIVERSION IMPOUNDMENT #7  
 Storm: 1.60 inches, 25 year- 6 hour, Type II-65  
 Hydrograph Convolution Interval: 0.1 hr

=====  
 DETAILED SUBWATERSHED INPUT/OUTPUT TABLE  
 =====

J	B	S	SWS	Seg. #	Land Flow Condition	Distance (ft)	Slope (%)	Velocity (fps)	Segment Time (hr)	Time Conc. (hr)	Muskingum K (hr)	X
1	1	1	1	-a	5	1550.00	2.19	1.48	0.29	0.290		
1	1	1	1	-1	5	1650.10	1.09	1.04	0.44			
				-2	8	500.00	0.40	1.90	0.07		0.512	0.211
1	1	1	2	-a	5	1050.00	0.50	0.71	0.41	0.412		

**HIGHWALL IMPOUNDMENTS**

**SEDCAD+ COMPUTER RUNS**

**EXISTING IMPOUNDMENTS  
USING THE CRITERIA FOR STANDARD DESIGN**

CIVIL SOFTWARE DESIGN

SEDCAD+ Version 3

YAZZIE STOCKPOND #1 - USING CRITERIA FOR STANDARD DESIGN

by

Name: LR

Company Name: BHP MINERALS  
File Name: C:\LR\HW\_IMP\HYD\YSPD1A

Date: 03-14-1997

Company Name: BHP MINERALS  
 Filename: C:\LR\HW\_IMP\HYD\YSPD1A User: LR  
 Date: 03-13-1997 Time: 12:21:53  
 YAZZIE STOCKPOND #1 - CRITERIA FOR STANDARD DESIGN  
 Storm: 1.60 inches, 25 year- 6 hour, Type II-65  
 Hydrograph Convolution Interval: 0.1 hr

=====  
 SUBWATERSHED/STRUCTURE INPUT/OUTPUT TABLE  
 =====

-Hydrology-

JBS	SWS	Area (ac)	CN	UHS	Tc (hrs)	K (hrs)	X	Base- Flow (cfs)	Runoff Volume (ac-ft)	Peak Discharge (cfs)	
111	1	125.50	93	M	0.487	0.000	0.000	0.0	9.98	118.13	
					Type: Null		Label: POND				
111	Structure	125.50								9.98	
111	Total IN/OUT	125.50								9.98	118.13

Company Name: BHP MINERALS  
 Filename: C:\LR\HW\_IMP\HYD\YSPD1A User: LR  
 Date: 03-13-1997 Time: 12:21:53  
 YAZZIE STOCKPOND #1 - CRITERIA FOR STANDARD DESIGN  
 Storm: 1.60 inches, 25 year- 6 hour, Type II-65  
 Hydrograph Convolution Interval: 0.1 hr

=====  
 DETAILED SUBWATERSHED INPUT/OUTPUT TABLE  
 =====

J	B	S	SWS	Seg. #	Land Flow Condition	Distance (ft)	Slope (%)	Velocity (fps)	Segment Time (hr)	Time Conc. (hr)	Muskingum K (hr)	X
1	1	1	1	-a	5	3507.00	4.00	2.00	0.49	0.487		

CIVIL SOFTWARE DESIGN

SEDCAD+ Version 3

YAZZIE STOCKPOND #2 - USING CRITERIA FOR STANDARD DESIGN

by

Name: LR

Company Name: BHP MINERALS  
File Name: C:\LR\HW\_IMP\HYD\YSPD2A

Date: 03-14-1997

Company Name: BHP MINERALS  
 Filename: C:\LR\HW\_IMP\HYD\YSPD2A User: LR  
 Date: 03-13-1997 Time: 12:21:54  
 YAZZIE STOCKPOND #2 - CRITERIA FOR STANDARD DESIGN  
 Storm: 1.60 inches, 25 year- 6 hour, Type II-65  
 Hydrograph Convolution Interval: 0.1 hr

=====  
 SUBWATERSHED/STRUCTURE INPUT/OUTPUT TABLE  
 =====

-Hydrology-

JBS	SWS	Area (ac)	CN	UHS	Tc (hrs)	K (hrs)	X	Base- Flow (cfs)	Runoff Volume (ac-ft)	Peak Discharge (cfs)	
111	1	174.10	93	M	0.573	0.000	0.000	0.0	13.84	148.87	
					Type: Null		Label: POND				
111	Structure	174.10									
									13.84		
111	Total IN/OUT	174.10								13.84	148.87

Company Name: BHP MINERALS  
Filename: C:\LR\HW\_IMP\HYD\YSPD2A User: LR  
Date: 03-13-1997 Time: 12:21:54  
YAZZIE STOCKPOND #2 - CRITERIA FOR STANDARD DESIGN  
Storm: 1.60 inches, 25 year- 6 hour, Type II-65  
Hydrograph Convolution Interval: 0.1 hr

=====  
DETAILED SUBWATERSHED INPUT/OUTPUT TABLE  
=====

J	B	S	SWS	Seg. #	Land Flow Condition	Distance (ft)	Slope (%)	Velocity (fps)	Segment Time (hr)	Time Conc. (hr)	Muskingum K (hr)	X
1	1	1	1	-a	5	4130.00	4.00	2.00	0.57	0.573		

CIVIL SOFTWARE DESIGN

SEDCAD+ Version 3

SOUTH HOSTEEN STOCKPOND #1 AND 2 - USING CRITERIA FOR STANDARD DESIGN

by

Name: LR

Company Name: BHP MINERALS  
File Name: C:\LR\HW\_IMP\HYD\SHSPD1A

Date: 03-14-1997

Company Name: BHP MINERALS  
 Filename: C:\LR\HW\_IMP\HYD\SHSPD1A User: LR  
 Date: 03-13-1997 Time: 12:21:56  
 SOUTH HOSTEEN STOCKPOND #1 AND 2 - CRITERIA FOR STANDARD DESIGN  
 Storm: 1.60 inches, 25 year- 6 hour, Type II-65  
 Hydrograph Convolution Interval: 0.1 hr

=====  
 SUBWATERSHED/STRUCTURE INPUT/OUTPUT TABLE  
 =====

-Hydrology-

JBS	SWS	Area (ac)	CN	UHS	Tc (hrs)	K (hrs)	X	Base- Flow (cfs)	Runoff Volume (ac-ft)	Peak Discharge (cfs)
111	1	80.10	93	M	0.389	0.000	0.000	0.0	6.37	84.66
111	Structure	80.10							6.37	
111 Total IN/OUT		80.10							6.37	84.66
112	1	37.70	93	M	0.266	0.000	0.000	0.0	3.00	46.74
112	Structure	37.70							9.37	
112 Total IN/OUT		117.80							9.37	98.37
111 to 112 Routing						0.245	0.316			

Company Name: BHP MINERALS  
 Filename: C:\LR\HW\_IMP\HYD\SHSPD1A User: LR  
 Date: 03-13-1997 Time: 12:21:56  
 SOUTH HOSTEEN STOCKPOND #1 AND 2 - CRITERIA FOR STANDARD DESIGN  
 Storm: 1.60 inches, 25 year- 6 hour, Type II-65  
 Hydrograph Convolution Interval: 0.1 hr

=====  
 DETAILED SUBWATERSHED INPUT/OUTPUT TABLE  
 =====

J	B	S	SWS	Seg. #	Land Flow Condition	Distance (ft)	Slope (%)	Velocity (fps)	Segment Time (hr)	Time Conc. (hr)	Muskingum K (hr)	X
1	1	1	1	-a	5	2802.00	4.00	2.00	0.39	0.389		
1	1	2	1	-a	5	1922.00	4.00	2.00	0.27	0.266		

CIVIL SOFTWARE DESIGN

SEDCAD+ Version 3

SOUTH HOSTEEN STOCKPOND #3 - USING CRITERIA FOR STANDARD DESIGN

by

Name: LR

Company Name: BHP MINERALS  
File Name: C:\LR\HW\_IMP\HYD\SHSPD3A

Date: 03-14-1997

Company Name: BHP MINERALS  
 Filename: C:\LR\HW\_IMP\HYD\SHSPD3A User: LR  
 Date: 03-13-1997 Time: 12:21:59

SOUTH HOSTEEN STOCKPOND #3 - CRITERIA FOR STANDARD DESIGN  
 Storm: 1.60 inches, 25 year- 6 hour, Type II-65  
 Hydrograph Convolution Interval: 0.1 hr

=====  
 SUBWATERSHED/STRUCTURE INPUT/OUTPUT TABLE  
 =====

-Hydrology-

JBS	SWS	Area (ac)	CN	UHS	Tc (hrs)	K (hrs)	X	Base- Flow (cfs)	Runoff Volume (ac-ft)	Peak Discharge (cfs)
111	1	157.30	93	M	0.545	0.000	0.000	0.0	12.51	138.63
					Type: Null		Label: POND			
111	Structure	157.30							12.51	
111	Total IN/OUT	157.30							12.51	138.63

Company Name: BHP MINERALS  
 Filename: C:\LR\HW\_IMP\HYD\SHSPD3A User: LR  
 Date: 03-13-1997 Time: 12:21:59  
 SOUTH HOSTEEN STOCKPOND #3 - CRITERIA FOR STANDARD DESIGN  
 Storm: 1.60 inches, 25 year- 6 hour, Type II-65  
 Hydrograph Convolution Interval: 0.1 hr

=====  
 DETAILED SUBWATERSHED INPUT/OUTPUT TABLE  
 =====

J	B	S	SWS	Seg. #	Land Flow Condition	Distance (ft)	Slope (%)	Velocity (fps)	Segment Time (hr)	Time Conc. (hr)	Muskingum K (hr)	X
1	1	1	1	-a	5	3926.00	4.00	2.00	0.55	0.545		

CIVIL SOFTWARE DESIGN

SEDCAD+ Version 3

STUB 16 IMPOUNDMENT #2 - USING CRITERIA FOR STANDARD DESIGN

by

Name: LR

Company Name: BHP MINERALS  
File Name: C:\LR\HW\_IMP\HYD\S16IMP2A

Date: 03-14-1997

Company Name: BHP MINERALS  
 Filename: C:\LR\HW\_IMP\HYD\S16IMP2A User: LR  
 Date: 03-13-1997 Time: 12:22:03  
 STUB 16 IMPOUNDMENT #2 - CRITERIA FOR STANDARD DESIGN  
 Storm: 1.60 inches, 25 year- 6 hour, Type II-65  
 Hydrograph Convolution Interval: 0.1 hr

=====  
 SUBWATERSHED/STRUCTURE INPUT/OUTPUT TABLE  
 =====

-Hydrology-

JBS	SWS	Area (ac)	CN	UHS	Tc (hrs)	K (hrs)	X	Base- Flow (cfs)	Runoff Volume (ac-ft)	Peak Discharge (cfs)
111	1	20.20	93	M	0.195	0.000	0.000	0.0	1.61	27.75
				Type: Null		Label: POND				
111	Structure	20.20							1.61	
111	Total IN/OUT	20.20							1.61	27.75

Company Name: BHP MINERALS  
Filename: C:\LR\HW\_IMP\HYD\S16IMP2A User: LR  
Date: 03-13-1997 Time: 12:22:03  
STUB 16 IMPOUNDMENT #2 - CRITERIA FOR STANDARD DESIGN  
Storm: 1.60 inches, 25 year- 6 hour, Type II-65  
Hydrograph Convolution Interval: 0.1 hr

=====  
DETAILED SUBWATERSHED INPUT/OUTPUT TABLE  
=====

J	B	S	SWS	Seg. #	Land Flow Condition	Distance (ft)	Slope (%)	Velocity (fps)	Segment Time (hr)	Time Conc. (hr)	Muskingum K (hr)	X
1	1	1	1	-a	5	1407.00	4.00	2.00	0.20	0.195		

CIVIL SOFTWARE DESIGN

SEDCAD+ Version 3

STUB 16 IMPOUNDMENT #3 - USING CRITERIA FOR STANDARD DESIGN

by

Name: LR

Company Name: BHP MINERALS  
File Name: C:\LR\HW\_IMP\HYD\S16IMP3A

Date: 03-14-1997

Company Name: BHP MINERALS  
 Filename: C:\LR\HW\_IMP\HYD\S16IMP3A User: LR  
 Date: 03-13-1997 Time: 12:22:04  
 STUB 16 IMPOUNDMENT #3 - CRITERIA FOR STANDARD DESIGN  
 Storm: 1.60 inches, 25 year- 6 hour, Type II-65  
 Hydrograph Convolution Interval: 0.1 hr

=====  
 SUBWATERSHED/STRUCTURE INPUT/OUTPUT TABLE  
 =====

-Hydrology-

JBS	SWS	Area (ac)	CN	UHS	Tc (hrs)	K (hrs)	X	Base- Flow (cfs)	Runoff Volume (ac-ft)	Peak Discharge (cfs)
111	1	10.60	93	M	0.141	0.000	0.000	0.0	0.84	15.48
				Type: Null	Label: POND					
111	Structure	10.60								
									0.84	
111	Total IN/OUT	10.60								
									0.84	15.48

Company Name: BHP MINERALS  
 Filename: C:\LR\HW\_IMP\HYD\S16IMP3A User: LR  
 Date: 03-13-1997 Time: 12:22:04  
 STUB 16 IMPOUNDMENT #3 - CRITERIA FOR STANDARD DESIGN  
 Storm: 1.60 inches, 25 year- 6 hour, Type II-65  
 Hydrograph Convolution Interval: 0.1 hr

=====  
 DETAILED SUBWATERSHED INPUT/OUTPUT TABLE  
 =====

J	B	S	SWS	Seg. #	Land Flow Condition	Distance (ft)	Slope (%)	Velocity (fps)	Segment Time (hr)	Time Conc. (hr)	Muskingum K (hr)	X
1	1	1	1	-a	5	1019.00	4.00	2.00	0.14	0.141		

CIVIL SOFTWARE DESIGN

SEDCAD+ Version 3

STUB 18 IMPOUNDMENT - USING CRITERIA FOR STANDARD DESIGN

by

Name: LR

Company Name: BHP MINERALS  
File Name: C:\LR\HW\_IMP\HYD\S18IMPA

Date: 03-14-1997

Company Name: BHP MINERALS  
 Filename: C:\LR\HW\_IMP\HYD\S18IMPA User: LR  
 Date: 03-13-1997 Time: 12:22:12  
 STUB 18 IMPOUNDMENT - CRITERIA FOR STANDARD DESIGN  
 Storm: 1.60 inches, 25 year- 6 hour, Type II-65  
 Hydrograph Convolution Interval: 0.1 hr

=====  
 SUBWATERSHED/STRUCTURE INPUT/OUTPUT TABLE  
 =====

-Hydrology-

JBS SWS	Area (ac)	CN UHS	Tc (hrs)	K (hrs)	X	Base- Flow (cfs)	Runoff Volume (ac-ft)	Peak Discharge (cfs)
111 1	103.40	83 M	0.442	0.000	0.000	0.0	3.77	45.24
		Type: Null		Label: POND				
111 Structure	103.40						3.77	
111 Total IN/OUT	103.40						3.77	45.24

Company Name: BHP MINERALS  
 Filename: C:\LR\HW\_IMP\HYD\S18IMPA User: LR  
 Date: 03-13-1997 Time: 12:22:12  
 STUB 18 IMPOUNDMENT - CRITERIA FOR STANDARD DESIGN  
 Storm: 1.60 inches, 25 year- 6 hour, Type II-65  
 Hydrograph Convolution Interval: 0.1 hr

=====  
 DETAILED SUBWATERSHED INPUT/OUTPUT TABLE  
 =====

J	B	S	SWS	Seg. #	Land Flow Condition	Distance (ft)	Slope (%)	Velocity (fps)	Segment Time (hr)	Time Conc. (hr)	Muskingum K (hr)	X
1	1	1	1	-a	5	3183.00	4.00	2.00	0.44	0.442		

CIVIL SOFTWARE DESIGN

SEDCAD+ Version 3

SUNFLOWER #1 - USING CRITERIA FOR STANDARD DESIGN

by

Name: LR

Company Name: BHP MINERALS  
File Name: C:\LR\HW\_IMP\HYD\SUNFL1A

Date: 03-14-1997

Company Name: BHP MINERALS  
 Filename: C:\LR\HW\_IMP\HYD\SUNFL1A User: LR  
 Date: 03-13-1997 Time: 12:22:11  
 SUNFLOWER #1 - CRITERIA FOR STANDARD DESIGN  
 Storm: 1.60 inches, 25 year- 6 hour, Type II-65  
 Hydrograph Convolution Interval: 0.1 hr

=====

SUBWATERSHED/STRUCTURE INPUT/OUTPUT TABLE

=====

-Hydrology-

JBS	SWS	Area (ac)	CN	UHS	Tc (hrs)	K (hrs)	X	Base- Flow (cfs)	Runoff Volume (ac-ft)	Peak Discharge (cfs)
111	1	24.60	83	M	0.215	0.000	0.000	0.0	0.90	15.62
		Type: Null Label: POND								
111	Structure	24.60							0.90	
111	Total IN/OUT	24.60							0.90	15.62

Company Name: BHP MINERALS  
 Filename: C:\LR\HW\_IMP\HYD\SUNFL1A User: LR  
 Date: 03-13-1997 Time: 12:22:11  
 SUNFLOWER #1 - CRITERIA FOR STANDARD DESIGN  
 Storm: 1.60 inches, 25 year- 6 hour, Type II-65  
 Hydrograph Convolution Interval: 0.1 hr

=====

DETAILED SUBWATERSHED INPUT/OUTPUT TABLE

=====

J	B	S	SWS	Seg. #	Land Flow Condition	Distance (ft)	Slope (%)	Velocity (fps)	Segment Time (hr)	Time Conc. (hr)	Muskingum K (hr)	X
1	1	1	1	-a	5	1553.00	4.00	2.00	0.22	0.215		

CIVIL SOFTWARE DESIGN

SEDCAD+ Version 3

AREA 3 TEMP DIVERSION IMP #2, 3, AND 5 - USING CRITERIA FOR STD DESIGN

by

Name: LR

Company Name: BHP MINERALS  
File Name: C:\LR\HW\_IMP\HYD\A3TD235A

Date: 03-14-1997

Company Name: BHP MINERALS  
 Filename: C:\LR\HW\_IMP\HYD\A3TD345A User: LR  
 Date: 03-13-1997 Time: 12:22:06  
 AREA 3 TEMP DIVERSION IMP #2, 3, AND 5 - CRITERIA FOR STANDARD DESIGN  
 Storm: 1.60 inches, 25 year- 6 hour, Type II-65  
 Hydrograph Convolution Interval: 0.1 hr

=====  
 SUBWATERSHED/STRUCTURE INPUT/OUTPUT TABLE  
 =====

-Hydrology-

JBS	SWS	Area (ac)	CN	UHS	Tc (hrs)	K (hrs)	X	Base- Flow (cfs)	Runoff Volume (ac-ft)	Peak Discharge (cfs)
111	1	69.90	83	M	0.363	0.000	0.000	0.0	2.55	34.34
111	2	0.00	0	M	0.000	0.000	0.000	0.0	0.00	0.00
111	Structure	69.90	Type: Null		Label: A3 TEMP DIV IMP 2				2.55	
111	Total IN/OUT	69.90							2.55	34.34
112	1	20.80	83	M	0.198	0.000	0.000	0.0	0.76	13.66
112	2	0.00	0	M	0.000	0.000	0.000	0.0	0.00	0.00
112	Structure	20.80	Type: Null		Label: A3 TEMP DIV IMP 3				3.31	
112	Total IN/OUT	90.70							3.31	32.08
111 to 112 Routing					0.414	0.220				
113	1	11.60	83	M	0.148	0.000	0.000	0.0	0.42	8.20
113	Structure	11.60	Type: Null		Label: A3 TEMP DIV IMP 5				3.73	
113	Total IN/OUT	102.30							3.73	29.61
112 to 113 Routing					0.370	0.267				

Company Name: BHP MINERALS

Filename: C:\LR\HW\_IMP\HYD\A3TD345A User: LR

Date: 03-13-1997 Time: 12:22:06

AREA 3 TEMP DIVERSION IMP #2, 3, AND 5 - CRITERIA FOR STANDARD DESIGN

Storm: 1.60 inches, 25 year- 6 hour, Type II-65

Hydrograph Convolution Interval: 0.1 hr

=====

DETAILED SUBWATERSHED INPUT/OUTPUT TABLE

=====

J	B	S	SWS	Seg. #	Land Flow Condition	Distance (ft)	Slope (%)	Velocity (fps)	Segment Time (hr)	Time Conc. (hr)	Muskingum K (hr)	X
1	1	1	1	-a	5	2617.00	4.00	2.00	0.36	0.363		
1	1	1	2	-a	5	2850.00	0.74	0.86	0.92	0.000		
1	1	2	1	-a	5	1428.00	4.00	2.00	0.20	0.198		
1	1	2	2	-a	5	2000.00	1.50	1.22	0.45	0.000		
1	1	3	1	-a	5	1066.00	4.00	2.00	0.15	0.148		

CIVIL SOFTWARE DESIGN

SEDCAD+ Version 3

AREA 3 TEMP DIVERSION IMPOUNDMENT #7 - USING CRITERIA FOR STD DESIGN

by

Name: LR

Company Name: BHP MINERALS  
File Name: C:\LR\HW\_IMP\HYD\A3TD7A

Date: 03-14-1997

Company Name: BHP MINERALS  
 Filename: C:\LR\HW\_IMP\HYD\A3TD7A User: LR  
 Date: 03-13-1997 Time: 12:21:49  
 AREA 3 TEMP DIVERSION IMPOUNDMENT #7 - CRITERIA FOR STANDARD DESIGN  
 Storm: 1.60 inches, 25 year- 6 hour, Type II-65  
 Hydrograph Convolution Interval: 0.1 hr

=====

SUBWATERSHED/STRUCTURE INPUT/OUTPUT TABLE

=====

-Hydrology-

JBS	SWS	Area (ac)	CN	UHS	Tc (hrs)	K (hrs)	X	Base- Flow (cfs)	Runoff Volume (ac-ft)	Peak Discharge (cfs)
111	1	55.50	86	M	0.323	0.000	0.000	0.0	2.59	37.38
111	2	0.00	0	M	0.000	0.000	0.000	0.0	0.00	0.00
					Type: Null		Label: POND			
111	Structure	55.50							2.59	
111	Total IN/OUT	55.50							2.59	37.38

Company Name: BHP MINERALS  
 Filename: C:\LR\HW\_IMP\HYD\A3TD7A User: LR  
 Date: 03-13-1997 Time: 12:21:49  
 AREA 3 TEMP DIVERSION IMPOUNDMENT #7 - CRITERIA FOR STANDARD DESIGN  
 Storm: 1.60 inches, 25 year- 6 hour, Type II-65  
 Hydrograph Convolution Interval: 0.1 hr

=====  
 DETAILED SUBWATERSHED INPUT/OUTPUT TABLE  
 =====

J	B	S	SWS	Seg. #	Land Flow Condition	Distance (ft)	Slope (%)	Velocity (fps)	Segment Time (hr)	Time Conc. (hr)	Muskingum K (hr)	X
1	1	1	1	-a	5	2332.00	4.00	2.00	0.32	0.323		
1	1	1	2	-a	5	1050.00	0.50	0.71	0.41	0.000		

**HIGHWALL IMPOUNDMENTS**

**SEDCAD+ COMPUTER RUNS**

**EXISTING SPILLWAYS**

# SEDCAD+ BASIN DISCHARGE UTILITY

## YAZZIE STOCKPOND #1 - EXISTING SPILLWAY

### EMERGENCY SPILLWAY INPUTS:

Emergency Spillway Elevation	105.50
Crest Length	20.000 feet
Z:1 (Left)	1.50:1
Z:1 (Right)	3.00:1
Bottom Width	8.000 feet

Elevation	Emergency Spillway (cfs)	Total Discharge (cfs)
=====		
100.00	0.0	0.0
100.50	0.0	0.0
101.00	0.0	0.0
101.50	0.0	0.0
102.00	0.0	0.0
102.50	0.0	0.0
103.00	0.0	0.0
103.50	0.0	0.0
104.00	0.0	0.0
104.50	0.0	0.0
105.00	0.0	0.0
105.50	0.0	0.0
106.00	6.7	6.7
106.10	8.1	8.1
106.20	10.5	10.5
106.30	13.8	13.8
106.40	17.2	17.2
106.50	21.2	21.2
107.00	45.8	45.8

Existing spillway will not pass the peak discharge from the 25 yr - 6 hr storm event.

# SEDCAD+ BASIN DISCHARGE UTILITY

## YAZZIE STOCKPOND #2 - EXISTING SPILLWAY

### EMERGENCY SPILLWAY INPUTS:

Emergency Spillway Elevation	105.30
Crest Length	23.000 feet
Z:1 (Left)	2.00:1
Z:1 (Right)	1.50:1
Bottom Width	12.000 feet

Elevation	Emergency Spillway (cfs)	Total Discharge (cfs)
=====		
100.00	0.0	0.0
100.50	0.0	0.0
101.00	0.0	0.0
101.50	0.0	0.0
102.00	0.0	0.0
102.50	0.0	0.0
103.00	0.0	0.0
103.50	0.0	0.0
104.00	0.0	0.0
104.50	0.0	0.0
105.00	0.0	0.0
105.30	0.0	0.0
105.50	4.2	4.2
106.00	14.7	14.7
106.10	19.1	19.1
106.20	23.6	23.6
106.30	28.9	28.9
106.50	40.7	40.7
106.80	61.3	61.3
107.00	77.0	77.0

Existing spillway will not pass the peak discharge from the 25 yr - 6 hr storm event.

# SEDCAD+ BASIN DISCHARGE UTILITY

## SOUTH HOSTEEN STOCKPOND #1 - EXISTING SPILLWAY

### EMERGENCY SPILLWAY INPUTS:

Emergency Spillway Elevation	103.90
Crest Length	27.000 feet
Z:1 (Left)	4.00:1
Z:1 (Right)	5.00:1
Bottom Width	5.000 feet

Elevation	Emergency Spillway (cfs)	Total Discharge (cfs)
-----------	--------------------------	-----------------------

=====		
==		
100.00	0.0	0.0
100.50	0.0	0.0
101.00	0.0	0.0
101.50	0.0	0.0
102.00	0.0	0.0
102.50	0.0	0.0
103.00	0.0	0.0
103.50	0.0	0.0
103.90	0.0	0.0
104.00	0.1	0.1
104.50	0.8	0.8
104.60	7.4	7.4
104.70	9.9	9.9
104.80	12.7	12.7
104.90	16.0	16.0
105.00	20.0	20.0
105.40	40.6	40.6
105.50	46.6	46.6
105.90	75.5	75.5
106.00	84.3	84.3
106.40	125.6	125.6
106.50	137.8	137.8
106.90	193.2	193.2
107.00	208.7	208.7

# SEDCAD+ BASIN DISCHARGE UTILITY

## SOUTH HOSTEEN STOCKPOND #2 - EXISTING SPILLWAY

### EMERGENCY SPILLWAY INPUTS:

Emergency Spillway Elevation	103.50
Crest Length	30.000 feet
Z:1 (Left)	1.50:1
Z:1 (Right)	1.50:1
Bottom Width	13.700 feet

Elevation	Emergency Spillway (cfs)	Total Discharge (cfs)
=====		
100.00	0.0	0.0
100.50	0.0	0.0
101.00	0.0	0.0
101.50	0.0	0.0
102.00	0.0	0.0
102.50	0.0	0.0
103.00	0.0	0.0
103.20	0.0	0.0
103.30	0.0	0.0
103.40	0.0	0.0
103.50	0.0	0.0
104.00	11.1	11.1
104.20	15.5	15.5
104.30	20.0	20.0
104.40	24.9	24.9
104.50	30.2	30.2
105.00	66.3	66.3
105.50	107.7	107.7
106.00	160.7	160.7
106.50	225.7	225.7
107.00	300.5	300.5

# SEDCAD+ BASIN DISCHARGE UTILITY

## SOUTH HOSTEEN STOCKPOND #3 - EXISTING SPILLWAY

### EMERGENCY SPILLWAY INPUTS:

Emergency Spillway Elevation	103.50
Crest Length	30.000 feet
Z:1 (Left)	1.50:1
Z:1 (Right)	1.50:1
Bottom Width	13.700 feet

Elevation	Emergency Spillway (cfs)	Total Discharge (cfs)
=====		
100.00	0.0	0.0
100.50	0.0	0.0
101.00	0.0	0.0
101.50	0.0	0.0
102.00	0.0	0.0
102.50	0.0	0.0
103.00	0.0	0.0
103.50	0.0	0.0
104.00	11.1	11.1
104.20	15.5	15.5
104.30	20.0	20.0
104.40	24.9	24.9
104.50	30.2	30.2
105.00	66.3	66.3
105.50	107.7	107.7
106.00	160.7	160.7
106.50	225.7	225.7
107.00	300.5	300.5

# SEDCAD+ BASIN DISCHARGE UTILITY

## STUB 16 IMPOUNDMENT #2 - EXISTING SPILLWAY

### EMERGENCY SPILLWAY INPUTS:

Emergency Spillway Elevation	103.70
Crest Length	48.000 feet
Z:1 (Left)	1.90:1
Z:1 (Right)	1.80:1
Bottom Width	12.800 feet

Elevation	Emergency Spillway (cfs)	Total Discharge (cfs)
=====		
====		
100.00	0.0	0.0
100.50	0.0	0.0
101.00	0.0	0.0
101.50	0.0	0.0
102.00	0.0	0.0
102.50	0.0	0.0
103.00	0.0	0.0
103.50	0.0	0.0
103.70	0.0	0.0
104.00	5.4	5.4
104.40	12.6	12.6
104.50	16.7	16.7
104.60	20.8	20.8
104.70	25.2	25.2
105.00	44.2	44.2
105.20	59.2	59.2
105.50	81.7	81.7
105.70	98.4	98.4
106.00	127.3	127.3
106.20	148.3	148.3
106.50	184.1	184.1
106.70	209.9	209.9
107.00	253.2	253.2

# SEDCAD+ BASIN DISCHARGE UTILITY

## STUB 16 IMPOUNDMENT #3 - EXISTING SPILLWAY

EMERGENCY SPILLWAY INPUTS:

Emergency Spillway Elevation	104.50
Crest Length	36.000 feet
Z:1 (Left)	1.90:1
Z:1 (Right)	2.20:1
Bottom Width	11.500 feet

Elevation	Emergency Spillway (cfs)	Total Discharge (cfs)
=====		
100.00	0.0	0.0
100.50	0.0	0.0
101.00	0.0	0.0
101.50	0.0	0.0
102.00	0.0	0.0
102.50	0.0	0.0
103.00	0.0	0.0
103.50	0.0	0.0
104.00	0.0	0.0
104.50	0.0	0.0
105.00	9.0	9.0
105.20	12.6	12.6
105.30	16.4	16.4
105.40	20.7	20.7
105.50	25.3	25.3
106.00	56.9	56.9
106.50	95.8	95.8
107.00	143.8	143.8

# SEDCAD+ BASIN DISCHARGE UTILITY

## STUB 18 IMPOUNDMENT - EXISTING SPILLWAY

### EMERGENCY SPILLWAY INPUTS:

Emergency Spillway Elevation	102.60
Crest Length	45.000 feet
Z:1 (Left)	2.30:1
Z:1 (Right)	2.50:1
Bottom Width	17.000 feet

Elevation	Emergency Spillway (cfs)	Total Discharge (cfs)
=====		
100.00	0.0	0.0
100.50	0.0	0.0
101.00	0.0	0.0
101.50	0.0	0.0
102.00	0.0	0.0
102.50	0.0	0.0
102.60	0.0	0.0
103.00	9.8	9.8
103.30	17.1	17.1
103.40	22.5	22.5
103.50	28.2	28.2
103.60	34.3	34.3
104.00	68.9	68.9
104.10	79.0	79.0
104.50	120.6	120.6
104.60	132.2	132.2
105.00	183.6	183.6
105.10	197.6	197.6
105.50	262.6	262.6
105.60	280.2	280.2
106.00	357.6	357.6
106.10	378.4	378.4
106.50	470.0	470.0
106.60	494.4	494.4
107.00	592.1	592.1

# SEDCAD+ BASIN DISCHARGE UTILITY

SUNFLOWER #1 - EXISTING SPILLWAY

EMERGENCY SPILLWAY INPUTS:

Emergency Spillway Elevation	103.90
Crest Length	38.000 feet
Z:1 (Left)	4.30:1
Z:1 (Right)	5.20:1
Bottom Width	15.000 feet

Elevation	Emergency Spillway (cfs)	Total Discharge (cfs)
=====		
100.00	0.0	0.0
100.50	0.0	0.0
101.00	0.0	0.0
101.50	0.0	0.0
102.00	0.0	0.0
102.50	0.0	0.0
103.00	0.0	0.0
103.50	0.0	0.0
103.90	0.0	0.0
104.00	2.4	2.4
104.50	14.4	14.4
104.60	16.8	16.8
104.70	22.1	22.1
104.80	28.1	28.1
104.90	34.7	34.7
105.00	42.5	42.5
105.40	81.0	81.0
105.50	91.8	91.8
105.90	141.6	141.6
106.00	155.4	155.4
106.40	217.3	217.3
106.50	236.1	236.1
106.90	319.8	319.8
107.00	342.9	342.9

# SEDCAD+ BASIN DISCHARGE UTILITY

## AREA 3 TEMP. DIVERSION IMP. #2 - EXISTING SPILLWAY

EMERGENCY SPILLWAY INPUTS:

Emergency Spillway Elevation	104.30
Crest Length	35.000 feet
Z:1 (Left)	1.50:1
Z:1 (Right)	1.50:1
Bottom Width	9.000 feet

Elevation	Emergency Spillway (cfs)	Total Discharge (cfs)
=====		
100.00	0.0	0.0
100.50	0.0	0.0
101.00	0.0	0.0
101.50	0.0	0.0
102.00	0.0	0.0
102.50	0.0	0.0
103.00	0.0	0.0
103.50	0.0	0.0
104.00	0.0	0.0
104.30	0.0	0.0
104.50	2.8	2.8
105.00	9.9	9.9
105.10	12.9	12.9
105.20	16.2	16.2
105.30	19.8	19.8
105.50	28.6	28.6
105.80	44.4	44.4
106.00	55.5	55.5
106.30	74.3	74.3
106.50	88.3	88.3
106.80	111.4	111.4
107.00	129.5	129.5

# SEDCAD+ BASIN DISCHARGE UTILITY

## AREA 3 TEMP. DIVERSION IMP. #3 - EXISTING SPILLWAY

### EMERGENCY SPILLWAY INPUTS:

Emergency Spillway Elevation	102.00
Crest Length	18.000 feet
Z:1 (Left)	2.00:1
Z:1 (Right)	2.00:1
Bottom Width	40.000 feet

Elevation	Emergency Spillway (cfs)	Total Discharge (cfs)
=====		
=====		
100.00	0.0	0.0
100.50	0.0	0.0
101.00	0.0	0.0
101.50	0.0	0.0
102.00	0.0	0.0
102.50	32.4	32.4
102.60	38.9	38.9
102.70	50.2	50.2
102.80	64.9	64.9
102.90	79.6	79.6
103.00	96.4	96.4
103.50	195.7	195.7
104.00	321.9	321.9
104.50	470.8	470.8
105.00	640.9	640.9
105.50	831.5	831.5
106.00	1042.0	1042.0
106.50	1272.3	1272.3
107.00	1522.1	1522.1

# SEDCAD+ BASIN DISCHARGE UTILITY

## AREA 3 TEMP. DIVERSION IMP. #7 - EXISTING SPILLWAY

### EMERGENCY SPILLWAY INPUTS:

Emergency Spillway Elevation	104.90
Crest Length	50.000 feet
Z:1 (Left)	2.00:1
Z:1 (Right)	4.00:1
Bottom Width	10.000 feet

Elevation	Emergency Spillway (cfs)	Total Discharge (cfs)
=====		
=====		
100.00	0.0	0.0
100.50	0.0	0.0
101.00	0.0	0.0
101.50	0.0	0.0
102.00	0.0	0.0
102.50	0.0	0.0
103.00	0.0	0.0
103.50	0.0	0.0
104.00	0.0	0.0
104.50	0.0	0.0
104.90	0.0	0.0
105.00	1.5	1.5
105.50	8.7	8.7
105.60	10.2	10.2
105.70	13.6	13.6
105.80	17.0	17.0
105.90	20.7	20.7
106.00	25.8	25.8
106.40	51.4	51.4
106.50	57.9	57.9
106.90	87.9	87.9
107.00	96.9	96.9

**HIGHWALL IMPOUNDMENTS**

**SEDCAD+ COMPUTER RUNS**

**WATERSHED SIZES 25 TO 700 ACRES  
USING THE CRITERIA FOR STANDARD DESIGN**

CIVIL SOFTWARE DESIGN

SEDCAD+ Version 3

HIGHWALL IMPOUNDMENT - 25 ACRE WATERSHED, CN = 93

by

Name: lr

Company Name: BHP MINERALS  
File Name: C:\LR\HW\_IMP\HYD\HW25CN93

Date: 03-14-1997

Company Name: BHP MINERALS  
 Filename: C:\LR\HW\_IMP\HYD\HW25CN93 User: lr  
 Date: 03-14-1997 Time: 11:42:05  
 HIGHWALL IMPOUNDMENT - 25 ACRE WATERSHED, CN = 93  
 Storm: 1.60 inches, 25 year- 6 hour, Type II-65  
 Hydrograph Convolution Interval: 0.1 hr

=====  
 SUBWATERSHED/STRUCTURE INPUT/OUTPUT TABLE  
 =====

-Hydrology-

JBS SWS	Area (ac)	CN UHS	Tc (hrs)	K (hrs)	X	Base- Flow (cfs)	Runoff Volume (ac-ft)	Peak Discharge (cfs)
111 1	25.00	93 M	0.217	0.000	0.000	0.0	1.99	33.27
		Type: Null		Label: POND				
111 Structure	25.00						1.99	
111 Total IN/OUT	25.00						1.99	33.27

Company Name: BHP MINERALS  
 Filename: C:\LR\HW\_IMP\HYD\HW25CN93 User: lr  
 Date: 03-14-1997 Time: 11:42:05  
 HIGHWALL IMPOUNDMENT - 25 ACRE WATERSHED, CN = 93  
 Storm: 1.60 inches, 25 year- 6 hour, Type II-65  
 Hydrograph Convolution Interval: 0.1 hr

=====  
 DETAILED SUBWATERSHED INPUT/OUTPUT TABLE  
 =====

J	B	S	SWS	Seg. #	Land Flow Condition	Distance (ft)	Slope (%)	Velocity (fps)	Segment Time (hr)	Time Conc. (hr)	Muskingum K (hr)	X
1	1	1	1	-a	5	1565.00	4.00	2.00	0.22	0.217		

CIVIL SOFTWARE DESIGN

SEDCAD+ Version 3

HIGHWALL IMPOUNDMENT - 25 ACRE WATERSHED, CN = 90

by

Name: lr

Company Name: BHP MINERALS  
File Name: C:\LR\HW\_IMP\HYD\HW25CN90

Date: 03-14-1997

Company Name: BHP MINERALS  
 Filename: C:\LR\HW\_IMP\HYD\HW25CN90 User: lr  
 Date: 03-14-1997 Time: 11:01:09  
 HIGHWALL IMPOUNDMENT - 25 ACRE WATERSHED, CN = 90  
 Storm: 1.60 inches, 25 year- 6 hour, Type II-65  
 Hydrograph Convolution Interval: 0.1 hr

=====  
 SUBWATERSHED/STRUCTURE INPUT/OUTPUT TABLE  
 =====

-Hydrology-

JBS	SWS	Area (ac)	CN	UHS	Tc (hrs)	K (hrs)	X	Base- Flow (cfs)	Runoff Volume (ac-ft)	Peak Discharge (cfs)
111	1	25.00	90	M	0.217	0.000	0.000	0.0	1.59	27.04
					Type: Null		Label: POND			
111	Structure	25.00							1.59	
111	Total IN/OUT	25.00							1.59	27.04

Company Name: BHP MINERALS  
 Filename: C:\LR\HW\_IMP\HYD\HW25CN90 User: lr  
 Date: 03-14-1997 Time: 11:01:09  
 HIGHWALL IMPOUNDMENT - 25 ACRE WATERSHED, CN = 90  
 Storm: 1.60 inches, 25 year- 6 hour, Type II-65  
 Hydrograph Convolution Interval: 0.1 hr

=====  
 DETAILED SUBWATERSHED INPUT/OUTPUT TABLE  
 =====

J	B	S	SWS	Seg. #	Land Flow Condition	Distance (ft)	Slope (%)	Velocity (fps)	Segment Time (hr)	Time Conc. (hr)	Muskingum K (hr)	X
1	1	1	1	-a	5	1565.00	4.00	2.00	0.22	0.217		

CIVIL SOFTWARE DESIGN

SEDCAD+ Version 3

HIGHWALL IMPOUNDMENT - 25 ACRE WATERSHED, CN = 86

by

Name: lr

Company Name: BHP MINERALS  
File Name: C:\LR\HW\_IMP\HYD\HW25CN86

Date: 03-14-1997

Company Name: BHP MINERALS  
 Filename: C:\LR\HW\_IMP\HYD\HW25CN86 User: lr  
 Date: 03-14-1997 Time: 11:01:13  
 HIGHWALL IMPOUNDMENT - 25 ACRE WATERSHED, CN = 86  
 Storm: 1.60 inches, 25 year- 6 hour, Type II-65  
 Hydrograph Convolution Interval: 0.1 hr

=====  
 SUBWATERSHED/STRUCTURE INPUT/OUTPUT TABLE  
 =====

-Hydrology-

JBS	SWS	Area (ac)	CN	UHS	Tc (hrs)	K (hrs)	X	Base- Flow (cfs)	Runoff Volume (ac-ft)	Peak Discharge (cfs)	
111	1	25.00	86	M	0.217	0.000	0.000	0.0	1.17	20.17	
					Type: Null		Label: POND				
111	Structure	25.00								1.17	
111	Total IN/OUT	25.00								1.17	20.17

Company Name: BHP MINERALS  
 Filename: C:\LR\HW\_IMP\HYD\HW25CN86 User: lr  
 Date: 03-14-1997 Time: 11:01:13  
 HIGHWALL IMPOUNDMENT - 25 ACRE WATERSHED, CN = 86  
 Storm: 1.60 inches, 25 year- 6 hour, Type II-65  
 Hydrograph Convolution Interval: 0.1 hr

=====  
 DETAILED SUBWATERSHED INPUT/OUTPUT TABLE  
 =====

J	B	S	SWS	Seg. #	Land Flow Condition	Distance (ft)	Slope (%)	Velocity (fps)	Segment Time (hr)	Time Conc. (hr)	Muskingum K (hr)	X
1	1	1	1	-a	5	1565.00	4.00	2.00	0.22	0.217		

CIVIL SOFTWARE DESIGN

SEDCAD+ Version 3

HIGHWALL IMPOUNDMENT - 25 ACRE WATERSHED, CN = 83

by

Name: lr

Company Name: BHP MINERALS  
File Name: C:\LR\HW\_IMP\HYD\HW25CN83

Date: 03-14-1997

Company Name: BHP MINERALS  
 Filename: C:\LR\HW\_IMP\HYD\HW25CN83 User: lr  
 Date: 03-14-1997 Time: 11:01:11  
 HIGHWALL IMPOUNDMENT - 25 ACRE WATERSHED, CN = 83  
 Storm: 1.60 inches, 25 year- 6 hour, Type II-65  
 Hydrograph Convolution Interval: 0.1 hr

=====  
 SUBWATERSHED/STRUCTURE INPUT/OUTPUT TABLE  
 =====

-Hydrology-

JBS	SWS	Area (ac)	CN	UHS	Tc (hrs)	K (hrs)	X	Base- Flow (cfs)	Runoff Volume (ac-ft)	Peak Discharge (cfs)
111	1	25.00	83	M	0.217	0.000	0.000	0.0	0.91	15.81
					Type: Null		Label: POND			
111	Structure	25.00							0.91	
111	Total IN/OUT	25.00							0.91	15.81

Company Name: BHP MINERALS  
 Filename: C:\LR\HW\_IMP\HYD\HW25CN83 User: lr  
 Date: 03-14-1997 Time: 11:01:11  
 HIGHWALL IMPOUNDMENT - 25 ACRE WATERSHED, CN = 83  
 Storm: 1.60 inches, 25 year- 6 hour, Type II-65  
 Hydrograph Convolution Interval: 0.1 hr

=====  
 DETAILED SUBWATERSHED INPUT/OUTPUT TABLE  
 =====

J	B	S	SWS	Seg. #	Land Flow Condition	Distance (ft)	Slope (%)	Velocity (fps)	Segment Time (hr)	Time Conc. (hr)	Muskingum K (hr)	X
1	1	1	1	-a	5	1565.00	4.00	2.00	0.22	0.217		

CIVIL SOFTWARE DESIGN

SEDCAD+ Version 3

HIGHWALL IMPOUNDMENT - 50 ACRE WATERSHED, CN = 93

by

Name: lr

Company Name: BHP MINERALS  
File Name: C:\LR\HW\_IMP\HYD\HW50CN93

Date: 03-14-1997

Company Name: BHP MINERALS  
 Filename: C:\LR\HW\_IMP\HYD\HW50CN93 User: lr  
 Date: 03-14-1997 Time: 11:01:16  
 HIGHWALL IMPOUNDMENT - 50 ACRE WATERSHED, CN = 93  
 Storm: 1.60 inches, 25 year- 6 hour, Type II-65  
 Hydrograph Convolution Interval: 0.1 hr

=====  
 SUBWATERSHED/STRUCTURE INPUT/OUTPUT TABLE  
 =====

-Hydrology-

JBS SWS	Area (ac)	CN UHS	Tc (hrs)	K (hrs)	X	Base- Flow (cfs)	Runoff Volume (ac-ft)	Peak Discharge (cfs)	
111 1	50.00	93 M	0.307	0.000	0.000	0.0	3.98	58.67	
		Type: Null		Label: POND					
111 Structure	50.00							3.98	
111 Total IN/OUT	50.00							3.98	58.67

Company Name: BHP MINERALS  
 Filename: C:\LR\HW\_IMP\HYD\HW50CN93 User: lr  
 Date: 03-14-1997 Time: 11:01:16  
 HIGHWALL IMPOUNDMENT - 50 ACRE WATERSHED, CN = 93  
 Storm: 1.60 inches, 25 year- 6 hour, Type II-65  
 Hydrograph Convolution Interval: 0.1 hr

=====  
 DETAILED SUBWATERSHED INPUT/OUTPUT TABLE  
 =====

J	B	S	SWS	Seg. #	Land Flow Condition	Distance (ft)	Slope (%)	Velocity (fps)	Segment Time (hr)	Time Conc. (hr)	Muskingum K (hr)	X
1	1	1	1	-a	5	2214.00	4.00	2.00	0.31	0.307		

CIVIL SOFTWARE DESIGN

SEDCAD+ Version 3

HIGHWALL IMPOUNDMENT - 50 ACRE WATERSHED, CN = 90

by

Name: lr

Company Name: BHP MINERALS  
File Name: C:\LR\HW\_IMP\HYD\HW50CN90

Date: 03-14-1997

Company Name: BHP MINERALS  
 Filename: C:\LR\HW\_IMP\HYD\HW50CN90 User: lr  
 Date: 03-14-1997 Time: 11:01:14  
 HIGHWALL IMPOUNDMENT - 50 ACRE WATERSHED, CN = 90  
 Storm: 1.60 inches, 25 year- 6 hour, Type II-65  
 Hydrograph Convolution Interval: 0.1 hr

=====  
 SUBWATERSHED/STRUCTURE INPUT/OUTPUT TABLE  
 =====

-Hydrology-

JBS SWS	Area (ac)	CN UHS	Tc (hrs)	K (hrs)	X	Base- Flow (cfs)	Runoff Volume (ac-ft)	Peak Discharg (cfs)
111 1	50.00	90 M	0.307	0.000	0.000	0.0	3.18	47.06
		Type: Null		Label: POND				
111 Structure	50.00						3.18	
111 Total IN/OUT	50.00						3.18	47.06

Company Name: BHP MINERALS  
 Filename: C:\LR\HW\_IMP\HYD\HW50CN90 User: lr  
 Date: 03-14-1997 Time: 11:01:14  
 HIGHWALL IMPOUNDMENT - 50 ACRE WATERSHED, CN = 90  
 Storm: 1.60 inches, 25 year- 6 hour, Type II-65  
 Hydrograph Convolution Interval: 0.1 hr

=====  
 DETAILED SUBWATERSHED INPUT/OUTPUT TABLE  
 =====

J	B	S	SWS	Seg. #	Land Flow Condition	Distance (ft)	Slope (%)	Velocity (fps)	Segment Time (hr)	Time Conc. (hr)	Muskingum K (hr)	X
1	1	1	1	-a	5	2214.00	4.00	2.00	0.31	0.307		

CIVIL SOFTWARE DESIGN

SEDCAD+ Version 3

HIGHWALL IMPOUNDMENT - 50 ACRE WATERSHED, CN = 86

by

Name: lr

Company Name: BHP MINERALS  
File Name: C:\LR\HW\_IMP\HYD\HW50CN86

Date: 03-14-1997

Company Name: BHP MINERALS  
 Filename: C:\LR\HW\_IMP\HYD\HW50CN86 User: lr  
 Date: 03-14-1997 Time: 11:01:18  
 HIGHWALL IMPOUNDMENT - 50 ACRE WATERSHED, CN = 86  
 Storm: 1.60 inches, 25 year- 6 hour, Type II-65  
 Hydrograph Convolution Interval: 0.1 hr

=====  
 SUBWATERSHED/STRUCTURE INPUT/OUTPUT TABLE  
 =====

-Hydrology-

JBS	SWS	Area (ac)	CN	UHS	Tc (hrs)	K (hrs)	X	Base- Flow (cfs)	Runoff Volume (ac-ft)	Peak Discharge (cfs)	
111	1	50.00	86	M	0.307	0.000	0.000	0.0	2.33	34.53	
				Type: Null		Label: POND					
111	Structure	50.00								2.33	
111	Total IN/OUT	50.00								2.33	34.53

Company Name: BHP MINERALS  
 Filename: C:\LR\HW\_IMP\HYD\HW50CN86 User: lr  
 Date: 03-14-1997 Time: 11:01:18  
 HIGHWALL IMPOUNDMENT - 50 ACRE WATERSHED, CN = 86  
 Storm: 1.60 inches, 25 year- 6 hour, Type II-65  
 Hydrograph Convolution Interval: 0.1 hr

=====  
 DETAILED SUBWATERSHED INPUT/OUTPUT TABLE  
 =====

J	B	S	SWS	Seg. #	Land Flow Condition	Distance (ft)	Slope (%)	Velocity (fps)	Segment Time (hr)	Time Conc. (hr)	Muskingum K (hr)	X
1	1	1	1	-a	5	2214.00	4.00	2.00	0.31	0.307		

CIVIL SOFTWARE DESIGN

SEDCAD+ Version 3

HIGHWALL IMPOUNDMENT - 50 ACRE WATERSHED, CN = 83

by

Name: lr

Company Name: BHP MINERALS  
File Name: C:\LR\HW\_IMP\HYD\HW50CN83

Date: 03-14-1997

Company Name: BHP MINERALS  
 Filename: C:\LR\HW\_IMP\HYD\HW50CN83 User: lr  
 Date: 03-14-1997 Time: 11:01:20  
 HIGHWALL IMPOUNDMENT - 50 ACRE WATERSHED, CN = 83  
 Storm: 1.60 inches, 25 year- 6 hour, Type II-65  
 Hydrograph Convolution Interval: 0.1 hr

=====  
 SUBWATERSHED/STRUCTURE INPUT/OUTPUT TABLE  
 =====

-Hydrology-

JBS	SWS	Area (ac)	CN	UHS	Tc (hrs)	K (hrs)	X	Base- Flow (cfs)	Runoff Volume (ac-ft)	Peak Discharge (cfs)	
111	1	50.00	83	M	0.307	0.000	0.000	0.0	1.82	26.87	
					Type: Null	Label: POND					
111	Structure	50.00									
111	Total IN/OUT	50.00								1.82	26.87

Company Name: BHP MINERALS  
 Filename: C:\LR\HW\_IMP\HYD\HW50CN83 User: lr  
 Date: 03-14-1997 Time: 11:01:20  
 HIGHWALL IMPOUNDMENT - 50 ACRE WATERSHED, CN = 83  
 Storm: 1.60 inches, 25 year- 6 hour, Type II-65  
 Hydrograph Convolution Interval: 0.1 hr

=====  
 DETAILED SUBWATERSHED INPUT/OUTPUT TABLE  
 =====

J	B	S	SWS	Seg. #	Land Flow Condition	Distance (ft)	Slope (%)	Velocity (fps)	Segment Time (hr)	Time Conc. (hr)	Muskingum K (hr)	X
1	1	1	1	-a	5	2214.00	4.00	2.00	0.31	0.307		

CIVIL SOFTWARE DESIGN

SEDCAD+ Version 3

HIGHWALL IMPOUNDMENT - 75 ACRE WATERSHED, CN = 93

by

Name: lr

Company Name: BHP MINERALS  
File Name: C:\LR\HW\_IMP\HYD\HW75CN93

Date: 03-14-1997

Company Name: BHP MINERALS  
 Filename: C:\LR\HW\_IMP\HYD\HW75CN93 User: lr  
 Date: 03-14-1997 Time: 11:01:21  
 HIGHWALL IMPOUNDMENT - 75 ACRE WATERSHED, CN = 93  
 Storm: 1.60 inches, 25 year- 6 hour, Type II-65  
 Hydrograph Convolution Interval: 0.1 hr

=====  
 SUBWATERSHED/STRUCTURE INPUT/OUTPUT TABLE  
 =====

-Hydrology-

JBS SWS	Area (ac)	CN UHS	Tc (hrs)	K (hrs)	X	Base- Flow (cfs)	Runoff Volume (ac-ft)	Peak Discharge (cfs)
111 1	75.00	93 M	0.376	0.000	0.000	0.0	5.96	80.52
		Type: Null		Label: POND				
111 Structure	75.00						5.96	
111 Total IN/OUT	75.00						5.96	80.52

Company Name: BHP MINERALS  
 Filename: C:\LR\HW\_IMP\HYD\HW75CN93 User: lr  
 Date: 03-14-1997 Time: 11:01:21  
 HIGHWALL IMPOUNDMENT - 75 ACRE WATERSHED, CN = 93  
 Storm: 1.60 inches, 25 year- 6 hour, Type II-65  
 Hydrograph Convolution Interval: 0.1 hr

=====  
 DETAILED SUBWATERSHED INPUT/OUTPUT TABLE  
 =====

J	B	S	SWS	Seg. #	Land Flow Condition	Distance (ft)	Slope (%)	Velocity (fps)	Segment Time (hr)	Time Conc. (hr)	Muskingum K (hr)	X
1	1	1	1	-a	5	2711.00	4.00	2.00	0.38	0.376		

CIVIL SOFTWARE DESIGN

SEDCAD+ Version 3

HIGHWALL IMPOUNDMENT - 75 ACRE WATERSHED, CN = 90

by

Name: lr

Company Name: BHP MINERALS  
File Name: C:\LR\HW\_IMP\HYD\HW75CN90

Date: 03-14-1997

Company Name: BHP MINERALS

Filename: C:\LR\HW\_IMP\HYD\HW75CN90 User: lr

Date: 03-14-1997 Time: 11:01:23

HIGHWALL IMPOUNDMENT - 75 ACRE WATERSHED, CN = 90

Storm: 1.60 inches, 25 year- 6 hour, Type II-65

Hydrograph Convolution Interval: 0.1 hr

=====  
 SUBWATERSHED/STRUCTURE INPUT/OUTPUT TABLE  
 =====

-Hydrology-

JBS	SWS	Area (ac)	CN	UHS	Tc (hrs)	K (hrs)	X	Base- Flow (cfs)	Runoff Volume (ac-ft)	Peak Discharge (cfs)	
111	1	75.00	90	M	0.376	0.000	0.000	0.0	4.77	64.24	
					Type: Null	Label: POND					
111	Structure	75.00								4.77	
111	Total IN/OUT	75.00								4.77	64.24

Company Name: BHP MINERALS  
Filename: C:\LR\HW\_IMP\HYD\HW75CN90 User: lr  
Date: 03-14-1997 Time: 11:01:23  
HIGHWALL IMPOUNDMENT - 75 ACRE WATERSHED, CN = 90  
Storm: 1.60 inches, 25 year- 6 hour, Type II-65  
Hydrograph Convolution Interval: 0.1 hr

=====  
DETAILED SUBWATERSHED INPUT/OUTPUT TABLE  
=====

J	B	S	SWS	Seg. #	Land Flow Condition	Distance (ft)	Slope (%)	Velocity (fps)	Segment Time (hr)	Time Conc. (hr)	Muskingum K (hr)	X
1	1	1	1	-a	5	2711.00	4.00	2.00	0.38	0.376		

CIVIL SOFTWARE DESIGN

SEDCAD+ Version 3

HIGHWALL IMPOUNDMENT - 75 ACRE WATERSHED, CN = 86

by

Name: lr

Company Name: BHP MINERALS  
File Name: C:\LR\HW\_IMP\HYD\HW75CN86

Date: 03-14-1997

Company Name: BHP MINERALS  
 Filename: C:\LR\HW\_IMP\HYD\HW75CN86 User: lr  
 Date: 03-14-1997 Time: 11:01:25  
 HIGHWALL IMPOUNDMENT - 75 ACRE WATERSHED, CN = 86  
 Storm: 1.60 inches, 25 year- 6 hour, Type II-65  
 Hydrograph Convolution Interval: 0.1 hr

=====  
 SUBWATERSHED/STRUCTURE INPUT/OUTPUT TABLE  
 =====

-Hydrology-

JBS	SWS	Area (ac)	CN	UHS	Tc (hrs)	K (hrs)	X	Base- Flow (cfs)	Runoff Volume (ac-ft)	Peak Discharge (cfs)	
111	1	75.00	86	M	0.376	0.000	0.000	0.0	3.50	46.73	
					Type: Null		Label: POND				
111	Structure	75.00								3.50	
111	Total IN/OUT	75.00								3.50	46.73

Company Name: BHP MINERALS  
 Filename: C:\LR\HW\_IMP\HYD\HW75CN86 User: lr  
 Date: 03-14-1997 Time: 11:01:25  
 HIGHWALL IMPOUNDMENT - 75 ACRE WATERSHED, CN = 86  
 Storm: 1.60 inches, 25 year- 6 hour, Type II-65  
 Hydrograph Convolution Interval: 0.1 hr

=====

DETAILED SUBWATERSHED INPUT/OUTPUT TABLE

=====

J	B	S	SWS	Seg. #	Land Flow Condition	Distance (ft)	Slope (%)	Velocity (fps)	Segment Time (hr)	Time Conc. (hr)	Muskingum K (hr)	X̄
1	1	1	1	-a	5	2711.00	4.00	2.00	0.38	0.376		

CIVIL SOFTWARE DESIGN

SEDCAD+ Version 3

HIGHWALL IMPOUNDMENT - 75 ACRE WATERSHED, CN = 83

by

Name: lr

Company Name: BHP MINERALS  
File Name: C:\LR\HW\_IMP\HYD\HW75CN83

Date: 03-14-1997

Company Name: BHP MINERALS  
 Filename: C:\LR\HW\_IMP\HYD\HW75CN83 User: lr  
 Date: 03-14-1997 Time: 11:01:27  
 HIGHWALL IMPOUNDMENT - 75 ACRE WATERSHED, CN = 83  
 Storm: 1.60 inches, 25 year- 6 hour, Type II-65  
 Hydrograph Convolution Interval: 0.1 hr

=====  
 SUBWATERSHED/STRUCTURE INPUT/OUTPUT TABLE  
 =====

-Hydrology-

JBS	SWS	Area (ac)	CN	UHS	Tc (hrs)	K (hrs)	X	Base- Flow (cfs)	Runoff Volume (ac-ft)	Peak Discharge (cfs)
111	1	75.00	83	M	0.376	0.000	0.000	0.0	2.73	36.11
					Type: Null		Label: POND			
111	Structure	75.00							2.73	
111	Total IN/OUT	75.00							2.73	36.11

Company Name: BHP MINERALS  
 Filename: C:\LR\HW\_IMP\HYD\HW75CN83 User: lr  
 Date: 03-14-1997 Time: 11:01:27  
 HIGHWALL IMPOUNDMENT - 75 ACRE WATERSHED, CN = 83  
 Storm: 1.60 inches, 25 year- 6 hour, Type II-65  
 Hydrograph Convolution Interval: 0.1 hr

=====  
 DETAILED SUBWATERSHED INPUT/OUTPUT TABLE  
 =====

J	B	S	SWS	Seg. #	Land Flow Condition	Distance (ft)	Slope (%)	Velocity (fps)	Segment Time (hr)	Time Conc. (hr)	Muskingum K (hr)	X
1	1	1	1	-a	5	2711.00	4.00	2.00	0.38	0.376		

CIVIL SOFTWARE DESIGN

SEDCAD+ Version 3

HIGHWALL IMPOUNDMENT - 100 ACRE WATERSHED, CN = 93

by

Name: lr

Company Name: BHP MINERALS  
File Name: C:\LR\HW\_IMP\HYD\HW100C93

Date: 03-14-1997

Company Name: BHP MINERALS  
 Filename: C:\LR\HW\_IMP\HYD\HW100C93 User: lr  
 Date: 03-14-1997 Time: 11:01:28  
 HIGHWALL IMPOUNDMENT - 100 ACRE WATERSHED, CN = 93  
 Storm: 1.60 inches, 25 year- 6 hour, Type II-65  
 Hydrograph Convolution Interval: 0.1 hr

=====  
 SUBWATERSHED/STRUCTURE INPUT/OUTPUT TABLE  
 =====

-Hydrology-

JBS SWS	Area (ac)	CN	UHS	Tc (hrs)	K (hrs)	X	Base- Flow (cfs)	Runoff Volume (ac-ft)	Peak Discharge (cfs)
111 1	100.00	93	M	0.434	0.000	0.000	0.0	7.95	100.17
Type: Null Label: POND									
111 Structure	100.00							7.95	
111 Total IN/OUT	100.00							7.95	100.17

Company Name: BHP MINERALS

Filename: C:\LR\HW\_IMP\HYD\HW100C93 User: lr

Date: 03-14-1997 Time: 11:01:28

HIGHWALL IMPOUNDMENT - 100 ACRE WATERSHED, CN = 93

Storm: 1.60 inches, 25 year- 6 hour, Type II-65

Hydrograph Convolution Interval: 0.1 hr

=====  
DETAILED SUBWATERSHED INPUT/OUTPUT TABLE  
=====

J	B	S	SWS	Seg. #	Land Flow Condition	Distance (ft)	Slope (%)	Velocity (fps)	Segment Time (hr)	Time Conc. (hr)	Muskingum K (hr)	X
1	1	1	1	-a	5	3131.00	4.00	2.00	0.43	0.434		

CIVIL SOFTWARE DESIGN

SEDCAD+ Version 3

HIGHWALL IMPOUNDMENT - 100 ACRE WATERSHED, CN = 90

by

Name: lr

Company Name: BHP MINERALS  
File Name: C:\LR\HW\_IMP\HYD\HW100C90

Date: 03-14-1997

Company Name: BHP MINERALS  
 Filename: C:\LR\HW\_IMP\HYD\HW100C90 User: lr  
 Date: 03-14-1997 Time: 11:01:30  
 HIGHWALL IMPOUNDMENT - 100 ACRE WATERSHED, CN = 90  
 Storm: 1.60 inches, 25 year- 6 hour, Type II-65  
 Hydrograph Convolution Interval: 0.1 hr

=====  
 SUBWATERSHED/STRUCTURE INPUT/OUTPUT TABLE  
 =====

-Hydrology-

JBS	SWS	Area (ac)	CN	UHS	Tc (hrs)	K (hrs)	X	Base- Flow (cfs)	Runoff Volume (ac-ft)	Peak Discharg (cfs)
111	1	100.00	90	M	0.434	0.000	0.000	0.0	6.36	79.46
					Type: Null		Label: POND			
111	Structure	100.00							6.36	
111	Total IN/OUT	100.00							6.36	79.46

Company Name: BHP MINERALS  
 Filename: C:\LR\HW\_IMP\HYD\HW100C90 User: lr  
 Date: 03-14-1997 Time: 11:01:30  
 HIGHWALL IMPOUNDMENT - 100 ACRE WATERSHED, CN = 90  
 Storm: 1.60 inches, 25 year- 6 hour, Type II-65  
 Hydrograph Convolution Interval: 0.1 hr

=====  
 DETAILED SUBWATERSHED INPUT/OUTPUT TABLE  
 =====

J	B	S	SWS	Seg. #	Land Flow Condition	Distance (ft)	Slope (%)	Velocity (fps)	Segment Time (hr)	Time Conc. (hr)	Muskingum K (hr)	X
1	1	1	1	-a	5	3131.00	4.00	2.00	0.43	0.434		

CIVIL SOFTWARE DESIGN

SEDCAD+ Version 3

HIGHWALL IMPOUNDMENT - 100 ACRE WATERSHED, CN = 36

by

Name: lr

Company Name: BHP MINERALS  
File Name: C:\LR\HW\_IMP\HYD\HW100C86

Date: 03-14-1997

Company Name: BHP MINERALS  
 Filename: C:\LR\HW\_IMP\HYD\HW100C86 User: lr  
 Date: 03-14-1997 Time: 11:01:32  
 HIGHWALL IMPOUNDMENT - 100 ACRE WATERSHED, CN = 86  
 Storm: 1.60 inches, 25 year- 6 hour, Type II-65  
 Hydrograph Convolution Interval: 0.1 hr

=====  
 SUBWATERSHED/STRUCTURE INPUT/OUTPUT TABLE  
 =====

-Hydrology-

JBS	SWS	Area (ac)	CN	UHS	Tc (hrs)	K (hrs)	X	Base- Flow (cfs)	Runoff Volume (ac-ft)	Peak Discharge (cfs)	
111	1	100.00	86	M	0.434	0.000	0.000	0.0	4.66	57.58	
				Type: Null		Label: POND					
111	Structure	100.00								4.66	
111	Total IN/OUT	100.00								4.66	57.58

Company Name: BHP MINERALS  
 Filename: C:\LR\HW\_IMP\HYD\HW100C86 User: lr  
 Date: 03-14-1997 Time: 11:01:32  
 HIGHWALL IMPOUNDMENT - 100 ACRE WATERSHED, CN = 86  
 Storm: 1.60 inches, 25 year- 6 hour, Type II-65  
 Hydrograph Convolution Interval: 0.1 hr

=====  
 DETAILED SUBWATERSHED INPUT/OUTPUT TABLE  
 =====

J	B	S	SWS	Seg. #	Land Flow Condition	Distance (ft)	Slope (%)	Velocity (fps)	Segment Time (hr)	Time Conc. (hr)	Muskingum K (hr)	X
1	1	1	1	-a	5	3131.00	4.00	2.00	0.43	0.434		

CIVIL SOFTWARE DESIGN

SEDCAD+ Version 3

HIGHWALL IMPOUNDMENT - 100 ACRE WATERSHED, CN = 83

by

Name: lr

Company Name: BHP MINERALS  
File Name: C:\LR\HW\_IMP\HYD\HW100C83

Date: 03-14-1997

Company Name: BHP MINERALS  
 Filename: C:\LR\HW\_IMP\HYD\HW100C83 User: lr  
 Date: 03-14-1997 Time: 11:01:34  
 HIGHWALL IMPOUNDMENT - 100 ACRE WATERSHED, CN = 83  
 Storm: 1.60 inches, 25 year- 6 hour, Type II-65  
 Hydrograph Convolution Interval: 0.1 hr

=====  
 SUBWATERSHED/STRUCTURE INPUT/OUTPUT TABLE  
 =====

-Hydrology-

JBS	SWS	Area (ac)	CN	UHS	Tc (hrs)	K (hrs)	X	Base- Flow (cfs)	Runoff Volume (ac-ft)	Peak Discharge (cfs)
111	1	100.00	83	M	0.434	0.000	0.000	0.0	3.65	44.25
				Type: Null		Label: POND				
111	Structure	100.00							3.65	
111	Total IN/OUT	100.00							3.65	44.25

Company Name: BHP MINERALS  
 Filename: C:\LR\HW\_IMP\HYD\HW100C83 User: lr  
 Date: 03-14-1997 Time: 11:01:34  
 HIGHWALL IMPOUNDMENT - 100 ACRE WATERSHED, CN = 83  
 Storm: 1.60 inches, 25 year- 6 hour, Type II-65  
 Hydrograph Convolution Interval: 0.1 hr

=====  
 DETAILED SUBWATERSHED INPUT/OUTPUT TABLE  
 =====

J	B	S	SWS	Seg. #	Land Flow Condition	Distance (ft)	Slope (%)	Velocity (fps)	Segment Time (hr)	Time Conc. (hr)	Muskingum K (hr)	X
1	1	1	1	-a	5	3131.00	4.00	2.00	0.43	0.434		

CIVIL SOFTWARE DESIGN

SEDCAD+ Version 3

HIGHWALL IMPOUNDMENT - 150 ACRE WATERSHED, CN = 93

by

Name: lr

Company Name: BHP MINERALS  
File Name: C:\LR\HW\_IMP\HYD\HW150C93

Date: 03-14-1997

Company Name: BHP MINERALS  
 Filename: C:\LR\HW\_IMP\HYD\HW150C93 User: lr  
 Date: 03-14-1997 Time: 11:01:35  
 HIGHWALL IMPOUNDMENT - 150 ACRE WATERSHED, CN = 93  
 Storm: 1.60 inches, 25 year- 6 hour, Type II-65  
 Hydrograph Convolution Interval: 0.1 hr

=====  
 SUBWATERSHED/STRUCTURE INPUT/OUTPUT TABLE  
 =====

-Hydrology-

JBS	SWS	Area (ac)	CN	UHS	Tc (hrs)	K (hrs)	X	Base- Flow (cfs)	Runoff Volume (ac-ft)	Peak Discharge (cfs)
111	1	150.00	93	M	0.532	0.000	0.000	0.0	11.93	134.13
				Type: Null		Label: POND				
111	Structure	150.00							11.93	
111	Total IN/OUT	150.00							11.93	134.13

Company Name: BHP MINERALS  
 Filename: C:\LR\HW\_IMP\HYD\HW150C93 User: lr  
 Date: 03-14-1997 Time: 11:01:35  
 HIGHWALL IMPOUNDMENT - 150 ACRE WATERSHED, CN = 93  
 Storm: 1.60 inches, 25 year- 6 hour, Type II-65  
 Hydrograph Convolution Interval: 0.1 hr

=====  
 DETAILED SUBWATERSHED INPUT/OUTPUT TABLE  
 =====

J	B	S	SWS	Seg. #	Land Flow Condition	Distance (ft)	Slope (%)	Velocity (fps)	Segment Time (hr)	Time Conc. (hr)	Muskingum K (hr)	X
1	1	1	1	-a	5	3834.00	4.00	2.00	0.53	0.532		

CIVIL SOFTWARE DESIGN

SEDCAD+ Version 3

HIGHWALL IMPOUNDMENT - 150 ACRE WATERSHED, CN = 90

by

Name: lr

Company Name: BHP MINERALS  
File Name: C:\LR\HW\_IMP\HYD\HW150C90

Date: 03-14-1997

Company Name: BHP MINERALS  
 Filename: C:\LR\HW\_IMP\HYD\HW150C90 User: lr  
 Date: 03-14-1997 Time: 11:01:37  
 HIGHWALL IMPOUNDMENT - 150 ACRE WATERSHED, CN = 90  
 Storm: 1.60 inches, 25 year- 6 hour, Type II-65  
 Hydrograph Convolution Interval: 0.1 hr

=====  
 SUBWATERSHED/STRUCTURE INPUT/OUTPUT TABLE  
 =====

-Hydrology-

JBS	SWS	Area (ac)	CN	UHS	Tc (hrs)	K (hrs)	X	Base- Flow (cfs)	Runoff Volume (ac-ft)	Peak Discharge (cfs)
111	1	150.00	90	M	0.532	0.000	0.000	0.0	9.53	105.70
Type: Null Label: POND										
111	Structure	150.00							9.53	
111	Total IN/OUT	150.00							9.53	105.70

Company Name: BHP MINERALS  
 Filename: C:\LR\HW\_IMP\HYD\HW150C90 User: lr  
 Date: 03-14-1997 Time: 11:01:37  
 HIGHWALL IMPOUNDMENT - 150 ACRE WATERSHED, CN = 90  
 Storm: 1.60 inches, 25 year- 6 hour, Type II-65  
 Hydrograph Convolution Interval: 0.1 hr

=====  
 DETAILED SUBWATERSHED INPUT/OUTPUT TABLE  
 =====

J	B	S	SWS	Seg. #	Land Flow Condition	Distance (ft)	Slope (%)	Velocity (fps)	Segment Time (hr)	Time Conc. (hr)	Muskingum K (hr)	X
1	1	1	1	-a	5	3834.00	4.00	2.00	0.53	0.532		

CIVIL SOFTWARE DESIGN

SEDCAD+ Version 3

HIGHWALL IMPOUNDMENT - 150 ACRE WATERSHED, CN = 86

by

Name: lr

Company Name: BHP MINERALS  
File Name: C:\LR\HW\_IMP\HYD\HW150C86

Date: 03-14-1997

Company Name: BHP MINERALS  
 Filename: C:\LR\HW\_IMP\HYD\HW150C86 User: lr  
 Date: 03-14-1997 Time: 11:01:39  
 HIGHWALL IMPOUNDMENT - 150 ACRE WATERSHED, CN = 86  
 Storm: 1.60 inches, 25 year- 6 hour, Type II-65  
 Hydrograph Convolution Interval: 0.1 hr

=====  
 SUBWATERSHED/STRUCTURE INPUT/OUTPUT TABLE  
 =====

-Hydrology-

JBS	SWS	Area (ac)	CN	UHS	Tc (hrs)	K (hrs)	X	Base- Flow (cfs)	Runoff Volume (ac-ft)	Peak Discharge (cfs)	
111	1	150.00	86	M	0.532	0.000	0.000	0.0	7.00	76.31	
					Type: Null		Label: POND				
111	Structure	150.00								7.00	
111	Total IN/OUT	150.00								7.00	76.31

Company Name: BHP MINERALS  
 Filename: C:\LR\HW\_IMP\HYD\HW150C86 User: lr  
 Date: 03-14-1997 Time: 11:01:39  
 HIGHWALL IMPOUNDMENT - 150 ACRE WATERSHED, CN = 86  
 Storm: 1.60 inches, 25 year- 6 hour, Type II-65  
 Hydrograph Convolution Interval: 0.1 hr

=====  
 DETAILED SUBWATERSHED INPUT/OUTPUT TABLE  
 =====

J	B	S	SWS	Seg. #	Land Flow Condition	Distance (ft)	Slope (%)	Velocity (fps)	Segment Time (hr)	Time Conc. (hr)	Muskingum K (hr)	X
1	1	1	1	-a	5	3834.00	4.00	2.00	0.53	0.532		

CIVIL SOFTWARE DESIGN

SEDCAD+ Version 3

HIGHWALL IMPOUNDMENT - 150 ACRE WATERSHED, CN = 83

by

Name: lr

Company Name: BHP MINERALS  
File Name: C:\LR\HW\_IMP\HYD\HW150C83

Date: 03-14-1997

Company Name: BHP MINERALS  
 Filename: C:\LR\HW\_IMP\HYD\HW150C83 User: lr  
 Date: 03-14-1997 Time: 11:01:41  
 HIGHWALL IMPOUNDMENT - 150 ACRE WATERSHED, CN = 83  
 Storm: 1.60 inches, 25 year- 6 hour, Type II-65  
 Hydrograph Convolution Interval: 0.1 hr

=====  
 SUBWATERSHED/STRUCTURE INPUT/OUTPUT TABLE  
 =====

-Hydrology-

JBS	SWS	Area (ac)	CN	UHS	Tc (hrs)	K (hrs)	X	Base- Flow (cfs)	Runoff Volume (ac-ft)	Peak Discharge (cfs)
111	1	150.00	83	M	0.532	0.000	0.000	0.0	5.47	58.33
					Type: Null		Label: POND			
111	Structure	150.00							5.47	
111	Total IN/OUT	150.00							5.47	58.33

Company Name: BHP MINERALS  
 Filename: C:\LR\HW\_IMP\HYD\HW150C83 User: lr  
 Date: 03-14-1997 Time: 11:01:41  
 HIGHWALL IMPOUNDMENT - 150 ACRE WATERSHED, CN = 83  
 Storm: 1.60 inches, 25 year- 6 hour, Type II-65  
 Hydrograph Convolution Interval: 0.1 hr

=====

DETAILED SUBWATERSHED INPUT/OUTPUT TABLE

=====

J	B	S	SWS	Seg. #	Land Flow Condition	Distance (ft)	Slope (%)	Velocity (fps)	Segment Time (hr)	Time Conc. (hr)	Muskingum K (hr)	X
1	1	1	1	-a	5	3834.00	4.00	2.00	0.53	0.532		

CIVIL SOFTWARE DESIGN

SEDCAD+ Version 3

HIGHWALL IMPOUNDMENT - 200 ACRE WATERSHED, CN = 93

by

Name: lr

Company Name: BHP MINERALS  
File Name: C:\LR\HW\_IMP\HYD\HW200C93

Date: 03-14-1997

Company Name: BHP MINERALS  
 Filename: C:\LR\HW\_IMP\HYD\HW200C93 User: lr  
 Date: 03-14-1997 Time: 11:01:42  
 HIGHWALL IMPOUNDMENT - 200 ACRE WATERSHED, CN = 93  
 Storm: 1.60 inches, 25 year- 6 hour, Type II-65  
 Hydrograph Convolution Interval: 0.1 hr

=====  
 SUBWATERSHED/STRUCTURE INPUT/OUTPUT TABLE  
 =====

-Hydrology-

JBS	SWS	Area (ac)	CN	UHS	Tc (hrs)	K (hrs)	X	Base- Flow (cfs)	Runoff Volume (ac-ft)	Peak Discharge (cfs)
111	1	200.00	93	M	0.614	0.000	0.000	0.0	15.90	163.75
					Type: Null		Label: POND			
111	Structure	200.00							15.90	
111	Total IN/OUT	200.00							15.90	163.75

Company Name: BHP MINERALS  
 Filename: C:\LR\HW\_IMP\HYD\HW200C93 User: lr  
 Date: 03-14-1997 Time: 11:01:42  
 HIGHWALL IMPOUNDMENT - 200 ACRE WATERSHED, CN = 93  
 Storm: 1.60 inches, 25 year- 6 hour, Type II-65  
 Hydrograph Convolution Interval: 0.1 hr

=====  
 DETAILED SUBWATERSHED INPUT/OUTPUT TABLE  
 =====

J	B	S	SWS	Seg. #	Land Flow Condition	Distance (ft)	Slope (%)	Velocity (fps)	Segment Time (hr)	Time Conc. (hr)	Muskingum K (hr)	X'
1	1	1	1	-a	5	4427.00	4.00	2.00	0.61	0.614		

CIVIL SOFTWARE DESIGN

SEDCAD+ Version 3

HIGHWALL IMPOUNDMENT - 200 ACRE WATERSHED, CN = 90

by

Name: lr

Company Name: BHP MINERALS  
File Name: C:\LR\HW\_IMP\HYD\HW20CC90

Date: 03-14-1997

Company Name: BHP MINERALS  
 Filename: C:\LR\HW\_IMP\HYD\HW200C90 User: lr  
 Date: 03-14-1997 Time: 11:01:48  
 HIGHWALL IMPOUNDMENT - 200 ACRE WATERSHED, CN = 90  
 Storm: 1.60 inches, 25 year- 6 hour, Type II-65  
 Hydrograph Convolution Interval: 0.1 hr

=====  
 SUBWATERSHED/STRUCTURE INPUT/OUTPUT TABLE  
 =====

-Hydrology-

JBS	SWS	Area (ac)	CN	UHS	Tc (hrs)	K (hrs)	X	Base- Flow (cfs)	Runoff Volume (ac-ft)	Peak Discharge (cfs)
111	1	200.00	90	M	0.614	0.000	0.000	0.0	12.71	129.02
					Type: Null		Label: POND			
111	Structure	200.00							12.71	
-----										
111	Total IN/OUT	200.00							12.71	129.02
=====										

Company Name: BHP MINERALS  
 Filename: C:\LR\HW\_IMP\HYD\HW200C90 User: lr  
 Date: 03-14-1997 Time: 11:01:48  
 HIGHWALL IMPOUNDMENT - 200 ACRE WATERSHED, CN = 90  
 Storm: 1.60 inches, 25 year- 6 hour, Type II-65  
 Hydrograph Convolution Interval: 0.1 hr

=====  
 DETAILED SUBWATERSHED INPUT/OUTPUT TABLE  
 =====

J	B	S	SWS	Seg. #	Land Flow Condition	Distance (ft)	Slope (%)	Velocity (fps)	Segment Time (hr)	Time Conc. (hr)	Muskingum K (hr)	X*
1	1	1	1	-a	5	4427.00	4.00	2.00	0.61	0.614		

CIVIL SOFTWARE DESIGN

SEDCAD+ Version 3

HIGHWALL IMPOUNDMENT - 200 ACRE WATERSHED, CN = 86

by

Name: lr

Company Name: BHP MINERALS  
File Name: C:\LR\HW\_IMP\HYD\HW200C86

Date: 03-14-1997

Company Name: BHP MINERALS  
 Filename: C:\LR\HW\_IMP\HYD\HW200C86 User: lr  
 Date: 03-14-1997 Time: 11:01:44  
 HIGHWALL IMPOUNDMENT - 200 ACRE WATERSHED, CN = 86  
 Storm: 1.60 inches, 25 year- 6 hour, Type II-65  
 Hydrograph Convolution Interval: 0.1 hr

=====  
 SUBWATERSHED/STRUCTURE INPUT/OUTPUT TABLE  
 =====

-Hydrology-

JBS	SWS	Area (ac)	CN	UHS	Tc (hrs)	K (hrs)	X	Base- Flow (cfs)	Runoff Volume (ac-ft)	Peak Discharge (cfs)
111	1	200.00	86	M	0.614	0.000	0.000	0.0	9.33	92.72
					Type: Null		Label: POND			
111	Structure	200.00							9.33	
111	Total IN/OUT	200.00							9.33	92.72

Company Name: BHP MINERALS  
 Filename: C:\LR\HW\_IMP\HYD\HW200C86 User: lr  
 Date: 03-14-1997 Time: 11:01:44  
 HIGHWALL IMPOUNDMENT - 200 ACRE WATERSHED, CN = 86  
 Storm: 1.60 inches, 25 year- 6 hour, Type II-65  
 Hydrograph Convolution Interval: 0.1 hr

=====  
 DETAILED SUBWATERSHED INPUT/OUTPUT TABLE  
 =====

J	B	S	SWS	Seg. #	Land Flow Condition	Distance (ft)	Slope (%)	Velocity (fps)	Segment Time (hr)	Time Conc. (hr)	Muskingum K (hr)	X
1	1	1	1	-a	5	4427.00	4.00	2.00	0.61	0.614		

CIVIL SOFTWARE DESIGN

SEDCAD+ Version 3

HIGHWALL IMPOUNDMENT - 200 ACRE WATERSHED, CN = 83

by

Name: lr

Company Name: BHP MINERALS  
File Name: C:\LR\HW\_IMP\HYD\HW200C83

Date: 03-14-1997

Company Name: BHP MINERALS  
 Filename: C:\LR\HW\_IMP\HYD\HW200C83 User: lr  
 Date: 03-14-1997 Time: 11:01:46  
 HIGHWALL IMPOUNDMENT - 200 ACRE WATERSHED, CN = 83  
 Storm: 1.60 inches, 25 year- 6 hour, Type II-65  
 Hydrograph Convolution Interval: 0.1 hr

=====  
 SUBWATERSHED/STRUCTURE INPUT/OUTPUT TABLE  
 =====

-Hydrology-

JBS	SWS	Area (ac)	CN	UHS	Tc (hrs)	K (hrs)	X	Base- Flow (cfs)	Runoff Volume (ac-ft)	Peak Discharge (cfs)
111	1	200.00	83	M	0.614	0.000	0.000	0.0	7.29	70.70
					Type: Null		Label: POND			
111	Structure	200.00							7.29	
111	Total IN/OUT	200.00							7.29	70.70

Company Name: BHP MINERALS  
 Filename: C:\LR\HW\_IMP\HYD\HW200C83 User: lr  
 Date: 03-14-1997 Time: 11:01:46  
 HIGHWALL IMPOUNDMENT - 200 ACRE WATERSHED, CN = 83  
 Storm: 1.60 inches, 25 year- 6 hour, Type II-65  
 Hydrograph Convolution Interval: 0.1 hr

=====

DETAILED SUBWATERSHED INPUT/OUTPUT TABLE

=====

J	B	S	SWS	Seg. #	Land Flow Condition	Distance (ft)	Slope (%)	Velocity (fps)	Segment Time (hr)	Time Conc. (hr)	Muskingum K (hr)	X
1	1	1	1	-a	5	4427.00	4.00	2.00	0.61	0.614		

CIVIL SOFTWARE DESIGN

SEDCAD+ Version 3

HIGHWALL IMPOUNDMENT - 300 ACRE WATERSHED, CN = 93

by

Name: lr

Company Name: BHP MINERALS  
File Name: C:\LR\HW\_IMP\HYD\HW300C93

Date: 03-14-1997

Company Name: BHP MINERALS  
 Filename: C:\LR\HW\_IMP\HYD\HW300C93 User: lr  
 Date: 03-14-1997 Time: 11:27:37  
 HIGHWALL IMPOUNDMENT - 300 ACRE WATERSHED, CN = 93  
 Storm: 1.60 inches, 25 year- 6 hour, Type II-65  
 Hydrograph Convolution Interval: 0.1 hr

=====  
 SUBWATERSHED/STRUCTURE INPUT/OUTPUT TABLE  
 =====

-Hydrology-

JBS SWS	Area (ac)	CN UHS	Tc (hrs)	K (hrs)	X	Base- Flow (cfs)	Runoff Volume (ac-ft)	Peak Discharge (cfs)
111 1	300.00	93 M	0.753	0.000	0.000	0.0	23.85	214.81
		Type: Null		Label: POND				
111 Structure	300.00						23.85	
111 Total IN/OUT	300.00						23.85	214.81

Company Name: BHP MINERALS  
 Filename: C:\LR\HW\_IMP\HYD\HW300C93 User: lr  
 Date: 03-14-1997 Time: 11:27:37  
 HIGHWALL IMPOUNDMENT - 300 ACRE WATERSHED, CN = 93  
 Storm: 1.60 inches, 25 year- 6 hour, Type II-65  
 Hydrograph Convolution Interval: 0.1 hr

=====

DETAILED SUBWATERSHED INPUT/OUTPUT TABLE

=====

J	B	S	SWS	Seg. #	Land Flow Condition	Distance (ft)	Slope (%)	Velocity (fps)	Segment Time (hr)	Time Conc. (hr)	Muskingum K (hr)	X
1	1	1	1	-a	5	5422.00	4.00	2.00	0.75	0.753		

CIVIL SOFTWARE DESIGN

SEDCAD+ Version 3

HIGHWALL IMPOUNDMENT - 300 ACRE WATERSHED, CN = 90

by

Name: lr

Company Name: BHP MINERALS  
File Name: C:\LR\HW\_IMP\HYD\HW300C90

Date: 03-14-1997

Company Name: BHP MINERALS  
 Filename: C:\LR\HW\_IMP\HYD\HW300C90 User: lr  
 Date: 03-14-1997 Time: 11:27:38  
 HIGHWALL IMPOUNDMENT - 300 ACRE WATERSHED, CN = 90  
 Storm: 1.60 inches, 25 year- 6 hour, Type II-65  
 Hydrograph Convolution Interval: 0.1 hr

=====  
 SUBWATERSHED/STRUCTURE INPUT/OUTPUT TABLE  
 =====

-Hydrology-

JBS	SWS	Area (ac)	CN	UHS	Tc (hrs)	K (hrs)	X	Base- Flow (cfs)	Runoff Volume (ac-ft)	Peak Discharge (cfs)
111	1	300.00	90	M	0.753	0.000	0.000	0.0	19.07	169.35
					Type: Null		Label: POND			
111	Structure	300.00							19.07	
111	Total IN/OUT	300.00							19.07	169.35

Company Name: BHP MINERALS  
 Filename: C:\LR\HW\_IMP\HYD\HW300C90 User: lr  
 Date: 03-14-1997 Time: 11:27:38  
 HIGHWALL IMPOUNDMENT - 300 ACRE WATERSHED, CN = 90  
 Storm: 1.60 inches, 25 year- 6 hour, Type II-65  
 Hydrograph Convolution Interval: 0.1 hr

=====

DETAILED SUBWATERSHED INPUT/OUTPUT TABLE

=====

J	B	S	SWS	Seg. #	Land Flow Condition	Distance (ft)	Slope (%)	Velocity (fps)	Segment Time (hr)	Time Conc. (hr)	Muskingum K (hr)	X
1	1	1	1	-a	5	5422.00	4.00	2.00	0.75	0.753		

CIVIL SOFTWARE DESIGN

SEDCAD+ Version 3

HIGHWALL IMPOUNDMENT - 300 ACRE WATERSHED, CN = 86

by

Name: lr

Company Name: BHP MINERALS  
File Name: C:\LR\HW\_IMP\HYD\HW300C86

Date: 03-14-1997

Company Name: BHP MINERALS  
 Filename: C:\LR\HW\_IMP\HYD\HW300C86 User: lr  
 Date: 03-14-1997 Time: 11:27:40  
 HIGHWALL IMPOUNDMENT - 300 ACRE WATERSHED, CN = 86  
 Storm: 1.60 inches, 25 year- 6 hour, Type II-65  
 Hydrograph Convolution Interval: 0.1 hr

=====  
 SUBWATERSHED/STRUCTURE INPUT/OUTPUT TABLE  
 =====

-Hydrology-

JBS SWS	Area (ac)	CN UHS	Tc (hrs)	K (hrs)	X	Base- Flow (cfs)	Runoff Volume (ac-ft)	Peak Discharge (cfs)
111 1	300.00	86 M	0.753	0.000	0.000	0.0	13.99	121.18
		Type: Null		Label: POND				
111 Structure	300.00						13.99	
111 Total IN/OUT	300.00						13.99	121.18

Company Name: BHP MINERALS  
 Filename: C:\LR\HW\_IMP\HYD\HW300C86 User: lr  
 Date: 03-14-1997 Time: 11:27:40  
 HIGHWALL IMPOUNDMENT - 300 ACRE WATERSHED, CN = 86  
 Storm: 1.60 inches, 25 year- 6 hour, Type II-65  
 Hydrograph Convolution Interval: 0.1 hr

=====  
 DETAILED SUBWATERSHED INPUT/OUTPUT TABLE  
 =====

J	B	S	SWS	Seg. #	Land Flow Condition	Distance (ft)	Slope (%)	Velocity (fps)	Segment Time (hr)	Time Conc. (hr)	Muskingum K (hr)	X
1	1	1	1	-a	5	5422.00	4.00	2.00	0.75	0.753		

CIVIL SOFTWARE DESIGN

SEDCAD+ Version 3

HIGHWALL IMPOUNDMENT - 300 ACRE WATERSHED, CN = 83

by

Name: lr

Company Name: BHP MINERALS  
File Name: C:\LR\HW\_IMP\HYD\HW300C83

Date: 03-14-1997

Company Name: BHP MINERALS  
 Filename: C:\LR\HW\_IMP\HYD\HW300C83 User: lr  
 Date: 03-14-1997 Time: 11:27:42  
 HIGHWALL IMPOUNDMENT - 300 ACRE WATERSHED, CN = 83  
 Storm: 1.60 inches, 25 year- 6 hour, Type II-65  
 Hydrograph Convolution Interval: 0.1 hr

=====  
 SUBWATERSHED/STRUCTURE INPUT/OUTPUT TABLE  
 =====

-Hydrology-

JBS	SWS	Area (ac)	CN	UHS	Tc (hrs)	K (hrs)	X	Base- Flow (cfs)	Runoff Volume (ac-ft)	Peak Discharge (cfs)
111	1	300.00	83	M	0.753	0.000	0.000	0.0	10.94	92.22
Type: Null Label: POND										
111	Structure	300.00							10.94	
111	Total IN/OUT	300.00							10.94	92.22

Company Name: BHP MINERALS  
 Filename: C:\LR\HW\_IMP\HYD\HW300C83 User: lr  
 Date: 03-14-1997 Time: 11:27:42  
 HIGHWALL IMPOUNDMENT - 300 ACRE WATERSHED, CN = 83  
 Storm: 1.60 inches, 25 year- 6 hour, Type II-65  
 Hydrograph Convolution Interval: 0.1 hr

=====

DETAILED SUBWATERSHED INPUT/OUTPUT TABLE

=====

J	B	S	SWS	Seg. #	Land Flow Condition	Distance (ft)	Slope (%)	Velocity (fps)	Segment Time (hr)	Time Conc. (hr)	Muskingum K (hr)	X'
1	1	1	1	-a	5	5422.00	4.00	2.00	0.75	0.753		

CIVIL SOFTWARE DESIGN

SEDCAD+ Version 3

HIGHWALL IMPOUNDMENT - 400 ACRE WATERSHED, CN = 93

by

Name: lr

Company Name: BHP MINERALS  
File Name: C:\LR\HW\_IMP\HYD\HW400C93

Date: 03-14-1997

Company Name: BHP MINERALS  
 Filename: C:\LR\HW\_IMP\HYD\HW400C93 User: lr  
 Date: 03-14-1997 Time: 11:27:44  
 HIGHWALL IMPOUNDMENT - 400 ACRE WATERSHED, CN = 93  
 Storm: 1.60 inches, 25 year- 6 hour, Type II-65  
 Hydrograph Convolution Interval: 0.1 hr

=====  
 SUBWATERSHED/STRUCTURE INPUT/OUTPUT TABLE  
 =====

-Hydrology-

JBS	SWS	Area (ac)	CN	UHS	Tc (hrs)	K (hrs)	X	Base- Flow (cfs)	Runoff Volume (ac-ft)	Peak Discharge (cfs)
111	1	400.00	93	M	0.869	0.000	0.000	0.0	31.80	259.47
Type: Null Label: POND										
111	Structure	400.00							31.80	
111	Total IN/OUT	400.00							31.80	259.47

Company Name: BHP MINERALS  
 Filename: C:\LR\HW\_IMP\HYD\HW400C93 User: lr  
 Date: 03-14-1997 Time: 11:27:44  
 HIGHWALL IMPOUNDMENT - 400 ACRE WATERSHED, CN = 93  
 Storm: 1.60 inches, 25 year- 6 hour, Type II-65  
 Hydrograph Convolution Interval: 0.1 hr

=====  
 DETAILED SUBWATERSHED INPUT/OUTPUT TABLE  
 =====

J	B	S	SWS	Seg. #	Land Flow Condition	Distance (ft)	Slope (%)	Velocity (fps)	Segment Time (hr)	Time Conc. (hr)	Muskingum K (hr)	X
1	1	1	1	-a	5	6261.00	4.00	2.00	0.87	0.869		

CIVIL SOFTWARE DESIGN

SEDCAD+ Version 3

HIGHWALL IMPOUNDMENT - 400 ACRE WATERSHED, CN = 90

by

Name: lr

Company Name: BHP MINERALS  
File Name: C:\LR\HW\_IMP\HYD\HW400C90

Date: 03-14-1997

Company Name: BHP MINERALS

Filename: C:\LR\HW\_IMP\HYD\HW400C90 User: lr

Date: 03-14-1997 Time: 11:27:46

HIGHWALL IMPOUNDMENT - 400 ACRE WATERSHED, CN = 90

Storm: 1.60 inches, 25 year- 6 hour, Type II-65

Hydrograph Convolution Interval: 0.1 hr

=====  
 SUBWATERSHED/STRUCTURE INPUT/OUTPUT TABLE  
 =====

-Hydrology-

JBS	SWS	Area (ac)	CN	UHS	Tc (hrs)	K (hrs)	X	Base- Flow (cfs)	Runoff Volume (ac-ft)	Peak Discharge (cfs)
111	1	400.00	90	M	0.869	0.000	0.000	0.0	25.42	204.67
				Type: Null		Label: POND				
111	Structure	400.00							25.42	
111	Total IN/OUT	400.00							25.42	204.67

Company Name: BHP MINERALS  
 Filename: C:\LR\HW\_IMP\HYD\HW400C90 User: lr  
 Date: 03-14-1997 Time: 11:27:46  
 HIGHWALL IMPOUNDMENT - 400 ACRE WATERSHED, CN = 90  
 Storm: 1.60 inches, 25 year- 6 hour, Type II-65  
 Hydrograph Convolution Interval: 0.1 hr

=====  
 DETAILED SUBWATERSHED INPUT/OUTPUT TABLE  
 =====

J	B	S	SWS	Seg. #	Land Flow Condition	Distance (ft)	Slope (%)	Velocity (fps)	Segment Time (hr)	Time Conc. (hr)	Muskingum K (hr)	X
1	1	1	1	-a	5	6261.00	4.00	2.00	0.87	0.869		

CIVIL SOFTWARE DESIGN

SEDCAD+ Version 3

HIGHWALL IMPOUNDMENT - 400 ACRE WATERSHED, CN = 86

by

Name: lr

Company Name: BHP MINERALS  
File Name: C:\LR\HW\_IMP\HYD\HW400C86

Date: 03-14-1997

Company Name: BHP MINERALS  
 Filename: C:\LR\HW\_IMP\HYD\HW400C86 User: lr  
 Date: 03-14-1997 Time: 11:27:47  
 HIGHWALL IMPOUNDMENT - 400 ACRE WATERSHED, CN = 86  
 Storm: 1.60 inches, 25 year- 6 hour, Type II-65  
 Hydrograph Convolution Interval: 0.1 hr

=====  
 SUBWATERSHED/STRUCTURE INPUT/OUTPUT TABLE  
 =====

-Hydrology-

JBS	SWS	Area (ac)	CN	UHS	Tc (hrs)	K (hrs)	X	Base- Flow (cfs)	Runoff Volume (ac-ft)	Peak Discharge (cfs)
111	1	400.00	86	M	0.869	0.000	0.000	0.0	18.65	146.21
				Type: Null		Label: POND				
111	Structure	400.00							18.65	
111	Total IN/OUT	400.00							18.65	146.21

Company Name: BHP MINERALS  
 Filename: C:\LR\HW\_IMP\HYD\HW400C86 User: lr  
 Date: 03-14-1997 Time: 11:27:47

HIGHWALL IMPOUNDMENT - 400 ACRE WATERSHED, CN = 86  
 Storm: 1.60 inches, 25 year- 6 hour, Type II-65  
 Hydrograph Convolution Interval: 0.1 hr

=====

DETAILED SUBWATERSHED INPUT/OUTPUT TABLE

=====

J	B	S	SWS	Seg. #	Land Flow Condition	Distance (ft)	Slope (%)	Velocity (fps)	Segment Time (hr)	Time Conc. (hr)	Muskingum K (hr)	X
1	1	1	1	-a	5	6261.00	4.00	2.00	0.87	0.869		

CIVIL SOFTWARE DESIGN

SEDCAD+ Version 3

HIGHWALL IMPOUNDMENT - 400 ACRE WATERSHED, CN = 83

by

Name: lr

Company Name: BHP MINERALS  
File Name: C:\LR\HW\_IMP\HYD\HW400C83

Date: 03-14-1997

Company Name: BHP MINERALS  
 Filename: C:\LR\HW\_IMP\HYD\HW400C83 User: lr  
 Date: 03-14-1997 Time: 11:27:49  
 HIGHWALL IMPOUNDMENT - 400 ACRE WATERSHED, CN = 83  
 Storm: 1.60 inches, 25 year- 6 hour, Type II-65  
 Hydrograph Convolution Interval: 0.1 hr

=====  
 SUBWATERSHED/STRUCTURE INPUT/OUTPUT TABLE  
 =====

-Hydrology-

JBS	SWS	Area (ac)	CN	UHS	Tc (hrs)	K (hrs)	X	Base- Flow (cfs)	Runoff Volume (ac-ft)	Peak Discharg (cfs)
111	1	400.00	83	M	0.869	0.000	0.000	0.0	14.58	111.64
				Type: Null		Label: POND				
111	Structure	400.00							14.58	
111	Total IN/OUT	400.00							14.58	111.64

Company Name: BHP MINERALS

Filename: C:\LR\HW\_IMP\HYD\HW400C83 User: lr

Date: 03-14-1997 Time: 11:27:49

HIGHWALL IMPOUNDMENT - 400 ACRE WATERSHED, CN = 83

Storm: 1.60 inches, 25 year- 6 hour, Type II-65

Hydrograph Convolution Interval: 0.1 hr

=====

DETAILED SUBWATERSHED INPUT/OUTPUT TABLE

=====

J	B	S	SWS	Seg. #	Land Flow Condition	Distance (ft)	Slope (%)	Velocity (fps)	Segment Time (hr)	Time Conc. (hr)	Muskingum K (hr)	X
1	1	1	1	-a	5	6261.00	4.00	2.00	0.87	0.869		

CIVIL SOFTWARE DESIGN

SEDCAD+ Version 3

HIGHWALL IMPOUNDMENT - 500 ACRE WATERSHED, CN = 93

by

Name: lr

Company Name: BHP MINERALS  
File Name: C:\LR\HW\_IMP\HYD\HW500C93

Date: 03-14-1997

Company Name: BHP MINERALS  
 Filename: C:\LR\HW\_IMP\HYD\HW500C93 User: lr  
 Date: 03-14-1997 Time: 11:27:51  
 HIGHWALL IMPOUNDMENT - 500 ACRE WATERSHED, CN = 93  
 Storm: 1.60 inches, 25 year- 6 hour, Type II-65  
 Hydrograph Convolution Interval: 0.1 hr

=====  
 SUBWATERSHED/STRUCTURE INPUT/OUTPUT TABLE  
 =====

-Hydrology-

JBS	SWS	Area (ac)	CN	UHS	Tc (hrs)	K (hrs)	X	Base- Flow (cfs)	Runoff Volume (ac-ft)	Peak Discharge (cfs)
111	1	500.00	93	M	0.972	0.000	0.000	0.0	39.75	300.19
				Type: Null	Label: POND					
111	Structure	500.00							39.75	
111	Total IN/OUT	500.00							39.75	300.19

Company Name: BHP MINERALS  
 Filename: C:\LR\HW\_IMP\HYD\HW500C93 User: lr  
 Date: 03-14-1997 Time: 11:27:51  
 HIGHWALL IMPOUNDMENT - 500 ACRE WATERSHED, CN = 93  
 Storm: 1.60 inches, 25 year- 6 hour, Type II-65  
 Hydrograph Convolution Interval: 0.1 hr

=====  
 DETAILED SUBWATERSHED INPUT/OUTPUT TABLE  
 =====

J	B	S	SWS	Seg. #	Land Flow Condition	Distance (ft)	Slope (%)	Velocity (fps)	Segment Time (hr)	Time Conc. (hr)	Muskingum K (hr)	X'
1	1	1	1	-a	5	7000.00	4.00	2.00	0.97	0.972		

CIVIL SOFTWARE DESIGN

SEDCAD+ Version 3

HIGHWALL IMPOUNDMENT - 500 ACRE WATERSHED, CN = 90

by

Name: lr

Company Name: BHP MINERALS  
File Name: C:\LR\HW\_IMP\HYD\HW500C90

Date: 03-14-1997

Company Name: BHP MINERALS  
 Filename: C:\LR\HW\_IMP\HYD\HW500C90 User: lr  
 Date: 03-14-1997 Time: 11:27:53  
 HIGHWALL IMPOUNDMENT - 500 ACRE WATERSHED, CN = 90  
 Storm: 1.60 inches, 25 year- 6 hour, Type II-65  
 Hydrograph Convolution Interval: 0.1 hr

=====  
 SUBWATERSHED/STRUCTURE INPUT/OUTPUT TABLE  
 =====

-Hydrology-

JBS	SWS	Area (ac)	CN	UHS	Tc (hrs)	K (hrs)	X	Base- Flow (cfs)	Runoff Volume (ac-ft)	Peak Discharge (cfs)
111	1	500.00	90	M	0.972	0.000	0.000	0.0	31.78	236.53
					Type: Null		Label: POND			
111	Structure	500.00							31.78	
111	Total IN/OUT	500.00							31.78	236.53

Company Name: BHP MINERALS  
 Filename: C:\LR\HW\_IMP\HYD\HW500C90 User: lr  
 Date: 03-14-1997 Time: 11:27:53  
 HIGHWALL IMPOUNDMENT - 500 ACRE WATERSHED, CN = 90  
 Storm: 1.60 inches, 25 year- 6 hour, Type II-65  
 Hydrograph Convolution Interval: 0.1 hr

=====  
 DETAILED SUBWATERSHED INPUT/OUTPUT TABLE  
 =====

J	B	S	SWS	Seg. #	Land Flow Condition	Distance (ft)	Slope (%)	Velocity (fps)	Segment Time (hr)	Time Conc. (hr)	Muskingum K (hr)	X
1	1	1	1	-a	5	7000.00	4.00	2.00	0.97	0.972		

CIVIL SOFTWARE DESIGN

SEDCAD+ Version 3

HIGHWALL IMPOUNDMENT - 500 ACRE WATERSHED, CN = 86

by

Name: lr

Company Name: BHP MINERALS  
File Name: C:\LR\HW\_IMP\HYD\HW500C86

Date: 03-14-1997

Company Name: BHP MINERALS  
 Filename: C:\LR\HW\_IMP\HYD\HW500C86 User: lr  
 Date: 03-14-1997 Time: 11:27:55  
 HIGHWALL IMPOUNDMENT - 500 ACRE WATERSHED, CN = 86  
 Storm: 1.60 inches, 25 year- 6 hour, Type II-65  
 Hydrograph Convolution Interval: 0.1 hr

=====  
 SUBWATERSHED/STRUCTURE INPUT/OUTPUT TABLE  
 =====

-Hydrology-

JBS SWS	Area (ac)	CN UHS	Tc (hrs)	K (hrs)	X	Base- Flow (cfs)	Runoff Volume (ac-ft)	Peak Discharge (cfs)
111 1	500.00	86 M	0.972	0.000	0.000	0.0	23.32	168.87
		Type: Null		Label: POND				
111 Structure	500.00						23.32	
111 Total IN/OUT	500.00						23.32	168.87

Company Name: BHP MINERALS  
 Filename: C:\LR\HW\_IMP\HYD\HW500C86 User: lr  
 Date: 03-14-1997 Time: 11:27:55  
 HIGHWALL IMPOUNDMENT - 500 ACRE WATERSHED, CN = 86  
 Storm: 1.60 inches, 25 year- 6 hour, Type II-65  
 Hydrograph Convolution Interval: 0.1 hr

=====  
 DETAILED SUBWATERSHED INPUT/OUTPUT TABLE  
 =====

J	B	S	SWS	Seg. #	Land Flow Condition	Distance (ft)	Slope (%)	Velocity (fps)	Segment Time (hr)	Time Conc. (hr)	Muskingum K	X
1	1	1	1	-a	5	7000.00	4.00	2.00	0.97	0.972		

CIVIL SOFTWARE DESIGN

SEDCAD+ Version 3

HIGHWALL IMPOUNDMENT - 500 ACRE WATERSHED, CN = 83

by

Name: lr

Company Name: BHP MINERALS  
File Name: C:\LR\HW\_IMP\HYD\HW500C83

Date: 03-14-1997

Company Name: BHP MINERALS  
 Filename: C:\LR\HW\_IMP\HYD\HW500C83 User: lr  
 Date: 03-14-1997 Time: 11:27:58  
 HIGHWALL IMPOUNDMENT - 500 ACRE WATERSHED, CN = 83  
 Storm: 1.60 inches, 25 year- 6 hour, Type II-65  
 Hydrograph Convolution Interval: 0.1 hr

=====  
 SUBWATERSHED/STRUCTURE INPUT/OUTPUT TABLE  
 =====

-Hydrology-

JBS	SWS	Area (ac)	CN	UHS	Tc (hrs)	K (hrs)	X	Base- Flow (cfs)	Runoff Volume (ac-ft)	Peak Discharge (cfs)
111	1	500.00	83	M	0.972	0.000	0.000	0.0	18.23	129.07
				Type: Null		Label: POND				
111	Structure	500.00							18.23	
111	Total IN/OUT	500.00							18.23	129.07

Company Name: BHP MINERALS  
 Filename: C:\LR\HW\_IMP\HYD\HW500C83 User: lr  
 Date: 03-14-1997 Time: 11:27:58  
 HIGHWALL IMPOUNDMENT - 500 ACRE WATERSHED, CN = 83  
 Storm: 1.60 inches, 25 year- 6 hour, Type II-65  
 Hydrograph Convolution Interval: 0.1 hr

=====  
 DETAILED SUBWATERSHED INPUT/OUTPUT TABLE  
 =====

J	B	S	SWS	Seg. #	Land Flow Condition	Distance (ft)	Slope (%)	Velocity (fps)	Segment Time (hr)	Time Conc. (hr)	Muskingum K (hr)	X
1	1	1	1	-a	5	7000.00	4.00	2.00	0.97	0.972		

CIVIL SOFTWARE DESIGN

SEDCAD+ Version 3

HIGHWALL IMPOUNDMENT - 600 ACRE WATERSHED, CN = 93

by

Name: lr

Company Name: BHP MINERALS  
File Name: C:\LR\HW\_IMP\HYD\HW600C93

Date: 03-14-1997

Company Name: BHP MINERALS  
 Filename: C:\LR\HW\_IMP\HYD\HW600C93 User: lr  
 Date: 03-14-1997 Time: 11:27:56  
 HIGHWALL IMPOUNDMENT - 600 ACRE WATERSHED, CN = 93  
 Storm: 1.60 inches, 25 year- 6 hour, Type II-65  
 Hydrograph Convolution Interval: 0.1 hr

=====  
 SUBWATERSHED/STRUCTURE INPUT/OUTPUT TABLE  
 =====

-Hydrology-

JBS	SWS	Area (ac)	CN	UHS	Tc (hrs)	K (hrs)	X	Base- Flow (cfs)	Runoff Volume (ac-ft)	Peak Discharge (cfs)
111	1	600.00	93	M	1.065	0.000	0.000	0.0	47.70	337.42
					Type: Null		Label: POND			
111	Structure	600.00							47.70	
111	Total IN/OUT	600.00							47.70	337.42

Company Name: BHP MINERALS

Filename: C:\LR\HW\_IMP\HYD\HW600C93 User: lr

Date: 03-14-1997 Time: 11:27:56

HIGHWALL IMPOUNDMENT - 500 ACRE WATERSHED, CN = 93

Storm: 1.60 inches, 25 year- 6 hour, Type II-65

Hydrograph Convolution Interval: 0.1 hr

=====  
 DETAILED SUBWATERSHED INPUT/OUTPUT TABLE  
 =====

J	B	S	SWS	Seg. #	Land Flow Condition	Distance (ft)	Slope (%)	Velocity (fps)	Segment Time (hr)	Time Conc. (hr)	Muskingum K (hr)	X
1	1	1	1	-a	5	7668.00	4.00	2.00	1.07	1.065		

CIVIL SOFTWARE DESIGN

SEDCAD+ Version 3

HIGHWALL IMPOUNDMENT - 600 ACRE WATERSHED, CN = 90

by

Name: lr

Company Name: BHP MINERALS  
File Name: C:\LR\HW\_IMP\HYD\HW600C90

Date: 03-14-1997

Company Name: BHP MINERALS  
 Filename: C:\LR\HW\_IMP\HYD\HW600C90 User: lr  
 Date: 03-14-1997 Time: 11:28:00  
 HIGHWALL IMPOUNDMENT - 600 ACRE WATERSHED, CN = 90  
 Storm: 1.60 inches, 25 year- 6 hour, Type II-65  
 Hydrograph Convolution Interval: 0.1 hr

=====  
 SUBWATERSHED/STRUCTURE INPUT/OUTPUT TABLE  
 =====

-Hydrology-

JBS	SWS	Area (ac)	CN	UHS	Tc (hrs)	K (hrs)	X	Base- Flow (cfs)	Runoff Volume (ac-ft)	Peak Discharge (cfs)
111	1	600.00	90	M	1.065	0.000	0.000	0.0	38.13	265.69
				Type: Null		Label: POND				
111	Structure	600.00							38.13	
111	Total IN/OUT	600.00							38.13	265.69

Company Name: BHP MINERALS  
Filename: C:\LR\HW\_IMP\EYD\HW600C90 User: lr  
Date: 03-14-1997 Time: 11:28:00  
HIGHWALL IMPOUNDMENT - 600 ACRE WATERSHED, CN = 90  
Storm: 1.60 inches, 25 year- 6 hour, Type II-65  
Hydrograph Convolution Interval: 0.1 hr

=====  
DETAILED SUBWATERSHED INPUT/OUTPUT TABLE  
=====

J	B	S	SWS	Seg. #	Land Flow Condition	Distance (ft)	Slope (%)	Velocity (fps)	Segment Time (hr)	Time Conc. (hr)	Muskingum K (hr)	X
1	1	1	1	-a	5	7668.00	4.00	2.00	1.07	1.065		

CIVIL SOFTWARE DESIGN

SEDCAD+ Version 3

HIGHWALL IMPOUNDMENT - 600 ACRE WATERSHED, CN = 86

by

Name: lr

Company Name: BHP MINERALS  
File Name: C:\LR\HW\_IMP\HYD\HW600C86

Date: 03-14-1997

Company Name: BHP MINERALS  
 Filename: C:\LR\HW\_IMP\HYD\HW600C86 User: lr  
 Date: 03-14-1997 Time: 11:28:02  
 HIGHWALL IMPOUNDMENT - 600 ACRE WATERSHED, CN = 86  
 Storm: 1.60 inches, 25 year- 6 hour, Type II-65  
 Hydrograph Convolution Interval: 0.1 hr

=====  
 SUBWATERSHED/STRUCTURE INPUT/OUTPUT TABLE  
 =====

-Hydrology-

JBS	SWS	Area (ac)	CN	UHS	Tc (hrs)	K (hrs)	X	Base- Flow (cfs)	Runoff Volume (ac-ft)	Peak Discharge (cfs)
111	1	600.00	86	M	1.065	0.000	0.000	0.0	27.98	189.64
				Type: Null		Label: POND				
111	Structure	600.00							27.98	
111	Total IN/OUT	600.00							27.98	189.64

Company Name: BHP MINERALS  
 Filename: C:\LR\HW\_IMP\HYD\HW600C86 User: lr  
 Date: 03-14-1997 Time: 11:28:02  
 HIGHWALL IMPOUNDMENT - 600 ACRE WATERSHED, CN = 86  
 Storm: 1.60 inches, 25 year- 6 hour, Type II-65  
 Hydrograph Convolution Interval: 0.1 hr

=====  
 DETAILED SUBWATERSHED INPUT/OUTPUT TABLE  
 =====

J	B	S	SWS	Seg. #	Land Flow Condition	Distance (ft)	Slope (%)	Velocity (fps)	Segment Time (hr)	Time Conc. (hr)	Muskingum K (hr)	X
1	1	1	1	-a	5	7668.00	4.00	2.00	1.07	1.065		

CIVIL SOFTWARE DESIGN

SEDCAD+ Version 3

HIGHWALL IMPOUNDMENT - 600 ACRE WATERSHED, CN = 83

by

Name: lr

Company Name: BHP MINERALS  
File Name: C:\LR\HW\_IMP\HYD\HW600C83

Date: 03-14-1997

Company Name: BHP MINERALS  
 Filename: C:\LR\HW\_IMP\HYD\HW600C83 User: lr  
 Date: 03-14-1997 Time: 11:28:04  
 HIGHWALL IMPOUNDMENT - 600 ACRE WATERSHED, CN = 83  
 Storm: 1.60 inches, 25 year- 6 hour, Type II-65  
 Hydrograph Convolution Interval: 0.1 hr

=====  
 SUBWATERSHED/STRUCTURE INPUT/OUTPUT TABLE  
 =====

-Hydrology-

JBS	SWS	Area (ac)	CN	UHS	Tc (hrs)	K (hrs)	X	Base- Flow (cfs)	Runoff Volume (ac-ft)	Peak Discharge (cfs)
111	1	600.00	83	M	1.065	0.000	0.000	0.0	21.88	145.05
				Type: Null		Label: POND				
111	Structure	600.00							21.88	
111	Total IN/OUT	600.00							21.88	145.05

Company Name: BHP MINERALS  
 Filename: C:\LR\HW\_IMP\HYD\HW600C83 User: lr  
 Date: 03-14-1997 Time: 11:28:04  
 HIGHWALL IMPOUNDMENT - 600 ACRE WATERSHED, CN = 83  
 Storm: 1.60 inches, 25 year- 6 hour, Type II-65  
 Hydrograph Convolution Interval: 0.1 hr

=====  
 DETAILED SUBWATERSHED INPUT/OUTPUT TABLE  
 =====

J	B	S	SWS	Seg. #	Land Flow Condition	Distance (ft)	Slope (%)	Velocity (fps)	Segment Time (hr)	Time Conc. (hr)	Muskingum K (hr)	X
1	1	1	1	-a	5	7668.00	4.00	2.00	1.07	1.065		

CIVIL SOFTWARE DESIGN

SEDCAD+ Version 3

HIGHWALL IMPOUNDMENT - 700 ACRE WATERSHED, CN = 93

by

Name: lr

Company Name: BHP MINERALS  
File Name: C:\LR\HW\_IMP\HYD\HW700C93

Date: 03-14-1997

Company Name: BHP MINERALS  
 Filename: C:\LR\HW\_IMP\HYD\HW700C93 User: lr  
 Date: 03-14-1997 Time: 11:28:05  
 HIGHWALL IMPOUNDMENT - 700 ACRE WATERSHED, CN = 93  
 Storm: 1.60 inches, 25 year- 6 hour, Type II-65  
 Hydrograph Convolution Interval: 0.1 hr

=====  
 SUBWATERSHED/STRUCTURE INPUT/OUTPUT TABLE  
 =====

-Hydrology-

JBS	SWS	Area (ac)	CN	UHS	Tc (hrs)	K (hrs)	X	Base- Flow (cfs)	Runoff Volume (ac-ft)	Peak Discharge (cfs)
111	1	700.00	93	M	1.150	0.000	0.000	0.0	55.65	372.07
Type: Null Label: POND										
111	Structure	700.00							55.65	
111	Total IN/OUT	700.00							55.65	372.07

Company Name: BHP MINERALS

Filename: C:\LR\HW\_IMP\HYD\HW700C93 User: lr

Date: 03-14-1997 Time: 11:28:05

HIGHWALL IMPOUNDMENT - 700 ACRE WATERSHED, CN = 93

Storm: 1.60 inches, 25 year- 6 hour, Type II-65

Hydrograph Convolution Interval: 0.1 hr

=====  
 DETAILED SUBWATERSHED INPUT/OUTPUT TABLE  
 =====

J	B	S	SWS	Seg. #	Land Flow Condition	Distance (ft)	Slope (%)	Velocity (fps)	Segment Time (hr)	Time Conc. (hr)	Muskingum K (hr)	X
1	1	1	1	-a	5	8283.00	4.00	2.00	1.15	1.150		

CIVIL SOFTWARE DESIGN

SEDCAD+ Version 3

HIGHWALL IMPOUNDMENT - 700 ACRE WATERSHED, CN = 90

by

Name: lr

Company Name: BHP MINERALS  
File Name: C:\LR\HW\_IMP\HYD\HW700C90

Date: 03-14-1997

Company Name: BHP MINERALS

Filename: C:\LR\HW\_IMP\HYD\HW700C90 User: lr

Date: 03-14-1997 Time: 11:28:07

HIGHWALL IMPOUNDMENT - 700 ACRE WATERSHED, CN = 90

Storm: 1.60 inches, 25 year- 6 hour, Type II-65

Hydrograph Convolution Interval: 0.1 hr

=====  
 SUBWATERSHED/STRUCTURE INPUT/OUTPUT TABLE  
 =====

-Hydrology-

JBS	SWS	Area (ac)	CN	UHS	Tc (hrs)	K (hrs)	X	Base- Flow (cfs)	Runoff Volume (ac-ft)	Peak Discharge (cfs)
111	1	700.00	90	M	1.150	0.000	0.000	0.0	44.49	292.85
				Type: Null		Label: POND				
111	Structure	700.00							44.49	
111	Total IN/OUT	700.00							44.49	292.85

Company Name: BHP MINERALS  
 Filename: C:\LR\HW\_IMP\HYD\HW700C90 User: lr  
 Date: 03-14-1997 Time: 11:28:07  
 HIGHWALL IMPOUNDMENT - 700 ACRE WATERSHED, CN = 90  
 Storm: 1.60 inches, 25 year- 6 hour, Type II-65  
 Hydrograph Convolution Interval: 0.1 hr

=====  
 DETAILED SUBWATERSHED INPUT/OUTPUT TABLE  
 =====

J	B	S	SWS	Seg. #	Land Flow Condition	Distance (ft)	Slope (%)	Velocity (fps)	Segment Time (hr)	Time Conc. (hr)	Muskingum K (hr)	X
1	1	1	1	-a	5	8283.00	4.00	2.00	1.15	1.150		

CIVIL SOFTWARE DESIGN

SEDCAD+ Version 3

HIGHWALL IMPOUNDMENT - 700 ACRE WATERSHED, CN = 86

by

Name: lr

Company Name: BHP MINERALS  
File Name: C:\LR\HW\_IMP\HYD\HW700C86

Date: 03-14-1997

Company Name: BHP MINERALS  
 Filename: C:\LR\HW\_IMP\HYD\HW700C86 User: lr

Date: 03-14-1997 Time: 11:28:13

HIGHWALL IMPOUNDMENT - 700 ACRE WATERSHED, CN = 86

Storm: 1.60 inches, 25 year- 6 hour, Type II-65

Hydrograph Convolution Interval: 0.1 hr

=====  
 SUBWATERSHED/STRUCTURE INPUT/OUTPUT TABLE  
 =====

-Hydrology-

JBS	SWS	Area (ac)	CN	UHS	Tc (hrs)	K (hrs)	X	Base- Flow (cfs)	Runoff Volume (ac-ft)	Peak Discharge (cfs)
111	1	700.00	86	M	1.150	0.000	0.000	0.0	32.64	209.05
					Type: Null		Label: POND			
111	Structure	700.00							32.64	
111	Total IN/OUT	700.00							32.64	209.05

Company Name: BHP MINERALS  
 Filename: C:\LR\HW\_IMP\HYD\HW700C86 User: lr  
 Date: 03-14-1997 Time: 11:28:13  
 HIGHWALL IMPOUNDMENT - 700 ACRE WATERSHED, CN = 86  
 Storm: 1.60 inches, 25 year- 6 hour, Type II-65  
 Hydrograph Convolution Interval: 0.1 hr

=====

DETAILED SUBWATERSHED INPUT/OUTPUT TABLE

=====

J	B	S	SWS	Seg. #	Land Flow Condition	Distance (ft)	Slope (%)	Velocity (fps)	Segment Time (hr)	Time Conc. (hr)	Muskingum K (hr)	X
1	1	1	1	-a	5	8283.00	4.00	2.00	1.15	1.150		

CIVIL SOFTWARE DESIGN

SEDCAD+ Version 3

HIGHWALL IMPOUNDMENT - 700 ACRE WATERSHED, CN = 83

by

Name: lr

Company Name: BHP MINERALS  
File Name: C:\LR\HW\_IMP\HYD\HW700C83

Date: 03-14-1997

Company Name: BHP MINERALS  
 Filename: C:\LR\HW\_IMP\HYD\HW700C83 User: lr  
 Date: 03-14-1997 Time: 11:28:11  
 HIGHWALL IMPOUNDMENT - 700 ACRE WATERSHED, CN = 83  
 Storm: 1.60 inches, 25 year- 6 hour, Type II-65  
 Hydrograph Convolution Interval: 0.1 hr

=====  
 SUBWATERSHED/STRUCTURE INPUT/OUTPUT TABLE  
 =====

-Hydrology-

JBS	SWS	Area (ac)	CN	UHS	Tc (hrs)	K (hrs)	X	Base- Flow (cfs)	Runoff Volume (ac-ft)	Peak Discharge (cfs)	
111	1	700.00	83	M	1.150	0.000	0.000	0.0	25.52	159.97	
				Type: Null		Label: POND					
111	Structure	700.00								25.52	
111	Total IN/OUT	700.00								25.52	159.97

Company Name: BHP MINERALS  
 Filename: C:\LR\HW\_IMP\HYD\HW700C83 User: lr  
 Date: 03-14-1997 Time: 11:28:11  
 HIGHWALL IMPOUNDMENT - 700 ACRE WATERSHED, CN = 83  
 Storm: 1.60 inches, 25 year- 6 hour, Type II-65  
 Hydrograph Convolution Interval: 0.1 hr

=====  
 DETAILED SUBWATERSHED INPUT/OUTPUT TABLE  
 =====

J	B	S	SWS	Seg. #	Land Flow Condition	Distance (ft)	Slope (%)	Velocity (fps)	Segment Time (hr)	Time Conc. (hr)	Muskingum K (hr)	X
1	1	1	1	-a	5	8283.00	4.00	2.00	1.15	1.150		

**HIGHWALL IMPOUNDMENTS**

**SEDCAD+ COMPUTER RUNS**

**STANDARD SPILLWAY SIZES**

**SEDCAD+ BASIN DISCHARGE UTILITY**  
**HIGHWALL IMPOUNDMENT - STANDARD SIZE SPILLWAY**  
**EMERGENCY SPILLWAY INPUTS:**

Emergency Spillway Elevation 105.00  
 Crest Length 25.000 feet  
 Z:1 (Left) 3.00:1  
 Z:1 (Right) 3.00:1  
 Bottom Width 10.000 feet

Elevation	Emergency Spillway (cfs)	Total Discharge (cfs)
100.00	0.0	0.0
100.50	0.0	0.0
101.00	0.0	0.0
101.50	0.0	0.0
102.00	0.0	0.0
102.50	0.0	0.0
103.00	0.0	0.0
103.50	0.0	0.0
104.00	0.0	0.0
104.50	0.0	0.0
105.00	0.0	0.0
105.50	9.0	9.0
105.70	12.6	12.6
105.80	16.5	16.5
105.90	20.7	20.7
106.00	25.5	25.5
106.50	56.9	56.9
107.00	98.5	98.5

**SEDCAD+ BASIN DISCHARGE UTILITY**  
**HIGHWALL IMPOUNDMENT - STANDARD SIZE SPILLWAY**  
**EMERGENCY SPILLWAY INPUTS:**

Emergency Spillway Elevation            105.00  
 Crest Length                                25.000 feet  
 Z:1 (Left)                                    3.00:1  
 Z:1 (Right)                                  3.00:1  
 Bottom Width                                15.000 feet

Elevation	Emergency Spillway (cfs)	Total Discharge (cfs)
100.00	0.0	0.0
100.50	0.0	0.0
101.00	0.0	0.0
101.50	0.0	0.0
102.00	0.0	0.0
102.50	0.0	0.0
103.00	0.0	0.0
103.50	0.0	0.0
104.00	0.0	0.0
104.50	0.0	0.0
105.00	0.0	0.0
105.50	13.1	13.1
105.70	18.3	18.3
105.80	23.9	23.9
105.90	29.7	29.7
106.00	36.4	36.4
106.50	79.3	79.3
107.00	134.3	134.3

**SEDCAD+ BASIN DISCHARGE UTILITY**  
**HIGHWALL IMPOUNDMENT - STANDARD SIZE SPILLWAY**  
**EMERGENCY SPILLWAY INPUTS:**

Emergency Spillway Elevation            105.00  
 Crest Length                                25.000 feet  
 Z:1 (Left)                                    3.00:1  
 Z:1 (Right)                                  3.00:1  
 Bottom Width                                20.000 feet

Elevation	Emergency Spillway (cfs)	Total Discharge (cfs)
100.00	0.0	0.0
100.50	0.0	0.0
101.00	0.0	0.0
101.50	0.0	0.0
102.00	0.0	0.0
102.50	0.0	0.0
103.00	0.0	0.0
103.50	0.0	0.0
104.00	0.0	0.0
104.50	0.0	0.0
105.00	0.0	0.0
105.50	17.2	17.2
105.70	24.0	24.0
105.80	31.2	31.2
105.90	38.7	38.7
106.00	47.3	47.3
106.50	101.8	101.8
107.00	170.2	170.2

**SEDCAD+ BASIN DISCHARGE UTILITY**  
**HIGHWALL IMPOUNDMENT - STANDARD SIZE SPILLWAY**  
**EMERGENCY SPILLWAY INPUTS:**

Emergency Spillway Elevation            105.00  
 Crest Length                                25.000 feet  
 Z:1 (Left)                                    3.00:1  
 Z:1 (Right)                                  3.00:1  
 Bottom Width                                25.000 feet

Elevation	Emergency Spillway (cfs)	Total Discharge (cfs)
100.00	0.0	0.0
100.50	0.0	0.0
101.00	0.0	0.0
101.50	0.0	0.0
102.00	0.0	0.0
102.50	0.0	0.0
103.00	0.0	0.0
103.50	0.0	0.0
104.00	0.0	0.0
104.50	0.0	0.0
105.00	0.0	0.0
105.50	21.2	21.2
105.70	29.7	29.7
105.80	38.6	38.6
105.90	47.8	47.8
106.00	58.3	58.3
106.50	124.2	124.2
107.00	206.2	206.2

**SEDCAD+ BASIN DISCHARGE UTILITY**  
**HIGHWALL IMPOUNDMENT - STANDARD SIZE SPILLWAY**  
**EMERGENCY SPILLWAY INPUTS:**

Emergency Spillway Elevation 104.75  
 Crest Length 25.000 feet  
 Z:1 (Left) 3.00:1  
 Z:1 (Right) 3.00:1  
 Bottom Width 10.000 feet

Elevation	Emergency Spillway (cfs)	Total Discharge (cfs)
100.00	0.0	0.0
100.50	0.0	0.0
101.00	0.0	0.0
101.50	0.0	0.0
102.00	0.0	0.0
102.50	0.0	0.0
103.00	0.0	0.0
103.50	0.0	0.0
104.00	0.0	0.0
104.50	0.0	0.0
104.75	0.0	0.0
105.00	1.3	1.3
105.40	3.4	3.4
105.50	12.6	12.6
105.60	16.5	16.5
105.70	20.7	20.7
105.80	25.5	25.5
105.90	30.8	30.8
106.00	36.7	36.7
106.20	49.7	49.7
106.50	72.2	72.2
106.70	89.3	89.3
107.00	119.0	119.0

**SEDCAD+ BASIN DISCHARGE UTILITY**  
**HIGHWALL IMPOUNDMENT - STANDARD SIZE SPILLWAY**  
**EMERGENCY SPILLWAY INPUTS:**

Emergency Spillway Elevation            104.75  
 Crest Length                              25.000 feet  
 Z:1 (Left)                                 3.00:1  
 Z:1 (Right)                                3.00:1  
 Bottom Width                              15.000 feet

Elevation	Emergency Spillway (cfs)	Total Discharge (cfs)
100.00	0.0	0.0
100.50	0.0	0.0
101.00	0.0	0.0
101.50	0.0	0.0
102.00	0.0	0.0
102.50	0.0	0.0
103.00	0.0	0.0
103.50	0.0	0.0
104.00	0.0	0.0
104.50	0.0	0.0
104.75	0.0	0.0
105.00	2.0	2.0
105.40	5.1	5.1
105.50	18.3	18.3
105.60	23.9	23.9
105.70	29.7	29.7
105.80	36.4	36.4
105.90	43.8	43.8
106.00	51.9	51.9
106.20	69.6	69.6
106.50	99.7	99.7
106.70	122.3	122.3
107.00	160.9	160.9

**SEDCAD+ BASIN DISCHARGE UTILITY**  
**HIGHWALL IMPOUNDMENT - STANDARD SIZE SPILLWAY**  
**EMERGENCY SPILLWAY INPUTS:**

Emergency Spillway Elevation            104.75  
 Crest Length                                25.000 feet  
 Z:1 (Left)                                    3.00:1  
 Z:1 (Right)                                  3.00:1  
 Bottom Width                                20.000 feet

Elevation	Emergency Spillway (cfs)	Total Discharge (cfs)
100.00	0.0	0.0
100.50	0.0	0.0
101.00	0.0	0.0
101.50	0.0	0.0
102.00	0.0	0.0
102.50	0.0	0.0
103.00	0.0	0.0
103.50	0.0	0.0
104.00	0.0	0.0
104.50	0.0	0.0
104.75	0.0	0.0
105.00	2.6	2.6
105.40	6.7	6.7
105.50	24.0	24.0
105.60	31.2	31.2
105.70	38.7	38.7
105.80	47.3	47.3
105.90	56.8	56.8
106.00	67.1	67.1
106.20	89.5	89.5
106.50	127.3	127.3
106.70	155.3	155.3
107.00	202.9	202.9

**SEDCAD+ BASIN DISCHARGE UTILITY**  
**HIGHWALL IMPOUNDMENT - STANDARD SIZE SPILLWAY**  
**EMERGENCY SPILLWAY INPUTS:**

Emergency Spillway Elevation            104.75  
 Crest Length                                25.000 feet  
 Z:1 (Left)                                    3.00:1  
 Z:1 (Right)                                  3.00:1  
 Bottom Width                                25.000 feet

Elevation	Emergency Spillway (cfs)	Total Discharge (cfs)
100.00	0.0	0.0
100.50	0.0	0.0
101.00	0.0	0.0
101.50	0.0	0.0
102.00	0.0	0.0
102.50	0.0	0.0
103.00	0.0	0.0
103.50	0.0	0.0
104.00	0.0	0.0
104.50	0.0	0.0
104.75	0.0	0.0
105.00	3.2	3.2
105.40	8.4	8.4
105.50	29.7	29.7
105.60	38.6	38.6
105.70	47.8	47.8
105.80	58.3	58.3
105.90	69.9	69.9
106.00	82.3	82.3
106.20	109.5	109.5
106.50	154.9	154.9
106.70	188.4	188.4
107.00	245.0	245.0

**SEDCAD+ BASIN DISCHARGE UTILITY**  
**HIGHWALL IMPOUNDMENT - STANDARD SIZE SPILLWAY**  
**EMERGENCY SPILLWAY INPUTS:**

Emergency Spillway Elevation            104.50  
 Crest Length                                25.000 feet  
 Z:1 (Left)                                    3.00:1  
 Z:1 (Right)                                  3.00:1  
 Bottom Width                                10.000 feet

Elevation	Emergency Spillway (cfs)	Total Discharge (cfs)
100.00	0.0	0.0
100.50	0.0	0.0
101.00	0.0	0.0
101.50	0.0	0.0
102.00	0.0	0.0
102.50	0.0	0.0
103.00	0.0	0.0
103.50	0.0	0.0
104.00	0.0	0.0
104.50	0.0	0.0
104.75	4.5	4.5
105.00	9.0	9.0
105.20	12.6	12.6
105.30	16.5	16.5
105.40	20.7	20.7
105.50	25.5	25.5
105.60	30.8	30.8
105.70	36.7	36.7
105.80	43.0	43.0
105.90	49.7	49.7
106.00	56.9	56.9
106.20	72.2	72.2
106.50	98.5	98.5
106.70	119.0	119.0
107.00	153.3	153.3

**SEDCAD+ BASIN DISCHARGE UTILITY**  
**HIGHWALL IMPOUNDMENT - STANDARD SIZE SPILLWAY**  
**EMERGENCY SPILLWAY INPUTS:**

Emergency Spillway Elevation            104.50  
 Crest Length                                25.000 feet  
 Z:1 (Left)                                  3.00:1  
 Z:1 (Right)                                 3.00:1  
 Bottom Width                                15.000 feet

Elevation	Emergency Spillway (cfs)	Total Discharge (cfs)
100.00	0.0	0.0
100.50	0.0	0.0
101.00	0.0	0.0
101.50	0.0	0.0
102.00	0.0	0.0
102.50	0.0	0.0
103.00	0.0	0.0
103.50	0.0	0.0
104.00	0.0	0.0
104.50	0.0	0.0
104.75	6.5	6.5
105.00	13.1	13.1
105.20	18.3	18.3
105.30	23.9	23.9
105.40	29.7	29.7
105.50	36.4	36.4
105.60	43.8	43.8
105.70	51.9	51.9
105.80	60.5	60.5
105.90	69.6	69.6
106.00	79.3	79.3
106.20	99.7	99.7
106.50	134.3	134.3
106.70	160.9	160.9
107.00	204.9	204.9

**SEDCAD+ BASIN DISCHARGE UTILITY**  
**HIGHWALL IMPOUNDMENT - STANDARD SIZE SPILLWAY**  
**EMERGENCY SPILLWAY INPUTS:**

Emergency Spillway Elevation            104.50  
 Crest Length                                25.000 feet  
 Z:1 (Left)                                    3.00:1  
 Z:1 (Right)                                  3.00:1  
 Bottom Width                                20.000 feet

Elevation	Emergency Spillway (cfs)	Total Discharge (cfs)
100.00	0.0	0.0
100.50	0.0	0.0
101.00	0.0	0.0
101.50	0.0	0.0
102.00	0.0	0.0
102.50	0.0	0.0
103.00	0.0	0.0
103.50	0.0	0.0
104.00	0.0	0.0
104.50	0.0	0.0
104.75	8.6	8.6
105.00	17.2	17.2
105.20	24.0	24.0
105.30	31.2	31.2
105.40	38.7	38.7
105.50	47.3	47.3
105.60	56.8	56.8
105.70	67.1	67.1
105.80	78.0	78.0
105.90	89.5	89.5
106.00	101.8	101.8
106.20	127.3	127.3
106.50	170.2	170.2
106.70	202.9	202.9
107.00	256.8	256.8

**SEDCAD+ BASIN DISCHARGE UTILITY**  
**HIGHWALL IMPOUNDMENT - STANDARD SIZE SPILLWAY**  
**EMERGENCY SPILLWAY INPUTS:**

Emergency Spillway Elevation 104.50  
 Crest Length 25.000 feet  
 Z:1 (Left) 3.00:1  
 Z:1 (Right) 3.00:1  
 Bottom Width 25.000 feet

Elevation	Emergency Spillway (cfs)	Total Discharge (cfs)
100.00	0.0	0.0
100.50	0.0	0.0
101.00	0.0	0.0
101.50	0.0	0.0
102.00	0.0	0.0
102.50	0.0	0.0
103.00	0.0	0.0
103.50	0.0	0.0
104.00	0.0	0.0
104.50	0.0	0.0
104.75	10.6	10.6
105.00	21.2	21.2
105.20	29.7	29.7
105.30	38.6	38.6
105.40	47.8	47.8
105.50	58.3	58.3
105.60	69.9	69.9
105.70	82.3	82.3
105.80	95.5	95.5
105.90	109.5	109.5
106.00	124.2	124.2
106.20	154.9	154.9
106.50	206.2	206.2
106.70	245.0	245.0
107.00	308.7	308.7

**SEDCAD+ BASIN DISCHARGE UTILITY**  
**HIGHWALL IMPOUNDMENT - STANDARD SIZE SPILLWAY**  
**EMERGENCY SPILLWAY INPUTS:**

Emergency Spillway Elevation 104.25  
 Crest Length 25.000 feet  
 Z:1 (Left) 3.00:1  
 Z:1 (Right) 3.00:1  
 Bottom Width 10.000 feet

Elevation	Emergency Spillway (cfs)	Total Discharge (cfs)
100.00	0.0	0.0
100.50	0.0	0.0
101.00	0.0	0.0
101.50	0.0	0.0
102.00	0.0	0.0
102.50	0.0	0.0
103.00	0.0	0.0
103.50	0.0	0.0
104.00	0.0	0.0
104.25	0.0	0.0
104.50	1.3	1.3
104.75	2.7	2.7
104.90	3.4	3.4
105.00	12.6	12.6
105.10	16.5	16.5
105.20	20.7	20.7
105.30	25.5	25.5
105.40	30.8	30.8
105.50	36.7	36.7
105.60	43.0	43.0
105.70	49.7	49.7
105.80	56.9	56.9
105.90	64.4	64.4
106.00	72.2	72.2
106.20	89.3	89.3
106.50	119.0	119.0
106.70	141.4	141.4
107.00	179.3	179.3

**SEDCAD+ BASIN DISCHARGE UTILITY**  
**HIGHWALL IMPOUNDMENT - STANDARD SIZE SPILLWAY**  
**EMERGENCY SPILLWAY INPUTS:**

Emergency Spillway Elevation            104.25  
 Crest Length                                25.000 feet  
 Z:1 (Left)                                    3.00:1  
 Z:1 (Right)                                  3.00:1  
 Bottom Width                                15.000 feet

Elevation	Emergency Spillway (cfs)	Total Discharge (cfs)
100.00	0.0	0.0
100.50	0.0	0.0
101.00	0.0	0.0
101.50	0.0	0.0
102.00	0.0	0.0
102.50	0.0	0.0
103.00	0.0	0.0
103.50	0.0	0.0
104.00	0.0	0.0
104.25	0.0	0.0
104.50	2.0	2.0
104.75	3.9	3.9
104.90	5.1	5.1
105.00	18.3	18.3
105.10	23.9	23.9
105.20	29.7	29.7
105.30	36.4	36.4
105.40	43.8	43.8
105.50	51.9	51.9
105.60	60.5	60.5
105.70	69.6	69.6
105.80	79.3	79.3
105.90	89.3	89.3
106.00	99.7	99.7
106.20	122.3	122.3
106.50	160.9	160.9
106.70	189.7	189.7
107.00	237.9	237.9

**SEDCAD+ BASIN DISCHARGE UTILITY**  
**HIGHWALL IMPOUNDMENT - STANDARD SIZE SPILLWAY**  
**EMERGENCY SPILLWAY INPUTS:**

Emergency Spillway Elevation            104.25  
 Crest Length                                25.000 feet  
 Z:1 (Left)                                    3.00:1  
 Z:1 (Right)                                  3.00:1  
 Bottom Width                                20.000 feet

Elevation	Emergency Spillway (cfs)	Total Discharge (cfs)
100.00	0.0	0.0
100.50	0.0	0.0
101.00	0.0	0.0
101.50	0.0	0.0
102.00	0.0	0.0
102.50	0.0	0.0
103.00	0.0	0.0
103.50	0.0	0.0
104.00	0.0	0.0
104.25	0.0	0.0
104.50	2.6	2.6
104.75	5.2	5.2
104.90	6.7	6.7
105.00	24.0	24.0
105.10	31.2	31.2
105.20	38.7	38.7
105.30	47.3	47.3
105.40	56.8	56.8
105.50	67.1	67.1
105.60	78.0	78.0
105.70	89.5	89.5
105.80	101.8	101.8
105.90	114.2	114.2
106.00	127.3	127.3
106.20	155.3	155.3
106.50	202.9	202.9
106.70	238.2	238.2
107.00	296.7	296.7

**SEDCAD+ BASIN DISCHARGE UTILITY**  
**HIGHWALL IMPOUNDMENT - STANDARD SIZE SPILLWAY**  
**EMERGENCY SPILLWAY INPUTS:**

Emergency Spillway Elevation            104.25  
 Crest Length                                25.000 feet  
 Z:1 (Left)                                    3.00:1  
 Z:1 (Right)                                  3.00:1  
 Bottom Width                                25.000 feet

Elevation	Emergency Spillway (cfs)	Total Discharge (cfs)
100.00	0.0	0.0
100.50	0.0	0.0
101.00	0.0	0.0
101.50	0.0	0.0
102.00	0.0	0.0
102.50	0.0	0.0
103.00	0.0	0.0
103.50	0.0	0.0
104.00	0.0	0.0
104.25	0.0	0.0
104.50	3.2	3.2
104.75	6.5	6.5
104.90	8.4	8.4
105.00	29.7	29.7
105.10	38.6	38.6
105.20	47.8	47.8
105.30	58.3	58.3
105.40	69.9	69.9
105.50	82.3	82.3
105.60	95.5	95.5
105.70	109.5	109.5
105.80	124.2	124.2
105.90	139.2	139.2
106.00	154.9	154.9
106.20	188.4	188.4
106.50	245.0	245.0
106.70	286.7	286.7
107.00	355.7	355.7

**SEDCAD+ BASIN DISCHARGE UTILITY**  
**HIGHWALL IMPOUNDMENT - STANDARD SIZE SPILLWAY**  
**EMERGENCY SPILLWAY INPUTS:**

Emergency Spillway Elevation            104.00  
 Crest Length                                25.000 feet  
 Z:1 (Left)                                  3.00:1  
 Z:1 (Right)                                 3.00:1  
 Bottom Width                                10.000 feet

Elevation	Emergency Spillway (cfs)	Total Discharge (cfs)
100.00	0.0	0.0
100.50	0.0	0.0
101.00	0.0	0.0
101.50	0.0	0.0
102.00	0.0	0.0
102.50	0.0	0.0
103.00	0.0	0.0
103.50	0.0	0.0
104.00	0.0	0.0
104.25	4.5	4.5
104.50	9.0	9.0
104.70	12.6	12.6
104.75	12.6	12.6
104.80	16.5	16.5
104.90	20.7	20.7
105.00	25.5	25.5
105.10	30.8	30.8
105.20	36.7	36.7
105.30	43.0	43.0
105.40	49.7	49.7
105.50	56.9	56.9
105.60	64.4	64.4
105.70	72.2	72.2
105.80	80.5	80.5
105.90	89.3	89.3
106.00	98.5	98.5
106.20	119.0	119.0
106.50	153.3	153.3
106.70	179.3	179.3
107.00	222.4	222.4

**SEDCAD+ BASIN DISCHARGE UTILITY  
HIGHWALL IMPOUNDMENT - STANDARD SIZE SPILLWAY  
EMERGENCY SPILLWAY INPUTS:**

Emergency Spillway Elevation 104.00  
Crest Length 25.000 feet  
Z:1 (Left) 3.00:1  
Z:1 (Right) 3.00:1  
Bottom Width 15.000 feet

Elevation	Emergency Spillway (cfs)	Total Discharge (cfs)
100.00	0.0	0.0
100.50	0.0	0.0
101.00	0.0	0.0
101.50	0.0	0.0
102.00	0.0	0.0
102.50	0.0	0.0
103.00	0.0	0.0
103.50	0.0	0.0
104.00	0.0	0.0
104.25	6.5	6.5
104.50	13.1	13.1
104.70	18.3	18.3
104.75	18.3	18.3
104.80	23.9	23.9
104.90	29.7	29.7
105.00	36.4	36.4
105.10	43.8	43.8
105.20	51.9	51.9
105.30	60.5	60.5
105.40	69.6	69.6
105.50	79.3	79.3
105.60	89.3	89.3
105.70	99.7	99.7
105.80	110.7	110.7
105.90	122.3	122.3
106.00	134.3	134.3
106.20	160.9	160.9
106.50	204.9	204.9
106.70	237.9	237.9
107.00	291.9	291.9

**SEDCAD+ BASIN DISCHARGE UTILITY**  
**HIGHWALL IMPOUNDMENT - STANDARD SIZE SPILLWAY**  
**EMERGENCY SPILLWAY INPUTS:**

Emergency Spillway Elevation            104.00  
 Crest Length                                25.000 feet  
 Z:1 (Left)                                  3.00:1  
 Z:1 (Right)                                 3.00:1  
 Bottom Width                                20.000 feet

Elevation	Emergency Spillway (cfs)	Total Discharge (cfs)
100.00	0.0	0.0
100.50	0.0	0.0
101.00	0.0	0.0
101.50	0.0	0.0
102.00	0.0	0.0
102.50	0.0	0.0
103.00	0.0	0.0
103.50	0.0	0.0
104.00	0.0	0.0
104.25	8.6	8.6
104.50	17.2	17.2
104.70	24.0	24.0
104.75	24.0	24.0
104.80	31.2	31.2
104.90	38.7	38.7
105.00	47.3	47.3
105.10	56.8	56.8
105.20	67.1	67.1
105.30	78.0	78.0
105.40	89.5	89.5
105.50	101.8	101.8
105.60	114.2	114.2
105.70	127.3	127.3
105.80	141.0	141.0
105.90	155.3	155.3
106.00	170.2	170.2
106.20	202.9	202.9
106.50	256.8	256.8
106.70	296.7	296.7
107.00	361.8	361.8

**SEDCAD+ BASIN DISCHARGE UTILITY**  
**HIGHWALL IMPOUNDMENT - STANDARD SIZE SPILLWAY**  
**EMERGENCY SPILLWAY INPUTS:**

Emergency Spillway Elevation            104.00  
 Crest Length                                25.000 feet  
 Z:1 (Left)                                  3.00:1  
 Z:1 (Right)                                 3.00:1  
 Bottom Width                                25.000 feet

Elevation	Emergency Spillway (cfs)	Total Discharge (cfs)
100.00	0.0	0.0
100.50	0.0	0.0
101.00	0.0	0.0
101.50	0.0	0.0
102.00	0.0	0.0
102.50	0.0	0.0
103.00	0.0	0.0
103.50	0.0	0.0
104.00	0.0	0.0
104.25	10.6	10.6
104.50	21.2	21.2
104.70	29.7	29.7
104.75	29.7	29.7
104.80	38.6	38.6
104.90	47.8	47.8
105.00	58.3	58.3
105.10	69.9	69.9
105.20	82.3	82.3
105.30	95.5	95.5
105.40	109.5	109.5
105.50	124.2	124.2
105.60	139.2	139.2
105.70	154.9	154.9
105.80	171.3	171.3
105.90	188.4	188.4
106.00	206.2	206.2
106.20	245.0	245.0
106.50	308.7	308.7
106.70	355.7	355.7
107.00	431.8	431.8

**SEDCAD+ BASIN DISCHARGE UTILITY**  
**HIGHWALL IMPOUNDMENT - STANDARD SIZE SPILLWAY**  
**EMERGENCY SPILLWAY INPUTS:**

Emergency Spillway Elevation 104.00  
 Crest Length 25.000 feet  
 Z:1 (Left) 3.00:1  
 Z:1 (Right) 3.00:1  
 Bottom Width 30.000 feet

Elevation	Emergency Spillway (cfs)	Total Discharge (cfs)
100.00	0.0	0.0
100.50	0.0	0.0
101.00	0.0	0.0
101.50	0.0	0.0
102.00	0.0	0.0
102.50	0.0	0.0
103.00	0.0	0.0
103.50	0.0	0.0
104.00	0.0	0.0
104.25	12.7	12.7
104.50	25.3	25.3
104.70	35.4	35.4
104.75	35.4	35.4
104.80	46.0	46.0
104.90	56.8	56.8
105.00	69.2	69.2
105.10	82.9	82.9
105.20	97.5	97.5
105.30	113.0	113.0
105.40	129.4	129.4
105.50	146.7	146.7
105.60	164.2	164.2
105.70	182.6	182.6
105.80	201.7	201.7
105.90	221.5	221.5
106.00	242.2	242.2
106.20	287.2	287.2
106.50	360.6	360.6
106.70	414.7	414.7
107.00	502.0	502.0

**SEDCAD+ BASIN DISCHARGE UTILITY  
HIGHWALL IMPOUNDMENT - STANDARD SPILLWAY SIZE  
EMERGENCY SPILLWAY INPUTS:**

Emergency Spillway Elevation 103.75  
Crest Length 25.000 feet  
Z:1 (Left) 3.00:1  
Z:1 (Right) 3.00:1  
Bottom Width 10.000 feet

Elevation	Emergency Spillway (cfs)	Total Discharge (cfs)
100.00	0.0	0.0
100.50	0.0	0.0
101.00	0.0	0.0
101.50	0.0	0.0
102.00	0.0	0.0
102.50	0.0	0.0
103.00	0.0	0.0
103.50	0.0	0.0
103.75	0.0	0.0
104.00	1.3	1.3
104.40	3.4	3.4
104.50	12.6	12.6
104.60	16.5	16.5
104.70	20.7	20.7
105.00	36.7	36.7
105.20	49.7	49.7
105.50	72.2	72.2
105.70	89.3	89.3
106.00	119.0	119.0
106.20	141.4	141.4
106.50	179.3	179.3
106.70	207.5	207.5
107.00	253.9	253.9

**SEDCAD+ BASIN DISCHARGE UTILITY**  
**HIGHWALL IMPOUNDMENT - STANDARD SPILLWAY SIZE**  
**EMERGENCY SPILLWAY INPUTS:**

Emergency Spillway Elevation           103.75  
 Crest Length                            25.000 feet  
 Z:1 (Left)                               3.00:1  
 Z:1 (Right)                              3.00:1  
 Bottom Width                            15.000 feet

Elevation	Emergency Spillway (cfs)	Total Discharge (cfs)
100.00	0.0	0.0
100.50	0.0	0.0
101.00	0.0	0.0
101.50	0.0	0.0
102.00	0.0	0.0
102.50	0.0	0.0
103.00	0.0	0.0
103.50	0.0	0.0
103.75	0.0	0.0
104.00	2.0	2.0
104.40	5.1	5.1
104.50	18.3	18.3
104.60	23.9	23.9
104.70	29.7	29.7
105.00	51.9	51.9
105.20	69.6	69.6
105.50	99.7	99.7
105.70	122.3	122.3
106.00	160.9	160.9
106.20	189.7	189.7
106.50	237.9	237.9
106.70	273.3	273.3
107.00	331.0	331.0

**SEDCAD+ BASIN DISCHARGE UTILITY**  
**HIGHWALL IMPOUNDMENT - STANDARD SPILLWAY SIZE**  
**EMERGENCY SPILLWAY INPUTS:**

Emergency Spillway Elevation            103.75  
 Crest Length                                25.000 feet  
 Z:1 (Left)                                  3.00:1  
 Z:1 (Right)                                 3.00:1  
 Bottom Width                                20.000 feet

Elevation	Emergency Spillway (cfs)	Total Discharge (cfs)
100.00	0.0	0.0
100.50	0.0	0.0
101.00	0.0	0.0
101.50	0.0	0.0
102.00	0.0	0.0
102.50	0.0	0.0
103.00	0.0	0.0
103.50	0.0	0.0
103.75	0.0	0.0
104.00	2.6	2.6
104.40	6.7	6.7
104.50	24.0	24.0
104.60	31.2	31.2
104.70	38.7	38.7
105.00	67.1	67.1
105.20	89.5	89.5
105.50	127.3	127.3
105.70	155.3	155.3
106.00	202.9	202.9
106.20	238.2	238.2
106.50	296.7	296.7
106.70	339.4	339.4
107.00	408.6	408.6

**SEDCAD+ BASIN DISCHARGE UTILITY**  
**HIGHWALL IMPOUNDMENT - STANDARD SPILLWAY SIZE**  
**EMERGENCY SPILLWAY INPUTS:**

Emergency Spillway Elevation            103.75  
 Crest Length                            25.000 feet  
 Z:1 (Left)                                3.00:1  
 Z:1 (Right)                              3.00:1  
 Bottom Width                            25.000 feet

Elevation	Emergency Spillway (cfs)	Total Discharge (cfs)
100.00	0.0	0.0
100.50	0.0	0.0
101.00	0.0	0.0
101.50	0.0	0.0
102.00	0.0	0.0
102.50	0.0	0.0
103.00	0.0	0.0
103.50	0.0	0.0
103.75	0.0	0.0
104.00	3.2	3.2
104.40	8.4	8.4
104.50	29.7	29.7
104.60	38.6	38.6
104.70	47.8	47.8
105.00	82.3	82.3
105.20	109.5	109.5
105.50	154.9	154.9
105.70	188.4	188.4
106.00	245.0	245.0
106.20	286.7	286.7
106.50	355.7	355.7
106.70	405.7	405.7
107.00	486.3	486.3

**SEDCAD+ BASIN DISCHARGE UTILITY**  
**HIGHWALL IMPOUNDMENT - STANDARD SPILLWAY SIZE**  
**EMERGENCY SPILLWAY INPUTS:**

Emergency Spillway Elevation            103.75  
 Crest Length                                25.000 feet  
 Z:1 (Left)                                    3.00:1  
 Z:1 (Right)                                  3.00:1  
 Bottom Width                                30.000 feet

Elevation	Emergency Spillway (cfs)	Total Discharge (cfs)
100.00	0.0	0.0
100.50	0.0	0.0
101.00	0.0	0.0
101.50	0.0	0.0
102.00	0.0	0.0
102.50	0.0	0.0
103.00	0.0	0.0
103.50	0.0	0.0
103.75	0.0	0.0
104.00	3.9	3.9
104.40	10.0	10.0
104.50	35.4	35.4
104.60	46.0	46.0
104.70	56.8	56.8
105.00	97.5	97.5
105.20	129.4	129.4
105.50	182.6	182.6
105.70	221.5	221.5
106.00	287.2	287.2
106.20	335.3	335.3
106.50	414.7	414.7
106.70	472.0	472.0
107.00	564.2	564.2

**SEDCAD+ BASIN DISCHARGE UTILITY**  
**HIGHWALL IMPOUNDMENT - STANDARD SPILLWAY SIZE**  
**EMERGENCY SPILLWAY INPUTS:**

Emergency Spillway Elevation            103.50  
 Crest Length                            25.000 feet  
 Z:1 (Left)                                3.00:1  
 Z:1 (Right)                              3.00:1  
 Bottom Width                            10.000 feet

Elevation	Emergency Spillway (cfs)	Total Discharge (cfs)
100.00	0.0	0.0
100.50	0.0	0.0
101.00	0.0	0.0
101.50	0.0	0.0
102.00	0.0	0.0
102.50	0.0	0.0
103.00	0.0	0.0
103.50	0.0	0.0
103.75	4.5	4.5
104.00	9.0	9.0
104.20	12.6	12.6
104.30	16.5	16.5
104.40	20.7	20.7
104.50	25.5	25.5
104.60	30.8	30.8
104.70	36.7	36.7
105.00	56.9	56.9
105.20	72.2	72.2
105.50	98.5	98.5
105.70	119.0	119.0
106.00	153.3	153.3
106.20	179.3	179.3
106.50	222.4	222.4
106.70	253.9	253.9
107.00	305.3	305.3

**SEDCAD+ BASIN DISCHARGE UTILITY**  
**HIGHWALL IMPOUNDMENT - STANDARD SPILLWAY SIZE**  
**EMERGENCY SPILLWAY INPUTS:**

Emergency Spillway Elevation            103.50  
 Crest Length                                25.000 feet  
 Z:1 (Left)                                    3.00:1  
 Z:1 (Right)                                  3.00:1  
 Bottom Width                                15.000 feet

Elevation	Emergency Spillway (cfs)	Total Discharge (cfs)
100.00	0.0	0.0
100.50	0.0	0.0
101.00	0.0	0.0
101.50	0.0	0.0
102.00	0.0	0.0
102.50	0.0	0.0
103.00	0.0	0.0
103.50	0.0	0.0
103.75	6.5	6.5
104.00	13.1	13.1
104.20	18.3	18.3
104.30	23.9	23.9
104.40	29.7	29.7
104.50	36.4	36.4
104.60	43.8	43.8
104.70	51.9	51.9
105.00	79.3	79.3
105.20	99.7	99.7
105.50	134.3	134.3
105.70	160.9	160.9
106.00	204.9	204.9
106.20	237.9	237.9
106.50	291.9	291.9
106.70	331.0	331.0
107.00	394.4	394.4

**SEDCAD+ BASIN DISCHARGE UTILITY**  
**HIGHWALL IMPOUNDMENT - STANDARD SPILLWAY SIZE**  
**EMERGENCY SPILLWAY INPUTS:**

Emergency Spillway Elevation            103.50  
 Crest Length                                25.000 feet  
 Z:1 (Left)                                    3.00:1  
 Z:1 (Right)                                  3.00:1  
 Bottom Width                                20.000 feet

Elevation	Emergency Spillway (cfs)	Total Discharge (cfs)
100.00	0.0	0.0
100.50	0.0	0.0
101.00	0.0	0.0
101.50	0.0	0.0
102.00	0.0	0.0
102.50	0.0	0.0
103.00	0.0	0.0
103.50	0.0	0.0
103.75	8.6	8.6
104.00	17.2	17.2
104.20	24.0	24.0
104.30	31.2	31.2
104.40	38.7	38.7
104.50	47.3	47.3
104.60	56.8	56.8
104.70	67.1	67.1
105.00	101.8	101.8
105.20	127.3	127.3
105.50	170.2	170.2
105.70	202.9	202.9
106.00	256.8	256.8
106.20	296.7	296.7
106.50	361.8	361.8
106.70	408.6	408.6
107.00	484.0	484.0

**SEDCAD+ BASIN DISCHARGE UTILITY**  
**HIGHWALL IMPOUNDMENT - STANDARD SPILLWAY SIZE**  
**EMERGENCY SPILLWAY INPUTS:**

Emergency Spillway Elevation            103.50  
 Crest Length                                25.000 feet  
 Z:1 (Left)                                    3.00:1  
 Z:1 (Right)                                  3.00:1  
 Bottom Width                                25.000 feet

Elevation	Emergency Spillway (cfs)	Total Discharge (cfs)
100.00	0.0	0.0
100.50	0.0	0.0
101.00	0.0	0.0
101.50	0.0	0.0
102.00	0.0	0.0
102.50	0.0	0.0
103.00	0.0	0.0
103.50	0.0	0.0
103.75	10.6	10.6
104.00	21.2	21.2
104.20	29.7	29.7
104.30	38.6	38.6
104.40	47.8	47.8
104.50	58.3	58.3
104.60	69.9	69.9
104.70	82.3	82.3
105.00	124.2	124.2
105.20	154.9	154.9
105.50	206.2	206.2
105.70	245.0	245.0
106.00	308.7	308.7
106.20	355.7	355.7
106.50	431.8	431.8
106.70	486.3	486.3
107.00	573.8	573.8

**SEDCAD+ BASIN DISCHARGE UTILITY**  
**HIGHWALL IMPOUNDMENT - STANDARD SPILLWAY SIZE**  
**EMERGENCY SPILLWAY INPUTS:**

Emergency Spillway Elevation            103.50  
 Crest Length                                25.000 feet  
 Z:1 (Left)                                    3.00:1  
 Z:1 (Right)                                  3.00:1  
 Bottom Width                                30.000 feet

Elevation	Emergency Spillway (cfs)	Total Discharge (cfs)
100.00	0.0	0.0
100.50	0.0	0.0
101.00	0.0	0.0
101.50	0.0	0.0
102.00	0.0	0.0
102.50	0.0	0.0
103.00	0.0	0.0
103.50	0.0	0.0
103.75	12.7	12.7
104.00	25.3	25.3
104.20	35.4	35.4
104.30	46.0	46.0
104.40	56.8	56.8
104.50	69.2	69.2
104.60	82.9	82.9
104.70	97.5	97.5
105.00	146.7	146.7
105.20	182.6	182.6
105.50	242.2	242.2
105.70	287.2	287.2
106.00	360.6	360.6
106.20	414.7	414.7
106.50	502.0	502.0
106.70	564.2	564.2
107.00	663.8	663.8

**SEDCAD+ BASIN DISCHARGE UTILITY**  
**HIGHWALL IMPOUNDMENT - STANDARD SPILLWAY SIZE**  
**EMERGENCY SPILLWAY INPUTS:**

Emergency Spillway Elevation            103.25  
 Crest Length                                25.000 feet  
 Z:1 (Left)                                    3.00:1  
 Z:1 (Right)                                  3.00:1  
 Bottom Width                                10.000 feet

Elevation	Emergency Spillway (cfs)	Total Discharge (cfs)
100.00	0.0	0.0
100.50	0.0	0.0
101.00	0.0	0.0
101.50	0.0	0.0
102.00	0.0	0.0
102.50	0.0	0.0
103.00	0.0	0.0
103.25	0.0	0.0
103.50	1.3	1.3
103.75	2.7	2.7
103.90	3.4	3.4
104.00	12.6	12.6
104.10	16.5	16.5
104.20	20.7	20.7
104.30	25.5	25.5
104.40	30.8	30.8
104.50	36.7	36.7
104.60	43.0	43.0
104.70	49.7	49.7
105.00	72.2	72.2
105.20	89.3	89.3
105.50	119.0	119.0
105.70	141.4	141.4
106.00	179.3	179.3
106.20	207.5	207.5
106.50	253.9	253.9
106.70	287.6	287.6
107.00	342.6	342.6

**SEDCAD+ BASIN DISCHARGE UTILITY**  
**HIGHWALL IMPOUNDMENT - STANDARD SPILLWAY SIZE**  
**EMERGENCY SPILLWAY INPUTS:**

Emergency Spillway Elevation            103.25  
 Crest Length                                25.000 feet  
 Z:1 (Left)                                    3.00:1  
 Z:1 (Right)                                  3.00:1  
 Bottom Width                                15.000 feet

Elevation	Emergency Spillway (cfs)	Total Discharge (cfs)
100.00	0.0	0.0
100.50	0.0	0.0
101.00	0.0	0.0
101.50	0.0	0.0
102.00	0.0	0.0
102.50	0.0	0.0
103.00	0.0	0.0
103.25	0.0	0.0
103.50	2.0	2.0
103.75	3.9	3.9
103.90	5.1	5.1
104.00	18.3	18.3
104.10	23.9	23.9
104.20	29.7	29.7
104.30	36.4	36.4
104.40	43.8	43.8
104.50	51.9	51.9
104.60	60.5	60.5
104.70	69.6	69.6
105.00	99.7	99.7
105.20	122.3	122.3
105.50	160.9	160.9
105.70	189.7	189.7
106.00	237.9	237.9
106.20	273.3	273.3
106.50	331.0	331.0
106.70	372.7	372.7
107.00	439.9	439.9

**SEDCAD+ BASIN DISCHARGE UTILITY**  
**HIGHWALL IMPOUNDMENT - STANDARD SPILLWAY SIZE**  
**EMERGENCY SPILLWAY INPUTS:**

Emergency Spillway Elevation            103.25  
 Crest Length                                25.000 feet  
 Z:1 (Left)                                    3.00:1  
 Z:1 (Right)                                  3.00:1  
 Bottom Width                                20.000 feet

Elevation	Emergency Spillway (cfs)	Total Discharge (cfs)
100.00	0.0	0.0
100.50	0.0	0.0
101.00	0.0	0.0
101.50	0.0	0.0
102.00	0.0	0.0
102.50	0.0	0.0
103.00	0.0	0.0
103.25	0.0	0.0
103.50	2.6	2.6
103.75	5.2	5.2
103.90	6.7	6.7
104.00	24.0	24.0
104.10	31.2	31.2
104.20	38.7	38.7
104.30	47.3	47.3
104.40	56.8	56.8
104.50	67.1	67.1
104.60	78.0	78.0
104.70	89.5	89.5
105.00	127.3	127.3
105.20	155.3	155.3
105.50	202.9	202.9
105.70	238.2	238.2
106.00	296.7	296.7
106.20	339.4	339.4
106.50	408.6	408.6
106.70	458.2	458.2
107.00	537.8	537.8

**SEDCAD+ BASIN DISCHARGE UTILITY**  
**HIGHWALL IMPOUNDMENT - STANDARD SPILLWAY SIZE**  
**EMERGENCY SPILLWAY INPUTS:**

Emergency Spillway Elevation            103.25  
 Crest Length                                25.000 feet  
 Z:1 (Left)                                    3.00:1  
 Z:1 (Right)                                  3.00:1  
 Bottom Width                                25.000 feet

Elevation	Emergency Spillway (cfs)	Total Discharge (cfs)
100.00	0.0	0.0
100.50	0.0	0.0
101.00	0.0	0.0
101.50	0.0	0.0
102.00	0.0	0.0
102.50	0.0	0.0
103.00	0.0	0.0
103.25	0.0	0.0
103.50	3.2	3.2
103.75	6.5	6.5
103.90	8.4	8.4
104.00	29.7	29.7
104.10	38.6	38.6
104.20	47.8	47.8
104.30	58.3	58.3
104.40	69.9	69.9
104.50	82.3	82.3
104.60	95.5	95.5
104.70	109.5	109.5
105.00	154.9	154.9
105.20	188.4	188.4
105.50	245.0	245.0
105.70	286.7	286.7
106.00	355.7	355.7
106.20	405.7	405.7
106.50	486.3	486.3
106.70	543.9	543.9
107.00	636.0	636.0

**SEDCAD+ BASIN DISCHARGE UTILITY**  
**HIGHWALL IMPOUNDMENT - STANDARD SPILLWAY SIZE**  
**EMERGENCY SPILLWAY INPUTS:**

Emergency Spillway Elevation            103.25  
 Crest Length                                25.000 feet  
 Z:1 (Left)                                    3.00:1  
 Z:1 (Right)                                  3.00:1  
 Bottom Width                                30.000 feet

Elevation	Emergency Spillway (cfs)	Total Discharge (cfs)
100.00	0.0	0.0
100.50	0.0	0.0
101.00	0.0	0.0
101.50	0.0	0.0
102.00	0.0	0.0
102.50	0.0	0.0
103.00	0.0	0.0
103.25	0.0	0.0
103.50	3.9	3.9
103.75	7.7	7.7
103.90	10.0	10.0
104.00	35.4	35.4
104.10	46.0	46.0
104.20	56.8	56.8
104.30	69.2	69.2
104.40	82.9	82.9
104.50	97.5	97.5
104.60	113.0	113.0
104.70	129.4	129.4
105.00	182.6	182.6
105.20	221.5	221.5
105.50	287.2	287.2
105.70	335.3	335.3
106.00	414.7	414.7
106.20	472.0	472.0
106.50	564.2	564.2
106.70	629.8	629.8
107.00	734.4	734.4

**HIGHWALL IMPOUNDMENTS**

**SEDCAD+ COMPUTER RUNS**

**AS-BUILT SPILLWAYS**

**AUGUST 27, 1997**

SEDCAD+ BASIN DISCHARGE UTILITY

YAZZIE STOCKPOND #1 - AS-BUILT SPILLWAY

EMERGENCY SPILLWAY INPUTS:

Emergency Spillway Elevation	102.50
Crest Length	23.400 feet
Z:1 (Left)	1.80:1
Z:1 (Right)	3.00:1
Bottom Width	20.000 feet

Elevation	Emergency Spillway (cfs)	Total Discharge (cfs)
100.00	0.0	0.0
100.50	0.0	0.0
101.00	0.0	0.0
101.50	0.0	0.0
102.00	0.0	0.0
102.50	0.0	0.0
103.00	17.2	17.2
103.20	24.1	24.1
103.30	31.4	31.4
103.40	38.8	38.8
103.50	47.3	47.3
104.00	100.0	100.0
104.50	166.9	166.9
105.00	249.9	249.9
105.50	348.9	348.9
106.00	463.0	463.0
106.50	592.3	592.3
107.00	737.3	737.3
107.50	898.1	898.1
108.00	1075.0	1075.0

SEDCAD+ BASIN DISCHARGE UTILITY

YAZZIE STOCKPOND #2 - AS-BUILT SPILLWAY

EMERGENCY SPILLWAY INPUTS:

Emergency Spillway Elevation	101.20
Crest Length	27.800 feet
Z:1 (Left)	3.00:1
Z:1 (Right)	2.80:1
Bottom Width	24.500 feet

Elevation	Emergency Spillway (cfs)	Total Discharge (cfs)
100.00	0.0	0.0
100.50	0.0	0.0
101.00	0.0	0.0
101.20	0.0	0.0
101.50	12.2	12.2
101.90	28.4	28.4
102.00	36.7	36.7
102.10	45.6	45.6
102.20	55.5	55.5
102.50	92.0	92.0
102.70	120.3	120.3
103.00	164.8	164.8
103.20	197.6	197.6
103.50	254.3	254.3
103.70	295.6	295.6
104.00	365.0	365.0
104.20	414.9	414.9
104.50	495.2	495.2
104.70	552.4	552.4
105.00	643.9	643.9
105.20	708.6	708.6
105.50	811.3	811.3
105.70	883.6	883.6
106.00	997.7	997.7
106.20	1077.7	1077.7
106.50	1203.6	1203.6
107.00	1429.3	1429.3
107.20	1525.2	1525.2
107.50	1675.2	1675.2
108.00	1941.8	1941.8

SEDCAD+ BASIN DISCHARGE UTILITY

SOUTH HOSTEEN STOCKPOND #1 - AS-BUILT SPILLWAY

EMERGENCY SPILLWAY INPUTS:

Emergency Spillway Elevation	102.00
Crest Length	29.700 feet
Z:1 (Left)	5.00:1
Z:1 (Right)	4.50:1
Bottom Width	5.000 feet

Elevation	Emergency Spillway (cfs)	Total Discharge (cfs)
100.00	0.0	0.0
100.50	0.0	0.0
101.00	0.0	0.0
101.50	0.0	0.0
102.00	0.0	0.0
102.50	5.2	5.2
102.70	7.3	7.3
102.80	9.8	9.8
102.90	12.6	12.6
103.00	15.8	15.8
103.50	41.1	41.1
104.00	75.8	75.8
104.50	126.5	126.5
105.00	195.9	195.9
105.50	283.5	283.5
106.00	390.6	390.6
106.50	518.1	518.1
107.00	667.3	667.3
107.50	839.0	839.0
108.00	1034.1	1034.1

SEDCAD+ BASIN DISCHARGE UTILITY

SOUTH HOSTEEN STOCKPOND #2 - AS-BUILT SPILLWAY

EMERGENCY SPILLWAY INPUTS:

Emergency Spillway Elevation	101.10
Crest Length	33.000 feet
Z:1 (Left)	6.00:1
Z:1 (Right)	2.20:1
Bottom Width	20.000 feet

Elevation	Emergency Spillway (cfs)	Total Discharge (cfs)
100.00	0.0	0.0
100.50	0.0	0.0
101.00	0.0	0.0
101.10	0.0	0.0
101.50	13.0	13.0
101.80	22.7	22.7
101.90	29.6	29.6
102.00	37.1	37.1
102.10	45.3	45.3
102.50	89.5	89.5
102.60	102.5	102.5
103.00	156.8	156.8
103.10	172.1	172.1
103.50	242.0	242.0
103.60	261.2	261.2
104.00	351.1	351.1
104.10	375.6	375.6
104.50	482.1	482.1
104.60	510.9	510.9
105.00	637.2	637.2
105.10	671.0	671.0
105.50	810.5	810.5
105.60	847.5	847.5
106.00	1007.9	1007.9
106.10	1050.4	1050.4
106.50	1229.9	1229.9
107.00	1476.4	1476.4
107.10	1528.8	1528.8
107.50	1748.4	1748.4
108.00	2046.4	2046.4

SEDCAD+ BASIN DISCHARGE UTILITY

SOUTH HOSTEEN STOCKPOND #3 - AS-BUILT SPILLWAY

EMERGENCY SPILLWAY INPUTS:

Emergency Spillway Elevation	101.30
Crest Length	32.000 feet
Z:1 (Left)	1.50:1
Z:1 (Right)	1.50:1
Bottom Width	14.500 feet

Elevation	Emergency Spillway (cfs)	Total Discharge (cfs)
100.00	0.0	0.0
100.50	0.0	0.0
101.00	0.0	0.0
101.30	0.0	0.0
101.50	4.6	4.6
102.00	16.1	16.1
102.10	20.8	20.8
102.20	25.9	25.9
102.30	31.5	31.5
102.50	45.2	45.2
102.80	69.1	69.1
103.00	85.5	85.5
103.30	112.8	112.8
103.50	133.6	133.6
103.80	167.5	167.5
104.00	193.4	193.4
104.30	235.2	235.2
104.50	265.0	265.0
104.80	312.9	312.9
105.00	347.3	347.3
105.30	401.9	401.9
105.50	439.5	439.5
105.80	499.0	499.0
106.00	541.1	541.1
106.30	607.5	607.5
106.50	653.9	653.9
107.00	777.3	777.3
107.30	856.6	856.6
107.50	911.6	911.6
108.00	1056.9	1056.9

SEDCAD+ BASIN DISCHARGE UTILITY

STUB 16 IMPOUNDMENT #2 - AS-BUILT SPILLWAY

EMERGENCY SPILLWAY INPUTS:

Emergency Spillway Elevation	101.00
Crest Length	45.000 feet
Z:1 (Left)	3.00:1
Z:1 (Right)	3.00:1
Bottom Width	12.500 feet

Elevation	Emergency Spillway (cfs)	Total Discharge (cfs)
100.00	0.0	0.0
100.50	0.0	0.0
101.00	0.0	0.0
101.50	9.2	9.2
101.70	12.9	12.9
101.80	17.2	17.2
101.90	21.6	21.6
102.00	26.4	26.4
102.50	62.4	62.4
103.00	106.9	106.9
103.50	163.2	163.2
104.00	236.2	236.2
104.50	325.2	325.2
105.00	432.7	432.7
105.50	549.3	549.3
106.00	685.6	685.6
106.50	838.9	838.9
107.00	1009.8	1009.8
107.50	1198.8	1198.8
108.00	1406.5	1406.5

SEDCAD+ BASIN DISCHARGE UTILITY

STUB 16 IMPOUNDMENT #3 - AS-BUILT SPILLWAY

EMERGENCY SPILLWAY INPUTS:

Emergency Spillway Elevation	101.00
Crest Length	34.000 feet
Z:1 (Left)	2.20:1
Z:1 (Right)	3.20:1
Bottom Width	12.500 feet

Elevation	Emergency Spillway (cfs)	Total Discharge (cfs)
100.00	0.0	0.0
100.50	0.0	0.0
101.00	0.0	0.0
101.50	10.1	10.1
101.70	14.1	14.1
101.80	18.4	18.4
101.90	23.1	23.1
102.00	28.3	28.3
102.50	64.2	64.2
103.00	108.5	108.5
103.50	164.7	164.7
104.00	237.5	237.5
104.50	323.9	323.9
105.00	427.0	427.0
105.50	539.5	539.5
106.00	669.7	669.7
106.50	815.6	815.6
107.00	977.7	977.7
107.50	1156.3	1156.3
108.00	1352.1	1352.1

SEDCAD+ BASIN DISCHARGE UTILITY  
 STUB 18 IMPOUNDMENT - AS-BUILT SPILLWAY

EMERGENCY SPILLWAY INPUTS:

Emergency Spillway Elevation	101.50
Crest Length	48.000 feet
Z:1 (Left)	3.40:1
Z:1 (Right)	3.30:1
Bottom Width	14.000 feet

Elevation	Emergency Spillway (cfs)	Total Discharge (cfs)
=====		
100.00	0.0	0.0
100.50	0.0	0.0
101.00	0.0	0.0
101.50	0.0	0.0
102.00	10.1	10.1
102.20	14.2	14.2
102.30	18.9	18.9
102.40	23.6	23.6
102.50	28.7	28.7
103.00	69.3	69.3
103.50	117.8	117.8
104.00	181.3	181.3
104.50	261.6	261.6
105.00	360.6	360.6
105.50	478.1	478.1
106.00	610.2	610.2
106.50	762.0	762.0
107.00	932.8	932.8
107.50	1123.3	1123.3
108.00	1333.9	1333.9

SEDCAD+ BASIN DISCHARGE UTILITY

SUNFLOWER #1 IMPOUNDMENT - AS-BUILT SPILLWAY

EMERGENCY SPILLWAY INPUTS:

Emergency Spillway Elevation	101.90
Crest Length	38.000 feet
Z:1 (Left)	4.30:1
Z:1 (Right)	5.20:1
Bottom Width	15.000 feet

Elevation	Emergency Spillway (cfs)	Total Discharge (cfs)
100.00	0.0	0.0
100.50	0.0	0.0
101.00	0.0	0.0
101.50	0.0	0.0
101.90	0.0	0.0
102.00	2.4	2.4
102.50	14.4	14.4
102.60	16.8	16.8
102.70	22.1	22.1
102.80	28.1	28.1
102.90	34.7	34.7
103.00	42.5	42.5
103.40	81.0	81.0
103.50	91.8	91.8
103.90	141.6	141.6
104.00	155.4	155.4
104.40	217.3	217.3
104.50	236.1	236.1
104.90	319.8	319.8
105.00	342.9	342.9
105.40	444.0	444.0
105.50	472.8	472.8
105.90	598.4	598.4
106.00	629.2	629.2
106.40	761.3	761.3
106.50	798.3	798.3
106.90	956.6	956.6
107.00	998.7	998.7
107.50	1225.0	1225.0
107.90	1425.4	1425.4
108.00	1478.3	1478.3

SEDCAD+ BASIN DISCHARGE UTILITY

AREA 3 TEMP. DIVERSION IMPOUNDMENT #2 - AS-BUILT SPILLWAY

EMERGENCY SPILLWAY INPUTS:

Emergency Spillway Elevation	101.30
Crest Length	35.000 feet
Z:1 (Left)	2.10:1
Z:1 (Right)	1.80:1
Bottom Width	9.400 feet

Elevation	Emergency Spillway (cfs)	Total Discharge (cfs)
100.00	0.0	0.0
100.50	0.0	0.0
101.00	0.0	0.0
101.30	0.0	0.0
101.50	3.0	3.0
102.00	10.5	10.5
102.10	13.7	13.7
102.20	17.2	17.2
102.30	21.1	21.1
102.50	30.6	30.6
102.80	47.8	47.8
103.00	60.0	60.0
103.30	80.7	80.7
103.50	96.3	96.3
103.80	122.1	122.1
104.00	142.5	142.5
104.30	175.9	175.9
104.50	200.2	200.2
104.80	239.7	239.7
105.00	268.9	268.9
105.30	316.1	316.1
105.50	347.8	347.8
105.80	398.4	398.4
106.00	435.3	435.3
106.30	494.1	494.1
106.50	535.5	535.5
107.00	647.3	647.3
107.30	720.0	720.0
107.50	770.9	770.9
108.00	906.8	906.8

SEDCAD+ BASIN DISCHARGE UTILITY

AREA 3 TEMP. DIVERSION IMPOUNDMENT #3 - AS-BUILT SPILLWAY

EMERGENCY SPILLWAY INPUTS:

Emergency Spillway Elevation	101.00
Crest Length	18.000 feet
Z:1 (Left)	2.00:1
Z:1 (Right)	2.00:1
Bottom Width	40.000 feet

Elevation	Emergency Spillway (cfs)	Total Discharge (cfs)
100.00	0.0	0.0
100.50	0.0	0.0
101.00	0.0	0.0
101.50	32.4	32.4
101.60	38.9	38.9
101.70	50.2	50.2
101.80	64.9	64.9
101.90	79.6	79.6
102.00	96.4	96.4
102.50	195.7	195.7
103.00	321.9	321.9
103.50	470.8	470.8
104.00	640.9	640.9
104.50	831.5	831.5
105.00	1042.0	1042.0
105.50	1272.3	1272.3
106.00	1522.1	1522.1
106.50	1791.3	1791.3
107.00	2079.9	2079.9
107.50	2387.9	2387.9
108.00	2715.3	2715.3

SEDCAD+ BASIN DISCHARGE UTILITY

AREA 3 TEMP. DIVERSION IMPOUNDMENT #5 - AS-BUILT SPILLWAY

EMERGENCY SPILLWAY INPUTS:

Emergency Spillway Elevation 101.80  
 Crest Length 25.000 feet  
 Z:1 (Left) 4.30:1  
 Z:1 (Right) 3.20:1  
 Bottom Width 10.400 feet

Elevation	Emergency Spillway (cfs)	Total Discharge (cfs)
100.00	0.0	0.0
100.50	0.0	0.0
101.00	0.0	0.0
101.50	0.0	0.0
101.80	0.0	0.0
102.00	3.8	3.8
102.50	13.4	13.4
102.60	17.6	17.6
102.70	22.1	22.1
102.80	27.2	27.2
103.00	39.5	39.5
103.30	61.8	61.8
103.50	78.8	78.8
103.80	108.2	108.2
104.00	131.2	131.2
104.30	170.1	170.1
104.50	199.7	199.7
104.80	248.9	248.9
105.00	285.1	285.1
105.30	344.5	344.5
105.50	387.6	387.6
105.80	457.7	457.7
106.00	508.1	508.1
106.30	589.4	589.4
106.50	647.4	647.4
106.80	740.4	740.4
107.00	806.4	806.4
107.50	985.7	985.7
107.80	1103.4	1103.4
108.00	1186.2	1186.2


SEDCAD+ BASIN DISCHARGE UTILITY

AREA 3 TEMP. DIVERSION IMPOUNDMENT #7 - AS-BUILT SPILLWAY

EMERGENCY SPILLWAY INPUTS:

Emergency Spillway Elevation	101.90
Crest Length	50.000 feet
Z:1 (Left)	5.00:1
Z:1 (Right)	1.70:1
Bottom Width	12.600 feet

Elevation	Emergency Spillway (cfs)	Total Discharge (cfs)
100.00	0.0	0.0
100.50	0.0	0.0
101.00	0.0	0.0
101.50	0.0	0.0
101.90	0.0	0.0
102.00	1.8	0.0
102.50	10.9	1.8
102.60	12.7	10.9
102.70	16.9	12.7
102.80	21.1	16.9
102.90	25.7	21.1
103.00	32.0	25.7
103.40	63.2	32.0
103.50	71.2	63.2
103.90	107.5	71.2
104.00	118.3	107.5
104.40	167.1	118.3
104.50	181.0	167.1
104.90	241.9	181.0
105.00	259.3	241.9
105.40	335.2	259.3
105.50	355.9	335.2
105.90	445.1	355.9
106.00	469.1	445.1
106.40	572.2	469.1
106.50	599.7	572.2
106.90	717.1	599.7
107.00	748.3	717.1
107.50	915.7	748.3
107.90	1063.5	915.7
108.00	1102.5	1063.5
		1102.5

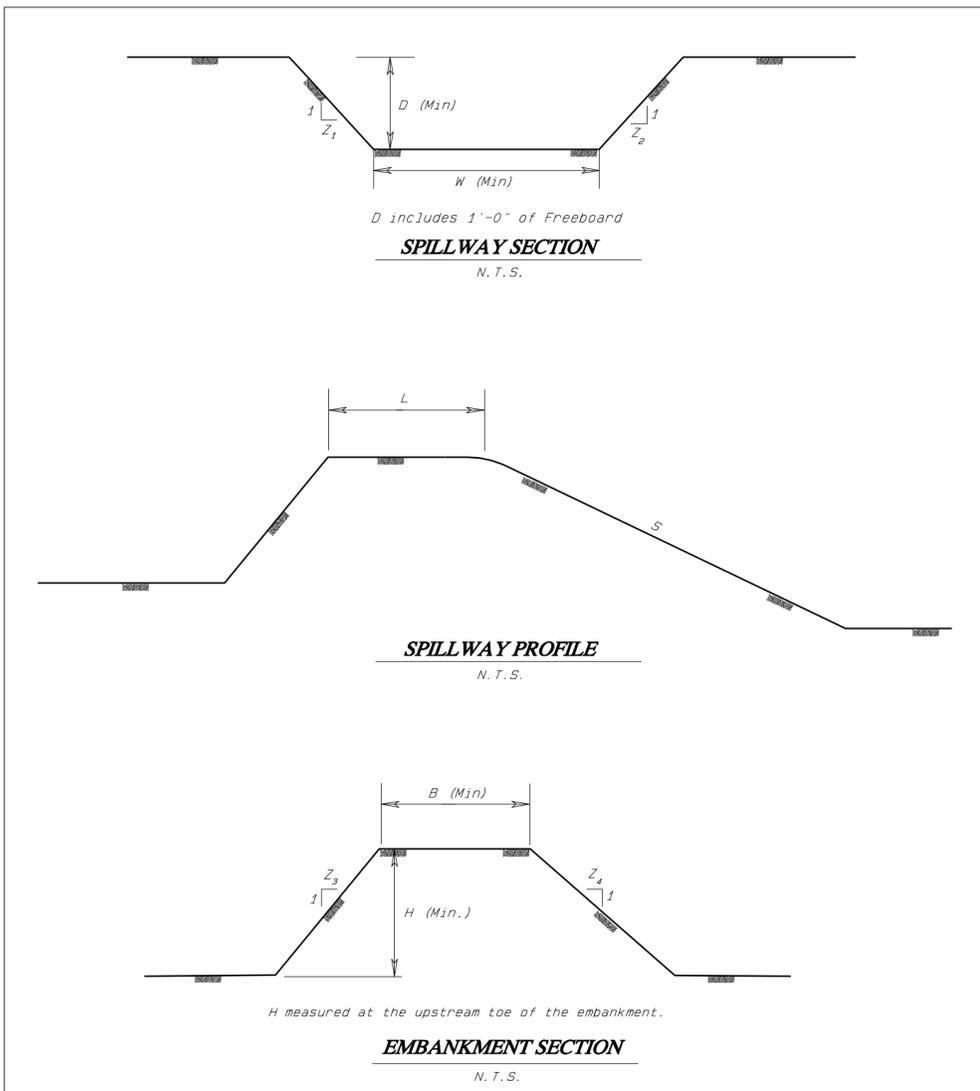

AS-BUILT DIMENSIONS													
Impoundment Id.	Watershed Area (acres)	Peak Discharge (cfs)	Spillway (1)						Embankment (1)				Comments:
			W (ft)	D (ft)	Z <sub>1</sub>	Z <sub>2</sub>	L (ft)	S (%)	B (ft)	H (ft)	Z <sub>3</sub>	Z <sub>4</sub>	
Yazzie Stockpond #1	125.5	92.8	20.0	2.5	1.8	3.0	23.4	25.0	15.2	5.1	2.0	2.8	REMOVED BY MINING ADVANCEMENT
Yazzie Stockpond #2	174.1	116.2	24.5	2.8	3.0	2.8	27.8	16.0	15.1	4.7	2.6	2.2	REMOVED BY MINING ADVANCEMENT
South Hosten Stockpond #1	80.1	73.3	5.0	3.0	5.0	4.5	29.7	6.0	16.5	4.6	2.1	2.0	REMOVED BY MINING ADVANCEMENT
South Hosten Stockpond #2	37.7	89.3	20.0	3.9	6.0	2.2	33.0	4.5	14.2	6.2	2.0	2.0	REMOVED BY MINING ADVANCEMENT
South Hosten Stockpond #3	157.3	115.7	14.5	3.7	1.5	1.5	32.0	12.0	18.0	4.5	2.3	2.0	REMOVED BY MINING ADVANCEMENT
Stub 16 Impoundment #2	20.2	24.9	12.5	4.0	3.0	3.0	45.0	7.0	38.0	8.1	2.8	3.6	REMOVED BY MINING ADVANCEMENT
Stub 16 Impoundment #3	10.6	15.5	12.5	3.0	2.2	3.2	34.0	15.0	36.0	6.1	2.2	2.0	REMOVED BY MINING ADVANCEMENT
Stub 18 Impoundment	103.4	69.8	14.0	4.5	3.4	3.3	48.0	7.0	12.5	10.0	2.0	2.0	REMOVED BY MINING ADVANCEMENT
Sunflower #1	24.6	17.3	15.0	3.1	4.3	5.2	38.0	2.2	9.0	7.5	4.2	3.9	REMOVED BY MINING ADVANCEMENT
Area 3 Temp. Div. Imp. #2	69.9	21.8	9.4	2.7	2.1	1.8	35.0	6.0	10.0	6.2	4.2	2.9	REMOVED BY MINING ADVANCEMENT
Area 3 Temp. Div. Imp. #3	20.8	23.9	40.0	20.0	2.0	2.0	18.0	2.5	18.0	5.8	4.0	40.0	REMOVED BY MINING ADVANCEMENT
Area 3 Temp. Div. Imp. #5	11.6	25.2	10.4	2.2	4.3	3.2	25.0	1.5	20.0	9.5	2.0	1.5	REMOVED BY MINING ADVANCEMENT
Area 3 Temp. Div. Imp. #7	55.5	21.9	12.6	2.1	5.0	1.7	50.0	0.5	73.0	8.5	2.9	4.0	REMOVED BY MINING ADVANCEMENT
Area 3 Highwall Pond 303	155.9	136.2	15.0	2.4	3.0	3.0	30.0	0.5	15.0	8.4	2.0	2.5	

(1) The data under each impoundment are the current dimensions of the structure. These indicate that the existing structures are adequate.  
Note: For supporting design data refer to Appendix 11-II "Highwall Impoundment Design and As-Built Information" in the Mine Permit.

**CERTIFICATION STATEMENT**

I, Ron C. Van Valkenburg, hereby certify that this drawing was reviewed by me and that the information shown is complete and accurate to the best of my knowledge.



10-A	7-21-10	PJF	ADDED A3 HIGHWALL POND 303 TO AS-BUILT DIMENSIONS TABLE AND SUBMITTED TO OSM FOR REVIEW.	RY	YB	RCV			
C	10-30-97	PJF	REMOVED EXHIBIT No.	LR	PS	LR			
B	08-27-97	FTJ	REVISED TABLE						
A	03-27-97	PJF	SUBMITTED TO OSM FOR APPROVAL						
REV. No.	DATE	DRAFT. BY	REVISION DESCRIPTION	ENG.	E. O.	P. E.	P. S.	CHIEF ENG.	
									APPROVALS

**BHP NAVAJO COAL COMPANY**




P. O. BOX 1717 FRUITLAND, NEW MEXICO 87416

**HIGHWALL IMPOUNDMENTS  
"AS BUILT"**

PREPARED BY	LR	DRAWN BY	PJF	SCALE	AS NOTED
APPROVED BY	LR	DATE	03-25-97		

PATH: G:\Gs\Permit F\Ch 11\HWSTR\HGWLIMP\_X-SECT.pro

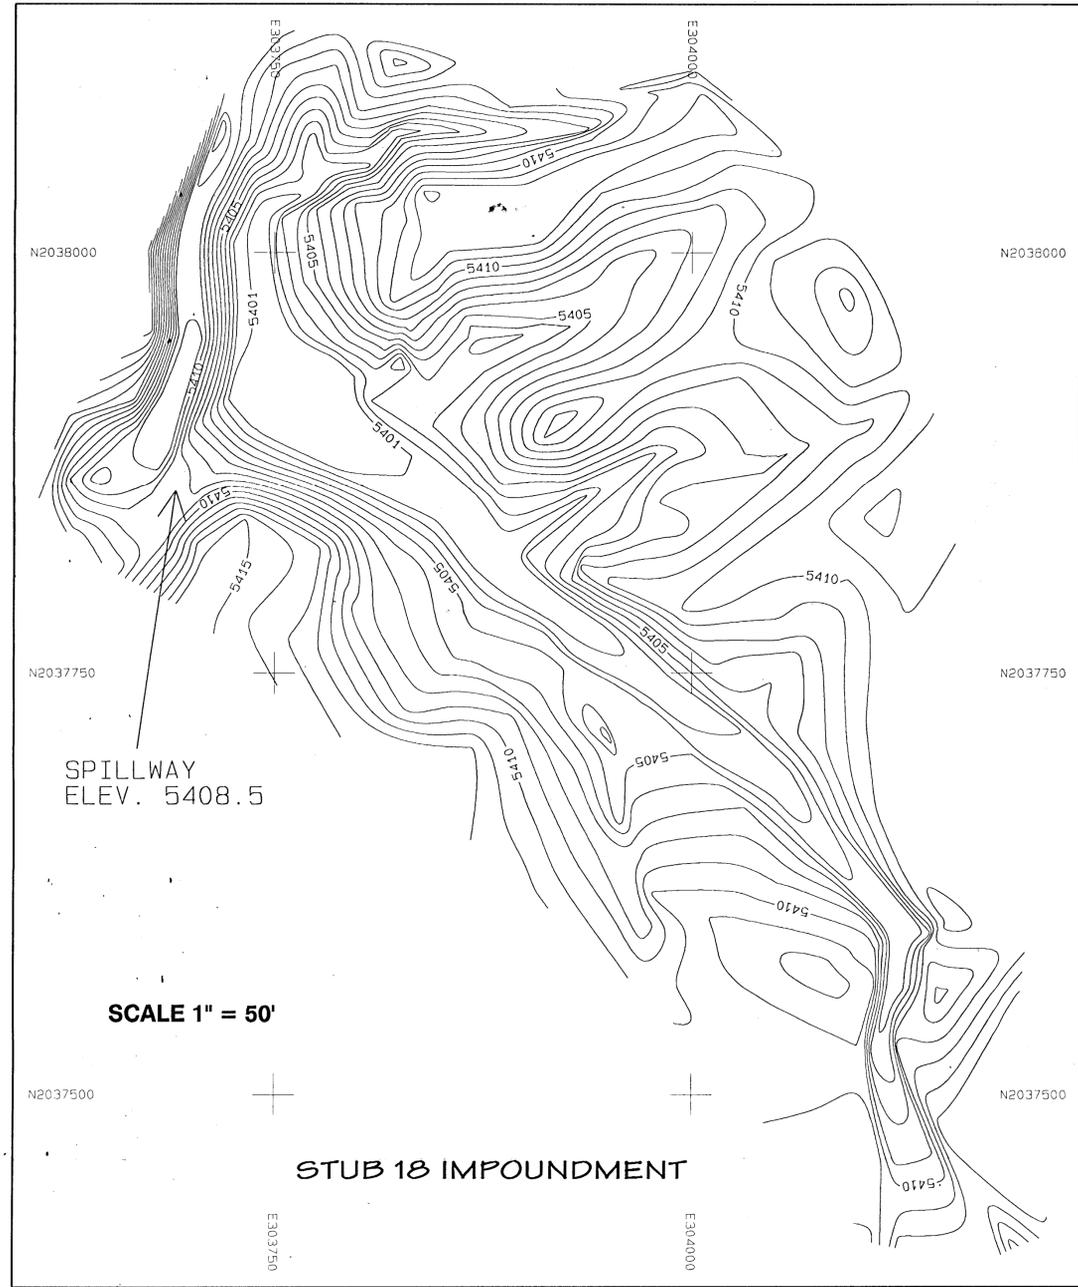


SCALE 1" = 50'

STUB 18 IMPOUNDMENT

STUB 18 IMPOUNDMENT  
STAGE STORAGE DATA

ELEV feet	AREA acres	VOLUME ac-ft	CUM. VOLUME ac-ft
5401	0.15	0.00	0.00
5402	0.31	0.23	0.23
5403	0.47	0.40	0.63
5404	0.70	0.59	1.22
5405	0.98	0.85	2.07
5406	1.33	1.17	3.24
5407	1.74	1.55	4.79
5408	2.21	1.99	6.78
5408.5	2.44	1.22	8.00

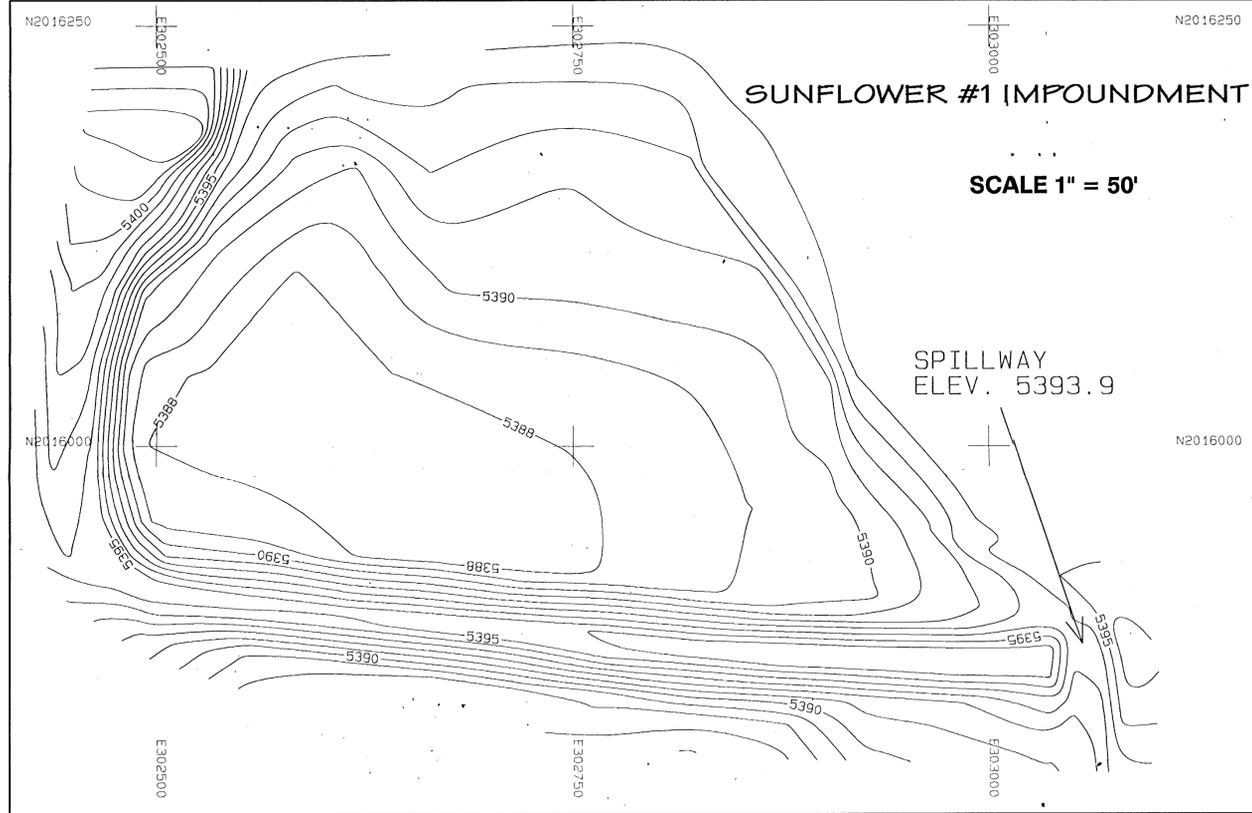


SUNFLOWER #1 IMPOUNDMENT

SCALE 1" = 50'

SPILLWAY  
ELEV. 5393.9

SUNFLOWER #1  
STAGE STORAGE DATA

ELEV feet	AREA acres	VOLUME ac-ft	CUM. VOLUME ac-ft
5388	0.58	0.00	0.00
5389	1.19	0.89	0.89
5390	1.69	1.45	2.34
5391	2.16	1.94	4.28
5392	2.54	2.37	6.65
5393	2.86	2.72	9.37
5393.9	3.18	2.86	12.23

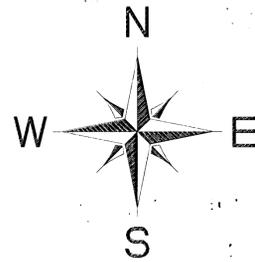

CERTIFICATION STATEMENT  
I, Leonard Raymond, hereby certify that this drawing was reviewed by me and that the information shown is accurate and complete to the best of my knowledge.



**BHP-NAVAJO COAL CO.**

PROJECT MANAGER: GREG PERKINS  
ENGR. of RECORD: LEONARD RAYMOND  
REC. NO. 6660  
SPWR of RECORD: [blank]  
REC. NO. [blank]


ACCOUNT: BHP NAVAJO  
DATE: MAY 04, 1997  
DESIGNED BY: F. T. JOHNSON  
DRAWN BY: LEONARD RAYMOND  
CHECKED BY: [blank]  
APPROVED BY: LEONARD RAYMOND

**PLAN**

**HIGHWALL IMPOUNDMENTS**  
SUNFLOWER #1 AND STUB 18  
(PRJD PROJ\_name?)

SHEET  
OF

PLOT: G:\USER\JOHNSON\PROJ\HIGHL\HIGHL.PLOT Plot Title: NAVAJO MAY 05 10:19:58 1997

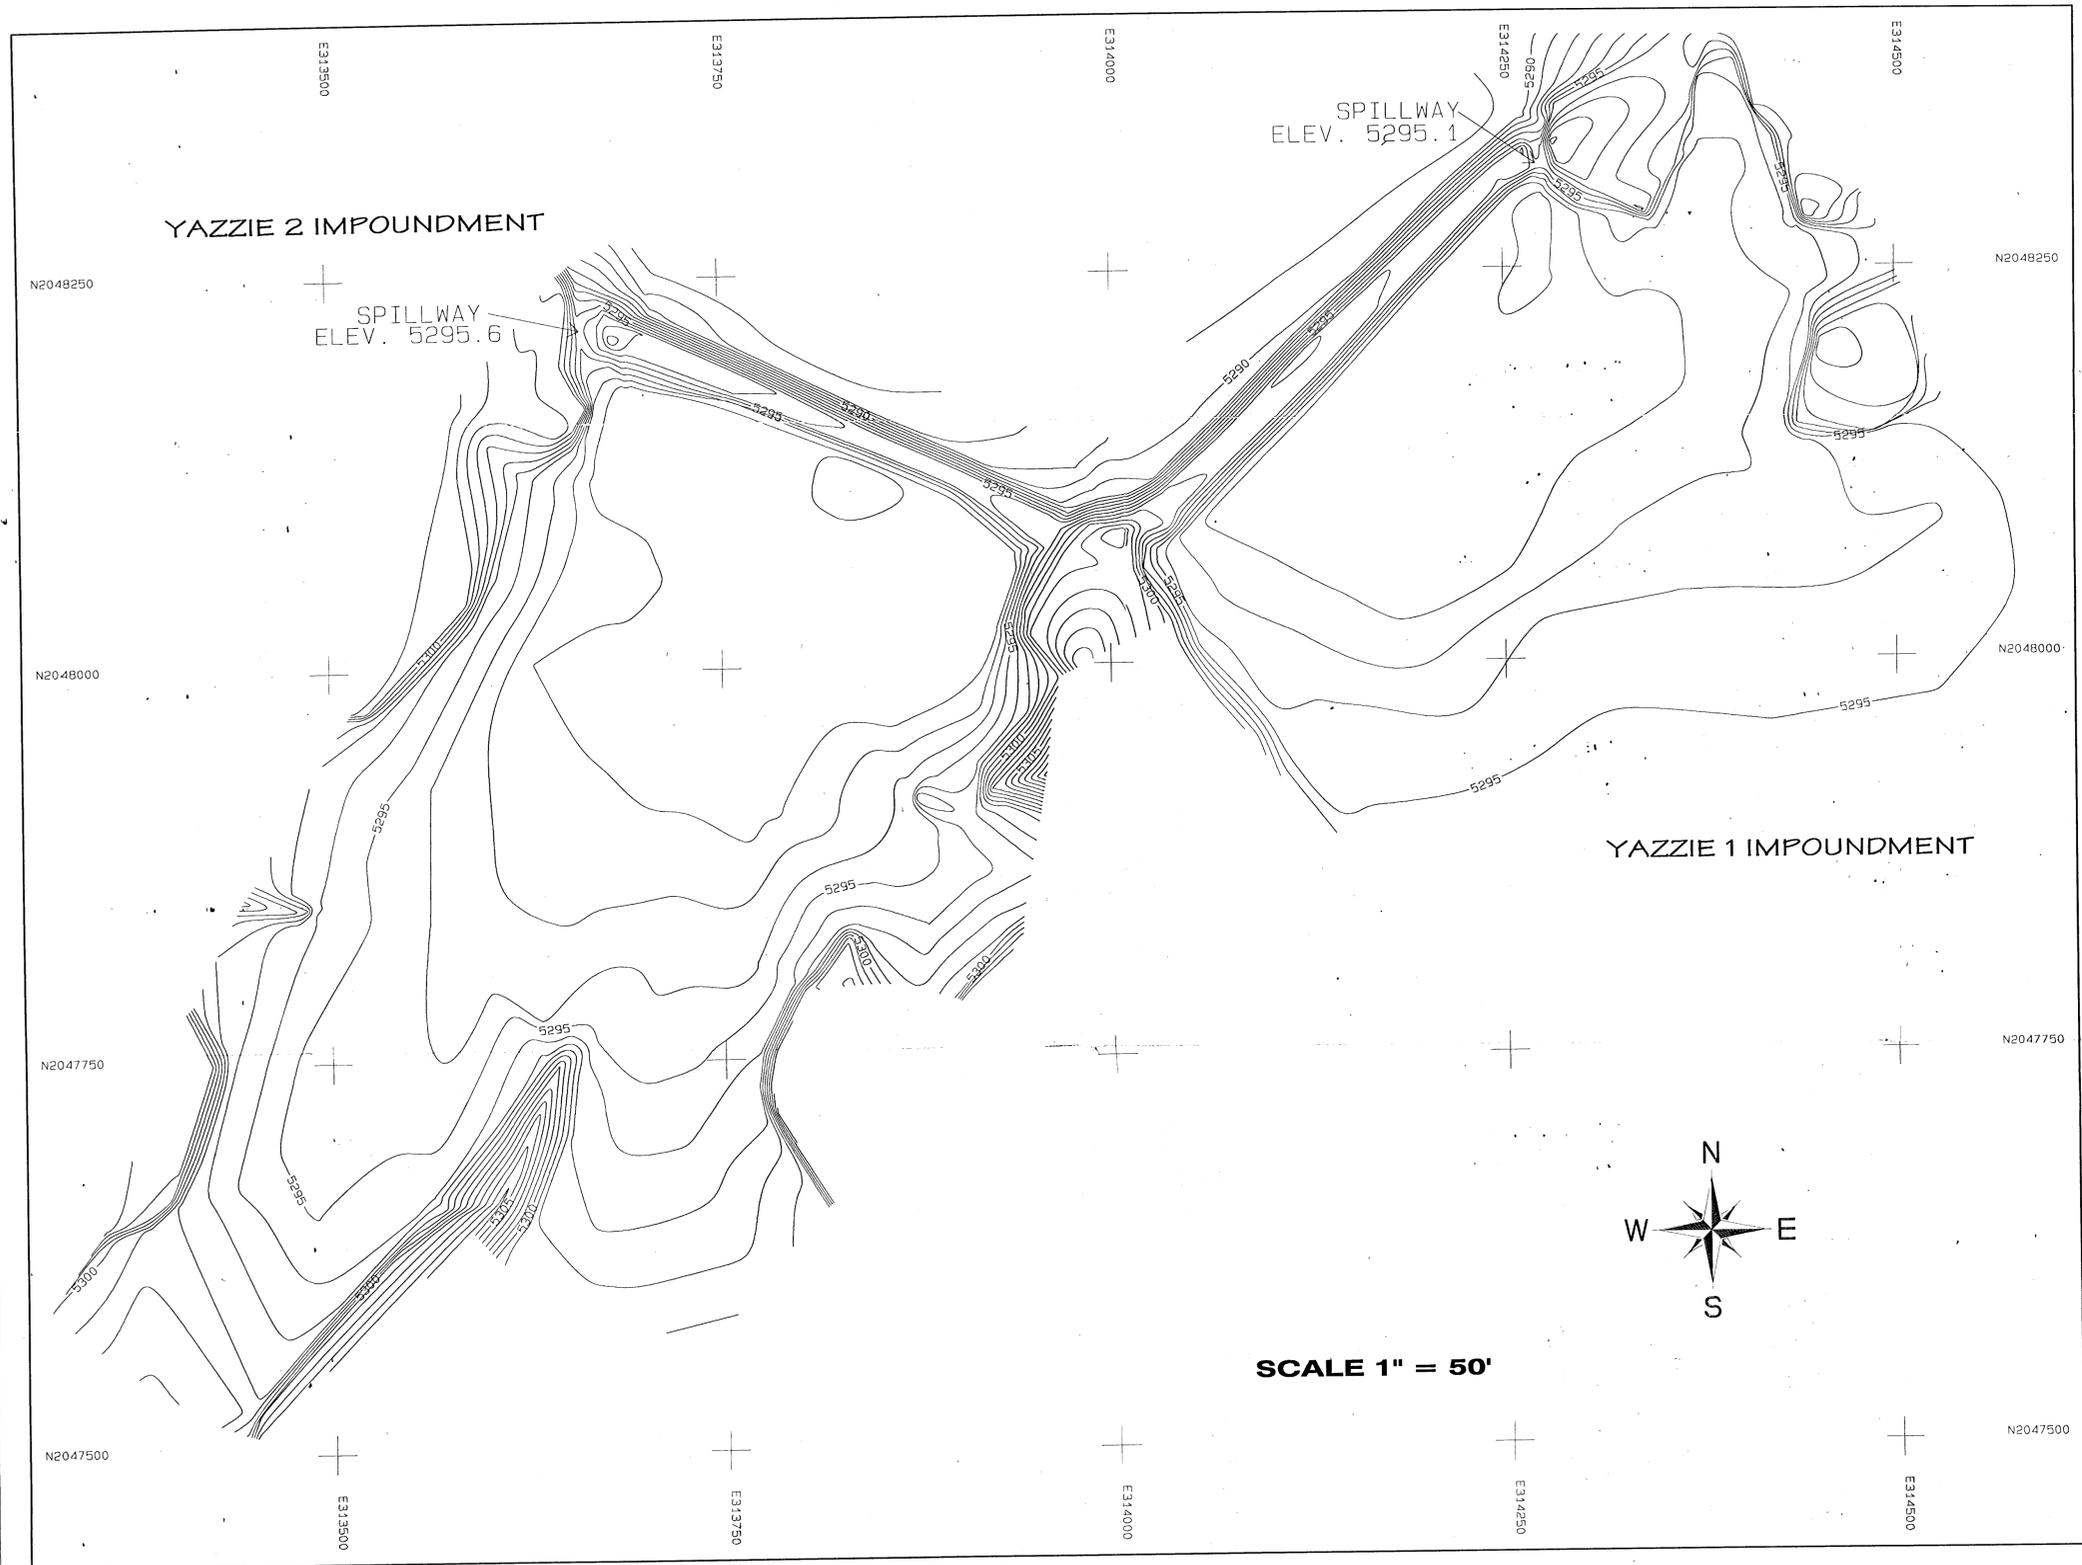


**YAZZIE 1 IMPOUNDMENT  
STAGE STORAGE DATA**

ELEV feet	AREA acres	VOLUME ac-ft	CUM. VOLUME ac-ft
5291	0.04	0.00	0.00
5292	0.98	0.52	0.52
5293	1.60	1.30	1.82
5294	2.30	1.96	3.78
5295	3.31	2.82	6.60
5295.1	3.41	0.34	6.94

**YAZZIE 2 IMPOUNDMENT  
STAGE STORAGE DATA**

ELEV feet	AREA acres	VOLUME ac-ft	CUM. VOLUME ac-ft
5291	0.04	0.00	0.00
5292	1.21	0.63	0.63
5293	1.80	1.52	2.15
5294	2.36	2.10	4.25
5295	3.10	2.75	7.00
5295.6	3.54	2.12	9.12

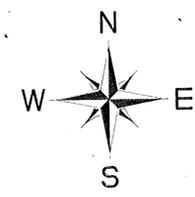

**SCALE 1" = 50'**



CERTIFICATION STATEMENT  
I, Leonard Raymond, hereby certify that this drawing was reviewed by me and that the information shown is accurate and complete to the best of my knowledge.

LEONARD RAYMOND  
REGISTERED PROFESSIONAL ENGINEER  
STATE OF NEW MEXICO  
NO. 11111  
5-6-11


**HIGHWALL IMPOUNDMENTS**  
YAZZIE 1 AND YAZZIE 2  
(PRJ01\_P03\_0802)

**PLAN**

**BHP-NAVAJO COAL CO.**  
PROJECT MANAGER: GREG PERDUE  
DATE: 05-05-97  
NO. OF SHEETS: 000  
SHEET NO.: 000  
DRAWN BY: LEONARD RAYMOND  
CHECKED BY: LEONARD RAYMOND  
APPROVED BY: LEONARD RAYMOND  
REV. NO.:  
REV. DATE:

SHEET  
OF



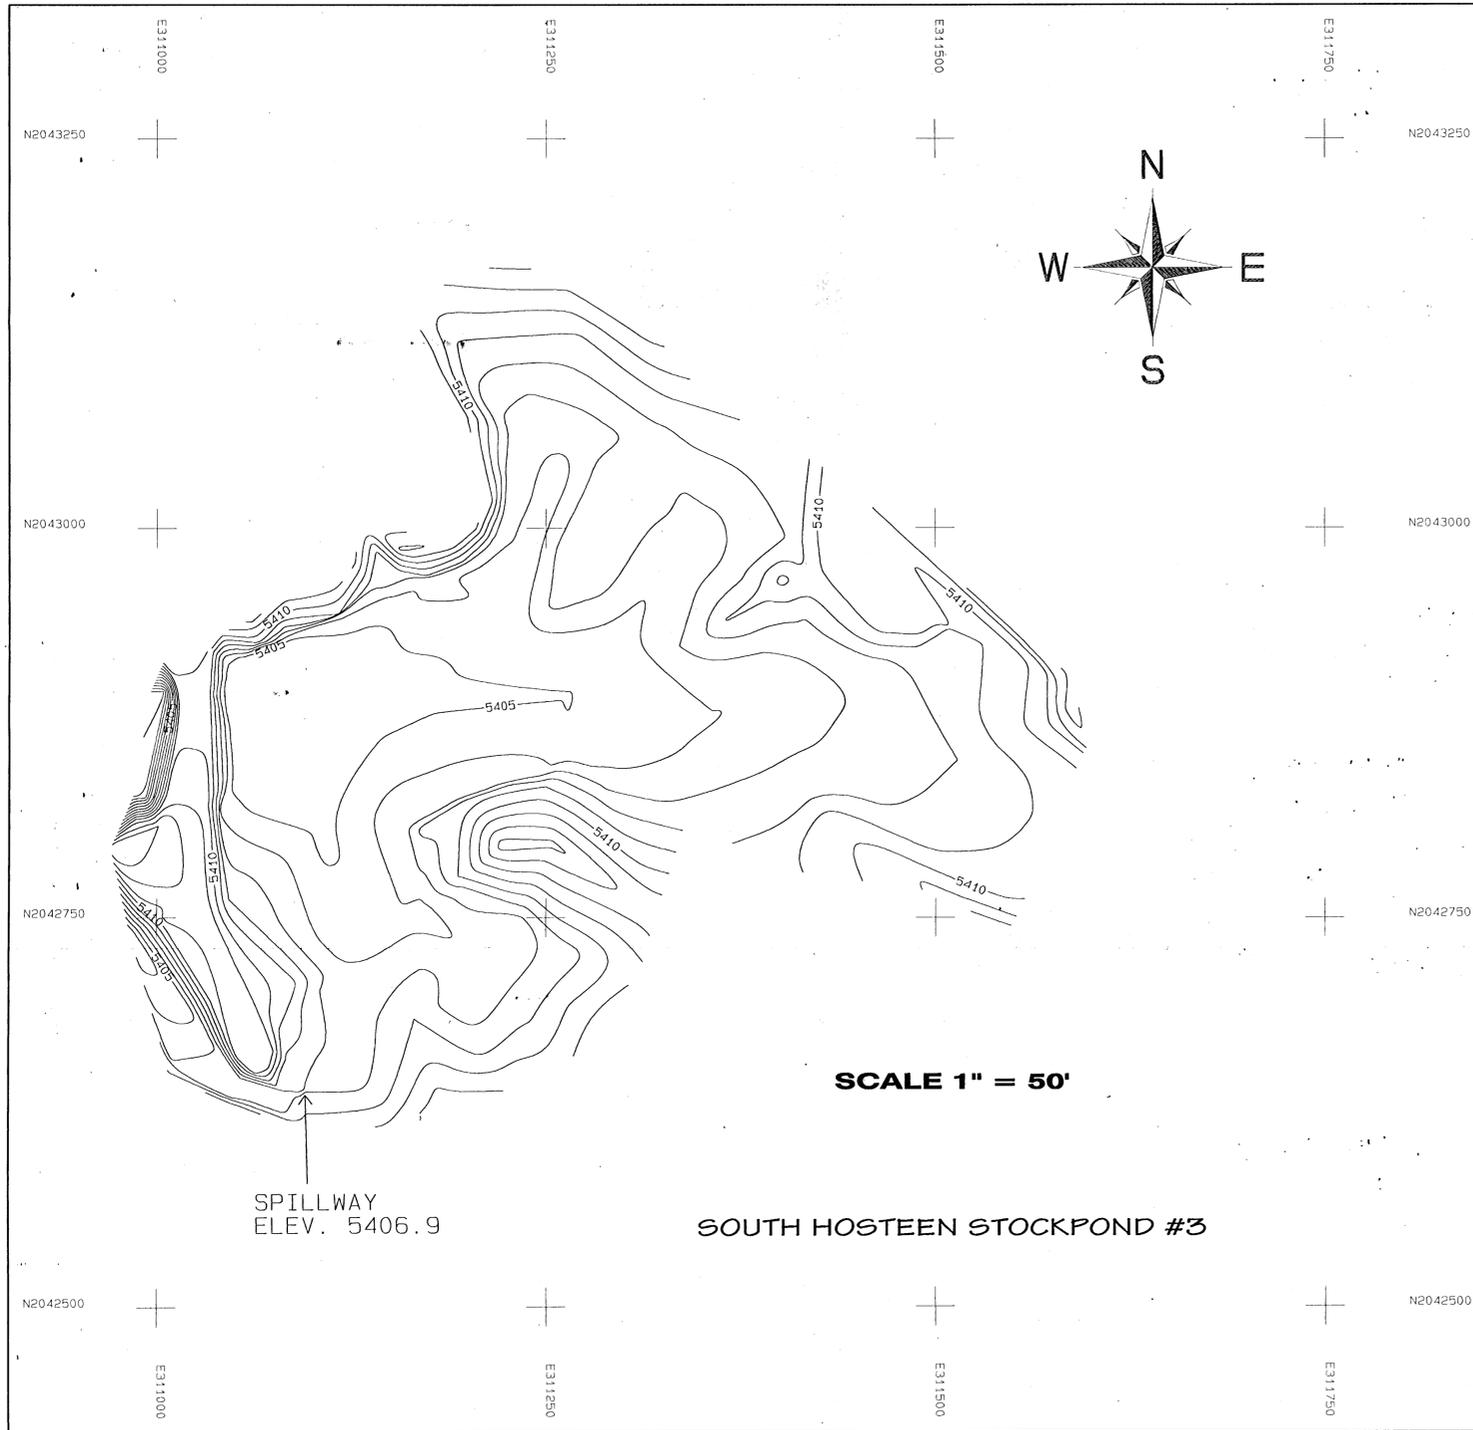

SCALE 1" = 50'

SOUTH HOSTEEN STOCKPOND #3

SPILLWAY  
ELEV. 5406.9

SOUTH HOSTEEN #3  
STAGE STORAGE DATA

ELEV feet	AREA acres	VOLUME ac-ft	CUM. VOLUME ac-ft
5405	0.32	0.00	0.00
5406	0.91	0.62	0.62
5406.9	1.44	1.30	1.92

CERTIFICATION STATEMENT  
I, Leonard Raymond, hereby certify that this drawing is accurate and complete to the best of my knowledge.

LEONARD RAYMOND  
REGISTERED PROFESSIONAL ENGINEER  
STATE OF NEW MEXICO  
No. 11-205



**HIGHWALL IMPOUNDMENTS**  
SOUTH HOSTEEN STOCKPOND #3  
(PRJ01)\_Name2



**PLAN**

**BHP-NAVAJO COAL CO.**  
PO BOX 504, FORTUNA, NEW MEXICO, 87416

PROJECT NUMBER: GREG PERKINS  
DRAWN BY: FREDERICK LEONARD RAYMOND  
DATE: MAY 05, 1997  
SCALE: AS SHOWN  
SHEET NO. 0

DATE: 05-05-97  
FOR GSA REVIEW: 05-05-97

APPROVED BY: LEONARD RAYMOND  
DRAWN BY: F. T. JOHNSON  
DATE: MAY 05, 1997  
PROJECT: BHP-NAVAJO COAL CO.

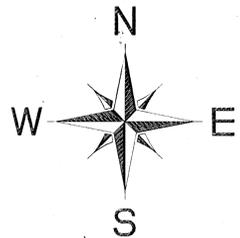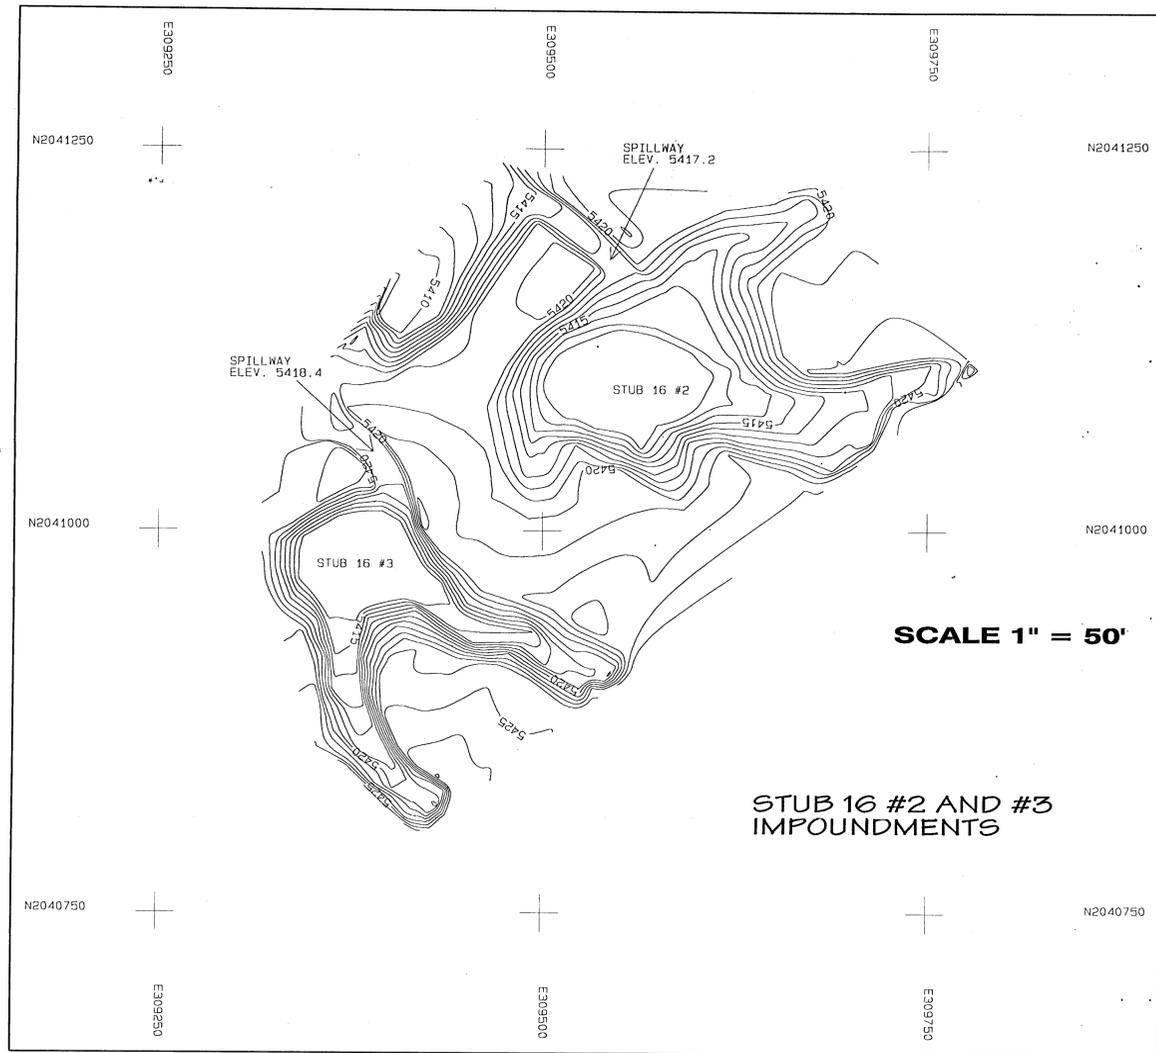

**STUB 16 #2  
STAGE STORAGE DATA**

ELEV feet	AREA acres	VOLUME ac-ft	CUM. VOLUME ac-ft
5411	9.2E-06	0.00	0.00
5412	0.13	0.06	0.06
5413	0.17	0.15	0.21
5414	0.24	0.21	0.42
5415	0.30	0.27	0.69
5416	0.37	0.34	1.03
5417	0.46	0.42	1.45
5417.2	0.48	0.10	1.55

**STUB 16 #3  
STAGE STORAGE DATA**

ELEV feet	AREA acres	VOLUME ac-ft	CUM. VOLUME ac-ft
5414	0.11	0.00	0.00
5415	0.14	0.12	0.12
5416	0.17	0.16	0.28
5417	0.21	0.19	0.47
5418	0.25	0.23	0.70
5418.4	0.27	0.11	0.81

**CERTIFICATION STATEMENT**  
 I, Leonard Raymond, hereby certify that this drawing is correct and that the information shown is accurate and complete to the best of my knowledge.

LEONARD RAYMOND  
 REGISTERED PROFESSIONAL ENGINEER  
 STATE OF NEW MEXICO  
 No. 12345  
 5-6-17



**HIGHWALL IMPOUNDMENTS**  
 STUB 16 #2 AND #3  
 (PRD\_0100\_7) (RMB2)

**PLAN**

**BHP-NAVAJO COAL CO.**  
 PO BOX 158, FRUITLAND, NEW MEXICO, 87416


PROJECT MANAGER: GREG PERKINS  
 ENGR. OF RECORD: LEONARD RAYMOND  
 REG. NO. 6800  
 STATE OF N.M.

ACCOUNT: PRD\_0100\_7  
 DATE: MAY 05, 1987  
 DESIGNED BY: F. J. JOHNSON  
 CHECKED BY: LEONARD RAYMOND  
 APPROVED BY: LEONARD RAYMOND

DATE: 05-05-87  
 1. DATE FOR REVIEW  
 2. DATE FOR REVIEW  
 3. DATE FOR REVIEW

SHEET  
 OF 0

DATE: 05-05-87  
 TIME: 10:52:11

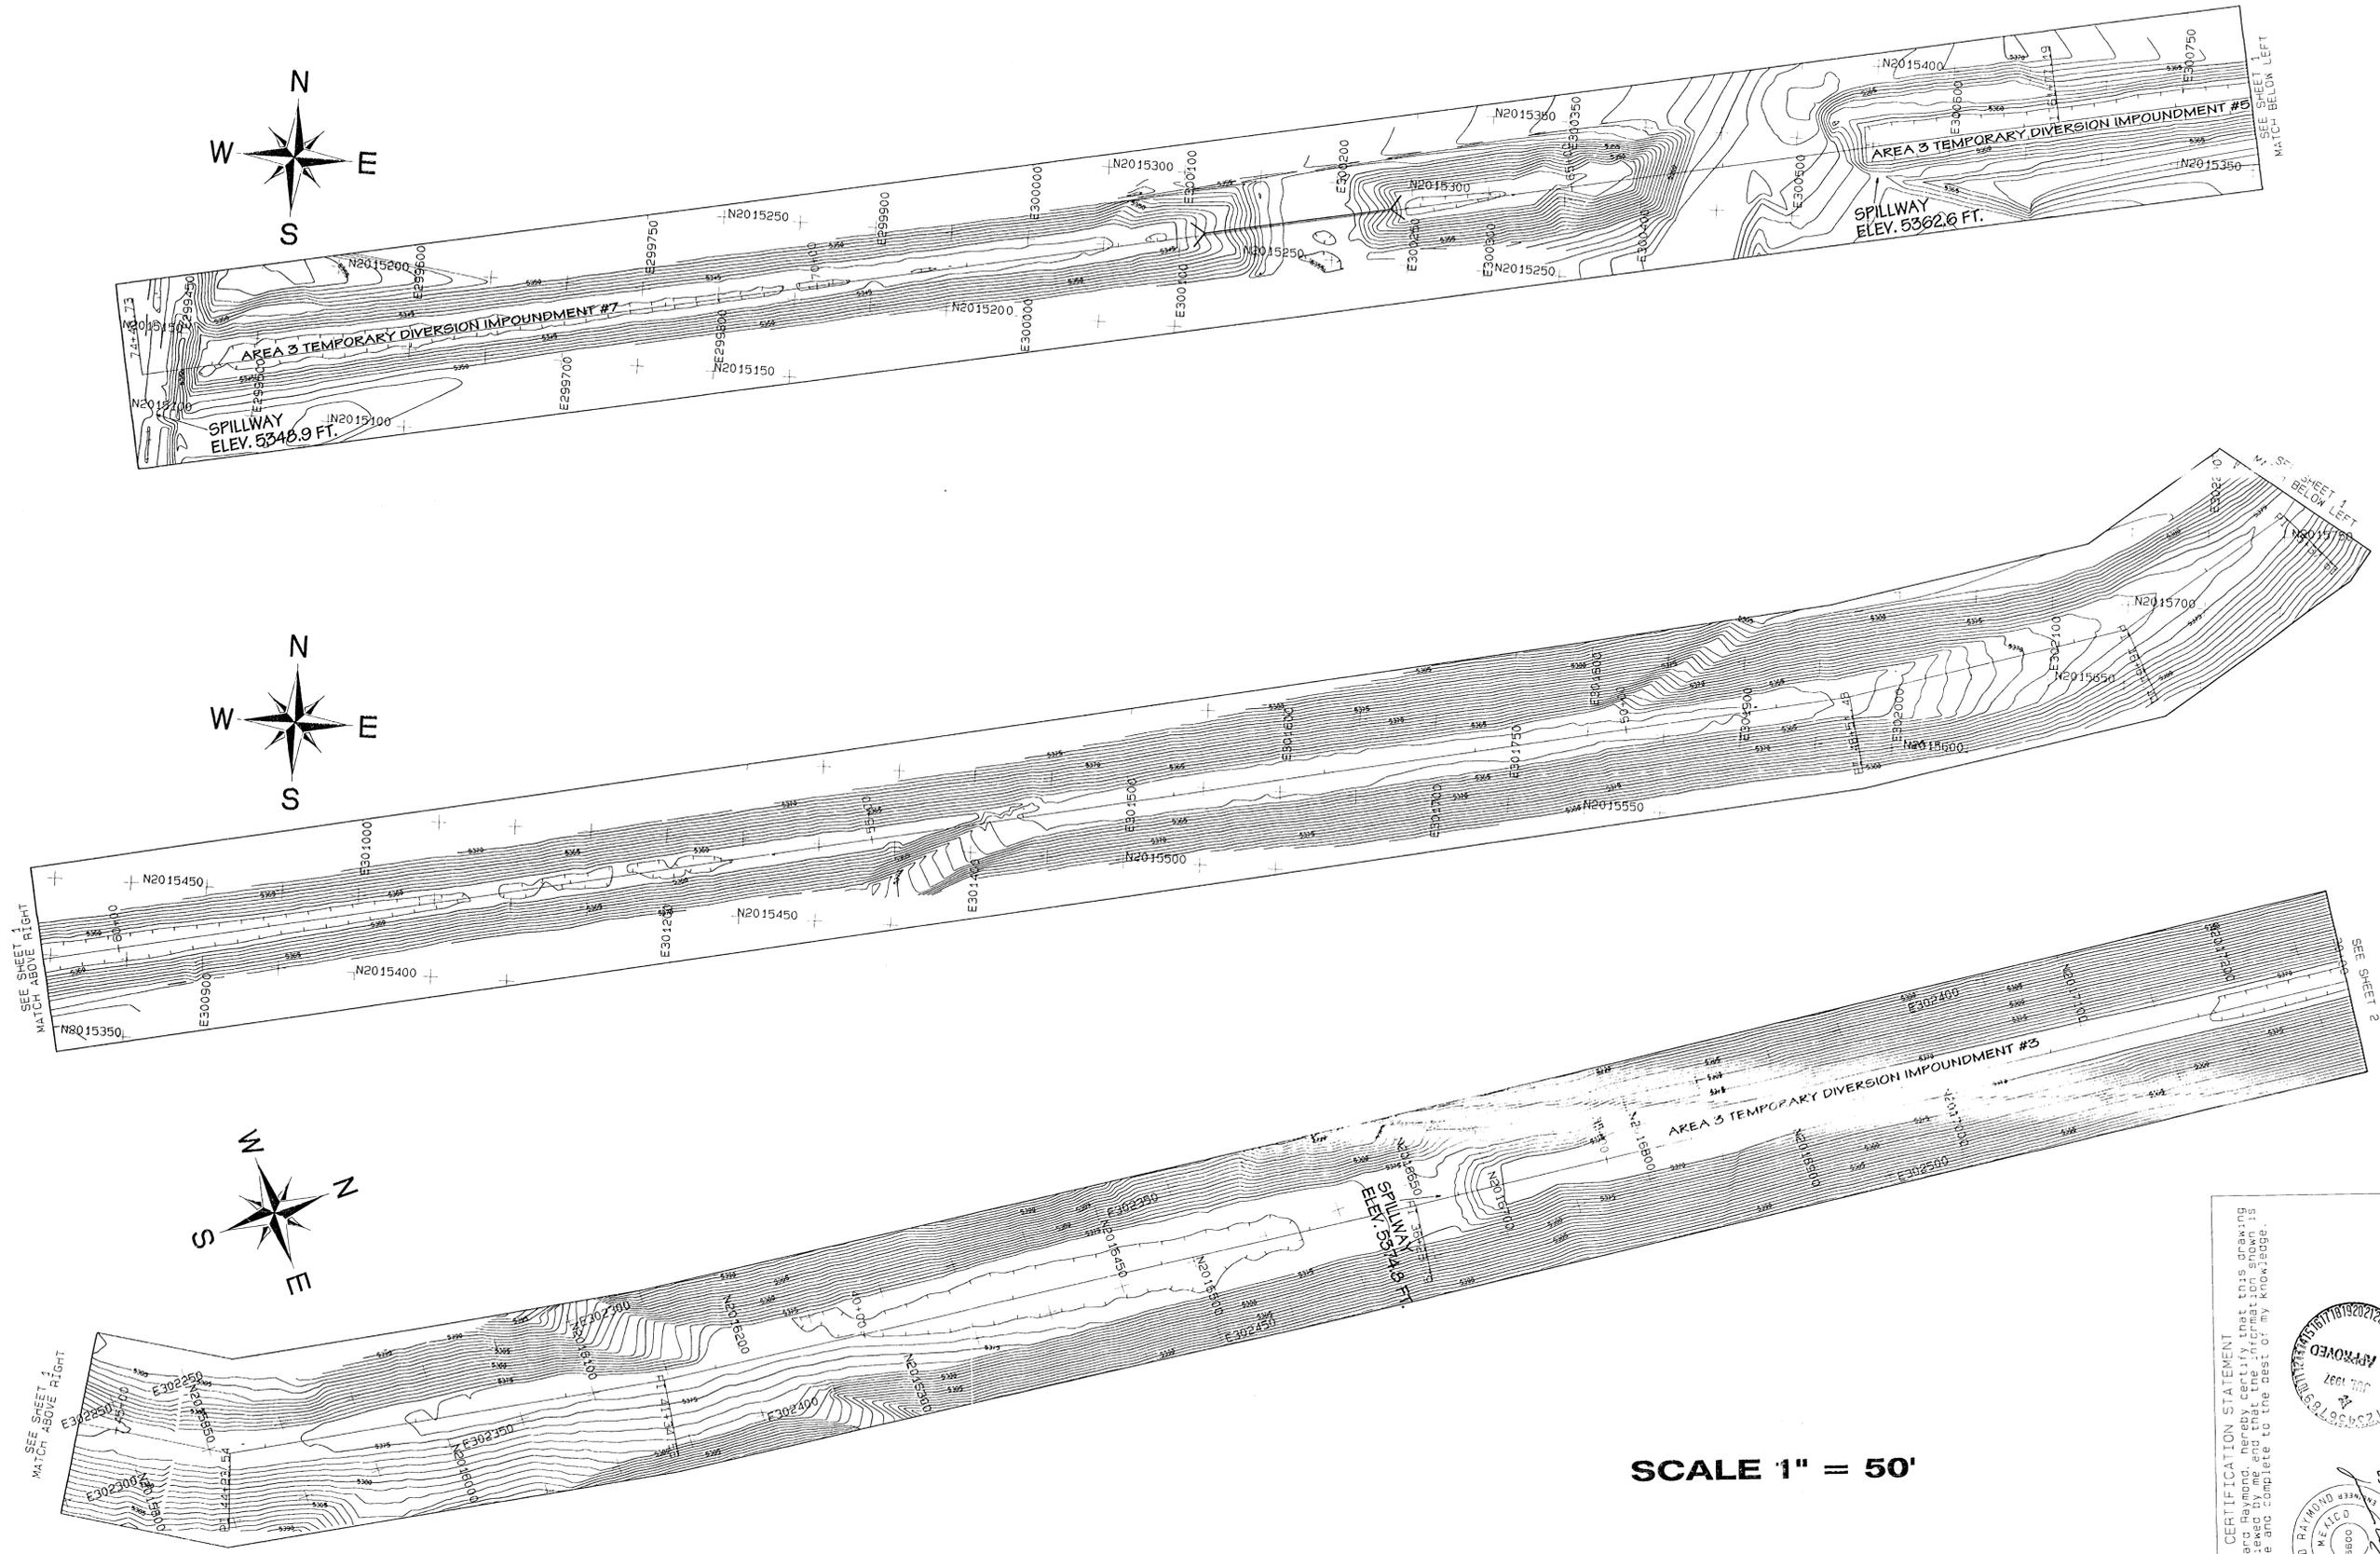

SCALE 1" = 50'

CERTIFICATION STATEMENT  
 I, Leonard Raymo, do hereby certify that this drawing is prepared and that the information shown is accurate and complete to the best of my knowledge.

APPROVED  
 JUN 11 1997  
 LEONARD RAYMO  
 REGISTERED PROFESSIONAL ENGINEER  
 NO. 6800  
 STATE OF MICHIGAN

ACCOUNT: BHP NAVAJCO  
 DATE: JAN 11 1997  
 DESIGNED BY: F. J. JOHNSON  
 DRAWN BY: LEONARD RAYMO  
 CHECKED BY: LEONARD RAYMO  
 APPROVED BY: LEONARD RAYMO

PROJECT MANAGER: GREG PERKINS  
 ENGINEER OF RECORD: LEONARD RAYMO  
 SURVEYOR OF RECORD: NO. 6800  
 SPRAYER OF RECORD: NO. 6800

FOR USE REVIEW  
 DATE: 06-11-97




**BHP-NAVAJO COAL CO.**

PO BOX 158 FRUITLAND, NEVADA 89418

**PLAN**

**HIGHWALL IMPOUNDMENTS**  
 AREA 3 TEMPORARY DIVERSION IMPOUNDMENTS

DRAWING  
 P-1  
 SHEET  
 OF 2

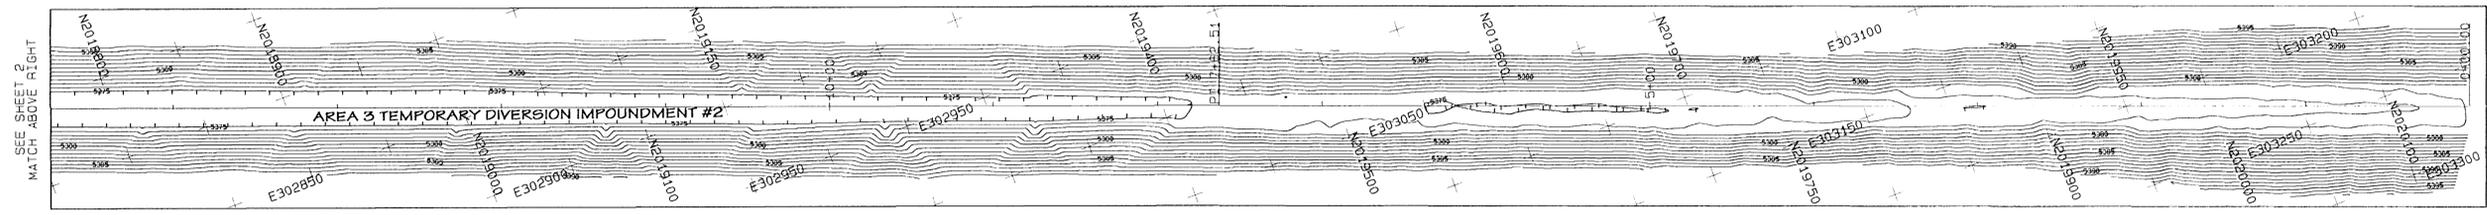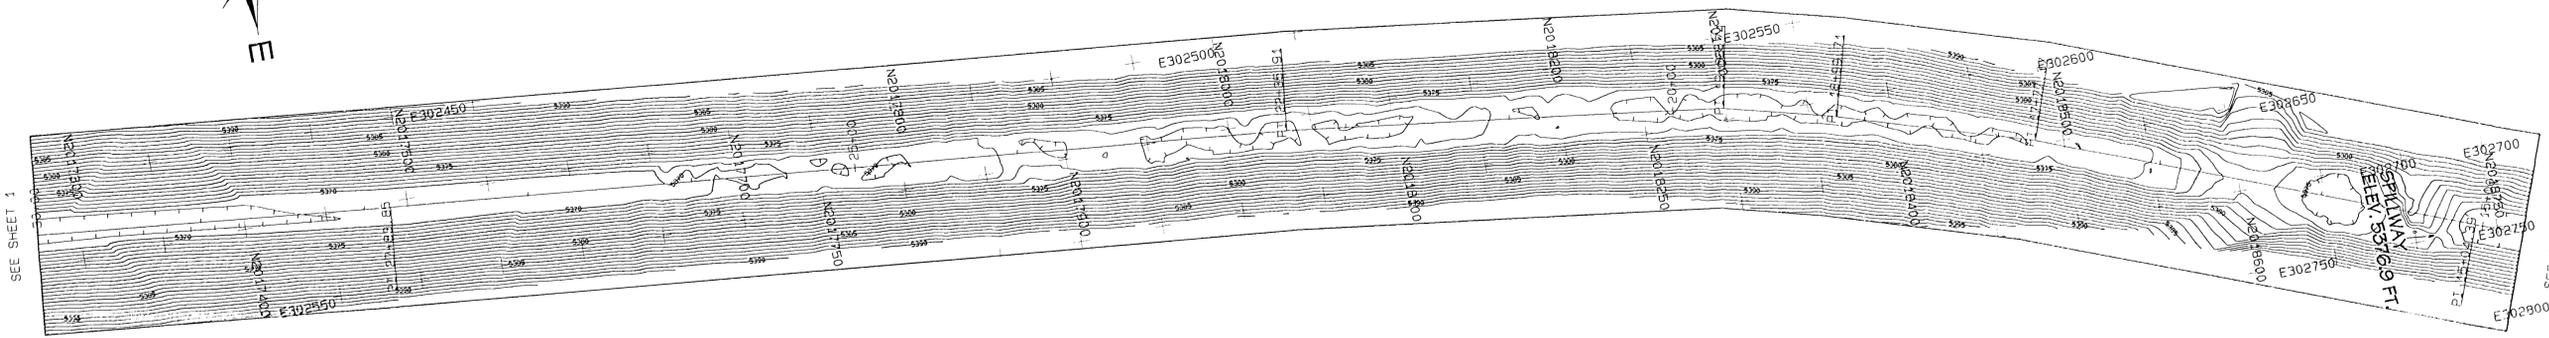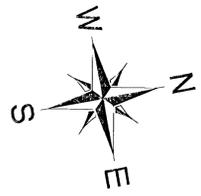

AREA 3 TEMPORARY DIVERSION IMPOUNDMENT #2 STAGE STORAGE DATA

ELEV feet	AREA acres	VOLUME ac-ft	CUM. VOLUME ac-ft
5375	0.31	0.00	0.00
5376	0.59	0.45	0.45
5376.9	0.84	0.76	1.21

AREA 3 TEMPORARY DIVERSION IMPOUNDMENT #3 STAGE STORAGE DATA

ELEV feet	AREA acres	VOLUME ac-ft	CUM. VOLUME ac-ft
5370	0.55	0.00	0.00
5371	0.74	0.65	0.65
5372	1.02	0.89	1.54
5373	1.41	1.22	2.76
5374	1.62	1.52	4.28
5374.8	1.79	1.43	5.71

AREA 3 TEMPORARY DIVERSION IMPOUNDMENT #5 STAGE STORAGE DATA

ELEV feet	AREA acres	VOLUME ac-ft	CUM. VOLUME ac-ft
5359	0.21	0.00	0.00
5360	0.40	0.31	0.31
5361	0.49	0.45	0.76
5362	0.79	0.64	1.40
5362.6	0.97	0.58	1.98



AREA 3 TEMPORARY DIVERSION IMPOUNDMENT #7 STAGE STORAGE DATA

ELEV feet	AREA acres	VOLUME ac-ft	CUM. VOLUME ac-ft
5343	0.09	0.00	0.00
5344	0.26	0.18	0.18
5345	0.37	0.32	0.50
5346	0.44	0.40	0.90
5347	0.55	0.73	1.63
5348	0.65	0.86	2.49
5348.9	0.74	0.67	3.16

SCALE 1" = 50'


CERTIFICATION STATEMENT  
I, Leonard Raymond, hereby certify that this drawing was reviewed by me and that the information shown is accurate and complete to the best of my knowledge.

SEE SHEET 1

SEE SHEET 2  
MATCH ABOVE RIGHT

SEE SHEET 2  
MATCH BELOW LEFT

DATE: 06-11-97  
PROJECT MANAGER: GREG PERKINS  
ENGR. OF RECORD: LEONARD RAYMOND  
DESIGNED BY: F. J. JOHNSON  
CHECKED BY: LEONARD RAYMOND  
APPROVED BY: LEONARD RAYMOND  
ACCOUNT: P.R.D. 151V/151W  
DATE: JUNE 11, 1997  
DESIGNED BY: F. J. JOHNSON  
CHECKED BY: LEONARD RAYMOND  
APPROVED BY: LEONARD RAYMOND  
BHP-NAVAJO COAL CO.  
PO BOX 158, PRUITT, WASH. NEW MEXICO, 87416  
HIGHWALL IMPOUNDMENTS  
AREA 3 TEMPORARY DIVERSION IMPOUNDMENTS  
DRAWING P-2  
SHEET OF 2

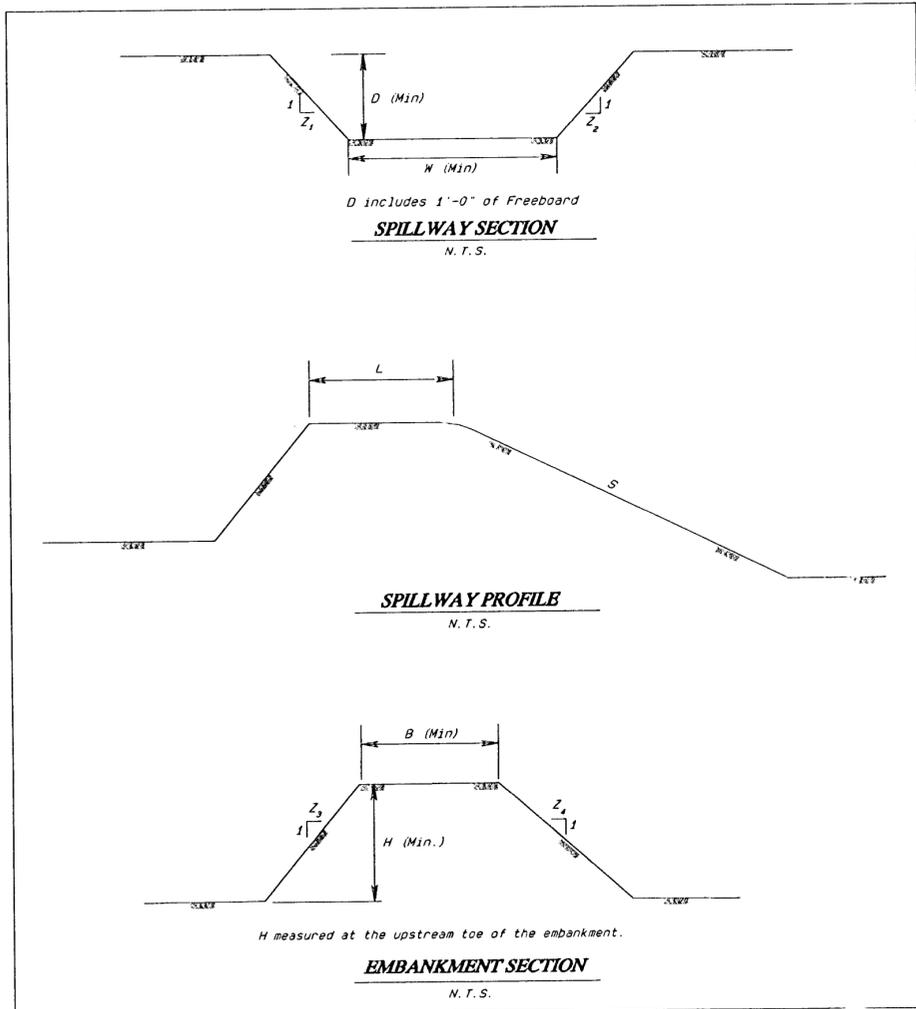

Impoundment ID	Watershed Area (Acres)	Peak Discharge (CFS)	Abutment (1)					Abutment (2)					Comments
			W	H	S	Z <sub>1</sub>	Z <sub>2</sub>	W	H	S	Z <sub>1</sub>	Z <sub>2</sub>	
razzle stockpond #1	125.5	30.8	20.0	4.7	3.8	3.0	29.4	25.0	15.2	5.1	2.0	2.8	
razzle stockpond #2	174.1	116.2	24.5	2.8	3.0	2.8	27.6	16.0	15.1	4.7	2.6	2.2	
South Hester Impoundment #1	80.1	73.3	5.0	3.1	5.0	4.5	22.7	9.0	16.5	4.6	2.1	2.0	
South Hester Impoundment #2	37.7	89.3	20.0	3.0	6.0	2.2	12.0	4.5	14.2	6.2	2.0	2.1	
South Hester Impoundment #3	157.3	115.7	14.5	3.7	1.5	1.5	32.0	12.0	18.0	4.5	2.3	2.0	
Strut 16 Impoundment #1	22.2	24.3	12.5	4.0	3.0	3.0	25.0	7.0	26.0	8.1	2.6	3.6	
Strut 16 Impoundment #2	11.1	15.5	12.5	3.1	2.2	3.2	24.0	15.0	26.0	5.1	2.2	2.0	
Strut 16 Impoundment #3	103.4	69.9	14.0	4.5	2.4	3.3	28.0	7.0	17.5	10.0	2.0	2.0	
Sunflower #1	24.6	17.3	15.0	3.1	4.3	6.2	38.0	2.2	9.0	7.5	4.8	3.9	
Area 1 Temp. Div. Imp. #1	29.9	21.9	3.4	2.7	2.1	1.8	16.0	6.0	10.0	6.2	4.3	2.9	
Area 2 Temp. Div. Imp. #2	26.8	23.9	30.0	2.0	2.0	18.0	2.5	18.0	5.9	4.0	20.0		
Area 3 Temp. Div. Imp. #3	11.1	25.2	10.4	2.2	4.3	2.2	25.0	1.8	20.0	9.5	2.0	1.6	
Area 7 Temp. Div. Imp. #7	16.5	21.9	12.5	2.1	5.0	1.7	50.0	0.5	73.0	8.5	2.9	4.0	

(1) The data under each impoundment are the current dimensions of the structure. These indicate that the existing structures are adequate.

Note: For supporting design data refer to Appendix 11011 Highwall Impoundment Design and Appendix 11012 Impoundment Construction in the Main Report.

**CERTIFICATION STATEMENT**

I, Leonard Raymond, hereby certify that this drawing was reviewed by me and that the information shown is accurate and complete to the best of my knowledge.



REV. NO.	DATE	CAUSE BY	REVISION DESCRIPTION	ENG.	E.G.	P.E.	P.S.	CHIEF ENG.
C	10-30-97	PJF	REMOVED EXHIBIT NO.					PS
B	08-27-97	FTJ	REVISED TABLE					
A	03-27-97	PJF	SUBMITTED TO DSM FOR APPROVAL					

**BHP NAVAJO COAL COMPANY**




P.O. BOX 155 FRUITLAND, NEW MEXICO 87416

**HIGHWALL IMPOUNDMENTS**

**"AS BUILT"**

PREPARED BY LR	DRAWN BY PJF	SCALE AS NOTED
APPROVED BY LR	DATE 03-25-97	MYLAR LOC. A13-2
PATH: J:\OSM_SUBM\PER_PROG\CH_11\HWSTR\HWLIMP.PRO		

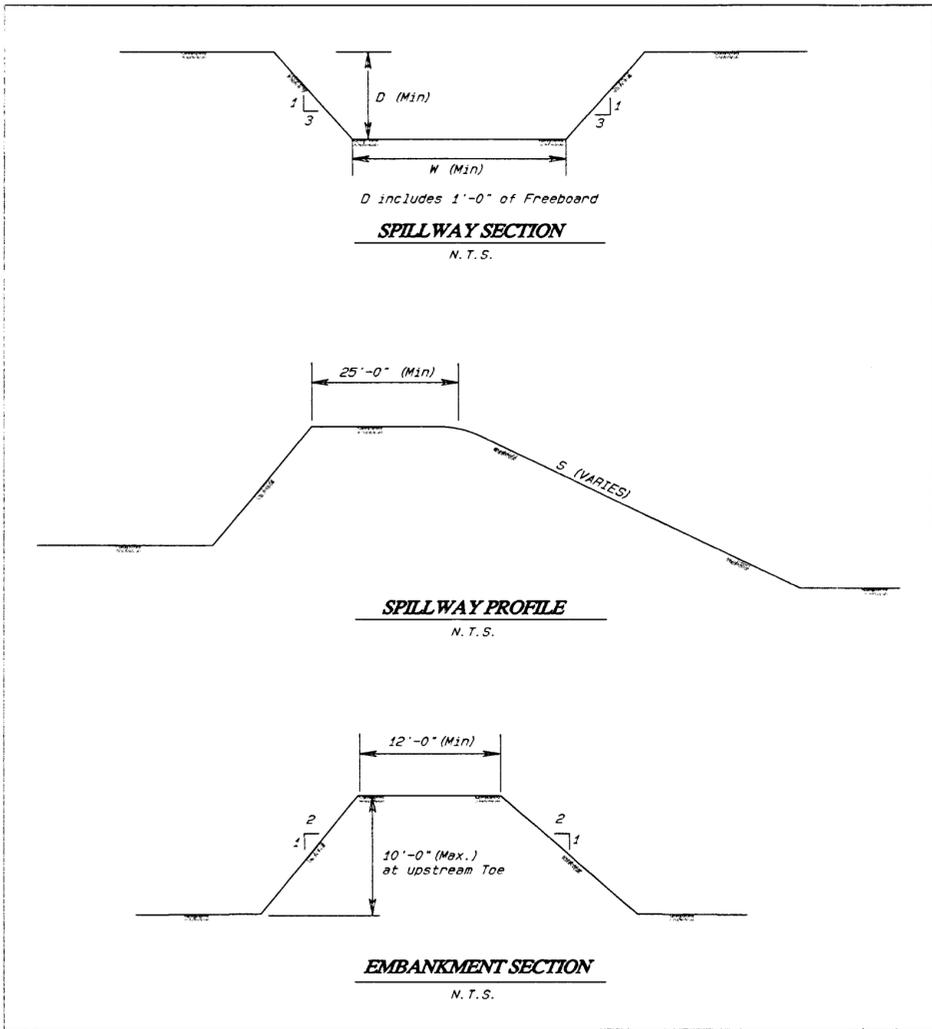

SPILLWAY SCHEDULE				
Watershed Area (acres)	CN	Discharge Peak (cfs)	Spillway	
			D (ft)	W (ft)
25.0	93.0	33.3	2.00	15.00
	90.0	27.0	2.00	15.00
	86.0	20.2	2.00	10.00
	83.0	15.8	2.00	10.00
50.0	93.0	58.7	2.25	20.00
	90.0	47.1	2.00	20.00
	86.0	34.5	2.00	15.00
	83.0	25.9	2.00	15.00
75.0	93.0	80.5	2.25	25.00
	90.0	64.2	2.25	20.00
	86.0	46.7	2.00	20.00
	83.0	36.1	2.00	15.00
100.0	93.0	100.2	2.50	20.00
	90.0	79.5	2.25	25.00
	86.0	57.6	2.25	20.00
	83.0	44.3	2.00	20.00
150.0	93.0	134.1	2.75	25.00
	90.0	105.7	2.50	25.00
	86.0	76.3	2.25	25.00
	83.0	58.3	2.00	25.00
200.0	93.0	163.8	3.00	20.00
	90.0	129.0	2.75	20.00
	86.0	92.7	2.50	20.00
	83.0	70.7	2.25	20.00
300.0	93.0	214.8	3.00	30.00
	90.0	169.4	3.00	20.00
	86.0	121.2	2.50	25.00
	83.0	92.2	2.50	20.00
400.0	93.0	259.5	3.25	30.00
	90.0	204.7	3.00	25.00
	86.0	146.2	2.75	25.00
	83.0	111.6	2.50	25.00
500.0	93.0	300.2	3.50	25.00
	90.0	236.5	3.25	25.00
	86.0	169.9	3.00	20.00
	83.0	129.1	2.75	20.00
600.0	93.0	337.4	3.50	30.00
	90.0	265.7	3.25	30.00
	86.0	189.6	3.00	25.00
	83.0	145.1	2.75	25.00
700.0	93.0	372.1	3.75	30.00
	90.0	292.9	3.50	25.00
	86.0	209.1	3.00	25.00
	83.0	160.0	3.00	20.00

Note: For supporting design data refer to Appendix 11-II "Highwall Impoundment Design and As-built Information" in the Mine Permit.

**CERTIFICATION STATEMENT**

I, Leonard Raymond, hereby certify that this drawing was reviewed by me and that the information shown is accurate and complete to the best of my knowledge.



REV. No.	DATE	DRAFT. BY	REVISION DESCRIPTION	ENG.	I.O.	P.E.	P.S.	CHIEF ENG.
<b>BHP NAVAJO COAL COMPANY</b>  P.O. BOX 155 FRUITLAND, NEW MEXICO 87416								
<b>HIGHWALL IMPOUNDMENTS</b> <b>STANDARD DESIGN</b>								
PREPARED BY LR			DRAWN BY PJF			SCALE AS NOTED		
APPROVED BY LR			DATE 03-25-97			MYLAR LOC. A13-2		
PATH: J:\OSM_SUBM\PER_PROG\CH_11\HWSTR\HGWL IMP.PRO								

**Appendix 26.E**

North Fork Diversion Channel

February 2001

---

# **NORTH FORK DIVERSION CHANNEL**

## **HYDROLOGY**

**FEBRUARY 2001**

# **NORTH FORK DIVERSION CHANNEL**

***Hydrology model for the North Fork Diversion Channel. Refer to Exhibit 11-142A for the SEDCAD watershed subdivisions and Exhibit 11-142B & 142C for design plan, profile, and sections.***

LR

BHP Navajo Coal Company  
Navajo Mine  
PO Box 1717  
Fruitland, NM 87415

Phone: 505-598-5861

***General Information***

***Storm Information:***


Storm Type:	NRCS Type II-60
Design Storm:	2 yr - 6 hr
Rainfall Depth:	0.800 inches

# SEDCAD 4 for Windows

Copyright 1998 Pamela J. Schwab  
Civil Software Design

## Structure Networking:

Type	Stru #	(flows into)	Stru #	Musk. K (hrs)	Musk. X	Description
Null	#24	==>	#25	0.964	0.340	
Null	#25	==>	#27	1.454	0.333	
Null	#26	==>	#27	1.454	0.333	
Null	#27	==>	#29	0.800	0.323	
Null	#28	==>	#29	0.800	0.323	
Null	#29	==>	#32	0.479	0.298	
Null	#30	==>	#32	0.479	0.298	
Null	#31	==>	#33	0.000	0.000	
Null	#32	==>	#33	0.000	0.000	
Null	#33	==>	End	0.000	0.000	Inlet to North Fork Diversion

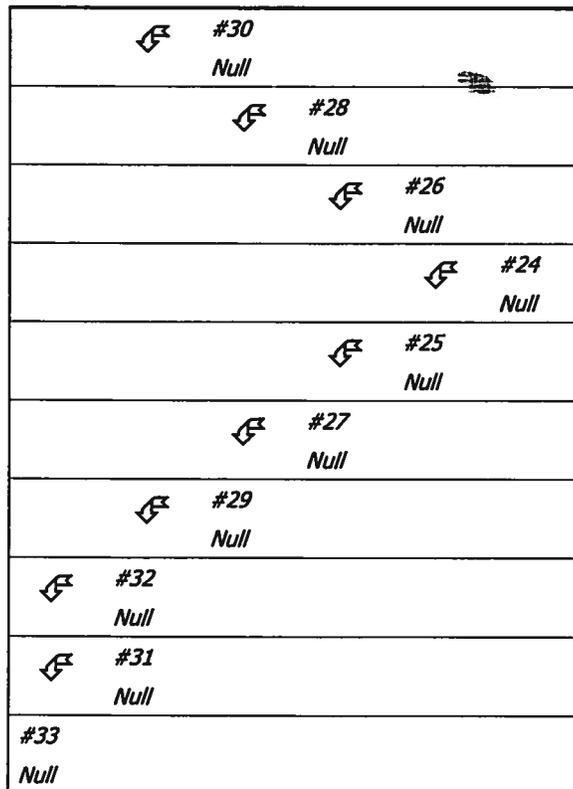

## Structure Routing Details:

# SEDCAD 4 for Windows

Copyright 1998 Pamela J. Schwab  
Civil Software Design

Stru #	Land Flow Condition	Slope (%)	Vert. Dist. (ft)	Horiz. Dist. (ft)	Velocity (fps)	Time (hrs)
#24	8. Large gullies, diversions, and low flowing streams	1.46	184.00	12,568.00	3.62	0.964
<b>#24</b>	<b>Muskingum K:</b>					<b>0.964</b>
#25	8. Large gullies, diversions, and low flowing streams	1.28	228.00	17,755.00	3.39	1.454
<b>#25</b>	<b>Muskingum K:</b>					<b>1.454</b>
#26	8. Large gullies, diversions, and low flowing streams	1.28	228.00	17,755.62	3.39	1.454
<b>#26</b>	<b>Muskingum K:</b>					<b>1.454</b>
#27	8. Large gullies, diversions, and low flowing streams	1.07	96.00	8,938.00	3.10	0.800
<b>#27</b>	<b>Muskingum K:</b>					<b>0.800</b>
#28	8. Large gullies, diversions, and low flowing streams	1.07	96.00	8,938.00	3.10	0.800
<b>#28</b>	<b>Muskingum K:</b>					<b>0.800</b>
#29	8. Large gullies, diversions, and low flowing streams	0.70	30.00	4,313.00	2.50	0.479
<b>#29</b>	<b>Muskingum K:</b>					<b>0.479</b>
#30	8. Large gullies, diversions, and low flowing streams	0.70	30.00	4,313.00	2.50	0.479
<b>#30</b>	<b>Muskingum K:</b>					<b>0.479</b>

***Structure Summary:***

	Immediate Contributing Area (ac)	Total Contributing Area (ac)	Peak Discharge (cfs)	Total Runoff Volume (ac-ft)
#30	476.400	476.400	0.20	0.04
#28	1,217.900	1,217.900	127.50	21.24
#26	2,486.400	2,486.400	5.44	2.30
#24	8,061.800	8,061.800	6.64	4.91
#25	1,015.700	9,077.500	25.38	9.08
#27	1,783.700	13,347.600	51.42	18.56
#29	966.000	15,531.500	173.24	56.11
#32	293.700	16,301.600	178.81	63.51
#31	957.100	957.100	135.01	21.90
#33	0.000	17,258.700	243.60	85.41

# SEDCAD 4 for Windows

Copyright 1988 Pamela J. Schwab  
Civil Software Design

## Subwatershed Hydrology Detail:

Stru #	SWS #	SWS Area (ac)	Time of Conc (hrs)	Musk K (hrs)	Musk X	Curve Number	UHS	Peak Discharge (cfs)	Runoff Volume (ac-ft)
#30	1	476.400	1.131	0.000	0.000	73.100	M	0.20	0.043
$\Sigma$		<b>476.400</b>						<b>0.20</b>	<b>0.043</b>
#28	1	772.300	0.657	0.523	0.334	90.400	M	106.00	13.472
	2	445.600	0.587	0.000	0.000	90.400	M	65.74	7.773
$\Sigma$		<b>1,217.900</b>						<b>127.50</b>	<b>21.244</b>
#26	1	447.600	2.192	0.000	0.000	74.200	M	0.34	0.114
	2	2,038.800	3.000	0.000	0.000	77.000	M	5.10	2.186
$\Sigma$		<b>2,486.400</b>						<b>5.44</b>	<b>2.300</b>
#24	1	2,607.500	5.367	2.377	0.305	75.200	M	2.02	1.246
	2	2,331.900	4.813	2.431	0.304	74.700	M	1.48	0.833
	3	1,758.500	2.231	1.788	0.297	76.200	M	3.66	1.366
	4	1,363.900	2.618	0.000	0.000	77.000	M	3.63	1.463
$\Sigma$		<b>8,061.800</b>						<b>6.64</b>	<b>4.907</b>
#25	1	515.200	0.990	0.342	0.357	78.200	M	3.32	0.833
	2	130.500	0.787	0.342	0.357	78.100	M	0.89	0.204
	3	370.000	0.516	0.000	0.000	85.700	M	25.34	3.140
$\Sigma$		<b>9,077.500</b>						<b>25.38</b>	<b>9.084</b>
#27	1	354.400	0.612	1.233	0.337	83.100	M	11.81	1.882
	2	305.200	0.529	1.054	0.328	84.000	M	14.02	1.922
	3	289.800	0.692	0.551	0.328	75.500	M	0.59	0.162
	4	253.000	0.361	0.551	0.328	79.400	M	3.26	0.579
	5	581.300	0.980	0.000	0.000	82.300	M	12.58	2.629
$\Sigma$		<b>13,347.600</b>						<b>51.42</b>	<b>18.559</b>
#29	1	508.800	0.409	0.416	0.312	89.500	M	80.63	7.795
	2	233.200	0.521	0.291	0.312	91.600	M	44.78	4.818
	3	224.000	0.467	0.000	0.000	90.000	M	35.63	3.690
$\Sigma$		<b>15,531.500</b>						<b>173.24</b>	<b>56.106</b>
#32	1	293.700	0.576	0.000	0.000	93.000	M	65.60	7.363
$\Sigma$		<b>16,301.600</b>						<b>178.81</b>	<b>63.512</b>
#31	1	431.100	0.588	0.450	0.336	91.500	M	75.71	8.782
	2	325.800	0.432	0.149	0.327	93.000	M	85.40	8.167
	3	200.200	0.373	0.000	0.000	92.900	M	55.57	4.950
$\Sigma$		<b>957.100</b>						<b>135.01</b>	<b>21.900</b>

# SEDCAD 4 for Windows

Copyright 1998 Pamela J. Schwab  
Civil Software Design

Stru #	SWS #	SWS Area (ac)	Time of Conc (hrs)	Musk K (hrs)	Musk X	Curve Number	UHS	Peak Discharge (cfs)	Runoff Volume (ac-ft)
#33	Σ	17,258.700						243.60	85.412

## Subwatershed Time of Concentration Details:

Stru #	SWS #	Land Flow Condition	Slope (%)	Vert. Dist. (ft)	Horiz. Dist. (ft)	Velocity (fps)	Time (hrs)
#24	1	5. Nearly bare and untilled, and alluvial valley fans	1.71	430.00	25,118.00	1.300	5.367
#24	1	<b>Time of Concentration:</b>					<b>5.367</b>
#24	2	5. Nearly bare and untilled, and alluvial valley fans	1.84	430.00	23,393.00	1.350	4.813
#24	2	<b>Time of Concentration:</b>					<b>4.813</b>
#24	3	5. Nearly bare and untilled, and alluvial valley fans	1.82	155.00	8,498.00	1.350	1.748
		8. Large gullies, diversions, and low flowing streams	0.84	40.00	4,771.00	2.740	0.483
#24	3	<b>Time of Concentration:</b>					<b>2.231</b>
#24	4	5. Nearly bare and untilled, and alluvial valley fans	1.24	50.00	4,042.00	1.110	1.011
		8. Large gullies, diversions, and low flowing streams	0.49	60.00	12,150.00	2.100	1.607
#24	4	<b>Time of Concentration:</b>					<b>2.618</b>
#25	1	5. Nearly bare and untilled, and alluvial valley fans	0.51	10.00	1,950.00	0.710	0.762
		8. Large gullies, diversions, and low flowing streams	1.81	60.00	3,322.00	4.030	0.228
#25	1	<b>Time of Concentration:</b>					<b>0.990</b>
#25	2	5. Nearly bare and untilled, and alluvial valley fans	1.11	25.00	2,254.00	1.050	0.596
		8. Large gullies, diversions, and low flowing streams	2.36	75.00	3,178.00	4.600	0.191
#25	2	<b>Time of Concentration:</b>					<b>0.787</b>
#25	3	5. Nearly bare and untilled, and alluvial valley fans	3.23	30.00	929.00	1.790	0.144
		8. Large gullies, diversions, and low flowing streams	2.45	154.00	6,297.00	4.690	0.372
#25	3	<b>Time of Concentration:</b>					<b>0.516</b>
#26	1	5. Nearly bare and untilled, and alluvial valley fans	1.20	103.00	8,602.00	1.090	2.192
#26	1	<b>Time of Concentration:</b>					<b>2.192</b>
#26	2	5. Nearly bare and untilled, and alluvial valley fans	1.23	120.00	9,780.00	1.100	2.469
		8. Large gullies, diversions, and low flowing streams	2.18	184.00	8,454.00	4.420	0.531
#26	2	<b>Time of Concentration:</b>					<b>3.000</b>

# SEDCAD 4 for Windows

Copyright 1998 Pamela J. Schwab  
Civil Software Design

Stru #	SWS #	Land Flow Condition	Slope (%)	Vert. Dist. (ft)	Horiz. Dist. (ft)	Velocity (fps)	Time (hrs)
#27	1	5. Nearly bare and untilled, and alluvial valley fans	4.32	50.00	1,158.02	2.070	0.155
		8. Large gullies, diversions, and low flowing streams	2.53	198.00	7,838.16	4.760	0.457
<b>#27</b>	<b>1</b>	<b>Time of Concentration:</b>					<b>0.612</b>
#27	2	5. Nearly bare and untilled, and alluvial valley fans	5.26	30.00	570.00	2.290	0.069
		8. Large gullies, diversions, and low flowing streams	3.15	278.00	8,822.00	5.320	0.460
<b>#27</b>	<b>2</b>	<b>Time of Concentration:</b>					<b>0.529</b>
#27	3	5. Nearly bare and untilled, and alluvial valley fans	16.33	80.00	490.00	4.040	0.033
		8. Large gullies, diversions, and low flowing streams	2.15	225.00	10,443.00	4.400	0.659
<b>#27</b>	<b>3</b>	<b>Time of Concentration:</b>					<b>0.692</b>
#27	4	5. Nearly bare and untilled, and alluvial valley fans	12.43	65.00	523.00	3.520	0.041
		8. Large gullies, diversions, and low flowing streams	3.49	225.00	6,454.00	5.600	0.320
<b>#27</b>	<b>4</b>	<b>Time of Concentration:</b>					<b>0.361</b>
#27	5	5. Nearly bare and untilled, and alluvial valley fans	9.40	25.00	266.00	3.060	0.024
		8. Large gullies, diversions, and low flowing streams	2.32	364.00	15,700.00	4.560	0.956
<b>#27</b>	<b>5</b>	<b>Time of Concentration:</b>					<b>0.980</b>
#28	1	5. Nearly bare and untilled, and alluvial valley fans	5.25	40.00	762.00	2.290	0.092
		8. Large gullies, diversions, and low flowing streams	2.96	310.00	10,479.34	5.150	0.565
<b>#28</b>	<b>1</b>	<b>Time of Concentration:</b>					<b>0.657</b>
#28	2	5. Nearly bare and untilled, and alluvial valley fans	25.86	105.00	406.00	5.080	0.022
		8. Large gullies, diversions, and low flowing streams	2.96	310.00	10,479.34	5.150	0.565
<b>#28</b>	<b>2</b>	<b>Time of Concentration:</b>					<b>0.587</b>
#29	1	5. Nearly bare and untilled, and alluvial valley fans	11.58	30.00	259.00	3.400	0.021
		8. Large gullies, diversions, and low flowing streams	3.61	288.00	7,976.00	5.700	0.388
<b>#29</b>	<b>1</b>	<b>Time of Concentration:</b>					<b>0.409</b>
#29	2	5. Nearly bare and untilled, and alluvial valley fans	8.06	40.00	496.00	2.830	0.048
		8. Large gullies, diversions, and low flowing streams	2.90	252.00	8,693.55	5.100	0.473
<b>#29</b>	<b>2</b>	<b>Time of Concentration:</b>					<b>0.521</b>
#29	3	5. Nearly bare and untilled, and alluvial valley fans	7.25	25.00	345.00	2.690	0.035

# SEDCAD 4 for Windows

Copyright 1998 Pamela J. Schwab  
Civil Software Design

Stru #	SWS #	Land Flow Condition	Slope (%)	Vert. Dist. (ft)	Horiz. Dist. (ft)	Velocity (fps)	Time (hrs)
		8. Large gullies, diversions, and low flowing streams	2.26	158.00	7,001.00	4.500	0.432
<b>#29</b>	<b>3</b>	<b>Time of Concentration:</b>					<b>0.467</b>
#30	1	5. Nearly bare and untilled, and alluvial valley fans	4.93	35.00	710.00	2.220	0.088
		8. Large gullies, diversions, and low flowing streams	1.67	243.00	14,540.00	3.870	1.043
<b>#30</b>	<b>1</b>	<b>Time of Concentration:</b>					<b>1.131</b>
#31	1	5. Nearly bare and untilled, and alluvial valley fans	2.91	15.00	515.00	1.700	0.084
		8. Large gullies, diversions, and low flowing streams	2.74	247.00	9,006.00	4.960	0.504
<b>#31</b>	<b>1</b>	<b>Time of Concentration:</b>					<b>0.588</b>
#31	2	5. Nearly bare and untilled, and alluvial valley fans	7.46	25.00	335.00	2.730	0.034
		8. Large gullies, diversions, and low flowing streams	2.18	138.00	6,335.00	4.420	0.398
<b>#31</b>	<b>2</b>	<b>Time of Concentration:</b>					<b>0.432</b>
#31	3	5. Nearly bare and untilled, and alluvial valley fans	3.84	20.00	521.00	1.950	0.074
		8. Large gullies, diversions, and low flowing streams	2.24	108.00	4,826.00	4.480	0.299
<b>#31</b>	<b>3</b>	<b>Time of Concentration:</b>					<b>0.373</b>
#32	1	5. Nearly bare and untilled, and alluvial valley fans	3.48	22.00	632.00	1.860	0.094
		8. Large gullies, diversions, and low flowing streams	1.56	101.00	6,494.00	3.740	0.482
<b>#32</b>	<b>1</b>	<b>Time of Concentration:</b>					<b>0.576</b>

## *Subwatershed Muskingum Routing Details:*

Stru #	SWS #	Land Flow Condition	Slope (%)	Vert. Dist. (ft)	Horiz. Dist. (ft)	Velocity (fps)	Time (hrs)
#24	1	8. Large gullies, diversions, and low flowing streams	0.79	180.00	22,769.00	2.660	2.377
<b>#24</b>	<b>1</b>	<b>Muskingum K:</b>					<b>2.377</b>
#24	2	8. Large gullies, diversions, and low flowing streams	0.78	180.00	23,111.00	2.640	2.431
<b>#24</b>	<b>2</b>	<b>Muskingum K:</b>					<b>2.431</b>
#24	4	8. Large gullies, diversions, and low flowing streams	0.00	0.00	0.00	0.000	0.000
<b>#24</b>	<b>4</b>	<b>Muskingum K:</b>					<b>0.000</b>
#25	1	8. Large gullies, diversions, and low flowing streams	1.99	104.00	5,220.00	4.230	0.342
<b>#25</b>	<b>1</b>	<b>Muskingum K:</b>					<b>0.342</b>
#25	2	8. Large gullies, diversions, and low flowing streams	1.99	104.00	5,220.00	4.230	0.342

# SEDCAD 4 for Windows

Copyright 1998 Pamela J. Schwab  
Civil Software Design

Stru #	SWS #	Land Flow Condition	Slope (%)	Vert. Dist. (ft)	Horiz. Dist. (ft)	Velocity (fps)	Time (hrs)
<b>#25</b>	<b>2</b>	<b>Muskingum K:</b>					<b>0.342</b>
#25	3	8. Large gullies, diversions, and low flowing streams	0.00	0.00	0.00	0.000	0.000
<b>#25</b>	<b>3</b>	<b>Muskingum K:</b>					<b>0.000</b>
#27	1	8. Large gullies, diversions, and low flowing streams	1.38	216.00	15,629.00	3.520	1.233
<b>#27</b>	<b>1</b>	<b>Muskingum K:</b>					<b>1.233</b>
#27	2	8. Large gullies, diversions, and low flowing streams	1.17	144.00	12,301.00	3.240	1.054
<b>#27</b>	<b>2</b>	<b>Muskingum K:</b>					<b>1.054</b>
#27	3	8. Large gullies, diversions, and low flowing streams	1.18	76.00	6,454.00	3.250	0.551
<b>#27</b>	<b>3</b>	<b>Muskingum K:</b>					<b>0.551</b>
#27	4	8. Large gullies, diversions, and low flowing streams	1.18	76.00	6,454.00	3.250	0.551
<b>#27</b>	<b>4</b>	<b>Muskingum K:</b>					<b>0.551</b>
#28	1	8. Large gullies, diversions, and low flowing streams	1.30	84.00	6,445.17	3.420	0.523
<b>#28</b>	<b>1</b>	<b>Muskingum K:</b>					<b>0.523</b>
#29	1	8. Large gullies, diversions, and low flowing streams	0.88	37.00	4,210.00	2.810	0.416
<b>#29</b>	<b>1</b>	<b>Muskingum K:</b>					<b>0.416</b>
#29	2	8. Large gullies, diversions, and low flowing streams	0.88	26.00	2,949.00	2.810	0.291
<b>#29</b>	<b>2</b>	<b>Muskingum K:</b>					<b>0.291</b>
#31	1	8. Large gullies, diversions, and low flowing streams	1.35	76.00	5,639.00	3.480	0.450
<b>#31</b>	<b>1</b>	<b>Muskingum K:</b>					<b>0.450</b>
#31	2	8. Large gullies, diversions, and low flowing streams	1.15	20.00	1,734.00	3.220	0.149
<b>#31</b>	<b>2</b>	<b>Muskingum K:</b>					<b>0.149</b>

***General Information***

***Storm Information:***

Storm Type:	NRCS Type II-60
Design Storm:	5 yr - 6 hr
Rainfall Depth:	1.100 inches

# SEDCAD 4 for Windows

Copyright 1998 Pamela J. Schwab  
Civil Software Design

## ***Structure Summary:***

	Immediate Contributing Area (ac)	Total Contributing Area (ac)	Peak Discharge (cfs)	Total Runoff Volume (ac-ft)
#30	476.400	476.400	5.05	1.30
#28	1,217.900	1,217.900	253.26	41.01
#26	2,486.400	2,486.400	33.98	13.87
#24	8,061.800	8,061.800	48.15	37.81
#25	1,015.700	9,077.500	67.51	49.99
#27	1,783.700	13,347.600	149.85	85.35
#29	966.000	15,531.500	373.04	158.08
#32	293.700	16,301.600	385.04	172.34
#31	957.100	957.100	249.28	39.41
#33	0.000	17,258.700	471.63	211.76

***General Information***

***Storm Information:***

Storm Type:	NRCS Type II-60
Design Storm:	10 yr - 6 hr
Rainfall Depth:	1.300 inches

# SEDCAD 4 for Windows

Copyright 1998 Pamela J. Schwab  
Civil Software Design

## *Structure Summary:*

	Immediate Contributing Area (ac)	Total Contributing Area (ac)	Peak Discharge (cfs)	Total Runoff Volume (ac-ft)
#30	476.400	476.400	12.85	2.98
#28	1,217.900	1,217.900	348.89	55.85
#26	2,486.400	2,486.400	65.87	26.07
#24	8,061.800	8,061.800	94.58	74.22
#25	1,015.700	9,077.500	103.41	93.53
#27	1,783.700	13,347.600	236.67	153.83
#29	966.000	15,531.500	535.73	253.00
#32	293.700	16,301.600	553.89	272.97
#31	957.100	957.100	333.75	52.17
#33	0.000	17,258.700	646.50	325.15

**NORTH FORK DIVERSION CHANNEL  
CHANNEL DESIGN**

**FEBRUARY 2001**

**North Fork Diversion Channel, Sta. 0+00 to 26+37 and  
 Sta. 31+50 to 39+80, 2yr-6hr Storm Event**

Material: Shale and clays

*Trapezoidal Channel*

Bottom Width (ft)	Left Sideslope Ratio	Right Sideslope Ratio	Slope (%)	Manning's n	Freeboard Depth (ft)	Freeboard % of Depth	Freeboard Mult. x (VxD)	Limiting Velocity (fps)
25.00	3.0:1	3.0:1	0.3	0.0310	1.00			5.0

	w/o Freeboard	w/ Freeboard
Design Discharge:	244.00 cfs	
Depth:	2.17 ft	3.17 ft
Top Width:	38.00 ft	44.00 ft
Velocity:	3.58 fps	
X-Section Area:	68.22 sq ft	
Hydraulic Radius:	1.763	
Froude Number:	0.47	

**North Fork Diversion Channel, Sta. 26+57 to 26+88,**  
**2yr-6hr Storm Event**

Material: Shale and clays

*Trapezoidal Channel*

Bottom Width (ft)	Left Sideslope Ratio	Right Sideslope Ratio	Slope (%)	Manning's n	Freeboard Depth (ft)	Freeboard % of Depth	Freeboard Mult. x (VxD)	Limiting Velocity (fps)
25.00	1.5:1	3.0:1	0.3	0.0310	1.00			5.0

	w/o Freeboard	w/ Freeboard
Design Discharge:	244.00 cfs	
Depth:	2.21 ft	3.21 ft
Top Width:	34.94 ft	39.44 ft
Velocity:	3.69 fps	
X-Section Area:	66.19 sq ft	
Hydraulic Radius:	1.845	
Froude Number:	0.47	

## North Fork Diversion Channel, Sta. 27+08 to 27+85, 2yr-6hr Storm Event

Material: Shale and clays

*Trapezoidal Channel*

Bottom Width (ft)	Left Sideslope Ratio	Right Sideslope Ratio	Slope (%)	Manning's n	Freeboard Depth (ft)	Freeboard % of Depth	Freeboard Mult. x (VxD)	Limiting Velocity (fps)
25.00	1.5:1	2.0:1	0.3	0.0310	1.00			5.0

	w/o Freeboard	w/ Freeboard
Design Discharge:	244.00 cfs	
Depth:	2.24 ft	3.24 ft
Top Width:	32.84 ft	36.34 ft
Velocity:	3.77 fps	
X-Section Area:	64.80 sq ft	
Hydraulic Radius:	1.904	
Froude Number:	0.47	

## North Fork Diversion Channel, Sta. 28+05 to 29+30, 2yr-6hr Storm Event

Material: Shale and clays

*Trapezoidal Channel*

Bottom Width (ft)	Left Sideslope Ratio	Right Sideslope Ratio	Slope (%)	Manning's n	Freeboard Depth (ft)	Freeboard % of Depth	Freeboard Mult. x (VxD)	Limiting Velocity (fps)
25.00	1.5:1	1.5:1	0.3	0.0310	1.00			5.0

	w/o Freeboard	w/ Freeboard
Design Discharge:	244.00 cfs	
Depth:	2.26 ft	3.26 ft
Top Width:	31.78 ft	34.78 ft
Velocity:	3.81 fps	
X-Section Area:	64.12 sq ft	
Hydraulic Radius:	1.935	
Froude Number:	0.47	

## North Fork Diversion Channel, Sta. 29+50 to 31+30, 2yr-6hr Storm Event

Material: Shale and clays

*Trapezoidal Channel*

Bottom Width (ft)	Left Sideslope Ratio	Right Sideslope Ratio	Slope (%)	Manning's n	Freeboard Depth (ft)	Freeboard % of Depth	Freeboard Mult. x (VxD)	Limiting Velocity (fps)
25.00	3.0:1	2.0:1	0.3	0.0310	1.00			5.0

	w/o Freeboard	w/ Freeboard
Design Discharge:	244.00 cfs	
Depth:	2.19 ft	3.19 ft
Top Width:	35.97 ft	40.97 ft
Velocity:	3.65 fps	
X-Section Area:	66.87 sq ft	
Hydraulic Radius:	1.817	
Froude Number:	0.47	

**North Fork Diversion Channel, Sta. 0+00 to 26+37 and  
 Sta. 31+50 to 39+80, 5yr-6hr Storm Event**

Material: Shale and clays

*Trapezoidal Channel*

Bottom Width (ft)	Left Sideslope Ratio	Right Sideslope Ratio	Slope (%)	Manning's n	Freeboard Depth (ft)	Freeboard % of Depth	Freeboard Mult. x (VxD)	Limiting Velocity (fps)
25.00	3.0:1	3.0:1	0.3	0.0310	1.00			5.0

	w/o Freeboard	w/ Freeboard
Design Discharge:	472.00 cfs	
Depth:	3.13 ft	4.13 ft
Top Width:	43.75 ft	49.75 ft
Velocity:	4.39 fps	
X-Section Area:	107.44 sq ft	
Hydraulic Radius:	2.400	
Froude Number:	0.49	

# North Fork Diversion Channel, Sta. 26+57 to 26+88, 5yr-6hr Storm Event

Material: Shale and clays

*Trapezoidal Channel*

Bottom Width (ft)	Left Sideslope Ratio	Right Sideslope Ratio	Slope (%)	Manning's n	Freeboard Depth (ft)	Freeboard % of Depth	Freeboard Mult. x (VxD)	Limiting Velocity (fps)
25.00	1.5:1	3.0:1	0.3	0.0310	1.00			5.0

	w/o Freeboard	w/ Freeboard
Design Discharge:	472.00 cfs	
Depth:	3.21 ft	4.21 ft
Top Width:	39.46 ft	43.96 ft
Velocity:	4.56 fps	
X-Section Area:	103.55 sq ft	
Hydraulic Radius:	2.537	
Froude Number:	0.50	

**North Fork Diversion Channel, Sta. 27+08 to 27+85,**  
**5yr-6hr Storm Event**

Material: Shale and clays

*Trapezoidal Channel*

Bottom Width (ft)	Left Sideslope Ratio	Right Sideslope Ratio	Slope (%)	Manning's n	Freeboard Depth (ft)	Freeboard % of Depth	Freeboard Mult. x (VxD)	Limiting Velocity (fps)
25.00	1.5:1	2.0:1	0.3	0.0310	1.00			5.0

	w/o Freeboard	w/ Freeboard
Design Discharge:	472.00 cfs	
Depth:	3.28 ft	4.28 ft
Top Width:	36.48 ft	39.98 ft
Velocity:	4.68 fps	
X-Section Area:	100.86 sq ft	
Hydraulic Radius:	2.639	
Froude Number:	0.50	

## North Fork Diversion Channel, Sta. 28+05 to 29+30, 5yr-6hr Storm Event

Material: Shale and clays

*Trapezoidal Channel*

Bottom Width (ft)	Left Sideslope Ratio	Right Sideslope Ratio	Slope (%)	Manning's n	Freeboard Depth (ft)	Freeboard % of Depth	Freeboard Mult. x (VxD)	Limiting Velocity (fps)
25.00	1.5:1	1.5:1	0.3	0.0310	1.00			5.0

	w/o Freeboard	w/ Freeboard
Design Discharge:	472.00 cfs	
Depth:	3.32 ft	4.32 ft
Top Width:	34.96 ft	37.96 ft
Velocity:	4.74 fps	
X-Section Area:	99.52 sq ft	
Hydraulic Radius:	2.692	
Froude Number:	0.50	

# North Fork Diversion Channel, Sta. 29+50 to 31+30, 5yr-6hr Storm Event

Material: Shale and clays

*Trapezoidal Channel*

Bottom Width (ft)	Left Sideslope Ratio	Right Sideslope Ratio	Slope (%)	Manning's n	Freeboard Depth (ft)	Freeboard % of Depth	Freeboard Mult. x (VxD)	Limiting Velocity (fps)
25.00	3.0:1	2.0:1	0.3	0.0310	1.00			5.0

	w/o Freeboard	w/ Freeboard
Design Discharge:	472.00 cfs	
Depth:	3.18 ft	4.18 ft
Top Width:	40.91 ft	45.91 ft
Velocity:	4.50 fps	
X-Section Area:	104.87 sq ft	
Hydraulic Radius:	2.489	
Froude Number:	0.50	

**North Fork Diversion Channel, Sta. 0+00 to 26+37 and  
Sta. 31+50 to 39+80, 10yr-6hr Storm Event**

Material: Shale and clays

*Trapezoidal Channel*

Bottom Width (ft)	Left Sideslope Ratio	Right Sideslope Ratio	Slope (%)	Manning's n	Freeboard Depth (ft)	Freeboard % of Depth	Freeboard Mult. x (VxD)	Limiting Velocity (fps)
25.00	3.0:1	3.0:1	0.3	0.0310	1.00			5.0

	w/o Freeboard	w/ Freeboard
Design Discharge:	647.00 cfs	
Depth:	3.71 ft	4.71 ft
Top Width:	47.25 ft	53.25 ft
Velocity:	4.83 fps	
X-Section Area:	134.00 sq ft	
Hydraulic Radius:	2.765	
Froude Number:	0.51	

**North Fork Diversion Channel, Sta. 26+57 to 26+88,**  
**10yr-6hr Storm Event**

Material: Shale and clays

*Trapezoidal Channel*

Bottom Width (ft)	Left Sideslope Ratio	Right Sideslope Ratio	Slope (%)	Manning's n	Freeboard Depth (ft)	Freeboard % of Depth	Freeboard Mult. x (VxD)	Limiting Velocity (fps)
25.00	1.5:1	3.0:1	0.3	0.0310	1.00			5.0

	w/o Freeboard	w/ Freeboard
Design Discharge:	647.00 cfs	
Depth:	3.83 ft	4.83 ft
Top Width:	42.24 ft	46.74 ft
Velocity:	5.02 fps	
X-Section Area:	128.76 sq ft	
Hydraulic Radius:	2.936	
Froude Number:	0.51	

## North Fork Diversion Channel, Sta. 27+08 to 27+85, 10yr-6hr Storm Event

Material: Shale and clays

*Trapezoidal Channel*

Bottom Width (ft)	Left Sideslope Ratio	Right Sideslope Ratio	Slope (%)	Manning's n	Freeboard Depth (ft)	Freeboard % of Depth	Freeboard Mult. x (VxD)	Limiting Velocity (fps)
25.00	1.5:1	2.0:1	0.3	0.0310	1.00			5.0

	w/o Freeboard	w/ Freeboard
Design Discharge:	647.00 cfs	
Depth:	3.93 ft	4.93 ft
Top Width:	38.74 ft	42.24 ft
Velocity:	5.17 fps	
X-Section Area:	125.12 sq ft	
Hydraulic Radius:	3.065	
Froude Number:	0.51	

## North Fork Diversion Channel, Sta. 28+05 to 29+30, 10yr-6hr Storm Event

Material: Shale and clays

*Trapezoidal Channel*

Bottom Width (ft)	Left Sideslope Ratio	Right Sideslope Ratio	Slope (%)	Manning's n	Freeboard Depth (ft)	Freeboard % of Depth	Freeboard Mult. x (VxD)	Limiting Velocity (fps)
25.00	1.5:1	1.5:1	0.3	0.0310	1.00			5.0

	w/o Freeboard	w/ Freeboard
Design Discharge:	647.00 cfs	
Depth:	3.98 ft	4.98 ft
Top Width:	36.94 ft	39.94 ft
Velocity:	5.25 fps	
X-Section Area:	123.30 sq ft	
Hydraulic Radius:	3.133	
Froude Number:	0.51	

**North Fork Diversion Channel, Sta. 29+50 to 31+30,**  
**10yr-6hr Storm Event**

Material: Shale and clays

*Trapezoidal Channel*

Bottom Width (ft)	Left Sideslope Ratio	Right Sideslope Ratio	Slope (%)	Manning's n	Freeboard Depth (ft)	Freeboard % of Depth	Freeboard Mult. x (VxD)	Limiting Velocity (fps)
25.00	3.0:1	2.0:1	0.3	0.0310	1.00			5.0

	w/o Freeboard	w/ Freeboard
Design Discharge:	647.00 cfs	
Depth:	3.79 ft	4.79 ft
Top Width:	43.94 ft	48.94 ft
Velocity:	4.96 fps	
X-Section Area:	130.55 sq ft	
Hydraulic Radius:	2.876	
Froude Number:	0.51	

# **NORTH FORK DIVERSION CHANNEL**

## **RIPRAPPED DOWNDRAIN DESIGNS FOR SIDE DRAINAGES**

**FEBRUARY 2001**

# **NORTH FORK DIVERSION CHANNEL**

***Hydrology model and designs for rip-rapped downdrains.  
Refer to attached 8 1/2 X 11 sheet for watershed  
subdivisions. The location of the downdrains are shown on  
Exhibit 11-142B & 11-142C.***

LR

BHP Navajo Coal Company  
Navajo Mine  
PO Box 1717  
Fruitland, NM 87415

Phone: 505-598-5861

***General Information***

***Storm Information:***


Storm Type:	NRCS Type II-60
Design Storm:	10 yr - 6 hr
Rainfall Depth:	1.300 inches

# SEDCAD 4 for Windows

Copyright 1988 Pamela J. Schwab  
Civil Software Design

## Structure Networking:

Type	Stru #	(flows into)	Stru #	Musk. K (hrs)	Musk. X	Description
Channel	#1	==>	#4	0.041	0.236	Downdrain @ Sta. 1+55
Channel	#2	==>	#4	0.000	0.000	Downdrain @ Sta. 3+50
Channel	#3	==>	#4	0.000	0.000	Downdrain @ Sta. 3+80
Null	#4	==>	#6	0.063	0.237	
Channel	#5	==>	#6	0.000	0.000	Downdrain @ Sta. 7+30
Null	#6	==>	#8	0.045	0.237	
Channel	#7	==>	#8	0.000	0.000	Downdrain @ Sta. 9+82
Null	#8	==>	#10	0.199	0.237	
Channel	#9	==>	#10	0.000	0.000	Downdrain @ Sta. 20+80
Null	#10	==>	#12	0.093	0.237	
Channel	#11	==>	#12	0.000	0.000	Downdrain @ Sta. 25+95
Null	#12	==>	#14	0.070	0.238	
Channel	#13	==>	#14	0.000	0.000	Downdrain @ Sta. 29+85
Null	#14	==>	End	0.000	0.000	

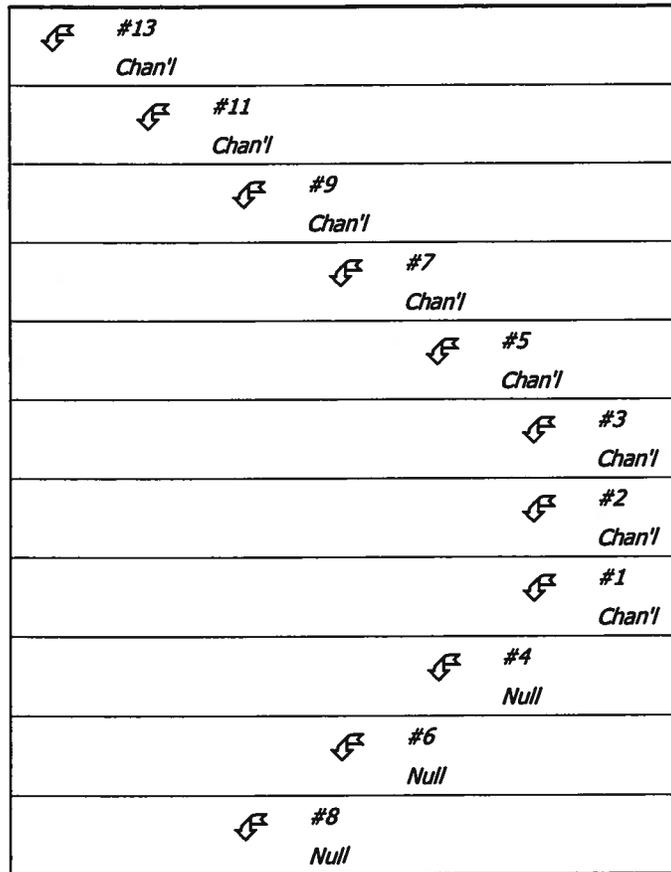

# SEDCAD 4 for Windows

Copyright 1988 Pamela J. Schwab  
Civil Software Design

#10 Null
#12 Null
#14 Null

## *Structure Routing Details:*

Stru #	Land Flow Condition	Slope (%)	Vert. Dist. (ft)	Horiz. Dist. (ft)	Velocity (fps)	Time (hrs)
#1	8. Large gullies, diversions, and low flowing streams	0.26	0.58	225.00	1.52	0.041
<b>#1</b>	<b>Muskingum K:</b>					<b>0.041</b>
#2	8. Large gullies, diversions, and low flowing streams	0.00	0.00	0.00	0.00	0.000
<b>#2</b>	<b>Muskingum K:</b>					<b>0.000</b>
#4	8. Large gullies, diversions, and low flowing streams	0.26	0.92	350.07	1.53	0.063
<b>#4</b>	<b>Muskingum K:</b>					<b>0.063</b>
#6	8. Large gullies, diversions, and low flowing streams	0.26	0.66	252.00	1.53	0.045
<b>#6</b>	<b>Muskingum K:</b>					<b>0.045</b>
#8	8. Large gullies, diversions, and low flowing streams	0.26	2.89	1,098.00	1.53	0.199
<b>#8</b>	<b>Muskingum K:</b>					<b>0.199</b>
#10	8. Large gullies, diversions, and low flowing streams	0.26	1.35	515.00	1.53	0.093
<b>#10</b>	<b>Muskingum K:</b>					<b>0.093</b>
#12	8. Large gullies, diversions, and low flowing streams	0.26	1.03	390.00	1.54	0.070
<b>#12</b>	<b>Muskingum K:</b>					<b>0.070</b>

# SEDCAD 4 for Windows

Copyright 1998 Pamela J. Schwab  
Civil Software Design

## *Structure Summary:*

	Immediate Contributing Area (ac)	Total Contributing Area (ac)	Peak Discharge (cfs)	Total Runoff Volume (ac-ft)
#13	8.020	8.020	10.45	0.46
#11	1.620	1.620	2.11	0.09
#9	6.850	6.850	8.93	0.40
#7	2.190	2.190	2.85	0.13
#5	5.780	5.780	7.53	0.33
#3	2.250	2.250	2.93	0.13
#2	37.760	37.760	29.33	2.19
#1	4.920	4.920	6.41	0.28
#4	0.000	44.930	34.27	2.60
#6	0.000	50.710	37.13	2.94
#8	0.000	52.900	39.99	3.06
#10	0.000	59.750	35.60	3.46
#12	0.000	61.370	34.94	3.55
#14	0.000	69.390	36.39	4.02

***Structure Detail:***

***Structure #13 (Riprap Channel)***

*Downdrain @ Sta. 29+85*

Trapezoidal Riprap Channel Inputs:

**Material: Riprap**

Bottom Width (ft)}	Left Sideslope Ratio	Right Sideslope Ratio	Slope (%)	Freeboard Depth (ft)	Freeboard % of Depth	Freeboard Mult. x (VxD)
5.00	3.0:1	3.0:1	15.0	1.00		

Riprap Channel Results:

**Simons/OSM Method - Steep Slope Design**

	w/o Freeboard	w/ Freeboard
Design Discharge:	10.45 cfs	
Depth:	0.16 ft	1.16 ft
Top Width:	5.98 ft	11.98 ft
Velocity*:		
X-Section Area:	0.90 sq ft	
Hydraulic Radius:	0.149	
Froude Number*:		
Manning's n*:		
Dmin:	3.00 in	
D50:	9.00 in	
Dmax:	11.25 in	

Velocity and Manning's n calculations may not apply for this method.

***Structure #11 (Riprap Channel)***

*Downdrain @ Sta. 25+95*

Trapezoidal Riprap Channel Inputs:

**Material: Riprap**

Bottom Width (ft)}	Left Sideslope Ratio	Right Sideslope Ratio	Slope (%)	Freeboard Depth (ft)	Freeboard % of Depth	Freeboard Mult. x (VxD)
2.00	3.0:1	3.0:1	15.0	1.00		

# SEDCAD 4 for Windows

Copyright 1998 Pamela J. Schwab  
Civil Software Design

## Riprap Channel Results:

### Simons/OSM Method - Steep Slope Design

	w/o Freeboard	w/ Freeboard
Design Discharge:	2.11 cfs	
Depth:	0.12 ft	1.12 ft
Top Width:	2.70 ft	8.70 ft
Velocity*:		
X-Section Area:	0.28 sq ft	
Hydraulic Radius:	0.101	
Froude Number*:		
Manning's n*:		
Dmin:	3.00 in	
D50:	9.00 in	
Dmax:	11.25 in	

Velocity and Manning's n calculations may not apply for this method.

## Structure #9 (Riprap Channel)

### *Downdrain @ Sta. 20+80*

## Trapezoidal Riprap Channel Inputs:

### Material: Riprap

Bottom Width (ft)}	Left Sideslope Ratio	Right Sideslope Ratio	Slope (%)	Freeboard Depth (ft)	Freeboard % of Depth	Freeboard Mult. x (VxD)
5.00	3.0:1	3.0:1	15.0	1.00		

## Riprap Channel Results:

### Simons/OSM Method - Steep Slope Design

	w/o Freeboard	w/ Freeboard
Design Discharge:	8.93 cfs	
Depth:	0.15 ft	1.15 ft
Top Width:	5.88 ft	11.88 ft
Velocity*:		
X-Section Area:	0.80 sq ft	
Hydraulic Radius:	0.135	
Froude Number*:		
Manning's n*:		
Dmin:	3.00 in	
D50:	9.00 in	
Dmax:	11.25 in	

# SEDCAD 4 for Windows

Copyright 1998 Pamela J. Schwab  
Civil Software Design

Velocity and Manning's n calculations may not apply for this method.

## Structure #7 (Riprap Channel)

*Downdrain @ Sta. 9+82*

Trapezoidal Riprap Channel Inputs:

### Material: Riprap

Bottom Width (ft)}	Left Sideslope Ratio	Right Sideslope Ratio	Slope (%)	Freeboard Depth (ft)	Freeboard % of Depth	Freeboard Mult. x (VxD)
4.00	3.0:1	3.0:1	20.0	1.00		

Riprap Channel Results:

### Simons/OSM Method - Steep Slope Design

	w/o Freeboard	w/ Freeboard
Design Discharge:	2.85 cfs	
Depth:	0.07 ft	1.07 ft
Top Width:	4.41 ft	10.41 ft
Velocity*:		
X-Section Area:	0.29 sq ft	
Hydraulic Radius:	0.064	
Froude Number*:		
Manning's n*:		
Dmin:	3.00 in	
D50:	9.00 in	
Dmax:	11.25 in	

Velocity and Manning's n calculations may not apply for this method.

## Structure #5 (Riprap Channel)

*Downdrain @ Sta. 7+30*

Trapezoidal Riprap Channel Inputs:

### Material: Riprap

Bottom Width (ft)}	Left Sideslope Ratio	Right Sideslope Ratio	Slope (%)	Freeboard Depth (ft)	Freeboard % of Depth	Freeboard Mult. x (VxD)
5.00	3.0:1	3.0:1	15.0	1.00		

Riprap Channel Results:

# SEDCAD 4 for Windows

Copyright 1998 Pamela J. Schwab  
Civil Software Design

## Simons/OSM Method - Steep Slope Design

	w/o Freeboard	w/ Freeboard
Design Discharge:	7.53 cfs	
Depth:	0.13 ft	1.13 ft
Top Width:	5.79 ft	11.79 ft
Velocity*:		
X-Section Area:	0.71 sq ft	
Hydraulic Radius:	0.121	
Froude Number*:		
Manning's n*:		
Dmin:	3.00 in	
D50:	9.00 in	
Dmax:	11.25 in	

Velocity and Manning's n calculations may not apply for this method.

### Structure #3 (Riprap Channel)

*Downdrain @ Sta. 3+80*

Trapezoidal Riprap Channel Inputs:

#### Material: Riprap

Bottom Width (ft)}	Left Sideslope Ratio	Right Sideslope Ratio	Slope (%)	Freeboard Depth (ft)	Freeboard % of Depth	Freeboard Mult. x (VxD)
4.00	3.0:1	3.0:1	20.0	1.00		

Riprap Channel Results:

## Simons/OSM Method - Steep Slope Design

	w/o Freeboard	w/ Freeboard
Design Discharge:	2.93 cfs	
Depth:	0.07 ft	1.07 ft
Top Width:	4.41 ft	10.41 ft
Velocity*:		
X-Section Area:	0.29 sq ft	
Hydraulic Radius:	0.065	
Froude Number*:		
Manning's n*:		
Dmin:	3.00 in	
D50:	9.00 in	
Dmax:	11.25 in	

Velocity and Manning's n calculations may not apply for this method.

# SEDCAD 4 for Windows

Copyright 1998 Pamela J. Schwab  
Civil Software Design

## Structure #2 (Riprap Channel)

*Downdrain @ Sta. 3+50*

Trapezoidal Riprap Channel Inputs:

### Material: Riprap

Bottom Width (ft)}	Left Sideslope Ratio	Right Sideslope Ratio	Slope (%)	Freeboard Depth (ft)	Freeboard % of Depth	Freeboard Mult. x (VxD)
6.00	3.0:1	3.0:1	15.0	1.00		

Riprap Channel Results:

### Simons/OSM Method - Steep Slope Design

	w/o Freeboard	w/ Freeboard
Design Discharge:	29.33 cfs	
Depth:	0.33 ft	1.33 ft
Top Width:	7.98 ft	13.98 ft
Velocity*:		
X-Section Area:	2.30 sq ft	
Hydraulic Radius:	0.285	
Froude Number*:		
Manning's n*:		
Dmin:	3.00 in	
D50:	9.00 in	
Dmax:	11.25 in	

Velocity and Manning's n calculations may not apply for this method.

## Structure #1 (Riprap Channel)

*Downdrain @ Sta. 1+55*

Trapezoidal Riprap Channel Inputs:

### Material: Riprap

Bottom Width (ft)}	Left Sideslope Ratio	Right Sideslope Ratio	Slope (%)	Freeboard Depth (ft)	Freeboard % of Depth	Freeboard Mult. x (VxD)
4.00	3.0:1	3.0:1	15.0	1.00		

Riprap Channel Results:

### Simons/OSM Method - Steep Slope Design

# SEDCAD 4 for Windows

Copyright 1998 Pamela J. Schwab  
Civil Software Design

	w/o Freeboard	w/ Freeboard
Design Discharge:	6.41 cfs	
Depth:	0.14 ft	1.14 ft
Top Width:	4.81 ft	10.81 ft
Velocity*:		
X-Section Area:	0.60 sq ft	
Hydraulic Radius:	0.123	
Froude Number*:		
Manning's n*:		
Dmin:	3.00 in	
D50:	9.00 in	
Dmax:	11.25 in	

Velocity and Manning's n calculations may not apply for this method.

Structure #4 (Null)

Structure #6 (Null)

Structure #8 (Null)

Structure #10 (Null)

Structure #12 (Null)

Structure #14 (Null)

# SEDCAD 4 for Windows

Copyright 1998 Pamela J. Schwab  
Civil Software Design

## *Subwatershed Hydrology Detail:*

Stru #	SWS #	SWS Area (ac)	Time of Conc (hrs)	Musk K (hrs)	Musk X	Curve Number	UHS	Peak Discharge (cfs)	Runoff Volume (ac-ft)
#13	1	8.020	0.110	0.000	0.000	93.000	M	10.45	0.464
	$\Sigma$	<b>8.020</b>						<b>10.45</b>	<b>0.464</b>
#11	1	1.620	0.029	0.000	0.000	93.000	M	2.11	0.094
	$\Sigma$	<b>1.620</b>						<b>2.11</b>	<b>0.094</b>
#9	1	6.850	0.049	0.000	0.000	93.000	M	8.93	0.397
	$\Sigma$	<b>6.850</b>						<b>8.93</b>	<b>0.397</b>
#7	1	2.190	0.048	0.000	0.000	93.000	M	2.85	0.127
	$\Sigma$	<b>2.190</b>						<b>2.85</b>	<b>0.127</b>
#5	1	5.780	0.079	0.000	0.000	93.000	M	7.53	0.335
	$\Sigma$	<b>5.780</b>						<b>7.53</b>	<b>0.335</b>
#3	1	2.250	0.035	0.000	0.000	93.000	M	2.93	0.130
	$\Sigma$	<b>2.250</b>						<b>2.93</b>	<b>0.130</b>
#2	1	37.760	0.235	0.000	0.000	93.000	M	29.33	2.186
	$\Sigma$	<b>37.760</b>						<b>29.33</b>	<b>2.186</b>
#1	1	4.920	0.104	0.000	0.000	93.000	M	6.41	0.285
	$\Sigma$	<b>4.920</b>						<b>6.41</b>	<b>0.285</b>
#4	$\Sigma$	<b>44.930</b>						<b>34.27</b>	<b>2.601</b>
#6	$\Sigma$	<b>50.710</b>						<b>37.13</b>	<b>2.935</b>
#8	$\Sigma$	<b>52.900</b>						<b>39.99</b>	<b>3.062</b>
#10	$\Sigma$	<b>59.750</b>						<b>35.60</b>	<b>3.459</b>
#12	$\Sigma$	<b>61.370</b>						<b>34.94</b>	<b>3.552</b>
#14	$\Sigma$	<b>69.390</b>						<b>36.39</b>	<b>4.017</b>

## *Subwatershed Time of Concentration Details:*

Stru #	SWS #	Land Flow Condition	Slope (%)	Vert. Dist. (ft)	Horiz. Dist. (ft)	Velocity (fps)	Time (hrs)
#1	1	5. Nearly bare and untilled, and alluvial valley fans	4.35	20.00	460.00	2.080	0.061
		8. Large gullies, diversions, and low flowing streams	1.98	13.00	658.00	4.210	0.043

# SEDCAD 4 for Windows


Copyright 1998 Pamela J. Schwab  
Civil Software Design

Stru #	SWS #	Land Flow Condition	Slope (%)	Vert. Dist. (ft)	Horiz. Dist. (ft)	Velocity (fps)	Time (hrs)
<b>#1</b>	<b>1</b>	<b>Time of Concentration:</b>					<b>0.104</b>
#2	1	5. Nearly bare and untilled, and alluvial valley fans	3.56	32.00	900.00	1.880	0.132
		8. Large gullies, diversions, and low flowing streams	2.06	33.00	1,601.00	4.300	0.103
<b>#2</b>	<b>1</b>	<b>Time of Concentration:</b>					<b>0.235</b>
#3	1	5. Nearly bare and untilled, and alluvial valley fans	23.00	23.00	100.00	4.790	0.005
		8. Large gullies, diversions, and low flowing streams	2.37	12.00	506.00	4.610	0.030
<b>#3</b>	<b>1</b>	<b>Time of Concentration:</b>					<b>0.035</b>
#5	1	5. Nearly bare and untilled, and alluvial valley fans	6.18	21.00	340.00	2.480	0.038
		8. Large gullies, diversions, and low flowing streams	1.91	12.00	627.00	4.150	0.041
<b>#5</b>	<b>1</b>	<b>Time of Concentration:</b>					<b>0.079</b>
#7	1	5. Nearly bare and untilled, and alluvial valley fans	6.67	20.00	300.00	2.580	0.032
		8. Large gullies, diversions, and low flowing streams	2.46	7.00	284.00	4.700	0.016
<b>#7</b>	<b>1</b>	<b>Time of Concentration:</b>					<b>0.048</b>
#9	1	5. Nearly bare and untilled, and alluvial valley fans	10.33	31.00	300.00	3.210	0.025
		8. Large gullies, diversions, and low flowing streams	2.44	10.00	409.00	4.690	0.024
<b>#9</b>	<b>1</b>	<b>Time of Concentration:</b>					<b>0.049</b>
#11	1	5. Nearly bare and untilled, and alluvial valley fans	7.00	14.00	200.00	2.640	0.021
		8. Large gullies, diversions, and low flowing streams	3.37	6.00	178.00	5.500	0.008
<b>#11</b>	<b>1</b>	<b>Time of Concentration:</b>					<b>0.029</b>
#13	1	5. Nearly bare and untilled, and alluvial valley fans	3.67	11.00	300.00	1.910	0.043
		8. Large gullies, diversions, and low flowing streams	2.38	27.00	1,133.00	4.630	0.067
<b>#13</b>	<b>1</b>	<b>Time of Concentration:</b>					<b>0.110</b>

**NORTH FORK DIVERSION CHANNEL**

**HYDRAULIC EVALUATION OF THE REACH  
IN THE NATURAL DRAINAGE**

**FEBRUARY 2001**

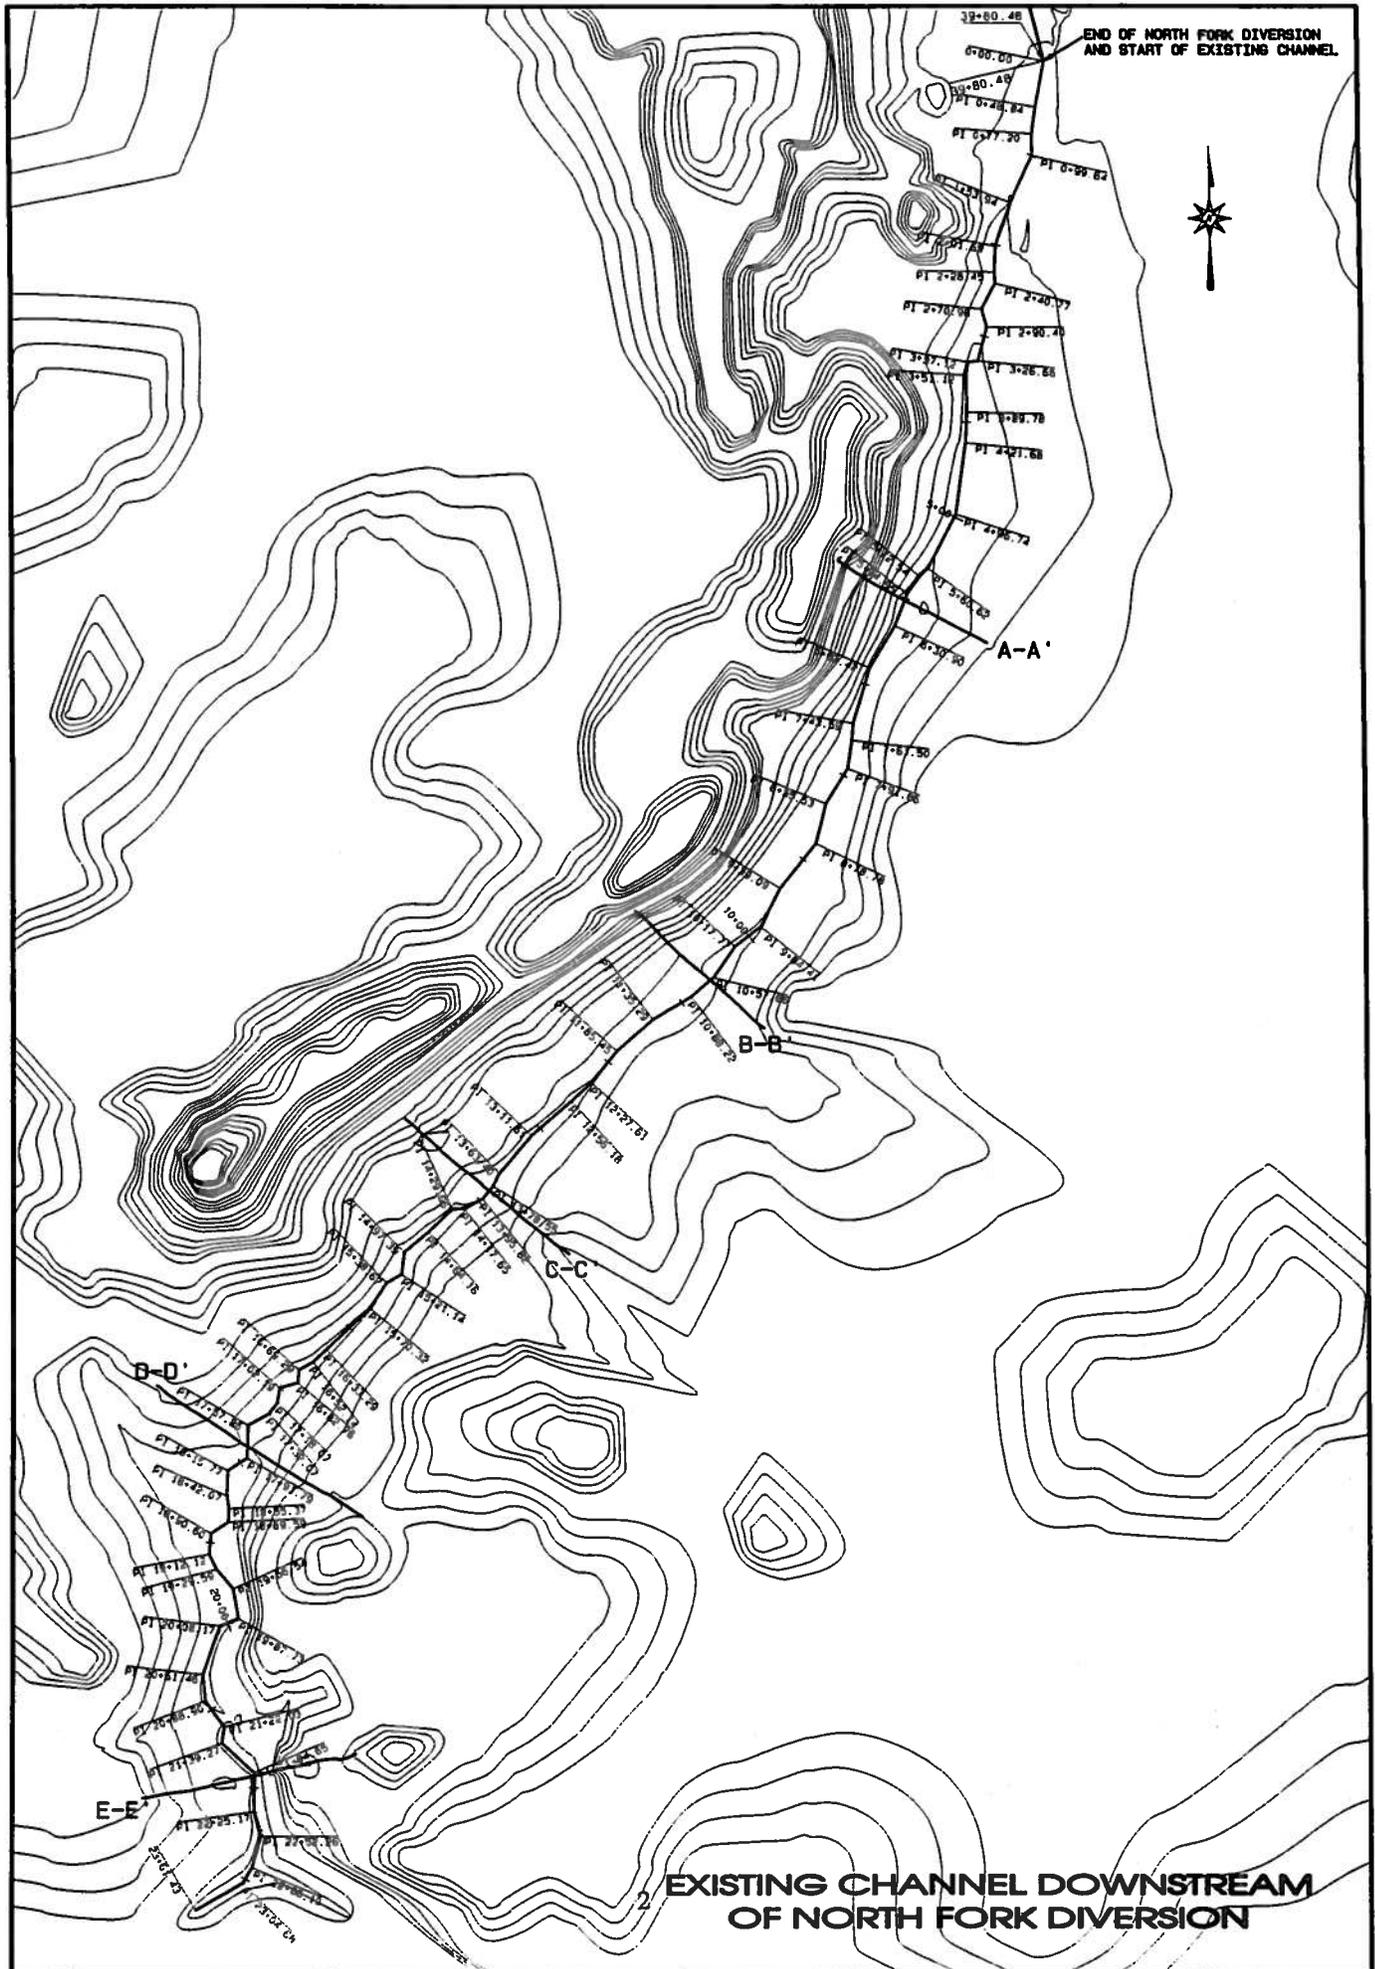

END OF NORTH FORK DIVERSION  
AND START OF EXISTING CHANNEL



A-A'




B-B'

C-C'



D-D'

E-E'

EXISTING CHANNEL DOWNSTREAM  
OF NORTH FORK DIVERSION

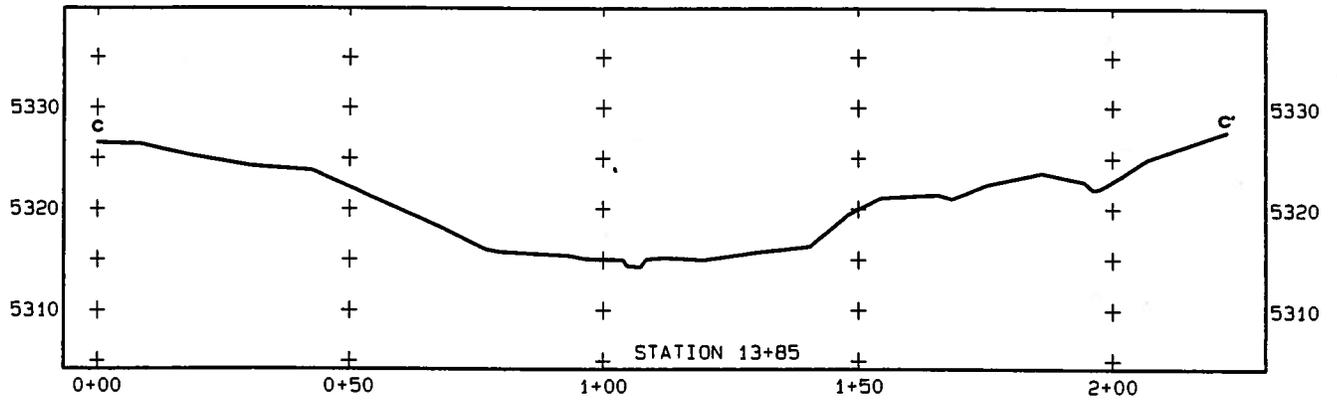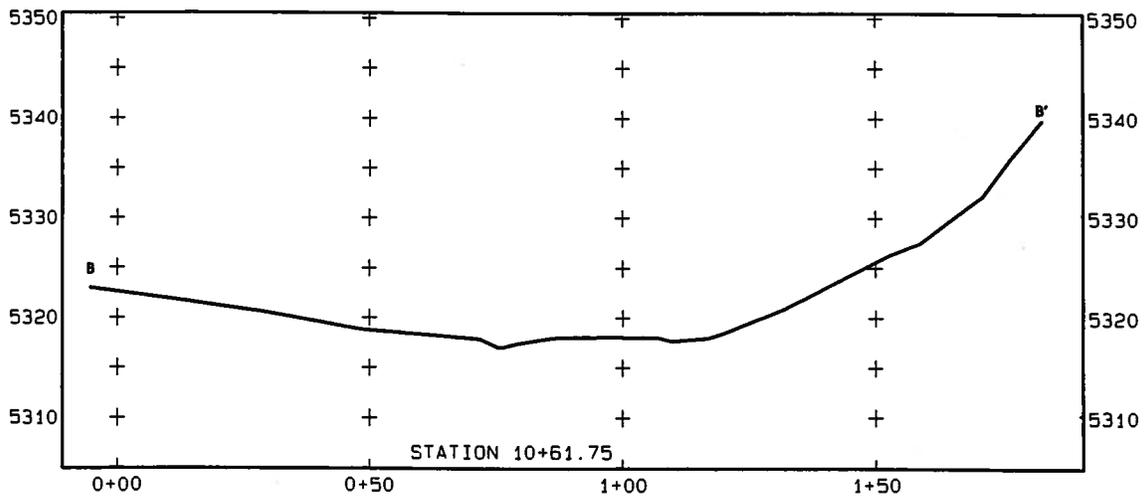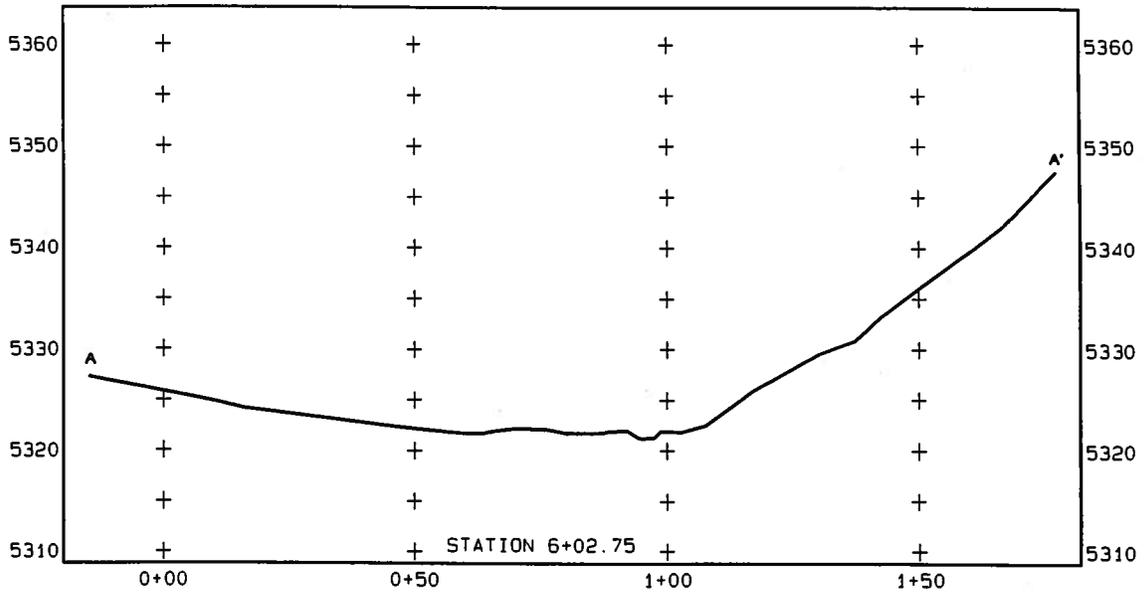

SCALE: H - 1"=40'  
V - 1"=20'

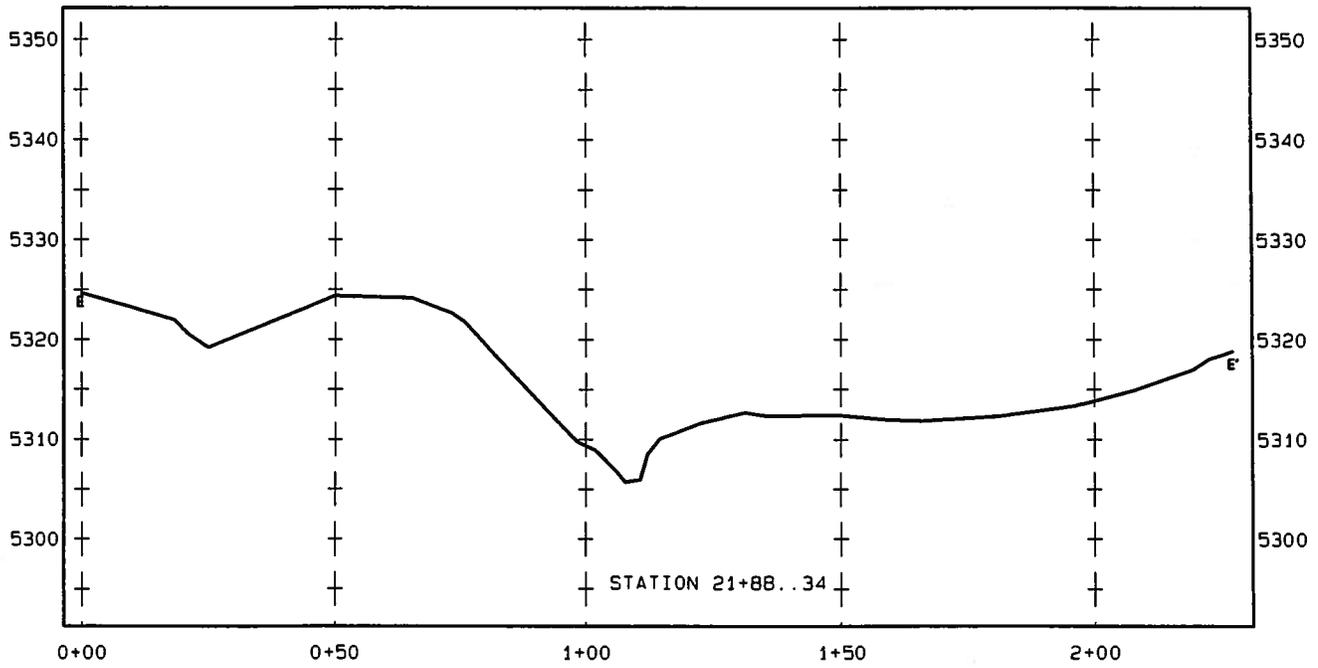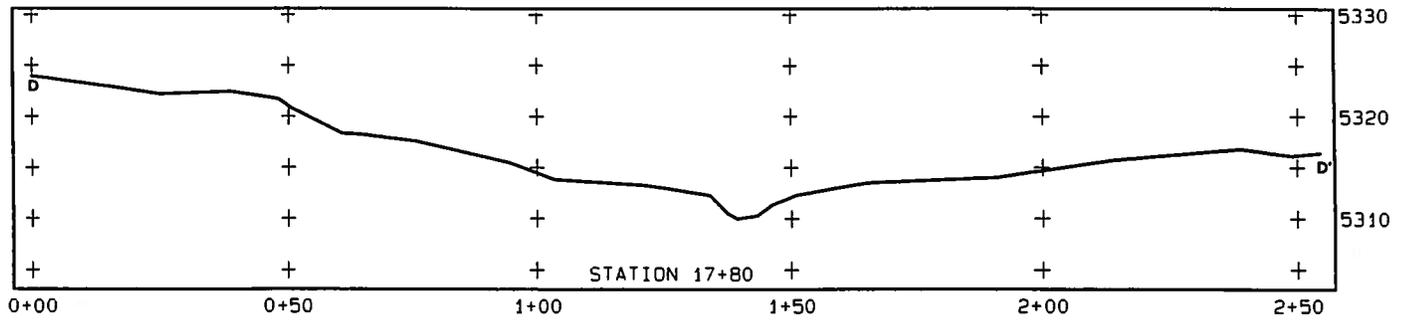

SCALE: H - 1"=40'  
 V - 1"=20'

**NORTH FORK DIVERSION CHANNEL  
X-SECTION DATA FOR EXISTING DRAINAGE**

PERIMETER (ft)														
CHANNEL DEPTH (ft)	INCREMENTAL AREA (sq ft)	ACCUMULATIVE AREA (sq ft)	WETTED	TOTAL	⊙ H2O SURFACE	LT OVERBANK FLOW, n=0.042	LT BANK, n=0.035	BOTTOM, n=0.030	RT BANK, n=0.035	RT OVERBANK FLOW, n=0.042	COMPOSITE VALUE	CENTERLINE STA. / EL.	UPSTREAM STA. / EL.	DOWN STREAM STA. / EL.
<b>X-SECTION A-A' @ Sta. 6+02.75</b>														
0.00	0.00	0.00	0.00	0.00	0.00							6+02.75	5+02.75	7+02.75
0.50	2.10	2.10	5.80	11.30	5.50	1.87	2.69	2.69	1.11	6.91	0.033	5321.23	5322.35	5320.36
1.00	18.50	20.60	57.10	113.90	56.80	21.92	2.50	2.69	1.55	6.91	0.040		1.12	-0.87
1.50	30.70	51.30	88.40	136.30	67.90	51.84	2.50	2.69	1.55	9.51	0.041			
2.00	36.50	87.80	78.30	156.10	77.80	60.29	2.50	2.69	1.55	11.00	0.041			
2.50	40.10	127.90	78.80	175.50	96.70	68.78	2.50	2.69	1.55	12.50	0.041			
3.00	47.10	175.00	106.70	194.10	87.40	76.41	2.50	2.69	1.55	14.00	0.041			
3.50	49.10	224.10	103.20	205.60	102.40	80.74	2.50	2.69	1.55	15.48	0.041			
4.00	53.00	277.10	109.80	218.60	108.80	85.77	2.50	2.69	1.55	16.98	0.041			
4.50	56.80	333.70	116.40	231.70	115.30	91.15	2.50	2.69	1.55	18.47	0.041			
5.00	59.10	392.80	124.90	245.30	120.40	95.05	2.50	2.69	1.55	20.19	0.041			
<b>X-SECTION B-B' @ Sta. 10+61.75</b>														
0.00	0.00	0.00	0.00	0.00	0.00							10+61.75	9+61.75	11+61.75
0.50	2.00	2.00	7.40	14.80	7.40	2.01	0.89	0.89	4.71	33.31	0.034	5316.83	5317.97	5316.3
1.00	7.90	9.90	29.20	57.90	28.70	3.02	3.64	0.89	11.01	33.31	0.036		1.14	-0.53
1.50	27.20	37.10	64.50	128.70	64.20	15.58	3.64	0.89	11.01	35.79	0.040			
2.00	35.80	72.90	76.90	153.50	76.60	25.53	3.64	0.89	11.01	38.27	0.041			
2.50	40.20	113.10	84.80	169.30	84.50	31.00	3.64	0.89	11.01	40.90	0.041			
3.00	44.00	157.10	92.80	185.10	92.30	36.52	3.64	0.89	11.01	43.24	0.041			
3.50	48.00	205.10	100.60	200.70	100.10	41.80	3.64	0.89	11.01	45.50	0.041			
4.00	51.40	256.50	109.90	219.30	109.40	48.91	3.64	0.89	11.01	47.58	0.041			
4.50	59.30	315.80	119.10	237.60	118.50	56.02	3.64	0.89	11.01	49.57	0.041			
5.00	60.70	378.50	128.20	255.70	127.50	63.12	3.64	0.89	11.01	51.57	0.041			
5.50	65.70	442.20	137.40	273.90	136.50	70.23	3.64	0.89	11.01					
<b>X-SECTION C-C' @ Sta. 13+85</b>														
0.00	0.00	0.00	0.00	0.00	0.00							13+85.00	12+85	14+85
0.50	1.50	1.50	4.20	8.10	3.90	0.60	2.68	2.68	0.94	15.88	0.032	5314.14	5315.08	5312.8
1.00	7.00	8.50	30.20	59.90	29.70	9.47	0.92	2.68	1.42	22.96	0.040		0.95	-1.34
1.50	20.00	28.50	52.70	104.90	52.20	24.71	0.92	2.68	1.42	31.98	0.041			
2.00	29.90	58.40	65.20	129.90	64.70	28.26	0.92	2.68	1.42	33.24	0.041			
2.50	31.80	90.20	68.60	136.50	67.90	30.35	0.92	2.68	1.42	34.53	0.041			
3.00	36.10	126.30	72.00	143.10	71.10	32.44	0.92	2.68	1.42	35.82	0.041			
3.50	35.50	161.80	75.40	149.70	74.30	34.53	0.92	2.68	1.42	37.11	0.041			
4.00	38.20	200.00	78.70	156.30	77.60	36.64	0.92	2.68	1.42	38.40	0.041			
4.50	40.50	240.50	82.40	163.50	81.10	39.01	0.92	2.68	1.42	39.69	0.041			
5.00	41.00	281.50	86.10	170.70	84.60	41.37	0.92	2.68	1.42		0.041			

n-values:  
 Left overbank flow 0.042  
 Left bank 0.035  
 Bottom 0.03  
 Right bank 0.035  
 Right overbank flow 0.042

**NORTH FORK DIVERSION CHANNEL  
X-SECTION DATA FOR EXISTING DRAINAGE**

CHANNEL DEPTH (ft)	INCREMENTAL AREA (sq ft)	ACCUMULATIVE AREA (sq ft)	WETTED	TOTAL	PERIMETER (ft)							COMPOSITE n VALUE	CENTERLINE STA. / EL.	UPSTREAM STA. / EL.	DOWN STREAM STA. / EL.
					@ H2O SURFACE	LT OVERBANK FLOW, n=0.042	LT BANK, n=0.035	BOTTOM, n=0.030	RT BANK, n=0.035	RT OVERBANK FLOW, n=0.042					
<b>X-SECTION-D-D' @ Sta. 17+80</b>															
0.00	0.00	0.00	0.00	0.00									17+80.00	16+80	18+80
0.50	2.00	2.00	6.50	12.90	6.40		1.92	3.97	0.63			0.032	5309.99	5310.88	5309
1.00	3.70	5.70	9.00	17.70	8.70		2.98	3.97	2.06			0.033	0.89		-0.99
1.50	5.00	10.70	11.80	23.10	11.30		4.06	3.97	3.78			0.033			S= 0.94%
2.00	6.50	17.20	15.50	30.30	14.80		5.14	3.97	6.37			0.034			
2.50	8.50	25.70	22.40	44.00	21.60	2.36	5.84	3.97	7.99	2.27		0.036			
3.00	14.00	39.70	35.60	69.80	34.20	8.96	5.84	3.97	7.99	8.28		0.038			
3.50	19.80	59.60	50.80	100.70	49.90	19.11	5.84	3.97	7.99	13.88		0.039			
4.00	36.20	95.80	90.40	176.60	86.20	31.37	5.84	3.97	7.99	37.99		0.040			
4.50	46.10	141.90	98.30	195.70	97.40	34.15	5.84	3.97	7.99	46.40		0.041			
5.00	51.00	192.90	107.80	214.50	106.70	36.95	5.84	3.97	7.99	53.02		0.041			
5.50	55.30	248.20	122.60	233.20	110.60	39.80	5.84	3.97	7.99	59.63		0.041			
<b>X-SECTION-E-E' @ Sta. 21+88.34</b>															
0.00	0.00	0.00	0.00	0.00	0.00								21+88.34	20+88.34	22+88.34
0.50	1.34	1.34	4.20	8.10	3.90		0.96	2.93	0.30			0.031	5305.61	5307.06	5305.15
1.00	2.26	3.60	5.70	10.70	5.00		1.91	2.93	0.87			0.032	1.25		-0.66
1.50	2.80	6.40	7.40	13.60	6.20		2.99	2.93	1.44			0.033			
2.00	3.40	9.80	9.00	16.50	7.50		4.08	2.93	2.12			0.033			
2.50	4.00	13.80	10.70	19.40	8.70		5.16	2.93	2.59			0.034			
3.00	4.70	18.50	12.50	22.60	10.10		6.25	2.93	3.31			0.034			
3.50	5.60	24.10	15.20	27.80	12.60	1.33	6.66	2.93	4.24			0.035			
4.00	7.10	31.20	18.30	33.90	15.60	3.57	6.66	2.93	5.16			0.036			
4.50	8.30	39.50	21.00	39.00	18.00	4.66	6.66	2.93	5.73	1.02		0.036			
5.00	9.80	49.30	24.70	46.20	21.50	5.75	6.66	2.93	5.73	3.43		0.037			
5.50	11.70	61.00	28.40	53.40	25.00	6.84	6.66	2.93	5.73	6.19		0.038			
6.00	13.30	74.30	32.30	61.20	28.90	7.92	6.66	2.93	5.73	9.12		0.038			
6.50	15.10	89.40	36.60	72.50	33.90	9.01	6.66	2.93	5.73	13.18		0.039			
7.00	45.10	134.50	98.80	194.60	94.80	10.10	6.66	2.93	5.73	73.24		0.041			
7.50	49.90	184.40	107.20	210.40	103.20	11.19	6.66	2.93	5.73	80.67		0.041			

n-values:  
 Left overbank flow 0.042  
 Left bank 0.035  
 Bottom 0.03  
 Right bank 0.035  
 Right overbank flow 0.042



**NORTH FORK DIVERSION CHANNEL  
STAGE FLOW DATA FOR EXISTING DRAINAGE**

Channel Bed Slope

S =

0.84 %

**STAGE FLOW @ 10+61.75 (Sta. Section B-B' existing channel)**

Flow Depth (Ft)	Area (Sq Ft)	Wetted Perimeter (Ft)	Hydraulic Radius	Composite n-value	Peak Flow (CFS)	Average Velocity (FPS)	Froude number
0.00	0.00	0.00	0.00		0.00	0.00	
0.50	2.00	7.40	0.27	0.034	3.30	1.65	0.41
1.00	9.90	29.20	0.34	0.036	18.19	1.84	0.32
1.50	37.10	64.50	0.58	0.040	86.66	2.34	0.34
2.00	72.90	76.90	0.95	0.041	236.36	3.24	0.40
2.50	113.10	84.80	1.33	0.041	459.42	4.06	0.45
3.00	157.10	92.80	1.69	0.041	746.61	4.75	0.48
3.50	205.10	100.60	2.04	0.041	1,101.64	5.37	0.51
4.00	256.50	109.90	2.33	0.041	1,504.95	5.87	0.52
4.50	315.80	119.10	2.65	0.041	2,014.47	6.38	0.53
5.00	376.50	128.20	2.94	0.041	2,567.80	6.82	0.54
5.50	442.20	137.40	3.22	0.041	3,202.25	7.24	0.54

**FLOW DEPTH AND AVERAGE VELOCITY AT PEAK FLOWS**

Storm Event	Peak Flow (cfs)	Flow Depth (ft)	Average Velocity (fps)	Froude number
2 year - 6 hour	244.00	2.02	3.27	0.41
5 year - 6 hour	472.00	2.52	4.09	0.45
10 year - 6 hour	647.00	2.83	4.51	0.47

**NORTH FORK DIVERSION CHANNEL  
STAGE FLOW DATA FOR EXISTING DRAINAGE**

Channel Bed Slope

S =

1.14 %

**STAGE FLOW @ Sta. 13+85 (Section C-C' existing channel)**

Flow Depth (Ft)	Area (Sq Ft)	Wetted Perimeter (Ft)	Hydraulic Radius	Composite n-value	Peak Flow (CFS)	Average Velocity (FPS)	Froude number
0.00	0.00	0.00	0.00		0.00	0.00	
0.50	1.50	4.20	0.36	0.032	3.77	2.51	0.63
1.00	8.50	30.20	0.28	0.040	14.34	1.69	0.30
1.50	28.50	52.70	0.54	0.041	73.29	2.57	0.37
2.00	58.40	65.20	0.90	0.041	209.74	3.59	0.45
2.50	90.20	68.60	1.31	0.041	418.62	4.64	0.52
3.00	126.30	72.00	1.75	0.041	710.49	5.63	0.57
3.50	161.80	75.40	2.15	0.041	1,041.08	6.43	0.61
4.00	200.00	78.70	2.54	0.041	1,440.36	7.20	0.63
4.50	240.50	82.40	2.92	0.041	1,899.22	7.90	0.66
5.00	281.50	86.10	3.27	0.041	2,397.26	8.52	0.67

**FLOW DEPTH AND AVERAGE VELOCITY AT PEAK FLOWS**

Storm Event	Peak Flow (cfs)	Flow Depth (ft)	Average Velocity (fps)	Froude number
2 year - 6 hour	244.00	2.08	3.76	0.46
5 year - 6 hour	472.00	2.59	4.82	0.53
10 year - 6 hour	647.00	2.89	5.41	0.56



**NORTH FORK DIVERSION CHANNEL  
STAGE FLOW DATA FOR EXISTING DRAINAGE**

Channel Bed Slope

S =

0.96 %


**STAGE FLOW @ Sta. 21+88 (Section E-E' existing channel)**

Flow Depth (Ft)	Area (Sq Ft)	Wetted Perimeter (Ft)	Hydraulic Radius	Composite n-value	Peak Flow (CFS)	Average Velocity (FPS)	Froude number
0.00	0.00	0.00	0.00		0.00	0.00	
0.50	1.34	4.20	0.32	0.031	2.88	2.15	0.54
1.00	3.60	5.70	0.63	0.032	11.88	3.30	0.58
1.50	6.40	7.40	0.86	0.033	25.62	4.00	0.58
2.00	9.80	9.00	1.09	0.033	45.26	4.62	0.58
2.50	13.80	10.70	1.29	0.034	70.90	5.14	0.57
3.00	18.50	12.50	1.48	0.034	103.63	5.60	0.57
3.50	24.10	15.20	1.59	0.035	137.90	5.72	0.54
4.00	31.20	18.30	1.70	0.036	182.46	5.85	0.52
4.50	39.50	21.00	1.88	0.036	242.34	6.14	0.51
5.00	49.30	24.70	2.00	0.037	307.60	6.24	0.49
5.50	61.00	28.40	2.15	0.038	392.61	6.44	0.48
6.00	74.30	32.30	2.30	0.038	493.77	6.65	0.48
6.50	89.40	38.60	2.32	0.039	588.98	6.59	0.46
7.00	134.50	99.80	1.35	0.041	586.88	4.36	0.29
7.50	184.40	107.20	1.72	0.041	945.34	5.13	0.33

**FLOW DEPTH AND AVERAGE VELOCITY AT PEAK FLOWS**

Storm Event	Peak Flow (cfs)	Flow Depth (ft)	Average Velocity (fps)	Froude number
2 year - 6 hour	244.00	4.51	6.14	0.51
5 year - 6 hour	472.00	5.89	6.60	0.48
10 year - 6 hour	647.00	7.08	4.49	0.30

# NORTH FORK DIVERSION - EXISTING CHANNEL FLOW RATING CURVES

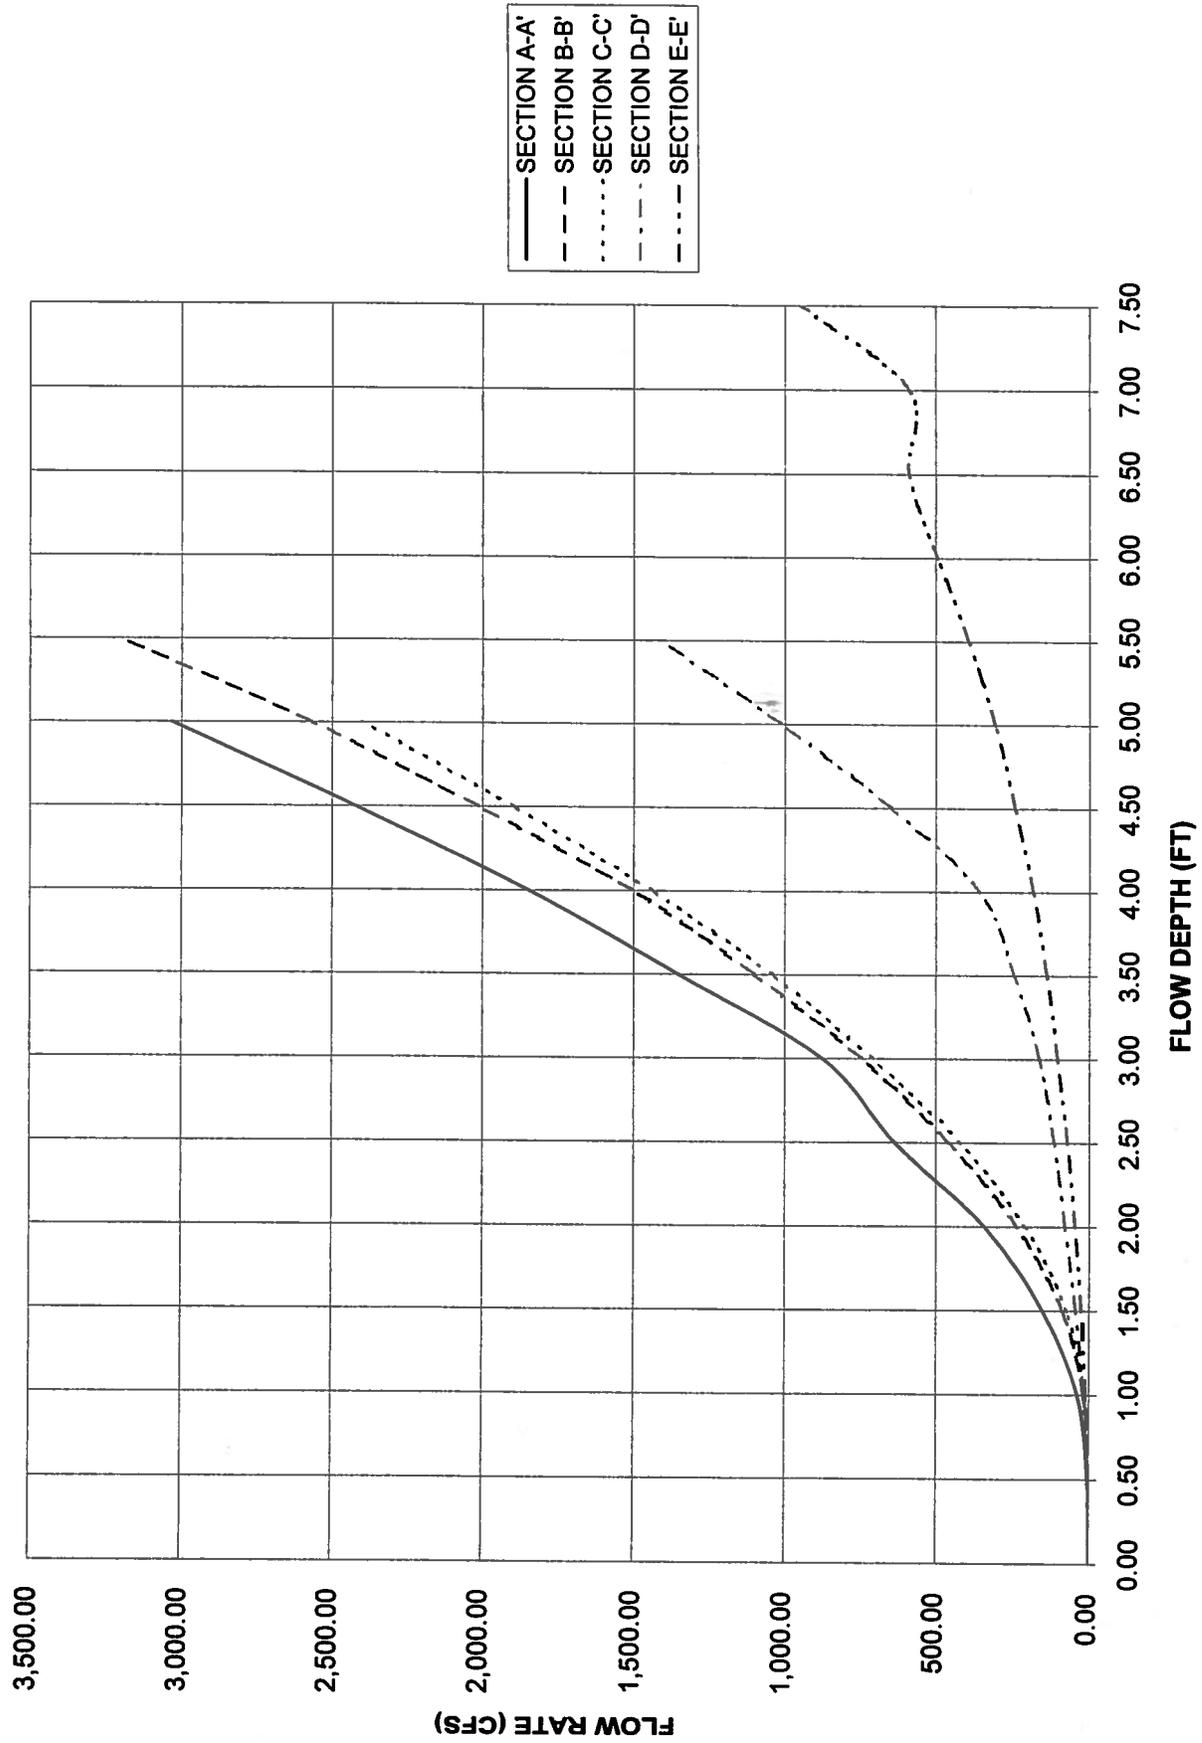

**NORTH FORK DIVERSION CHANNEL  
AS-BUILT**

**CHANNEL DESIGN**

**JULY 2002**

## NORTH FORK DIVERSION CHANNEL - AS-BUILT

### FLOW DEPTHS AND VELOCITIES AT PEAK FLOWS

Channel Reach (% grade)	Channel Material	2 year-6 hour		5 year-6 hour		10 year-6 hour	
		Flow Depth (ft)	Velocity (fps)	Flow Depth (ft)	Velocity (fps)	Flow Depth (ft)	Velocity (fps)
Sta. 3+00 to 5+00, 10+00 to 18+00 & 28+00 to 36+00 @ max. grade, (0.852%)	Sandstone	1.74	5.52	2.49	6.76	2.95	7.42
Sta. 0+00 to 3+00, 5+00 to 10+00, 18+00 to 28+00 & 36+00 to 39+70 @ max. grade, (0.321%)	Shale	2.22	4.05	3.22	4.99	3.83	5.49
Sta. 2+49 Min. Channel Depth (0.227%)	Shale/Clay	2.52	3.36	3.50	4.03	4.08	4.39

The flow velocities in the reaches in sandstone material at maximum grade (0.852%) exceeds 5 fps, these reaches are in competent sandstone formation capable of withstanding flow velocities up to 15 fps. In the reaches that are in shale material at maximum grade (0.321%) the velocities for the 2 and 5 year peak flows are less than 5 fps. The limiting flow velocity or erosive velocity for shale is 5 fps. Some erosion can be expected to occur during the 10 year 6 hour storm event when the flow velocity exceeds 5 fps.

The minimum channel embankment height is approximately 8.5 feet at Station 2+49. The maximum flow depth during the peak flow from the 10 year-6 hour storm event is 4.1 feet. Thus, the channel is capable of safely passing the peak flow from the 10 year-6 hour storm event with a freeboard of 4.4 feet.

**NORTH FORK DIVERSION CHANNEL - AS-BUILT**  
**CHANNEL BED MATERIAL**

CHANNEL REACH	CHANNEL BED MATERIAL	MAXIMUM GRADE	MINIMUM GRADE
0+00 to 3+00	Shale/Clay	0.227	n/a
3+00 to 5+00	Sandstone	0.852	n/a
5+00 to 10+00	Shale	0.287	n/a
10+00 to 18+00	Sandstone	0.835	0.022
18+00 to 28+00	Shale	0.321	0.169
28+00 to 36+00	Sandstone	0.456	0.179
36+00 to 39+70	Shale	0.309	n/a

## NORTH FORK DIVERSION CHANNEL - AS-BUILT

### CHANNEL DATA (STA 3+78)

Bottom Channel Width (ft)	W =	19.50
Side Slopes (Z1:1)	Z1 =	3.70
(Z2:1)	Z2 =	3.10
Manning's Roughness Coefficient	n =	0.031
Channel Bed Slope (%)	S =	0.852 (max.)
D50 Riprap Size (ft)	D50 =	n/a

### STAGE FLOW AND VELOCITIES @ MAX. GRADE IN SANDSTONE CUT

Flow Depth (Ft)	Area (Sq Ft)	Wetted Perimeter (Ft)	Hydraulic Radius	Discharge Rate (CFS)	Velocity (FPS)
0.00	0.00	19.50	0.00	0.00	0.00
0.25	5.09	21.27	0.24	8.66	1.70
0.50	10.60	23.05	0.46	27.95	2.64
0.75	16.54	24.82	0.67	55.90	3.38
1.00	22.90	26.59	0.86	91.92	4.01
1.25	29.69	28.36	1.05	135.80	4.57
1.50	36.90	30.14	1.22	187.50	5.08
1.75	44.54	31.91	1.40	247.06	5.55
2.00	52.60	33.68	1.56	314.59	5.98
2.25	61.09	35.45	1.72	390.23	6.39
2.50	70.00	37.23	1.88	474.13	6.77
2.75	79.34	39.00	2.03	566.47	7.14
3.00	89.10	40.77	2.19	667.44	7.49
3.25	99.29	42.54	2.33	777.22	7.83
3.50	109.90	44.32	2.48	896.03	8.15
3.75	120.94	46.09	2.62	1024.05	8.47
4.00	132.40	47.86	2.77	1161.49	8.77
4.25	144.29	49.63	2.91	1308.55	9.07

### FLOW DEPTH AND VELOCITY BY STORM EVENTS

Storm Event	Peak Flow (cfs)	Flow Depth (ft)	Flow Velocity (fps)
2 year - 6 hour	244.00	1.74	5.52
5 year - 6 hour	472.00	2.49	6.76
10 year - 6 hour	647.00	2.95	7.42

## NORTH FORK DIVERSION CHANNEL - AS-BUILT

### CHANNEL DATA (STA 26+74)

Bottom Channel Width (ft)	W =	21.80
Side Slopes (Z1:1)	Z1 =	2.00
(Z2:1)	Z2 =	2.70
Manning's Roughness Coefficient	n =	0.031
Channel Bed Slope (%)	S =	0.321 (max.)
D50 Riprap Size (ft)	D50=	N/A

### STAGE FLOW AND VELOCITIES @ MAX. GRADE IN SHALE CUT

Flow Depth (Ft)	Area (Sq Ft)	Wetted Perimeter (Ft)	Hydraulic Radius	Discharge Rate (CFS)	Velocity (FPS)
0.00	0.00	21.80	0.00	0.00	0.00
0.25	5.60	23.08	0.24	5.90	1.05
0.50	11.49	24.36	0.47	18.91	1.65
0.75	17.67	25.64	0.69	37.51	2.12
1.00	24.15	26.92	0.90	61.16	2.53
1.25	30.92	28.19	1.10	89.58	2.90
1.50	37.99	29.47	1.29	122.62	3.23
1.75	45.35	30.75	1.47	160.19	3.53
2.00	53.00	32.03	1.65	202.25	3.82
2.25	60.95	33.31	1.83	248.79	4.08
2.50	69.19	34.59	2.00	299.81	4.33
2.75	77.72	35.87	2.17	355.33	4.57
3.00	86.55	37.15	2.33	415.41	4.80
3.25	95.67	38.42	2.49	480.06	5.02
3.50	105.09	39.70	2.65	549.35	5.23
3.75	114.80	40.98	2.80	623.33	5.43
4.00	124.80	42.26	2.95	702.06	5.63
4.25	135.10	43.54	3.10	785.60	5.82
4.50	145.69	44.82	3.25	874.00	6.00

### FLOW DEPTH AND VELOCITY BY STORM EVENTS

Storm Event	Peak Flow (cfs)	Flow Depth (ft)	Flow Velocity (fps)
2 year - 6 hour	244.00	2.22	4.05
5 year - 6 hour	472.00	3.22	4.99
10 year - 6 hour	647.00	3.83	5.49

## NORTH FORK DIVERSION CHANNEL - AS-BUILT

### CHANNEL DATA (2+49)

Bottom Channel Width (ft)	W =	17.30
Side Slopes (Z1:1)	Z1 =	3.80
(Z2:1)	Z2 =	5.40
Manning's Roughness Coefficient	n =	0.031
Channel Bed Slope (%)	S =	0.227 (min.)
D50 Riprap Size (ft)	D50 =	N/A

### STAGE FLOW AND VELOCITY @ MIN. GRADE AND MIN. CHANNEL DEPTH

Flow Depth (Ft)	Area (Sq Ft)	Wetted Perimeter (Ft)	Hydraulic Radius	Discharge Rate (CFS)	Velocity (FPS)
0.00	0.00	17.30	0.00	0.00	0.00
0.25	4.61	19.66	0.23	4.00	0.87
0.50	9.80	22.01	0.45	13.05	1.33
0.75	15.56	24.37	0.64	26.39	1.70
1.00	21.90	26.72	0.82	43.89	2.00
1.25	28.81	29.08	0.99	65.58	2.28
1.50	36.30	31.43	1.15	91.55	2.52
1.75	44.36	33.79	1.31	121.92	2.75
2.00	53.00	36.14	1.47	156.86	2.96
2.25	62.21	38.50	1.62	196.50	3.16
2.50	72.00	40.85	1.76	241.03	3.35
2.75	82.36	43.21	1.91	290.59	3.53
3.00	93.30	45.56	2.05	345.36	3.70
3.25	104.81	47.92	2.19	405.50	3.87
3.50	116.90	50.27	2.33	471.18	4.03
3.75	129.56	52.63	2.46	542.57	4.19
4.00	142.80	54.98	2.60	619.83	4.34
4.25	156.61	57.34	2.73	703.12	4.49

### FLOW DEPTH AND VELOCITY BY STORM EVENTS

Storm Event	Peak Flow (cfs)	Flow Depth (ft)	Flow Velocity (fps)
2 year - 6 hour	244.00	2.52	3.36
5 year - 6 hour	472.00	3.50	4.03
10 year - 6 hour	647.00	4.08	4.39

**NORTH FORK DIVERSION CHANNEL**  
**RIP-RAPPED DOWNDRAINS**  
**AS-BUILT**

***Hydrology model and designs for rip-rapped downdrains. For the watershed subdivisions, refer to the 8 1/2 X 11 sheet in the original design submitted. The location and details of the downdrains are presented on Exhibit 11-142D & 11-142E.***

LR

BHP Navajo Coal Company  
Navajo Mine  
PO Box 1717  
Fruitland, NM 87415

Phone: 505-598-5861

***General Information***

***Storm Information:***


Storm Type:	NRCS Type II-60
Design Storm:	2 yr - 6 hr
Rainfall Depth:	0.800 inches

# SEDCAD 4 for Windows

Copyright 1998 Pamela J. Schwab  
Civil Software Design

## Structure Networking:

Type	Stru #	(flows into)	Stru #	Musk. K (hrs)	Musk. X	Description
Channel	#1	==>	#4	0.041	0.236	Downdrain @ Sta. 1+59
Channel	#2	==>	#4	0.000	0.000	Downdrain @ Sta. 3+55
Channel	#3	==>	#4	0.000	0.000	Sta. 3+80 Sandstone Downdrain
Null	#4	==>	#6	0.063	0.237	
Channel	#5	==>	#6	0.000	0.000	Downdrain @ Sta. 7+43
Null	#6	==>	#8	0.045	0.237	
Channel	#7	==>	#8	0.000	0.000	Downdrain @ Sta. 9+89
Null	#8	==>	#10	0.199	0.237	
Channel	#9	==>	#10	0.000	0.000	Downdrain @ Sta. 20+84
Null	#10	==>	#12	0.093	0.237	
Channel	#11	==>	#12	0.000	0.000	Downdrain @ Sta. 26+16
Null	#12	==>	#14	0.070	0.238	
Channel	#13	==>	#14	0.000	0.000	Downdrain @ Sta. 29+88
Null	#14	==>	End	0.000	0.000	

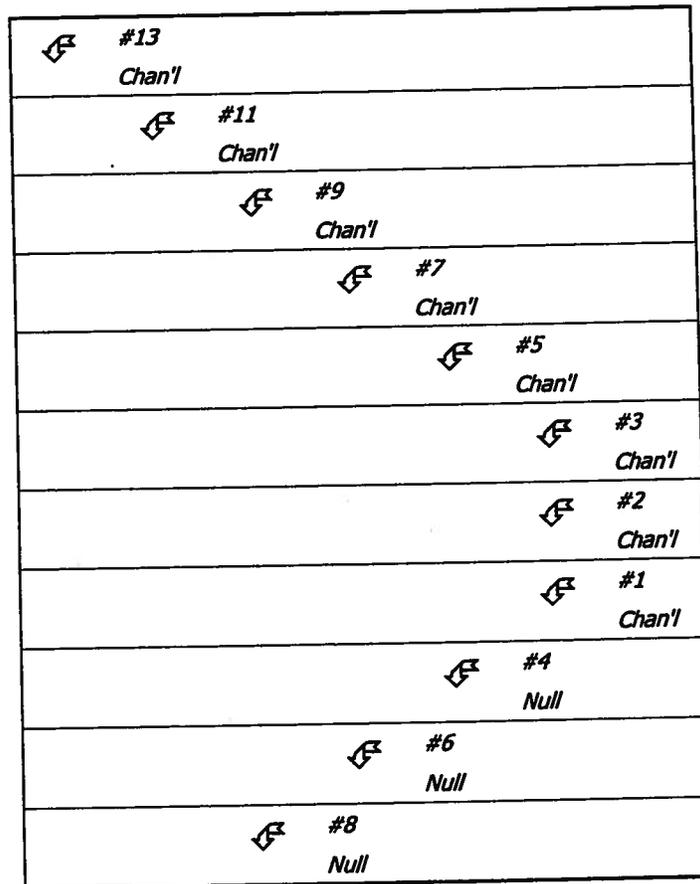

# SEDCAD 4 for Windows

Copyright 1998 Pamela J. Schwab  
Civil Software Design

↖	#10 Null
↖	#12 Null
	#14 Null

## *Structure Routing Details:*

Stru #	Land Flow Condition	Slope (%)	Vert. Dist. (ft)	Horiz. Dist. (ft)	Velocity (fps)	Time (hrs)
#1	8. Large gullies, diversions, and low flowing streams	0.26	0.58	225.00	1.52	0.041
<b>#1</b>	<b>Muskingum K:</b>					<b>0.041</b>
#2	8. Large gullies, diversions, and low flowing streams	0.00	0.00	0.00	0.00	0.000
<b>#2</b>	<b>Muskingum K:</b>					<b>0.000</b>
#4	8. Large gullies, diversions, and low flowing streams	0.26	0.92	350.07	1.53	0.063
<b>#4</b>	<b>Muskingum K:</b>					<b>0.063</b>
#6	8. Large gullies, diversions, and low flowing streams	0.26	0.66	252.00	1.53	0.045
<b>#6</b>	<b>Muskingum K:</b>					<b>0.045</b>
#8	8. Large gullies, diversions, and low flowing streams	0.26	2.89	1,098.00	1.53	0.199
<b>#8</b>	<b>Muskingum K:</b>					<b>0.199</b>
#10	8. Large gullies, diversions, and low flowing streams	0.26	1.35	515.00	1.53	0.093
<b>#10</b>	<b>Muskingum K:</b>					<b>0.093</b>
#12	8. Large gullies, diversions, and low flowing streams	0.26	1.03	390.00	1.54	0.070
<b>#12</b>	<b>Muskingum K:</b>					<b>0.070</b>

# SEDCAD 4 for Windows

Copyright 1988 Pamela J. Schwab  
Civil Software Design

## *Structure Summary:*

	Immediate Contributing Area (ac)	Total Contributing Area (ac)	Peak Discharge (cfs)	Total Runoff Volume (ac-ft)
#13	8.020	8.020	5.06	0.20
#11	1.620	1.620	1.02	0.04
#9	6.850	6.850	4.32	0.17
#7	2.190	2.190	1.38	0.05
#5	5.780	5.780	3.64	0.14
#3	2.250	2.250	1.42	0.06
#2	37.760	37.760	12.84	0.95
#1	4.920	4.920	3.10	0.12
#4	0.000	44.930	14.33	1.13
#6	0.000	50.710	15.20	1.27
#8	0.000	52.900	16.58	1.33
#10	0.000	59.750	14.78	1.50
#12	0.000	61.370	14.77	1.54
#14	0.000	69.390	15.55	1.74

***Structure Detail:***

***Structure #13 (Riprap Channel)***

*Downdrain @ Sta. 29+88*

Trapezoidal Riprap Channel Inputs:

**Material: Riprap**

Bottom Width (ft)}	Left Sideslope Ratio	Right Sideslope Ratio	Slope (%)	Freeboard Depth (ft)	Freeboard % of Depth	Freeboard Mult. x (VxD)
4.00	3.0:1	3.0:1	10.7	1.00		

Riprap Channel Results:

**Simons/OSM Method - Steep Slope Design**

	w/o Freeboard	w/ Freeboard
Design Discharge:	5.06 cfs	
Depth:	0.14 ft	1.14 ft
Top Width:	4.87 ft	10.87 ft
Velocity*:		
X-Section Area:	0.64 sq ft	
Hydraulic Radius:	0.130	
Froude Number*:		
Manning's n*:		
Dmin:	3.00 in	
D50:	9.00 in	
Dmax:	11.25 in	

Velocity and Manning's n calculations may not apply for this method.

***Structure #11 (Riprap Channel)***

*Downdrain @ Sta. 26+16*

Trapezoidal Riprap Channel Inputs:

**Material: Riprap**

Bottom Width (ft)}	Left Sideslope Ratio	Right Sideslope Ratio	Slope (%)	Freeboard Depth (ft)	Freeboard % of Depth	Freeboard Mult. x (VxD)
4.00	3.0:1	3.0:1	23.5	1.00		

# SEDCAD 4 for Windows

Copyright 1998 Pamela J. Schwab  
Civil Software Design

## Riprap Channel Results:

### Simons/OSM Method - Steep Slope Design

	w/o Freeboard	w/ Freeboard
Design Discharge:	1.02 cfs	
Depth:	0.03 ft	1.03 ft
Top Width:	4.20 ft	10.20 ft
Velocity*:		
X-Section Area:	0.14 sq ft	
Hydraulic Radius:	0.033	
Froude Number*:		
Manning's n*:		
Dmin:	3.00 in	
D50:	9.00 in	
Dmax:	11.25 in	

Velocity and Manning's n calculations may not apply for this method.

## Structure #9 (Riprap Channel)

### *Downdrain @ Sta. 20+84*

## Trapezoidal Riprap Channel Inputs:

### Material: Riprap

Bottom Width (ft)}	Left Sideslope Ratio	Right Sideslope Ratio	Slope (%)	Freeboard Depth (ft)	Freeboard % of Depth	Freeboard Mult. x (VxD)
5.00	3.0:1	3.0:1	21.5	1.00		

## Riprap Channel Results:

### Simons/OSM Method - Steep Slope Design

	w/o Freeboard	w/ Freeboard
Design Discharge:	4.32 cfs	
Depth:	0.06 ft	1.06 ft
Top Width:	5.38 ft	11.38 ft
Velocity*:		
X-Section Area:	0.33 sq ft	
Hydraulic Radius:	0.061	
Froude Number*:		
Manning's n*:		
Dmin:	3.00 in	
D50:	9.00 in	
Dmax:	11.25 in	

# SEDCAD 4 for Windows

Copyright 1998 Pamela J. Schwab  
Civil Software Design

Velocity and Manning's n calculations may not apply for this method.

## Structure #7 (Riprap Channel)

*Downdrain @ Sta. 9+89*

Trapezoidal Riprap Channel Inputs:

### Material: Riprap

Bottom Width (ft)	Left Sideslope Ratio	Right Sideslope Ratio	Slope (%)	Freeboard Depth (ft)	Freeboard % of Depth	Freeboard Mult. x (VxD)
3.00	3.0:1	3.0:1	24.0	1.00		

Riprap Channel Results:

### Simons/OSM Method - Steep Slope Design

	w/o Freeboard	w/ Freeboard
Design Discharge:	1.38 cfs	
Depth:	0.04 ft	1.04 ft
Top Width:	3.26 ft	9.26 ft
Velocity*:		
X-Section Area:	0.13 sq ft	
Hydraulic Radius:	0.041	
Froude Number*:		
Manning's n*:		
Dmin:	3.00 in	
D50:	9.00 in	
Dmax:	11.25 in	

Velocity and Manning's n calculations may not apply for this method.

## Structure #5 (Riprap Channel)

*Downdrain @ Sta. 7+43*

Trapezoidal Riprap Channel Inputs:

### Material: Riprap

Bottom Width (ft)	Left Sideslope Ratio	Right Sideslope Ratio	Slope (%)	Freeboard Depth (ft)	Freeboard % of Depth	Freeboard Mult. x (VxD)
3.00	2.0:1	2.0:1	20.5	1.00		

Riprap Channel Results:

# SEDCAD 4 for Windows

Copyright 1998 Pamela J. Schwab  
Civil Software Design

## Simons/OSM Method - Steep Slope Design

	w/o Freeboard	w/ Freeboard
Design Discharge:	3.64 cfs	
Depth:	0.08 ft	1.08 ft
Top Width:	3.34 ft	7.34 ft
Velocity*:		
X-Section Area:	0.27 sq ft	
Hydraulic Radius:	0.079	
Froude Number*:		
Manning's n*:		
Dmin:	4.00 in	
D50:	12.00 in	
Dmax:	15.00 in	

Velocity and Manning's n calculations may not apply for this method.

### Structure #3 (Nonerodible Channel)

*Sta. 3+80 Sandstone Downdrain*

Trapezoidal Nonerodible Channel Inputs:

Material: Sandstone

Bottom Width (ft)	Left Sideslope Ratio	Right Sideslope Ratio	Slope (%)	Manning's n	Freeboard Depth (ft)	Freeboard % of Depth	Freeboard Mult. x (VxD)
2.00	2.0:1	2.0:1	24.0	0.0290	1.00		

Nonerodible Channel Results:

	w/o Freeboard	w/ Freeboard
Design Discharge:	1.42 cfs	
Depth:	0.12 ft	1.12 ft
Top Width:	2.46 ft	6.46 ft
Velocity:	5.50 fps	
X-Section Area:	0.26 sq ft	
Hydraulic Radius:	0.102	
Froude Number:	3.00	

### Structure #2 (Riprap Channel)

*Downdrain @ Sta. 3+55*

Trapezoidal Riprap Channel Inputs:

# SEDCAD 4 for Windows

Copyright 1998 Pamela J. Schwab  
Civil Software Design

## Material: Riprap

Bottom Width (ft)}	Left Sideslope Ratio	Right Sideslope Ratio	Slope (%)	Freeboard Depth (ft)	Freeboard % of Depth	Freeboard Mult. x (VxD)
4.00	3.0:1	3.0:1	10.0	1.00		

### Riprap Channel Results:

#### Simons/OSM Method - Steep Slope Design

	w/o Freeboard	w/ Freeboard
Design Discharge:	12.84 cfs	
Depth:	0.25 ft	1.25 ft
Top Width:	5.52 ft	11.52 ft
Velocity*:		
X-Section Area:	1.20 sq ft	
Hydraulic Radius:	0.215	
Froude Number*:		
Manning's n*:		
Dmin:	4.00 in	
D50:	12.00 in	
Dmax:	15.00 in	

Velocity and Manning's n calculations may not apply for this method.

### Structure #1 (Riprap Channel)

#### *Downdrain @ Sta. 1+59*

### Trapezoidal Riprap Channel Inputs:

#### Material: Riprap

Bottom Width (ft)}	Left Sideslope Ratio	Right Sideslope Ratio	Slope (%)	Freeboard Depth (ft)	Freeboard % of Depth	Freeboard Mult. x (VxD)
3.00	3.0:1	3.0:1	15.8	1.00		

### Riprap Channel Results:

#### Simons/OSM Method - Steep Slope Design

	w/o Freeboard	w/ Freeboard
Design Discharge:	3.10 cfs	
Depth:	0.11 ft	1.11 ft
Top Width:	3.65 ft	9.65 ft
Velocity*:		

# SEDCAD 4 for Windows

Copyright 1998 Pamela J. Schwab  
Civil Software Design

	w/o Freeboard	w/ Freeboard
X-Section Area:	0.36 sq ft	
Hydraulic Radius:	0.097	
Froude Number*:		
Manning's n*:		
Dmin:	3.00 in	
D50:	9.00 in	
Dmax:	11.25 in	

Velocity and Manning's n calculations may not apply for this method.

Structure #4 (Null)

Structure #6 (Null)

Structure #8 (Null)

Structure #10 (Null)

Structure #12 (Null)

Structure #14 (Null)

# SEDCAD 4 for Windows

Copyright 1998 Pamela J. Schwab  
Civil Software Design

## Subwatershed Hydrology Detail:

Stru #	SWS #	SWS Area (ac)	Time of Conc (hrs)	Musk K (hrs)	Musk X	Curve Number	UHS	Peak Discharge (cfs)	Runoff Volume (ac-ft)
#13	1	8.020	0.110	0.000	0.000	93.000	M	5.06	0.201
	$\Sigma$	8.020						5.06	0.201
#11	1	1.620	0.029	0.000	0.000	93.000	M	1.02	0.041
	$\Sigma$	1.620						1.02	0.041
#9	1	6.850	0.049	0.000	0.000	93.000	M	4.32	0.172
	$\Sigma$	6.850						4.32	0.172
#7	1	2.190	0.048	0.000	0.000	93.000	M	1.38	0.055
	$\Sigma$	2.190						1.38	0.055
#5	1	5.780	0.079	0.000	0.000	93.000	M	3.64	0.145
	$\Sigma$	5.780						3.64	0.145
#3	1	2.250	0.035	0.000	0.000	93.000	M	1.42	0.056
	$\Sigma$	2.250						1.42	0.056
#2	1	37.760	0.235	0.000	0.000	93.000	M	12.84	0.947
	$\Sigma$	37.760						12.84	0.947
#1	1	4.920	0.104	0.000	0.000	93.000	M	3.10	0.123
	$\Sigma$	4.920						3.10	0.123
#4	$\Sigma$	44.930						14.33	1.126
#6	$\Sigma$	50.710						15.20	1.271
#8	$\Sigma$	52.900						16.58	1.326
#10	$\Sigma$	59.750						14.78	1.498
#12	$\Sigma$	61.370						14.77	1.538
#14	$\Sigma$	69.390						15.55	1.740

## Subwatershed Time of Concentration Details:

Stru #	SWS #	Land Flow Condition	Slope (%)	Vert. Dist. (ft)	Horiz. Dist. (ft)	Velocity (fps)	Time (hrs)
#1	1	5. Nearly bare and untilled, and alluvial valley fans	4.35	20.00	460.00	2.080	0.061
		8. Large gullies, diversions, and low flowing streams	1.98	13.00	658.00	4.210	0.043

# SEDCAD 4 for Windows

Copyright 1998 Pamela J. Schwab  
Civil Software Design

Stru #	SWS #	Land Flow Condition	Slope (%)	Vert. Dist. (ft)	Horiz. Dist. (ft)	Velocity (fps)	Time (hrs)
<b>#1</b>	<b>1</b>	<b>Time of Concentration:</b>					<b>0.104</b>
#2	1	5. Nearly bare and untilled, and alluvial valley fans	3.56	32.00	900.00	1.880	0.132
		8. Large gullies, diversions, and low flowing streams	2.06	33.00	1,601.00	4.300	0.103
<b>#2</b>	<b>1</b>	<b>Time of Concentration:</b>					<b>0.235</b>
#3	1	5. Nearly bare and untilled, and alluvial valley fans	23.00	23.00	100.00	4.790	0.005
		8. Large gullies, diversions, and low flowing streams	2.37	12.00	506.00	4.610	0.030
<b>#3</b>	<b>1</b>	<b>Time of Concentration:</b>					<b>0.035</b>
#5	1	5. Nearly bare and untilled, and alluvial valley fans	6.18	21.00	340.00	2.480	0.038
		8. Large gullies, diversions, and low flowing streams	1.91	12.00	627.00	4.150	0.041
<b>#5</b>	<b>1</b>	<b>Time of Concentration:</b>					<b>0.079</b>
#7	1	5. Nearly bare and untilled, and alluvial valley fans	6.67	20.00	300.00	2.580	0.032
		8. Large gullies, diversions, and low flowing streams	2.46	7.00	284.00	4.700	0.016
<b>#7</b>	<b>1</b>	<b>Time of Concentration:</b>					<b>0.048</b>
#9	1	5. Nearly bare and untilled, and alluvial valley fans	10.33	31.00	300.00	3.210	0.025
		8. Large gullies, diversions, and low flowing streams	2.44	10.00	409.00	4.690	0.024
<b>#9</b>	<b>1</b>	<b>Time of Concentration:</b>					<b>0.049</b>
#11	1	5. Nearly bare and untilled, and alluvial valley fans	7.00	14.00	200.00	2.640	0.021
		8. Large gullies, diversions, and low flowing streams	3.37	6.00	178.00	5.500	0.008
<b>#11</b>	<b>1</b>	<b>Time of Concentration:</b>					<b>0.029</b>
#13	1	5. Nearly bare and untilled, and alluvial valley fans	3.67	11.00	300.00	1.910	0.043
		8. Large gullies, diversions, and low flowing streams	2.38	27.00	1,133.00	4.630	0.067
<b>#13</b>	<b>1</b>	<b>Time of Concentration:</b>					<b>0.110</b>

## **Appendix 26.F**

Emma's Pond Design and As-Built

Appendix 26.F

Emma's Pond Design and As-Builts

Due to reformatting of the Navajo Mine PAP, the following references in this appendix have been changed, deleted or renumbered:

NM-0003F Paper Permit

Exhibit 11-13B

Exhibit 11-33

NM-0003F Electronic Permit

Exhibit 26-9

Exhibit 26-27

# **Emma's Pond** **100 yr - 6 hr Event**

***The location and watershed area are presented on Exhibit 11-13B. The pond design is presented on Exhibit 11-33.***

***UPDATED JUNE 2010***

LR

BHP Navajo Coal Company  
P.O. Box 1717  
Fruitland, NM 87416

Phone: 505-598-4200

---

## ***General Information***

### ***Storm Information:***

Storm Type:	NM TYPE II 70
Design Storm:	100 yr - 6 hr
Rainfall Depth:	1.960 inches

### ***Structure Networking:***

Type	Stru #	(flows into)	Stru #	Musk. K (hrs)	Musk. X	Description
Pond	#1	==>	#2	0.000	0.000	Emma's Pond
Channel	#2	==>	End	0.000	0.000	Spillway/Outflow chan



***Structure Summary:***

		Immediate Contributing Area (ac)	Total Contributing Area (ac)	Peak Discharge (cfs)	Total Runoff Volume (ac-ft)
#1	In			76.22	3.34
	Out	91.500	91.500	13.70	3.34
#2		0.000	91.500	13.70	3.34

## ***Structure Detail:***

### ***Structure #1 (Pond)***

*Emma's Pond*

Pond Inputs:

Initial Pool Elev:	5,359.80 ft
Initial Pool:	9.53 ac-ft

### **Emergency Spillway**

Spillway Elev	Crest Length (ft)	Left Sideslope	Right Sideslope	Bottom Width (ft)
5,359.80	25.00	3.10:1	4.10:1	9.00

Pond Results:

Peak Elevation:	5,360.44 ft
Dewater Time:	0.60 days

*Dewatering time is calculated from peak stage to lowest spillway*

### **Elevation-Capacity-Discharge Table**

Elevation	Area (ac)	Capacity (ac-ft)	Discharge (cfs)	Dewater Time (hrs)
5,354.70	0.000	0.000	0.000	
5,355.00	0.160	0.016	0.000	
5,355.70	0.894	0.350	0.000	
5,356.00	1.330	0.682	0.000	
5,356.70	1.789	1.770	0.000	
5,357.00	2.000	2.337	0.000	
5,357.70	2.346	3.857	0.000	
5,358.00	2.500	4.583	0.000	
5,358.70	2.702	6.404	0.000	
5,359.00	2.790	7.227	0.000	
5,359.70	2.957	9.239	0.000	
5,359.80	2.981	9.535	0.000	Spillway #1
5,360.00	3.030	10.137	4.312	11.40
5,360.44	3.149	11.498	13.698	2.90 Peak Stage
5,360.70	3.218	12.324	19.396	
5,361.00	3.300	13.301	34.907	
5,361.70	3.544	15.696	87.462	
5,362.00	3.650	16.775	117.724	

Detailed Discharge Table

Elevation (ft)	Emergency Spillway (cfs)	Combined Total Discharge (cfs)
5,354.70	0.000	0.000
5,355.00	0.000	0.000
5,355.70	0.000	0.000
5,356.00	0.000	0.000
5,356.70	0.000	0.000
5,357.00	0.000	0.000
5,357.70	0.000	0.000
5,358.00	0.000	0.000
5,358.70	0.000	0.000
5,359.00	0.000	0.000
5,359.70	0.000	0.000
5,359.80	0.000	0.000
5,360.00	4.312	4.312
5,360.70	19.396	19.396
5,361.00	34.907	34.907
5,361.70	87.462	87.462
5,362.00	117.724	117.724

*Structure #2 (Riprap Channel)*

*Spillway/Outflow chan*

Trapezoidal Riprap Channel Inputs:

Material: Riprap

Bottom Width (ft)	Left Sideslope Ratio	Right Sideslope Ratio	Slope (%)	Freeboard Depth (ft)	Freeboard % of Depth	Freeboard Mult. x (VxD)
9.00	3.0:1	3.0:1	5.6	1.00		

Riprap Channel Results:

Simons/OSM Method - Steep Slope Design

	w/o Freeboard	w/ Freeboard
Design Discharge:	13.70 cfs	
Depth:	0.18 ft	1.18 ft
Top Width:	10.09 ft	16.09 ft
Velocity*:		
X-Section Area:	1.73 sq ft	
Hydraulic Radius:	0.170 ft	
Froude Number*:		
Manning's n*:		
Dmin:	1.00 in	

---

	w/o Freeboard	w/ Freeboard
D50:		3.00 in
Dmax:		3.75 in

Velocity and Manning's n calculations may not apply for this method.

### ***Subwatershed Hydrology Detail:***

Stru #	SWS #	SWS Area (ac)	Time of Conc (hrs)	Musk K (hrs)	Musk X	Curve Number	UHS	Peak Discharge (cfs)	Runoff Volume (ac-ft)
#1	1	91.500	0.156	0.000	0.000	80.000	M	76.22	3.335
	<b>Σ</b>	<b>91.500</b>						<b>76.22</b>	<b>3.335</b>
<b>#2</b>	<b>Σ</b>	<b>91.500</b>						<b>13.70</b>	<b>3.336</b>

### ***Subwatershed Time of Concentration Details:***

Stru #	SWS #	Land Flow Condition	Slope (%)	Vert. Dist. (ft)	Horiz. Dist. (ft)	Velocity (fps)	Time (hrs)
#1	1	5. Nearly bare and untilled, and alluvial valley fans	5.79	25.00	432.00	2.400	0.050
		8. Large gullies, diversions, and low flowing streams	3.33	70.00	2,103.00	5.470	0.106
<b>#1</b>	<b>1</b>	<b>Time of Concentration:</b>					<b>0.156</b>

# **Emma's Pond** **25 yr - 6 hr Event**

***The location and watershed area are presented on Exhibit 11-13B. The pond design is presented on Exhibit 11-33.***

***UPDATED JUNE 2010***

LR

BHP Navajo Coal Company  
P.O. Box 1717  
Fruitland, NM 87416

Phone: 505-598-4200

## ***General Information***

### ***Storm Information:***

Storm Type:	NM TYPE II 70
Design Storm:	25 yr - 6 hr
Rainfall Depth:	1.500 inches

### Structure Networking:

Type	Stru #	(flows into)	Stru #	Musk. K (hrs)	Musk. X	Description
Pond	#1	==>	#2	0.000	0.000	Emma's Pond
Channel	#2	==>	End	0.000	0.000	Spillway/Outflow chan



***Structure Summary:***

		Immediate Contributing Area (ac)	Total Contributing Area (ac)	Peak Discharge (cfs)	Total Runoff Volume (ac-ft)
#1	In			41.25	1.77
	Out	91.500	91.500	7.14	1.77
#2		0.000	91.500	7.14	1.77

## ***Structure Detail:***

### ***Structure #1 (Pond)***

*Emma's Pond*

Pond Inputs:

Initial Pool Elev:	5,359.80 ft
Initial Pool:	9.53 ac-ft

### **Emergency Spillway**

Spillway Elev	Crest Length (ft)	Left Sideslope	Right Sideslope	Bottom Width (ft)
5,359.80	25.00	3.10:1	4.10:1	9.00

Pond Results:

Peak Elevation:	5,360.13 ft
Dewater Time:	0.55 days

*Dewatering time is calculated from peak stage to lowest spillway*

### **Elevation-Capacity-Discharge Table**

Elevation	Area (ac)	Capacity (ac-ft)	Discharge (cfs)	Dewater Time (hrs)
5,354.70	0.000	0.000	0.000	
5,355.00	0.160	0.016	0.000	
5,355.70	0.894	0.350	0.000	
5,356.00	1.330	0.682	0.000	
5,356.70	1.789	1.770	0.000	
5,357.00	2.000	2.337	0.000	
5,357.70	2.346	3.857	0.000	
5,358.00	2.500	4.583	0.000	
5,358.70	2.702	6.404	0.000	
5,359.00	2.790	7.227	0.000	
5,359.70	2.957	9.239	0.000	
5,359.80	2.981	9.535	0.000	Spillway #1
5,360.00	3.030	10.137	4.312	11.75
5,360.13	3.069	10.546	7.136	1.50 Peak Stage
5,360.70	3.218	12.324	19.396	
5,361.00	3.300	13.301	34.907	
5,361.70	3.544	15.696	87.462	
5,362.00	3.650	16.775	117.724	

Detailed Discharge Table

Elevation (ft)	Emergency Spillway (cfs)	Combined Total Discharge (cfs)
5,354.70	0.000	0.000
5,355.00	0.000	0.000
5,355.70	0.000	0.000
5,356.00	0.000	0.000
5,356.70	0.000	0.000
5,357.00	0.000	0.000
5,357.70	0.000	0.000
5,358.00	0.000	0.000
5,358.70	0.000	0.000
5,359.00	0.000	0.000
5,359.70	0.000	0.000
5,359.80	0.000	0.000
5,360.00	4.312	4.312
5,360.70	19.396	19.396
5,361.00	34.907	34.907
5,361.70	87.462	87.462
5,362.00	117.724	117.724

*Structure #2 (Riprap Channel)*

*Spillway/Outflow chan*

Trapezoidal Riprap Channel Inputs:

Material: Riprap

Bottom Width (ft)	Left Sideslope Ratio	Right Sideslope Ratio	Slope (%)	Freeboard Depth (ft)	Freeboard % of Depth	Freeboard Mult. x (VxD)
9.00	3.0:1	3.0:1	5.6	1.00		

Riprap Channel Results:

**Simons/OSM Method - Steep Slope Design**

	w/o Freeboard	w/ Freeboard
Design Discharge:	7.14 cfs	
Depth:	0.11 ft	1.11 ft
Top Width:	9.68 ft	15.68 ft
Velocity*:		
X-Section Area:	1.06 sq ft	
Hydraulic Radius:	0.109 ft	
Froude Number*:		
Manning's n*:		
Dmin:	1.00 in	

---

	w/o Freeboard	w/ Freeboard
D50:		3.00 in
Dmax:		3.75 in

Velocity and Manning's n calculations may not apply for this method.

### ***Subwatershed Hydrology Detail:***

Stru #	SWS #	SWS Area (ac)	Time of Conc (hrs)	Musk K (hrs)	Musk X	Curve Number	UHS	Peak Discharge (cfs)	Runoff Volume (ac-ft)
#1	1	91.500	0.156	0.000	0.000	80.000	M	41.25	1.770
	<b>Σ</b>	<b>91.500</b>						<b>41.25</b>	<b>1.770</b>
<b>#2</b>	<b>Σ</b>	<b>91.500</b>						<b>7.14</b>	<b>1.771</b>

### ***Subwatershed Time of Concentration Details:***

Stru #	SWS #	Land Flow Condition	Slope (%)	Vert. Dist. (ft)	Horiz. Dist. (ft)	Velocity (fps)	Time (hrs)
#1	1	5. Nearly bare and untilled, and alluvial valley fans	5.79	25.00	432.00	2.400	0.050
		8. Large gullies, diversions, and low flowing streams	3.33	70.00	2,103.00	5.470	0.106
<b>#1</b>	<b>1</b>	<b>Time of Concentration:</b>					<b>0.156</b>

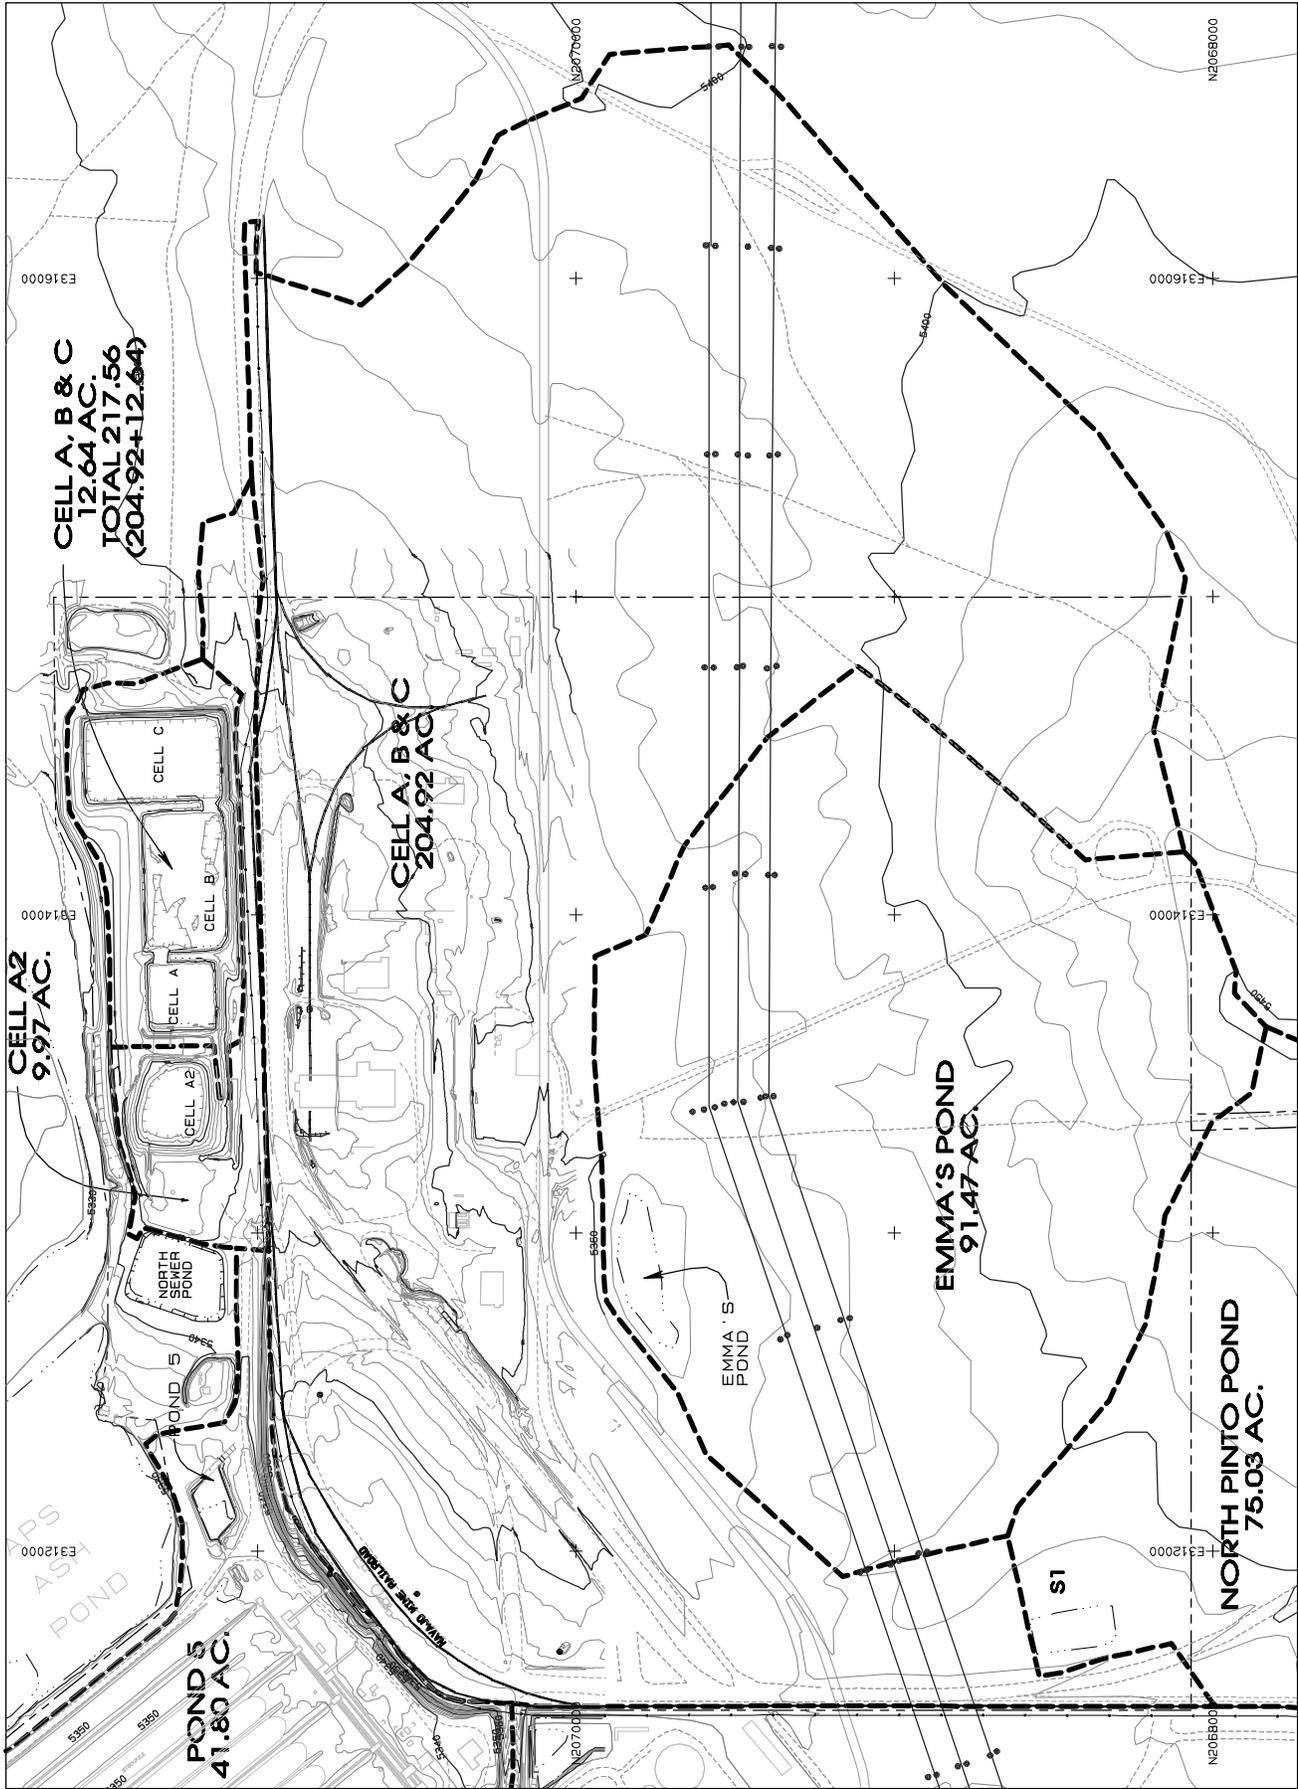


EXHIBIT 11-13B PARTIAL PLAN  
 EMMA'S POND WATERSHED  
 1" = 600'

## **Appendix 26.H**

North Pinto Modification Design and As-Built

Appendix 26.H  
North Pinto Modification Design and As-Built

Due to reformatting of the Navajo Mine PAP, the following references (formerly Appendix 29-M under NM-0003C; Appendix 11-G under NM-0003F Paper Permit) in this appendix have been changed, deleted or renumbered:

<u>NM-0003C Reference</u>	<u>NM-0003D</u>	<u>NM-0003F Paper</u>	<u>NM-0003F Electronic</u>
Exhibit 29-2 or Exhibit 29-3A	Exhibit 11-36	Exhibit 11-35	Exhibit 26-29

NORTH PINTO POND MODIFICATION

---

Due to reformatting of the Navajo Mine PAP, the following references in this appendix (formerly Appendix 29-M under NM-0003C) have been changed, deleted or renumbered:

NM-0003C Reference

Exhibit 29-2 or  
Exhibit 29-3A

NM-0003D Reference

Exhibit 11-36

## NAVAJO MINE

### NORTH PINTO POND HYDROLOGY

BHP Minerals International Inc. is proposing to alter the existing hydrology design for the Navajo Mine's North Pinto Pond area. The new hydrology design will entail the modification of the existing North Pinto sedimentation pond and its inlet channel. The construction and modification proposed are to enable the Navajo Mine to better control the surface runoff from the upstream watersheds of Pinto Pond from entering the North Shop and coal handling facilities.

Pinto pond's watersheds are approximately 87 acres of mostly undisturbed land. The exceptions are the haul road and a residence that utilize a small portion of the watershed. For the purposes of this design, however, the watersheds were assumed undisturbed. A soil curve number of 80 was designated for this area. For hydrological analysis, this area has been divided into two (2) subwatersheds labelled as A and B. These configurations and their associated hydrological structures are shown on the attached map, exhibit 29-2.

Federal regulation 30 CFR 816.46 (c)(2)(iii) requires that a sedimentation pond contain the runoff generated for a 100 year-6 hour (2.10 inches) storm event when excluding a combination spillway from the hydrological design. The proposed enlargement of Pinto Pond is designed to meet these regulations. In addition, the pond has been expanded to contain twenty-five (25) years of sediment yield from its respective watershed.

The culvert shown on exhibit 29-2 was constructed to divert watershed A runoff from the haul road to Pinto Pond. This culvert was modelled using the peak discharge from Watershed "A" for a 10 year-6 hour storm event. This diversion meets the requirements of federal regulation 30 CFR 816.43 (b)(3).

Navajo Mine is proposing to modify the inlet and outlet channels at the culvert. The runoff entering the culvert comes from Channel 1 located on the southwest side of Pinto haul road. The runoff exiting the culvert flows through Channel 2 into Pinto Pond. These proposed hydrological structures are designed for a 10 year-6 hour storm event, therefore satisfying federal regulation 30 CFR 816.43 (b)(3).

Channel 3 shown on exhibit 29-2 is designed to divert runoff from entering the south east corner of Pinto Pond to the existing inlet channel. This channel will help in the prevention of rilling on the south and east side slopes of Pinto Pond. Channel 3 was

North Pinto Pond Hydrology  
March 1992

modelled using the peak discharge from Watershed "B" for a 2 year-6 hour storm event, hence satisfying federal regulation 30 CFR 816.43 (c)(3).

Precipitation values used in these designs were taken from the Navajo Mine's Reclamation Surface Stabilization Design Handbook, Table "C", BHP-Utah International Inc.

The SEDCAD Hydrology Software Package (Version 3.0) was used for the designs of hydrological structures within this packet. Utilizing a user-defined storm and routing network structures, this package is capable of predicting the hydrological, hydraulic, and sediment runoff response of disturbed and undisturbed lands. The model outputs have been used to evaluate hydrologic structure performance. The specific design information and SEDCAD models are contained in the following pages.

STATEMENT OF CERTIFICATION

The hydrologic structures found in the following pages have been designed using current, prudent engineering practices and have been certified by a qualified, registered professional engineer in accordance with 30 CFR 816.49 (a) (2).


Signed

Date

*RON VAN VALKENBURG*  
*5-72*




# PINTO POND AREA SEDCAD ROUTING SCHEMATIC

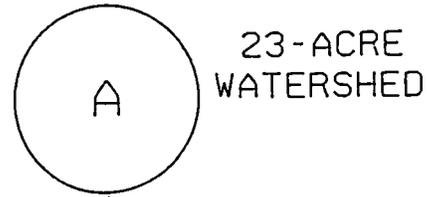


23-ACRE  
WATERSHED


BRANCH 1

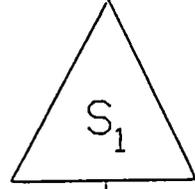

NULL STRUCTURE

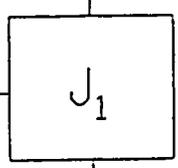


BRANCH 2


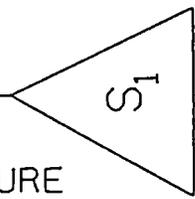


NULL STRUCTURE

BRANCH 1

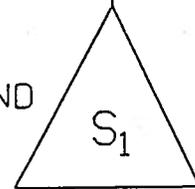

PINTO SEDIMENTATION POND

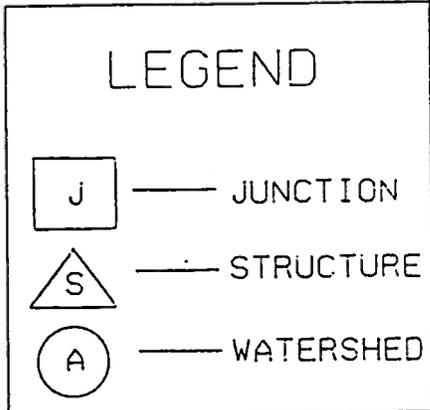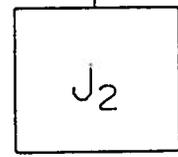

BHP-UTAH INTERNATIONAL  
 SEDCAD COMPUTER MODEL  
 WATERSHED INPUTS

NAVAJO MINE  
 PINTO POND

<u>WATERSHED</u>	<u>A</u>	<u>B</u>
Total Acres	23.00	64.00
Undisturbed	23.00	64.00
Disturbed	0.00	0.00
Spoil	0.00	0.00
Curve Number (CN)		
Undisturbed	80.00	80.00
Disturbed	80.00	80.00
Spoil	93.00	93.00
Watershed CN	80.00	80.00
Control Practice Factor (CP)		
Undisturbed	0.373	0.373
Disturbed	0.393	0.393
Spoil	1.000	1.000
Watershed CP	0.373	0.373
Soil Erodibility Factor (K)		
Undisturbed	0.30	0.30
Disturbed	0.15	0.15
Spoil	0.30	0.30
Watershed K	0.30	0.30
Tc Utilizing Velocity (hr)	0.308	0.563
Length of Slope (ft)	200	200
Ave. Slope (%)	3.30%	3.40%
Length-Slope Factors (LS)		
MUSLE LS Factor	0.389	0.401
"m"	0.3	0.3
"theta"	0.03	0.03
RUSLE LS Factor	0.542	0.542
"m"	0.3	0.3
"slope factor"	0.40	0.40

BHP-UTAH INTERNATIONAL  
 AVERAGE ANNUAL SOIL LOSS  
 UTILIZING THE "MUSLE" OR "RUSLE" EQUATION

NAVAJO MINE  
 PINTO POND

<u>WATERSHED</u>	<u>A</u>	<u>B</u>
Total Acres	23	64
Undisturbed	23	64
Disturbed	0	0
Spoil	0	0
Rainfall Erosivity (R)	20	20
Soil Erodibility Factor (K)		
Undisturbed	0.30	0.30
Disturbed	0.15	0.15
Spoil	0.30	0.30
Watershed K	0.30	0.30
Length-Slope Factors (LS)		
MUSLE LS Factor	0.389	0.401
"m"	0.3	0.3
"theta"	0.03	0.03
RUSLE LS Factor	NA	NA
"m"	0.3	0.3
"slope factor"	0.400	0.400
Control Practice Factor (CP)		
Undisturbed	0.373	0.373
Disturbed	0.393	0.393
Spoil	1.000	1.000
Watershed CP	0.373	0.373
<u>Sediment Yields</u>		
Tons/Acre/Year	0.87	0.90
Tons/Year	20.00	57.39
Acre-Feet/Year	0.01	0.03
5 Yr Sediment Vol. (ac-ft)	0.06	0.17
10 Yr Sediment Vol. (ac-ft)	0.12	0.34
15 Yr Sediment Vol. (ac-ft)	0.18	0.51
20 Yr Sediment Vol. (ac-ft)	0.24	0.68
25 Yr Sediment Vol. (ac-ft)	0.29	0.84
Total Sediment Vol. (ac-ft) for A & B		1.13

NAVAJO MINE

NORTH PINTO SEDIMENTATION POND

The North Pinto sedimentation pond is designed to contain the 4.53 ac.-ft. runoff from a 100 year-6 hour storm event and a 25 year sediment deposition. The pond will not overflow unless a storm event of greater precipitation than a 100 year event occurs, or if successive storms immediately follow a 100 year-6 hour event.

A gauge post will be installed in the pond to monitor the pond volume. Water and sediment levels will be maintained below the 5374.5 elevation to insure that the design capacity is available. Periodic cleaning will be performed as needed. Water will be pumped below the design capacity level within 10 days following a runoff event. Water will be pumped to water trucks for distribution on roads, or will be pumped to and contained in a mining pit.

Watersheds "A" and "B" shown on Exhibit 29-3a are routed to this pond. The total watershed encompasses 87 acres of type Az soil, with a soil curve number of 80. For the purposes of SEDCAD, the channel material contains characteristics that model "Fine Sand Colloidal" and "Sandy Loam Noncolloidal" both at velocities of 2.5 fps.

A SEDCAD computer run performed on the Pinto sedimentation pond for the 100 year-6 hour storm event has been included in this packet and the results are summarized below.

Design Summary: 100 Year-6 Hour Storm Event (2.10 Inches)  
Acres = 87

	<u>Pond #1</u>
Drainage Area (Acres)	87
Runoff Volume (Ac.-Ft.)	4.53
25 Year Sediment Volume (Ac.-Ft.)	1.13
Total Storage Capacity (Ac.-Ft.)	5.66
Elevation Top of Pond	5381.5
Elevation of Pond Bottom	5373.0
Maximum Water/Sediment Level	5374.5

\*\*\*\*\*  
POND VOLUMES USING BOTTOM DIMENSIONS  
\*\*\*\*\*

\*\*\*\* INPUT DATA USING BOTTOM DIMENSIONS \*\*\*\*


POND NUMBER.....	PINTO POND
LENGTH OF POND .....	315 FT
WIDTH OF POND .....	93 FT
DEPTH OF POND .....	8.5 FT
ONE SIDE SLOPE OF LENGTH ....	2
ONE SIDE SLOPE OF LENGTH ....	2
ONE SIDE SLOPE OF WIDTH.....	2
ONE SIDE SLOPE OF WIDTH.....	2

\*\*\*\*\* POND RESULTS INCREMENTALY \*\*\*\*\*

ELEVATION	VOLUME AC.FT.	SURFACE AC.	DEPTH FT.
5373.0	0.00	0.67	0.00
5373.5	0.34	0.69	0.50
5374.0	0.69	0.71	1.00
5374.5	1.05	0.73	1.50
5375.0	1.42	0.75	2.00
5375.5	1.80	0.77	2.50
5376.0	2.19	0.79	3.00
5376.5	2.59	0.81	3.50
5377.0	3.00	0.83	4.00
5377.5	3.42	0.85	4.50
5378.0	3.85	0.87	5.00
5378.5	4.29	0.89	5.50
5379.0	4.74	0.91	6.00
5379.5	5.20	0.93	6.50
5380.0	5.67	0.95	7.00
5380.5	6.15	0.97	7.50
5381.0	6.64	1.00	8.00
5381.5	7.15	1.02	8.50


\*\*\*\*\* POND RESULTS \*\*\*\*\*

THE POND VOLUME IS .....	7.145061 AC.FT
THE TOP DIMENSIONS ARE...	349 FT. X 127 FT.
THE SURFACE AREA IS...	1.017516 AC.

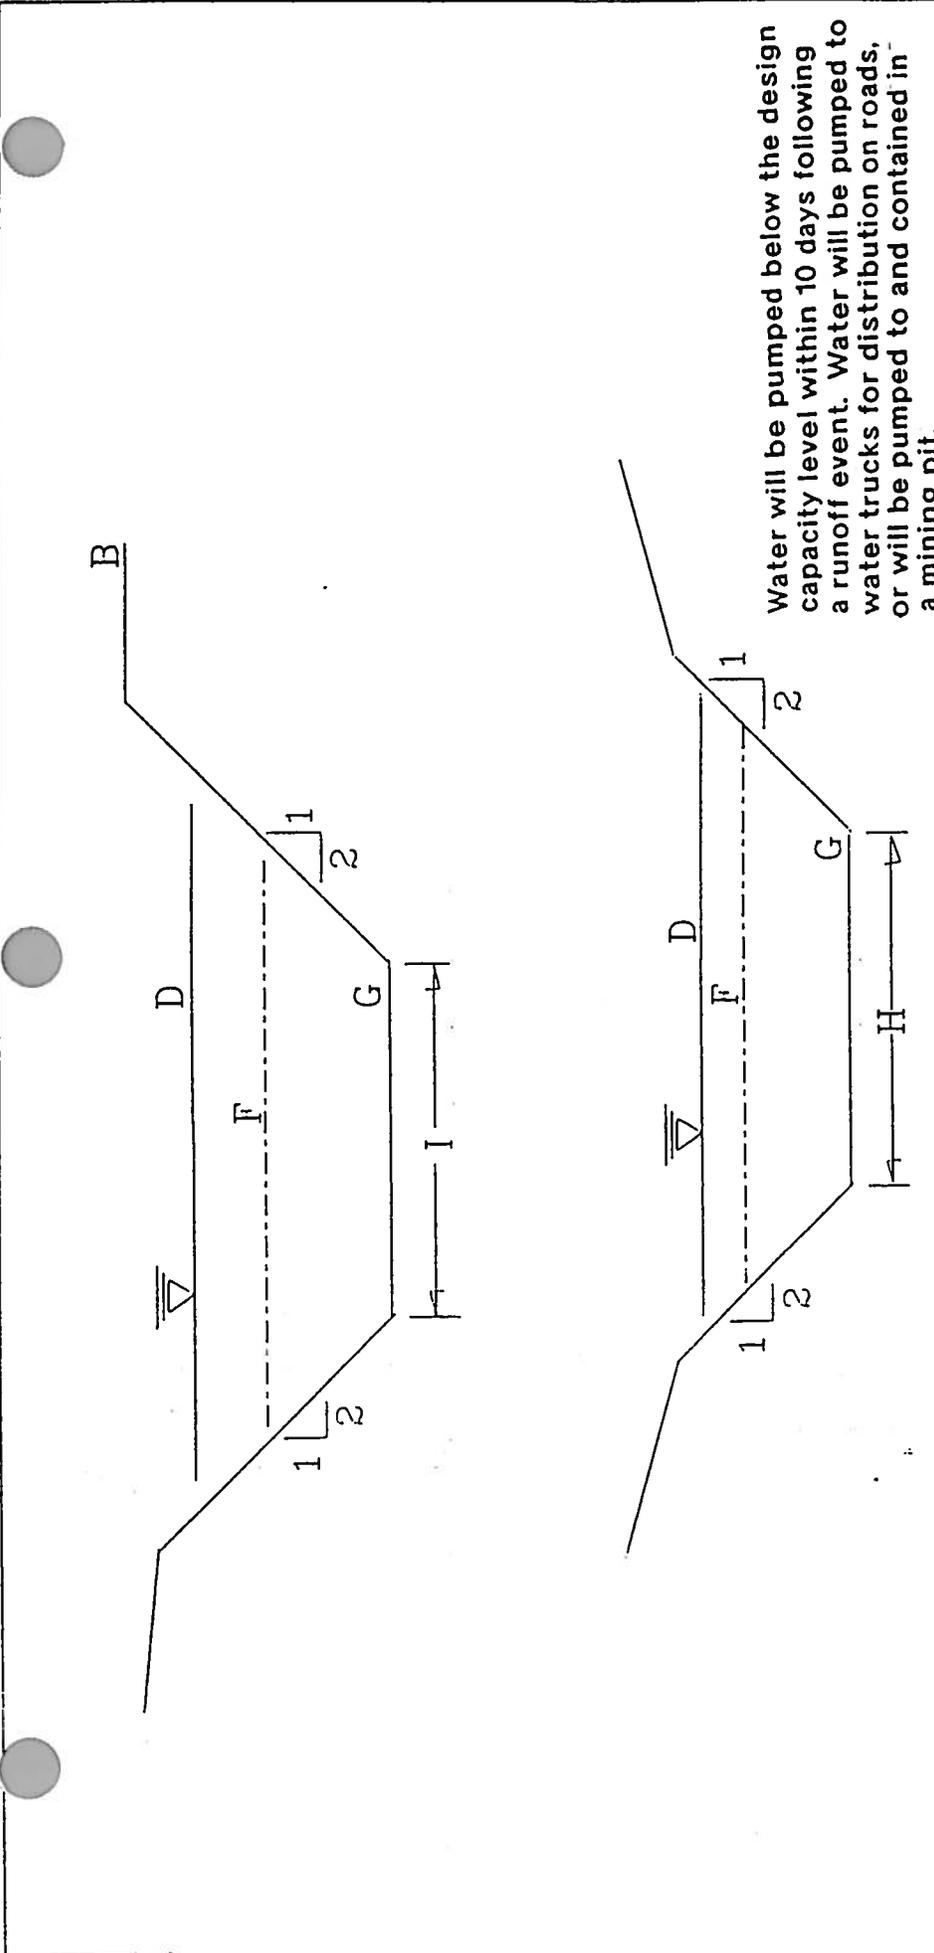

Water will be pumped below the design capacity level within 10 days following a runoff event. Water will be pumped to water trucks for distribution on roads, or will be pumped to and contained in a mining pit.

NOT TO SCALE

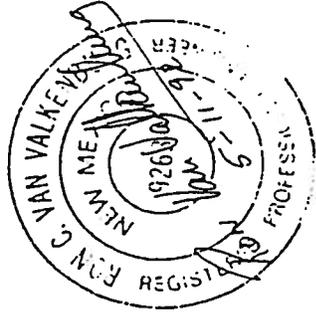

ITEM	DIM.	ELEV. DIM.
ELEV. OF TOP OF DAM	B	5381.5
ELEV. OF POND BOTTOM	G	5373.0
TOP WIDTH OF DAM (ft.)	A	NA (INCISED)
DESIGNED MAX. WAT. LEVEL	D	5380.0
TOE OF EMBANKMENT	E	NA (INCISED)
MAX SEDIMENT LEVEL	F	5374.5
BOTTOM LENGTH (ft.)	H	315.0
BOTTOM WIDTH (ft.)	I	93.0

BHP MINERALS INTERNATIONAL INC.  
 MAYA: MINE  
 FRUITLAND, NEW MEXICO USA

POND CROSS SECTIONS  
 Pinto Pond

DRAWN BY	SYT	SCALE	N/A
APPROVED BY		DATE	03/20/92
DRAWING NO		LOCATION NO	

NAVAJO MINE  
PINTO SEDIMENTATION POND  
CHANNEL 1

The existing Channel 1 diverts the runoff from watershed "A" to the Pinto Culvert. The proposed modification of Channel 1 will reduce the sediment accumulation at the Pinto Culvert inlet, and it is shown on Exhibit 29-2.

Watershed "A" is 23 acres of undisturbed land with an average curve number of 80. The proposed channel is designed to pass the runoff from a 10 year-6 hour storm event. The SEDCAD model indicates a peak flow of 4.47 cfs from this watershed, which will produce a flow depth of 0.52 feet. Flow velocities are more than 2.5 fps for an erodible channel, therefore, erosion control measures (rip rap with a D50 of 9") will be required.

To design the channel, the SEDCAD Utility computer program was used. The design details and typical cross-section for this structure follow.

Design Summary:

Channel Depth (Ft.)	2.0
Channel Bottom Width (Ft.)	3.0
Channel Inner Side Slopes	2:1
Channel Outer Side Slopes	3:1
Channel Slope (%)	1.0
Peak Stage: 10 Year-6 Hour (Ft.)	0.52
Freeboard (Ft.)	1.48
Required Flow (cfs)	4.47
Velocity (fps)	2.13
Lining	D50 9" Rip Rap

SEDCAD+ RIPRAP CHANNEL DESIGN

channel 1 10yr-6hr


INPUT VALUES:

Shape	TRAPEZOIDAL	
Discharge	4.47 cfs	
Slope	1.00 %	
Sideslopes (L and R)	2.00:1	2.00:1
Bottom Width	3.00 feet	
Freeboard	1.48 ft	

RESULTS:

Mild Slope Design


Depth	0.52 ft	
with Freeboard	2.00 ft	
Top Width	5.08 ft	
with Freeboard	11.00 ft	
Velocity	2.13 fps	
Cross Sectional Area	2.10 sq ft	
Hydraulic Radius	0.39 ft	
Manning's n	0.038	
Froude Number	0.58	
Dmax	1.500 ft (18.00 in)	
D50	0.750 ft ( 9.00 in)	
D10	0.250 ft ( 3.00 in)	

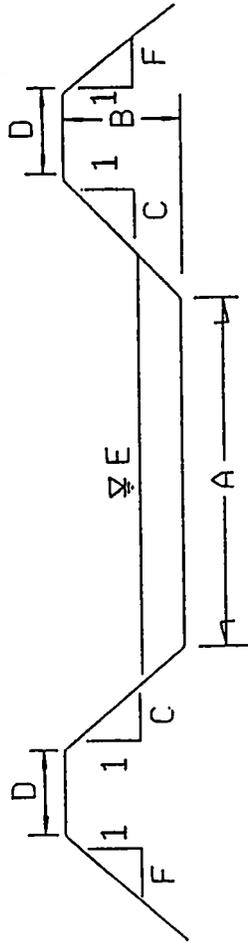

CHANNEL 1  
CROSS-SECTION

NOT TO SCALE

BHP MINERALS INTERNATIONAL INC.

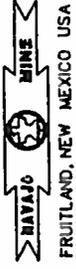

CHANNEL 1 CROSS-SECTION

DRAWN BY	SYP	SCALE	N/A
APPROVED BY		DATE	06/02/82
BRANDING NO.		LOCATION NO.	

ITEM	DIM.	ELEV./DIM.
BOTTOM WIDTH (FT)	A	3.0
CHANNEL DEPTH (FT)	B	2.0
SIDE SLOPES (C:1)	C	2:1
BERM WIDTH (FT)	D	1.0
PEAK STAGE (FT)	E	0.52
CHANNEL SLOPE (%)		1.0
MAX VELOCITY (FPS)		2.13
DESIGN CFS		4.47
LINING		Rip Rap
D <sub>50</sub> (where needed)		9"
SIDE SLOPES (F:1)	F	3:1

NAVAJO MINE  
PINTO SEDIMENTATION POND  
CHANNEL 2

The existing Channel 2 passes the runoff from Pinto Culvert to the Pinto Pond inlet spillway. The proposed modification of Channel 2 will reduce the rate of sediment deposition in Pinto Pond. The location is shown on Exhibit 29-2.

The proposed channel is designed to pass the runoff from a 10 year-6 hour storm event. The runoff entering Channel 2 is via the watershed "A", Channel 1, and Pinto Culvert and from natural drainages from watershed "B". The SEDCAD model indicates a combined peak flow of 12.12 cfs from watershed "A" and "B", which will produce a flow depth of 0.79 feet. Flow velocities are more than 2.5 fps for an erodible channel, therefore, erosion control measures (rip rap with a D50 of 9") will be required.

To design the channel, the SEDCAD Utility computer program was used. The design details and typical cross-section for this structure follow.

Design Summary:

Channel Depth (Ft.)	2.0
Channel Bottom Width (Ft.)	3.0
Channel Inner Side Slopes	2:1
Channel Outer Side Slopes	3:1
Channel Slope (%)	1.6
Peak Stage: 10 Year-6 Hour (Ft.)	0.79
Freeboard (Ft.)	1.21
Required Flow (cfs)	12.12
Velocity (fps)	3.37
Lining	D50 9" Rip Rap

SEDCAD+ RIPRAP CHANNEL DESIGN

channel 2 10yr-6hr


INPUT VALUES:

Shape	TRAPEZOIDAL	
Discharge	12.12 cfs	
Slope	1.60 %	
Sideslopes (L and R)	2.00:1	2.00:1
Bottom Width	3.00 feet	
Freeboard	1.21 ft	

RESULTS:

Mild Slope Design

Depth	0.79 ft	
with Freeboard	2.00 ft	
Top Width	6.15 ft	
with Freeboard	10.99 ft	
Velocity	3.37 fps	
Cross Sectional Area	3.60 sq ft	
Hydraulic Radius	0.55 ft	
Manning's n	0.038	
Froude Number	0.78	
Dmax	1.500 ft (18.00 in)	
D50	0.750 ft ( 9.00 in)	
D10	0.250 ft ( 3.00 in)	

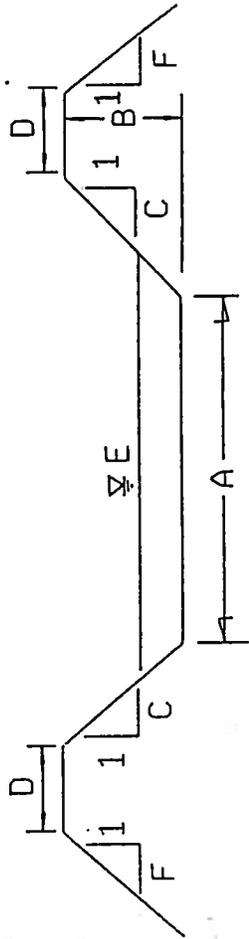

CHANNEL 2  
CROSS-SECTION

NOT TO SCALE

BHP MINERALS INTERNATIONAL INC.



CHANNEL 2 CROSS-SECTION

DRAWN BY	SYP	SCALE	N/A
APPROVED BY		DATE	08/02/92
DRAWING NO.		LOCATION NO.	

ITEM	DDM	ELEV - DDM
BOTTOM WIDTH (FT)	A	3.0
CHANNEL DEPTH (FT)	B	2.0
SIDE SLOPES (C:1)	C	2:1
BERM WIDTH (FT)	D	1.0
PEAK STAGE (FT)	E	0.79
CHANNEL SLOPE (%)		1.6
MAX VELOCITY (FPS)		3.37
'DESIGN CFS		12.12
LINING		Rip Rap
D <sub>50</sub> (where needed)		9"
SIDE SLOPES (F:1)	F	3:1

NAVAJO MINE  
PINTO SEDIMENTATION POND  
CHANNEL 3

The proposed Channel 3 will redirect watershed "B" from entering the south east corner of Pinto Pond to the existing inlet spillway. This channel will help in the prevention of rilling on the south and east side slopes of Pinto Pond. The location is shown on exhibit 29-2.

Watershed "B" is 64 acres of undisturbed land with an average curve number of 80. The proposed channel is designed to pass the runoff from a 2 year-6 hour storm event. The SEDCAD model indicates a peak flow of 1.76 cfs from this watershed which will produce a flow depth of 0.21 feet. Flow velocities are less than 2.5 fps, therefore, erosion control measures will not be required.

To design the channel, the SEDCAD utility computer program was used. The design details and typical cross-section for this structure follow.

Design Summary:

Channel Depth (Ft.)	2.0
Channel Bottom Width (Ft.)	3.0
Channel Inner Side Slopes	2:1
Channel Outer Side Slopes	3:1
Channel Slope (%)	1.0
Peak Stage: 2 Year-6 Hour (Ft.)	0.21
Freeboard (Ft.)	1.79
Required Flow (cfs)	1.76
Velocity (fps)	2.42
Lining	Grass/Dirt

SEDCAD+ ERODIBLE CHANNEL DESIGN

channel 3 2year-6hour


Limiting Velocity Technique  
Sediment-laden Water

INPUT VALUES:

Shape	TRAPEZOIDAL	
Discharge	1.76 cfs	
Slope	1.00 %	
Sideslopes	2.00:1 (L)	2.00:1 (R)
Bottom Width	3.00 ft	
Manning's n	0.020	
Max. Velocity	2.50 fps	
Material	SANDY LOAM NONCOLLOIDAL	
Freeboard	1.79 ft	

RESULTS:

Actual Discharge	1.76 cfs
Depth	0.21 ft
with Freeboard	2.00 ft
Top Width	3.85 ft
with Freeboard	11.01 ft
Velocity	2.42 fps
Cross Sectional Area	0.73 sq ft
Hydraulic Radius	0.18 ft
Froude Number	0.98

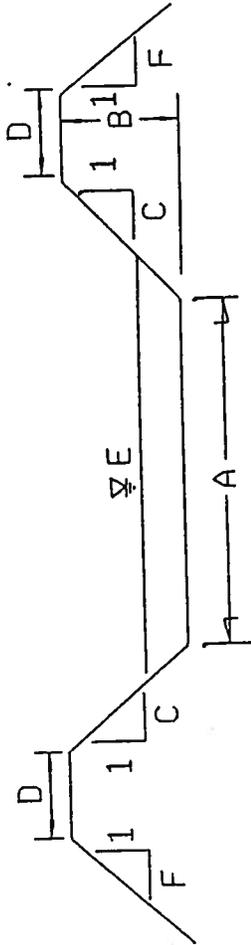

CHANNEL 3  
CROSS-SECTION

NOT TO SCALE

KFP MINERALS INTERNATIONAL INC  
  
 FRUITLAND, NEW MEXICO USA

CHANNEL 3 CROSS-SECTION

DRAWN BY	SYP	SCALE	N/A
APPROVED BY		DATE	06/02/92
DRAWING NO.		LOCATION NO.	

ITEM	BOX	ELEV./ODD
BOTTOM WIDTH (FT)	A	3.0
CHANNEL DEPTH (FT)	B	2.0
SIDE SLOPES (C:I)	C	2:1
BERM WIDTH (FT)	D	1.0
PEAK STAGE (FT)	E	0.21
CHANNEL SLOPE (%)		1.0
MAX VELOCITY (FPS)		2.42
DESIGN CFS		1.76
LINING		Grass/Dirt
D <sub>50</sub> (where needed)		N/A
SIDE SLOPES (F:I)	F	3:1

NAVAJO MINE

PINTO HAUL ROAD CULVERT

The culvert shown on exhibit 29-2 was constructed to divert Watershed "A" runoff from the haul road to Pinto Pond. Runoff from Watershed "A" drains to the northernmost corner of the watershed passing through Channel 1. This runoff is then routed by Pinto Culvert to the inlet channel (Channel 2). This culvert was modelled using the peak discharge from Watershed "A" for a 10 year-6 hour storm event.

The design details and typical cross-sections are included in the following pages.

Design Summary:

Culvert Inlet Elev. (Ft.)	5386.8
Culvert Outlet Elev. (Ft.)	5382.9
Culvert Diameter (Ft.)	2.0
Pipe Length (Ft.)	158.9
Design Discharge (cfs)	4.47

SEDCAD+ CULVERT SIZING UTILITY

PINTO CULVERT'

Design Discharge = 4.470 cfs  
 Entrance Loss Coefficient = 0.5  
 Pipe Length = 158.900 feet  
 Pipe Slope = 2.400 %  
 Manning's n = 0.016  
 Maximum Headwater = 3.200 feet  
 Tailwater Depth = 0.000 feet

Smallest Diameter Required to Pass Flow is 12 inches

PERFORMANCE CURVES:

Diameter: 8 inches

Headwater (ft)	Discharge (cfs)	Control	Flow Type
0.32	0.00		0
0.64	0.00		0
0.96	0.00		0
1.28	0.00		0
1.60	0.00		0
1.92	0.00		0
2.24	0.00		0
2.56	0.00		0
2.88	0.00		0
3.20	0.00		0
3.52	0.00		0
3.84	1.92	Outlet	6
4.16	2.01	Outlet	6
4.48	2.04	Outlet	6
4.80	2.07	Outlet	6

Diameter: 9 inches

Headwater (ft)	Discharge (cfs)	Control	Flow Type
0.32	0.00		0
0.64	0.00		0
0.96	0.00		0
1.28	0.00		0
1.60	0.00		0
1.92	0.00		0
2.24	0.00		0
2.56	0.00		0
2.88	0.00		0
3.20	0.00		0
3.52	0.00		0
3.84	2.56	Outlet	6
4.16	2.63	Outlet	6
4.48	2.70	Outlet	6
4.80	2.77	Outlet	6

Diameter: 12 inches

Headwater (ft)	Discharge (cfs)	Control	Flow Type
0.32	0.00		0
0.64	0.00		0
0.96	0.00		0
1.28	0.00		0
1.60	0.00		0
1.92	0.00		0
2.24	0.00		0
2.56	0.00		0
2.88	0.00		0
3.20	0.00		0
3.52	0.00		0
3.84	5.45	Outlet	6
4.16	5.57	Outlet	6
4.48	5.70	Outlet	6
4.80	5.83	Outlet	6

Diameter: 15 inches

Headwater (ft)	Discharge (cfs)	Control	Flow Type
0.32	0.00		0
0.64	0.00		0
0.96	0.00		0
1.28	0.00		0
1.60	0.00		0
1.92	0.00		0
2.24	0.00		0
2.56	0.00		0
2.88	0.00		0
3.20	0.00		0
3.52	0.00		0
3.84	9.48	Outlet	6
4.16	9.71	Outlet	6
4.48	9.94	Outlet	6
4.80	10.15	Outlet	6

Diameter: 18 inches


Headwater (ft)	Discharge (cfs)	Control	Flow Type
0.32	0.00		0
0.64	0.00		0
0.96	0.00		0
1.28	0.00		0
1.60	0.00		0
1.92	0.00		0
2.24	0.00		0
2.56	0.00		0
2.88	0.00		0
3.20	0.00		0

3.52	0.00		0
3.84	14.52	Outlet	6
4.16	15.12	Outlet	6
4.48	15.47	Outlet	6
4.80	15.83	Outlet	6


Diameter: 21 inches

Headwater (ft)	Discharge (cfs)	Control	Flow Type
0.32	0.00		0
0.64	0.00		0
0.96	0.00		0
1.28	0.00		0
1.60	0.00		0
1.92	0.00		0
2.24	0.00		0
2.56	0.00		0
2.88	0.00		0
3.20	0.00		0
3.52	0.00		0
3.84	19.22	Inlet	5
4.16	20.37	Inlet	5
4.48	21.47	Inlet	5
4.80	22.51	Inlet	5

SEDCAD+ - 12/15/82

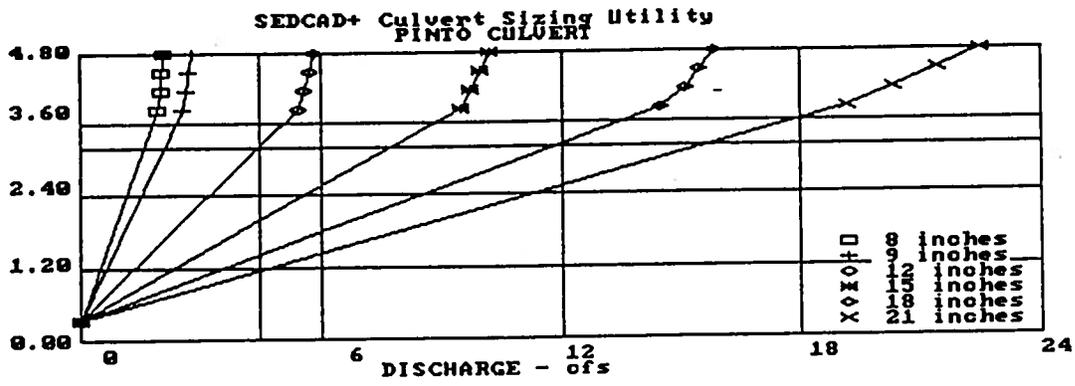

SAFETY BERMS

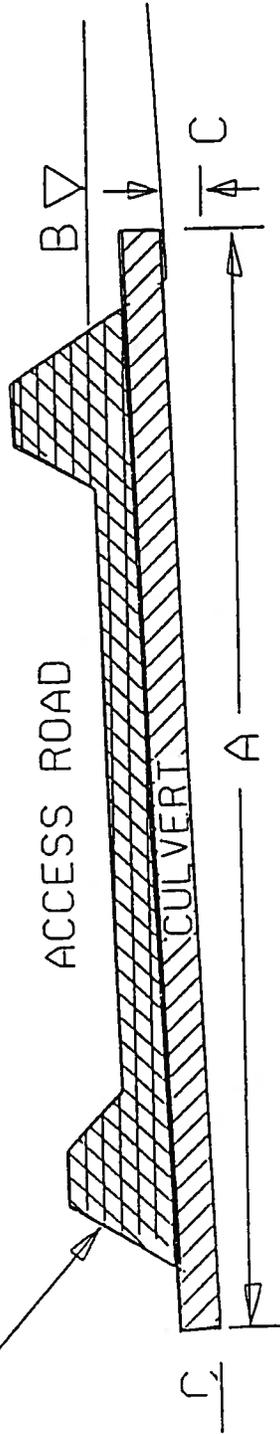

ACCESS ROAD CULVERT

NOT TO SCALE

BHP-UTAH INTERNATIONAL INC.



FRUITLAND, NEW MEXICO USA

PINTO CULVERT  
TYPICAL CROSS-SECTIONS

DRAWN BY	SYP	SCALE	N/A
APPROVED BY		DATE	04/01/92
DRAWING NO.		LOCATION NO.	

ITEM	DIM.	ELEV.-DIM.
CULVERT LENGTH	A	158.9 (F.T)
HEADWATER	B	3.2 (F.T)
ELEVATION CHANGE	C	3.0 (F.T)

# **North Pinto Pond**

LR

BHP Navajo Coal Company  
PO Box 1717  
Fruitland, NM 87416

Phone: 505-598-5861

***General Information***

***Storm Information:***

Storm Type:	Type II - 60
Design Storm:	100 yr - 6 hr
Rainfall Depth:	2.000 inches

# SEDCAD 4 for Windows

Copyright 1998 Pamela J. Schwab  
Civil Software Design

---

## ***Structure Summary:***

	Immediate Contributing Area (ac)	Total Contributing Area (ac)	Peak Discharge (cfs)	Total Runoff Volume (ac-ft)
#1	76.900	76.900	42.40	3.60

# SEDCAD 4 for Windows

Copyright 1998 Pamela J. Schwab  
Civil Software Design

## *Subwatershed Hydrology Detail:*

Stru #	SWS #	SWS Area (ac)	Time of Conc (hrs)	Musk K (hrs)	Musk X	Curve Number	UHS	Peak Discharge (cfs)	Runoff Volume (ac-ft)
#1	1	76.900	0.332	0.000	0.000	80.000	M	42.40	3.605
$\Sigma$		<b>76.900</b>						<b>42.40</b>	<b>3.605</b>

## *Subwatershed Time of Concentration Details:*

Stru #	SWS #	Land Flow Condition	Slope (%)	Vert. Dist. (ft)	Horiz. Dist. (ft)	Velocity (fps)	Time (hrs)
#1	1	5. Nearly bare and untilled, and alluvial valley fans	3.41	75.00	2,200.00	1.840	0.332
#1	1	<b>Time of Concentration:</b>					<b>0.332</b>

CIVIL SOFTWARE DESIGN

SEDCAD+ Version 3

AS BUILT DESIGN HYDROLOGY CALCULATION FOR NORTH PINTO POND CHANNEL 2

by

Name: Brian Sambirsky

Company Name: BHP MINERALS  
File Name: C:\BRIAN\NPINTOCH

Date: 12-19-1995

Company Name: BHP MINERALS

Filename: C:\BRIAN\NPINTOCH

User: Brian Sambirsky

Date: 12-19-1995 Time: 09:44:26

As built design hydrology calculation for North Pinto Pond Channel 2  
 Storm: 1.30 inches, 10 year- 6 hour, Type II-65

Hydrograph Convolution Interval: 0.1 hr

=====  
 SUBWATERSHED/STRUCTURE INPUT/OUTPUT TABLE  
 =====

-Hydrology-

IBS	SWS	Area (ac)	CN	UHS	Tc (hrs)	K (hrs)	X	Base- Flow (cfs)	Runoff Volume (ac-ft)	Peak Discharge (cfs)
011	1	21.30	83	M	0.330	0.000	0.000	0.0	0.48	6.65
		Type: Null		Label: CP-37		Influence				
011	Structure	21.30							0.48	
011	Total IN/OUT	21.30							0.48	6.65
211	1	55.60	83	M	0.350	0.000	0.000	0.0	1.25	16.77
		Type: Null		Label: North Pinto Pond						
211	Structure	55.60							1.73	
211	Total IN/OUT	76.90							1.73	23.42
011	to 211 Routing					0.028	0.249			
		Type: Null		Label: North Pinto Pond						
011	Structure	55.60							1.73	
011	Total IN/OUT	76.90							1.73	23.42
011	to 311 Routing					0.000	0.000			

Company Name: BHP MINERALS

Filename: C:\BRIAN\NPINTOCH User: Brian Sambirsky

Date: 12-19-1995 Time: 09:44:26

As built design hydrology calculation for North Pinto Pond Channel 2

Storm: 1.30 inches, 10 year- 6 hour, Type II-65

Hydrograph Convolution Interval: 0.1 hr

=====

DETAILED SUBWATERSHED INPUT/OUTPUT TABLE

=====

J	B	S	SWS	Seg. #	Land Flow Condition	Distance (ft)	Slope (%)	Velocity (fps)	Segment Time (hr)	Time Conc. (hr)	Muskingum K (hr)	X
1	1	1	1	-a	5	2150.00	3.26	1.81	0.33	0.330		
2	1	1	1	-a	5	2120.00	2.83	1.68	0.35	0.350		

CIVIL SOFTWARE DESIGN

SEDCAD+ Version 3

AS BUILT DESIGN HYDROLOGY CALCULATION FOR NORTH PINTO POND CHANNEL 3

by

Name: Brian Sambirsky

Company Name: BHP MINERALS  
File Name: C:\BRIAN\NPINTOCH

Date: 12-19-1995

Company Name: BHP MINERALS

Filename: C:\BRIAN\NPINTOCH User: Brian Sambirsky

Date: 12-19-1995 Time: 09:54:18

As built design hydrology calculation for North Pinto Pond Channel 3

Storm: 0.80 inches, 2 year- 6 hour, Type II-65

Hydrograph Convolution Interval: 0.1 hr

=====  
 SUBWATERSHED/STRUCTURE INPUT/OUTPUT TABLE  
 =====

-Hydrology-

JBS	SWS	Area (ac)	CN	UHS	Tc (hrs)	K (hrs)	X	Base- Flow (cfs)	Runoff Volume (ac-ft)	Peak Discharge (cfs)	
111	1	21.30	83	M	0.330	0.000	0.000	0.0	0.11	1.28	
		Type: Null		Label: CP-37		Influence					
111	Structure	21.30									
111	Total IN/OUT	21.30									
211	1	55.60	83	M	0.350	0.000	0.000	0.0	0.29	3.22	
		Type: Null		Label: North Pinto Pond							
211	Structure	55.60									
2	Total IN/OUT	76.90									
111	to 211 Routing					0.028	0.249				
311	Structure	55.60	Type: Null		Label: North Pinto Pond						
311	Total IN/OUT	76.90									
211	to 311 Routing					0.000	0.000				

Company Name: BHP MINERALS

Filename: C:\BRIAN\NPINTOCH User: Brian Sambirsky

Date: 12-19-1995 Time: 09:54:18

As built design hydrology calculation for North Pinto Pond Channel 3

Storm: 0.80 inches, 2 year- 6 hour, Type II-65 ..

Hydrograph Convolution Interval: 0.1 hr

=====

DETAILED SUBWATERSHED INPUT/OUTPUT TABLE

=====

J	B	S	SWS	Seg. #	Land Flow Condition	Distance (ft)	Slope (%)	Velocity (fps)	Segment Time (hr)	Time Conc. (hr)	Muskingum K (hr)	X
1	1	1	1	-a	5	2150.00	3.26	1.81	0.33	0.330		
2	1	1	1	-a	5	2120.00	2.83	1.68	0.35	0.350		

SEDCAD+ RIPRAP CHANNEL DESIGN

Channel 1 10yr-6hr

INPUT VALUES:

Shape	TRAPEZOIDAL	
Discharge	12.29 cfs	
Slope	1.00 %	
Sideslopes (L and R)	2.00:1	2.00:1
Bottom Width	3.00 feet	
Freeboard	1.1 ft	

RESULTS:

Mild Slope Design

Depth	0.90 ft	
with Freeboard	2.00 ft	
Top Width	6.59 ft	
with Freeboard	10.99 ft	
Velocity	2.86 fps	
Cross Sectional Area	4.30 sq ft	
Hydraulic Radius	0.61 ft	
Manning's n	0.038	
Froude Number	0.62	
Dmax	1.500 ft (18.00 in)	
D50	0.750 ft ( 9.00 in)	
D10	0.250 ft ( 3.00 in)	

SEDCAD+ RIPRAP CHANNEL DESIGN

Channel 2 10yr-6hr

INPUT VALUES:

Shape	TRAPEZOIDAL	
Discharge	23.42 cfs	
Slope	1.60 %	
Sideslopes (L and R)	2.00:1	2.00:1
Bottom Width	3.00 feet	
Freeboard	0.98 ft	

RESULTS:

Steep Slope Design - PADER Method

Depth	1.02 ft	
with Freeboard	2.00 ft	
Top Width	7.08 ft	
with Freeboard	11.00 ft	
Velocity	4.55 fps	
Cross Sectional Area	5.14 sq ft	
Hydraulic Radius	0.68 ft	
Manning's n	0.032	
Froude Number	0.94	
Dmax	0.313 ft ( 3.75 in)	
D50	0.250 ft ( 3.00 in)	
D10	0.083 ft ( 1.00 in)	

SEDCAD+ RIPRAP CHANNEL DESIGN

Channel 3 2yr-6hr

INPUT VALUES:

Shape	TRAPEZOIDAL	
Discharge	3.22 cfs	
Slope	1.00 %	
Sideslopes (L and R)	2.00:1	2.00:1
Bottom Width	3.00 feet	
Freeboard	1.57 ft	

RESULTS:

Mild Slope Design

Depth	0.43 ft	
with Freeboard	2.00 ft	
Top Width	4.73 ft	
with Freeboard	11.01 ft	
Velocity	1.92 fps	
Cross Sectional Area	1.67 sq ft	
Hydraulic Radius	0.34 ft	
Manning's n	0.038	
Froude Number	0.57	
Dmax	1.500 ft (18.00 in)	
D50	0.750 ft ( 9.00 in)	
D10	0.250 ft ( 3.00 in)	

## **Appendix 26.I**

North Pond Expansion Cell A2

---

Appendix 26.I

North Pond Expansion – Cell A2

Due to reformatting of the Navajo Mine PAP, the following references in this appendix have been changed, deleted or renumbered:

NM-0003C

Exhibit 29-IJ

Exhibit 29-IK

NM-0003D

Exhibit 11-24

Exhibit 11-49

NM-0003F Paper

Exhibit 11-13B

Exhibit 11-16

Exhibit 11-17

Exhibit 11-18

Exhibit 11-21

Exhibit 11-22

Exhibit 11-23

Exhibit 11-24

Exhibit 11-25

Exhibit 11-106

Exhibit 11-49A was removed

with REV 1012

NM-0003F Electronic

Exhibit 26-9

Exhibit 22-8

Exhibit 22-9 Sheet 1 of 2

Exhibit 22-9 Sheet 2 of 2

Exhibit 22-10

Exhibit 22-11

Exhibit 22-12

Exhibit 22-13

Exhibit 22-14

Exhibit 26-13

### **Cell A 2 Expansion Pond**

The cell A 2 expansion pond is adjacent to the presently existing ponds in the North pond system near 20071200N, 313500E. The North pond 1 system consists of four (4) distinct cells namely A, A 2, B, and C. These ponds are linked by overflow spillways protected by an oil skimmer located at the outlet from cell A. The ponds in conjunction with Pond 5 are designed to catch and contain all runoff from the north office, shop, and coal handling facility. At present, the capacity of these ponds when cells B and C are empty, contains the 100 - yr., 6-hour storm event. The addition of the cell A 2 pond provides an operating buffer of storm capacity for those times when the ponds are not empty.

Location of cell A 2 , as well as design and construction details can be seen on the accompanying maps and diagrams, see EXHIBIT 11-12 to 11-25. As-Builts for North Pond 1 (North Cells) can be found on EXHIBIT 11-49a and 11-106.

### **Design**

#### **The Pond**

The cell A 2 Pond provides approximately 5 additional acre feet of capacity, to the present total capacity of approximately 29 acre feet available in the Pond 1 system. The slope of the sides of the pond were constructed at least 3:1.

#### **The Spillway**

A level spillway at an elevation of 5329.5 feet allows water to flow between cells A and A2. The Spillway is lined with 6" of concrete. The spillway is 50' wide at the base with sides sloping up at 2:1.

#### **Operation Sequence**

The pond 1 drainage system is designed to deliver all runoff to cells A and A2. For this reason, cells A and A2 can be considered primary cells. Once either of these cells is filled to an elevation of 5329.5, it will overflow through the spillway into the other primary cell. Only when both cells are filled to an elevation of 5330 will water flow from cell A through the oil skimmer to cell B. Once cell B is filled to an elevation of 5330 ft. will water flow into cell C. Cell A 2 will be kept at an appropriate depth to allow for containment of the 100 - yr. 6 - hr. storm event, in conjunction with cells B and C.

---

Pumping Plan

Water and sediment levels are maintained at a level which will ensure that the designed capacity is available. Cleaning of the pond will be performed as needed. Water levels will be pumped to below design capacity within ten working days of a significant runoff event.

## **Appendix 26.J**

South Dixon Ponds 1, 2 & 3 Hydrology

Appendix 26.J

South Dixon Ponds 1, 2 & 3 Hydrology

Due to reformatting of the Navajo Mine PAP, the following references in this appendix have been changed, deleted or renumbered:

NM-0003F Paper

Exhibit 11-13 E

Exhibit 11-51C

Exhibit 11-51D

Exhibit 11-117A

NM-0003F Electronic

Exhibit 26-12

Exhibit 26-41

Exhibit 26-42

Exhibit 26-48

APPENDIX 26.J

South Dixon Ponds 1 to 3 Hydrology

TABLE OF CONTENTS

	pg.
South Dixon Pond 1	2
South Dixon Pond 2	16
South Dixon Pond 3	26

## **South Dixon Pond #1**

***The as-built is presented on Exhibit 11-51C. The location and watershed area are presented on Exhibit 11-13E. The SedCad model was updated on 11/20/08 by Shawn Smith to reflect current watershed. Structure 1 watershed increase from 287.23 to 285.19 acres. The watershed boundary was modified using actual surveys and aerial flight data.***

LR

Navajo Coal Company  
P.O. Box 1717  
Fruitland, NM 87414

Phone: (505) 598-3376  
Email: shawn.smith@bhpbilliton.com


***General Information***

***Storm Information:***

Storm Type:	Type II-70
Design Storm:	10 yr - 24 hr
Rainfall Depth:	1.600 inches

## Structure Networking:

Type	Stru #	(flows into)	Stru #	Musk. K (hrs)	Musk. X	Description
Channel	#1	==>	#3	0.000	0.000	NW Inlet
Channel	#2	==>	#3	0.000	0.000	SE Inlet
Pond	#3	==>	#4	0.000	0.000	South Dixon Pond 1
Channel	#4	==>	End	0.000	0.000	Spillway Outflow

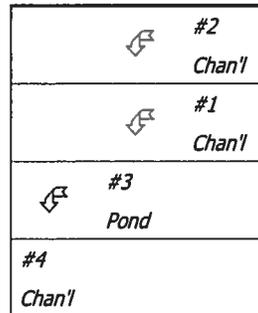

***Structure Summary:***

	Immediate Contributing Area (ac)	Total Contributing Area (ac)	Peak Discharge (cfs)	Total Runoff Volume (ac-ft)
#2	11.270	11.270	3.23	0.25
#1	285.190	285.190	70.01	6.38
#3 In	0.000	296.460	73.11	6.63
#3 Out			39.52	6.63
#4	0.000	296.460	39.52	6.63

***Subwatershed Hydrology Detail:***

Stru #	SWS #	SWS Area (ac)	Time of Conc (hrs)	Musk K (hrs)	Musk X	Curve Number	UHS	Peak Discharge (cfs)	Runoff Volume (ac-ft)
#2	1	11.270	0.333	0.000	0.000	80.000	M	3.23	0.253
<b>Σ</b>		<b>11.270</b>						<b>3.23</b>	<b>0.253</b>
#1	1	285.190	0.430	0.000	0.000	80.000	M	70.01	6.378
<b>Σ</b>		<b>285.190</b>						<b>70.01</b>	<b>6.378</b>
#3	1	0.000	0.000	0.000	0.000	1.000	0.00	0.000	
<b>Σ</b>		<b>296.460</b>						<b>73.11</b>	<b>6.631</b>
<b>#4</b>	<b>Σ</b>	<b>296.460</b>						<b>39.52</b>	<b>6.631</b>

***Subwatershed Time of Concentration Details:***

Stru #	SWS #	Land Flow Condition	Slope (%)	Vert. Dist. (ft)	Horiz. Dist. (ft)	Velocity (fps)	Time (hrs)
#1	1	5. Nearly bare and untilled, and alluvial valley fans	4.47	30.00	671.00	2.110	0.088
		8. Large gullies, diversions, and low flowing streams	2.23	123.00	5,517.00	4.470	0.342
<b>#1</b>	<b>1</b>	<b>Time of Concentration:</b>					<b>0.430</b>
#2	1	5. Nearly bare and untilled, and alluvial valley fans	3.03	58.00	1,913.00	1.740	0.305
		8. Large gullies, diversions, and low flowing streams	3.16	17.00	538.00	5.330	0.028
<b>#2</b>	<b>1</b>	<b>Time of Concentration:</b>					<b>0.333</b>

***General Information***

***Storm Information:***

Storm Type:	Type II-70
Design Storm:	25 yr - 6 hr
Rainfall Depth:	1.600 inches

***Structure Summary:***

	Immediate Contributing Area (ac)	Total Contributing Area (ac)	Peak Discharge (cfs)	Total Runoff Volume (ac-ft)
#2	11.270	11.270	4.35	0.25
#1	285.190	285.190	94.36	6.38
#3 In	0.000	296.460	98.51	6.63
Out	0.000		61.11	6.63
#4	0.000	296.460	61.11	6.63

### **Structure Detail:**

Structure #3 (Pond)

*South Dixon Pond 1*

Pond Inputs:

Initial Pool Elev:	5,246.90 ft
Initial Pool:	11.89 ac-ft

#### Emergency Spillway

Spillway Elev	Crest Length (ft)	Left Sideslope	Right Sideslope	Bottom Width (ft)
5,246.90	25.00	3.00:1	3.00:1	15.00

Pond Results:

Peak Elevation:	5,248.17 ft
Dewater Time:	0.26 days

*Dewatering time is calculated from peak stage to lowest spillway*

#### Elevation-Capacity-Discharge Table

Elevation	Area (ac)	Capacity (ac-ft)	Discharge (cfs)	Dewater Time (hrs)
5,237.00	0.777	0.000	0.000	
5,237.01	0.779	0.008	0.000	
5,238.00	1.006	0.889	0.000	
5,239.00	1.058	1.921	0.000	
5,240.00	1.107	3.003	0.000	
5,241.00	1.157	4.135	0.000	
5,242.00	1.207	5.317	0.000	
5,243.00	1.258	6.550	0.000	
5,244.00	1.311	7.834	0.000	
5,245.00	1.368	9.173	0.000	
5,246.00	1.430	10.572	0.000	
5,246.90	1.488	11.885	0.000	Spillway #1
5,247.00	1.495	12.035	3.988	3.30
5,248.00	1.555	13.560	43.833	2.70
5,248.17	1.557	13.823	61.111	0.30 Peak Stage
5,249.00	1.602	15.138	147.308	

#### Detailed Discharge Table

# SEDCAD 4 for Windows

Copyright 1998 - 2007 Pamela J. Schwab

Elevation (ft)	Emergency Spillway (cfs)	Combined Total Discharge (cfs)
5,237.00	0.000	0.000
5,237.01	0.000	0.000
5,238.00	0.000	0.000
5,239.00	0.000	0.000
5,240.00	0.000	0.000
5,241.00	0.000	0.000
5,242.00	0.000	0.000
5,243.00	0.000	0.000
5,244.00	0.000	0.000
5,245.00	0.000	0.000
5,246.00	0.000	0.000
5,246.90	0.000	0.000
5,247.00	3.988	3.988
5,248.00	43.833	43.833
5,249.00	147.308	147.308

**Structure Detail:**

Structure #4 (Riprap Channel)

*Spillway Outflow*

Trapezoidal Riprap Channel Inputs:

Material: Riprap

Bottom Width (ft)	Left Sideslope Ratio	Right Sideslope Ratio	Slope (%)	Freeboard Depth (ft)	Freeboard % of Depth	Freeboard Mult. x (VxD)
12.00	3.0:1	3.0:1	12.0	1.00		

Riprap Channel Results:

**Simons/OSM Method - Steep Slope Design**

	w/o Freeboard	w/ Freeboard
Design Discharge:	61.11 cfs	
Depth:	0.42 ft	1.42 ft
Top Width:	14.52 ft	20.52 ft
Velocity*:		
X-Section Area:	5.58 sq ft	
Hydraulic Radius:	0.380 ft	
Froude Number*:		
Manning's n*:		
Dmin:	3.00 in	
D50:	9.00 in	
Dmax:	11.25 in	

Velocity and Manning's n calculations may not apply for this method.

## ***General Information***

### ***Storm Information:***

Storm Type:	Type II-70
Design Storm:	10 yr - 6 hr
Rainfall Depth:	1.300 inches

***Structure Summary:***

	Immediate Contributing Area (ac)	Total Contributing Area (ac)	Peak Discharge (cfs)	Total Runoff Volume (ac-ft)
#2	11.270	11.270	2.43	0.15
#1	285.190	285.190	52.31	3.68
#3 In	0.000	296.460	54.70	3.83
Out			29.54	3.83
#4	0.000	296.460	29.54	3.83

***Structure Detail:***

***Structure #2 (Riprap Channel)***

***SE Inlet***

Trapezoidal Riprap Channel Inputs:

**Material: Riprap**

Bottom Width (ft)	Left Sideslope Ratio	Right Sideslope Ratio	Slope (%)	Freeboard Depth (ft)	Freeboard % of Depth	Freeboard Mult. x (VxD)
8.00	3.0:1	3.0:1	15.0	1.00		

Riprap Channel Results:

**Simons/OSM Method - Steep Slope Design**

	w/o Freeboard	w/ Freeboard
Design Discharge:	2.43 cfs	
Depth:	0.05 ft	1.05 ft
Top Width:	8.32 ft	14.32 ft
Velocity*:		
X-Section Area:	0.44 sq ft	
Hydraulic Radius:	0.052 ft	
Froude Number*:		
Manning's n*:		
Dmin:	2.00 in	
D50:	6.00 in	
Dmax:	7.50 in	

Velocity and Manning's n calculations may not apply for this method.

**Structure Detail:**

Structure #1 (Riprap Channel)

*NW Inlet*

Trapezoidal Riprap Channel Inputs:

Material: Riprap


Bottom Width (ft)	Left Sideslope Ratio	Right Sideslope Ratio	Slope (%)	Freeboard Depth (ft)	Freeboard % of Depth	Freeboard Mult. x (VxD)
8.00	3.0:1	3.0:1	15.0	1.00		

Riprap Channel Results:

**Simons/OSM Method - Steep Slope Design**

	w/o Freeboard	w/ Freeboard
Design Discharge:	52.31 cfs	
Depth:	0.44 ft	1.44 ft
Top Width:	10.66 ft	16.66 ft
Velocity*:		
X-Section Area:	4.14 sq ft	
Hydraulic Radius:	0.383 ft	
Froude Number*:		
Manning's n*:		
Dmin:	4.00 in	
D50:	12.00 in	
Dmax:	15.00 in	

Velocity and Manning's n calculations may not apply for this method.

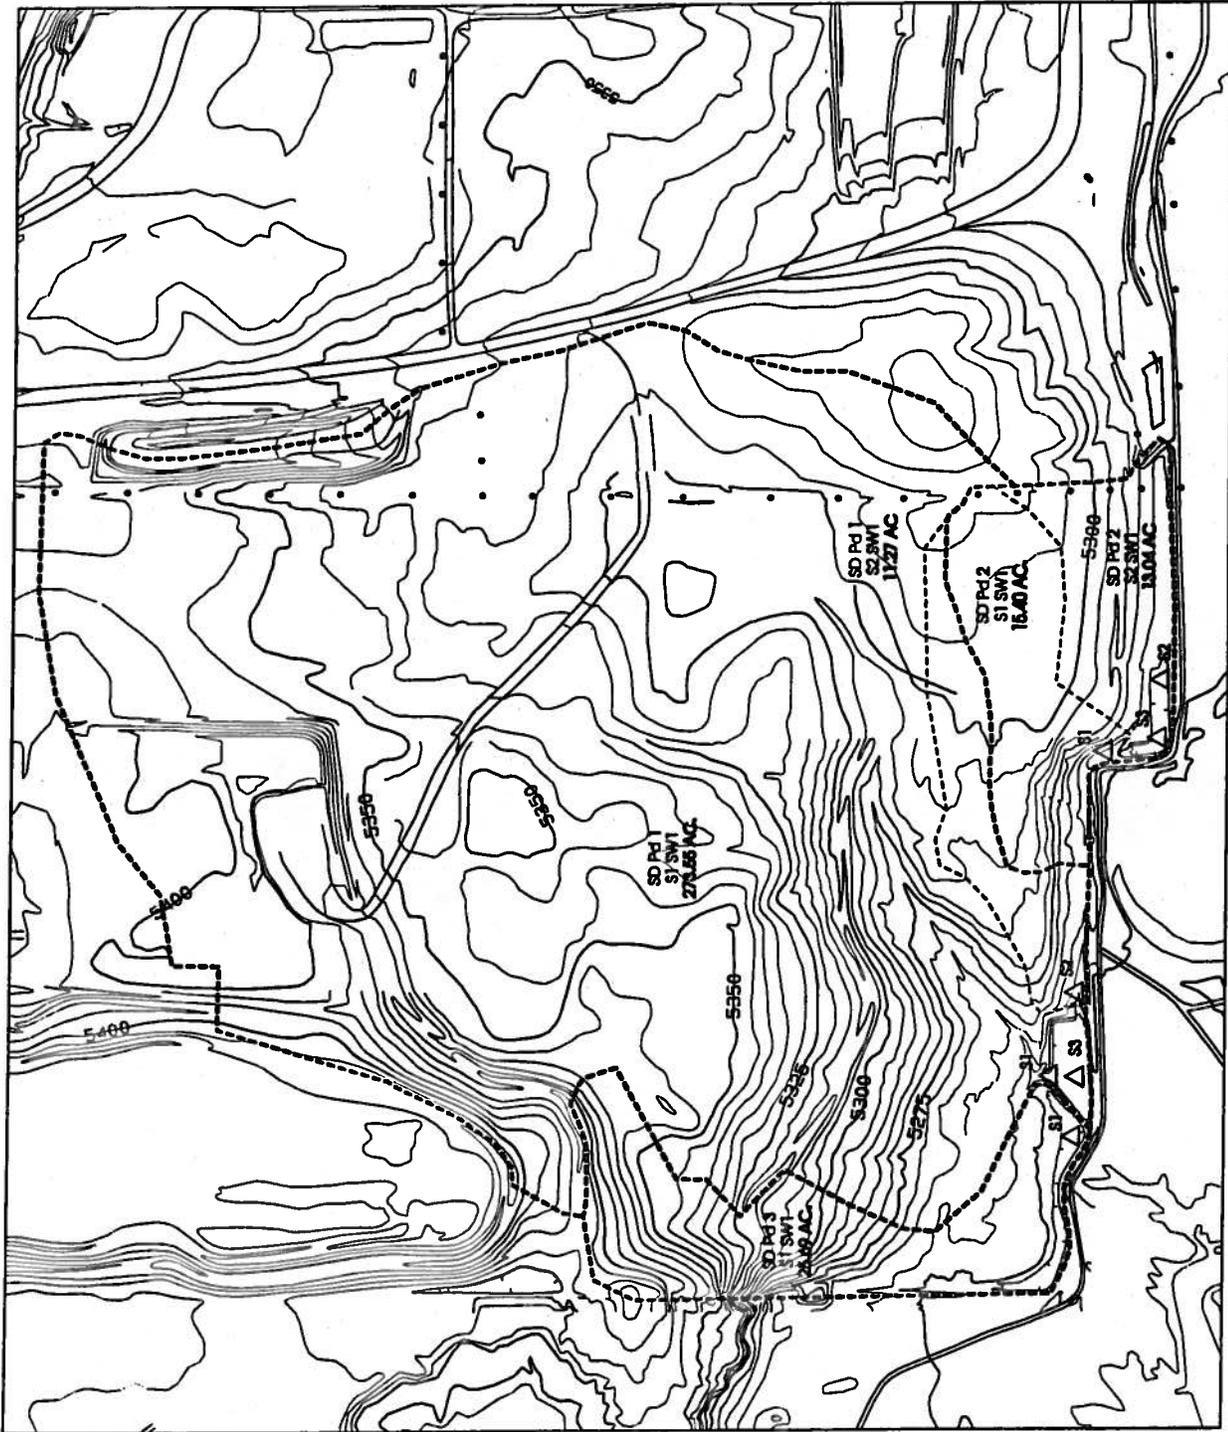

**SOUTH DIXON POND 1, 2 AND 3  
HYDROLOGY MODEL (11/2005)  
NTS**

## **South Dixon Pond 2** **Design Modification**

***The erosion of north bank of the Cottonwood Wash is encroaching onto the pond embankment. The embankment also functions as a roadway for residences west of the mine lease. To prevent possible breach of the embankment and enhance the safety of the road, a reach of the embankment was realigned. The design modification of the embankment is presented on Exhibit 11-117A. The location and watershed area are presented on Exhibit 11-13E. The hydrology model is presented on a 8 1/2 X 11 sheet attached.***

LR

BHP Navajo Coal Company  
PO Box 1717  
Fruitland, NM  
87416


***General Information***

***Storm Information:***

Storm Type:	Type II-60
Design Storm:	100 yr - 6 hr
Rainfall Depth:	2.000 inches

### *Structure Networking:*

Type	Stru #	(flows into)	Stru #	Musk. K (hrs)	Musk. X	Description
Channel	#1	==>	#3	0.000	0.000	NW Inlet
Channel	#2	==>	#3	0.000	0.000	East Inlet
Null	#3	==>	End	0.000	0.000	South Dixon Pd 2

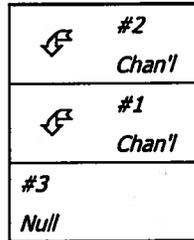

**Structure Summary:**

	Immediate Contributing Area (ac)	Total Contributing Area (ac)	Peak Discharge (cfs)	Total Runoff Volume (ac-ft)
#2	13.040	13.040	16.54	0.61
#1	15.400	15.400	9.85	0.72
#3	0.000	28.440	23.15	1.33

**Subwatershed Hydrology Detail:**

Stru #	SWS #	SWS Area (ac)	Time of Conc (hrs)	Musk K (hrs)	Musk X	Curve Number	UHS	Peak Discharge (cfs)	Runoff Volume (ac-ft)
#2	1	13.040	0.123	0.000	0.000	80.000	M	16.54	0.611
		<b>Σ</b>	<b>13.040</b>					<b>16.54</b>	<b>0.611</b>
#1	1	15.400	0.236	0.000	0.000	80.000	M	9.85	0.722
		<b>Σ</b>	<b>15.400</b>					<b>9.85</b>	<b>0.722</b>
#3	<b>Σ</b>	<b>28.440</b>						<b>23.15</b>	<b>1.333</b>

**Subwatershed Time of Concentration Details:**

Stru #	SWS #	Land Flow Condition	Slope (%)	Vert. Dist. (ft)	Horiz. Dist. (ft)	Velocity (fps)	Time (hrs)
#1	1	5. Nearly bare and untilled, and alluvial valley fans	3.08	42.00	1,362.00	1.750	0.216
		8. Large gullies, diversions, and low flowing streams	5.70	30.00	526.00	7.160	0.020
#1	1	<b>Time of Concentration:</b>					<b>0.236</b>
#2	1	5. Nearly bare and untilled, and alluvial valley fans	9.68	64.00	661.00	3.110	0.059
		8. Large gullies, diversions, and low flowing streams	1.75	16.00	916.00	3.960	0.064
#2	1	<b>Time of Concentration:</b>					<b>0.123</b>

## ***General Information***

### ***Storm Information:***

Storm Type:	Type II-60
Design Storm:	10 yr - 6 hr
Rainfall Depth:	1.300 inches

***Structure Summary:***

	Immediate Contributing Area (ac)	Total Contributing Area (ac)	Peak Discharge (cfs)	Total Runoff Volume (ac-ft)
#2	13.040	13.040	6.43	0.21
#1	15.400	15.400	3.22	0.25
#3	0.000	28.440	7.84	0.46

**Structure Detail:**

Structure #2 (Riprap Channel)

*East Inlet*

Trapezoidal Riprap Channel Inputs:

Material: Riprap

Bottom Width (ft)}	Left Sideslope Ratio	Right Sideslope Ratio	Slope (%)	Freeboard Depth (ft)	Freeboard % of Depth	Freeboard Mult. x (VxD)
6.00	2.0:1	2.0:1	14.0	1.00		

Riprap Channel Results:

Simons/OSM Method - Steep Slope Design

	w/o Freeboard	w/ Freeboard
Design Discharge:	6.43 cfs	
Depth:	0.11 ft	1.11 ft
Top Width:	6.43 ft	10.43 ft
Velocity*:		
X-Section Area:	0.66 sq ft	
Hydraulic Radius:	0.102	
Froude Number*:		
Manning's n*:		
Dmin:	2.00 in	
D50:	6.00 in	
Dmax:	7.50 in	

Velocity and Manning's n calculations may not apply for this method.

Structure #1 (Riprap Channel)

*NW Inlet*

Trapezoidal Riprap Channel Inputs:

Material: Riprap

Bottom Width (ft)}	Left Sideslope Ratio	Right Sideslope Ratio	Slope (%)	Freeboard Depth (ft)	Freeboard % of Depth	Freeboard Mult. x (VxD)
8.00	2.0:1	2.0:1	15.0	1.00		

Riprap Channel Results:


Simons/OSM Method - Steep Slope Design

	w/o Freeboard	w/ Freeboard
Design Discharge:	3.22 cfs	
Depth:	0.06 ft	1.06 ft
Top Width:	8.24 ft	12.24 ft
Velocity*:		
X-Section Area:	0.50 sq ft	
Hydraulic Radius:	0.060	
Froude Number*:		
Manning's n*:		
Dmin:	2.00 in	
D50:	6.00 in	
Dmax:	7.50 in	

Velocity and Manning's n calculations may not apply for this method.

Structure #3 (Null)

South Dixon Pd 2

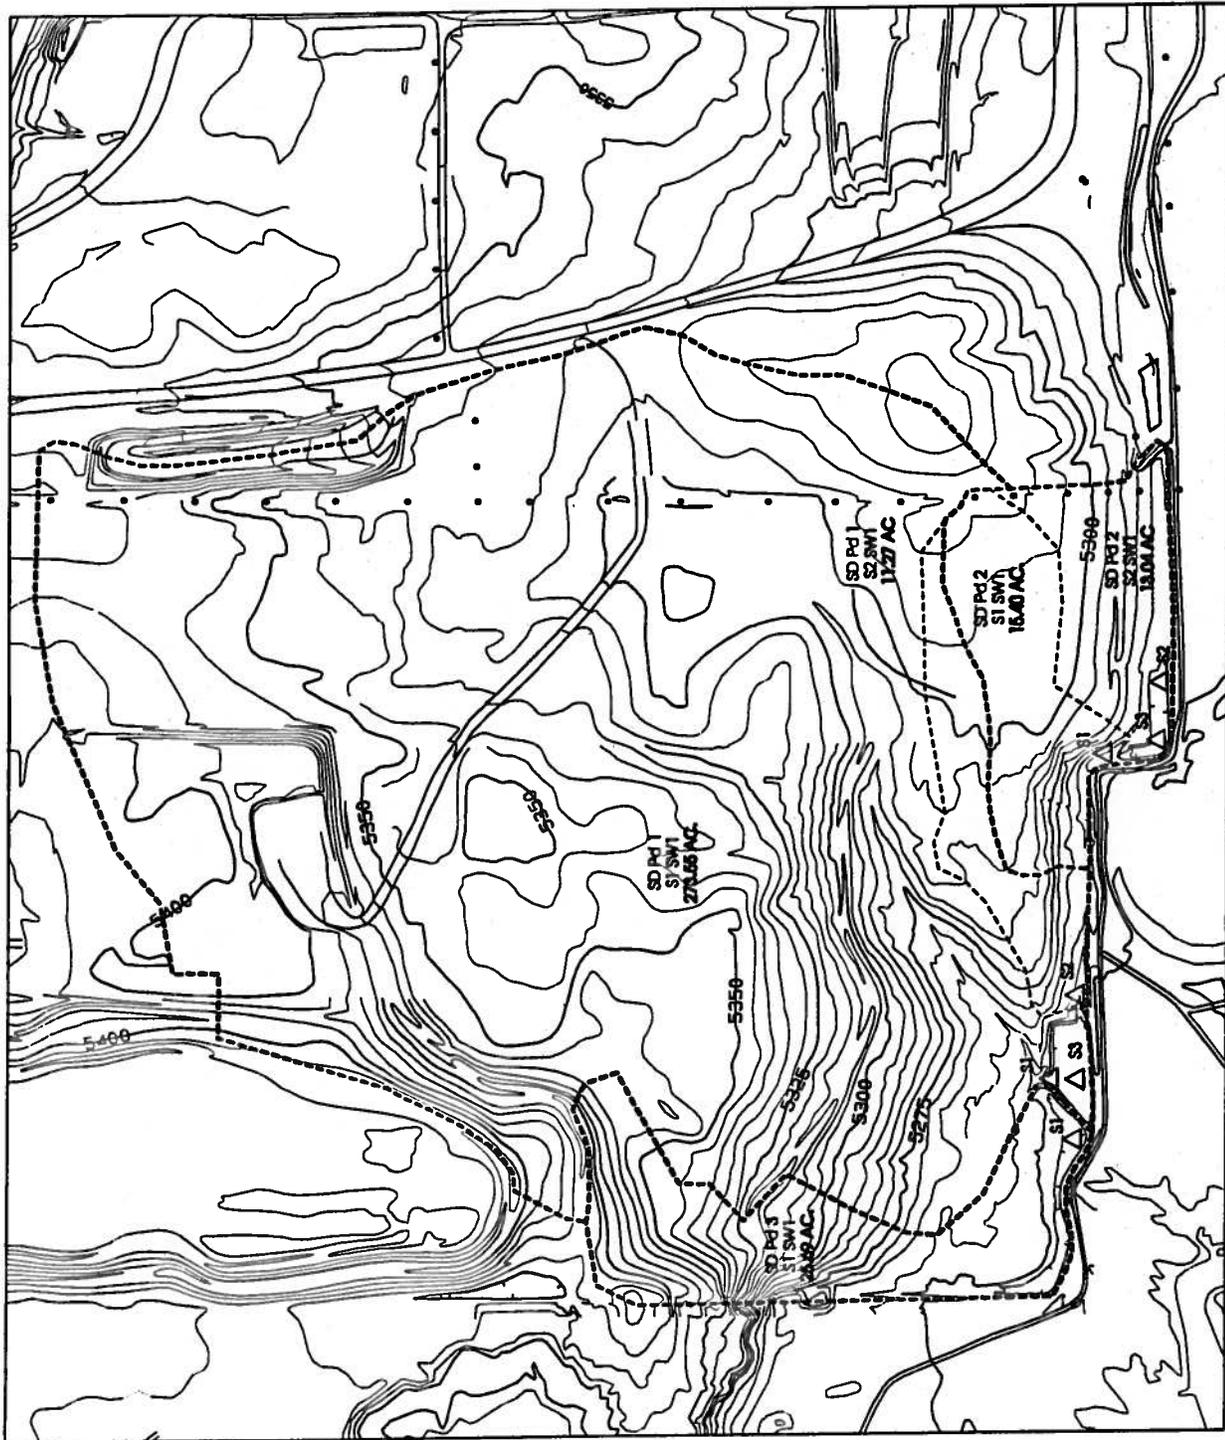

**SOUTH DIXON POND 1, 2 AND 3  
HYDROLOGY MODEL (11/2005)  
NTS**

## **South Dixon Pond 3**

***The as-built is presented on Exhibit 11-51D. The location and watershed area are presented on Exhibit 11-13E. The watershed boundary was modified using actual surveys and aerial flight data.***

LR

Navajo Coal Company  
P.O. Box 1717  
Fruitland, NM 87414

Phone: (505) 598-3376  
Email: shawn.smith@bhpbilliton.com

## ***General Information***

### ***Storm Information:***

Storm Type:	Type II-70
Design Storm:	100 yr - 6 hr
Rainfall Depth:	2.000 inches

***Structure Networking:***

Type	Stru #	(flows into)	Stru #	Musk. K (hrs)	Musk. X	Description
Null	#1	==>	End	0.000	0.000	South Dixon Pd 3

#1 Null
------------

***Structure Summary:***

	Immediate Contributing Area (ac)	Total Contributing Area (ac)	Peak Discharge (cfs)	Total Runoff Volume (ac-ft)
#1	28.180	28.180	22.60	1.05

***Subwatershed Hydrology Detail:***

Stru #	SWS #	SWS Area (ac)	Time of Conc (hrs)	Musk K (hrs)	Musk X	Curve Number	UHS	Peak Discharge (cfs)	Runoff Volume (ac-ft)
#1	1	28.180	0.204	0.000	0.000	80.000	M	22.60	1.055
<b>Σ</b>		<b>28.180</b>						<b>22.60</b>	<b>1.055</b>

***Subwatershed Time of Concentration Details:***

Stru #	SWS #	Land Flow Condition	Slope (%)	Vert. Dist. (ft)	Horiz. Dist. (ft)	Velocity (fps)	Time (hrs)
#1	1	5. Nearly bare and untilled, and alluvial valley fans	10.32	105.00	1,017.00	3.210	0.088
		8. Large gullies, diversions, and low flowing streams	1.86	32.00	1,719.00	4.090	0.116
<b>#1</b>	<b>1</b>	<b>Time of Concentration:</b>					<b>0.204</b>

**Appendix 26.K**

**Spur D Drainage/Sediment Control**

May 2004

---

Appendix 26.K  
Spur D Drainage/Sediment Control

Due to reformatting of the Navajo Mine PAP, the following references in this appendix have been changed, deleted or renumbered:

<u>NM-0003F Paper Permit</u>	<u>NM-0003F Electronic Permit</u>
Exhibit 11-53	Exhibit 26-83
Exhibit 11-14P	Exhibit in As-built
Exhibit 1-14T	Exhibit in As-built
Exhibit 11-14S	Exhibit in As-built

**NAVAJO MINE RAILROAD**  
**DRAINAGE/SEDIMENT CONTROL AT SPUR D**

The drainage and erosion control structures for the railroad at Spur D consist of a diversion berm on the east side and riprap lined channels on both the east and west side. The watershed subdivisions are presented on Exhibit 11-53. The location and details of the drainage control structures are presented on Exhibits 11-14P and 11-14T.

A diversion berm was constructed at the top of the slope that is directly east of culvert CP-16. The berm will divert the surface runoff from watershed "B1" into drop-structure "DS-484L" as presented on Exhibit 11-53 and 11-14P. The diversion berm will prevent formation of gullies and rills on the slope, thus reducing the sediment load to the downstream flow. The diversion berm is design for the peak discharge from the 10 year-24 hour storm event. Typical section of the diversion berm is shown on Exhibit 11-14S.

Drop-structures DS-481+50L, DS-484L, and DS-484R are design for the peak discharge from the 10 year-6 hour storm event. Refer to the schedule on Exhibit 11-14T for the channel dimensions and the riprap size placed.

# **Railroad Drainage/Sediment Control at Spur D - East Side**

***The watershed subdivisions are presented on Exhibit 11-53.  
The location and details of the drainage control structures are  
presented on Exhibits 11-14P and 11-14T.***

LR

BHP Navajo Coal Company  
Navajo Mine  
PO Box 1717  
Fruitland, NM 87415

Phone: 505-598-5861

***General Information***

***Storm Information:***


Storm Type:	NRCS Type II-60
Design Storm:	10 yr - 6 hr
Rainfall Depth:	1.300 inches

# SEDCAD 4 for Windows

Copyright 1998 Pamela J. Schwab  
Civil Software Design

## Structure Networking:

Type	Stru #	(flows into)	Stru #	Musk. K (hrs)	Musk. X	Description
Channel	#1	==>	#2	0.000	0.000	Diversion Berm
Channel	#2	==>	#4	0.000	0.000	Dropstructure DS-484L
Channel	#3	==>	#4	0.000	0.000	Dropstructure DS-481+50L
Channel	#4	==>	End	0.000	0.000	Dropstructure DS-484

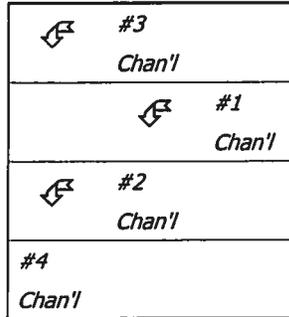

***Structure Summary:***

	Immediate Contributing Area (ac)	Total Contributing Area (ac)	Peak Discharge (cfs)	Total Runoff Volume (ac-ft)
#3	39.000	39.000	8.02	0.63
#1	104.000	104.000	19.45	1.68
#2	21.000	125.000	28.54	2.53
#4	0.000	164.000	36.39	3.16

***Structure Detail:***

**Structure #3 (Riprap Channel)**

*Dropstructure DS-481+50L*

Trapezoidal Riprap Channel Inputs:

Material: Riprap

Bottom Width (ft)}	Left Sideslope Ratio	Right Sideslope Ratio	Slope (%)	Freeboard Depth (ft)	Freeboard % of Depth	Freeboard Mult. x (VxD)
6.00	3.0:1	3.0:1	20.0	1.00		

Riprap Channel Results:

**Simons/OSM Method - Steep Slope Design**

	w/o Freeboard	w/ Freeboard
Design Discharge:	8.02 cfs	
Depth:	0.10 ft	1.10 ft
Top Width:	6.57 ft	12.57 ft
Velocity*:		
X-Section Area:	0.60 sq ft	
Hydraulic Radius:	0.091	
Froude Number*:		
Manning's n*:		
Dmin:	3.00 in	
D50:	9.00 in	
Dmax:	11.25 in	

Velocity and Manning's n calculations may not apply for this method.

**Structure #1 (Erodible Channel)**

*Diversion Berm*

Trapezoidal Erodible Channel Inputs:

Material: Ordinary firm loam

Bottom Width (ft)	Left Sideslope Ratio	Right Sideslope Ratio	Slope (%)	Manning's n	Freeboard Depth (ft)	Freeboard % of Depth	Freeboard Mult. x (VxD)	Limiting Velocity (fps)
4.00	6.0:1	2.0:1	1.0	0.0300	1.00			3.5

**Erodible Channel Results:**

	w/o Freeboard	w/ Freeboard
Design Discharge:	19.45 cfs	
Depth:	0.81 ft	1.81 ft
Top Width:	10.47 ft	18.47 ft
Velocity:	3.33 fps	
X-Section Area:	5.85 sq ft	
Hydraulic Radius:	0.548	
Froude Number:	0.78	

*Structure #2 (Riprap Channel)*

*Dropstructure DS-484L*

Trapezoidal Riprap Channel Inputs:

Material: Riprap

Bottom Width (ft)}	Left Sideslope Ratio	Right Sideslope Ratio	Slope (%)	Freeboard Depth (ft)	Freeboard % of Depth	Freeboard Mult. x (VxD)
10.00	3.0:1	3.0:1	9.0	1.00		

Riprap Channel Results:

**Simons/OSM Method - Steep Slope Design**

	w/o Freeboard	w/ Freeboard
Design Discharge:	28.54 cfs	
Depth:	0.28 ft	1.28 ft
Top Width:	11.70 ft	17.70 ft
Velocity*:		
X-Section Area:	3.07 sq ft	
Hydraulic Radius:	0.260	
Froude Number*:		
Manning's n*:		
Dmin:	2.00 in	
D50:	6.00 in	
Dmax:	7.50 in	

Velocity and Manning's n calculations may not apply for this method.

*Structure #4 (Riprap Channel)*

*Dropstructure DS-484*

# SEDCAD 4 for Windows

Copyright 1998 Pamela J. Schwab  
Civil Software Design

## Trapezoidal Riprap Channel Inputs:

### Material: Riprap

Bottom Width (ft)	Left Sideslope Ratio	Right Sideslope Ratio	Slope (%)	Freeboard Depth (ft)	Freeboard % of Depth	Freeboard Mult. x (VxD)
10.00	3.0:1	3.0:1	10.0	1.00		

## Riprap Channel Results:

### Simons/OSM Method - Steep Slope Design

	w/o Freeboard	w/ Freeboard
Design Discharge:	36.39 cfs	
Depth:	0.34 ft	1.34 ft
Top Width:	12.04 ft	18.04 ft
Velocity*:		
X-Section Area:	3.74 sq ft	
Hydraulic Radius:	0.308	
Froude Number*:		
Manning's n*:		
Dmin:	2.00 in	
D50:	6.00 in	
Dmax:	7.50 in	

Velocity and Manning's n calculations may not apply for this method.

***Subwatershed Hydrology Detail:***

Stru #	SWS #	SWS Area (ac)	Time of Conc (hrs)	Musk K (hrs)	Musk X	Curve Number	UHS	Peak Discharge (cfs)	Runoff Volume (ac-ft)
#3	1	39.000	0.244	0.000	0.000	80.000	M	8.02	0.630
	$\Sigma$	<b>39.000</b>						<b>8.02</b>	<b>0.630</b>
#1	1	104.000	0.292	0.000	0.000	80.000	M	19.45	1.681
	$\Sigma$	<b>104.000</b>						<b>19.45</b>	<b>1.681</b>
#2	1	21.000	0.409	0.000	0.000	89.000	M	9.10	0.847
	$\Sigma$	<b>125.000</b>						<b>28.54</b>	<b>2.528</b>
<b>#4</b>	$\Sigma$	<b>164.000</b>						<b>36.39</b>	<b>3.159</b>

***Subwatershed Time of Concentration Details:***

Stru #	SWS #	Land Flow Condition	Slope (%)	Vert. Dist. (ft)	Horiz. Dist. (ft)	Velocity (fps)	Time (hrs)
#1	1	5. Nearly bare and untilled, and alluvial valley fans	4.41	75.00	1,700.00	2.100	0.224
		8. Large gullies, diversions, and low flowing streams	3.57	50.00	1,400.00	5.660	0.068
<b>#1</b>	<b>1</b>	<b>Time of Concentration:</b>					<b>0.292</b>
#2	1	8. Large gullies, diversions, and low flowing streams	1.67	95.00	5,700.00	3.870	0.409
<b>#2</b>	<b>1</b>	<b>Time of Concentration:</b>					<b>0.409</b>
#3	1	5. Nearly bare and untilled, and alluvial valley fans	3.59	52.00	1,450.00	1.890	0.213
		8. Large gullies, diversions, and low flowing streams	4.29	30.00	700.00	6.210	0.031
<b>#3</b>	<b>1</b>	<b>Time of Concentration:</b>					<b>0.244</b>

# **Railroad Drainage/Sediment Control at Spur D - West Side**

***The watershed subdivisions are presented on Exhibit 11-53.  
The location and details of the drainage control structures are  
presented on Exhibits 11-14P and 11-14T.***

LR

BHP Navajo Coal Company  
Navajo Mine  
PO Box 1717  
Fruitland, NM 87415

Phone: 505-598-5861

***General Information***

***Storm Information:***

Storm Type:	NRCS Type II-60
Design Storm:	10 yr - 6 hr
Rainfall Depth:	1.300 inches

# SEDCAD 4 for Windows

Copyright 1998 Pamela J. Schwab  
Civil Software Design

## *Structure Networking:*

Type	Stru #	(flows into)	Stru #	Musk. K (hrs)	Musk. X	Description
Channel	#1	==>	End	0.000	0.000	Dropstructure DS-484R

#1  
Chan'

# SEDCAD 4 for Windows

Copyright 1998 Pamela J. Schwab  
Civil Software Design

---

## *Structure Summary:*

	Immediate Contributing Area (ac)	Total Contributing Area (ac)	Peak Discharge (cfs)	Total Runoff Volume (ac-ft)
#1	31.000	31.000	10.60	1.25

***Structure Detail:***

***Structure #1 (Riprap Channel)***

***Dropstructure DS-484R***

Trapezoidal Riprap Channel Inputs:

**Material: Riprap**

Bottom Width (ft)}	Left Sideslope Ratio	Right Sideslope Ratio	Slope (%)	Freeboard Depth (ft)	Freeboard % of Depth	Freeboard Mult. x (VxD)
3.00	3.0:1	3.0:1	7.0	1.00		

Riprap Channel Results:

**Simons/OSM Method - Steep Slope Design**

	w/o Freeboard	w/ Freeboard
Design Discharge:	10.60 cfs	
Depth:	0.30 ft	1.30 ft
Top Width:	4.82 ft	10.82 ft
Velocity*:		
X-Section Area:	1.19 sq ft	
Hydraulic Radius:	0.241	
Froude Number*:		
Manning's n*:		
Dmin:	3.00 in	
D50:	9.00 in	
Dmax:	11.25 in	

Velocity and Manning's n calculations may not apply for this method.

# SEDCAD 4 for Windows

Copyright 1998 Pamela J. Schwab  
Civil Software Design

## *Subwatershed Hydrology Detail:*

Stru #	SWS #	SWS Area (ac)	Time of Conc (hrs)	Musk K (hrs)	Musk X	Curve Number	UHS	Peak Discharge (cfs)	Runoff Volume (ac-ft)
#1	1	25.000	0.523	0.000	0.000	89.000	M	9.50	1.009
	2	6.000	0.058	0.000	0.000	89.000	M	6.11	0.242
	$\Sigma$	<b>31.000</b>						<b>10.60</b>	<b>1.251</b>

## *Subwatershed Time of Concentration Details:*

Stru #	SWS #	Land Flow Condition	Slope (%)	Vert. Dist. (ft)	Horiz. Dist. (ft)	Velocity (fps)	Time (hrs)
#1	1	8. Large gullies, diversions, and low flowing streams	1.36	90.00	6,600.00	3.500	0.523
<b>#1</b>	<b>1</b>	<b>Time of Concentration:</b>					<b>0.523</b>
#1	2	5. Nearly bare and untilled, and alluvial valley fans	20.00	30.00	150.00	4.470	0.009
		8. Large gullies, diversions, and low flowing streams	3.81	40.00	1,050.00	5.850	0.049
<b>#1</b>	<b>2</b>	<b>Time of Concentration:</b>					<b>0.058</b>

**Appendix 26.L**

Lowe Dixon Temporary Diversion  
Inlet Redesign SEDCAD Backup

October 1995

---

## TABLE OF CONTENTS

ITEMS DESCRIPTION	PAGE #
Discussion/ Background/ Redesign . . . . .	2
SEDCAD Output: "Lowe Diversion Watershed Analysis" . . . . .	5
* General Input Table, Storm #1 . . . . .	6
* Subwatershed/ Structure Input/ Output Table . . . . .	8
* Lowe Diversion Channel - Typical #1 . . . . .	10
* Lowe Diversion Channel - Typical #2. . . . .	12
* Lowe Diversion Channel - Typical #3. . . . .	14
* Lowe Diversion Channel - Typical #4. . . . .	16
* Lowe Diversion Channel - Typical #5. . . . .	18
* Lowe Diversion - Main Inlet . . . . .	20
* Lowe Diversion - Main Inlet Wing . . . . .	22
* Lowe Diversion - East Inlet @ Sta. 18+00 (Bottom Width 12.50 ft) . . . . .	24
* Lowe Diversion - East Inlet @ Sta. 18+00 (Bottom Width 6.25 ft) . . . . .	26
* Lowe Diversion - East Inlet @ Sta. 26+45 (Bottom Width 12.20 ft). . . . .	28
* Lowe Diversion - East Inlet @ Sta. 26+45 (Bottom Width 6.10 ft) . . . . .	30
* Lowe Diversion - East Inlet @ Sta. 39+64 (Bottom Width 10.80 ft). . . . .	32
* Lowe Diversion - East Inlet @ Sta. 39+64 (Bottom Width 5.40 ft). . . . .	34
* Lowe Diversion - East Inlet @ Sta. 64+00 (Bottom Width 16.50 ft). . . . .	36
* Lowe Diversion - East Inlet @ Sta. 64+00 (Bottom Width 8.25 ft). . . . .	38
+ * Lowe Diversion - East Inlet @ Sta. 26+45 (Bottom Width 9.30 ft). . . . .	40
+ * Lowe Diversion - East Inlet @ Sta. 64+00 (Bottom Width 5.0 ft). . . . .	42

+ - denotes new modified inlets for As-Builts.

## LOWE / DIXON TEMPORARY DIVERSION - INLET REDESIGN

### 1.0 LOCATION AND FUNCTION:

The Lowe / Dixon Temporary Diversion, is currently located on the eastern portion of the Lowe / Dixon lease boundary and was constructed in 1994 and 1995. The approved discussion in the NM-0003D PAP, CHAPTER 11, TABLE 11-9; and EXHIBIT's 11-68 through 11-72 contain the design criteria for the diversion. The structure was constructed as a means to divert water from entering the Lowe and Dixon Pits, as well as other mine areas.

### 2.0 BACKGROUND AND CONCERN:

During an inspection on September 14, 1995, by the Office of Surface Mining/Albuquerque Field Office (OSM/AFO), minor erosion was noted on all four of the inlets on the east side of the diversion (inlets 3 and 4 having the most erosion). A breach (south of inlet four) was also discovered in the berm which currently diverts water along the top edge of the diversion to inlet structure 4 and a natural drainage south of inlet structure four. The designs for inlets 1 through 4 were deemed to be inadequate and AFO requested that they be redesigned. Thus, a submittal containing corrective updates would be made to Navajo Mine's "Operation Plan" portion of the NM-0003D PAP pertaining to the diversion.

The areas of concern are the four inlets (drop structures) on the east side of the diversion and an area where an old road approaches the diversion (south of inlet four). Navajo Mine has evaluated the four inlets located on the east side of the diversion, based on the enclosed redesign criteria. These changes will not alter the function of the diversion or change the purpose of the drop structures.

### 3.0 UPGRADE DESIGNS (Surface Water Drainage and Corrective Action):

The current Lowe / Dixon Temporary Diversion water drainage was designed using a SCSII storm type. In our re-evaluation, a SCSII-65 storm type (the appropriate storm type) was utilized which increases the peak flows (cfs) contributing to the inlets and the diversion itself. The inlet slopes used to calculate the rip-rap size required was also under estimated. The proper slope to be used is the maximum encountered which is slightly higher in all cases. Using these new parameters in SEDCAD+ Version 3, the design rip-rap sizes changed for 3 of the inlets (inlets two through four).

- For inlet two the design rip-rap  $D_{50}$  went from 1.5" to 3.0", fortunately inlet two has been constructed with the appropriate sized rip-rap.
- Inlet three was constructed with the 1.5"  $D_{50}$  material on the upper portion and 6" - 9"  $D_{50}$  material on the lower portions. From the new SEDCAD the upper rip-rap should be increased from 1.5"  $D_{50}$  material to 6.0"  $D_{50}$  material (some of this has already been placed) and shows that the rip-rap placed on the lower portion is adequate.
- Inlet four has the same design problem as inlet three and has also already had some of the larger required material placed.

Inlets one and two, will have 3.0" rip-rap<sup>1</sup> added to the upper portions and any location containing rip-rap smaller than 3.0"  $D_{50}$  material will be upgraded with at least 3.0" or greater  $D_{50}$  material. Inlets three and four, will have 6.0" rip-rap<sup>1</sup> added to the upper portions and any location containing rip-rap smaller than 6.0"  $D_{50}$  material will be upgraded with at least 6.0" or greater  $D_{50}$  material.

Another factor that was addressed is how the flows enter the inlets. The inlets were designed and built to receive water from the top end, but currently the diversion berms are setup to route flows to the inlet structures causing a good portion of the designed capacity to enter the sides of the inlets. Entry points were evaluated and will require larger rip-rap and its placement made to suit field conditions. Another measure to control the flows will be to add short diversion berms parallel to the inlets along the upper portions of the inlets, this will route all incoming flows to properly rip-rapped receiving points (this berm material, a relatively small quantity will come directly from the diversion site). Updated EXHIBIT 11-72B attached to this submittal, provides the new hydrologic parameters, rip-rap sizes, and design drawings of alteration on inlets one through four. New APPENDIX 11-W contains the backup calculations for the alterations.

---

<sup>1</sup> Rip-rap for remaining changes will come from one of two locations. Either from existing acceptable sources for rip-rap on the mine; or from off-site sources such as ARCO (an aggregate sales company).

In order to address the site where the old road meets the safety berm (previously breached), the berm size will be increased, and the catch drain on the east side of the berm will be re-cut so that flows from the road will drain north towards inlet four, and south towards natural drainage.

For the integrity of the diversion itself, there were no problems seen, and is currently capable of accommodating even higher design flows. The approved reclamation measures outlined in CHAPTER 12 of the PAP, Section 12.3.5, "Reclamation of Diversion Structures", will still apply. As a result of the re-evaluation, the only change that needs to be addressed for the diversion are current NM-0003D, CHAPTER 11 items: text page 11-71 (TABLE 11-9) and page 11-76a; plus EXHIBIT's 11-72A and 11-72B. It should be noted that design revisions per AFO's immediate corrective action request have been added to the current "As-Built" maps included with this letter.

CIVIL SOFTWARE DESIGN

SEDCAD+ Version 3

LOWE DIVERSION WATERSHED ANALYSIS

by

Name: DJR

Company Name: BHP MINERALS  
File Name: C:\SEDCAD3\LOWDV\_DR

Date: 10-01-1995

Company Name: BHP MINERALS  
 Filename: C:\SEDCAD3\LOWDV\_DR User: DJR  
 Date: 10-01-1995 Time: 14:51:34  
 LOWE DIVERSION WATERSHED ANALYSIS  
 Storm: 1.30 inches, 10 year- 6 hour, type II-65  
 Hydrograph Convolution Interval: 0.1 hr

=====  
 GENERAL INPUT TABLE  
 =====

STORM #1:

User-Defined Distribution

Label: type II-65

	Accumulated Time (hrs)	Accumulated Dimensionless Depth
1	0.0	0.000
2	0.5	0.006
3	1.0	0.012
4	1.5	0.019
5	2.0	0.026
6	2.5	0.034
7	3.0	0.043
8	3.5	0.055
9	4.0	0.067
10	4.5	0.083
11	5.0	0.105
12	5.5	0.139
13	6.0	0.711
14	6.5	0.789
15	7.0	0.819
16	7.5	0.837
17	8.0	0.851
18	8.5	0.861
19	9.0	0.872
20	9.5	0.880
21	10.0	0.888
22	10.5	0.894
23	11.0	0.900
24	11.5	0.905
25	12.0	0.910
26	12.5	0.915
27	13.0	0.920
28	13.5	0.925
29	14.0	0.930
30	14.5	0.934
31	15.0	0.938
32	15.5	0.943
33	16.0	0.947
34	16.5	0.951
35	17.0	0.954
36	17.5	0.958
37	18.0	0.962

38	18.5	0.966
39	19.0	0.969
40	19.5	0.973
41	20.0	0.976
42	20.5	0.979
43	21.0	0.982
44	21.5	0.985
45	22.0	0.988
46	22.5	0.991
47	23.0	0.994
48	23.5	0.997
49	24.0	1.000

\*\*\*\*\*

Company Name: BHP MINERALS  
 Filename: C:\SEDCAD3\LOWDV\_DR User: DJR  
 Date: 10-01-1995 Time: 14:51:34  
 LOWE DIVERSION WATERSHED ANALYSIS  
 Storm: 1.30 inches, 10 year- 6 hour, type II-65  
 Hydrograph Convolution Interval: 0.1 hr

=====

SUBWATERSHED/STRUCTURE INPUT/OUTPUT TABLE

=====

-Hydrology-

JBS	SWS	Area (ac)	CN	UHS	Tc (hrs)	K (hrs)	X	Base- Flow (cfs)	Runoff Volume (ac-ft)	Peak Discharge (cfs)
111	1	131.20	80	M	0.470	1.251	0.273	0.0	2.12	22.59
111	2	49.20	83	M	0.560	1.251	0.273	0.0	1.11	11.01
111	3	94.90	88	M	0.310	1.038	0.254	0.0	3.49	51.45
111	4	86.90	89	M	0.330	0.925	0.252	0.0	3.51	50.14
111	5	53.30	89	M	0.190	1.038	0.254	0.0	2.15	39.20
111	6	77.30	89	M	0.350	0.739	0.230	0.0	3.12	43.33
111	7	72.40	89	M	0.300	0.739	0.230	0.0	2.92	43.73
111	8	102.30	80	M	0.300	0.557	0.170	0.0	1.65	23.08
Type: Null					Label: Main Inlet					
111	Structure	667.50							20.07	
111	Total IN/OUT	667.50							20.07	166.29
112	1	116.20	84	M	0.570	0.764	0.221	0.0	2.90	28.88
112	2	68.10	88	M	0.460	0.249	0.267	0.0	2.50	29.82
Type: Null					Label: Main Inlet Wing					
112	Structure	184.30							25.47	
112	Total IN/OUT	851.80							25.47	202.05
111 to 112 Routing					0.000	0.000				
121	1	76.80	79	M	0.350	0.000	0.000	0.0	1.10	13.85
Type: Null					Label: Inlet @ 17+50					
121	Structure	76.80							1.10	
121	Total IN/OUT	76.80							1.10	13.85
211	1	66.70	80	M	0.350	0.000	0.000	0.0	1.08	13.77
Type: Null					Label: Inlet @ 27+30					
211	Structure	66.70							27.65	
211	Total IN/OUT	995.30							27.65	193.32
112 to 211 Routing					0.390	0.146				
1		87.20	80	M	0.310	0.000	0.000	0.0	1.41	19.30
Type: Null					Label: Inlet @ 40+10					
212	Structure	87.20							29.06	

212 Total IN/OUT	1082.50							29.06	183.50
=====									
211 to 212 Routing				0.510	0.146				
=====									
1	262.10	80	M	0.600	0.000	0.000	0.0	4.24	38.48
	Type: Null		Label: Inlet @ 62+00						
213 Structure	262.10							33.30	
-----									
213 Total IN/OUT	1344.60							33.30	173.29
=====									
212 to 213 Routing				0.870	0.146				
=====									

SEDCAD+ ERODIBLE CHANNEL DESIGN

LOWE DIVERSION CHANNEL - TYPICAL #1

Limiting Velocity Technique  
Sediment-laden Water


INPUT VALUES:

Shape	TRAPEZOIDAL	
Discharge	202.05 cfs	
Slope	0.30 %	
Sideslopes	2.30:1 (L)	2.50:1 (R)
Bottom Width	80.20 ft	
Manning's n	0.025	
Max. Velocity	5.00 fps	
Material		
Freeboard	1 ft	

RESULTS:

Actual Discharge	202.05 cfs
Depth	0.85 ft
with Freeboard	1.85 ft
Top Width	84.29 ft
with Freeboard	89.09 ft
Velocity	2.88 fps
Cross Sectional Area	70.15 sq ft
Hydraulic Radius	0.83 ft
Froude Number	0.56


SEDCAD+ CHANNEL DESIGN  
 LOWE DIVERSION CHANNEL - TYPICAL #1

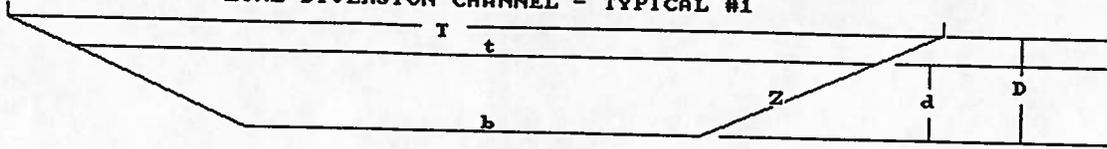

Limiting Variable: MATERIAL: Velocity = 5.000 fps  
 Sediment-laden Water

Discharge	==	202.05	cfs	Depth (d)	==	0.85	ft	Freeboard:	
Bottom (b)	==	2.80	ft	Top width (t)	==	84.25	ft	1.85	ft
Side Slopes (Z)	==	2.5:1	(R)	Velocity	==	5.000	fps	89.09	ft
Bed Slope	==	0.25	%	Hydraulic Radius	==	0.500	ft		
Manning's n	==	0.025		Froude number	==	0.500			

SEDCAD+ CHANNEL DESIGN  
 LOWE DIVERSION CHANNEL - TYPICAL #2

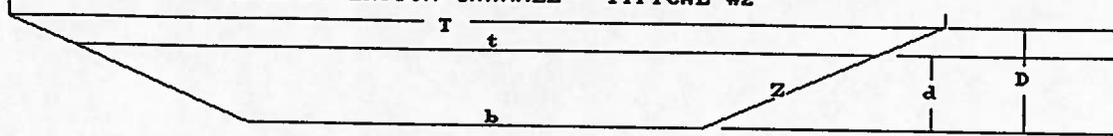

MATERIAL:  
 Limiting Variable: Velocity = 5.000 fps  
 Sediment-laden Water

Discharge	==	202.95	cfs	Depth (d)	==	2.14	ft	Freeboard:	
Bottom (b)	==	2.14	ft	Top width (t)	==	26.02	ft	3.14	ft
Side slopes (Z)	==	2.5:1	(L)	Velocity	==	4.96	ft/s	31.62	ft
Bed Slope	==	0.025	%	Hydraulic Radius	==	1.62	ft		
Manning's n	==	0.025		Froude number	==	0.62			

SEDCAD+ RIPRAP CHANNEL DESIGN

LOWE DIVERSION CHANNEL - TYPICAL #3

INPUT VALUES:


Shape	TRAPEZOIDAL	
Discharge	173.29 cfs	
Slope	0.30 %	
Sideslopes (L and R)	2.40:1	2.80:1
Bottom Width	15.50 feet	
Freeboard	1 ft	

RESULTS:

Mild Slope Design

Depth	2.44 ft
with Freeboard	3.44 ft
Top Width	28.20 ft
with Freeboard	33.40 ft
Velocity	3.25 fps
Cross Sectional Area	53.37 sq ft
Hydraulic Radius	1.83 ft
Manning's n	0.038
Froude Number	0.42
Dmax	1.500 ft (18.00 in)
D50	0.750 ft ( 9.00 in)
D10	0.250 ft ( 3.00 in)

SEDCAD+ CHANNEL DESIGN  
 LOWE DIVERSION CHANNEL - TYPICAL #3

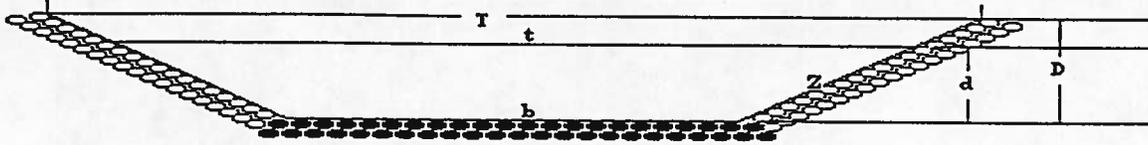

Riprap - Mild Slope Design

Discharge	==	173.29	cfs	Depth (d)	==	2.44	(D/	Freeboard:
Bottom (b)	==	15.50	ft	Top width (t)	==	28.20	(T/	33.44) ft
Side slopes (Z)	==	2.4:1(L)	2.8:1(R)	Velocity	==	3.25	ft	
Bed slope	==	0.30	%	Hydraulic Radius	==	1.83	ft	
Manning's n	==	0.038		Froude number	==	0.42		
		D <sub>max</sub>	==	1.50	ft	(18.00	in)	
		D <sub>50</sub>	==	0.75	ft	(9.00	in)	
		D <sub>10</sub>	==	0.25	ft	(3.00	in)	

SEDCAD+ RIPRAP CHANNEL DESIGN

LOWE DIVERSION CHANNEL - TYPICAL #4

INPUT VALUES:


Shape	TRAPEZOIDAL	
Discharge	173.29 cfs	
Slope	6.00 %	
Sideslopes (L and R)	1.50:1	1.20:1
Bottom Width	11.10 feet	
Freeboard	1 ft	

RESULTS:

Steep Slope Design - PADER Method

Depth	1.46 ft	
with Freeboard	2.46 ft	
Top Width	15.03 ft	
with Freeboard	17.73 ft	
Velocity	9.11 fps	
Cross Sectional Area	19.03 sq ft	
Hydraulic Radius	1.19 ft	
Manning's n	0.045	
Froude Number	1.43	
Dmax	0.938 ft (11.25 in)	
D50	0.750 ft ( 9.00 in)	
D10	0.250 ft ( 3.00 in)	

SEDCAD+ CHANNEL DESIGN  
 LOWE DIVERSION CHANNEL - TYPICAL #4

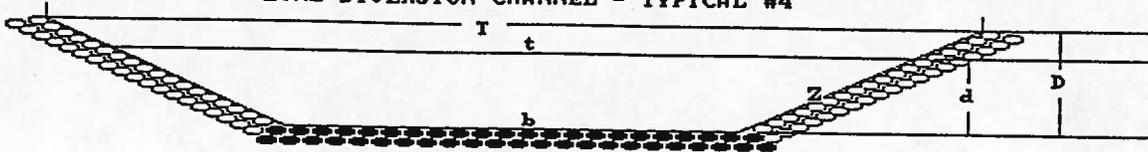

Riprap - Steep Slope Design - PADER Method

Discharge	==	173.29	cfs	Depth (d)	==	1.46	ft	Freeboard:	
Bottom (b)	==	11.16	ft	Top width (t)	==	15.03	ft	(D)	2.46
Side slopes (Z)	==	1.5:1(L)	1.2:1(R)	Velocity	==	9.11	ft/s	(T)	17.73
Bed Slope	==	0.00	%	Hydraulic Radius	==	1.19	ft	(T)	
Manning's n	==	0.045		Froude number	==	1.43		(T)	
		D <sub>max</sub>	==	0.9	ft	(11.25	in)		
		D <sub>50</sub>	==	0.304	ft	(9.00	in)		
		D <sub>10</sub>	==	0.204	ft	(3.00	in)		

SEDCAD+ RIPRAP CHANNEL DESIGN

LOWE DIVERSION CHANNEL - TYPICAL #5

INPUT VALUES:


Shape	TRAPEZOIDAL	
Discharge	173.29 cfs	
Slope	2.20 %	
Sideslopes (L and R)	2.50:1	3.60:1
Bottom Width	14.90 feet	
Freeboard	1 ft	

RESULTS:

Steep Slope Design - PADER Method

Depth	1.38 ft
with Freeboard	2.38 ft
Top Width	23.31 ft
with Freeboard	29.41 ft
Velocity	6.58 fps
Cross Sectional Area	26.34 sq ft
Hydraulic Radius	1.11 ft
Manning's n	0.036
Froude Number	1.09
Dmax	0.625 ft ( 7.50 in)
D50	0.500 ft ( 6.00 in)
D10	0.167 ft ( 2.00 in)

SEDCAD+ CHANNEL DESIGN  
 LOWE DIVERSION CHANNEL - TYPICAL #5

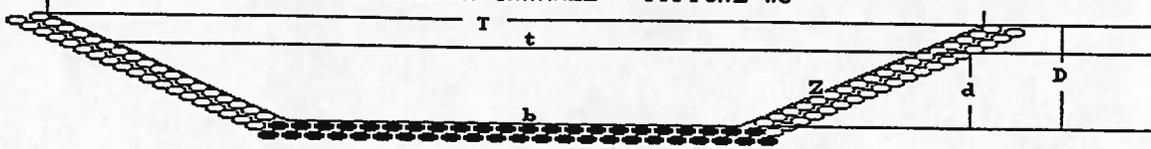

Riprap - Steep Slope Design - PADER Method

Discharge	==	173.29	cf/s	Depth (d)	==	1.38	(D/	Freeboard:
Bottom (b)	==	14.90	ft	Top width (t)	==	23.31	(D/	2.38) ft
Side slopes (Z)	==	2.5:1(L)	3.6:1(R)	Velocity	==	6.58	ft/s	29.41) ft
Bed Slope	==	2.20%		Hydraulic Radius	==	1.11	ft	
Manning's n	==	0.036		Froude number	==	1.09		
		Dmax	==	0.63	ft	(	7.50	in)
		D50	==	0.50	ft	(	6.00	in)
		D10	==	0.17	ft	(	2.00	in)

SEDCAD+ ERODIBLE CHANNEL DESIGN

LOWE DIVERSION CHANNEL - TYPICAL #2

Limiting Velocity Technique  
Sediment-laden Water

INPUT VALUES:

Shape	TRAPEZOIDAL	
Discharge	202.05 cfs	
Slope	0.30 %	
Sideslopes	2.50:1 (L)	2.50:1 (R)
Bottom Width	15.30 ft	
Manning's n	0.025	
Max. Velocity	5.00 fps	
Material		
Freeboard	1 ft	

RESULTS:

Actual Discharge	202.05 cfs
Depth	2.14 ft
with Freeboard	3.14 ft
Top Width	26.02 ft
with Freeboard	31.02 ft
Velocity	4.56 fps
Cross Sectional Area	44.32 sq ft
Hydraulic Radius	1.65 ft
Froude Number	0.62

SEDCAD+ RIPRAP CHANNEL DESIGN

-----  
LOWE DIVERSION - MAIN INLET

INPUT VALUES:


Shape	TRAPEZOIDAL	
Discharge	166.29 cfs	
Slope	0.30 %	
Sideslopes (L and R)	2.50:1	2.50:1
Bottom Width	15.00 feet	
Freeboard	1 ft	

RESULTS:

Mild Slope Design

Depth	2.43 ft	
with Freeboard	3.43 ft	
Top Width	27.17 ft	
with Freeboard	32.17 ft	
Velocity	3.24 fps	
Cross Sectional Area	51.34 sq ft	
Hydraulic Radius	1.83 ft	
Manning's n	0.038	
Froude Number	0.42	
Dmax	1.500 ft (18.00 in)	
D50	0.750 ft ( 9.00 in)	
D10	0.250 ft ( 3.00 in)	

SEDCAD+ CHANNEL DESIGN  
LOWE DIVERSION - MAIN INLET

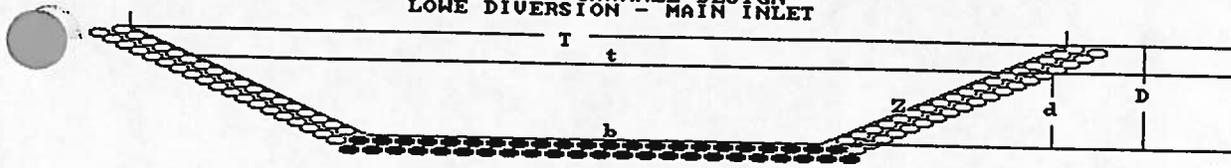

Riprap - Mild Slope Design

Discharge	== 166.29 cfs	Depth (d)	== 27.43 (ft)	Freeboard:	
Bottom (b)	== 15.50 ft	Top width (t)	== 27.17 (ft)	3.00 (ft)	
Side slopes (Z)	== 2.5:1(L) 2.5:1(R)	Velocity	== 3.24 (ft/s)	2.17 (ft)	
Bed Slope	== 0.38 %	Hydraulic Radius	== 1.83 (ft)		
Manning's n	== 0.038	Froude number	== 0.42		
	Dmax == 1.50 ft	(18.00 in)			
	D50 == 0.25 ft	(9.00 in)			
	D10 == 0.15 ft	(3.00 in)			

SEDCAD+ RIPRAP CHANNEL DESIGN

LOWE DIVERSION - MAIN INLET WING

INPUT VALUES:


Shape	TRAPEZOIDAL	
Discharge	35.76 cfs	
Slope	0.30 %	
Sideslopes (L and R)	2.50:1	5.00:1
Bottom Width	12.00 feet	
Freeboard	1 ft	

RESULTS:

Mild Slope Design

Depth	1.12 ft	
with Freeboard	2.12 ft	
Top Width	20.37 ft	
with Freeboard	27.87 ft	
Velocity	1.98 fps	
Cross Sectional Area	18.05 sq ft	
Hydraulic Radius	0.87 ft	
Manning's n	0.038	
Froude Number	0.37	
Dmax	1.500 ft (18.00 in)	
D50	0.750 ft ( 9.00 in)	
D10	0.250 ft ( 3.00 in)	

SEDCAD+ CHANNEL DESIGN  
 LOWE DIVERSION - MAIN INLET WING

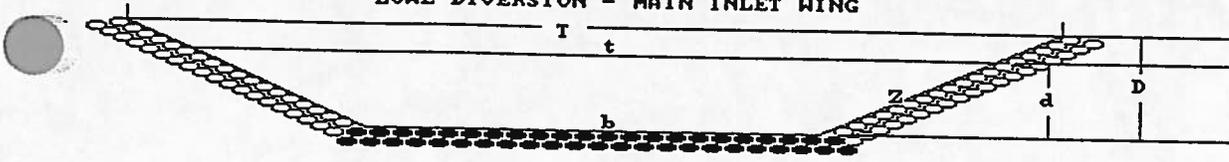

Riprap - Mild Slope Design

Discharge	35.76	cfs	Depth (d)	20.12	ft	Freeboard	2.80	ft
Bottom (b)	155.60	ft	Top width (t)	20.37	ft	Freeboard	2.80	ft
Side slopes (Z)	2.5:1(L)	5.0:1(R)	Velocity	0.638	ft/s	Freeboard	2.80	ft
Bed Slope	0.30	%	Hydraulic Radius	0.638	ft	Freeboard	2.80	ft
Manning's n	0.038		Froude number	0.37		Freeboard	2.80	ft
	D <sub>max</sub>	1.50	ft					
	D <sub>50</sub>	0.75	ft					
	D <sub>10</sub>	0.30	ft					

SEDCAD+ RIPRAP CHANNEL DESIGN

LOWE DIVERSION EAST INLET @ STA 18+00

INPUT VALUES:


Shape	TRAPEZOIDAL	
Discharge	13.85 cfs	
Slope	20.75 %	
Sideslopes (L and R)	2.00:1	2.00:1
Bottom Width	12.50 feet	
Freeboard	1 ft	

RESULTS:

Steep Slope Design - PADER Method

Depth	0.24 ft	
with Freeboard	1.24 ft	
Top Width	13.45 ft	
with Freeboard	17.45 ft	
Velocity	4.51 fps	
Cross Sectional Area	3.07 sq ft	
Hydraulic Radius	0.23 ft	
Manning's n	0.056	
Froude Number	1.66	
Dmax	0.313 ft ( 3.75 in)	
D50	0.250 ft ( 3.00 in)	
D10	0.083 ft ( 1.00 in)	

SEDCAD+ CHANNEL DESIGN  
 LOWE DIVERSION EAST INLET @ STA 18+00

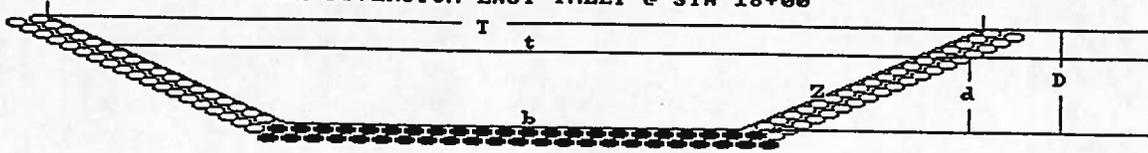

Riprap - Steep Slope Design - PADER Method

Discharge	==	13.08	cfs	Depth (d)	==	0.24	(ft)	Freeboard:	
Bottom (b)	==	1.22	ft	Top width (t)	==	13.45	(ft)	1.24	ft
Side slopes (Z)	==	2.00	1(R)	Velocity	==	4.51	ft/s	17.45	ft
Bed slope	==	0.00	1.00	Hydraulic Radius	==	0.23	ft		
Manning's n	==	0.06		Froude number	==	1.66			
				D <sub>max</sub>	==	0.31	ft ( 3.75 in)		
				D <sub>50</sub>	==	0.25	ft ( 3.00 in)		
				D <sub>10</sub>	==	0.08	ft ( 1.00 in)		

SEDCAD+ RIPRAP CHANNEL DESIGN

LOWE DIVERSION EAST INLET @ STA 18+00

INPUT VALUES:


Shape	TRAPEZOIDAL	
Discharge	13.85 cfs	
Slope	20.75 %	
Sideslopes (L and R)	2.00:1	2.00:1
Bottom Width	6.25 feet	
Freeboard	1 ft	

RESULTS:

Steep Slope Design - PADER Method

Depth	0.34 ft
with Freeboard	1.34 ft
Top Width	7.59 ft
with Freeboard	11.59 ft
Velocity	5.96 fps
Cross Sectional Area	2.32 sq ft
Hydraulic Radius	0.30 ft
Manning's n	0.051
Froude Number	1.90
Dmax	0.313 ft ( 3.75 in)
D50	0.250 ft ( 3.00 in)
D10	0.083 ft ( 1.00 in)

SEDCAD+ CHANNEL DESIGN  
 LOWE DIVERSION EAST INLET @ STA 18+00

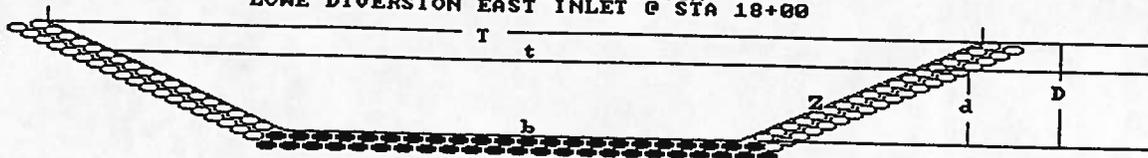

Riprap - Steep Slope Design - PADER Method

Discharge		13	cf/s	Depth (d)		0.3	ft	Freeboard:	
Bottom (b)		2	ft	Top width (t)		0.0004	ft	1.34	ft
Side slopes (Z)		2	ft	Velocity		0.0004	ft	11.59	ft
Bed Slope			2.0:1(R)	Hydraulic Radius		1.0006	ft		
Manning's n				Froude number		0.0006	ft		
		D <sub>max</sub>		0.0001	ft				
		D <sub>50</sub>		0.0001	ft				
		D <sub>10</sub>		0.0001	ft				

SEDCAD+ RIPRAP CHANNEL DESIGN

LOWE DIVERSION EAST INLET @ STA 24+45

INPUT VALUES:


Shape	TRAPEZOIDAL	
Discharge	13.77 cfs	
Slope	21.45 %	
Sideslopes (L and R)	2.00:1	2.00:1
Bottom Width	12.20 feet	
Freeboard	1 ft	

RESULTS:

Steep Slope Design - PADER Method

Depth	0.24 ft
with Freeboard	1.24 ft
Top Width	13.16 ft
with Freeboard	17.16 ft
Velocity	4.53 fps
Cross Sectional Area	3.04 sq ft
Hydraulic Radius	0.23 ft
Manning's n	0.057
Froude Number	1.66
Dmax	0.313 ft ( 3.75 in)
D50	0.250 ft ( 3.00 in)
D10	0.083 ft ( 1.00 in)

SEDCAD+ CHANNEL DESIGN  
 LOWE DIVERSION EAST INLET @ STA 24+45

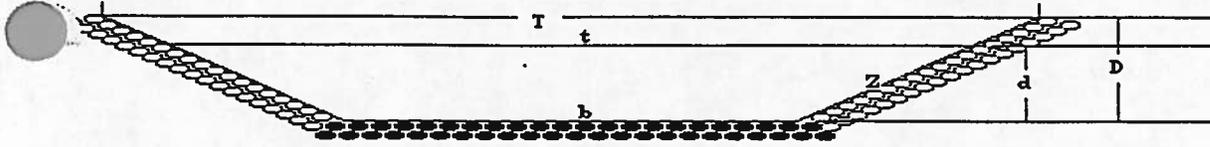

Riprap - Steep Slope Design - PADER Method

Discharge	==	13.77 cfs	Depth (d)	==	0.24 (D)	Freeboard:
Bottom (b)	==	12.20 ft	Top width (t)	==	13.16 (T)	1.24 ft
Side slopes (Z)	==	2.0:1(L) 2.0:1(R)	Velocity	==	4.16 (V)	17.16 ft
Bed Slope	==	21.45 %	Hydraulic Radius	==	0.203 (R)	
Manning's n	==	0.057	Froude number	==	1.66 (F)	
		D <sub>max</sub> == 0.31 ft ( 3.75 in)				
		D <sub>50</sub> == 0.25 ft ( 3.00 in)				
		D <sub>10</sub> == 0.08 ft ( 1.00 in)				

SEDCAD+ RIPRAP CHANNEL DESIGN  
-----

LOWE DIVERSION EAST INLET @ STA 24+45

INPUT VALUES:


Shape	TRAPEZOIDAL	
Discharge	13.77 cfs	
Slope	21.45 %	
Sideslopes (L and R)	2.00:1	2.00:1
Bottom Width	6.10 feet	
Freeboard	1 ft	

RESULTS:

Steep Slope Design - PADER Method

Depth	0.34 ft
with Freeboard	1.34 ft
Top Width	7.44 ft
with Freeboard	11.44 ft
Velocity	6.05 fps
Cross Sectional Area	2.27 sq ft
Hydraulic Radius	0.30 ft
Manning's n	0.051
Froude Number	1.93
Dmax	0.313 ft ( 3.75 in)
D50	0.250 ft ( 3.00 in)
D10	0.083 ft ( 1.00 in)

SEDCAD+ CHANNEL DESIGN  
 LOWE DIVERSION EAST INLET @ STA 24+45

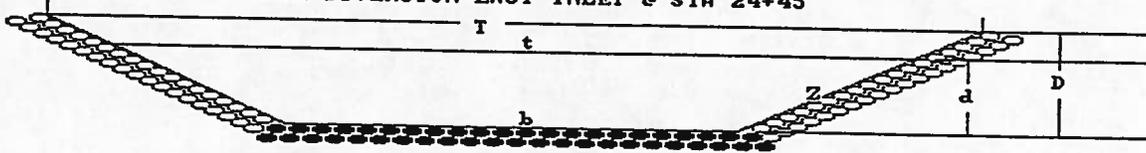

Riprap - Steep Slope Design - PADER Method

Discharge	==	13.77	cfs	Depth (d)	==	0.34	(D/d) ==	Freeboard:
Bottom (b)	==	6.10	ft	Top width (t)	==	7.44	(T/d) ==	1.34
Side slopes (Z)	==	2.0:1(L)	2.0:1(R)	Velocity	==	6.05	(V/d) ==	11.44
Bed Slope	==	21.45	%	Hydraulic Radius	==	0.30	(R/d) ==	
Manning's n	==	0.051		Froude number	==	1.93	(Fr) ==	
		Dmax	== 0.31	ft				
		D50	== 0.25	ft				
		D10	== 0.08	ft				
				( 3.75 in)				
				( 3.00 in)				
				( 1.00 in)				

SEDCAD+ RIPRAP CHANNEL DESIGN

LOWE DIVERSION EAST INLET @ STA 39+64

INPUT VALUES:


Shape	TRAPEZOIDAL	
Discharge	19.30 cfs	
Slope	28.41 %	
Sideslopes (L and R)	2.00:1	2.00:1
Bottom Width	10.80 feet	
Freeboard	1 ft	

RESULTS:

Steep Slope Design - PADER Method

Depth	0.28 ft
with Freeboard	1.28 ft
Top Width	11.92 ft
with Freeboard	15.92 ft
Velocity	6.06 fps
Cross Sectional Area	3.19 sq ft
Hydraulic Radius	0.26 ft
Manning's n	0.054
Froude Number	2.06
Dmax	0.313 ft ( 3.75 in)
D50	0.250 ft ( 3.00 in)
D10	0.083 ft ( 1.00 in)

SEPCAD+ CHANNEL DESIGN  
 LOWE DIVERSION EAST INLET @ STA 39+64

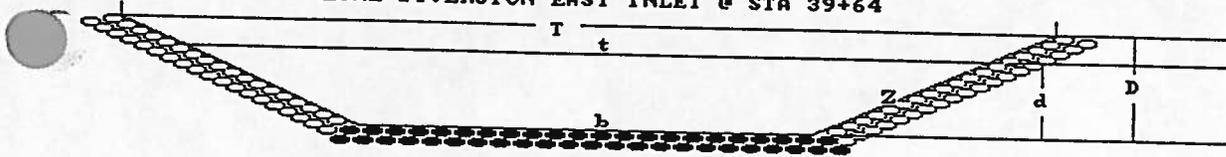

Riprap - Steep Slope Design - PADER Method

Discharge	==	19.30	cfs	Depth (d)	==	0.28	(D/	Freeboard:
Bottom (b)	==	10.80	ft	Top width (t)	==	11.92	(T	1.28)
Side slopes (Z)	==	2.0:1(L)	2.0:1(R)	Velocity	==	6.06	(V	15.92)
Bed Slope	==	28.41	%	Hydraulic Radius	==	2.06	ft	ft
Manning's n	==	0.054		Froude number	==	2.06		
		D <sub>max</sub>	==	0.31	ft	(	3.75	in)
		D <sub>50</sub>	==	0.25	ft	(	3.00	in)
		D <sub>10</sub>	==	0.08	ft	(	1.00	in)

SEDCAD+ RIPRAP CHANNEL DESIGN

LOWE DIVERSION EAST INLET @ STA 39+64

INPUT VALUES:


Shape	TRAPEZOIDAL	
Discharge	19.30 cfs	
Slope	28.41 %	
Sideslopes (L and R)	2.00:1	2.00:1
Bottom Width	5.40 feet	
Freeboard	1 ft	

RESULTS:

Steep Slope Design - PADER Method

Depth	0.46 ft
with Freeboard	1.46 ft
Top Width	7.26 ft
with Freeboard	11.26 ft
Velocity	6.56 fps
Cross Sectional Area	2.94 sq ft
Hydraulic Radius	0.39 ft
Manning's n	0.065
Froude Number	1.82
Dmax	0.625 ft ( 7.50 in)
D50	0.500 ft ( 6.00 in)
D10	0.167 ft ( 2.00 in)

SEDCAD+ CHANNEL DESIGN  
 LOWE DIVERSION EAST INLET @ STA 39+64

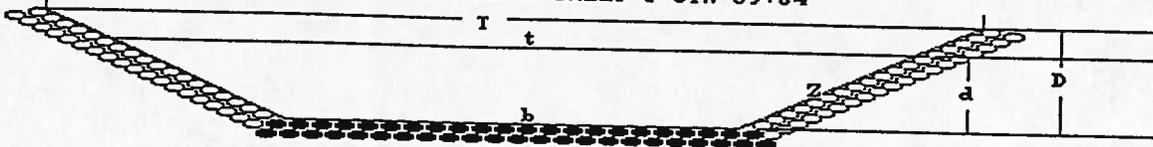

Riprap - Steep Slope Design - PADER Method

Discharge	==	19.30	cfs	Depth (d)	==	0.46	(D/	Freeboard:
Bottom (b)	==	5.40	ft	Top width (t)	==	7.26	(D	1.46)
Side slopes (Z)	==	2.0:1(L)	2.0:1(R)	Velocity	==	6.56	(I	11.26)
Bed Slope	==	28.41	%	Hydraulic Radius	==	0.39	ft	
Manning's n	==	0.065		Froude number	==	1.82		
		Dmax	==	0.63	ft	(	7.50	in)
		D50	==	0.50	ft	(	6.00	in)
		D10	==	0.17	ft	(	2.00	in)

SEDCAD+ RIPRAP CHANNEL DESIGN

LOWE DIVERSION EAST INLET @ STA 64+00

INPUT VALUES:


Shape	TRAPEZOIDAL	
Discharge	38.48 cfs	
Slope	15.73 %	
Sideslopes (L and R)	2.00:1	2.00:1
Bottom Width	16.50 feet	
Freeboard	1 ft	

RESULTS:

Steep Slope Design - PADER Method

Depth	0.37 ft
with Freeboard	1.37 ft
Top Width	17.98 ft
with Freeboard	21.98 ft
Velocity	6.02 fps
Cross Sectional Area	6.40 sq ft
Hydraulic Radius	0.35 ft
Manning's n	0.049
Froude Number	1.78
Dmax	0.313 ft ( 3.75 in)
D50	0.250 ft ( 3.00 in)
D10	0.083 ft ( 1.00 in)

SEDCAD+ CHANNEL DESIGN  
 LOWE DIVERSION EAST INLET @ STA 64+00

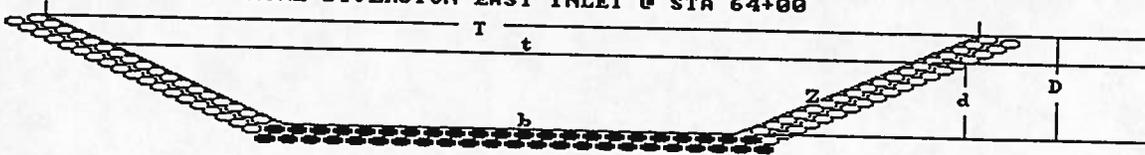

Riprap - Steep Slope Design - PADER Method

Discharge	==	38.48	cfs	Depth (d)	==	0.37	(D/	Freeboard:
Bottom (b)	==	16.50	ft	Top width (t)	==	17.98	(T	1.37)
Side slopes (Z)	==	2.0:1(L)	2.0:1(R)	Velocity	==	6.02	(V	21.98)
Bed Slope	==	15.73	%	Hydraulic Radius	==	0.35	ft	
Manning's n	==	0.049		Froude number	==	1.78		
		Dmax	==	0.31	ft			
		D50	==	0.25	ft			
		D10	==	0.08	ft			

SEDCAD+ RIPRAP CHANNEL DESIGN

LOWE DIVERSION EAST INLET @ STA 64+00

INPUT VALUES:


Shape	TRAPEZOIDAL	
Discharge	38.48 cfs	
Slope	15.73 %	
Sideslopes (L and R)	2.00:1	2.00:1
Bottom Width	8.25 feet	
Freeboard	1 ft	

RESULTS:

Steep Slope Design - PADER Method

Depth	0.62 ft
with Freeboard	1.62 ft
Top Width	10.72 ft
with Freeboard	14.72 ft
Velocity	6.57 fps
Cross Sectional Area	5.85 sq ft
Hydraulic Radius	0.53 ft
Manning's n	0.059
Froude Number	1.57
Dmax	0.625 ft ( 7.50 in)
D50	0.500 ft ( 6.00 in)
D10	0.167 ft ( 2.00 in)

SEDCAD+ CHANNEL DESIGN  
 LOWE DIVERSION EAST INLET @ STA 64+00

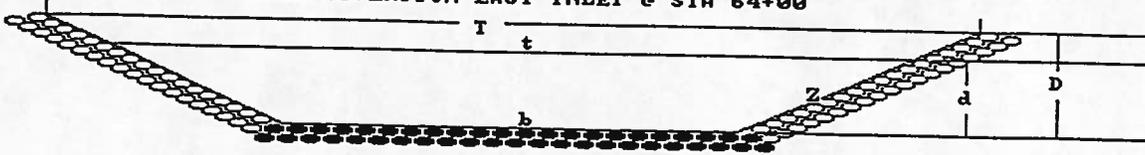

Riprap - Steep Slope Design - PADER Method

Discharge	==	38.48	cfs	Depth (d)	==	10.63	(D/d ==	Freeboard:
Bottom (b)	==	8.25	ft	Top width (t)	==	18.72	(T/d ==	1.62) ft
Side slopes (Z)	==	2.0:1(L)	2.0:1(R)	Velocity	==	6.55	(V/d ==	14.72) ft
Side slope	==	15.73	%	Hydraulic Radius	==	6.55	ft	
Manning's n	==	0.059		Froude number	==	1.57		
		D <sub>max</sub>	==	0.63	ft	( 7.50	in)	
		D <sub>50</sub>	==	0.50	ft	( 6.00	in)	
		D <sub>10</sub>	==	0.17	ft	( 2.00	in)	

Civil Software Design

SEDCAD+ Version 3

LOWE DIVERSION INLET @ STA. 26+45 AS-BUILT ANALYSIS

by

Name: BH

Company Name: BHP MINERALS

Date: 08-08-97

SEDCAD+ RIPRAP CHANNEL DESIGN

LOWE DIVERSION EAST INLET @ 26+45

INPUT VALUES:

Shape	TRAPEZOIDAL	
Discharge	13.77 cfs	
Slope	17.52 %	
Sideslopes (L and R)	2.00:1	2.10:1
Bottom Width	9.30 feet	
Freeboard	1 ft	

RESULTS:

Steep Slope Design - Simons/OSM Method

Depth	0.13 ft
with Freeboard	1.13 ft
Top Width	9.85 ft
with Freeboard	13.95 ft
Velocity	10.72 fps
Cross Sectional Area	1.28 sq ft
Hydraulic Radius	0.13 ft
Manning's n	0.035
Froude Number	5.23
Dmax	0.625 ft ( 7.50 in)
D50	0.500 ft ( 6.00 in)
D10	0.167 ft ( 2.00 in)

Civil Software Design

SEDCAD+ Version 3

LOWE DIVERSION INLET @ STA. 64+00 AS-BUILT ANALYSIS

by

Name: BH

Company Name: BHP MINERALS

Date: 08-08-97

SEDCAD+ RIPRAP CHANNEL DESIGN

-----  
LOWE DIVERSION EAST INLET @ STA 64+00

INPUT VALUES:

Shape	TRAPEZOIDAL	
Discharge	38.48 cfs	
Slope	11.70 %	
Sideslopes (L and R)	2.71:1	1.62:1
Bottom Width	5.00 feet	
Freeboard	1 ft	

RESULTS:

Steep Slope Design - PADER Method

Depth	0.81 ft
with Freeboard	1.81 ft
Top Width	8.52 ft
with Freeboard	12.85 ft
Velocity	6.99 fps
Cross Sectional Area	5.50 sq ft
Hydraulic Radius	0.62 ft
Manning's n	0.053
Froude Number	1.53
Dmax	0.625 ft ( 7.50 in)
D50	0.500 ft ( 6.00 in)
D10	0.167 ft ( 2.00 in)