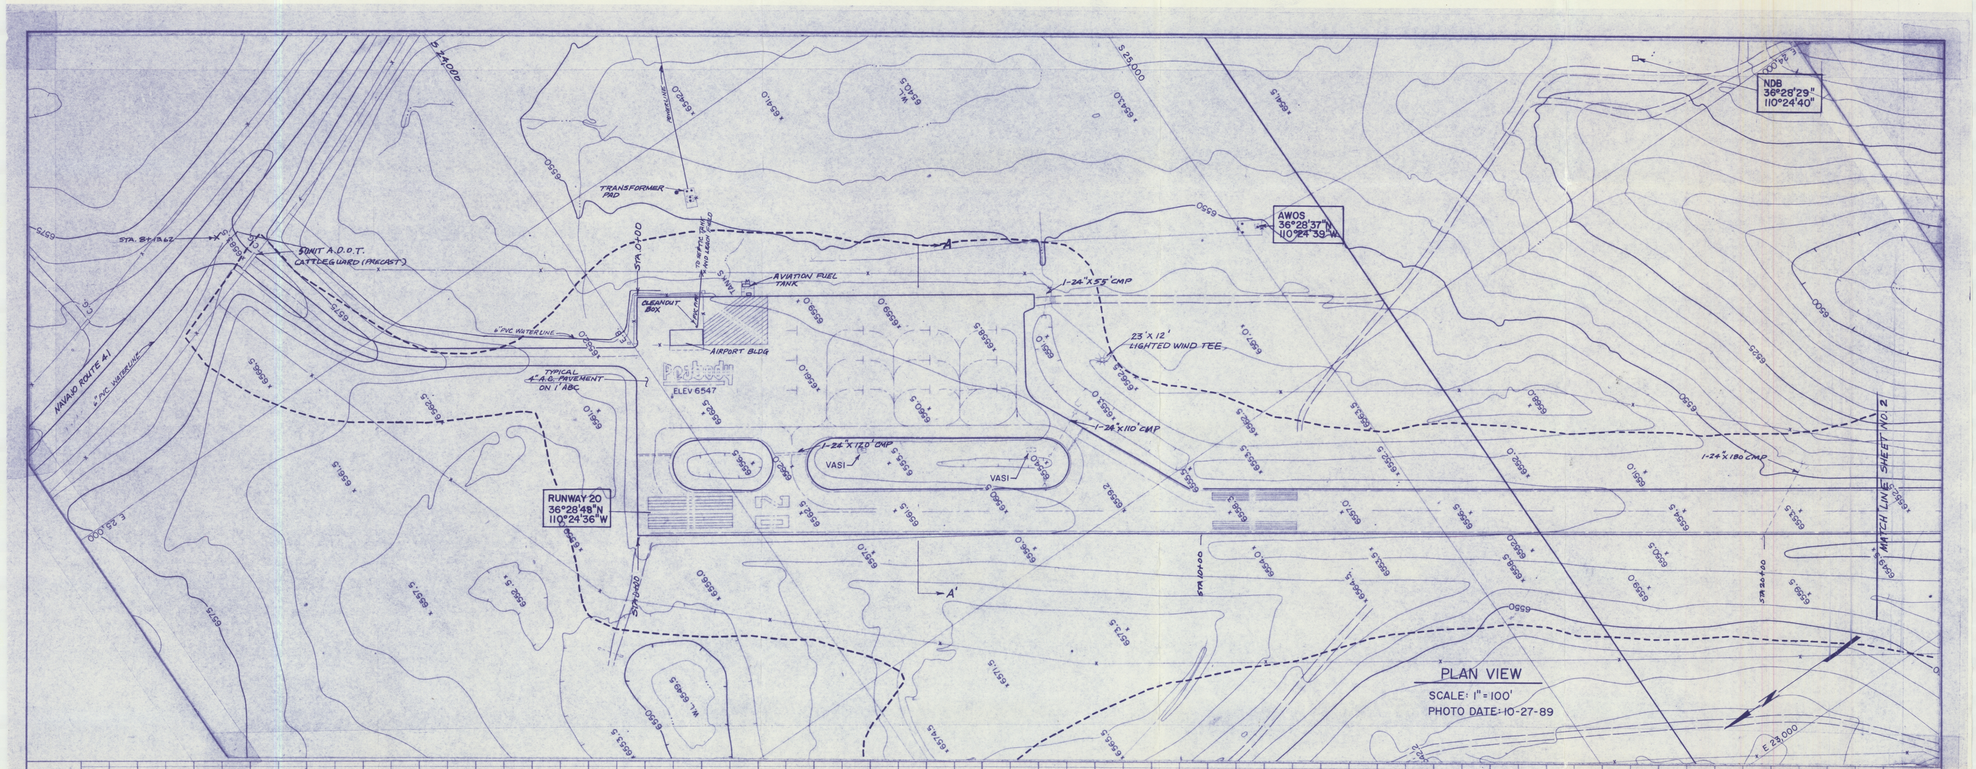

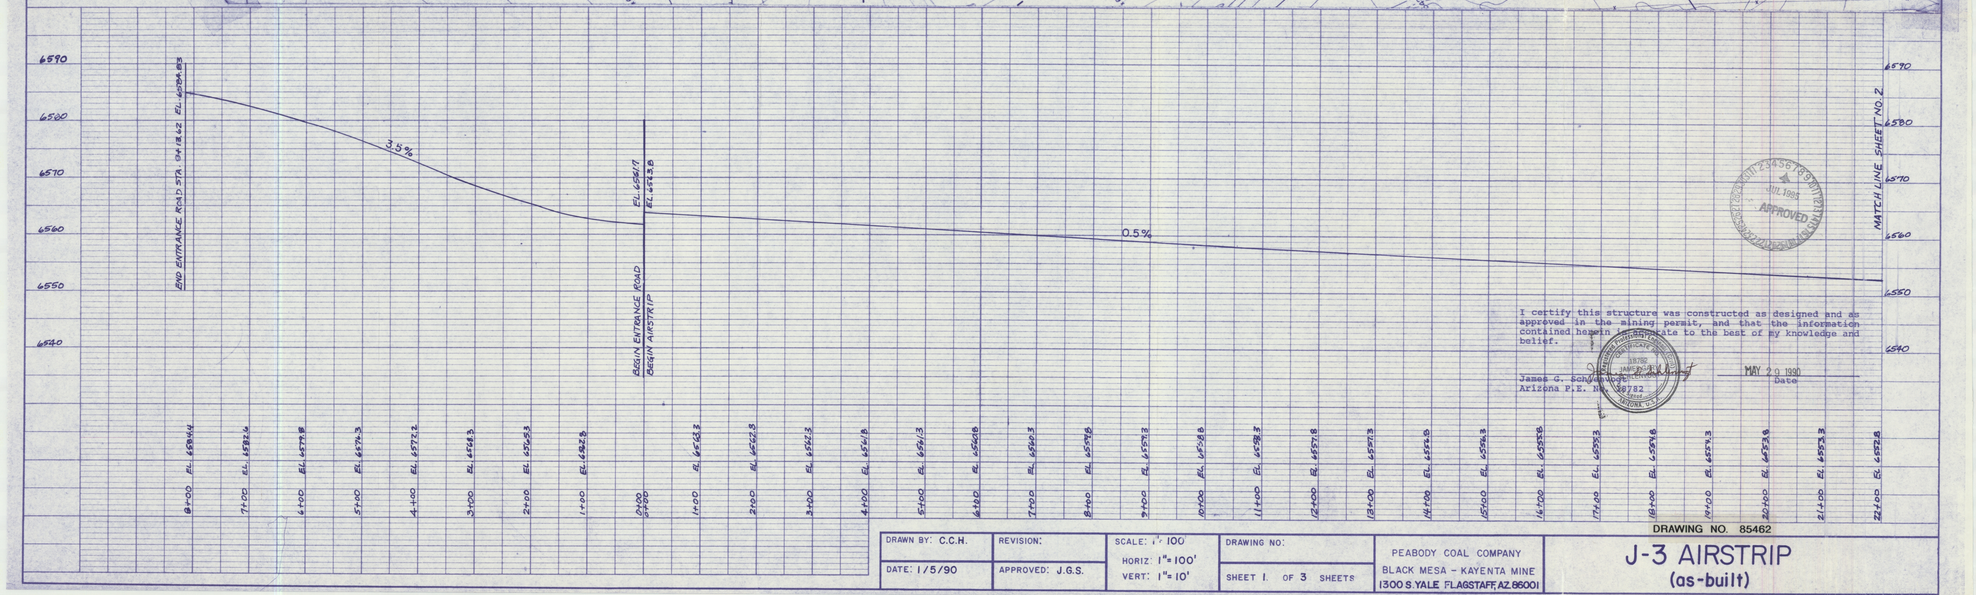

I certify this structure was constructed as designed and as approved in the mining permit, and that the information contained herein is accurate to the best of my knowledge and belief.

James G. Schlenbecker
Arizona P.E. No. 38782

MAY 29 1990
Date

DRAWING NO. 85462

DRAWN BY: C.C.H.	REVISION:	SCALE: 1" = 100'	DRAWING NO:	PEABODY COAL COMPANY	J-3 AIRSTRIP
DATE: 1/5/90	APPROVED: J.G.S.	HORIZ: 1" = 100' VERT: 1" = 10'	SHEET 1 OF 3 SHEETS	BLACK MESA - KAYENTA MINE 1300 S. YALE FLAGSTAFF, AZ. 86001	(as-built)