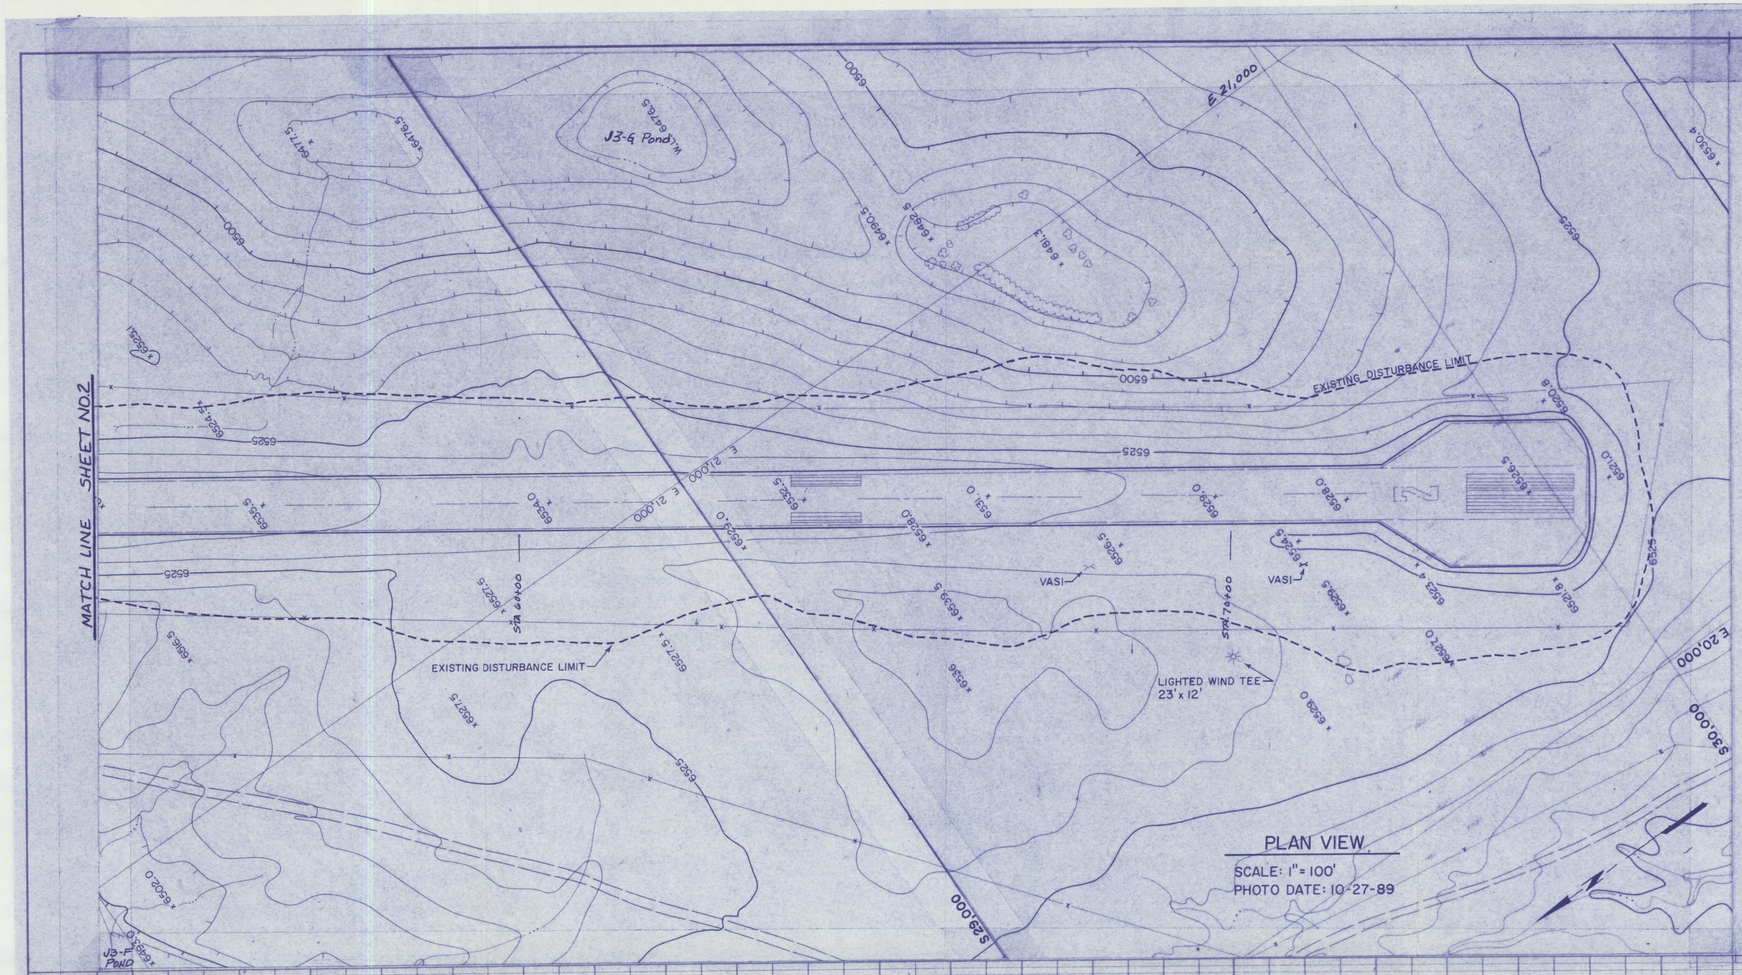

PLAN VIEW

SCALE: 1" = 100'

PHOTO DATE: 10-27-89

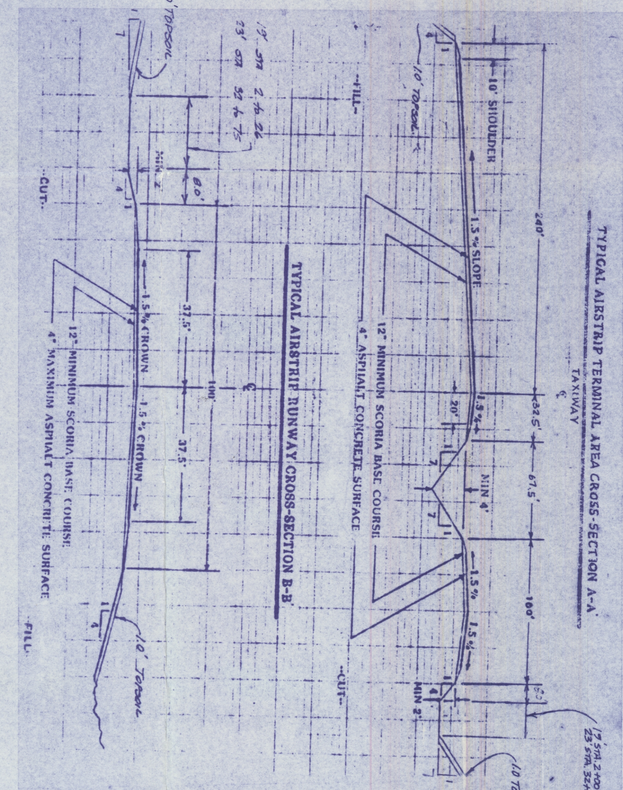

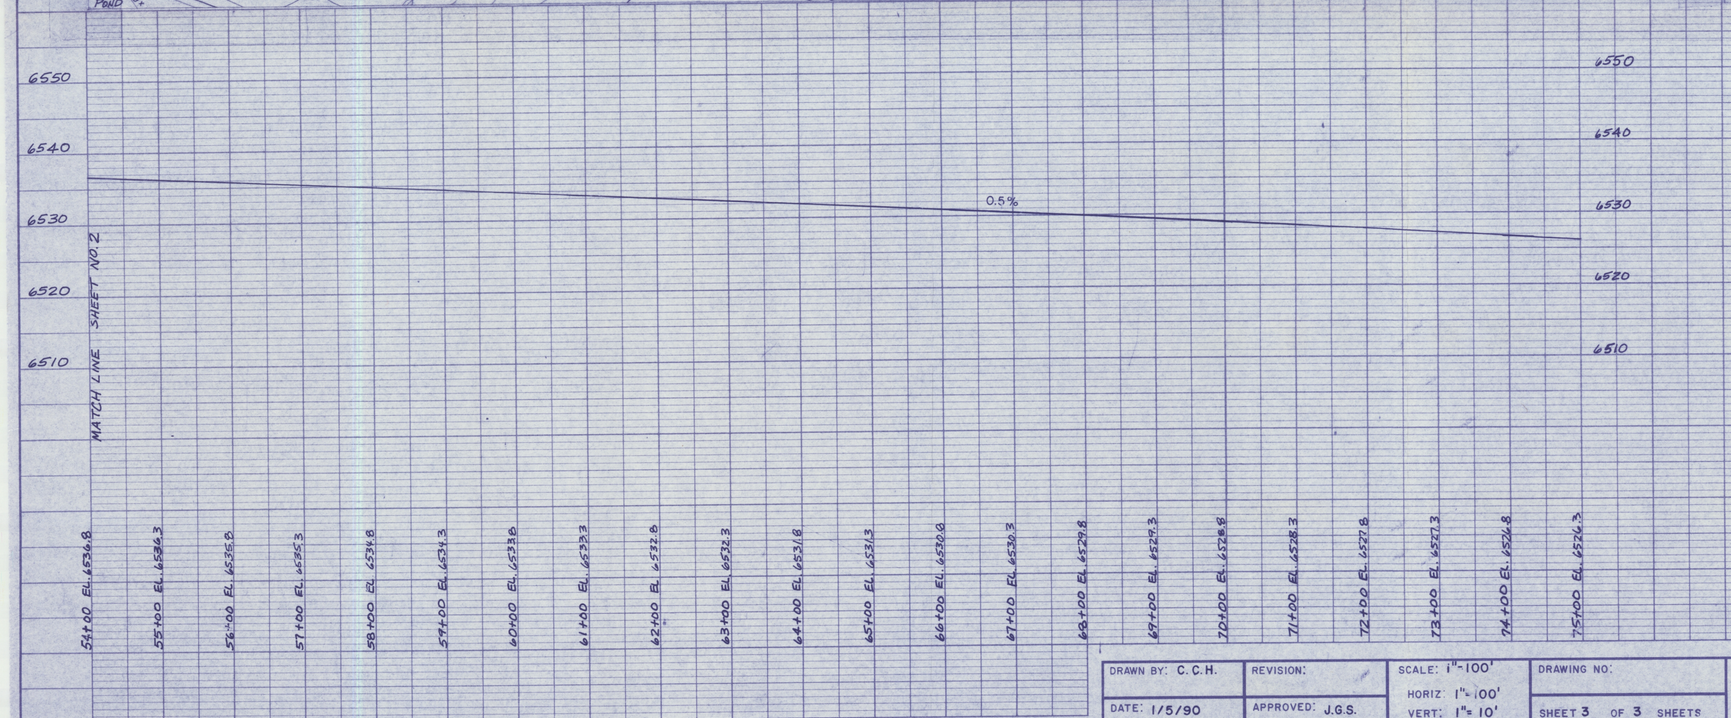

I certify this structure was constructed as designed and as approved in the mining permit, and that the information contained herein is accurate to the best of my knowledge and belief.

James G. Schlenwerk
Arizona R.L.S. No. 18782

MAY 23 1990
Date

JUL 1995 APPROVED

DRAWING NO. 85462

DRAWN BY: C.C.H.	REVISION:	SCALE: 1"-100'	DRAWING NO:	PEABODY COAL COMPANY	J-3 AIRSTRIP (as-built)
DATE: 1/5/90	APPROVED: J.G.S.	HORIZ 1"= 100' VERT: 1"= 10'	SHEET 3 OF 3 SHEETS	BLACK MESA - KAYENTA MINE 1300 S. YALE FLAGSTAFF, AZ 86001	